


DATE	BY
FINAL SURVEY PLOTTED	
NOTE BOOK AREAS CHECKED	

DATE	BY
ORIGINAL SURVEY PLOTTED	
NOTE BOOK AREAS CHECKED	

FED. ROAD DIST. NO.	STATE	FED. AID PROJ. NO.	FISCAL YEAR	SHEET NO.	TOTAL SHEETS
HAWAII	HAW.	I-H2-1(5)	1970	13	130

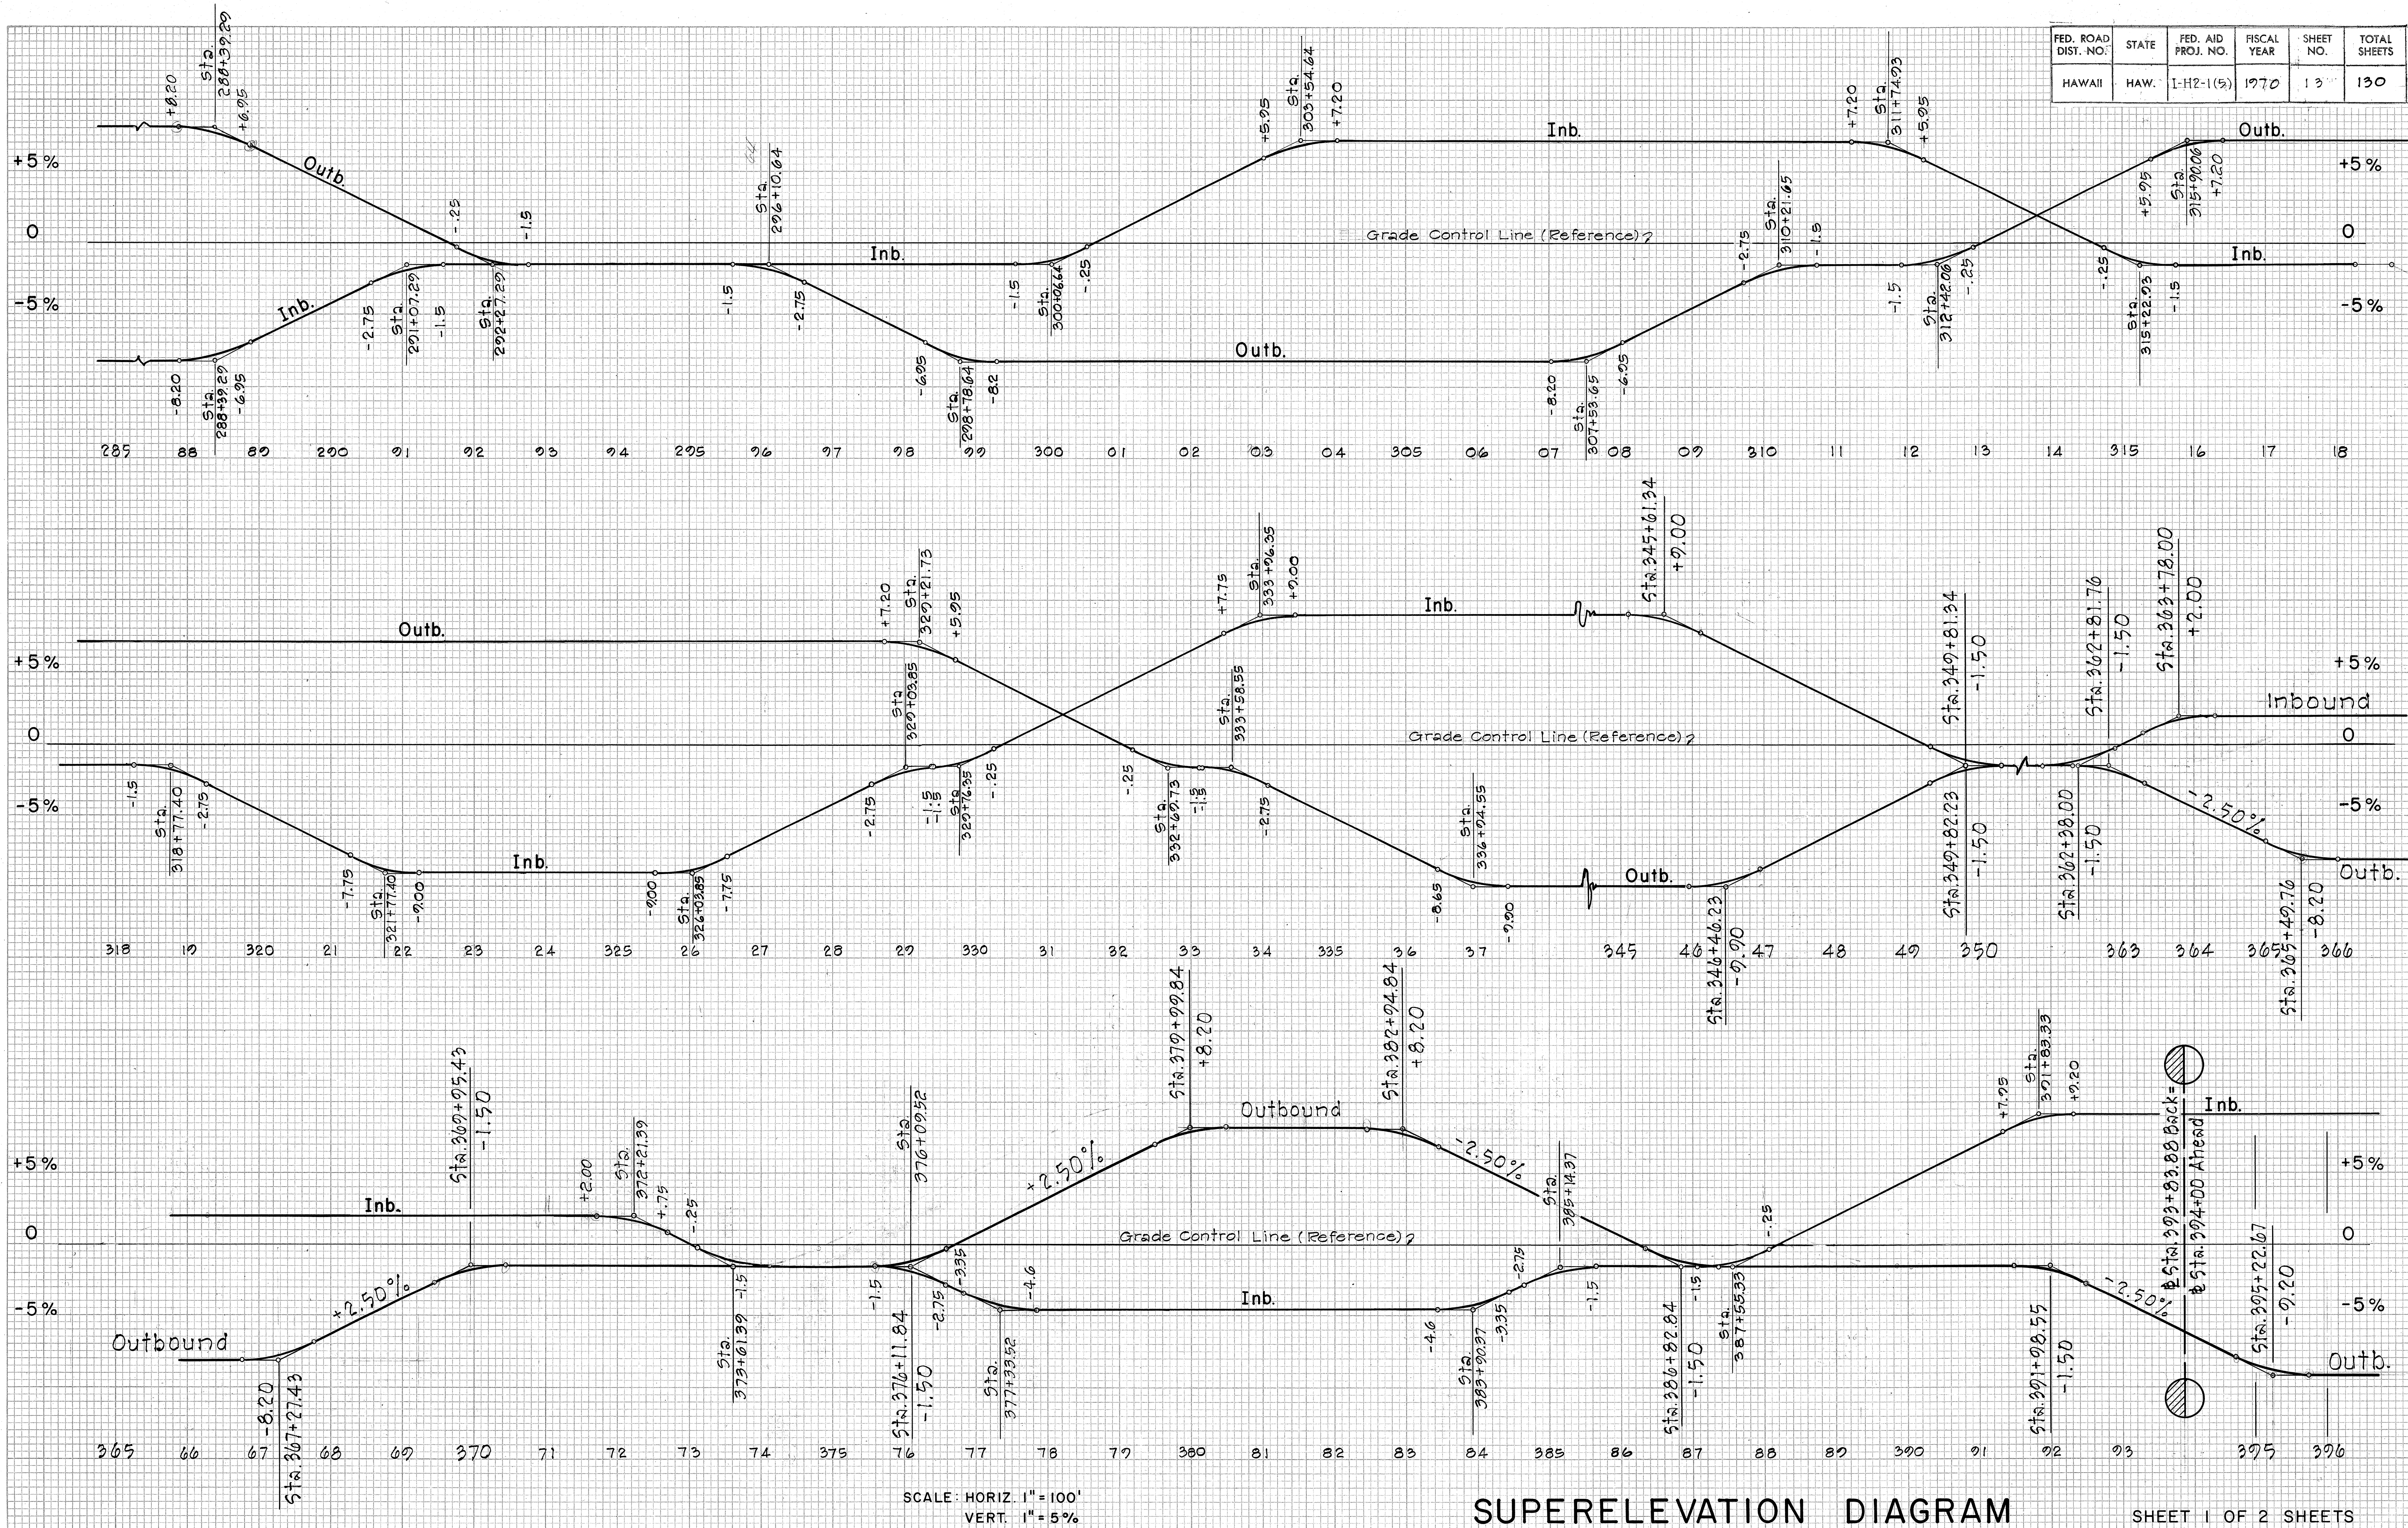

SUPERELEVATION DIAGRAM


SHEET 1 OF 2 SHEETS

PLATE 3. CROSS SECTION O. L. R. & R. E. STANDARD
KUFFEL & ESSER CO., NEW YORK
K & E CO. NO. 348-30

Aug. 19, 1971 (C) (D) . 1 3

FINAL SURVEY	BY	DATE
NOTE BOOK		
PLOTTED		
TEMPLATE		
AREAS		
AREAS CHECKED		

ORIGINAL			
SURVEY	SURVEYED	BY	DATE
NOTE BOOK	PLOTTED		
	TEMPLATE		
	AREAS		
NO.	AREAS CHECKED		

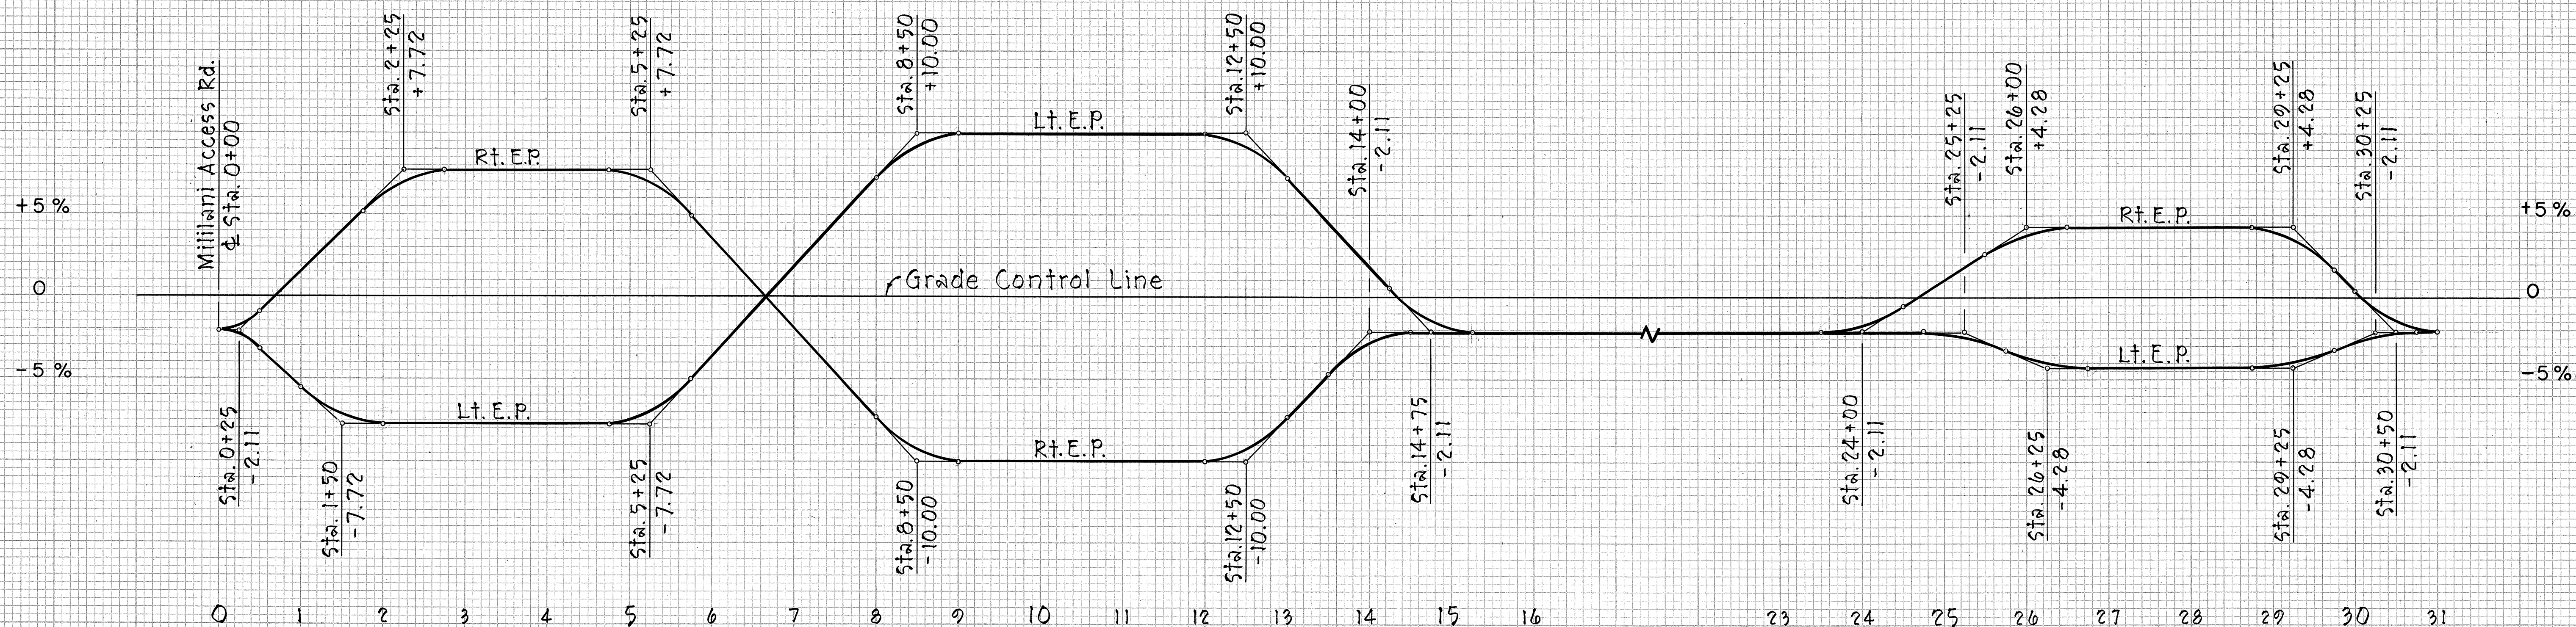

MILILANI ACCESS ROAD

SUPERELEVATION DIAGRAM



SCALE: HORIZ. 1" = 100'
VERT. 1" = 5 %

SHEET 2 OF 2 SHEETS

Aug. 19, 1971

CO. 141

FED. ROAD DIST. NO.	STATE	FED. AID PROJ. NO.	FISCAL YEAR	SHEET NO.	TOTAL SHEETS
HAWAII	HAW.	I-H2-1(5)	1970	14A	130

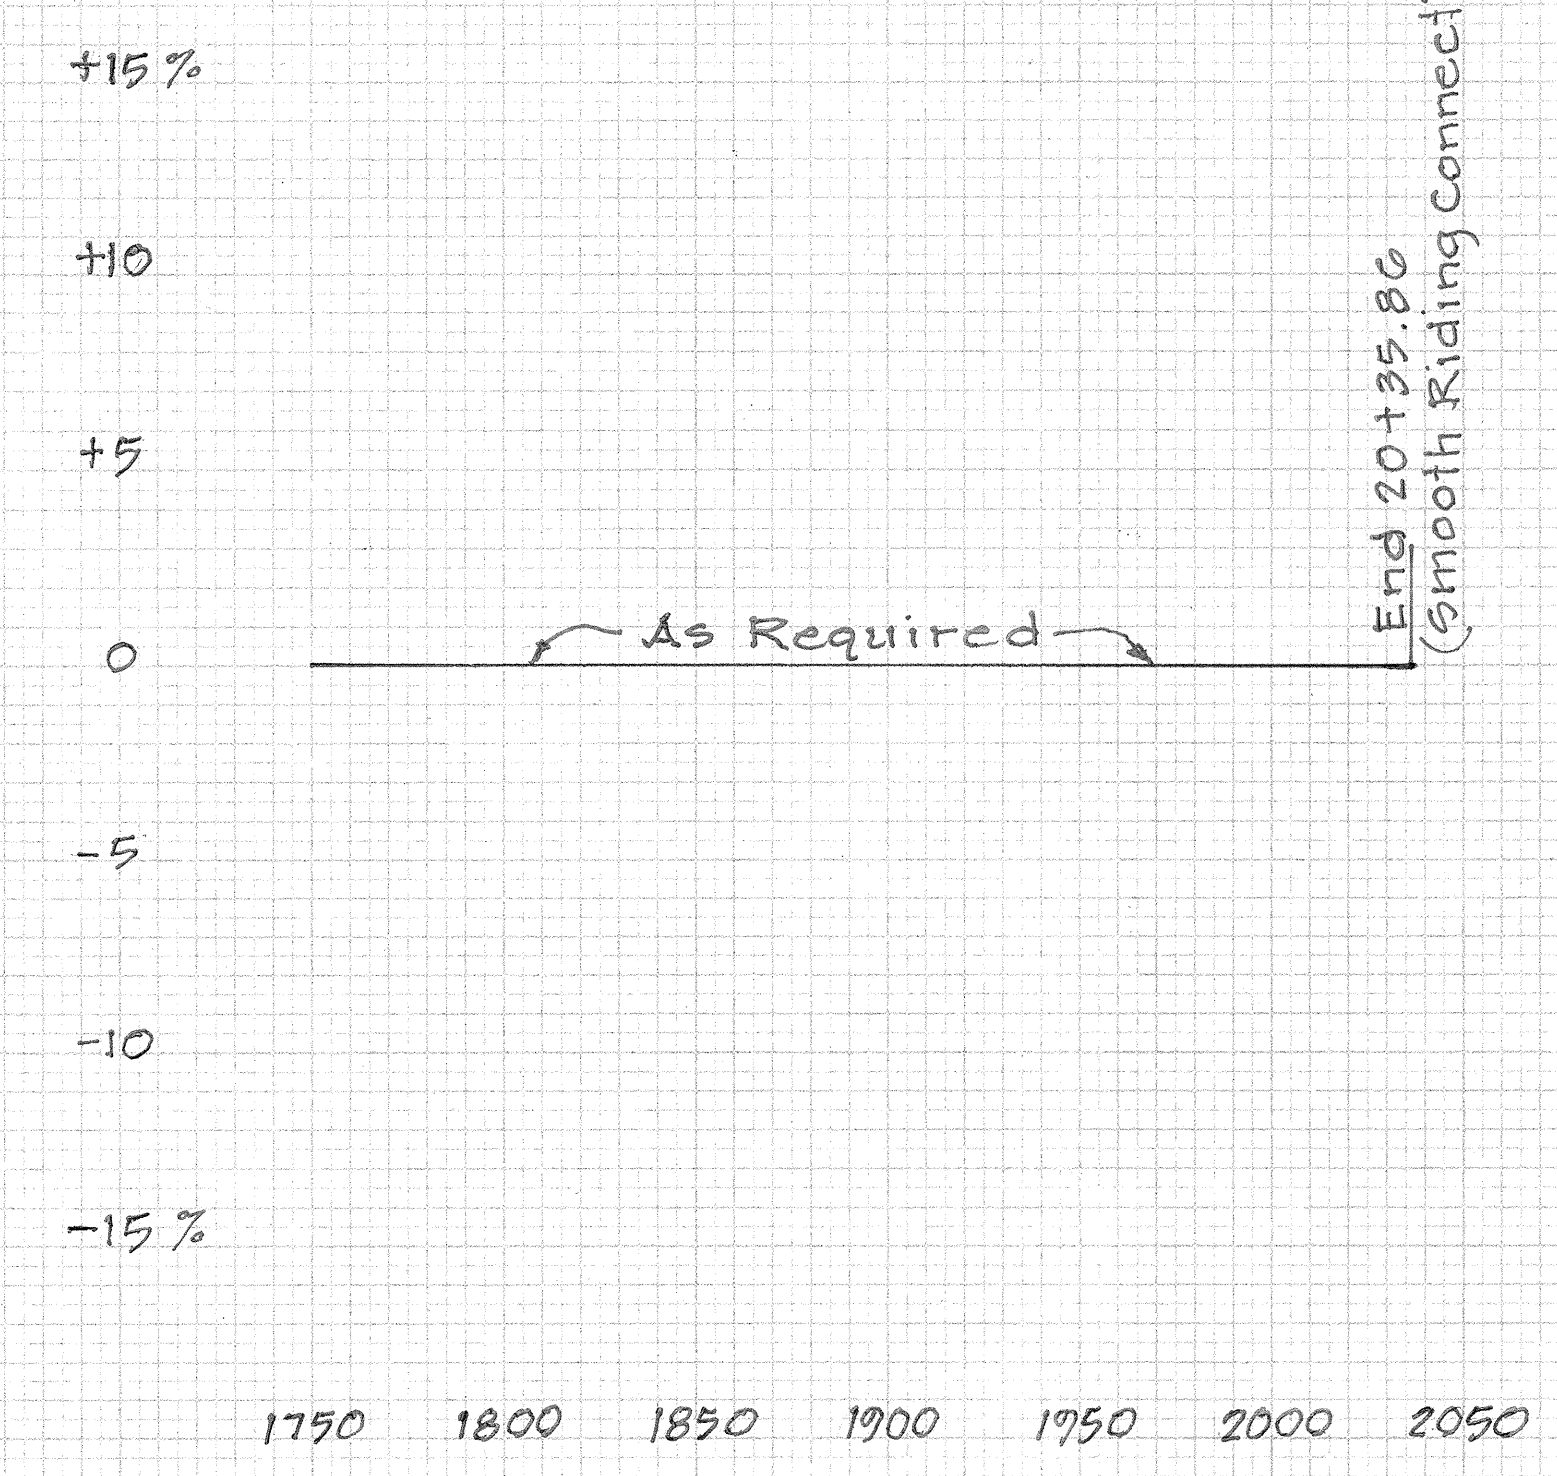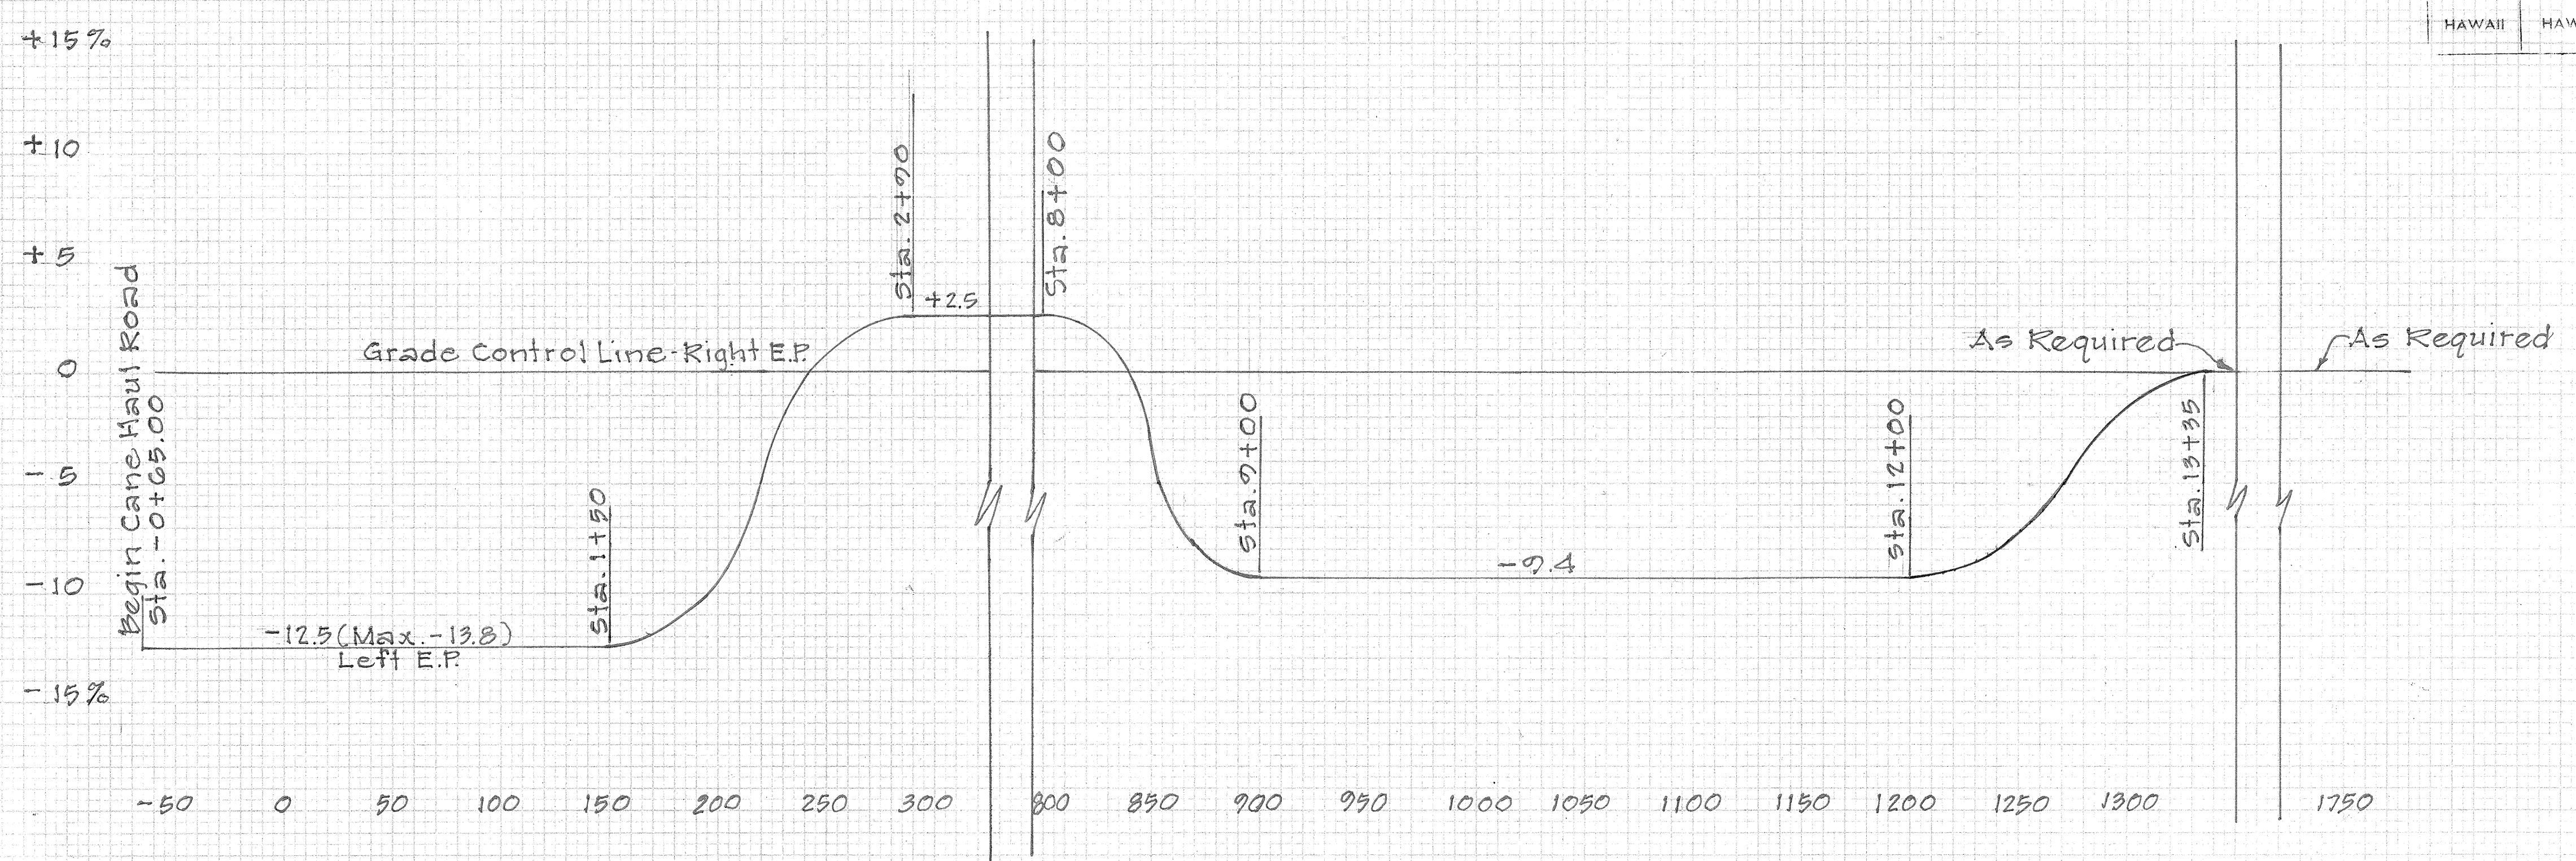

Superelevation Diagram
CANE HAUL ROAD
I-H2-1(5)

DATE	BY	SURVEYED	PLOTTED	AREA CHECKED

DATE	BY	SURVEYED	PLOTTED	AREA CHECKED