

FED. ROAD DIST. NO.	STATE	FED. AID PROJ. NO.	FISCAL YEAR	SHEET NO.	TOTAL SHEETS
HAWAII	HAW.	I-42-(6)3	1972	63	83

3/30/73	Contour Grading Revised
DATE	REVISION

C = 1,124
P = 1,168
0


C = 92
P = 152
0

C = 0
P = 0

NOTE: Limit of Grading - Finish Grade of Kipapa Stream Bridge (N.I.C.)

SHEET No. 1 OF 18 SHEETS

C.O. 63

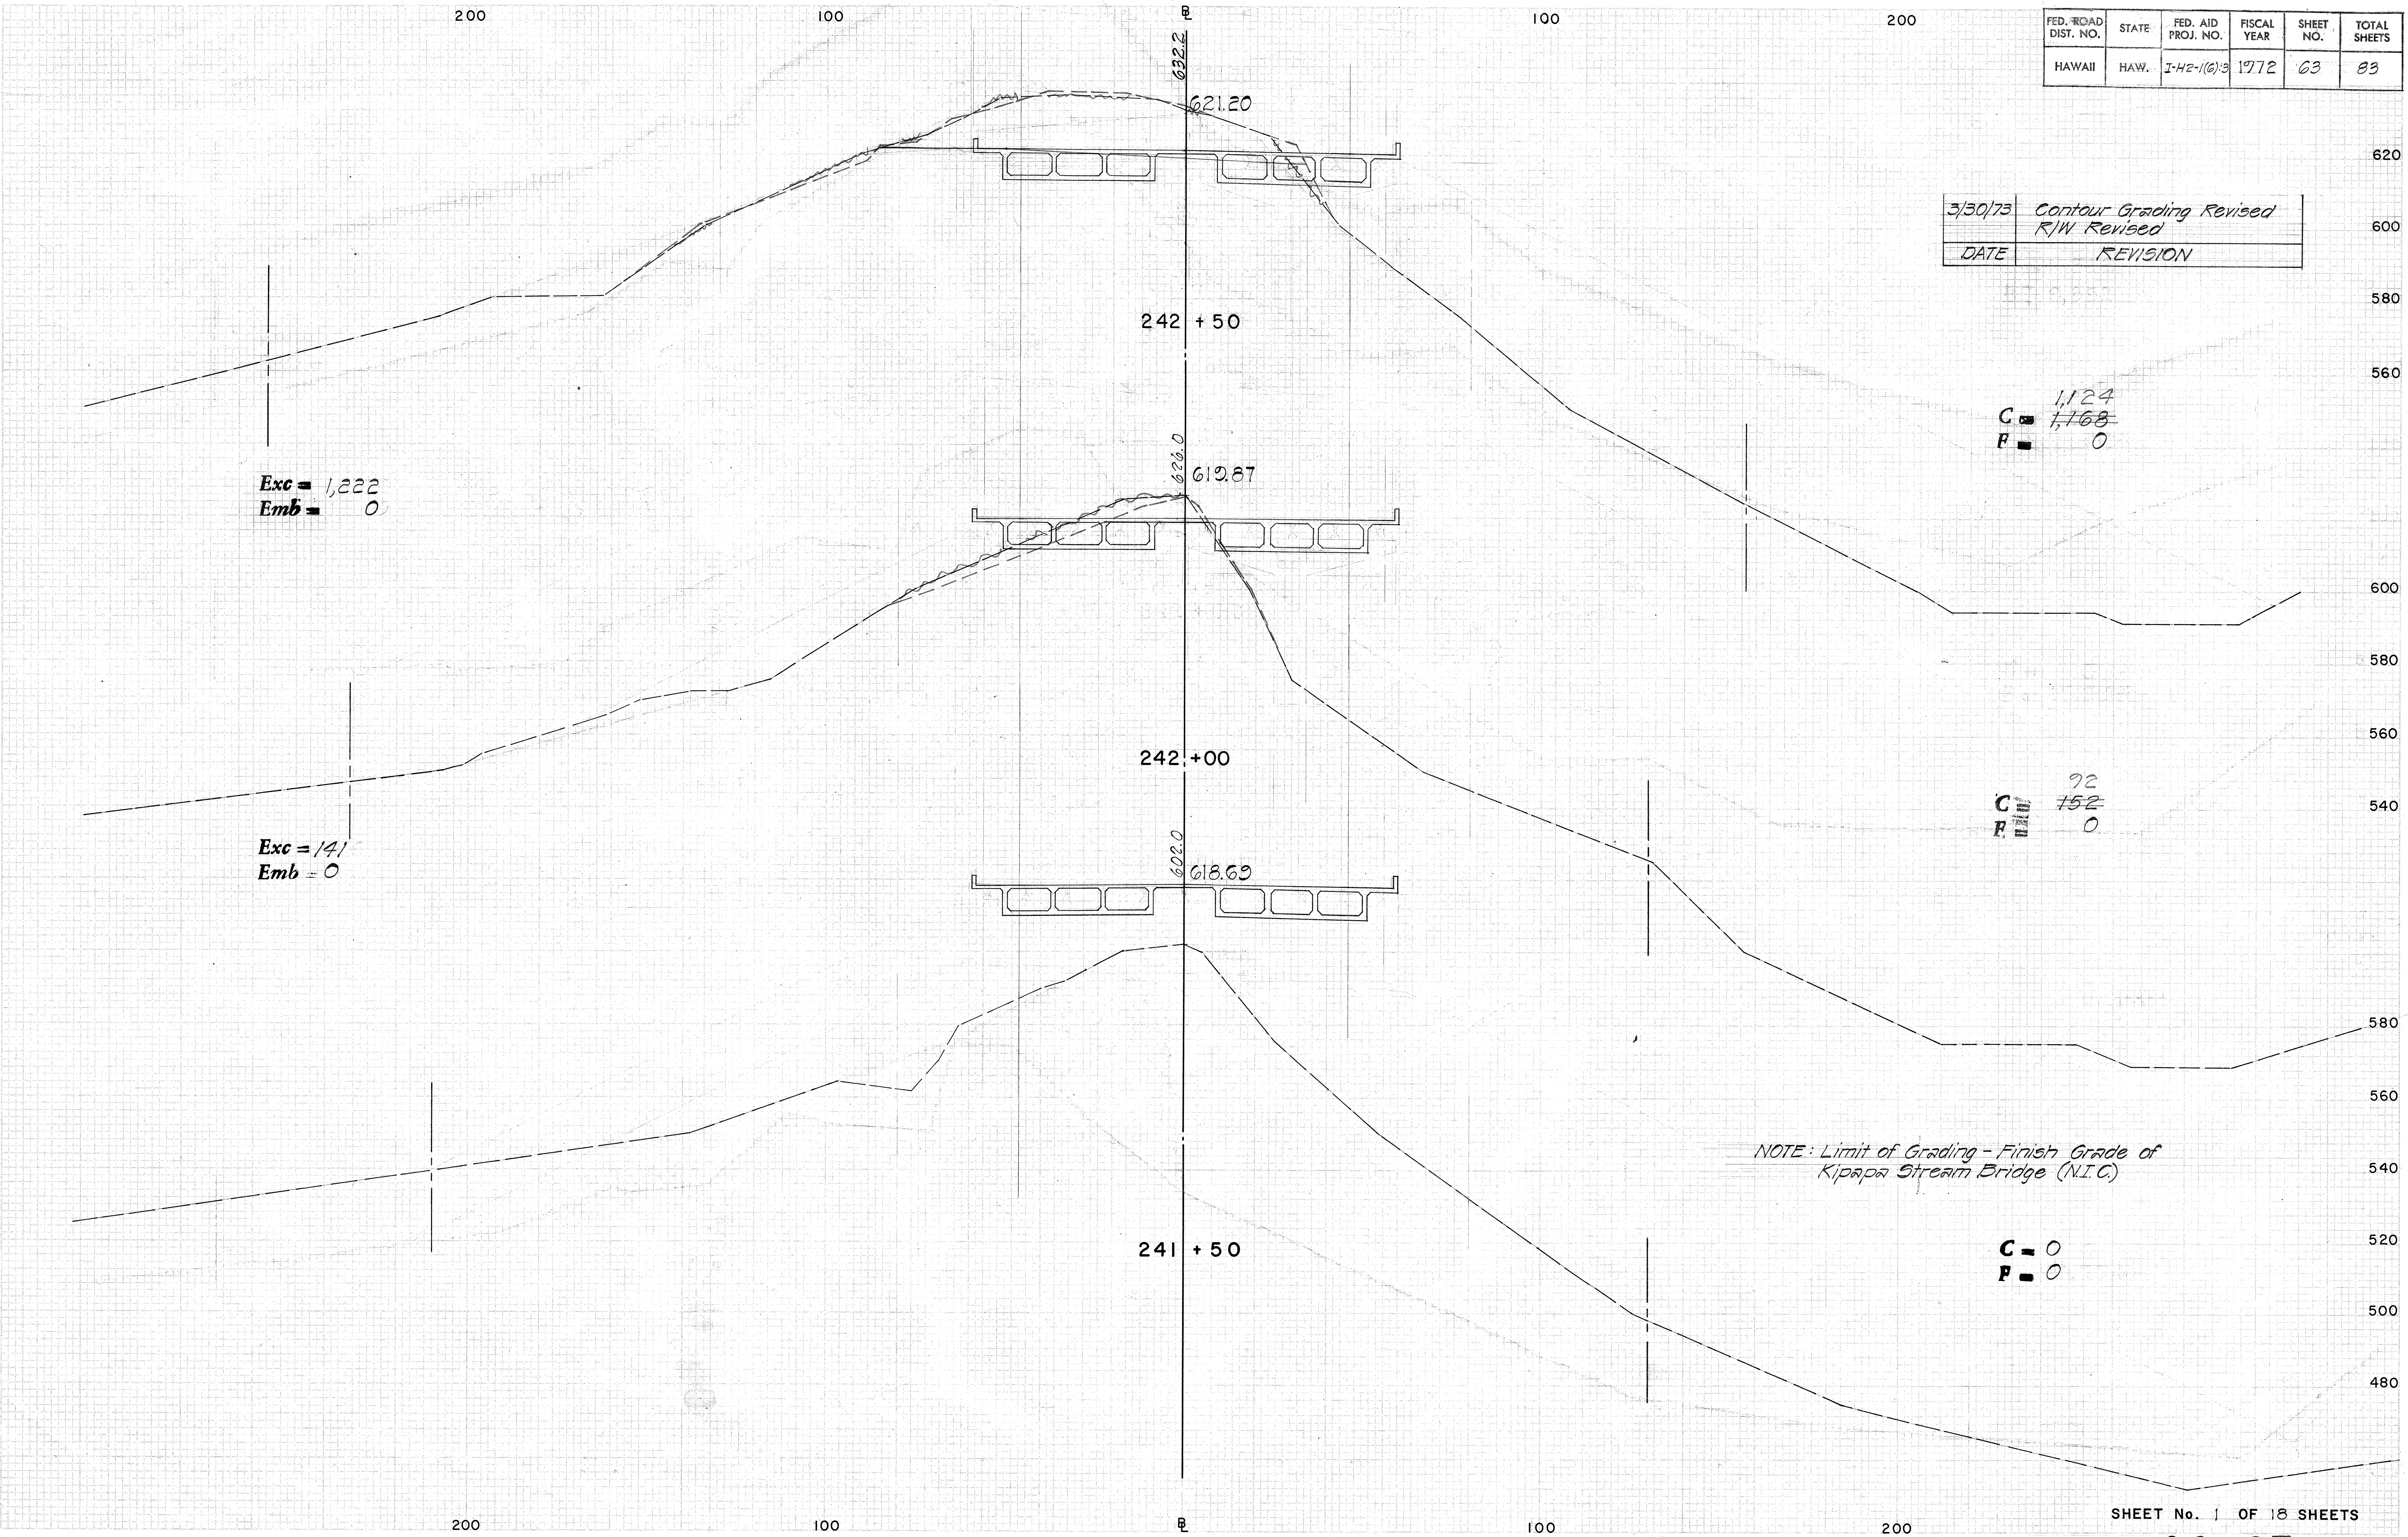


Exc = 1,222
Emb = 0

Exc = 141
Emb = 0

FINAL
SURVEY
NOTE BOOK
NO.

FINAL
SURVEY
NOTE BOOK
NO.

FED. ROAD DIST. NO.	STATE	FED. AID PROJ. NO.	FISCAL YEAR	SHEET NO.	TOTAL SHEETS
HAWAII	HAW.	I-12-1(6)3	1972	64	83

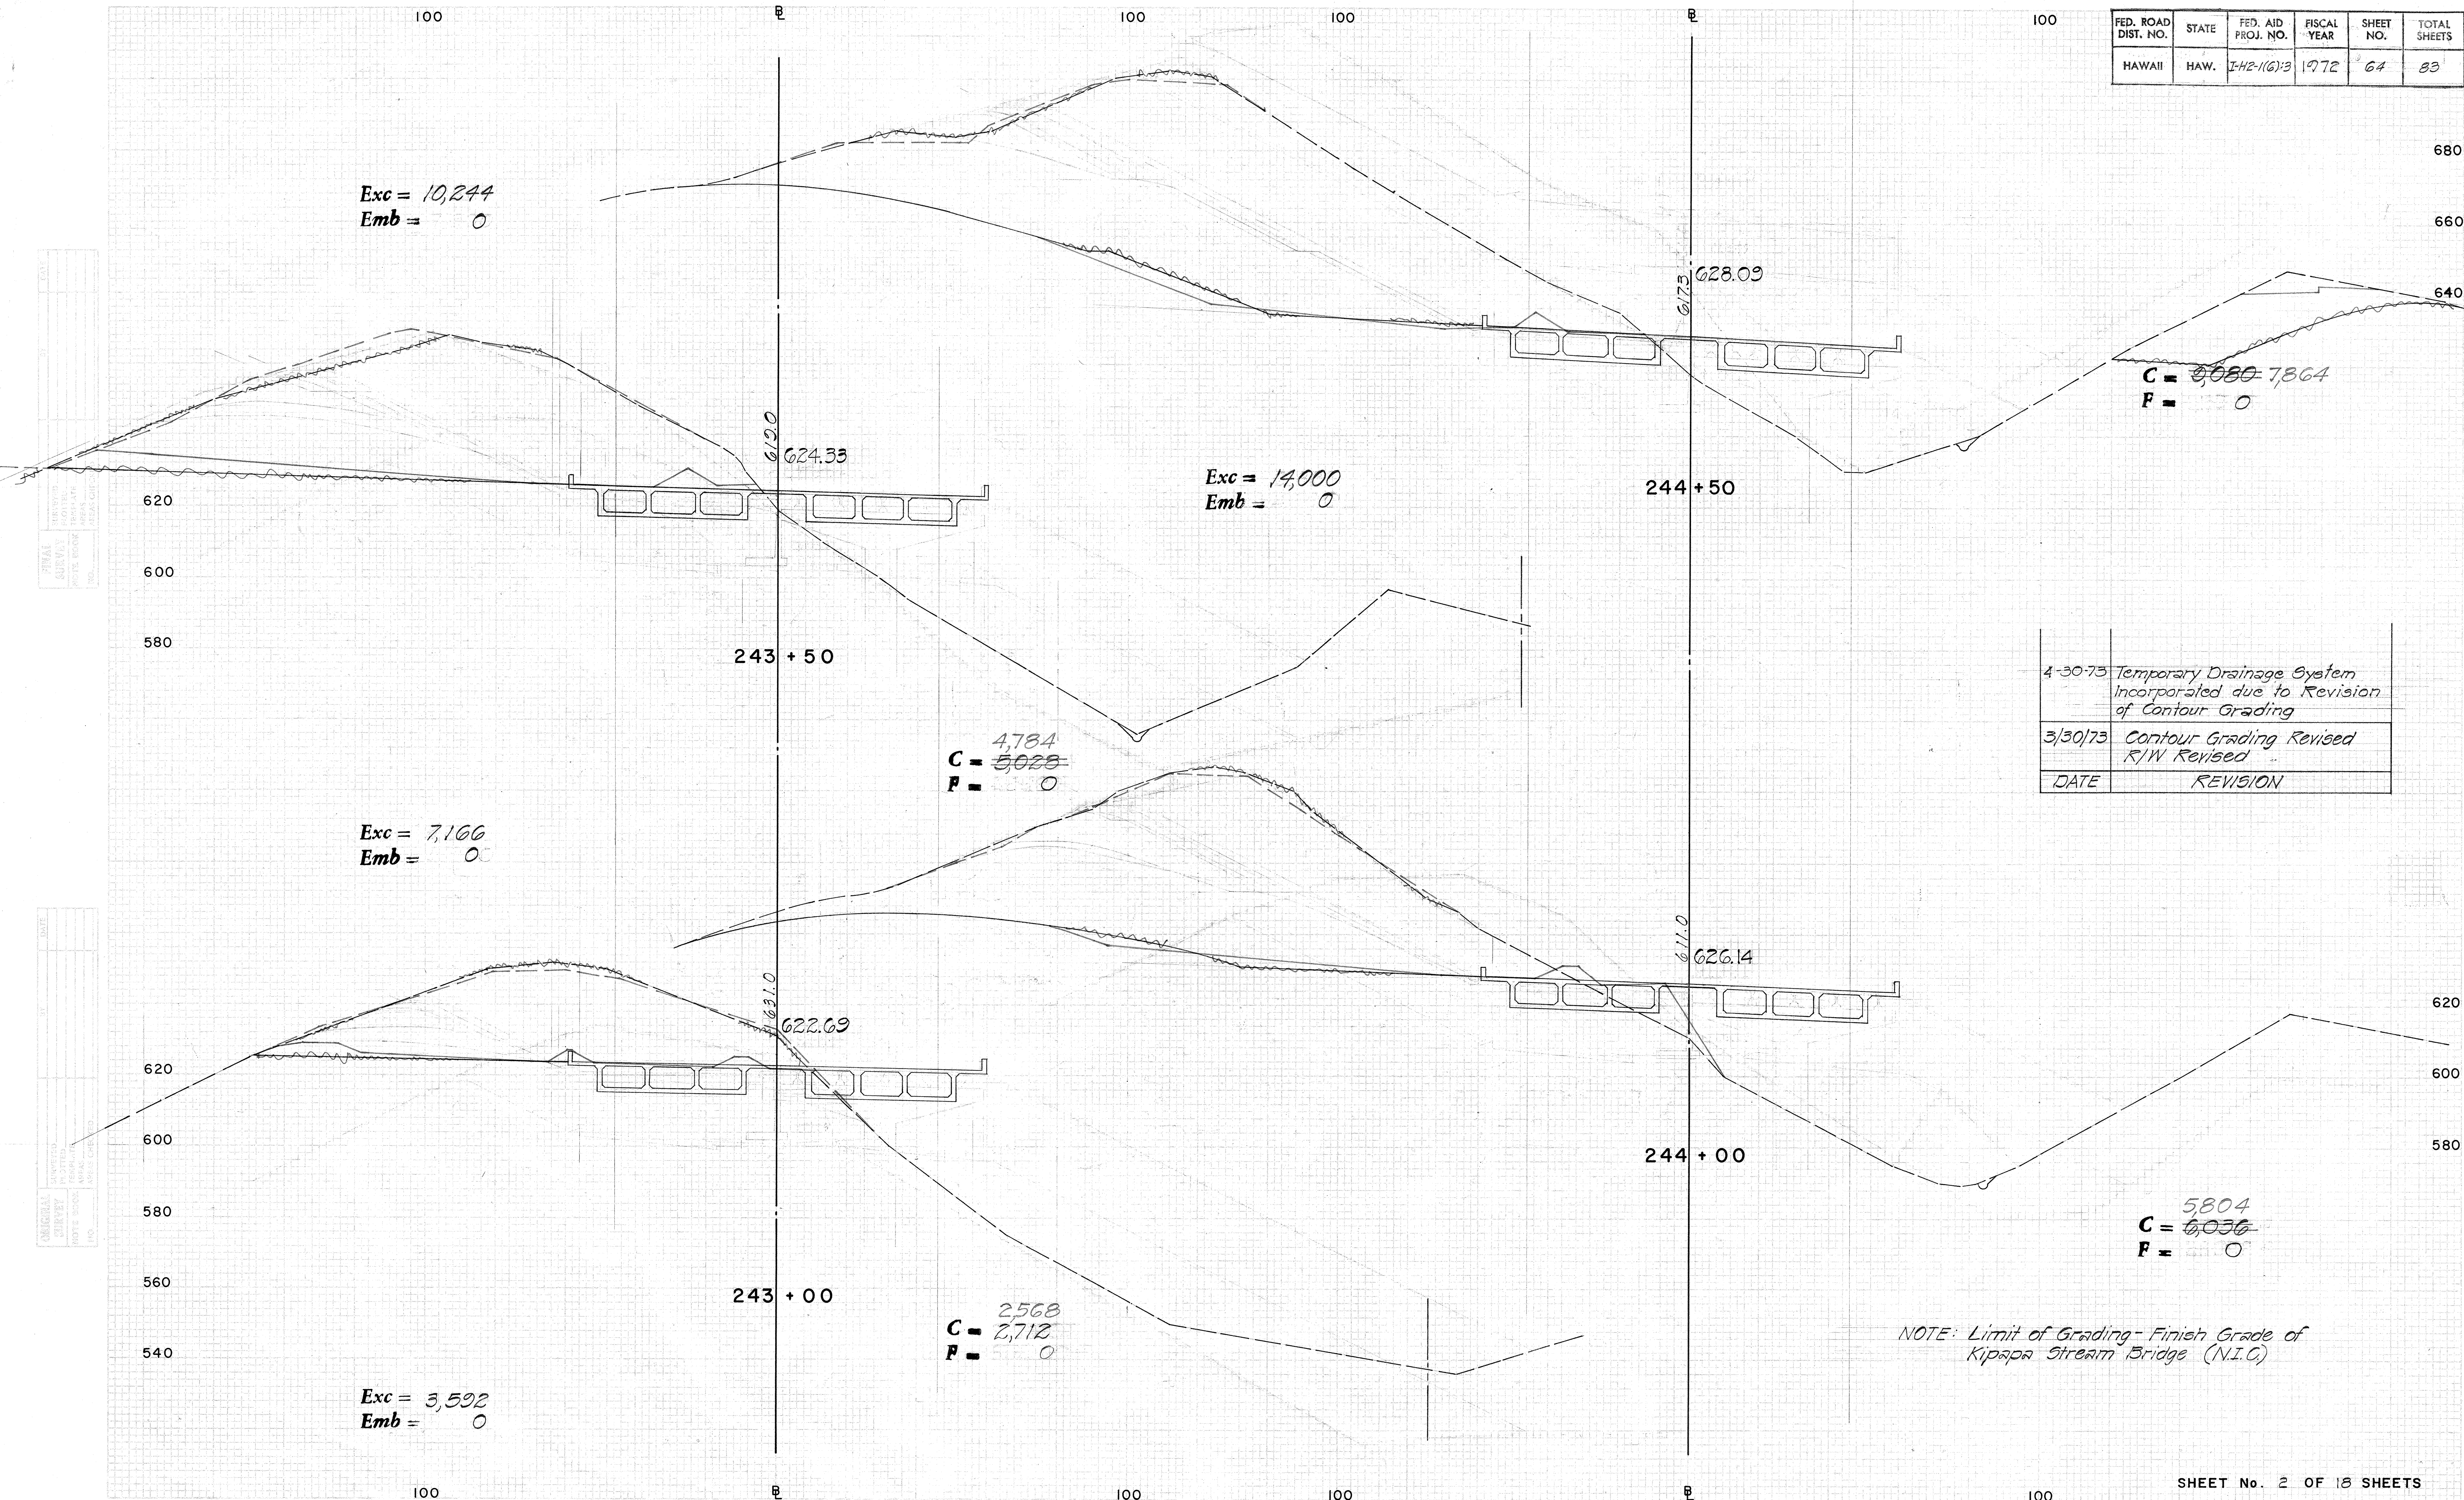

4-30-73	Temporary Drainage System Incorporated due to Revision of Contour Grading
3/30/73	Contour Grading Revised R/W Revised
DATE	REVISION

FED. ROAD DIST. NO.	STATE	FED. AID PROJ. NO.	FISCAL YEAR	SHEET NO.	TOTAL SHEETS
HAWAII	HAW.	I-H2-11613	1972	65	83

Exc = 22,818
Emb = 0

13,332
C = ~~15,508~~
P = 0

Exc = 20,086
Emb = 0

8,892
C = ~~11,156~~
P = 0

8,916
C = ~~10,388~~
P = 0


Exc = 15,052
Emb = 0

NOTE: Limit of Grading - Finish Grade of Kipapa Stream Bridge (N.I.C.)

4/30/73	Temporary Drainage System Incorporated due to Revision of Contour Grading.
3/30/73	Contour Grading Revised R/W Revised
DATE	REVISION

SHEET No. 3 OF 18 SHEETS

C.O. 65

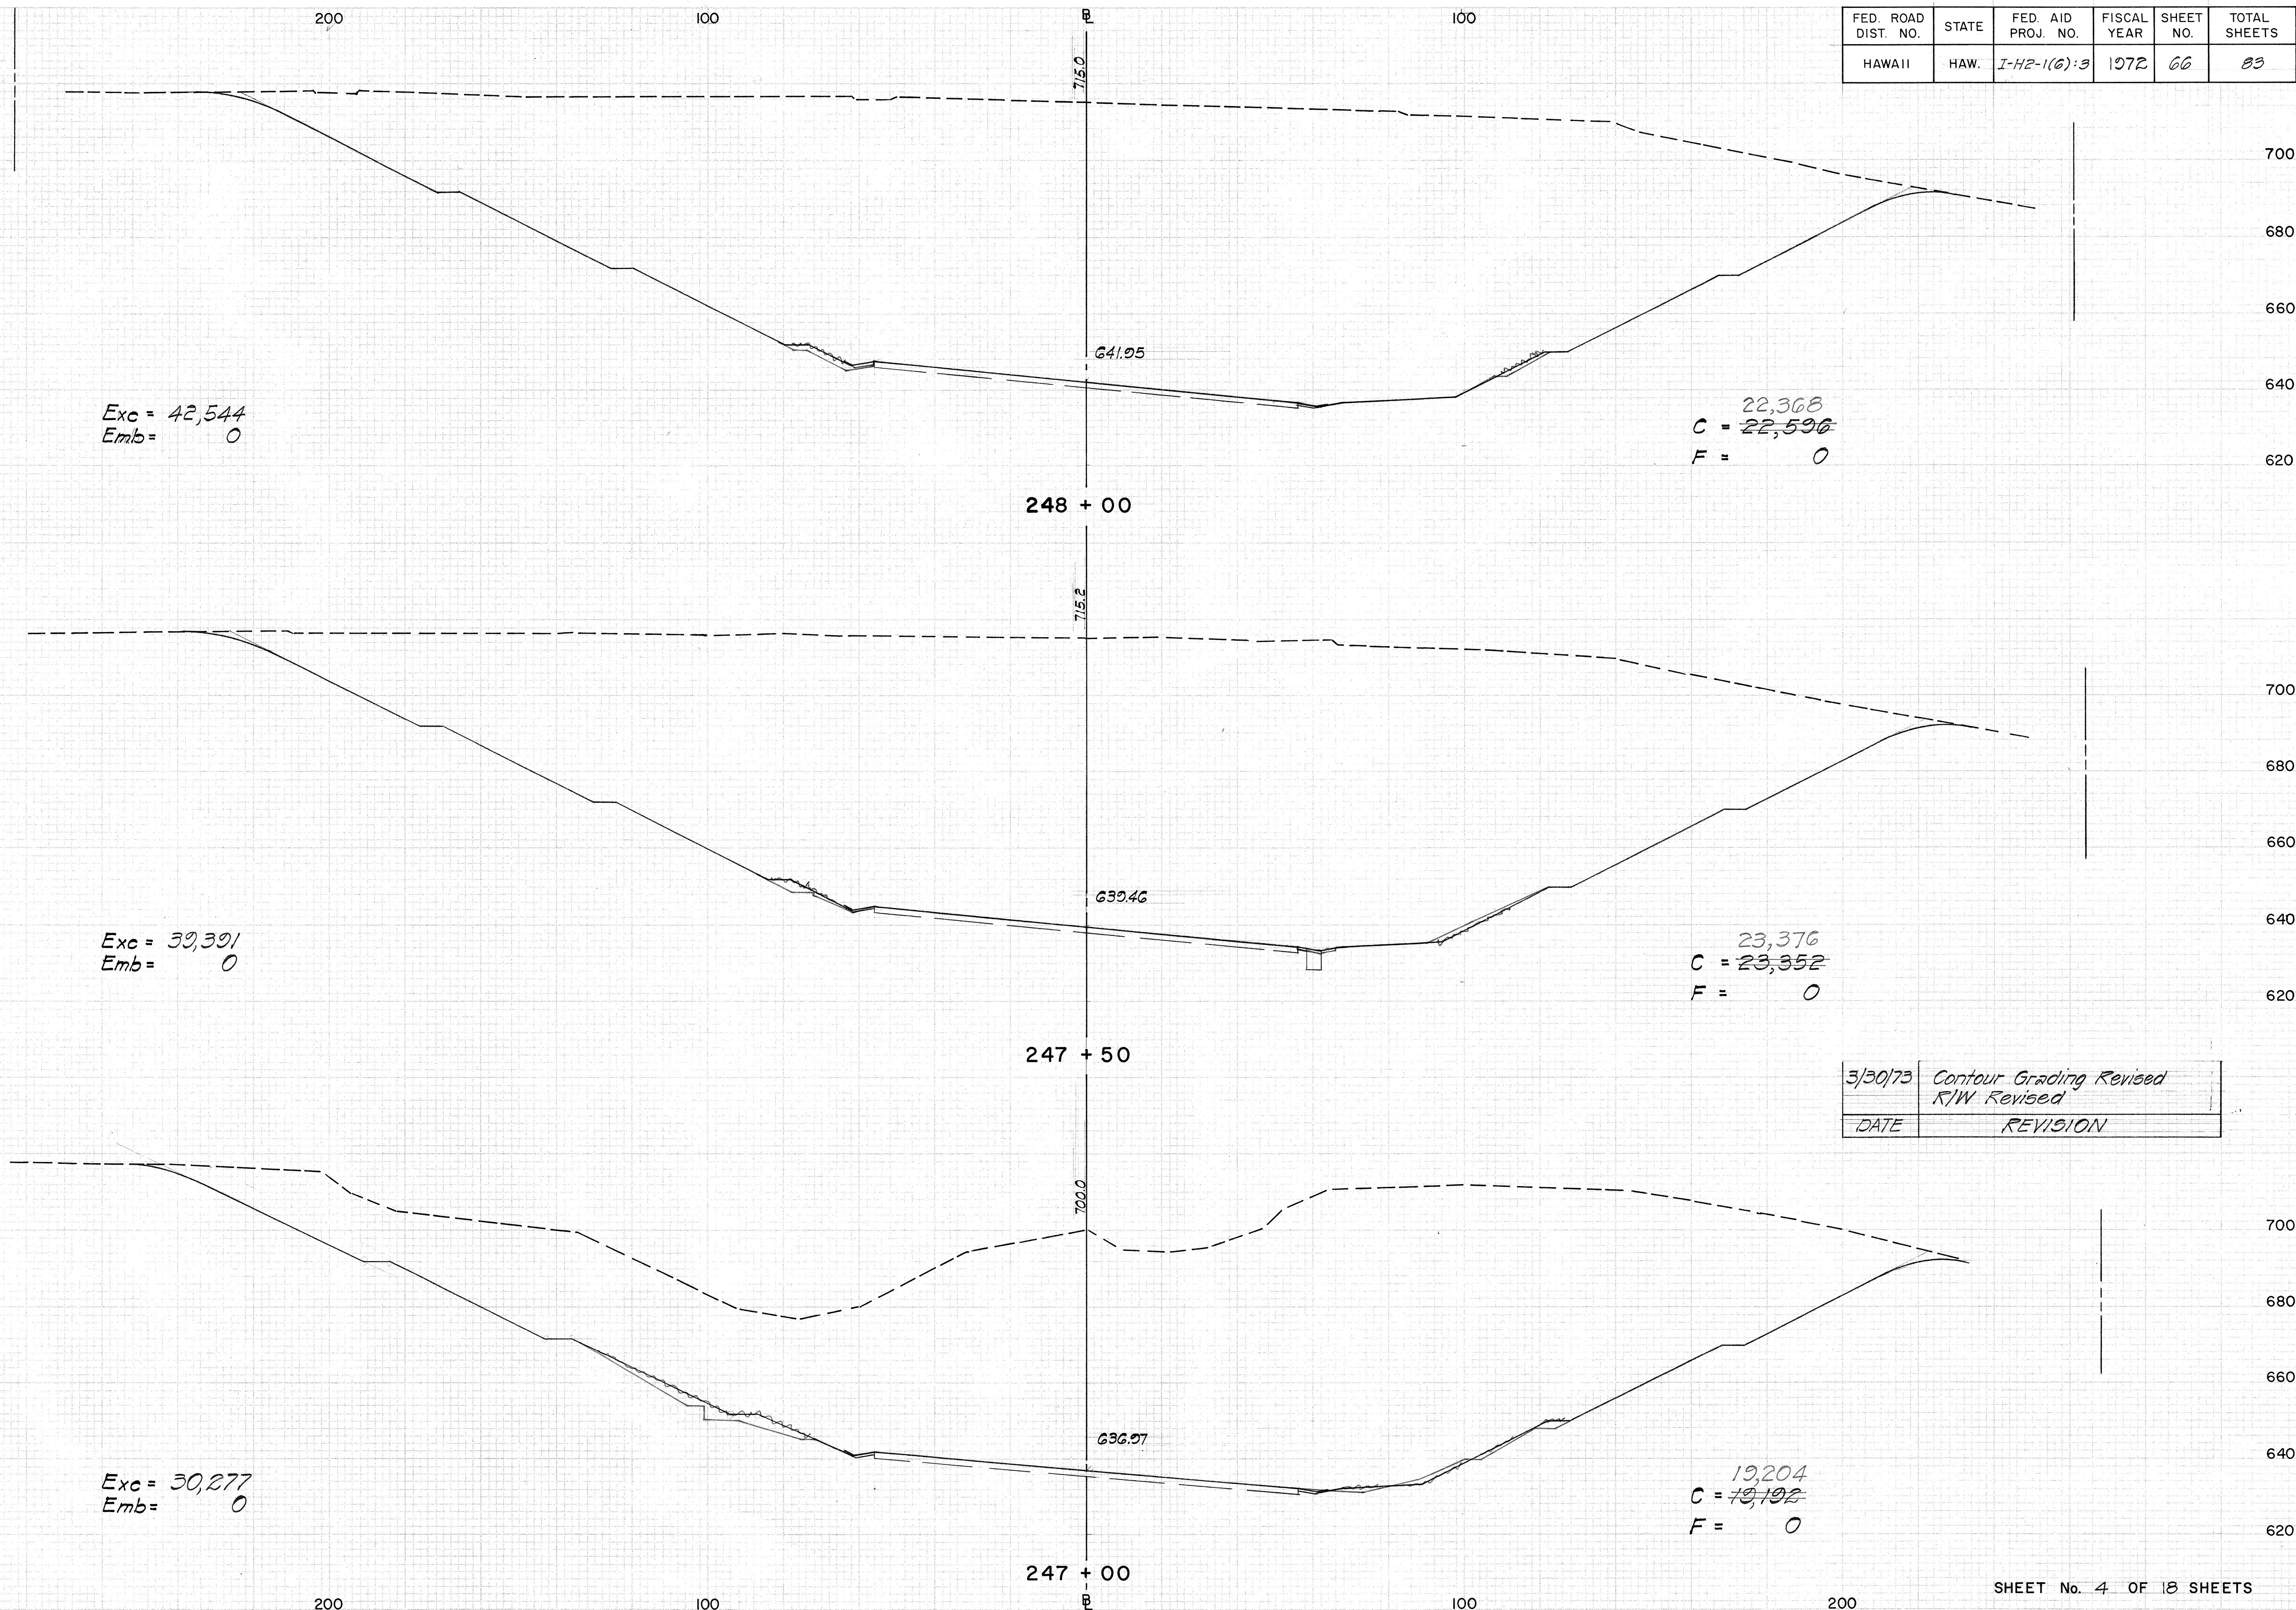


SHEET No. 4 OF 18 SHEETS

C.O. 66

PLATE 3-CROSS SECTION, P.A.S.
CLEARPRINT PAPER CO., S.F. CAL. NO. 1000H

FED. ROAD DIST. NO.	STATE	FED. AID PROJ. NO.	FISCAL YEAR	SHEET NO.	TOTAL SHEETS
HAWAII	HAW.	I-H2-1(6)-3	1972	73	83

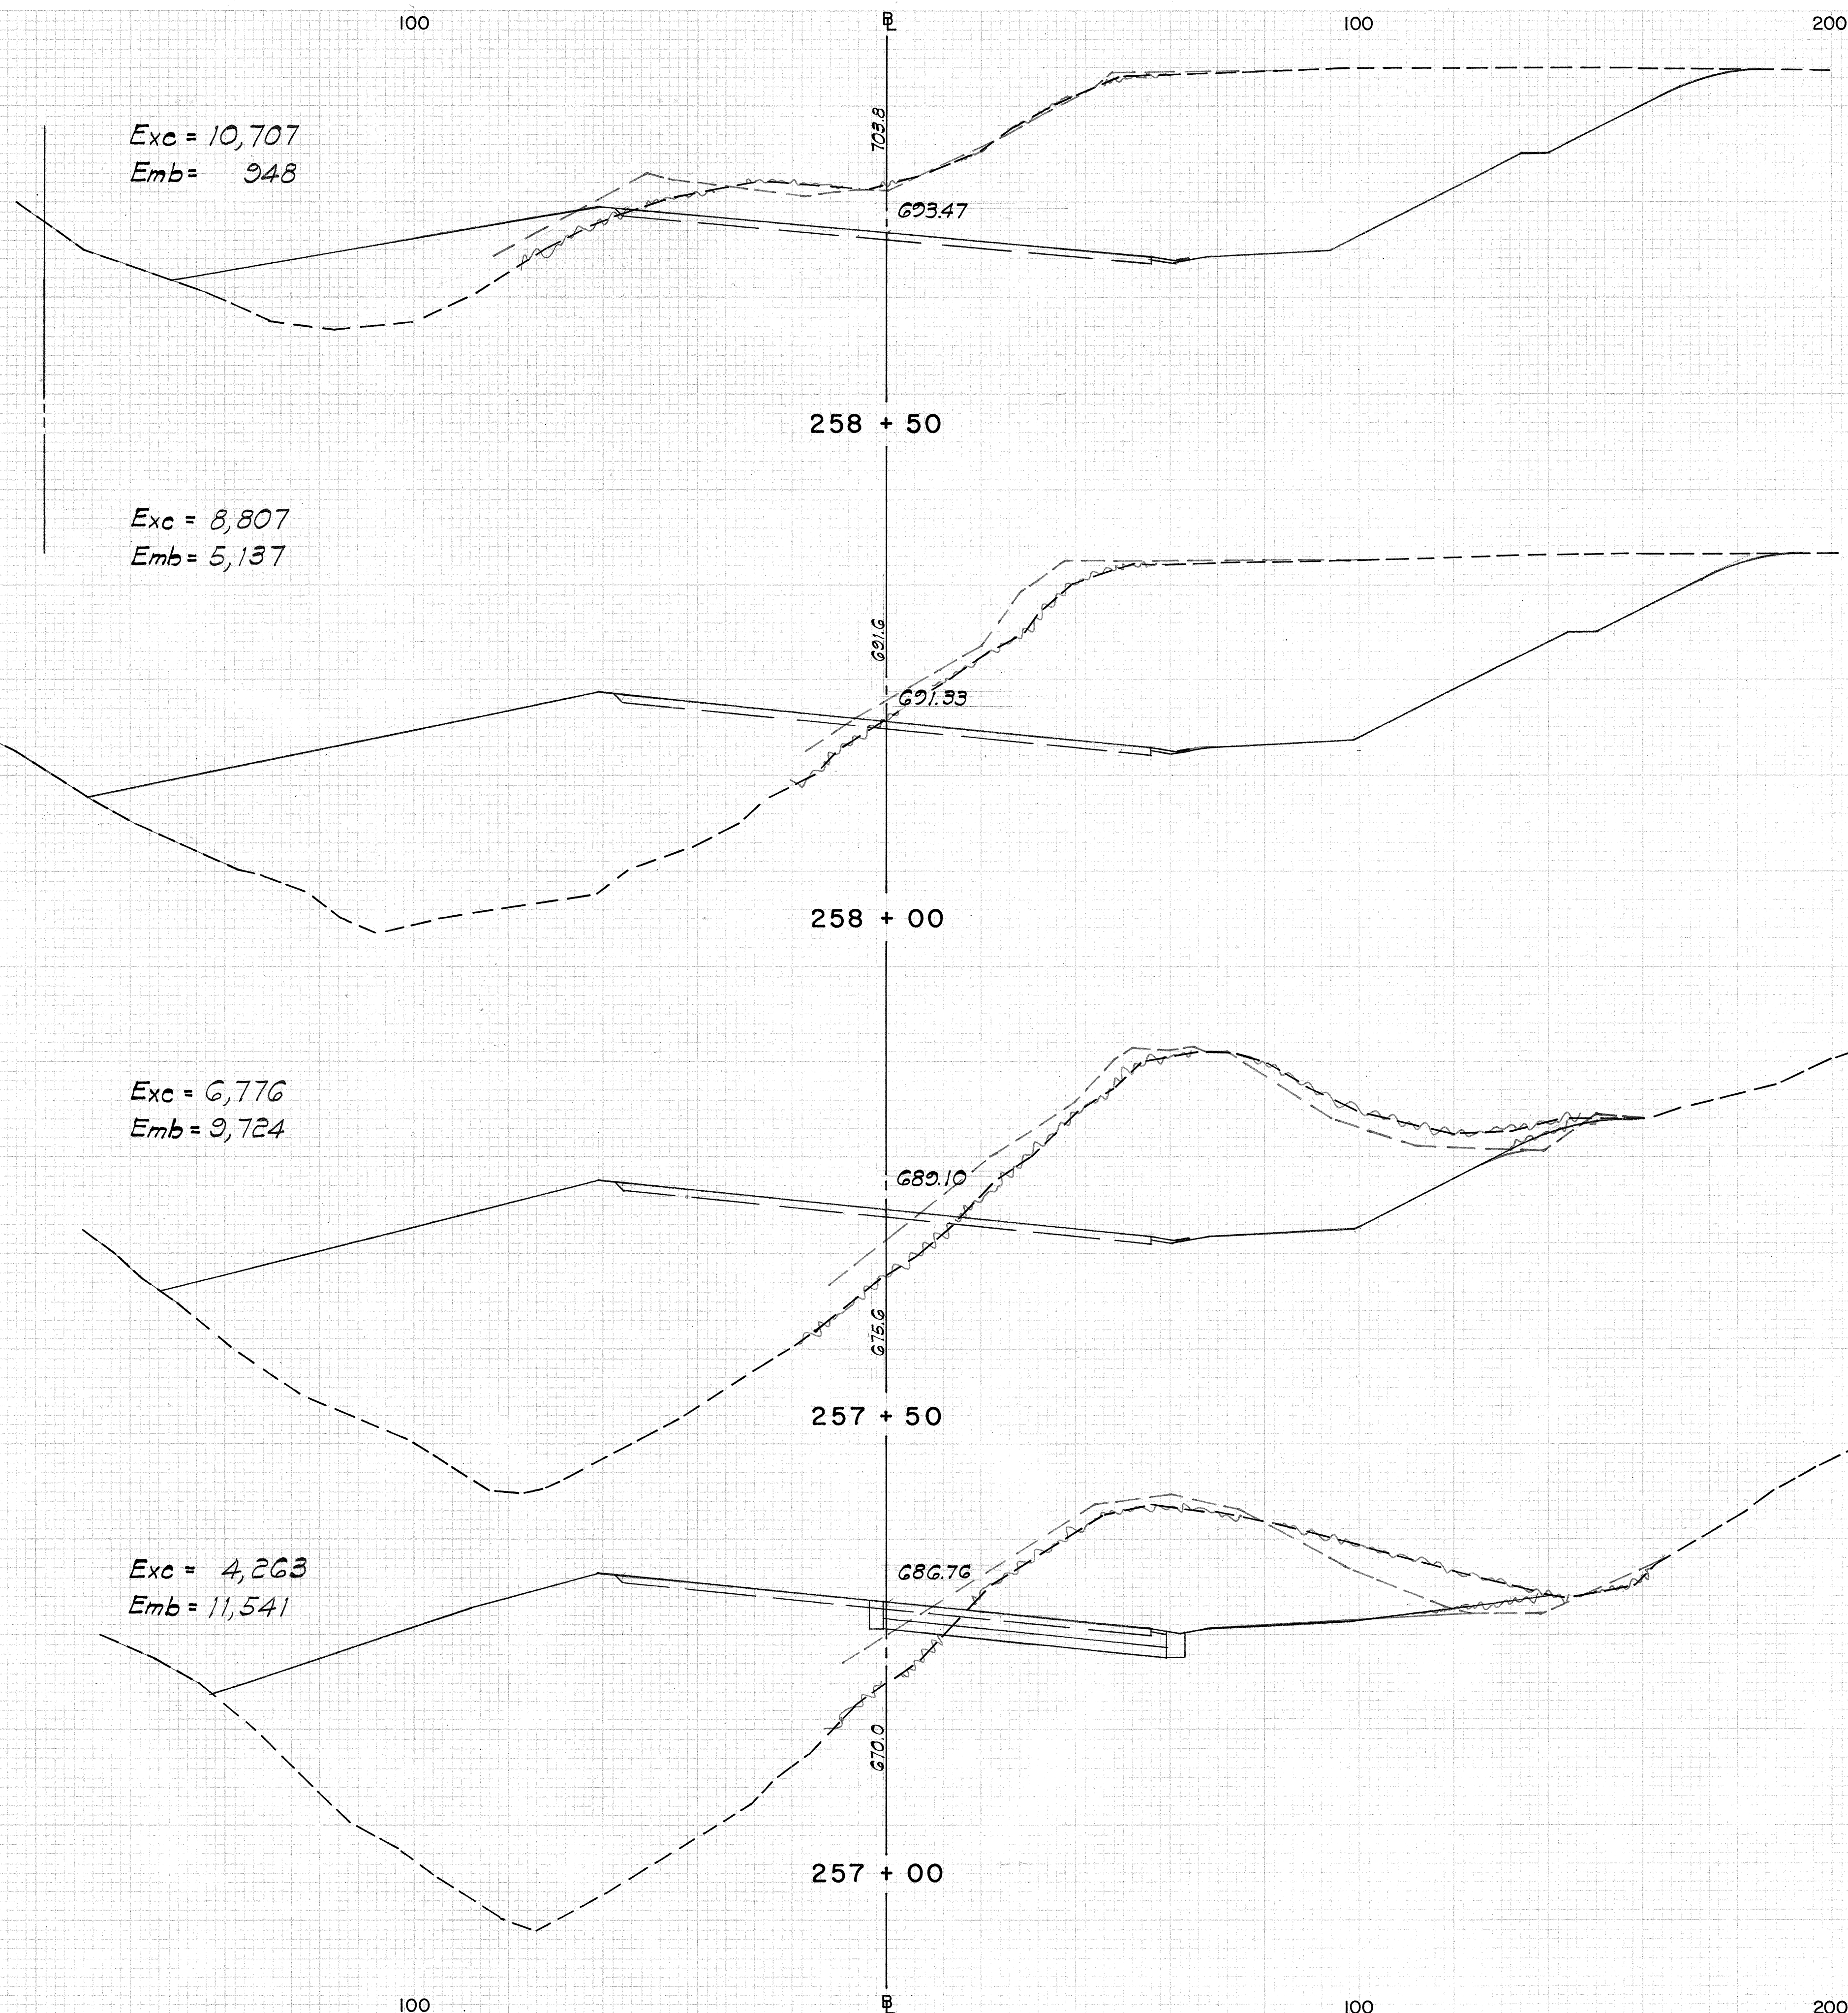

FED. ROAD DIST. NO.	STATE	FED. AID PROJ. NO.	FISCAL YEAR	SHEET NO.	TOTAL SHEETS
HAWAII	HAW.	I-H2-1(6)-3	1972	74	83

FINAL SURVEY	DATE	
	BY	
	SUPERVISED	
	NO. _____	
NO. _____	NO. _____	
	NO. _____	
	NO. _____	
	NO. _____	

ORIGINAL SURVEY	DATE	
	BY	
	SUPERVISED	
	NO. _____	
NO. _____	NO. _____	
	NO. _____	
	NO. _____	
	NO. _____	



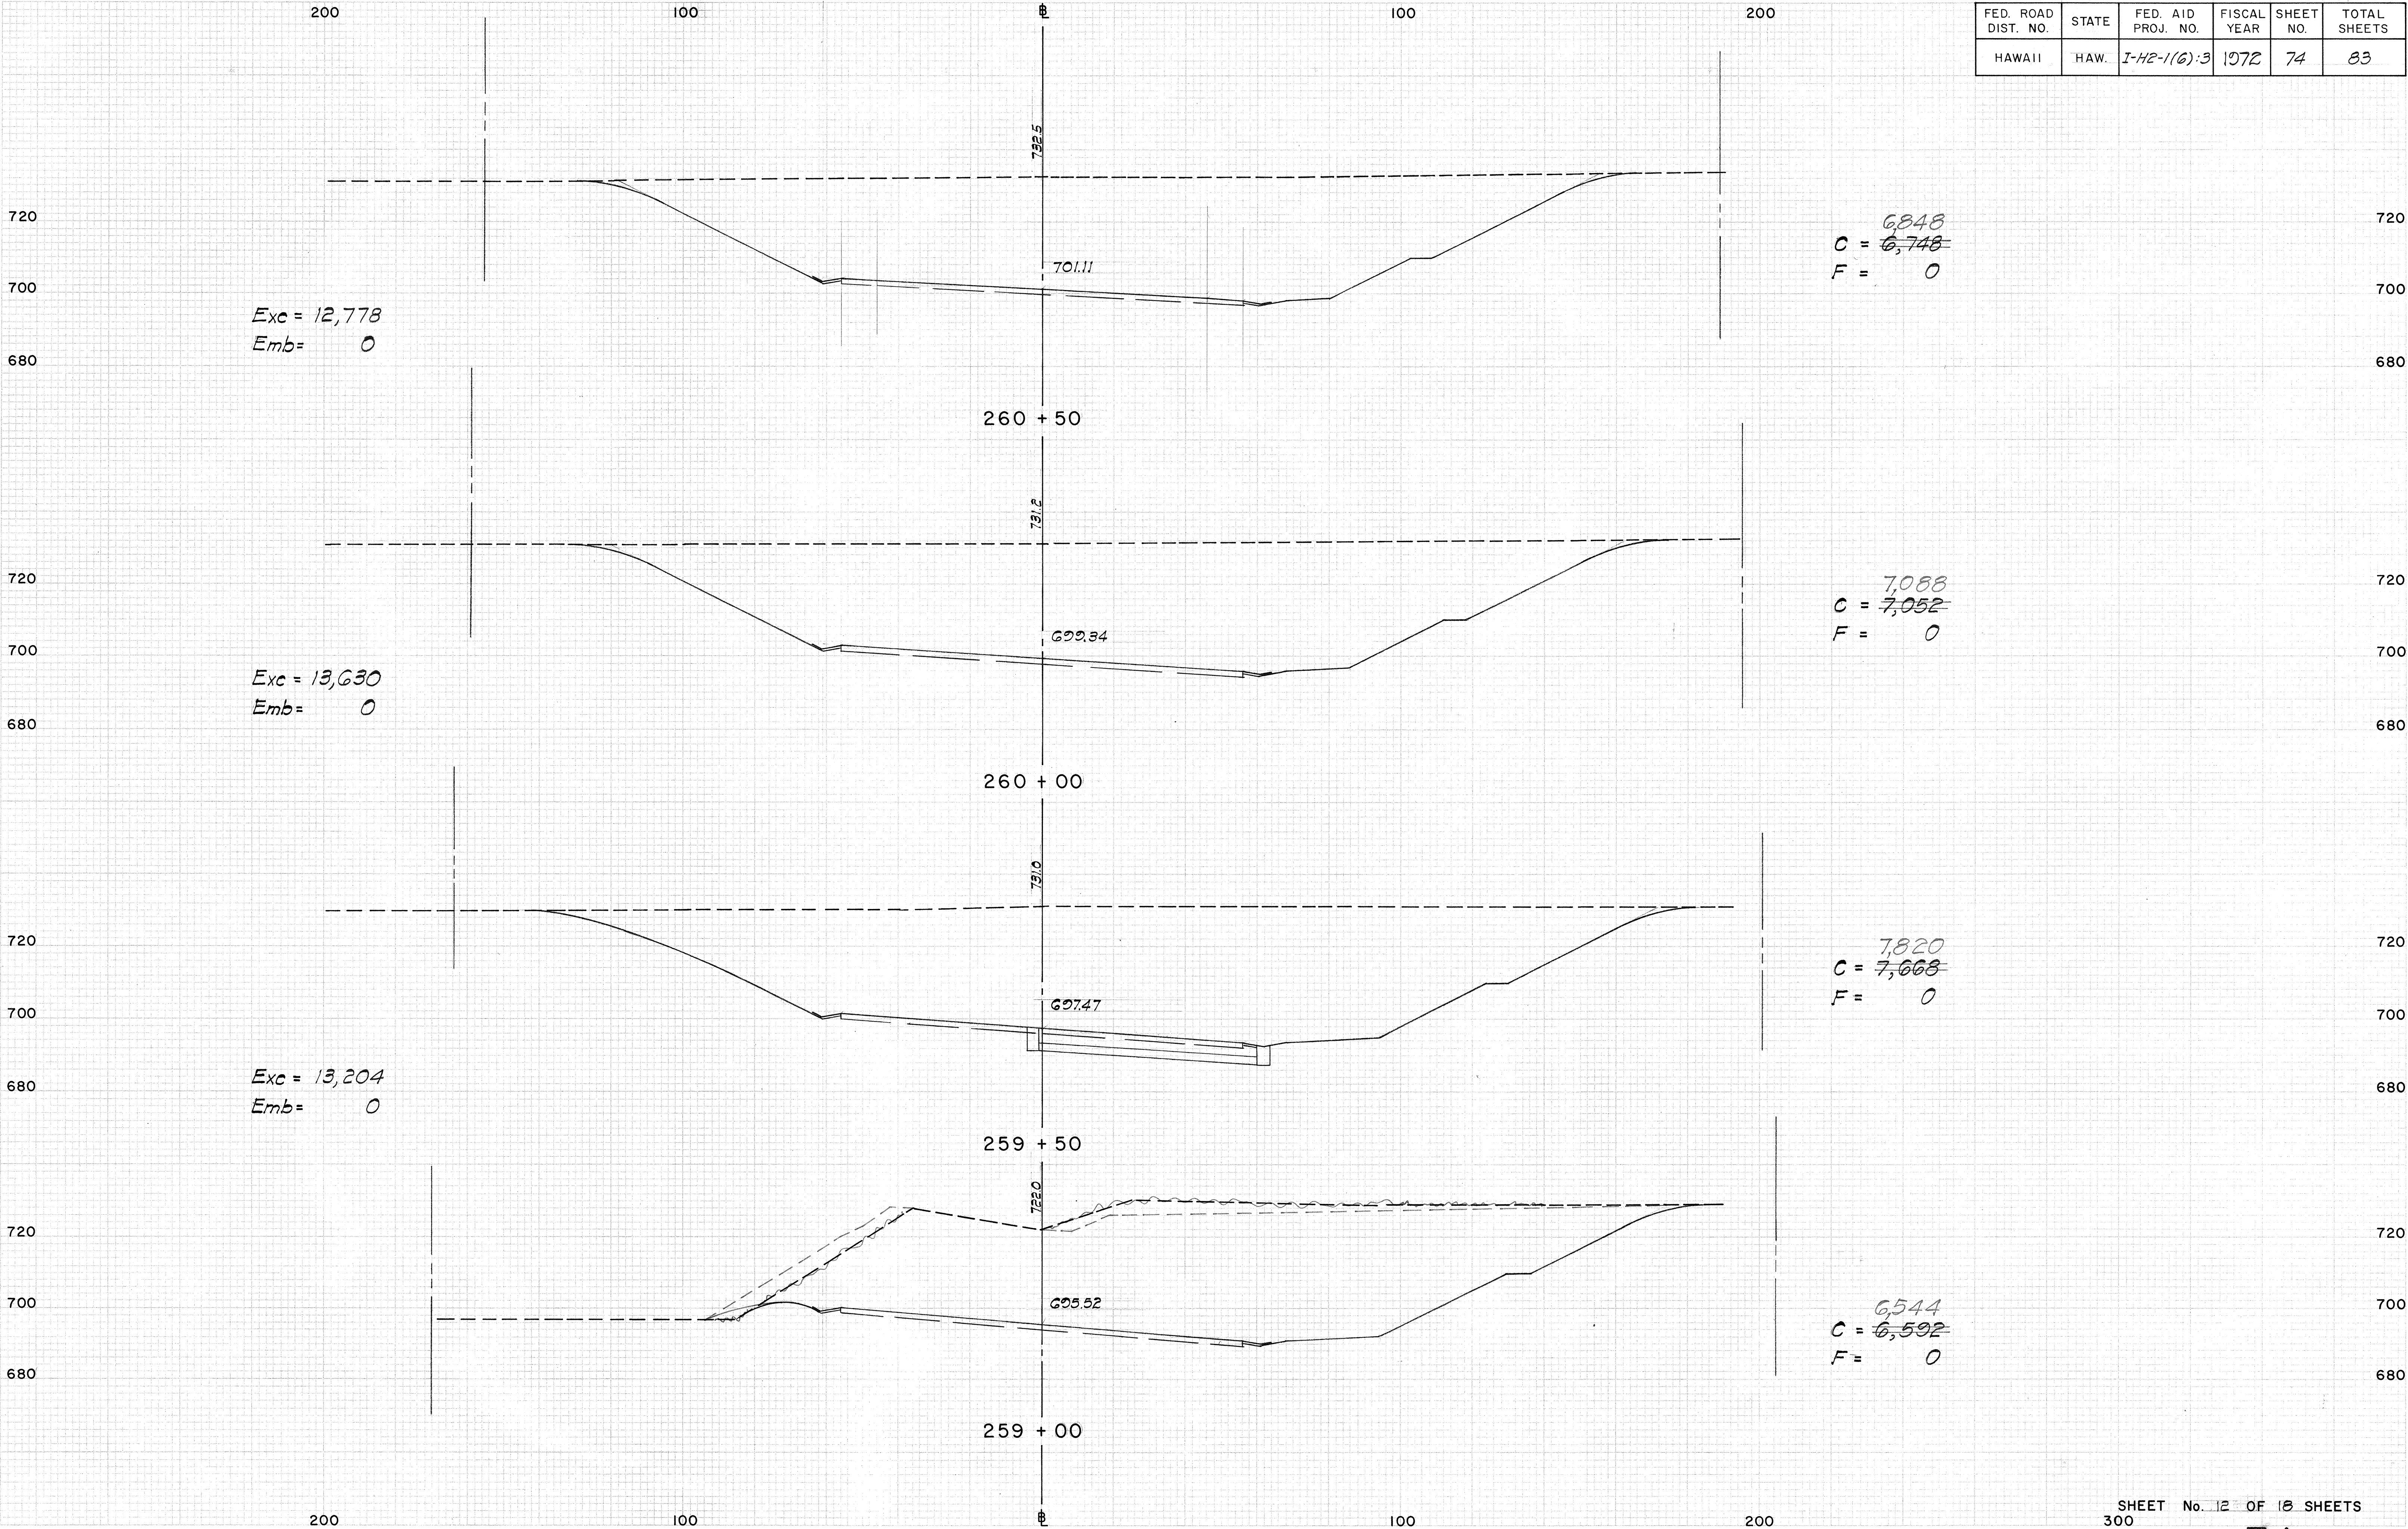



PLATE 3 - CROSS SECTION, P.A.S.
CLEARPRINT PAPER CO., S.F. CAL.
NO. 100H-3

FED. ROAD DIST. NO.	STATE	FED. AID PROJ. NO.	FISCAL YEAR	SHEET NO.	TOTAL SHEETS
HAWAII	HAW.	I-HE-1(6)3	1972	76	83

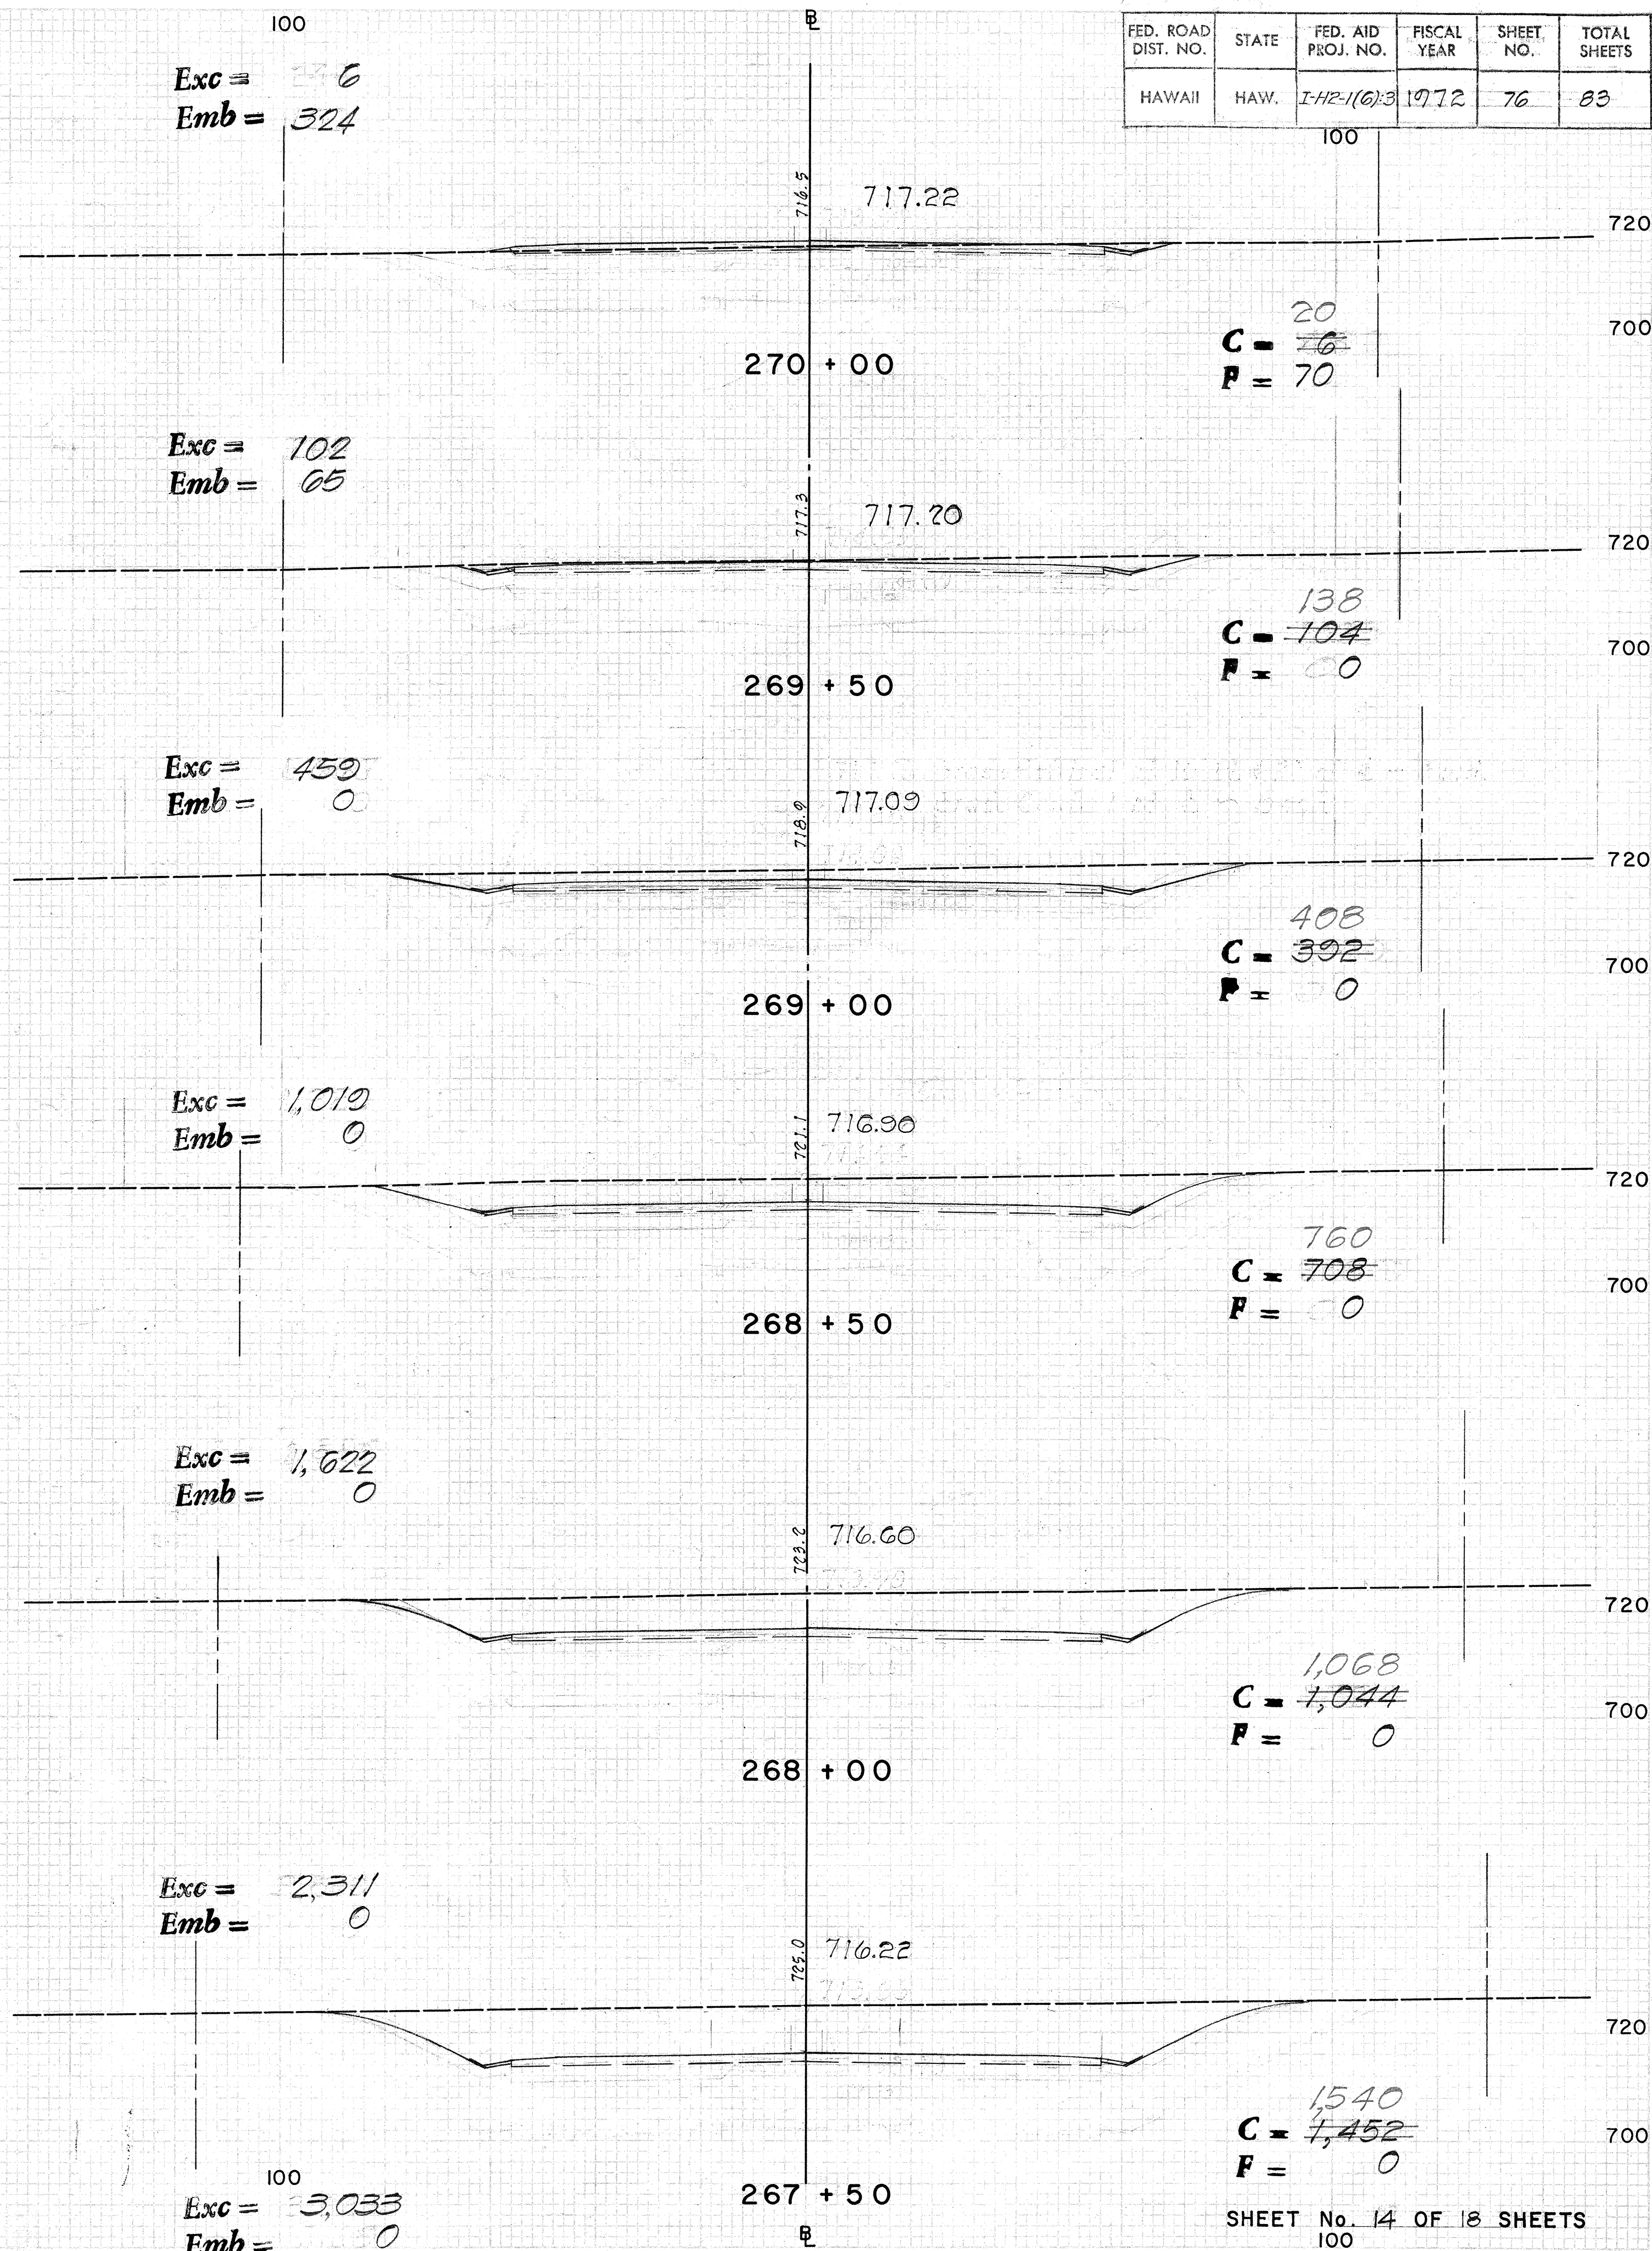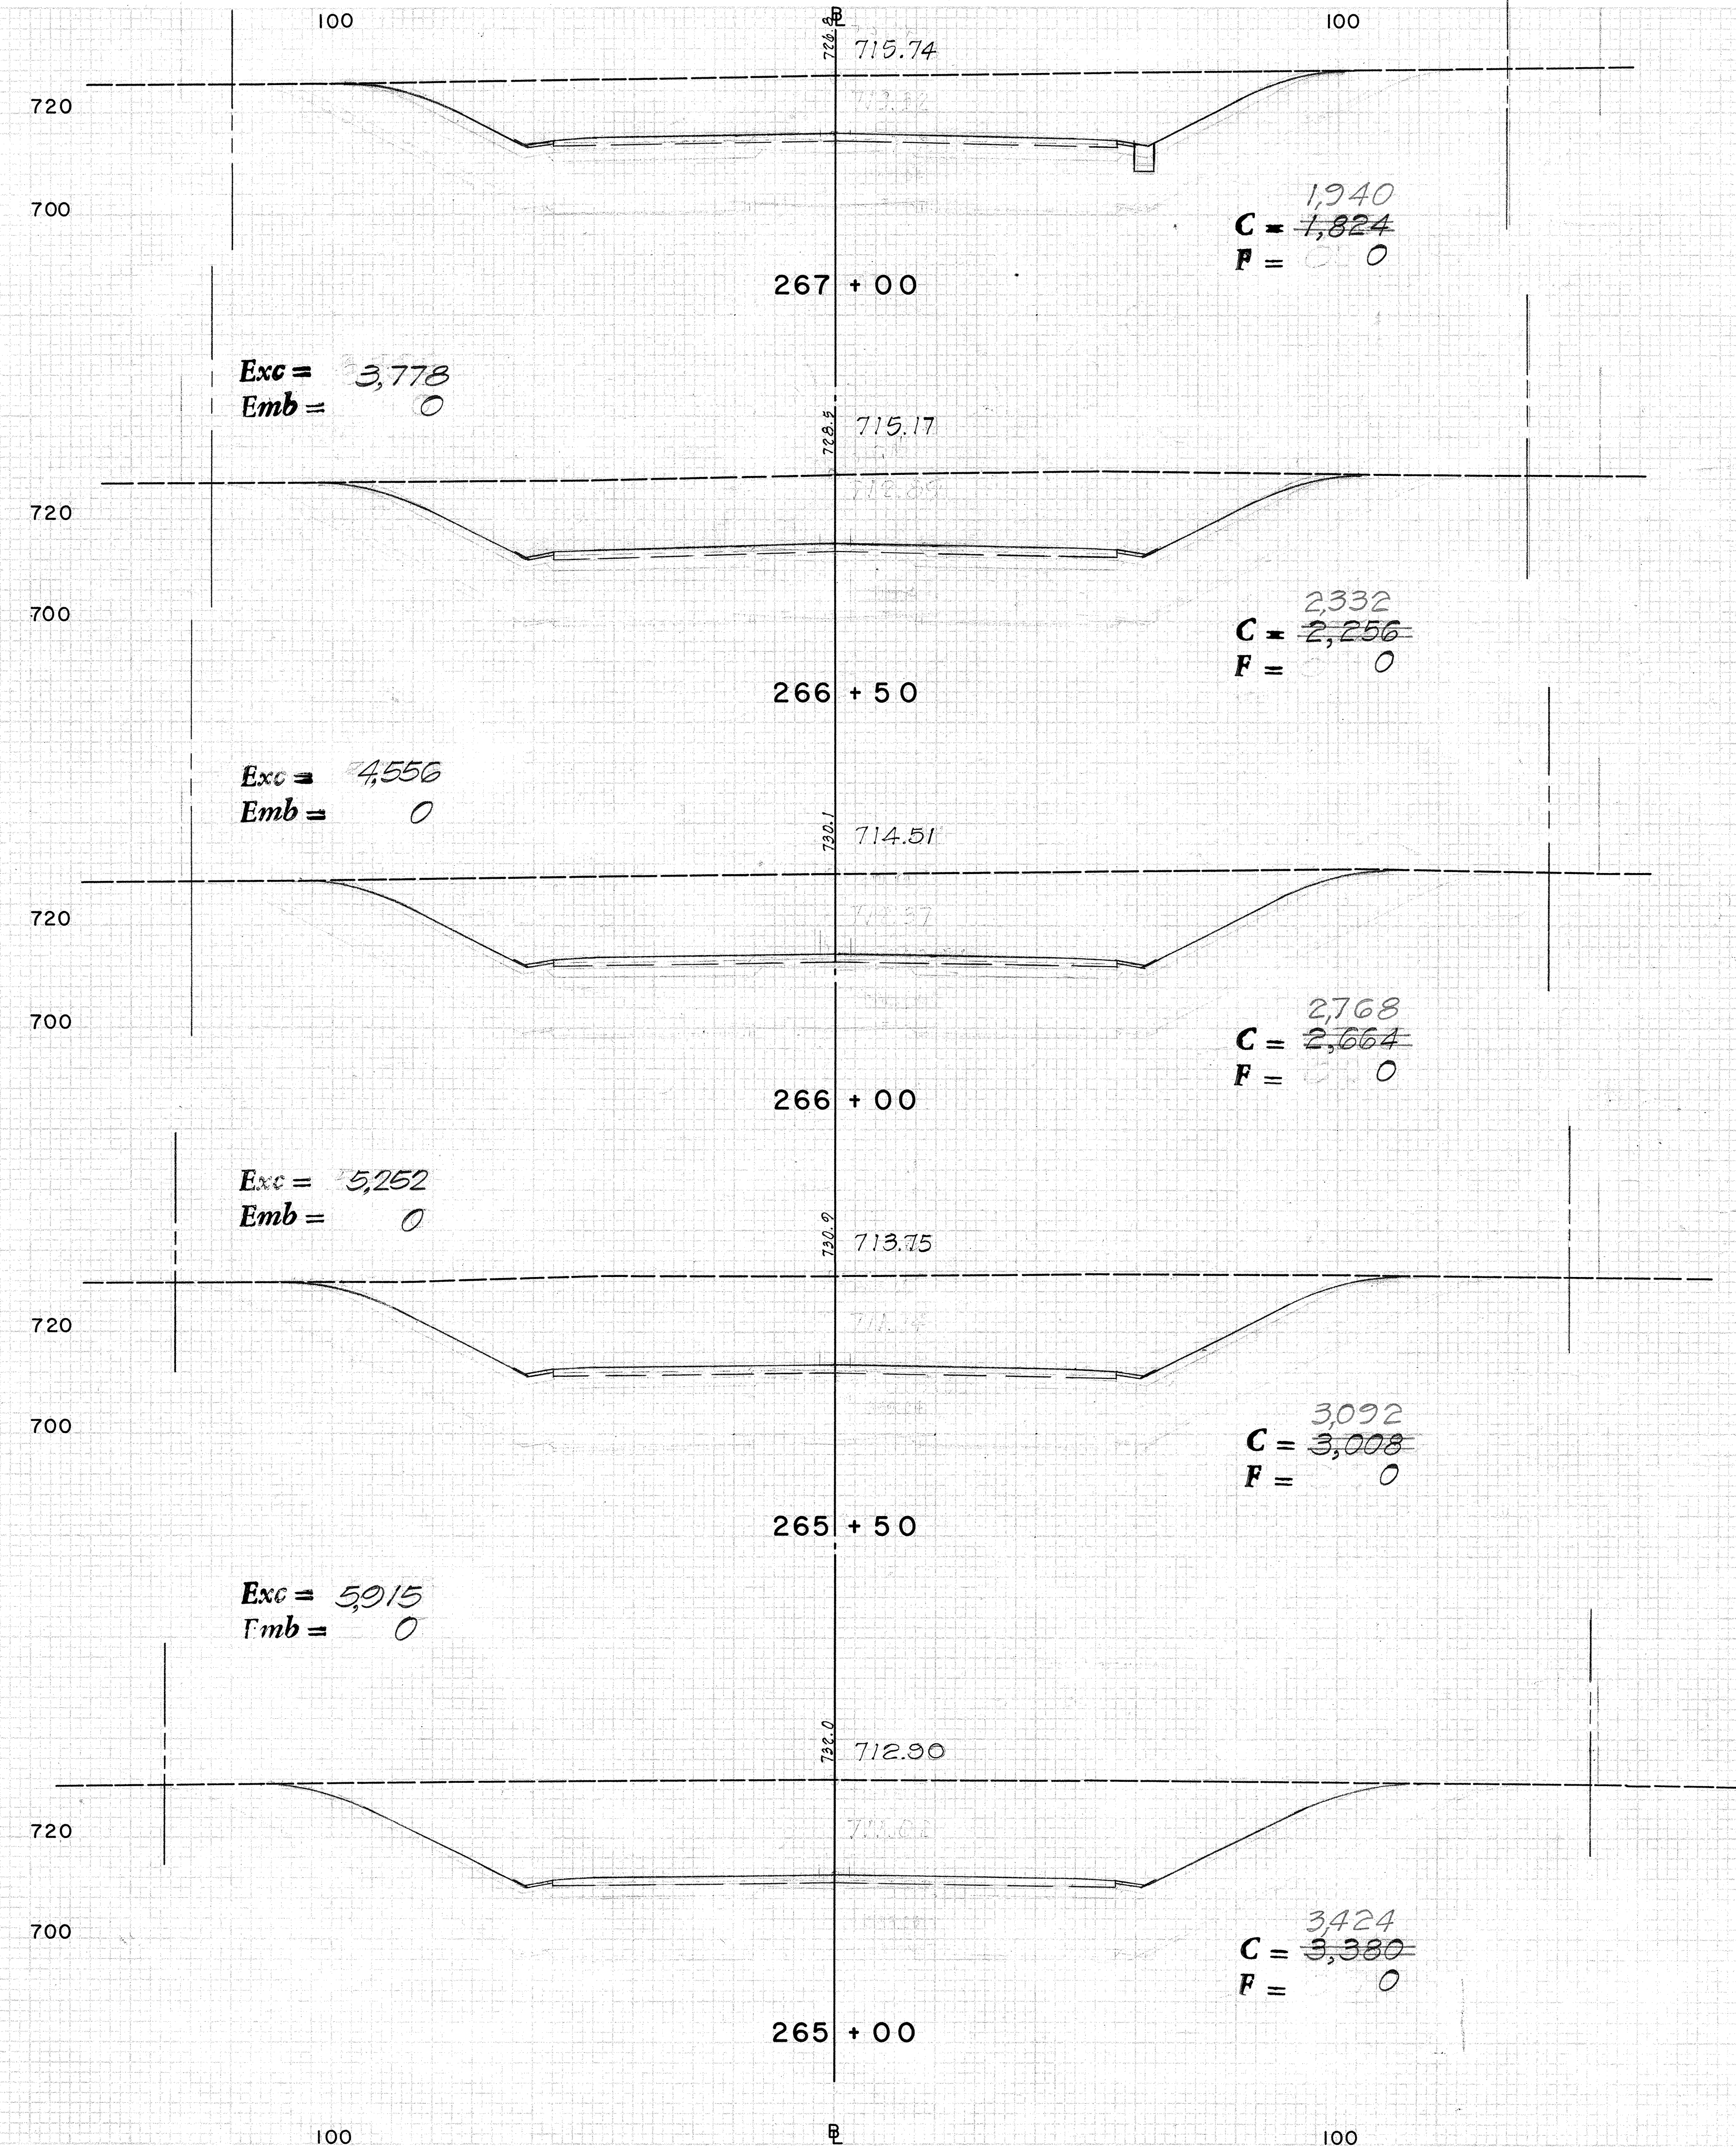


SHEET No. 14 OF 18 SHEETS
100

FED. ROAD DIST. NO.	STATE	FED. AID PROJ. NO.	FISCAL YEAR	SHEET NO.	TOTAL SHEETS
HAWAII	HAW.	I-42-1(6)3	1972	77	83

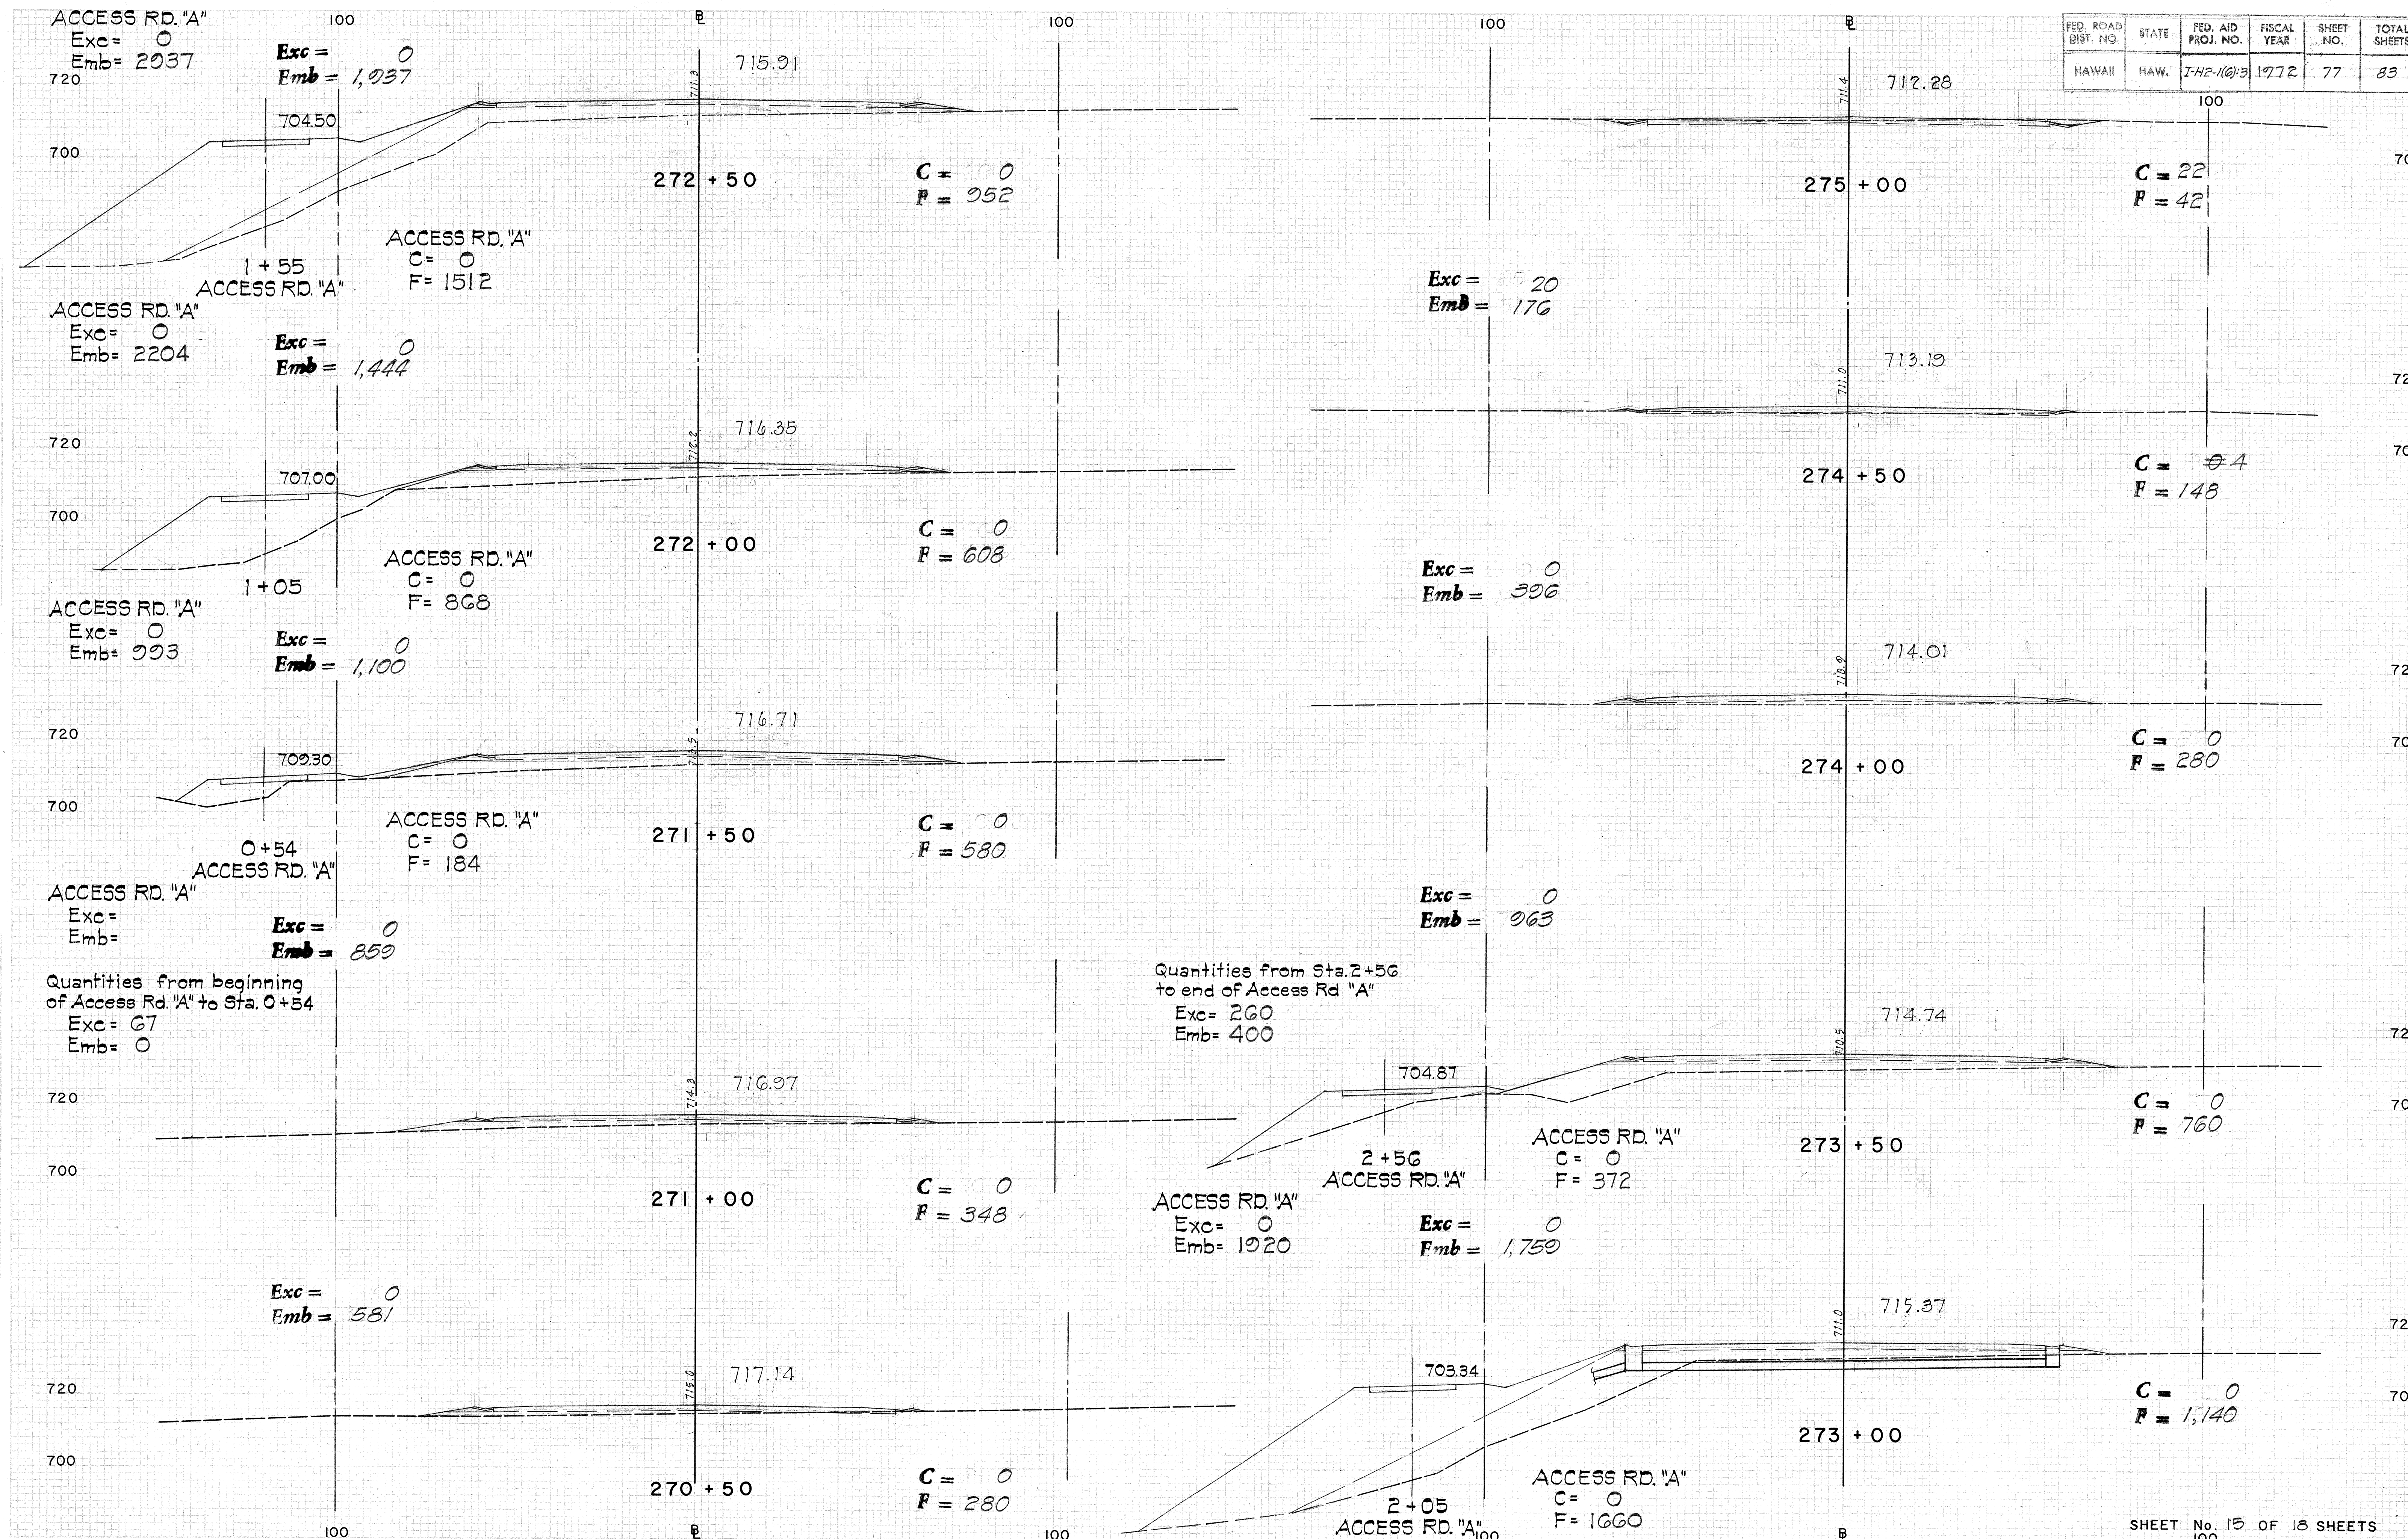



SHEET No. 15 OF 18 SHEETS

FED. ROAD DIST. NO.	STATE	FED. AID PROJ. NO.	FISCAL YEAR	SHEET NO.	TOTAL SHEETS
HAWAII	HAW.	I-H2-1(6)3	1972	78	83

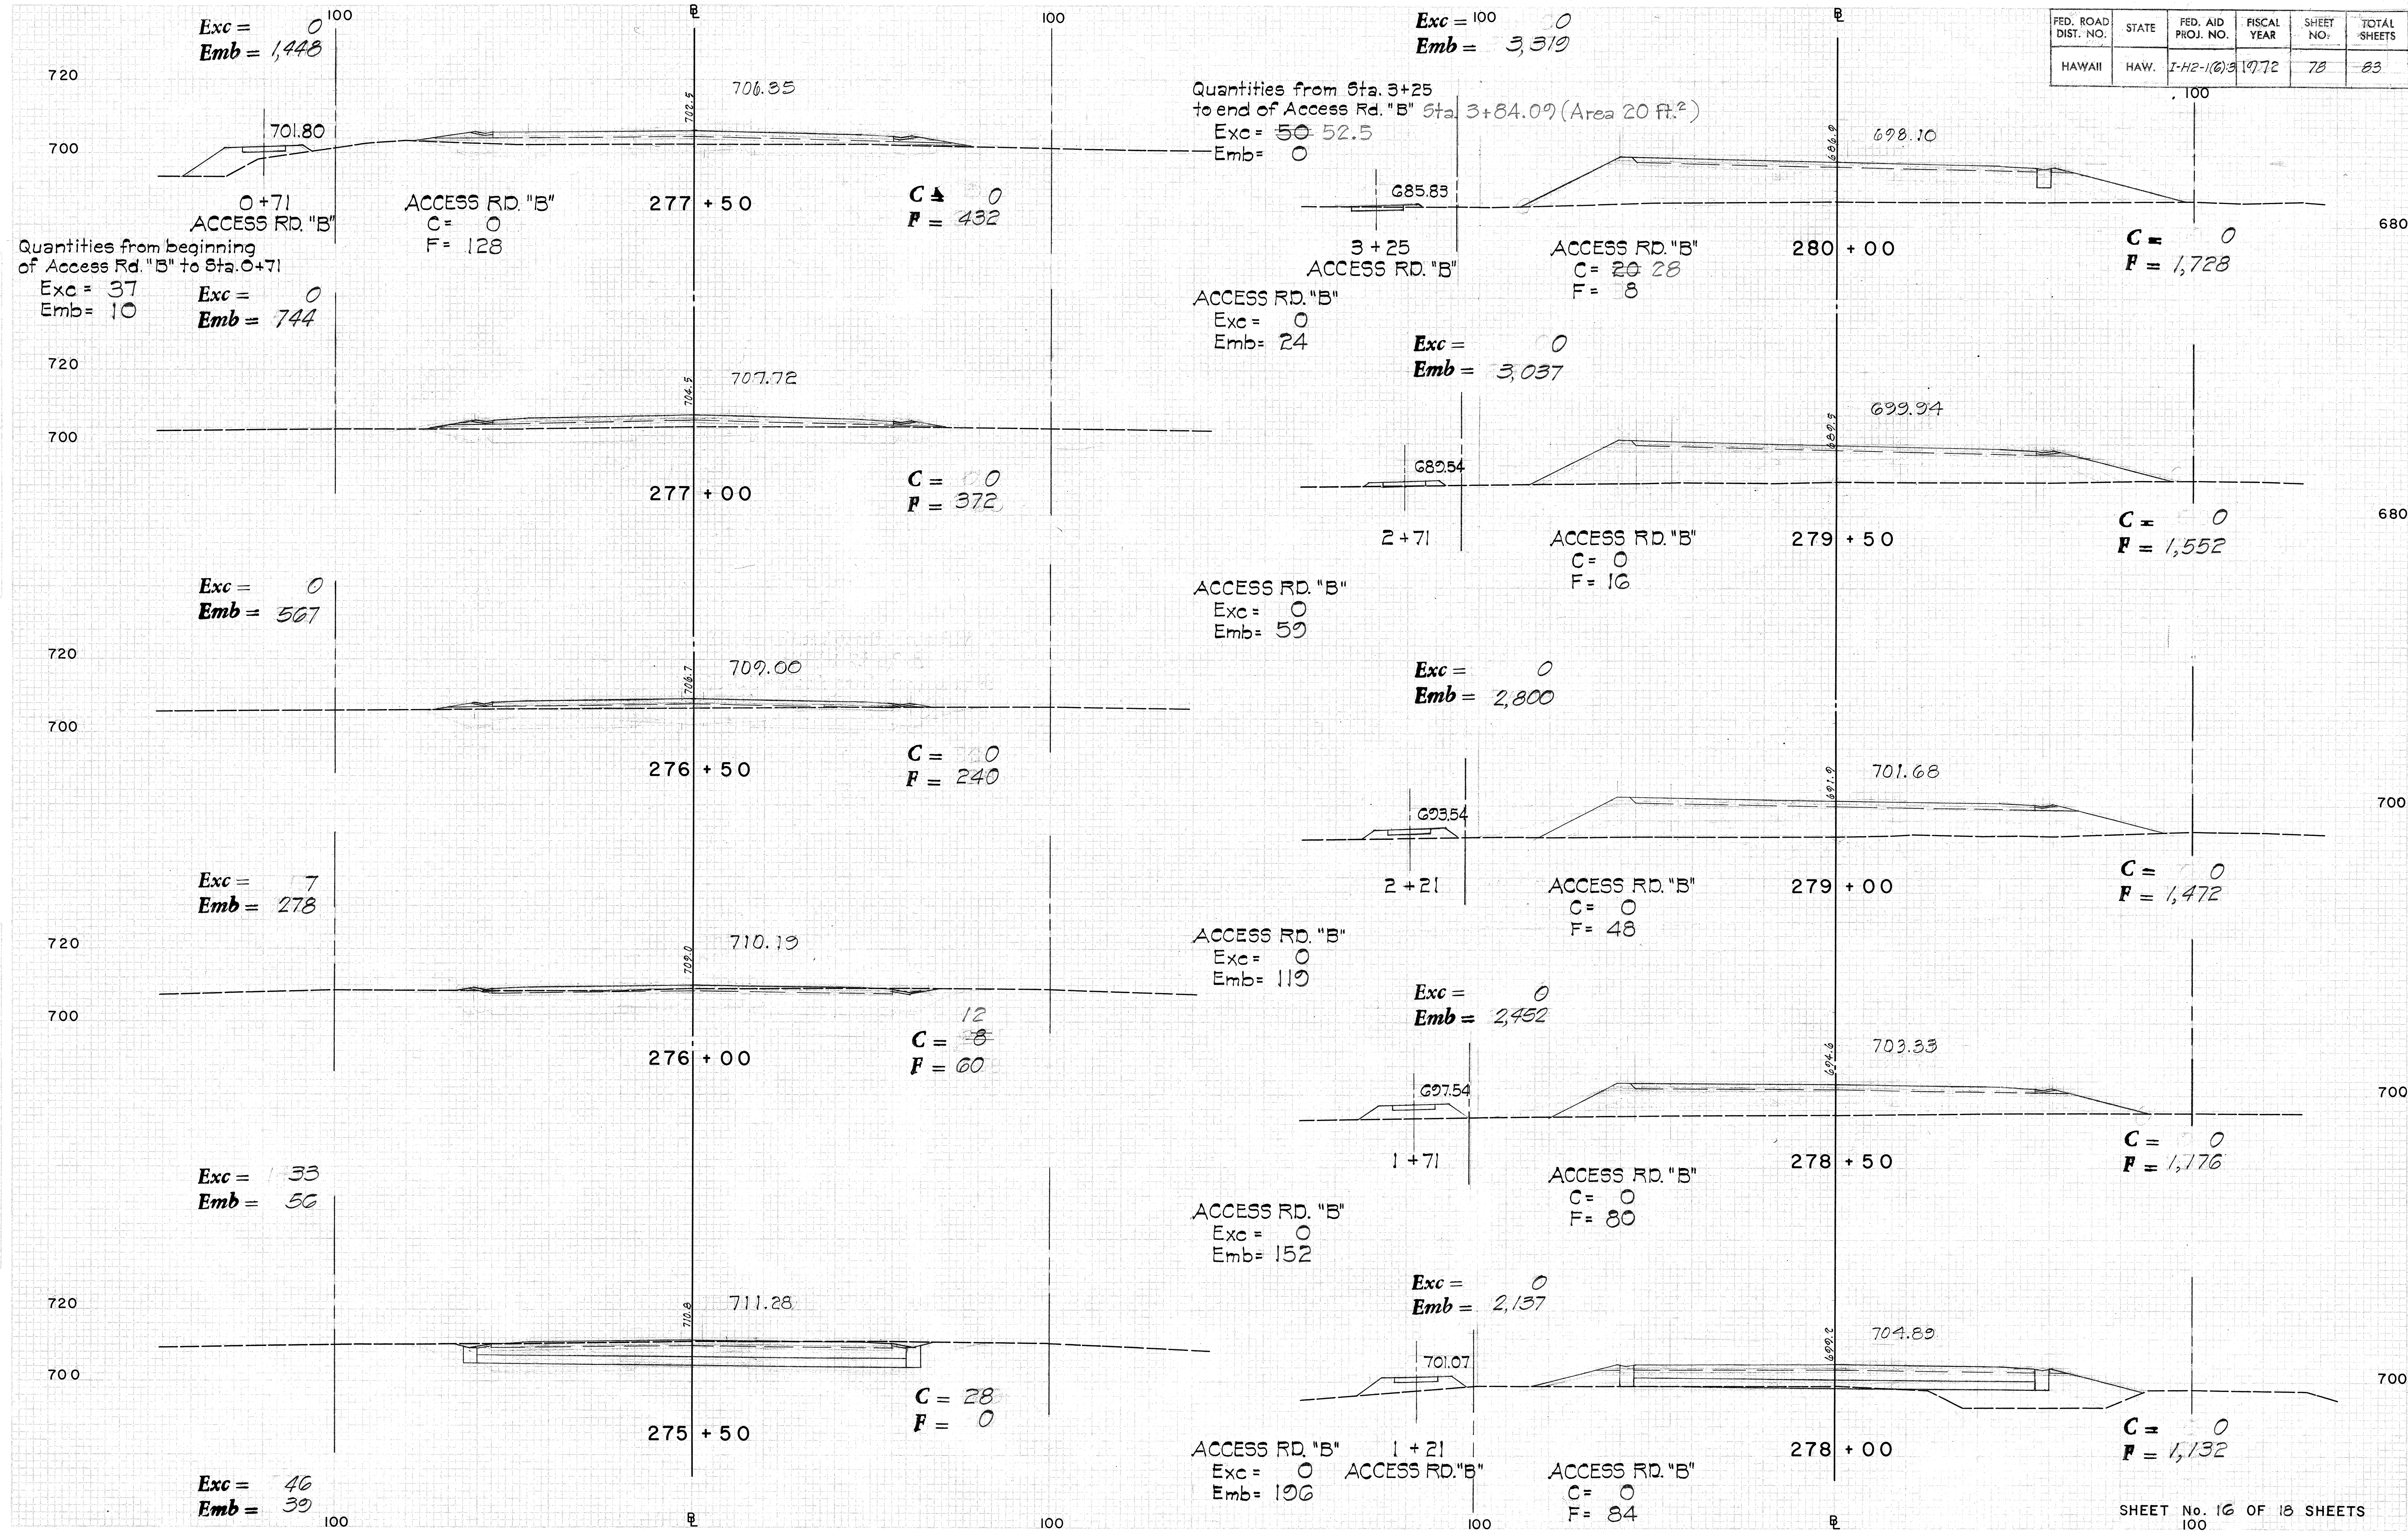

FED. ROAD DIST. NO.	STATE	FED. AID PROJ. NO.	FISCAL YEAR	SHEET NO.	TOTAL SHEETS
HAWAII	HAW.	I-H2-1(6)3	1972	79	83

100

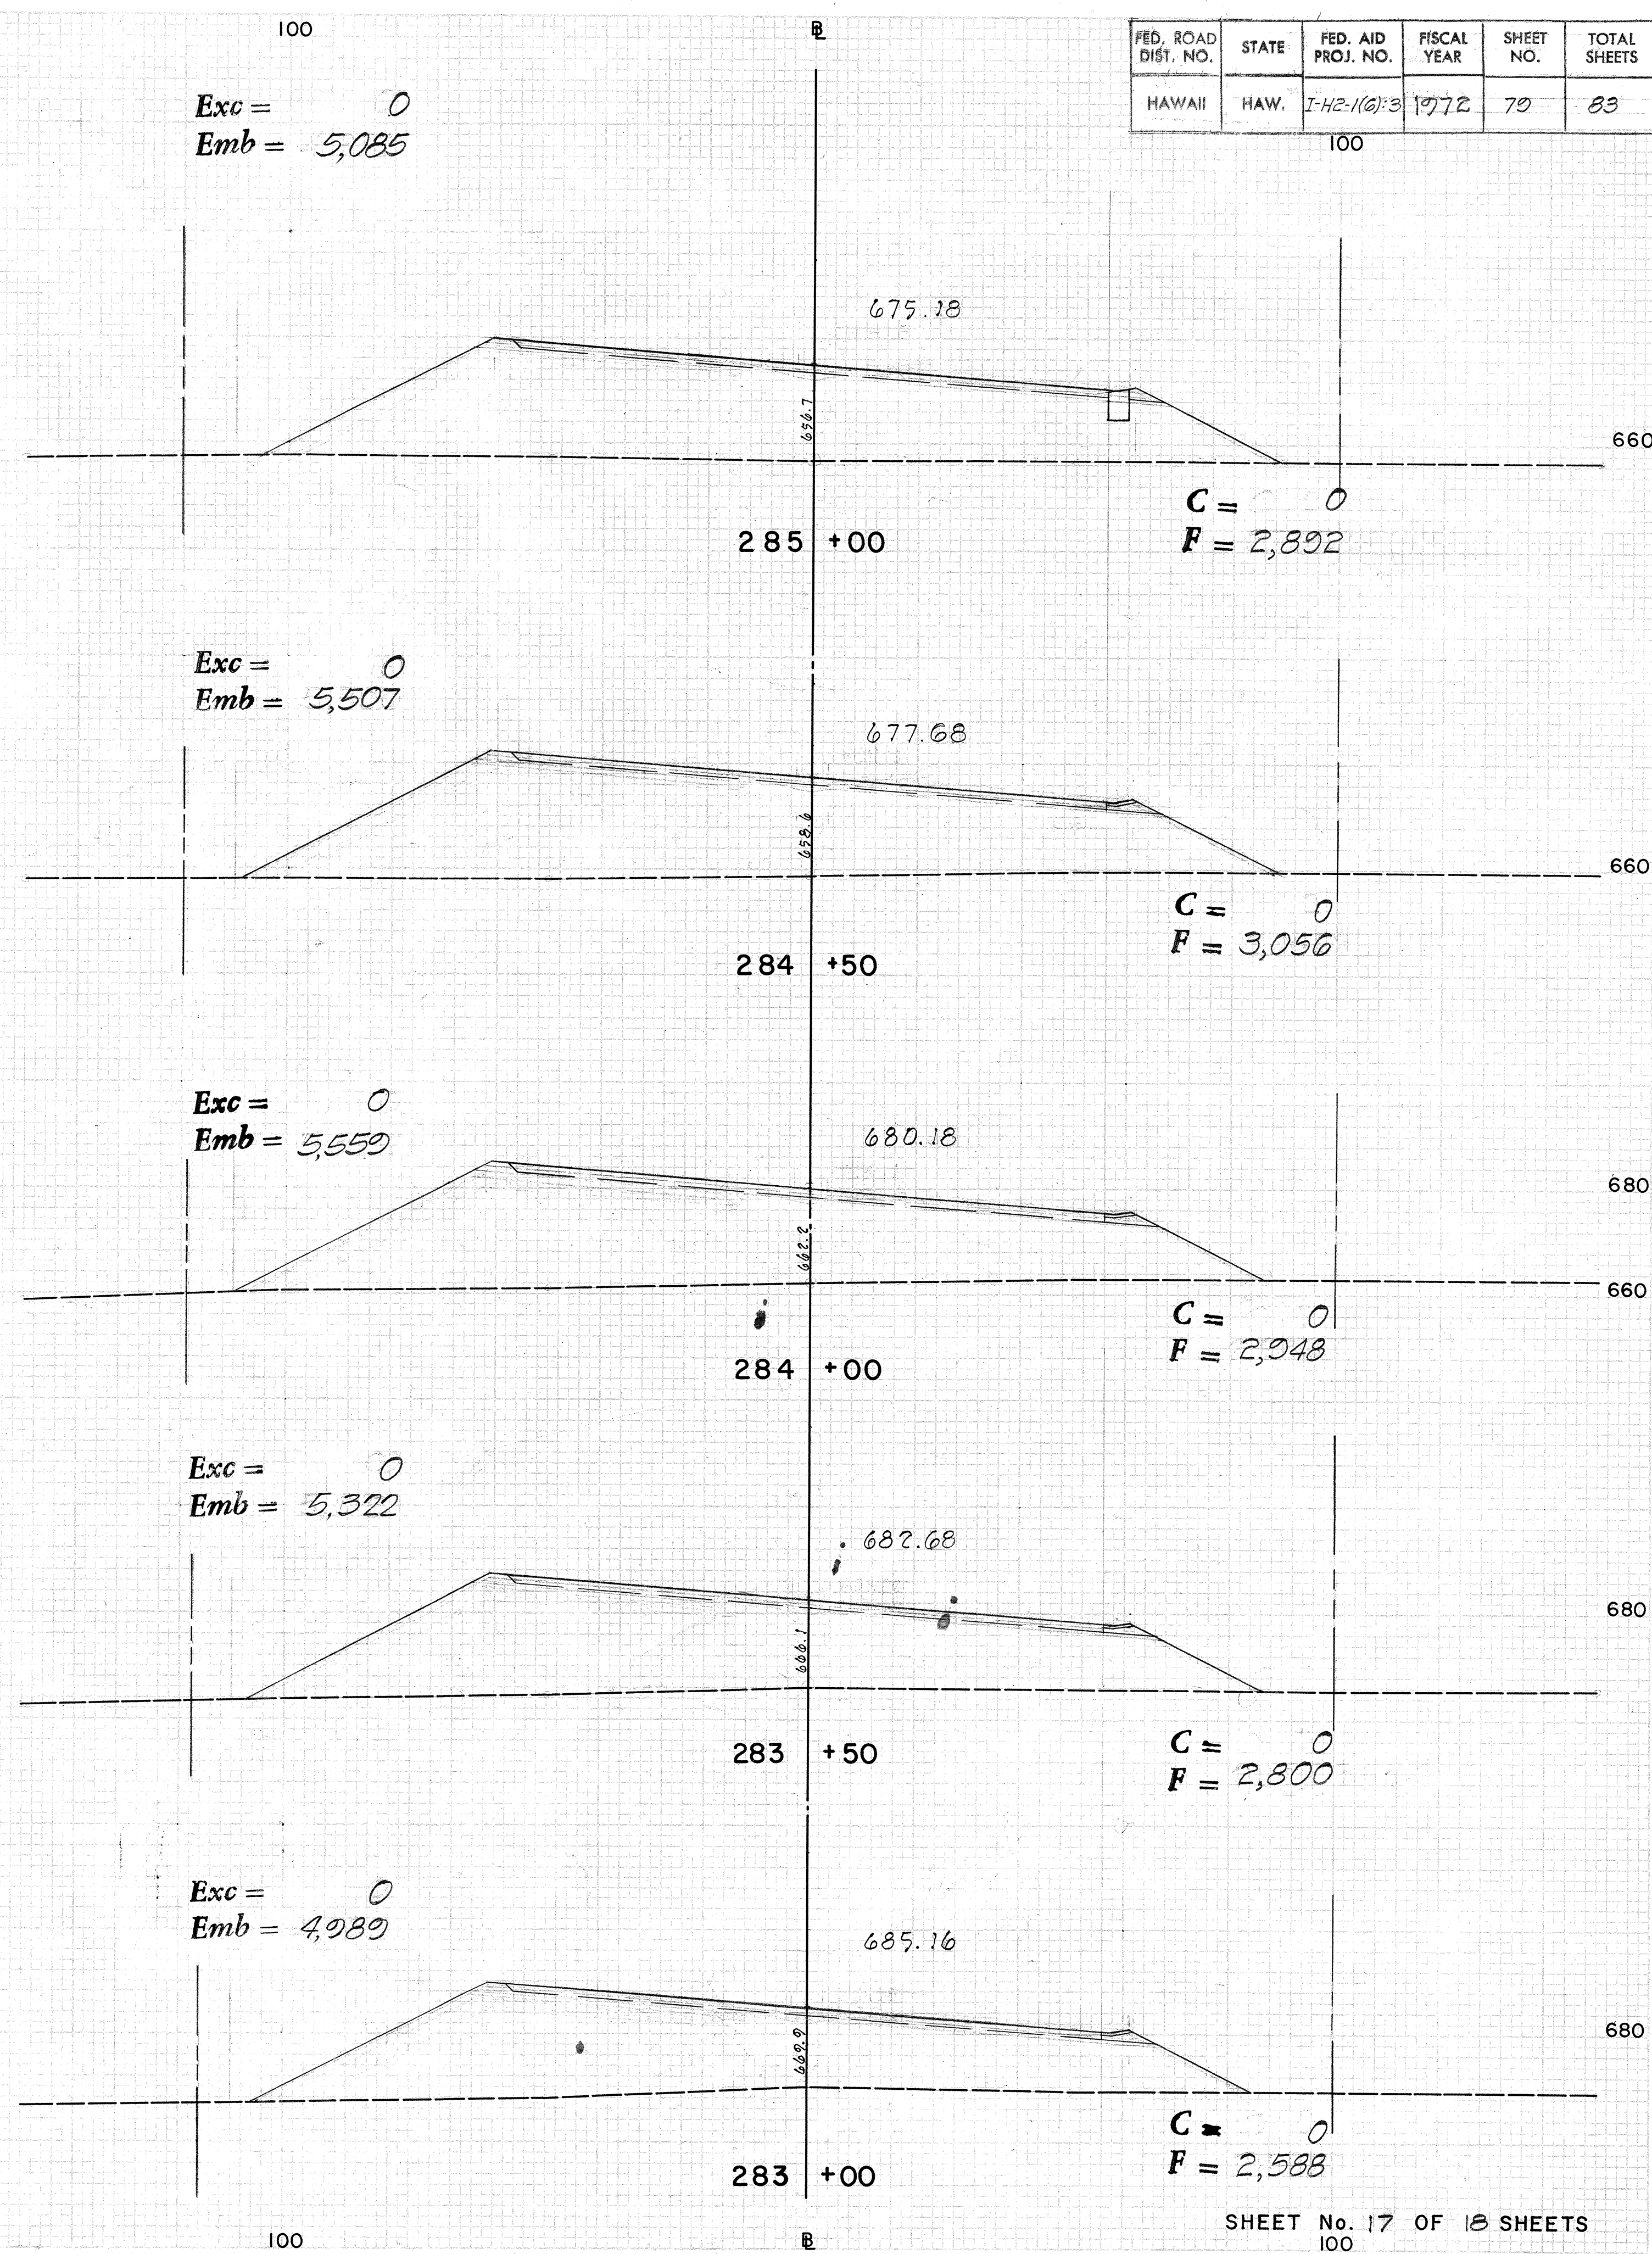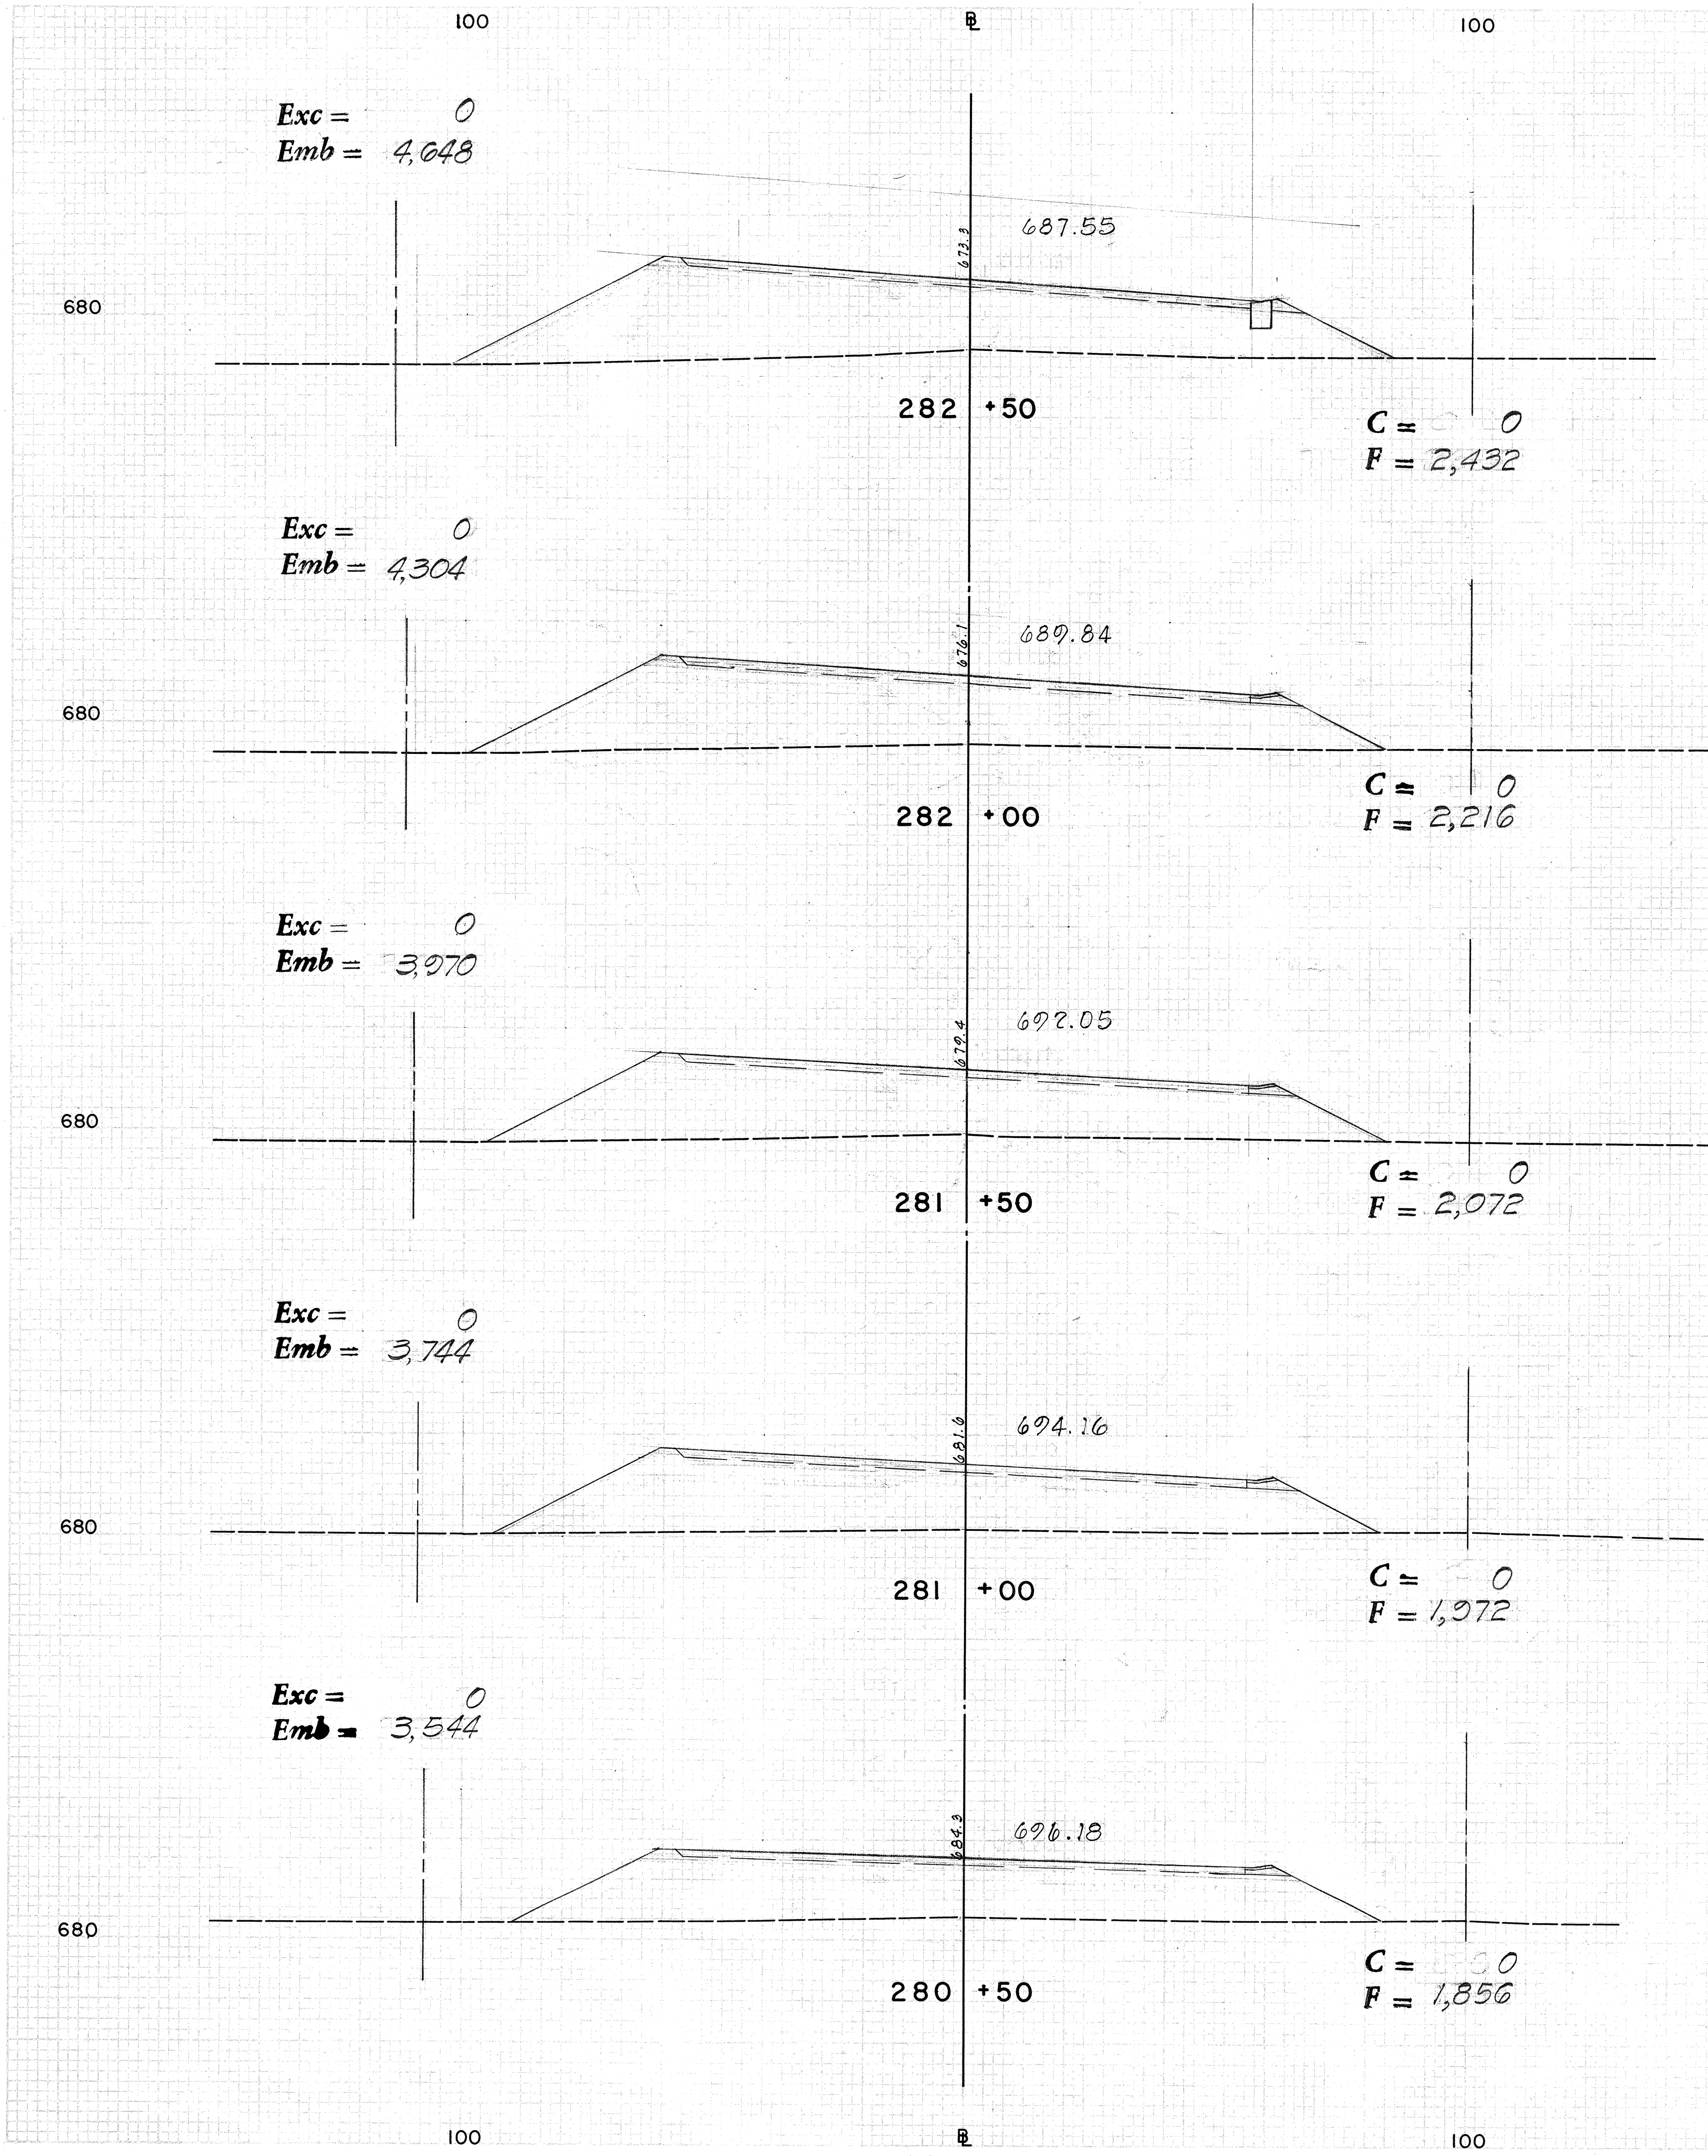

FED. ROAD DIST. NO.	STATE	FED. AID PROJ. NO.	FISCAL YEAR	SHEET NO.	TOTAL SHEETS
HAWAII	HAW.	I-H2-1(6)-3	1972	80	83

100

