


GENERAL NOTES

1. All fill and cut slopes shall be hydromulched (with Bermuda Seed) except where condition does not permit hydromulching such as on rock slopes. The Engineer will determine where hydromulching is not required.
2. Planting on roadbed areas shall be as directed by the Engineer.
3. All eroded slopes shall be filled and dressed before hydromulching.
4. For additional details, see Section G41 Slope Control Planting, of the Special Provisions.
5. Item No. G41.05 "Slope Preparation" is not applicable to erosion control work for F.A.I.P. No. I-H2-1(G):3.
6. In addition to the Project Information Sign shown hereon, 1- each Project Information and Construction I.D. Signs shall be placed at Mililani Access Road Separation. Exact locations to be determined by the Engineer. Also refer to Sections G35 and G70 of the Special Provisions for additional sign requirements.


FED. ROAD DIST. NO.	STATE	FED. AID PROJ. NO.	FISCAL YEAR	SHEET NO.	TOTAL SHEETS
HAWAII	HAW.	I-H2-1(G):3	1972	12	83

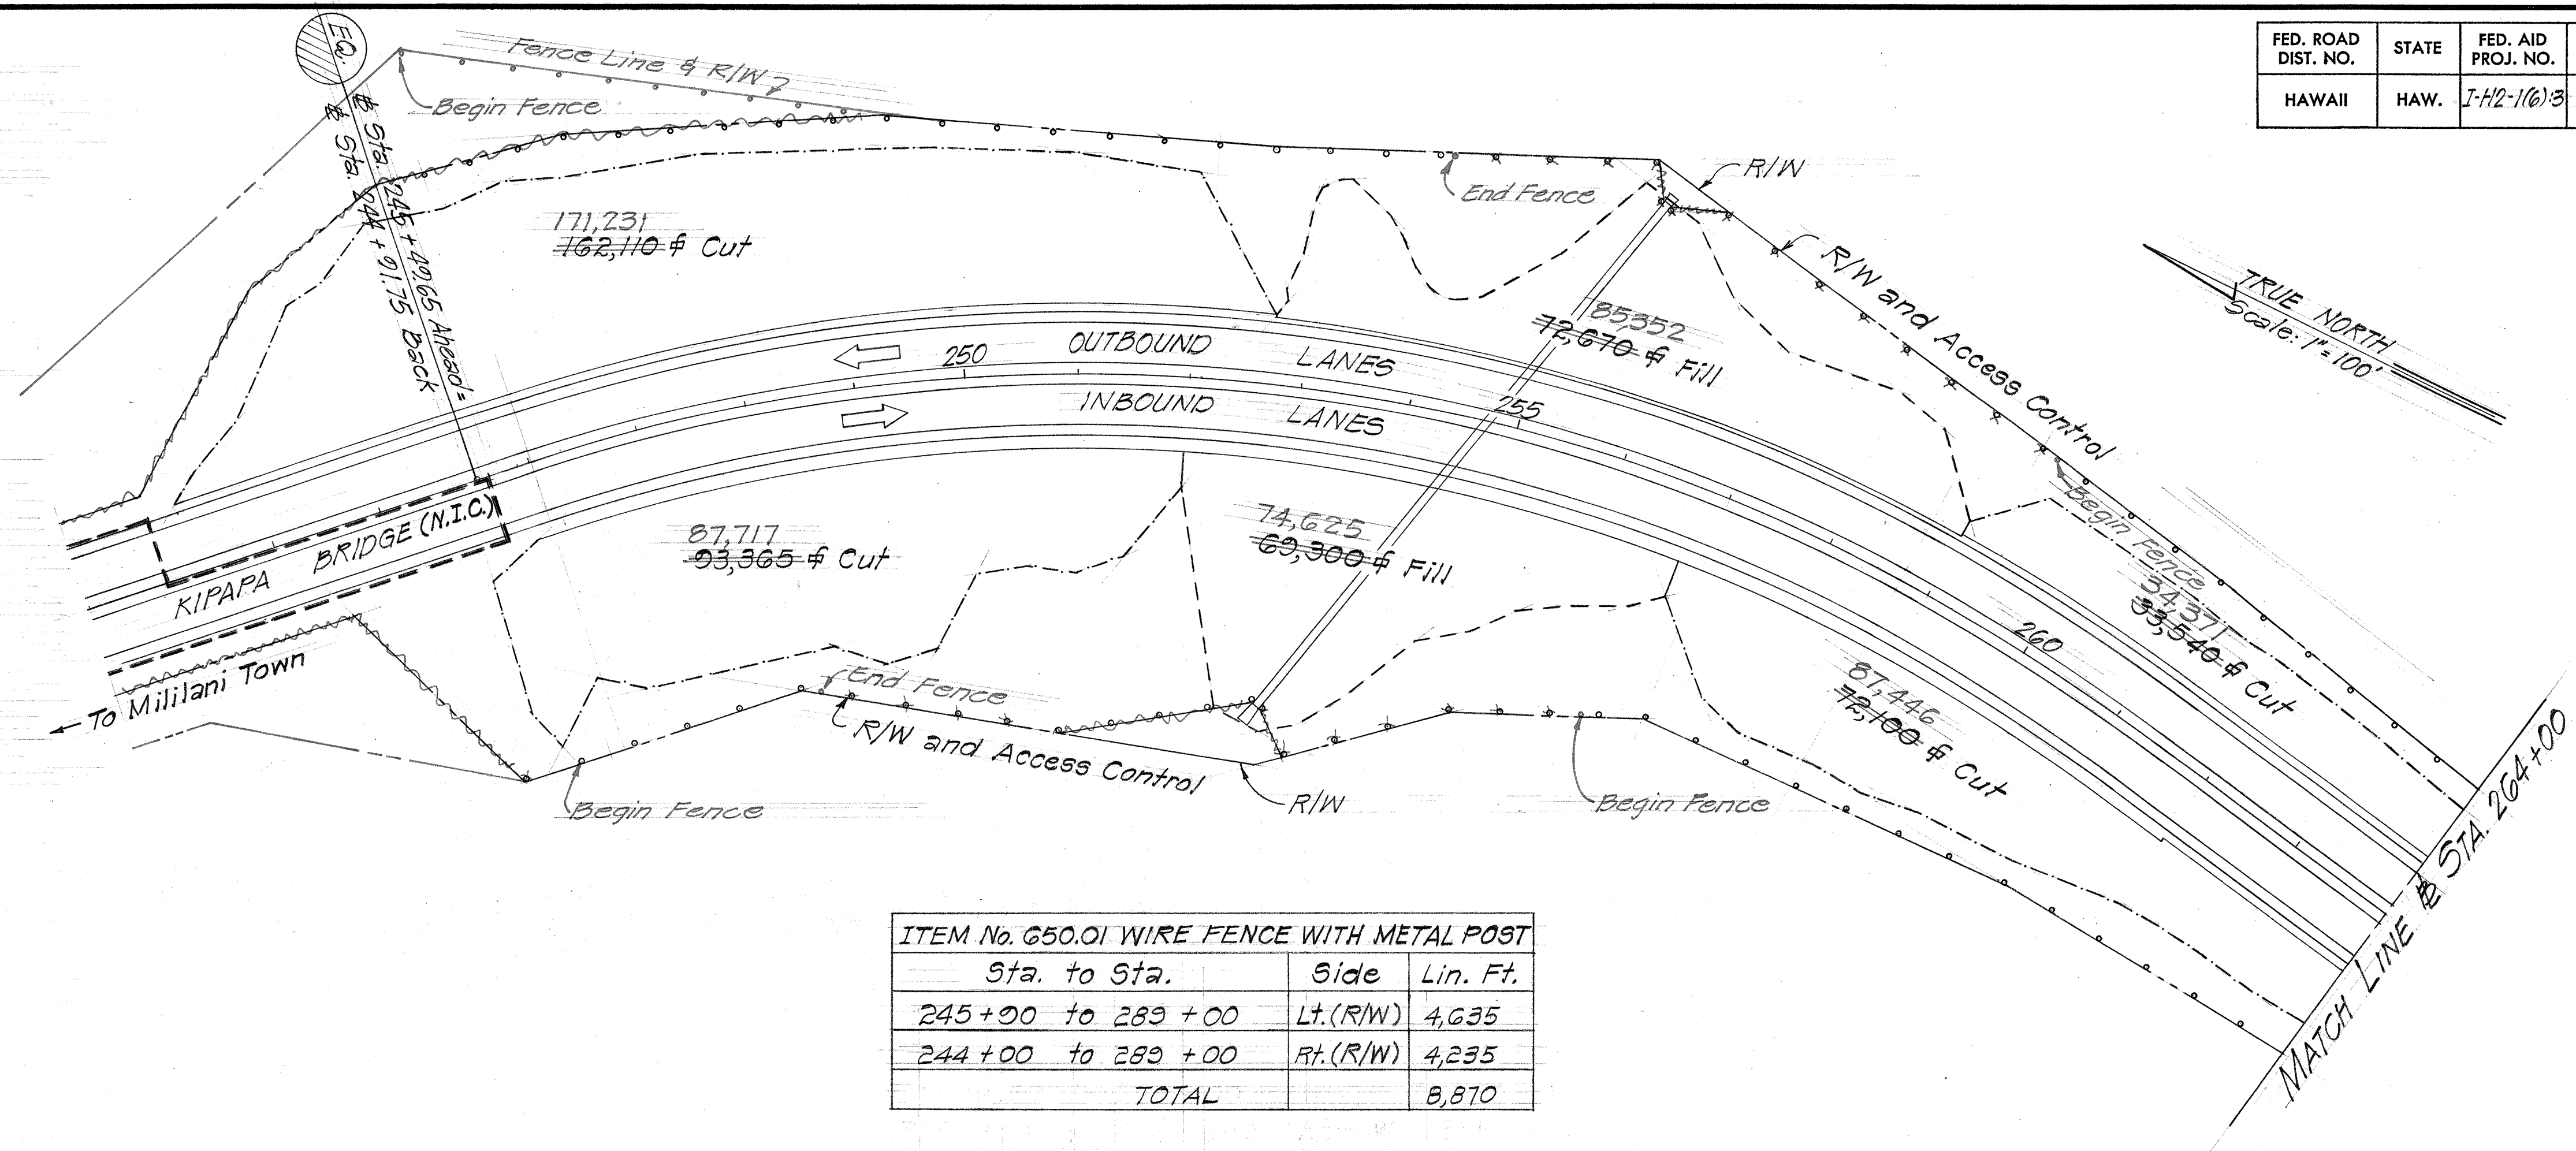

ITEM No. G50.01 WIRE FENCE WITH METAL POST		
Sta. to Sta.	Side	Lin. Ft.
245+00 to 283+00	Lt. (R/W)	4,635
244+00 to 283+00	Rt. (R/W)	4,235
TOTAL		8,870

LEGEND:

—•—•— New Wire Fence with Metal Post

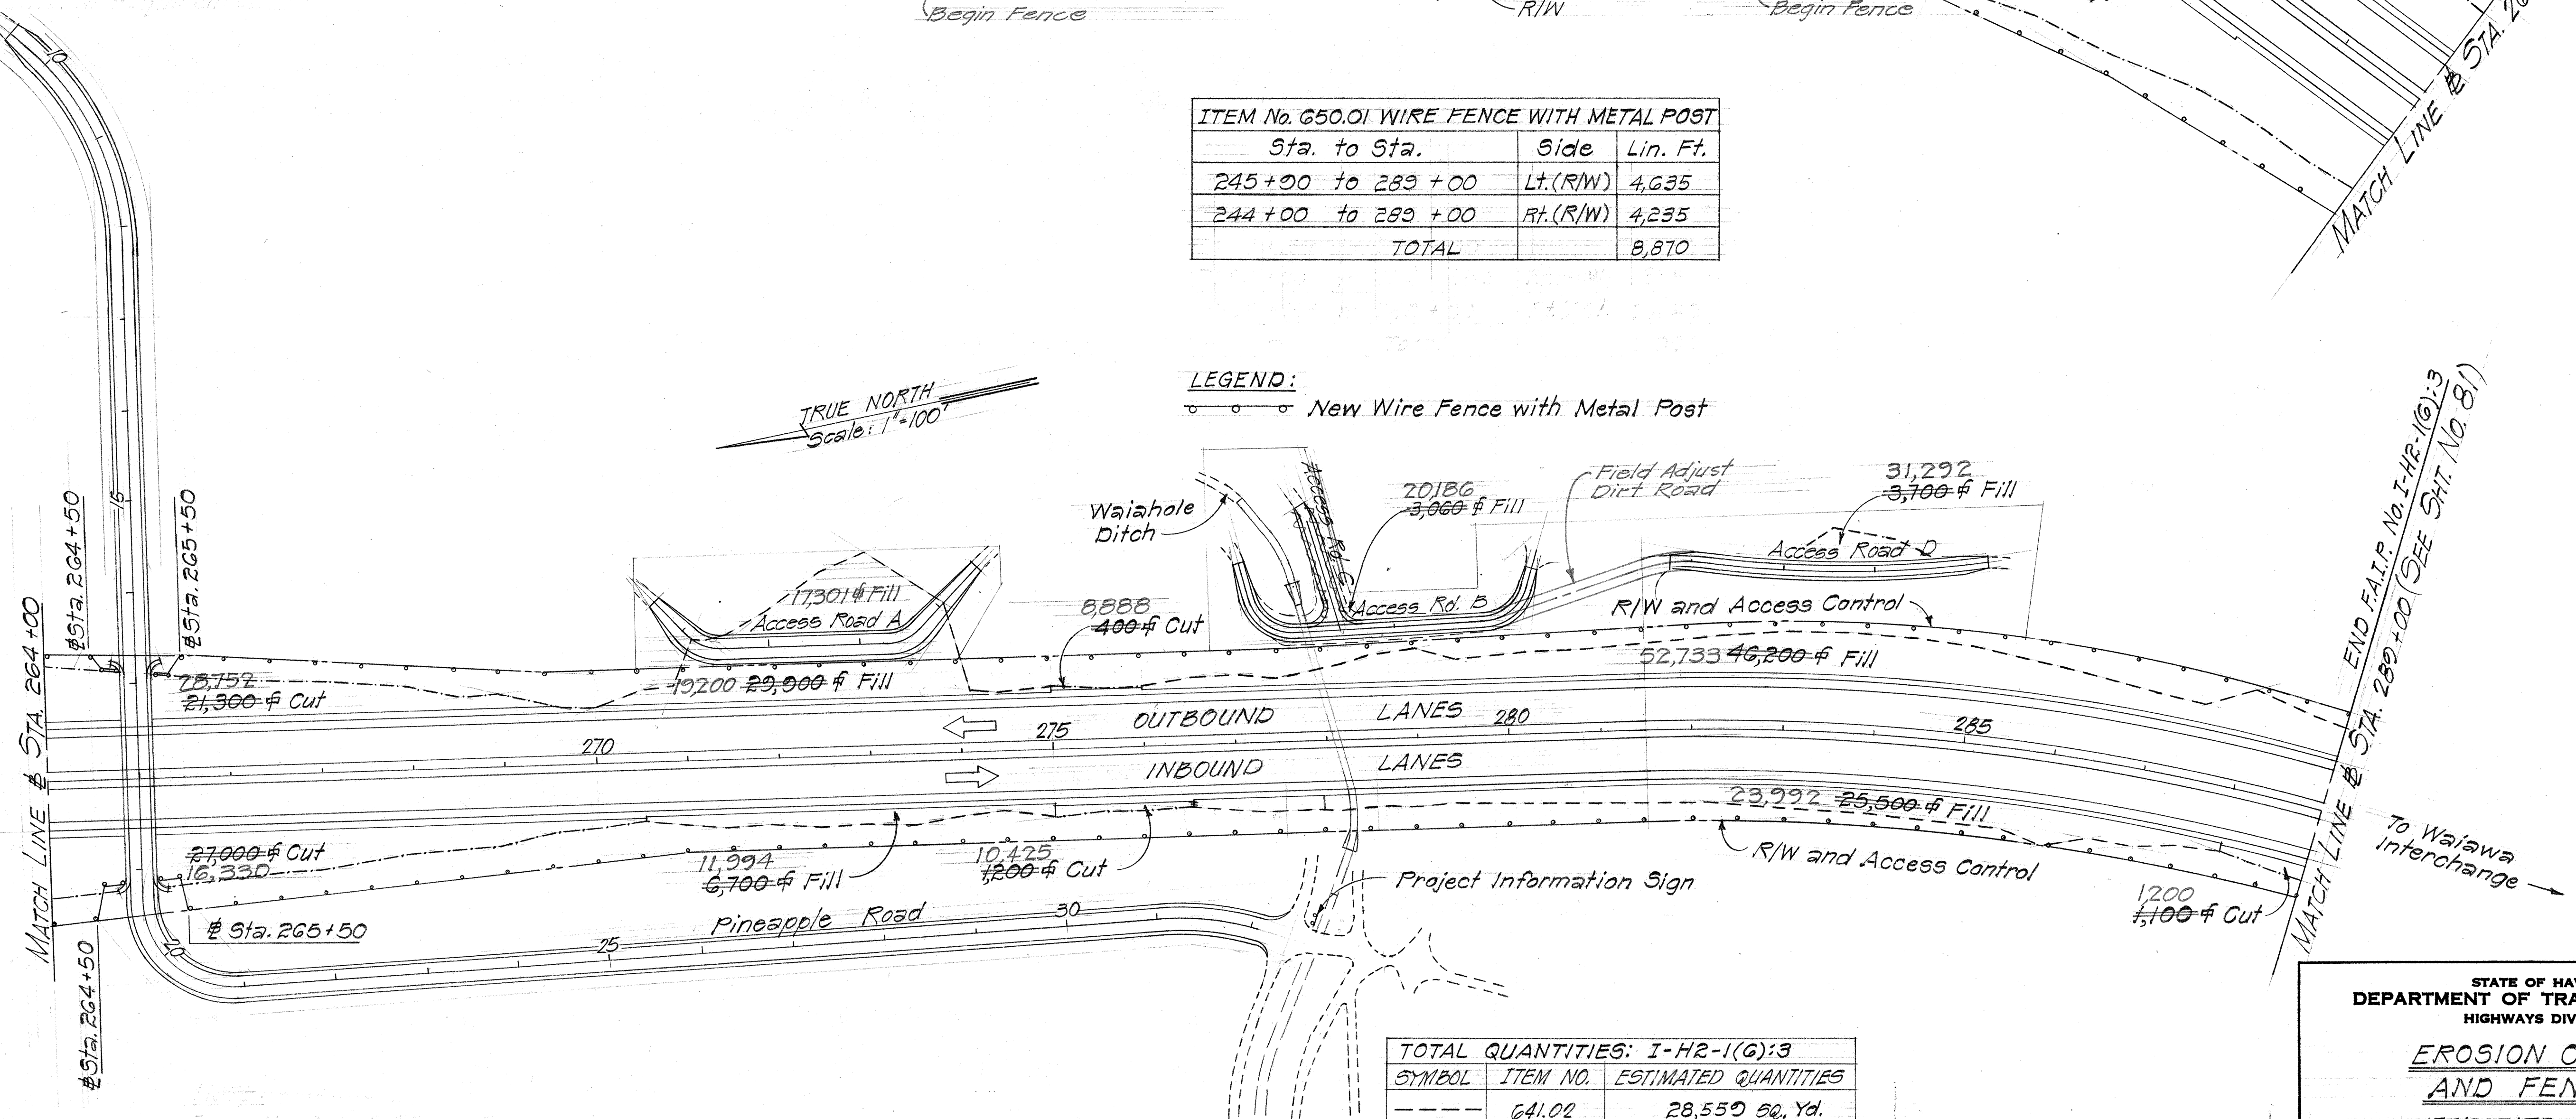

TOTAL QUANTITIES: I-H2-1(G):3		
SYMBOL	ITEM NO.	ESTIMATED QUANTITIES
---	G41.02	28,550 sq. Yd.
---	G41.03	45,791 sq. Yd.
F.A.	G41.04	55,000 sq. Yd.

STATE OF HAWAII
DEPARTMENT OF TRANSPORTATION
HIGHWAYS DIVISION

EROSION CONTROL AND FENCING

INTERSTATE ROUTE H-2
Kipapa Gulch to Waiahole Ditch
F.A.I. Proj. No. I-H2-1(G):3

Scale: 1"=100'

Date: April 1972

SHEET No. 1 OF 1 SHEETS