
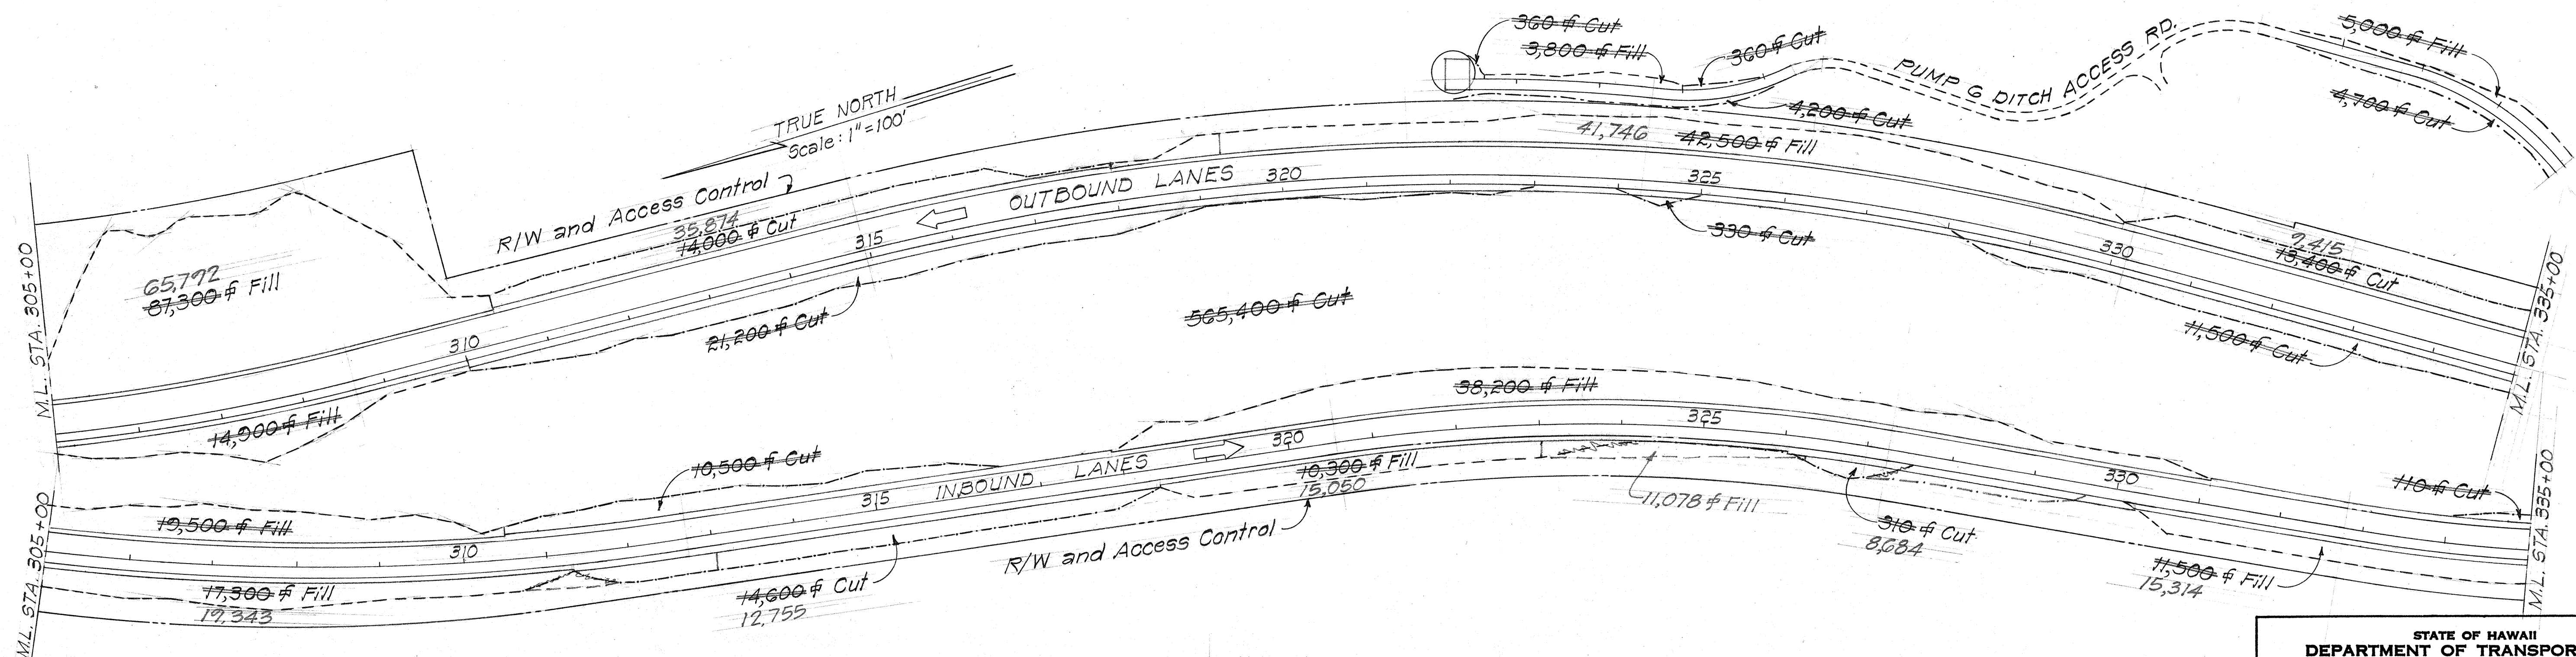


GENERAL NOTES

- 1- All fill and cut slopes shall be hydro-mulched (with Bermuda Seed) except where condition does not permit hydro-mulching such as on rock slopes. The Engineer will determine where hydro-mulching is not required.
- 2- Planting on roadbed areas shall be as directed by the Engineer.
- 3- All eroded slopes shall be filled and dressed before hydromulching.
- 4- Erosion Control Planting shall not commence until notice to proceed is obtained in writing from the Engineer.
- 5- For additional details, see Section 641 Slope Control Planting of the Special Provisions.

FED. ROAD DIST. NO.	STATE	FED. AID PROJ. NO.	FISCAL YEAR	SHEET NO.	TOTAL SHEETS
HAWAII	HAW.	I-H2-1(14):0	1972	81	83

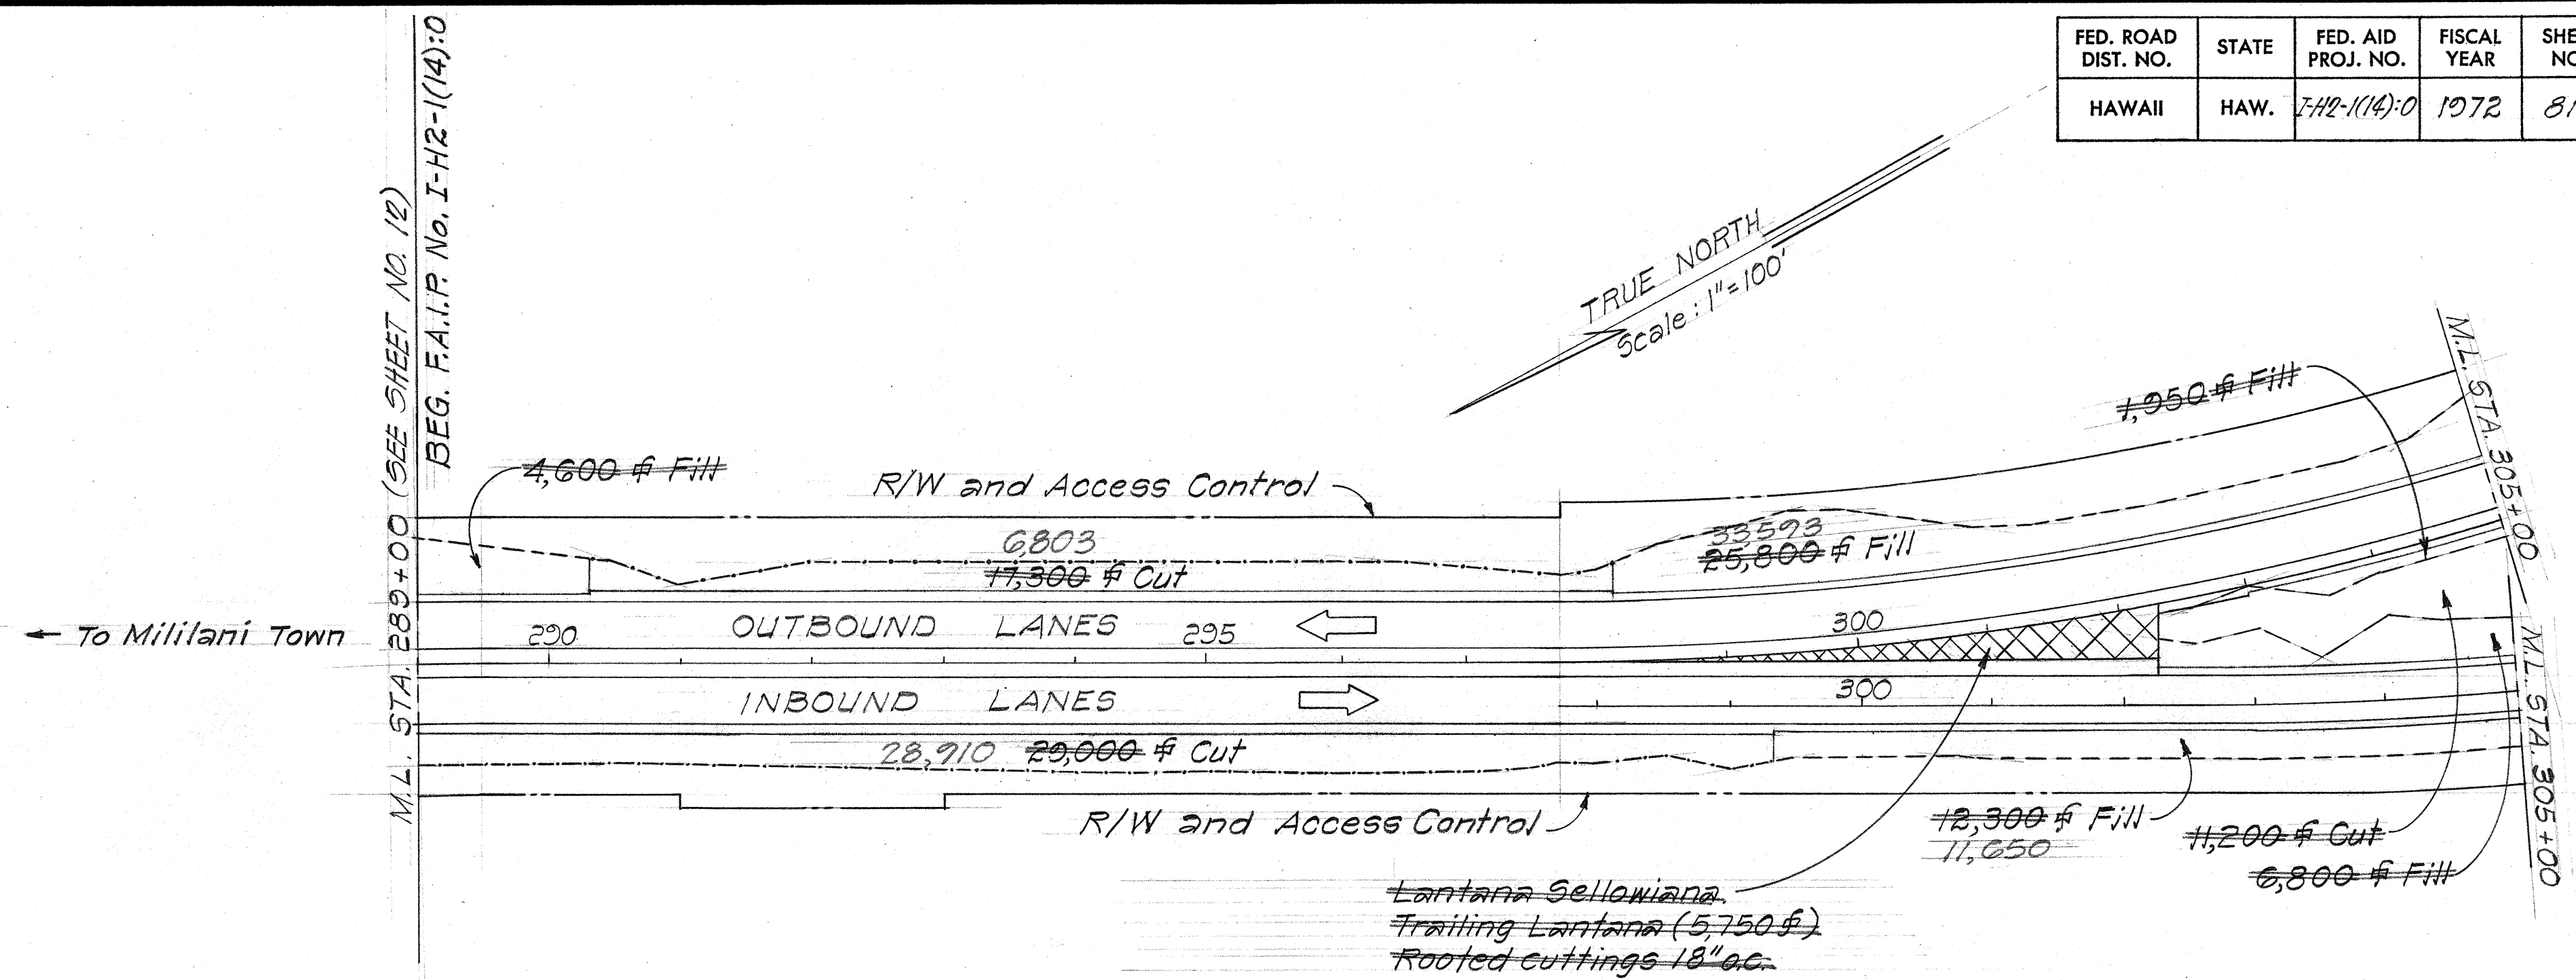

NOTE:
Erosion Control work in median area shown on this sheet deleted from this project and added to F.A.I. Project No. I-H2-1(12):0 by C.C.O. 12.

4/25/73	Replaced Bermuda Grass with Trailing Lantana ground cover in median area.
DATE	REVISION

STATE OF HAWAII
DEPARTMENT OF TRANSPORTATION
HIGHWAYS DIVISION

EROSION CONTROL


INTERSTATE ROUTE H-2
Waiahole Ditch to Waialae I.C.
F.A.I. Proj. No. I-H2-1(14):0

Scale: 1"=100' Date: April 1972

SHEET No. 1 OF 3 SHEETS

C081

FED. ROAD DIST. NO.	STATE	FED. AID PROJ. NO.	FISCAL YEAR	SHEET NO.	TOTAL SHEETS
HAWAII	HAW.	I-H2-1(14)0	1972	82	83

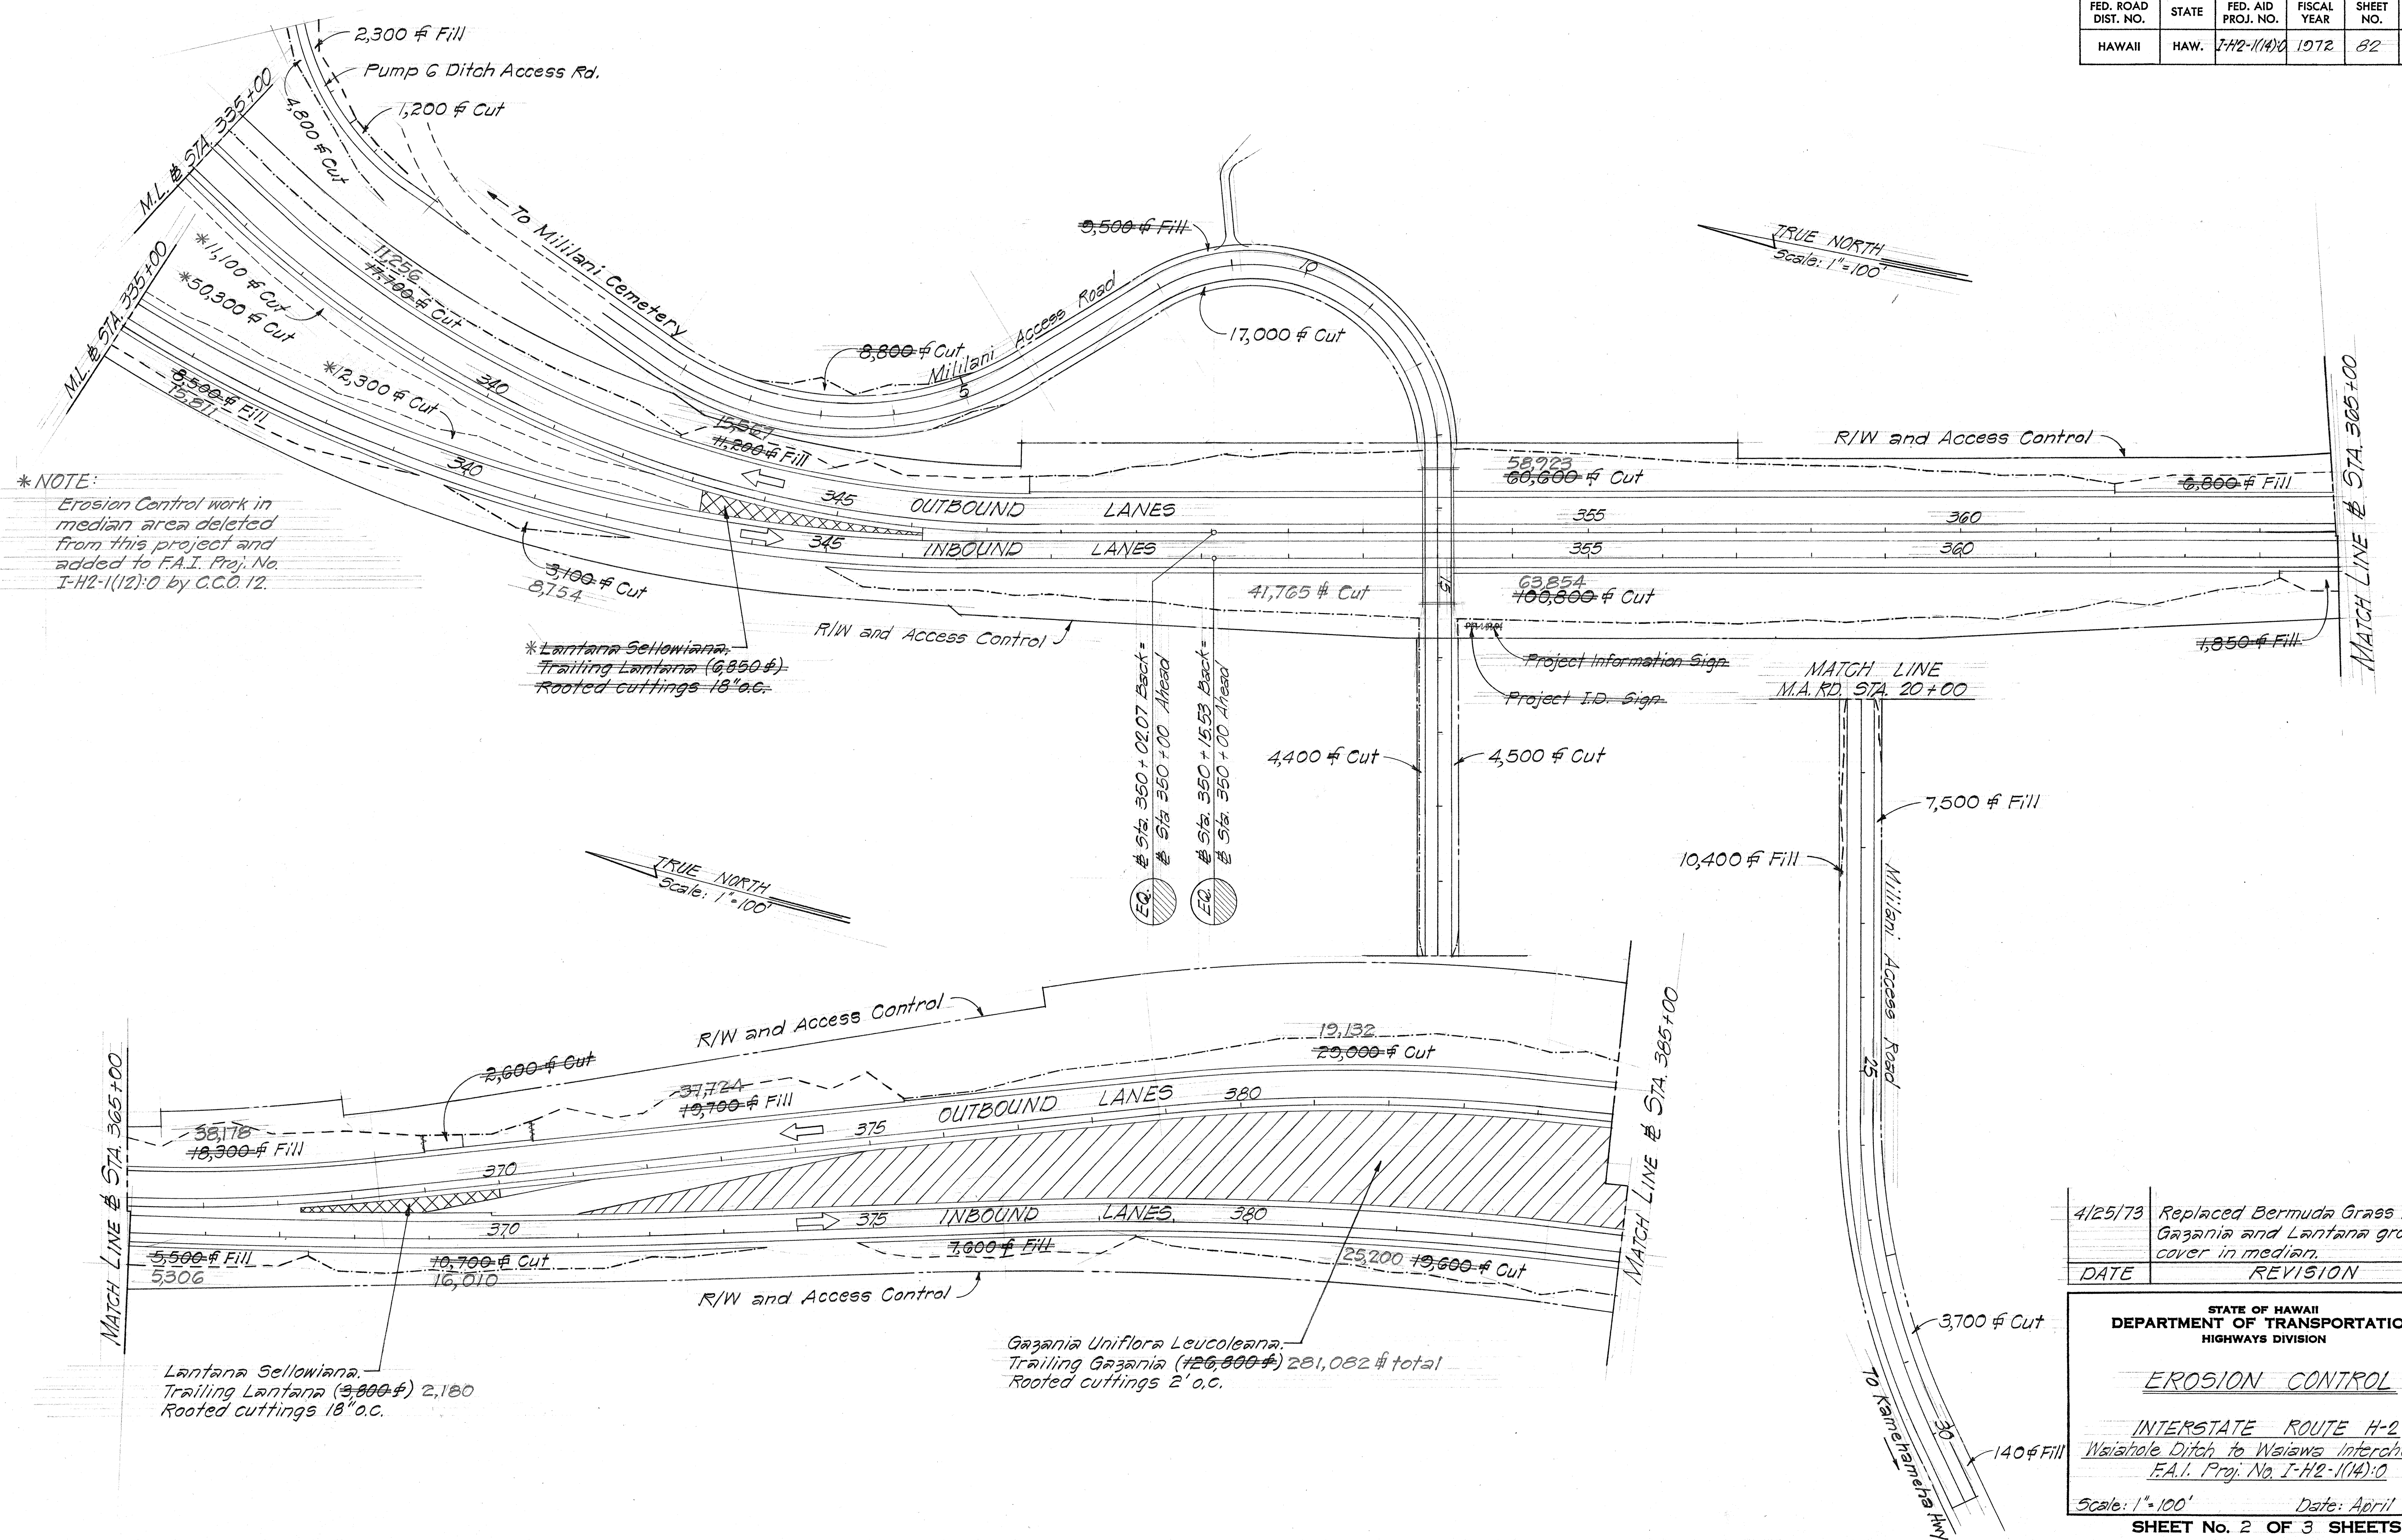

* NOTE:
Erosion Control work in median area deleted from this project and added to F.A.I. Proj. No. I-H2-1(12)0 by C.C.O. 12.

* Lantana Sellowiana.
Trailing Lantana (6,850 #)
Rooted cuttings 18" o.c.

Gazania Uniflora Leucoleana.
Trailing Gazania (#26,800 #) 281,082 # total
Rooted cuttings 2' o.c.

Lantana Sellowiana.
Trailing Lantana (3,800 #) 2,180
Rooted cuttings 18" o.c.

4/25/73	Replaced Bermuda Grass with Gazania and Lantana ground cover in median.
DATE	REVISION



STATE OF HAWAII
DEPARTMENT OF TRANSPORTATION
HIGHWAYS DIVISION

EROSION CONTROL

INTERSTATE ROUTE H-2
Waiatole Ditch to Waiawa Interchange
F.A.I. Proj. No. I-H2-1(14)0
Scale: 1"=100' Date: April 1972

SHEET No. 2 OF 3 SHEETS

FED. ROAD DIST. NO.	STATE	FED. AID PROJ. NO.	FISCAL YEAR	SHEET NO.	TOTAL SHEETS
HAWAII	HAW.	I-H2-1(14):0	1972	83	83

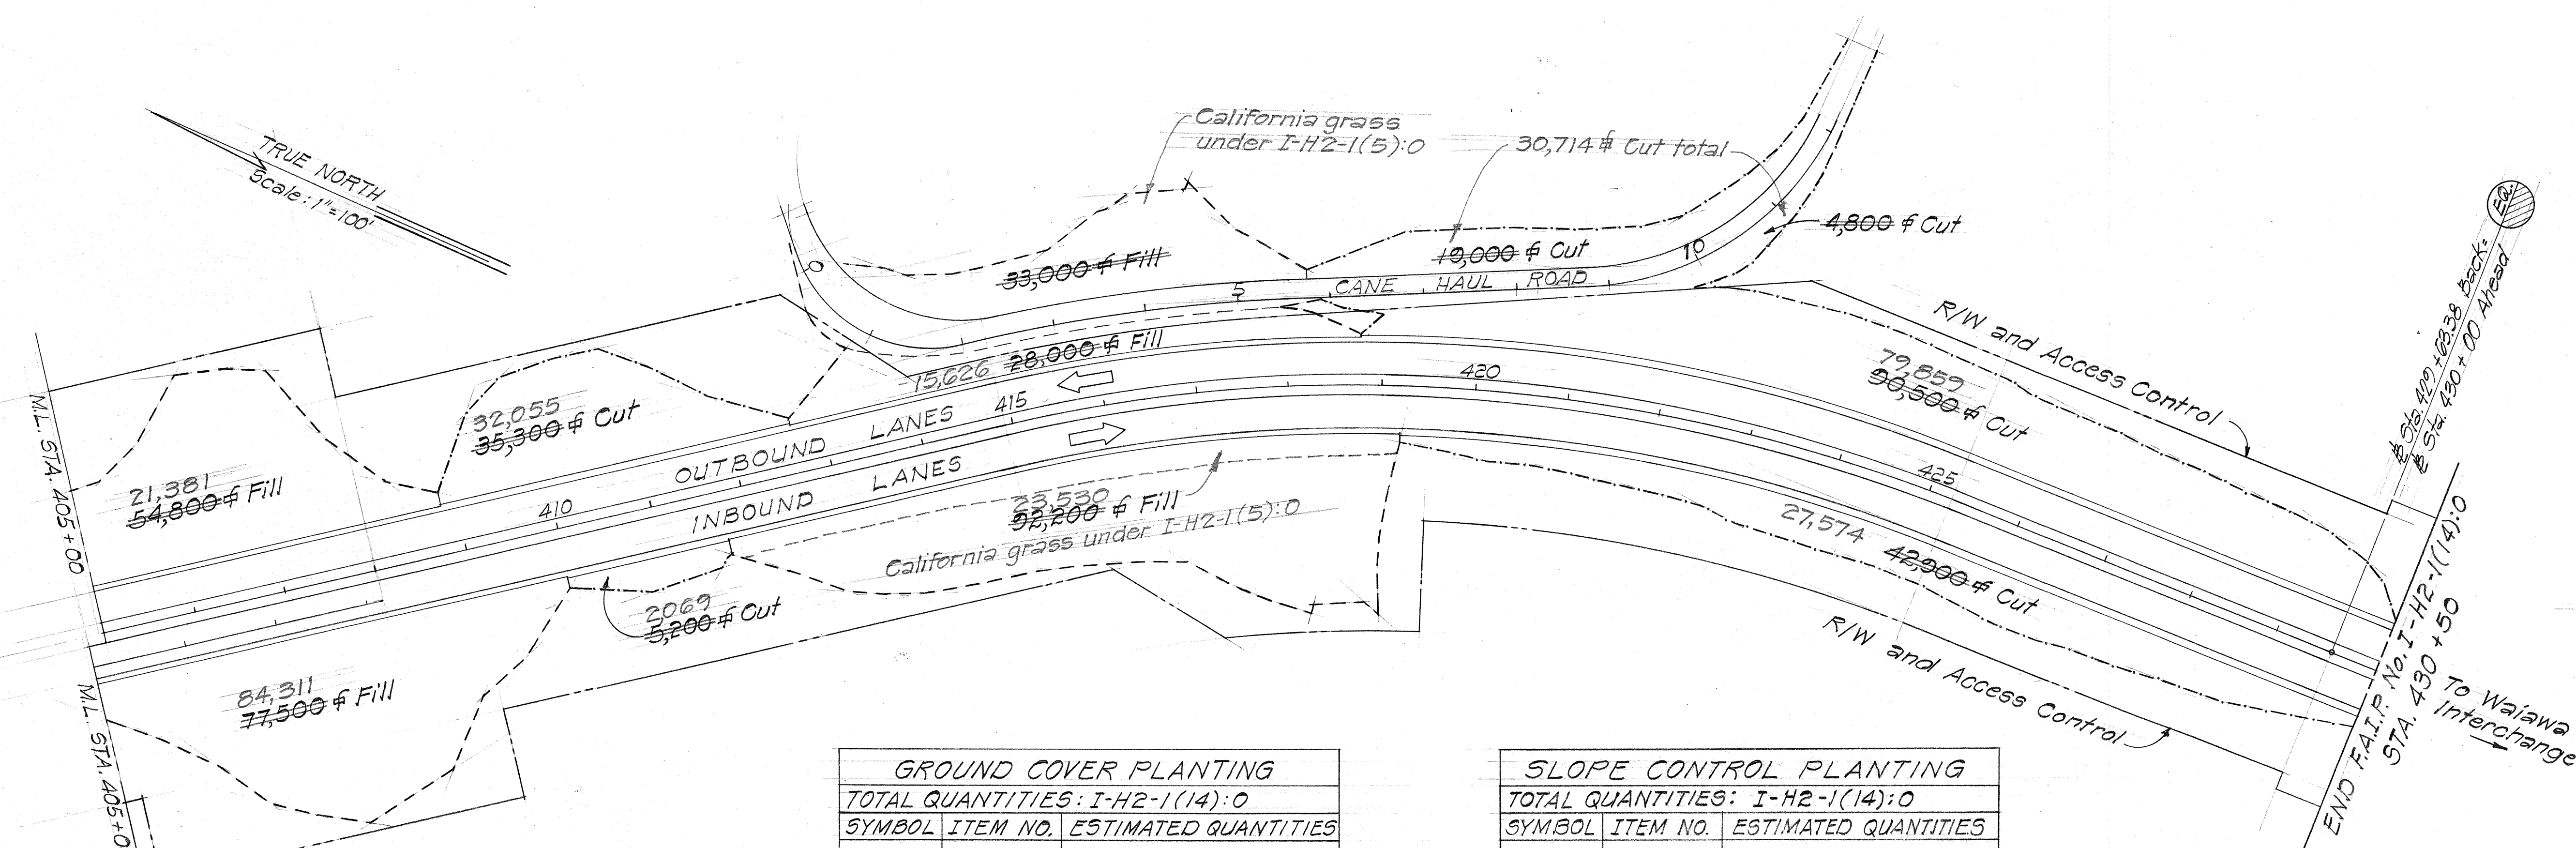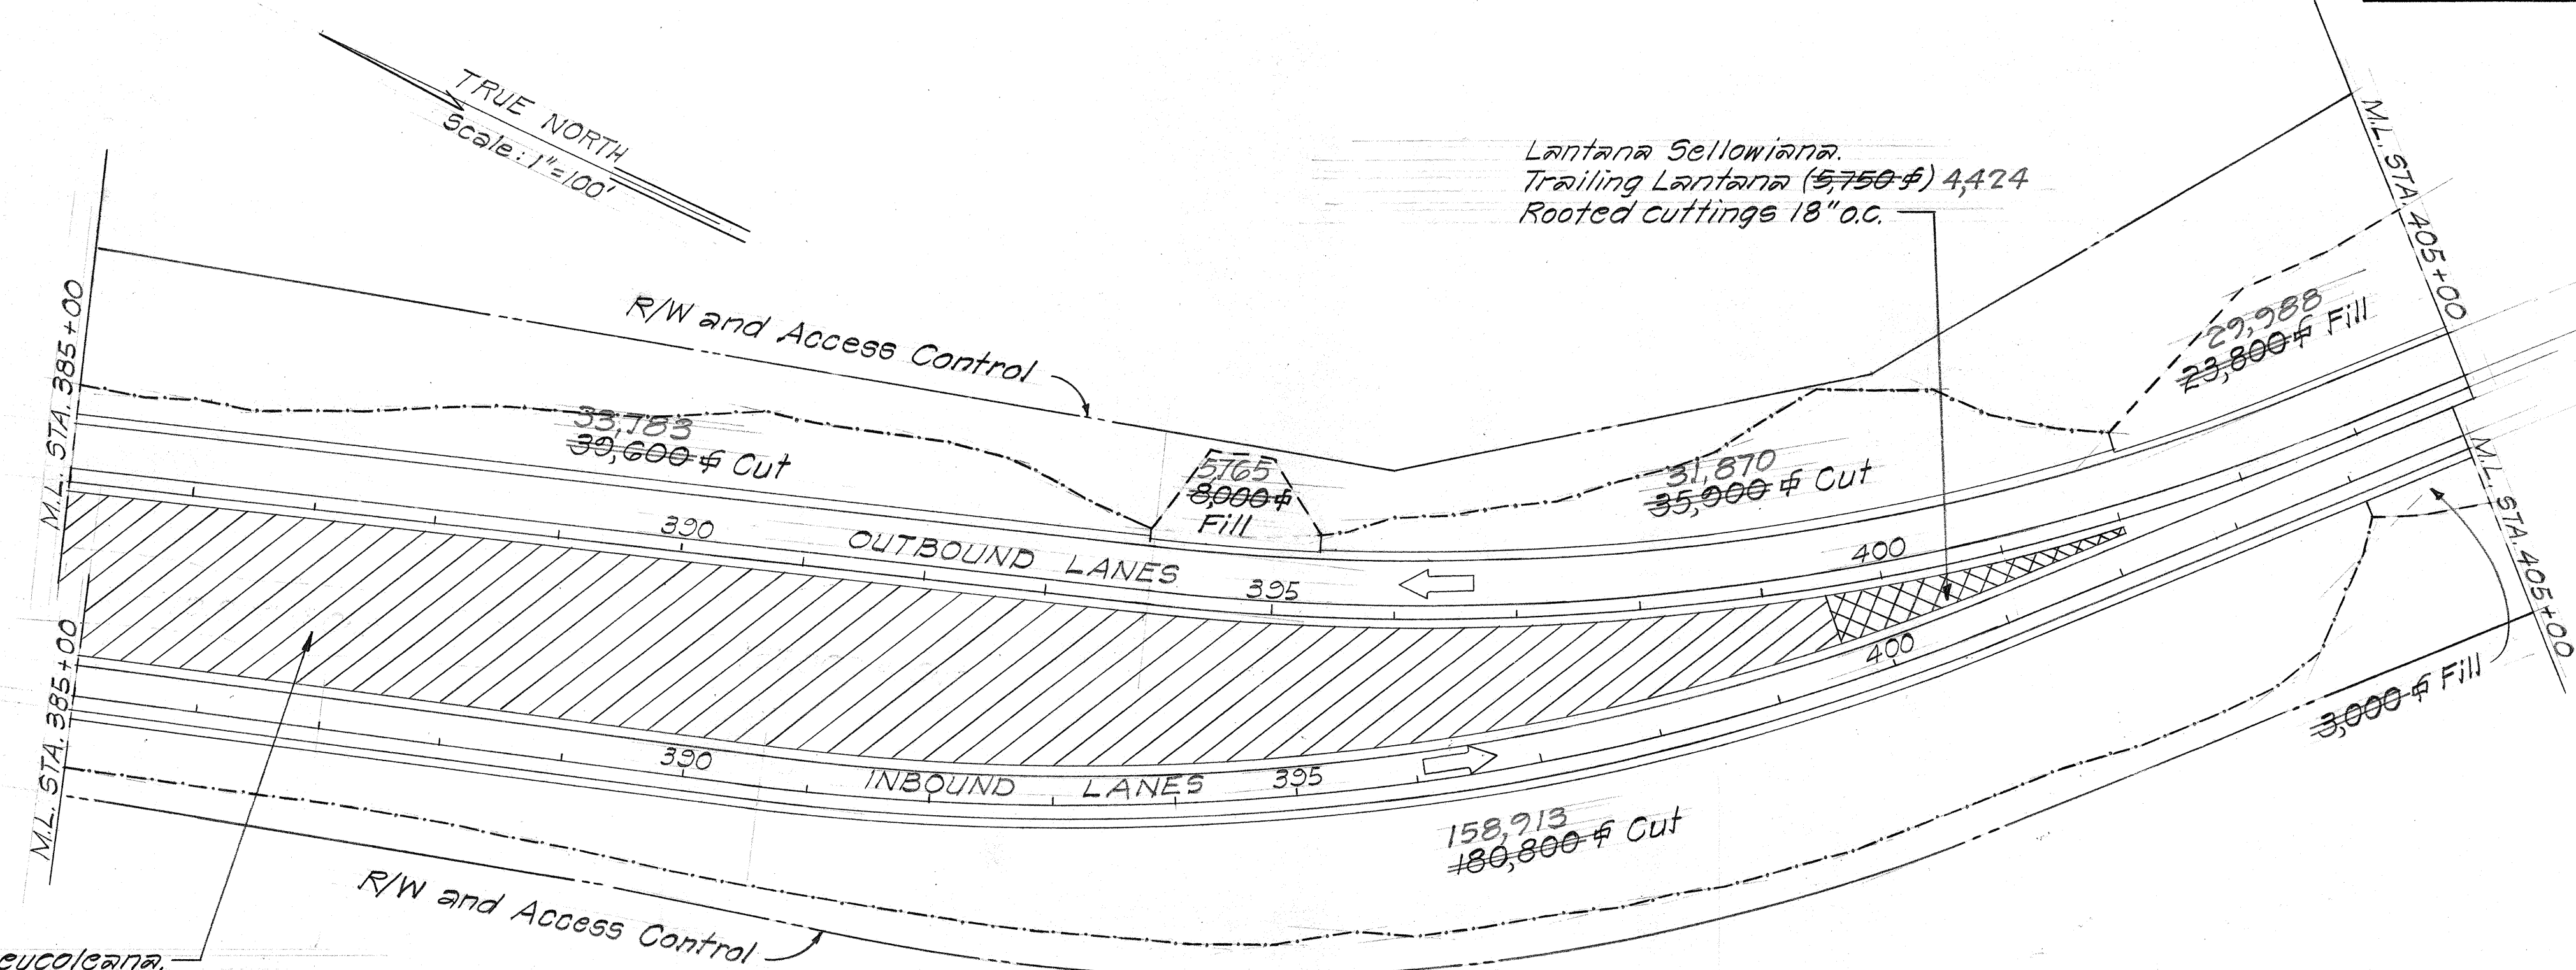

GROUND COVER PLANTING		
TOTAL QUANTITIES: I-H2-1(14):0		
SYMBOL	ITEM NO.	ESTIMATED QUANTITIES
XXXX	G47.01	22,150 SQ. FT.
XXXX	G47.02	290,400 SQ. FT.

SLOPE CONTROL PLANTING		
TOTAL QUANTITIES: I-H2-1(14):0		
SYMBOL	ITEM NO.	ESTIMATED QUANTITIES
----	G41.02	81,260 SQ. Yd.
----	G41.03	170,510 SQ. Yd.
F.A.	G41.04	118,845 SQ. Yd.
F.A.	G41.05	38,837 SQ. Yd.

4/25/73	Replaced Bermuda Grass with Gazania and Lantana ground cover in median area.
DATE	REVISION

STATE OF HAWAII
DEPARTMENT OF TRANSPORTATION
HIGHWAYS DIVISION

EROSION CONTROL

INTERSTATE ROUTE H-2
Waiahole Ditch to Waiawa I.C.
F.A.I. Proj. No. I-H2-1(14):0

Scale: 1"=100' Date: April 1972

SHEET No. 3 OF 3 SHEETS

DATE	
SURVEY PLATTED BY	
DRAWN BY	
DESIGNED BY	
QUANTITIES BY	
CHECKED BY	
ORIGINAL PLAN	
NOTE BOOK	
NO.	