
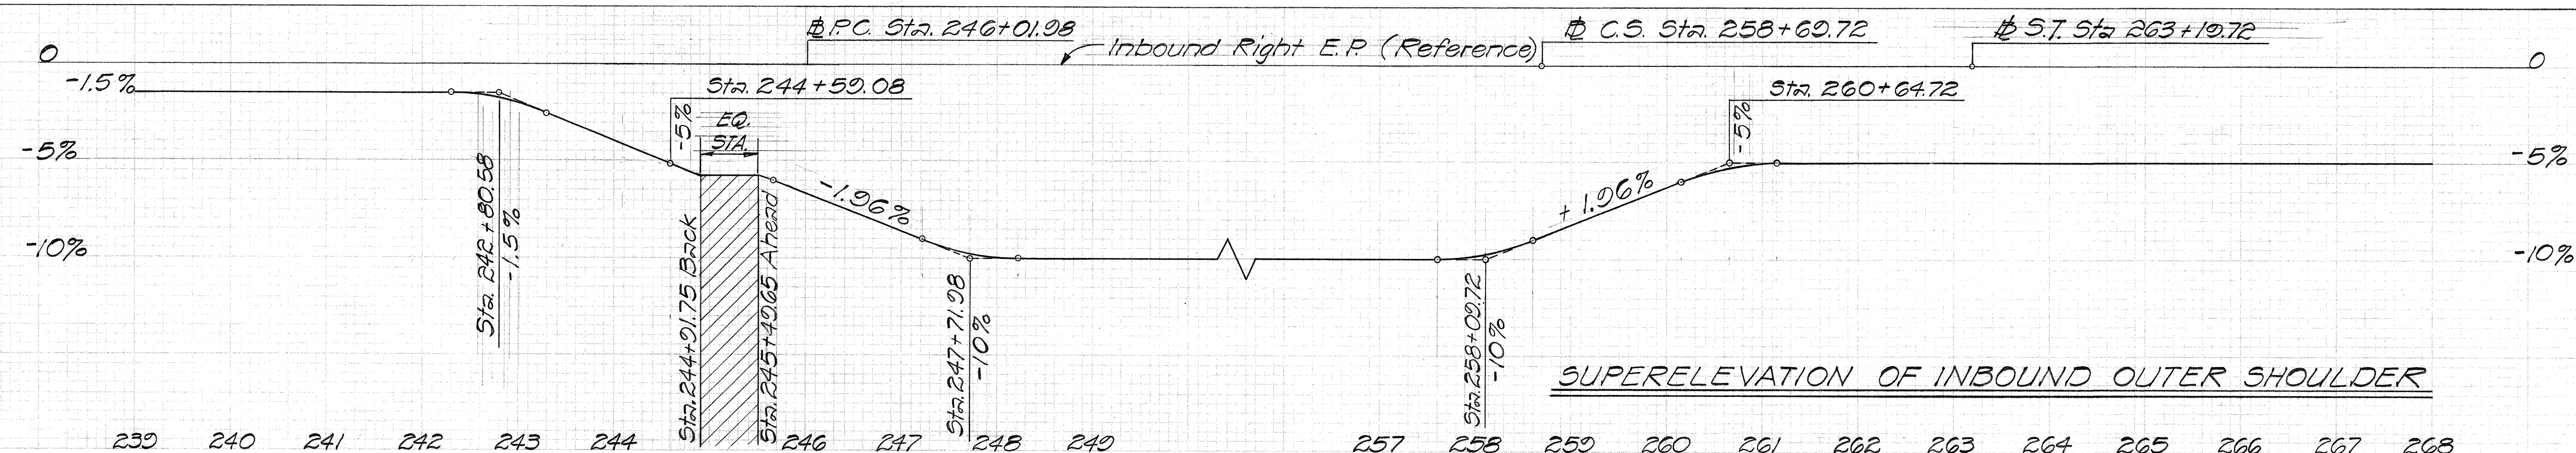
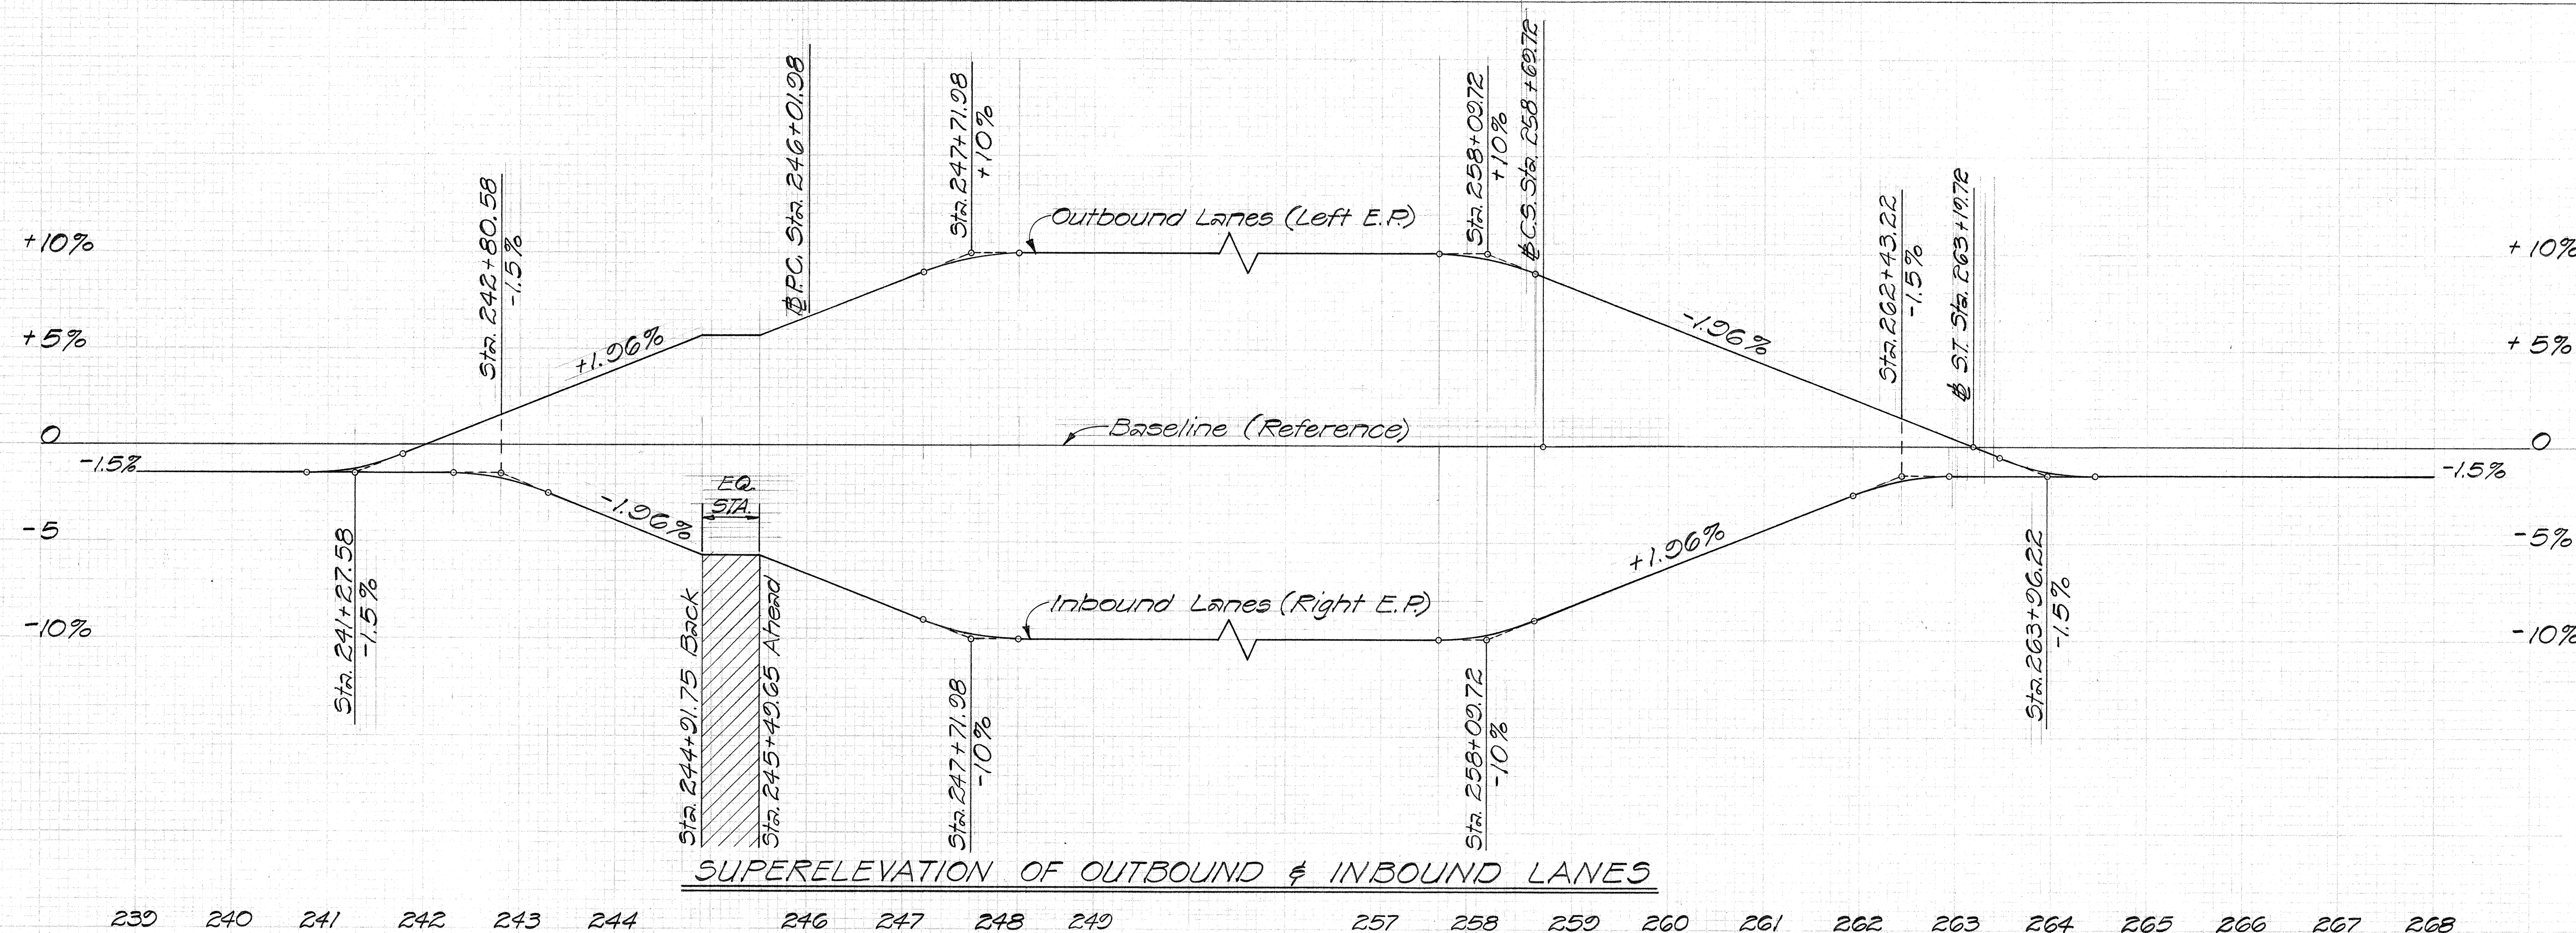


FED. ROAD DIST. NO.	STATE	FED. AID PROJ. NO.	FISCAL YEAR	SHEET NO.	TOTAL SHEETS
HAWAII	HAW.	I-H2-1(6):3	1972	7	83

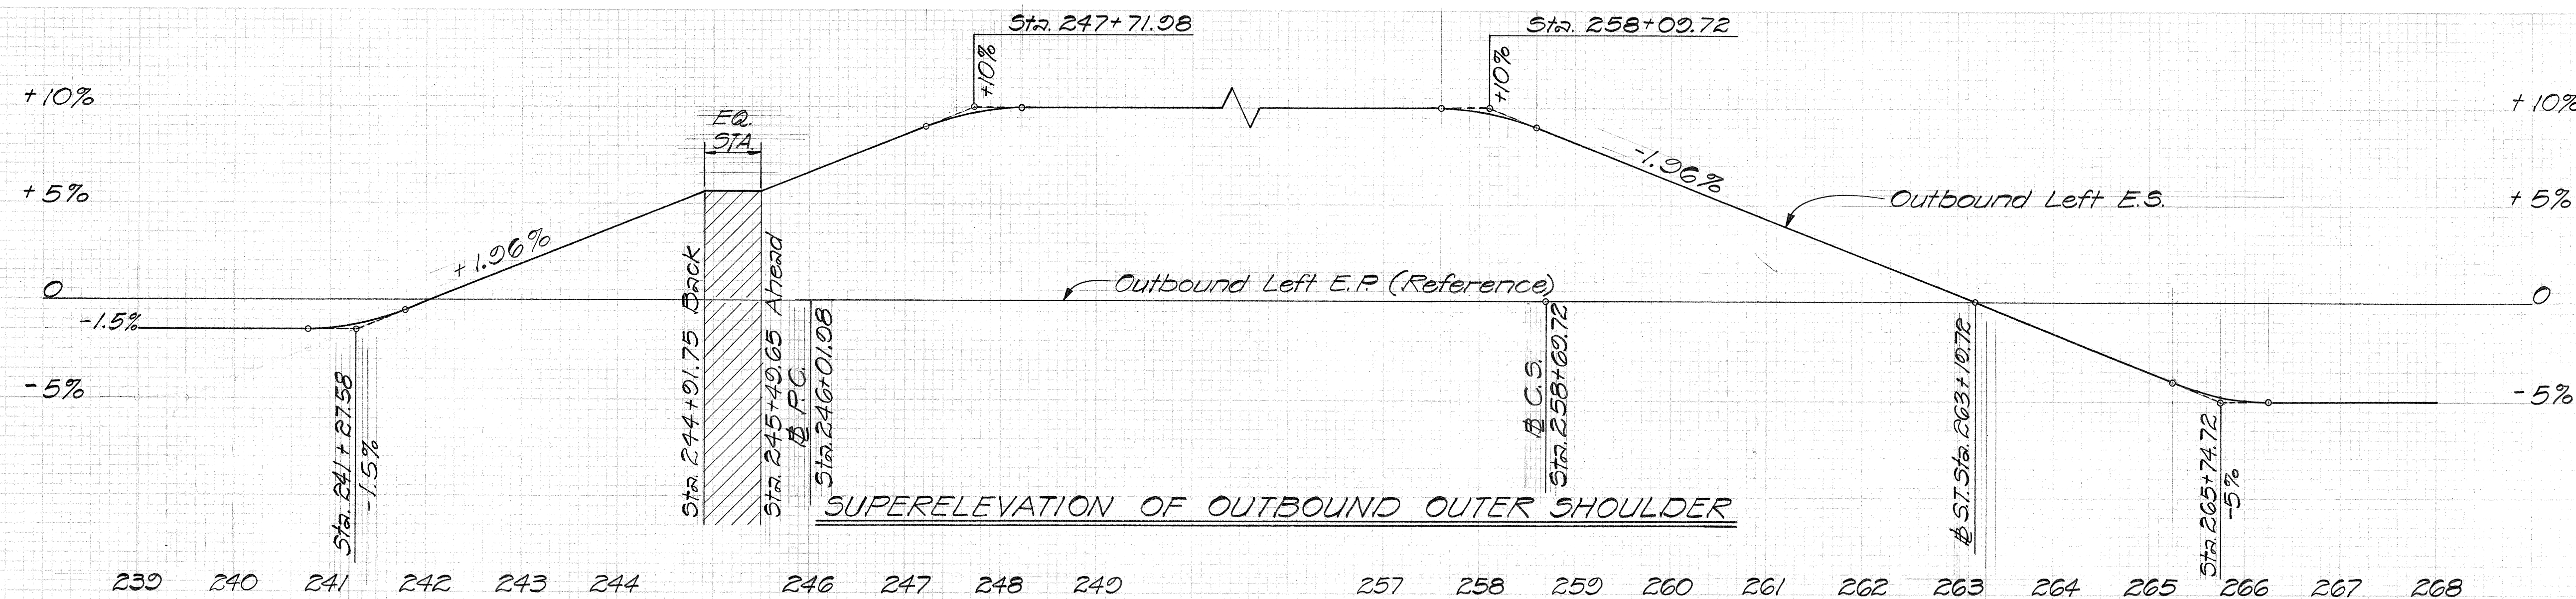

NOTE: All Vertical Curves are 100'

STATE OF HAWAII
DEPARTMENT OF TRANSPORTATION
HIGHWAYS DIVISION



SUPERELEVATION DIAGRAMS

INTERSTATE ROUTE H-2
Kipapa Gulch to Waiahole Ditch
F.A.I. Proj. No. I-H2-1(6):3


Scale: Horiz. 1"=100'
Vert. 1"= 5% Date: April 1972

SHEET No. 1 OF 2 SHEETS

FED. ROAD DIST. NO.	STATE	FED. AID PROJ. NO.	FISCAL YEAR	SHEET NO.	TOTAL SHEETS
HAWAII	HAW.	I-H2-1(6):3	1972	8	83

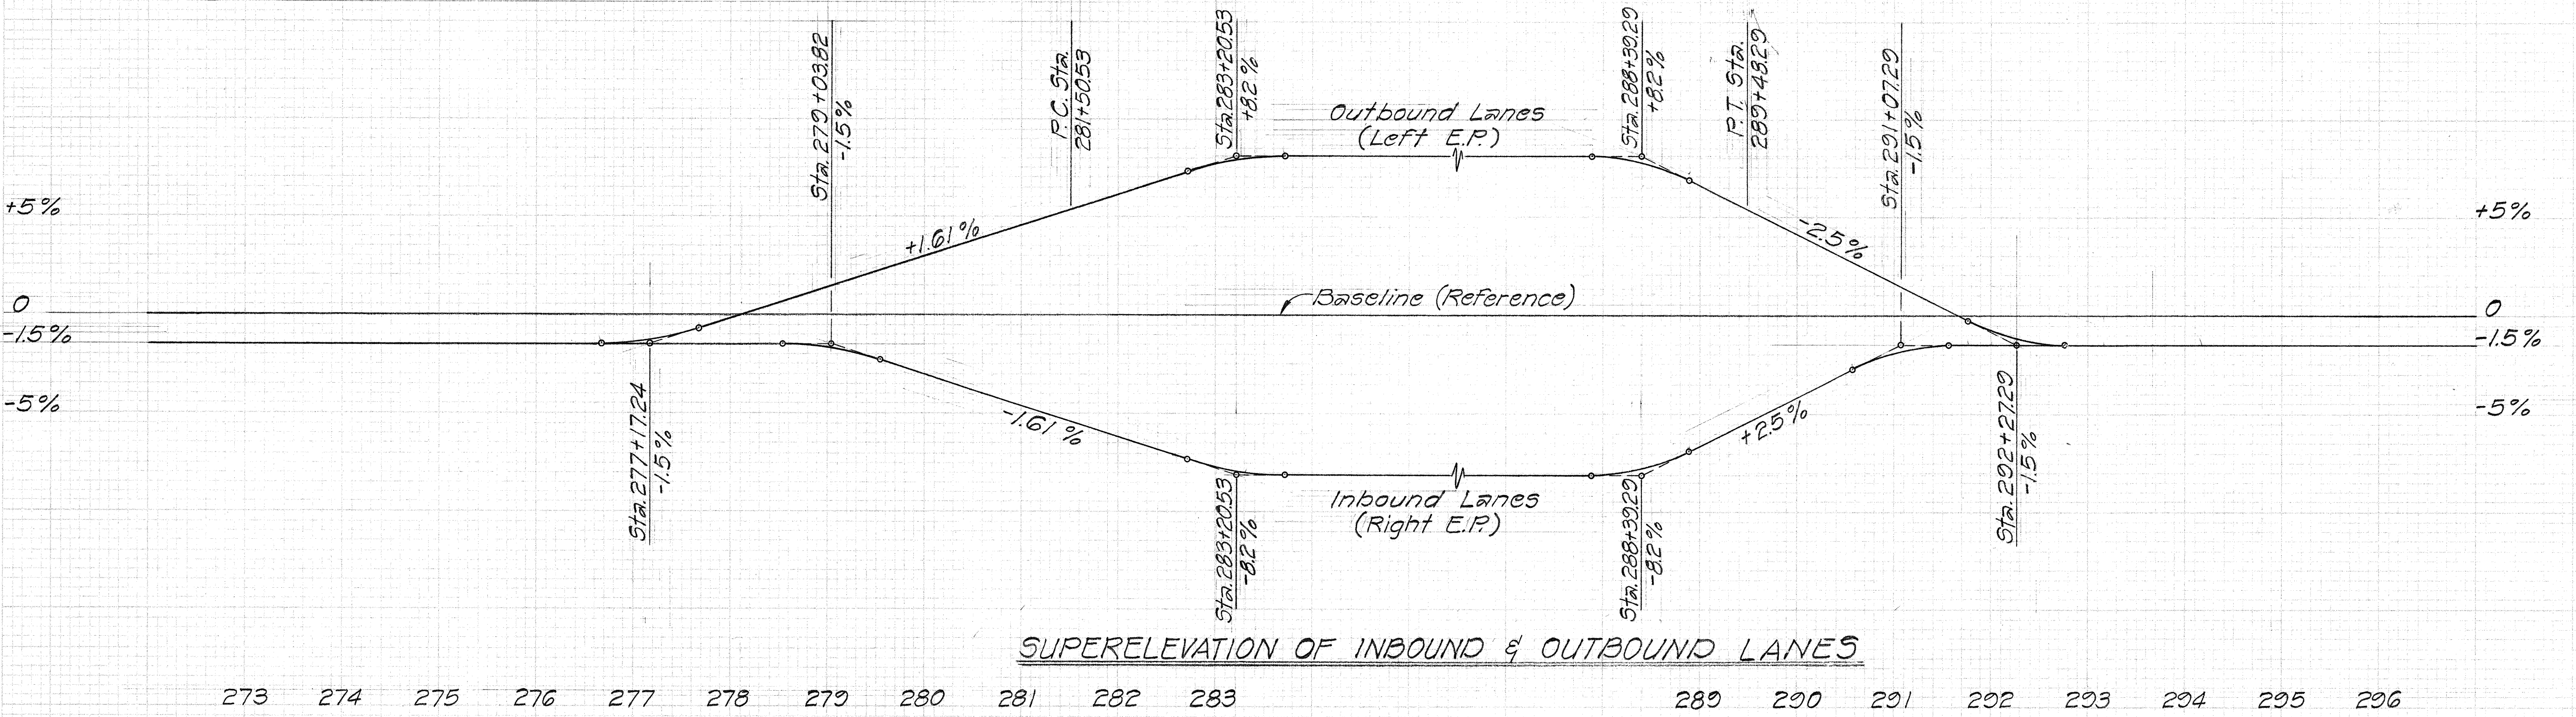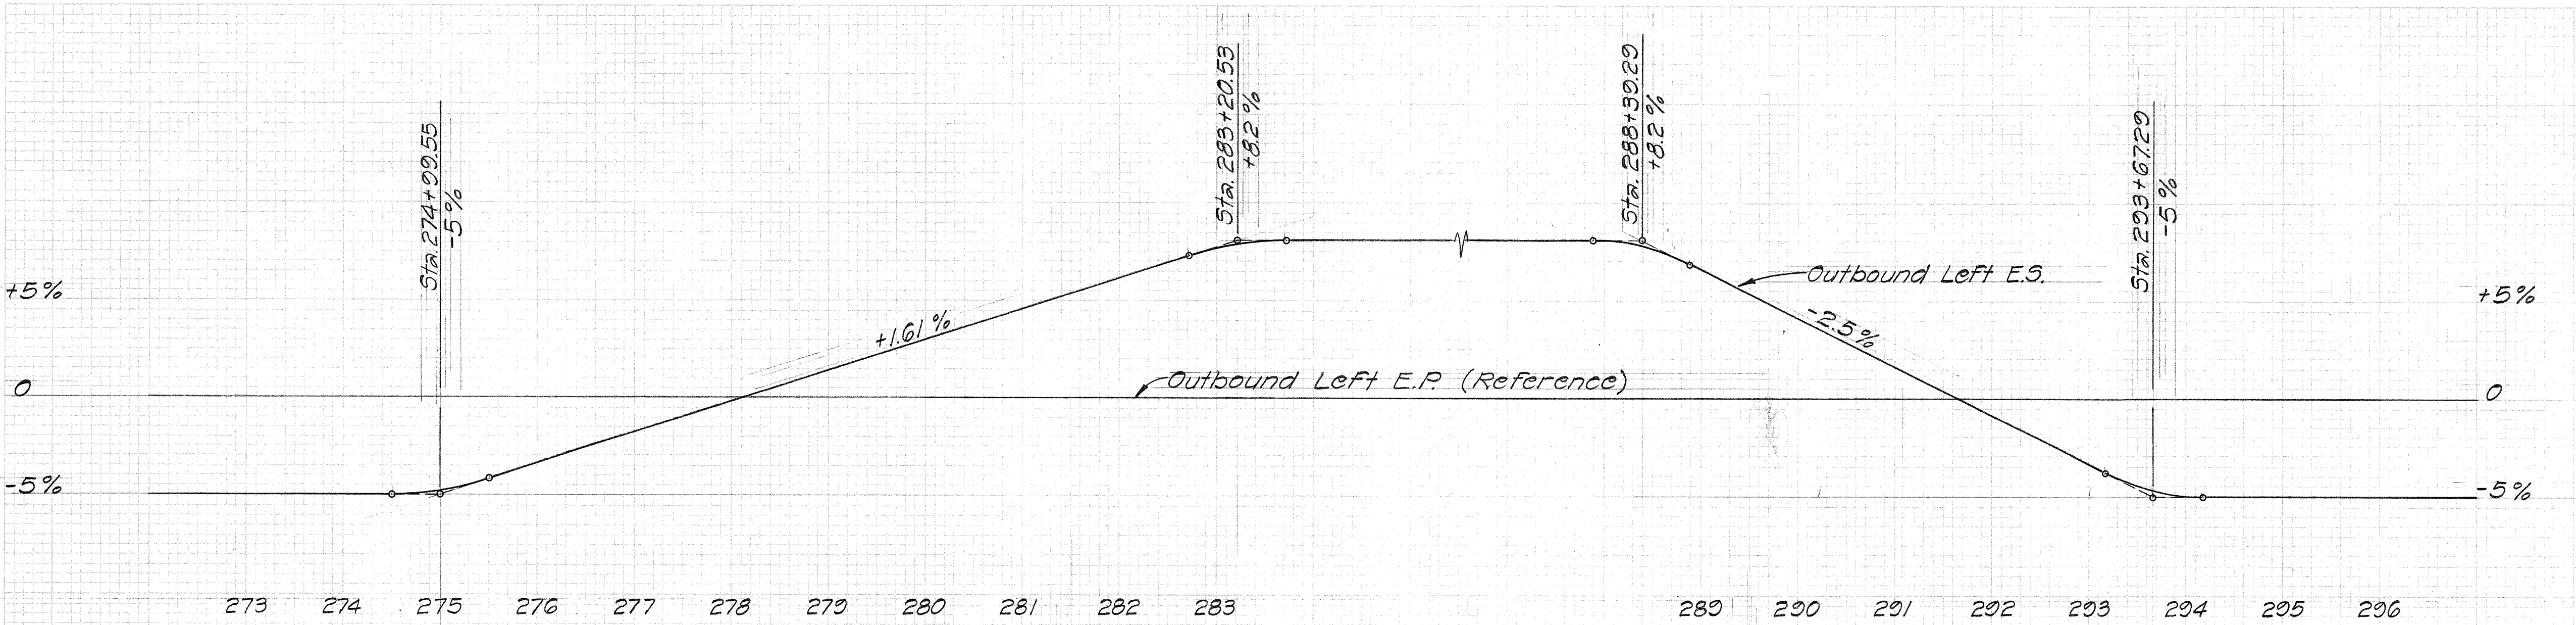

SUPERELEVATION OF INBOUND & OUTBOUND LANES

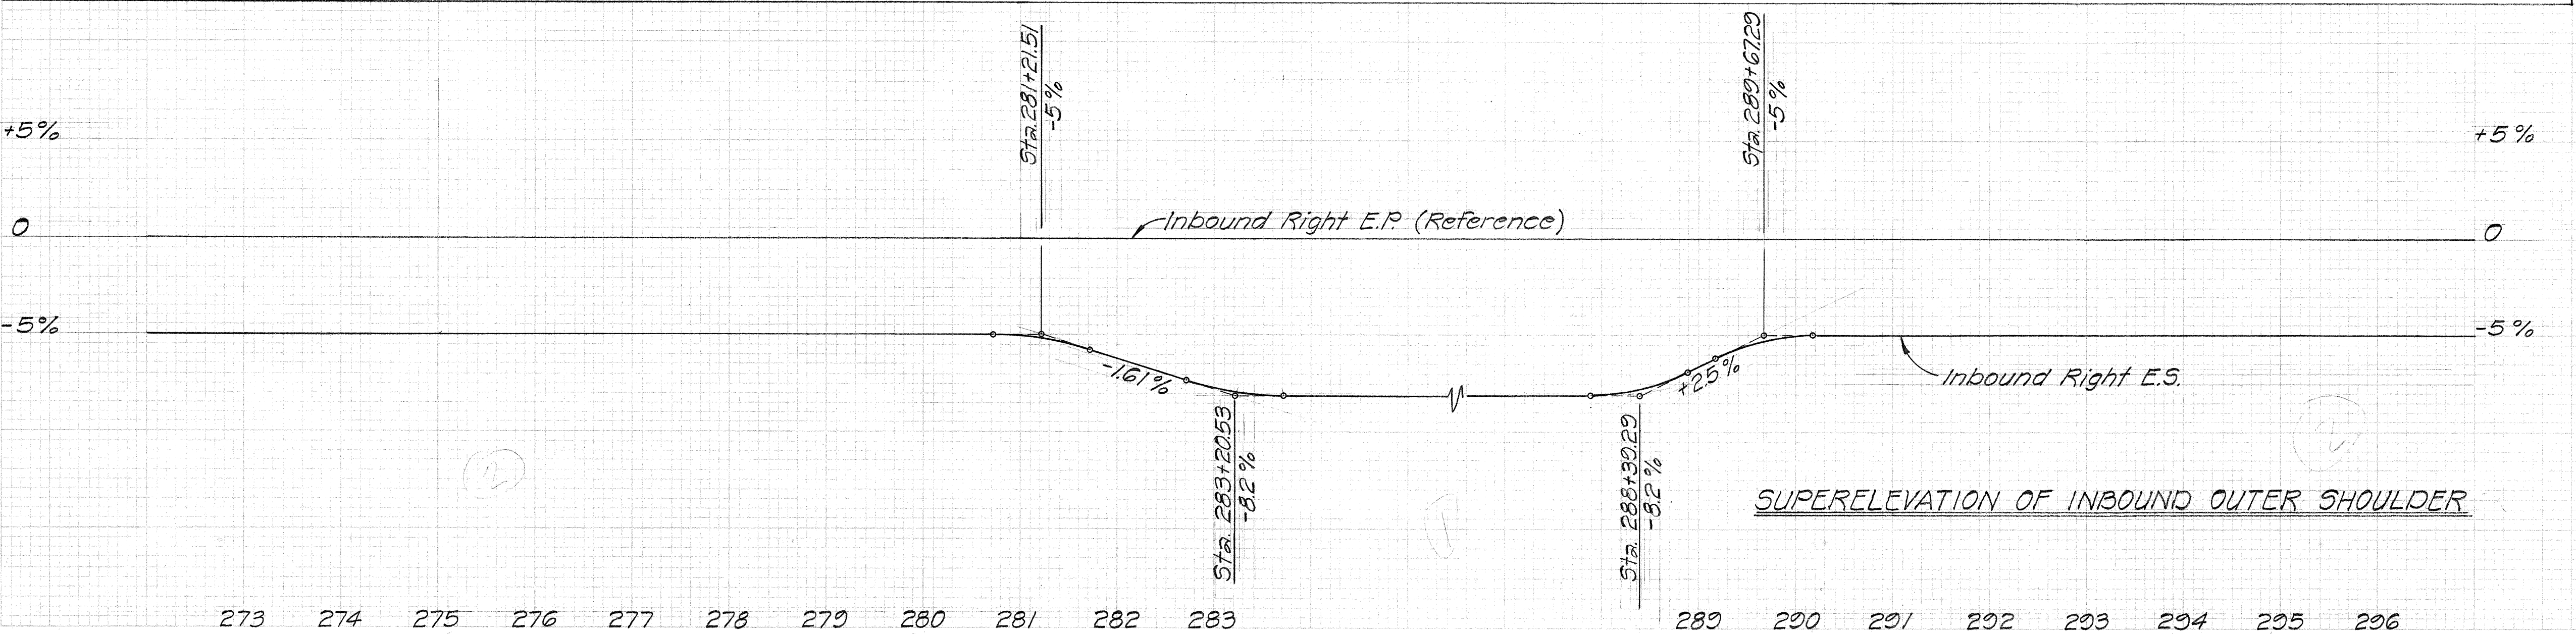

SUPERELEVATION OF INBOUND OUTER SHOULDER

NOTE: All Vertical Curves are 100'

STATE OF HAWAII
 DEPARTMENT OF TRANSPORTATION
 HIGHWAYS DIVISION

SUPERELEVATION DIAGRAMS
 INTERSTATE ROUTE H-2
 Kipapa Gulch to Waihole Ditch
 F.A.I. Proj. No. I-H2-1(6):3

Scale: Horiz. 1"=100'
 Vert. 1"= 5%

Date: April 1972
 SHEET No. 2 OF 8 SHEETS