

INDEX TO DRAWINGS	
SHEET NO.	DESCRIPTION
1	TITLE SHEET
2 - 4	TYPICAL SECTIONS
5 - 6	PLAN AND PROFILE
7 - 8	SUPERELEVATION DIAGRAMS
9	BORINGS, ACCESS TO PROJECT
10 - 11	CONTOUR GRADING PLAN
12	EROSION CONTROL AND FENCING
13 - 19	REHABILITATION
	PINEAPPLE ROAD
	ACCESS ROADS 'A','B','C','D'
	WAIHOLE DITCH BOX CULVERT
20 - 29	STANDARD AND MISCELLANEOUS ROADWAY DETAILS
30 - 49	DRAINAGE PLAN AND DETAILS
50 - 62	PINEAPPLE ROAD SEPARATION
63 - 80	CROSS SECTIONS
81 - 83	F.A.I. PROJ. NO. I-H2-1(14):0
	EROSION CONTROL

STATE OF HAWAII
DEPARTMENT OF TRANSPORTATION
HIGHWAYS DIVISION
HONOLULU, HAWAII

PLANS FOR CONSTRUCTION OF A PORTION OF

INTERSTATE ROUTE H-2

KIPAPA GULCH TO WAIHOLE DITCH
(GRADING AND STRUCTURE)

FEDERAL AID INTERSTATE PROJECT NO. I-H2-1(6):3

AND

INTERSTATE ROUTE H-2

SOUTH OF WAIHOLE DITCH TO WAIAWA INTERCHANGE
(EROSION CONTROL)



FEDERAL AID INTERSTATE PROJECT NO. I-H2-1(14):0

DISTRICT OF EWA
ISLAND OF OAHU

NOTE:
ALL CHANGES MADE DURING
CONSTRUCTION HAVE BEEN
NOTED IN RED ON THESE
TRACINGS AND CHECKED BY

Stefing D. Morlan 17 June 1977
PROJECT ENGINEER DATE

FED. ROAD DIST. NO.	STATE	FED. AID PROJ. NO.	FISCAL YEAR	SHEET NO.	TOTAL SHEETS
HAWAII	HAW.	I-H2-1(6):3 I-H2-1(14):0	1972	1	83

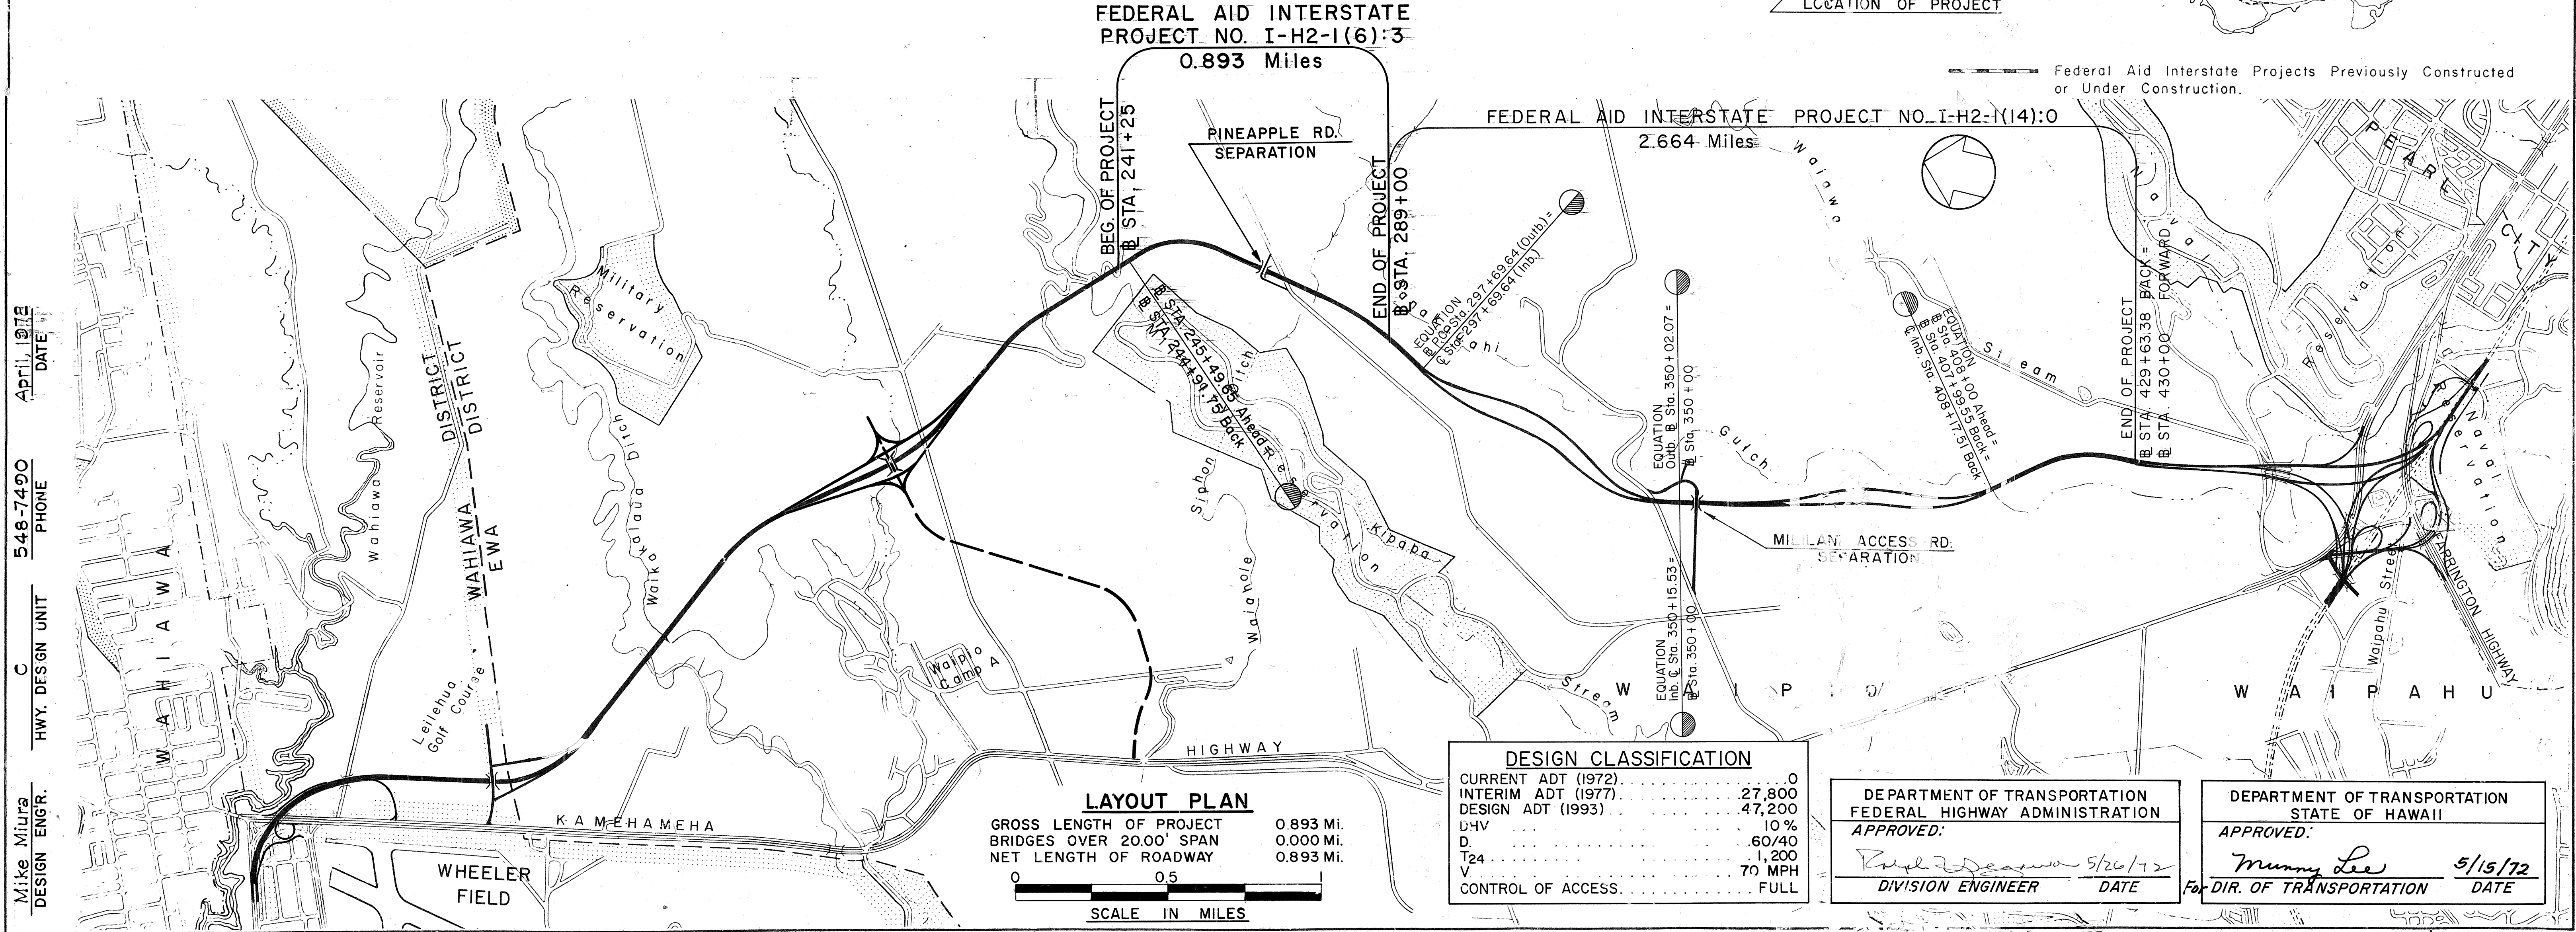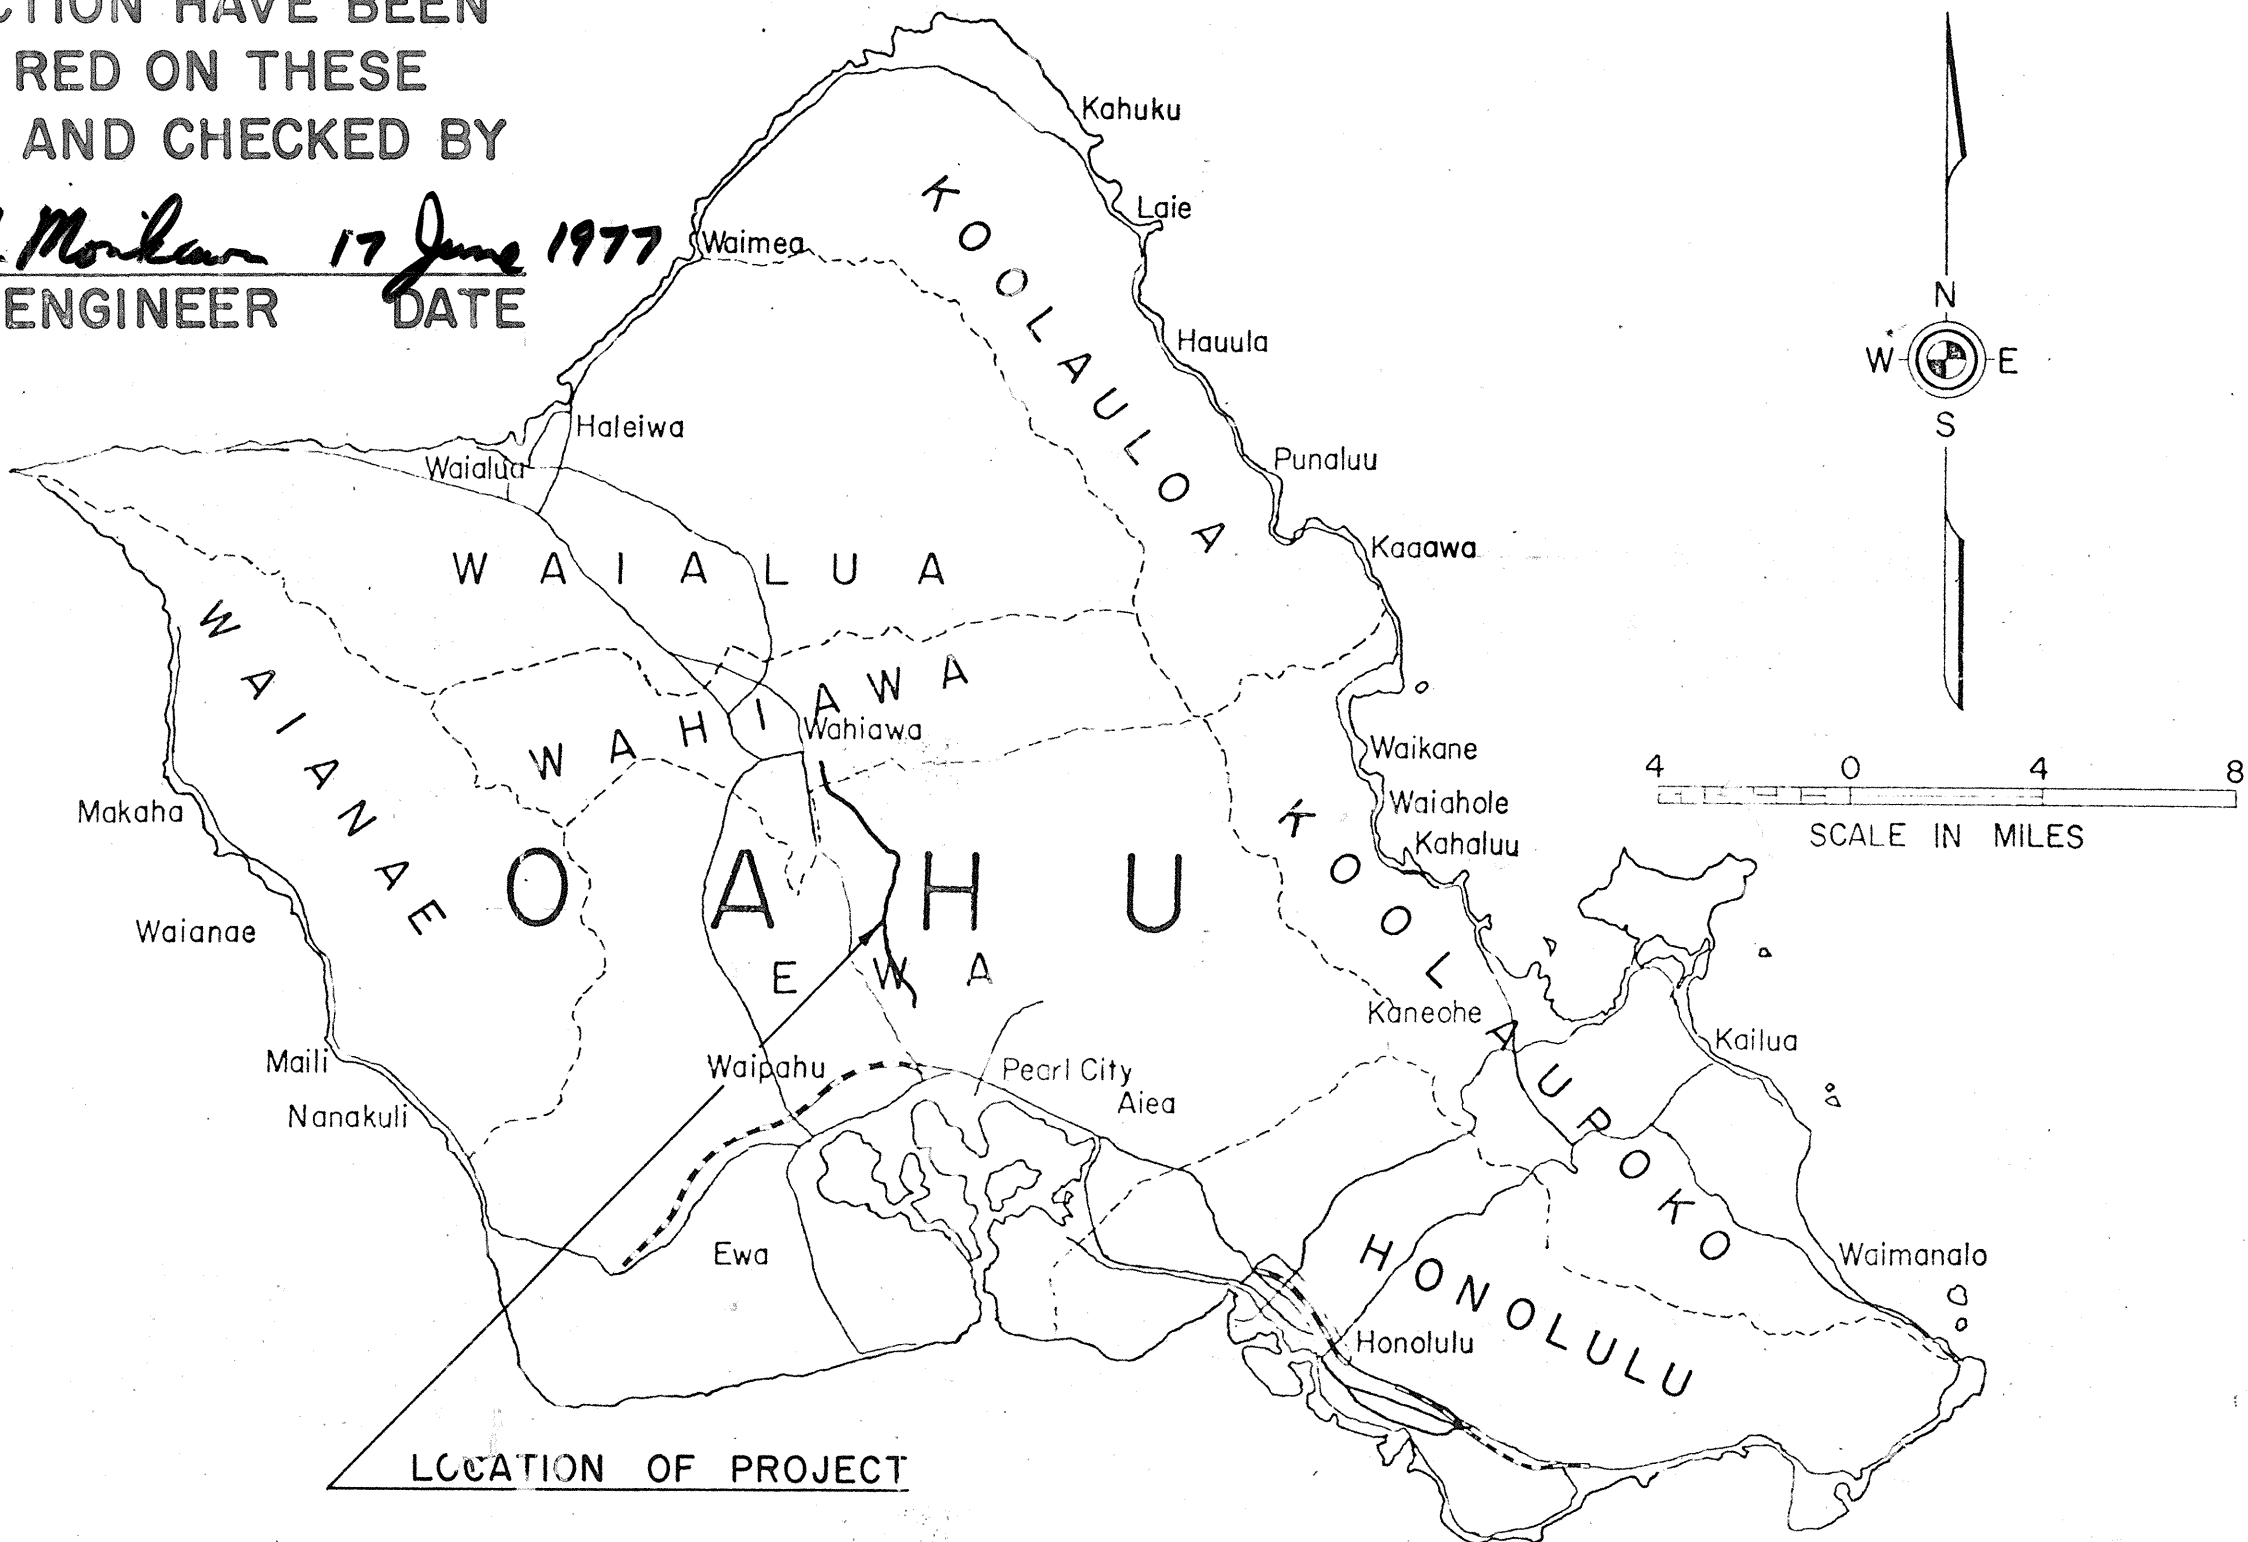

Mike Miura
DESIGN ENGR.

C HWY. DESIGN UNIT

548-7490 PHONE

April, 1972 DATE

LAYOUT PLAN	
GROSS LENGTH OF PROJECT	0.893 Mi.
BRIDGES OVER 20.00' SPAN	0.000 Mi.
NET LENGTH OF ROADWAY	0.893 Mi.
0 0.5 SCALE IN MILES	

DESIGN CLASSIFICATION	
CURRENT ADT (1972)	0
INTERIM ADT (1977)	27,800
DESIGN ADT (1993)	47,200
D/HV	10 %
D	60/40
T24	1,200
V	70 MPH
CONTROL OF ACCESS	FULL

DEPARTMENT OF TRANSPORTATION FEDERAL HIGHWAY ADMINISTRATION	
APPROVED:	
<i>Paul J. ...</i> 5/26/72	DATE
DIVISION ENGINEER	

DEPARTMENT OF TRANSPORTATION STATE OF HAWAII	
APPROVED:	
<i>Mummy Lee</i> 5/15/72	DATE
FOR DIR. OF TRANSPORTATION	