



FED. ROAD DIST. NO.	STATE	FED. AID PROJ. NO.	FISCAL YEAR	SHEET NO.	TOTAL SHEETS
HAWAII	HAW.	I-HI-1(46):8	1973	2	107

Revised: Feb. 1973

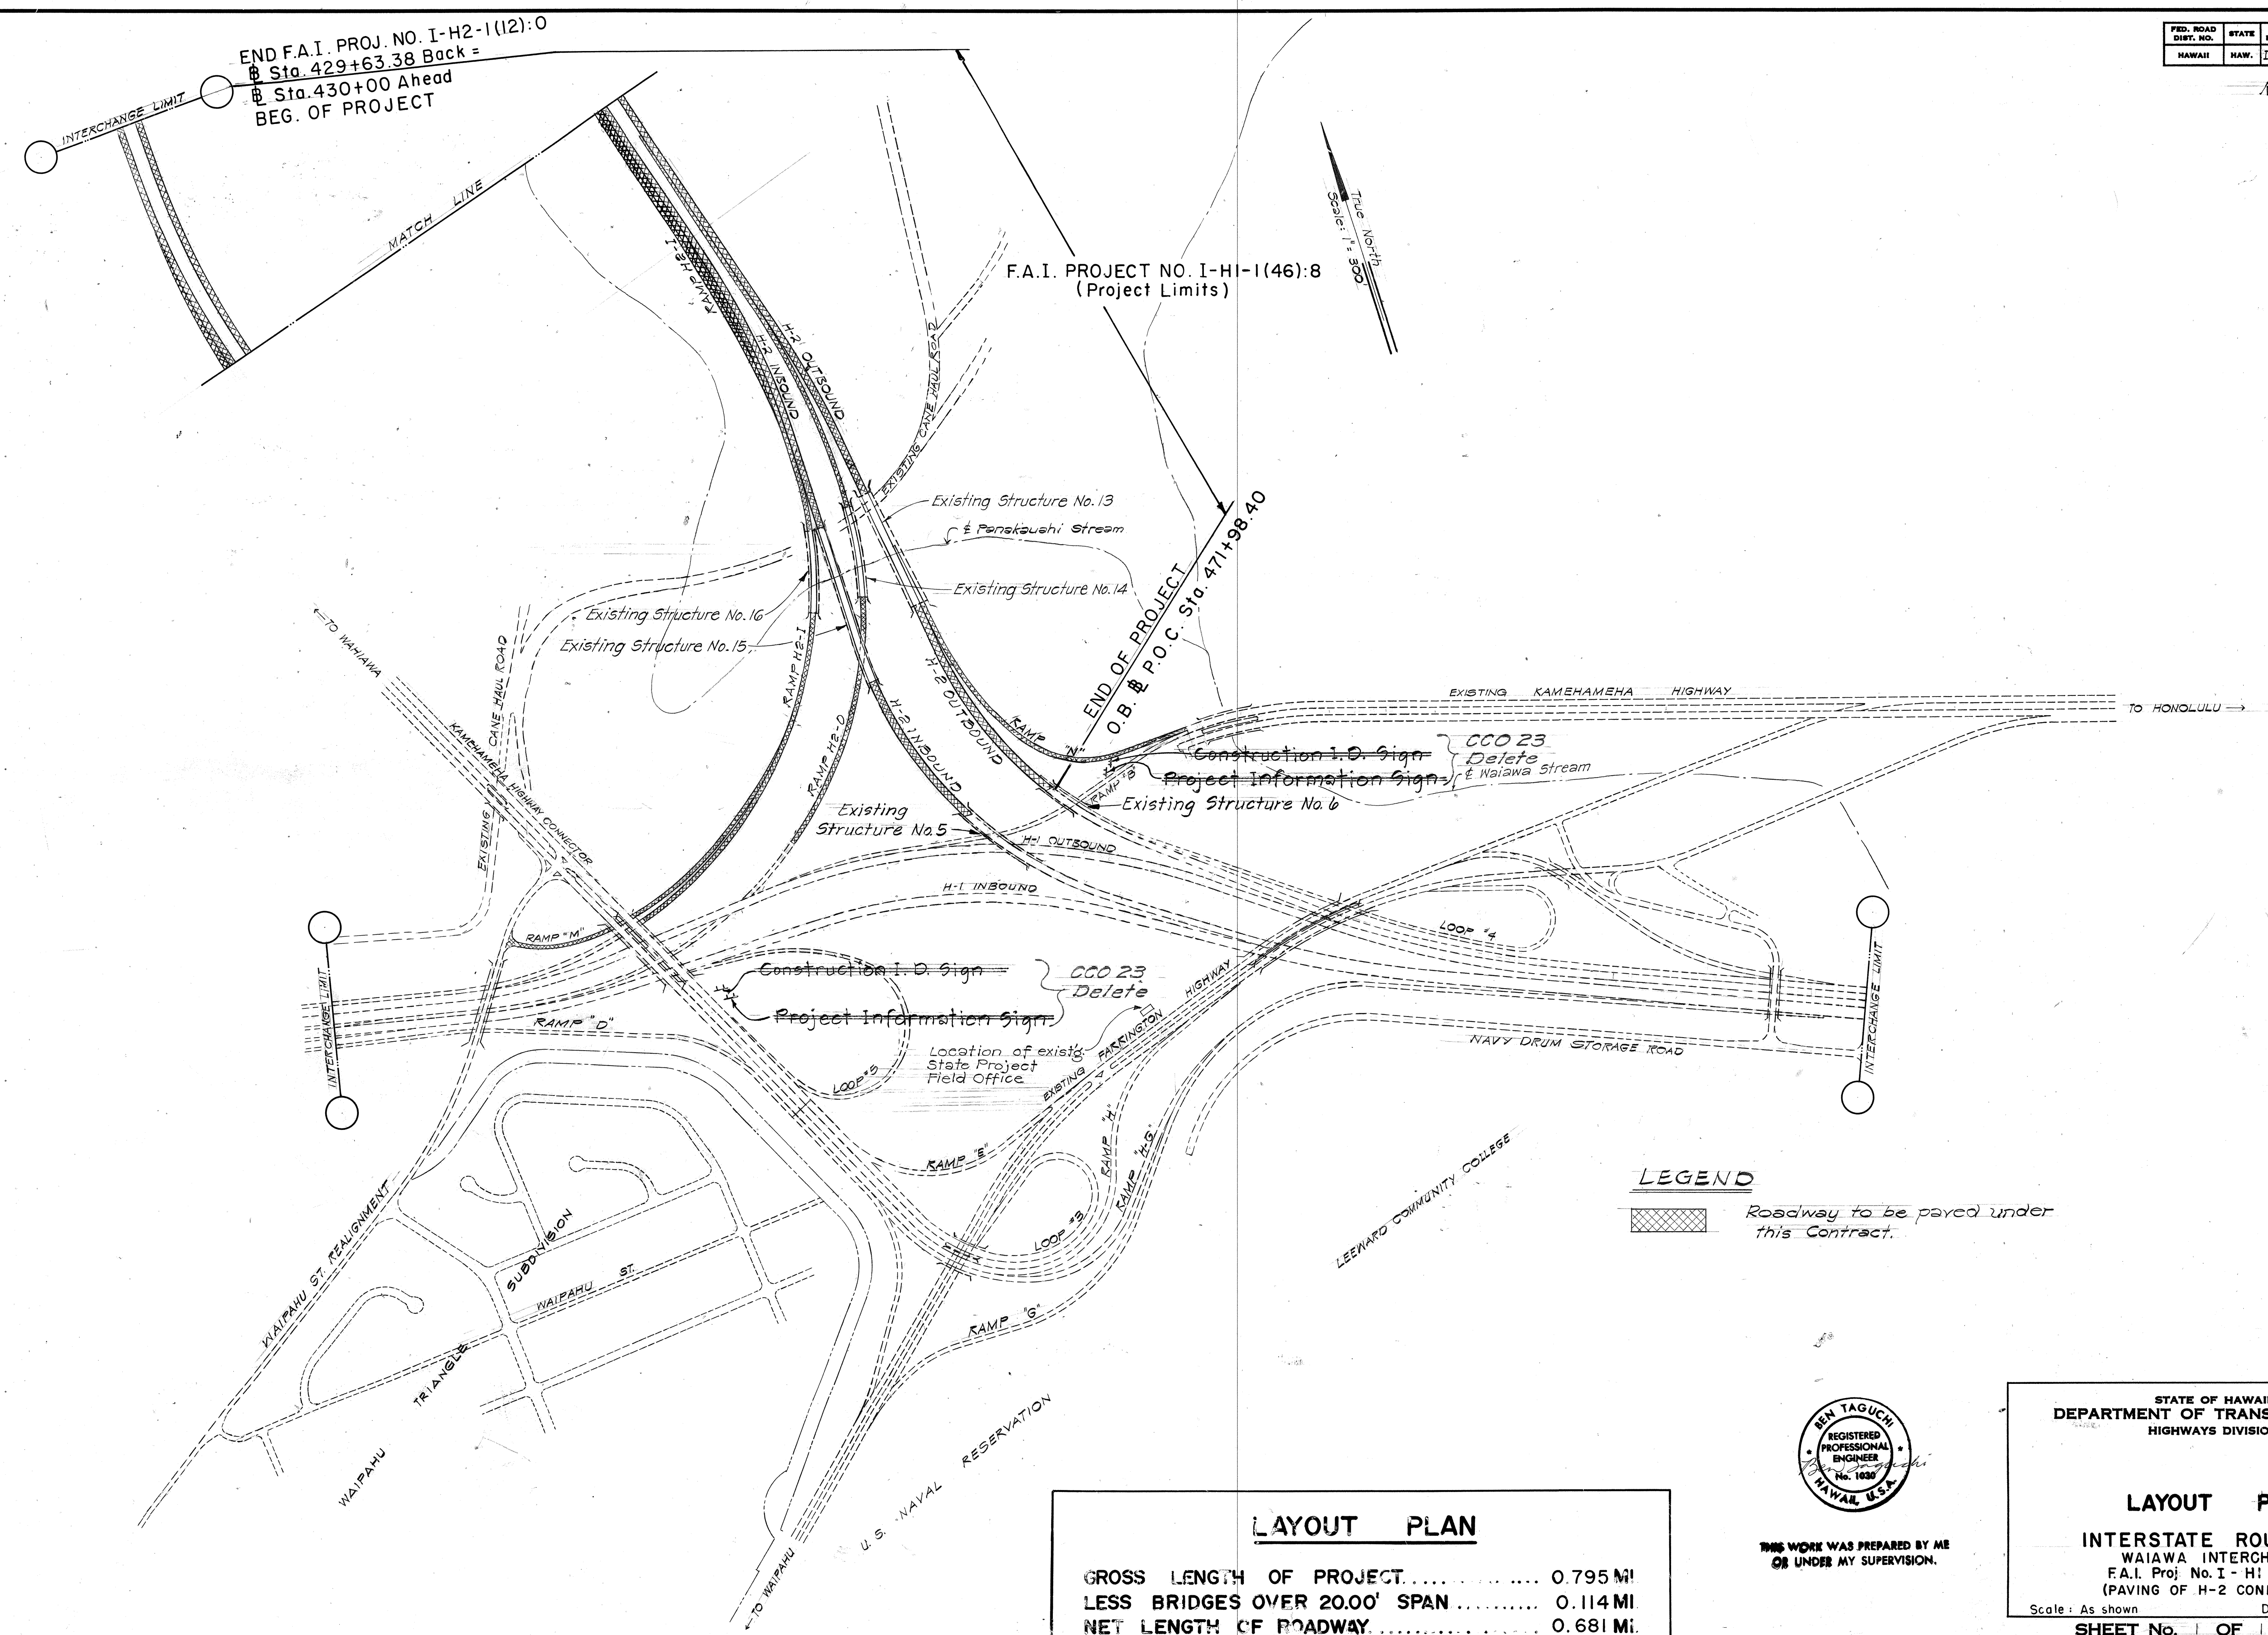

DATE	_____
SURVEY PLOTTED BY	_____
DESIGNED BY	_____
NOTED BY	_____
CHECKED BY	_____
ORIGINAL PLAN	_____
NOTE BOOK	_____
NO.	_____

LAYOUT PLAN	
GROSS LENGTH OF PROJECT.....	0.795 MI.
LESS BRIDGES OVER 20.00' SPAN.....	0.114 MI.
NET LENGTH OF ROADWAY.....	0.681 MI.

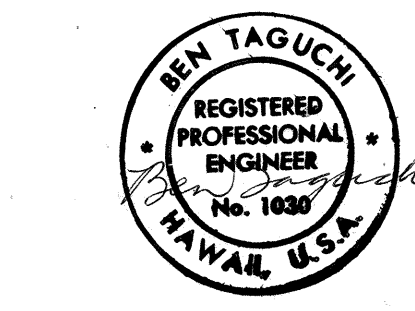

THIS WORK WAS PREPARED BY ME
OR UNDER MY SUPERVISION.

STATE OF HAWAII
DEPARTMENT OF TRANSPORTATION
HIGHWAYS DIVISION

LAYOUT PLAN
INTERSTATE ROUTE H-1
WAIKAWA INTERCHANGE
F.A.I. Proj. No. I - H-1(46):8
(PAVING OF H-2 CONNECTION)

Scale: As shown Date: NOV. 1969
SHEET No. 1 OF 2 SHEETS