

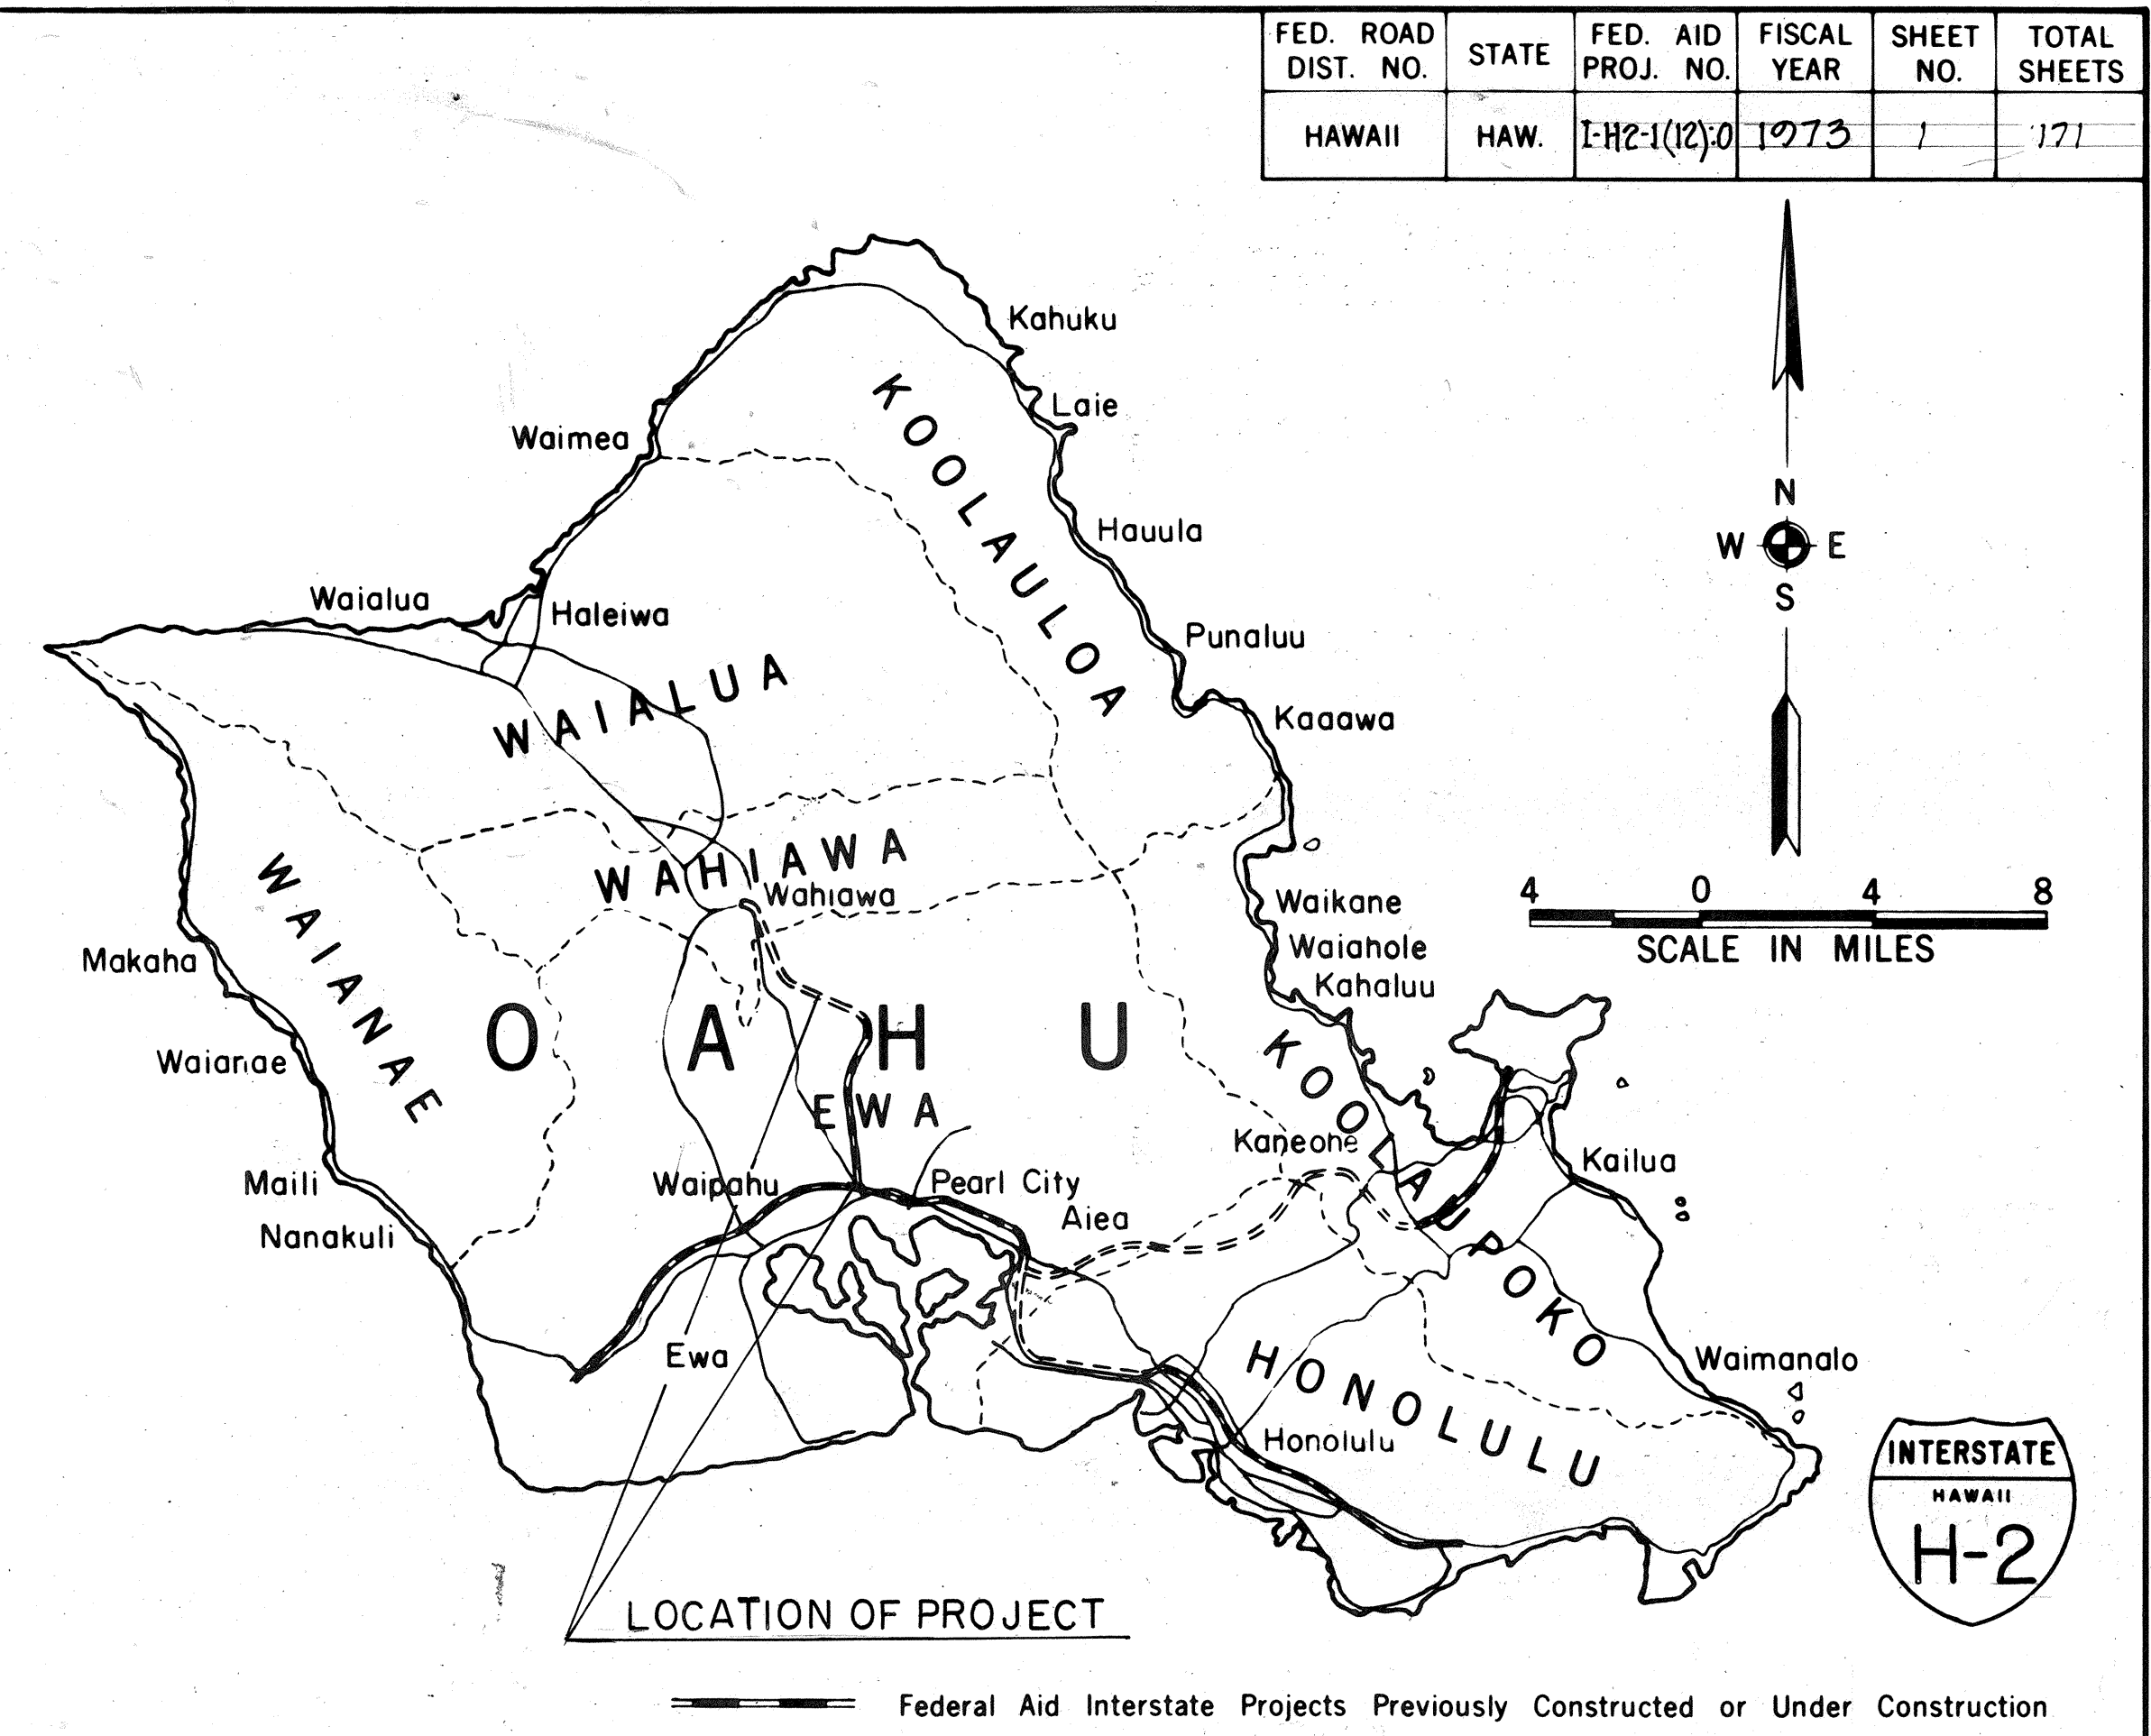
| INDEX TO DRAWINGS |                                               | COMPOSITE SHEET NO. |
|-------------------|-----------------------------------------------|---------------------|
| SHEET NO.         | DESCRIPTION                                   |                     |
| 1                 | TITLE SHEET                                   | 1                   |
| 2-8               | TYPICAL SECTION                               | 2-8                 |
| 9-15              | PLAN AND PROFILE                              | 9-15                |
| 16-25             | SUPERELEVATION DIAGRAM                        | 16-25               |
| 26-38             | DETAIL PLAN OF ROADWAY                        | 26-38               |
| 39-41             | TEMPORARY CONNECTOR                           | 39-41               |
| 42-53             | MISC. ROADWAY AND STANDARD DETAILS            | 42-53               |
| 54-63             | DRAINAGE SUMMARY AND DETAILS                  | 54-63               |
| 64-97             | SIGNING AND PAVEMENT MARKINGS PLANS & DETAILS | 64-97               |
| 98-99             | CROSS SECTION KEY                             | 98-99               |
| 100-171           | CROSS SECTIONS                                | 100-171             |

SUPPLEMENT: SHEET NO. 42A

Sht. Nos. ① C0.38 S-1, ② C0.40 S-1, C0.40 S-2, ③ 42 S-1, C0.53 S-1, C0.53 S-2, C0.53 S-3, C0.53 S-4, ④ 61 S-1, ⑤ C0.97 S-1, & C0.97 S-2 are supplementary sheets to this project.





STATE OF HAWAII  
DEPARTMENT OF TRANSPORTATION  
HIGHWAYS DIVISION  
HONOLULU, HAWAII  
"AS BUILT"  
PLANS FOR  
CONSTRUCTION OF A PORTION OF  
**INTERSTATE ROUTE H-2**  
KIPAPA GULCH TO WAIAWA INTERCHANGE  
(PAVING)  
FED. AID INTERSTATE PROJ. NO. I-H2-1(12):0  
DISTRICT OF EWA  
ISLAND OF OAHU



NOTE:  
CHANGES MADE DURING CONSTRUCTION HAVE BEEN INCORPORATED ON THESE PLANS IN RED, EXCEPT CHANGES IN THE ORIGINAL THEORETICAL QUANTITIES FOR ACTUAL QUANTITIES, REFER TO PROJECT LEDGER AND/OR COMPUTATION BOOK.

*Huling H. Morikawa*  
PROJECT ENGINEER  
17 March 1976  
DATE

| DESIGN CLASSIFICATION |        |
|-----------------------|--------|
| CURRENT ADT (1973)    | 0      |
| INTERIM ADT (1977)    | 27,800 |
| DESIGN ADT (1993)     | 47,200 |
| DHV                   | 10 %   |
| D                     | 60/40  |
| T24                   | 1,200  |
| V                     | 70 MPH |
| CONTROL OF ACCESS     | FULL   |

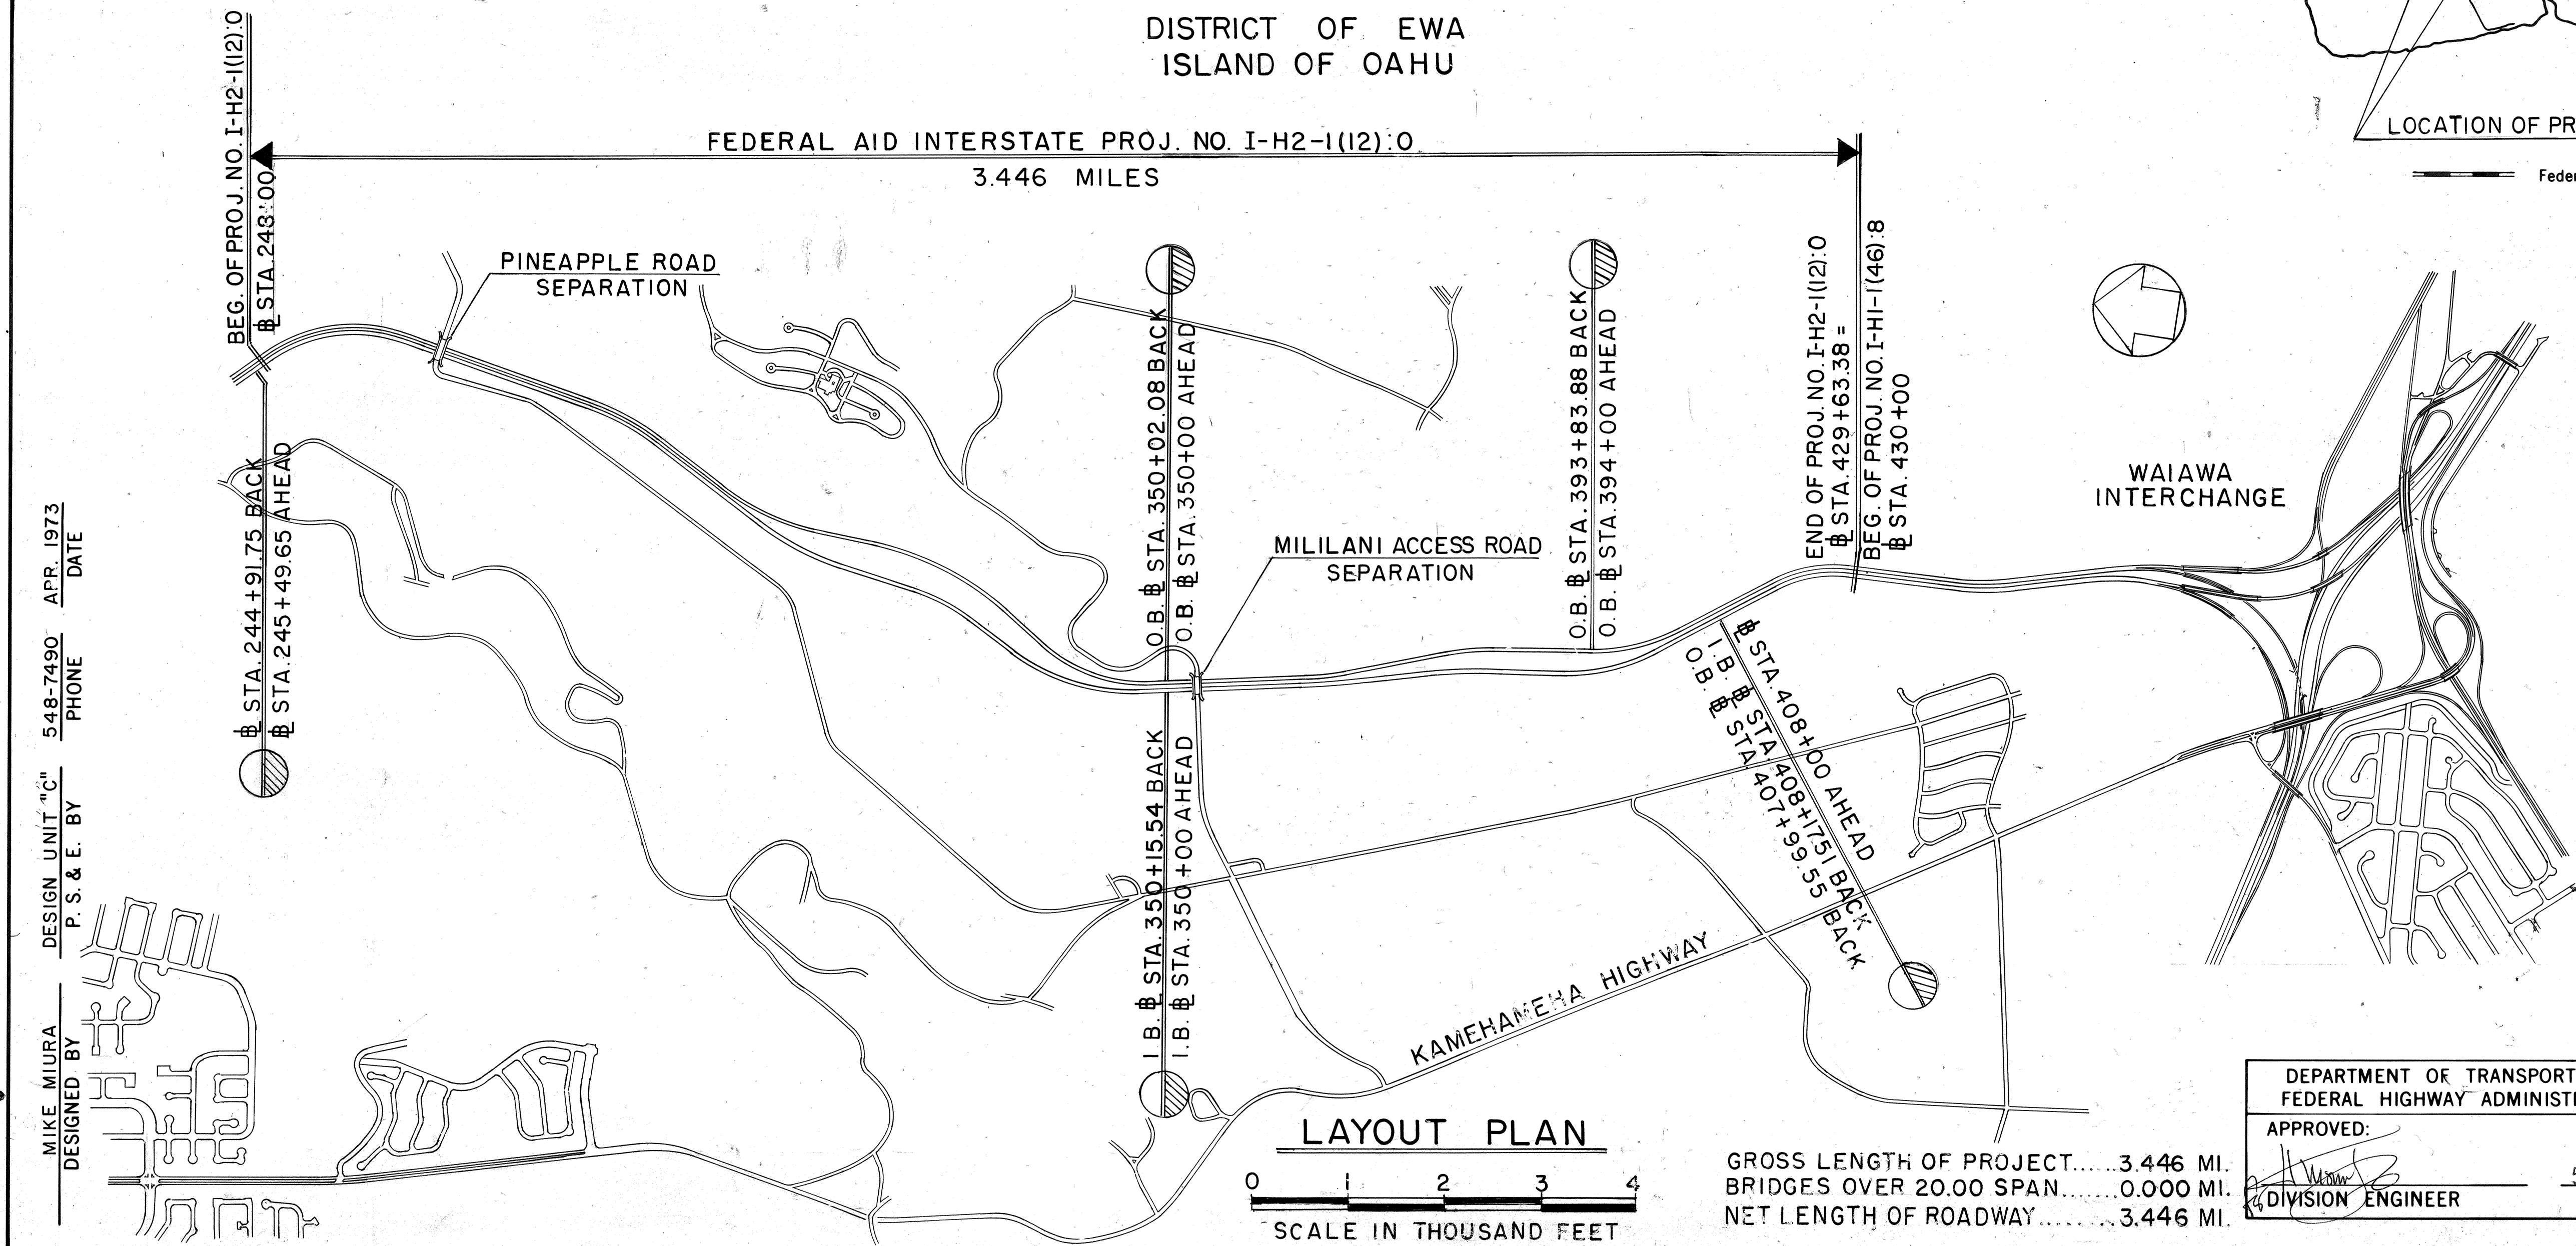

DESIGNED BY  
P. S. & E. BY  
DATE  
548-7490  
PHONE  
APR. 1973  
DATE

GROSS LENGTH OF PROJECT..... 3.446 MI.  
BRIDGES OVER 20.00 SPAN..... 0.000 MI.  
NET LENGTH OF ROADWAY..... 3.446 MI.

DEPARTMENT OF TRANSPORTATION  
FEDERAL HIGHWAY ADMINISTRATION  
APPROVED:  

*[Signature]*

  
DIVISION ENGINEER  
5-773  
DATE

DEPARTMENT OF TRANSPORTATION  
STATE OF HAWAII  
APPROVED:  

*[Signature]*

  
FOR DIR. OF TRANSPORTATION  
4/30/73  
DATE