
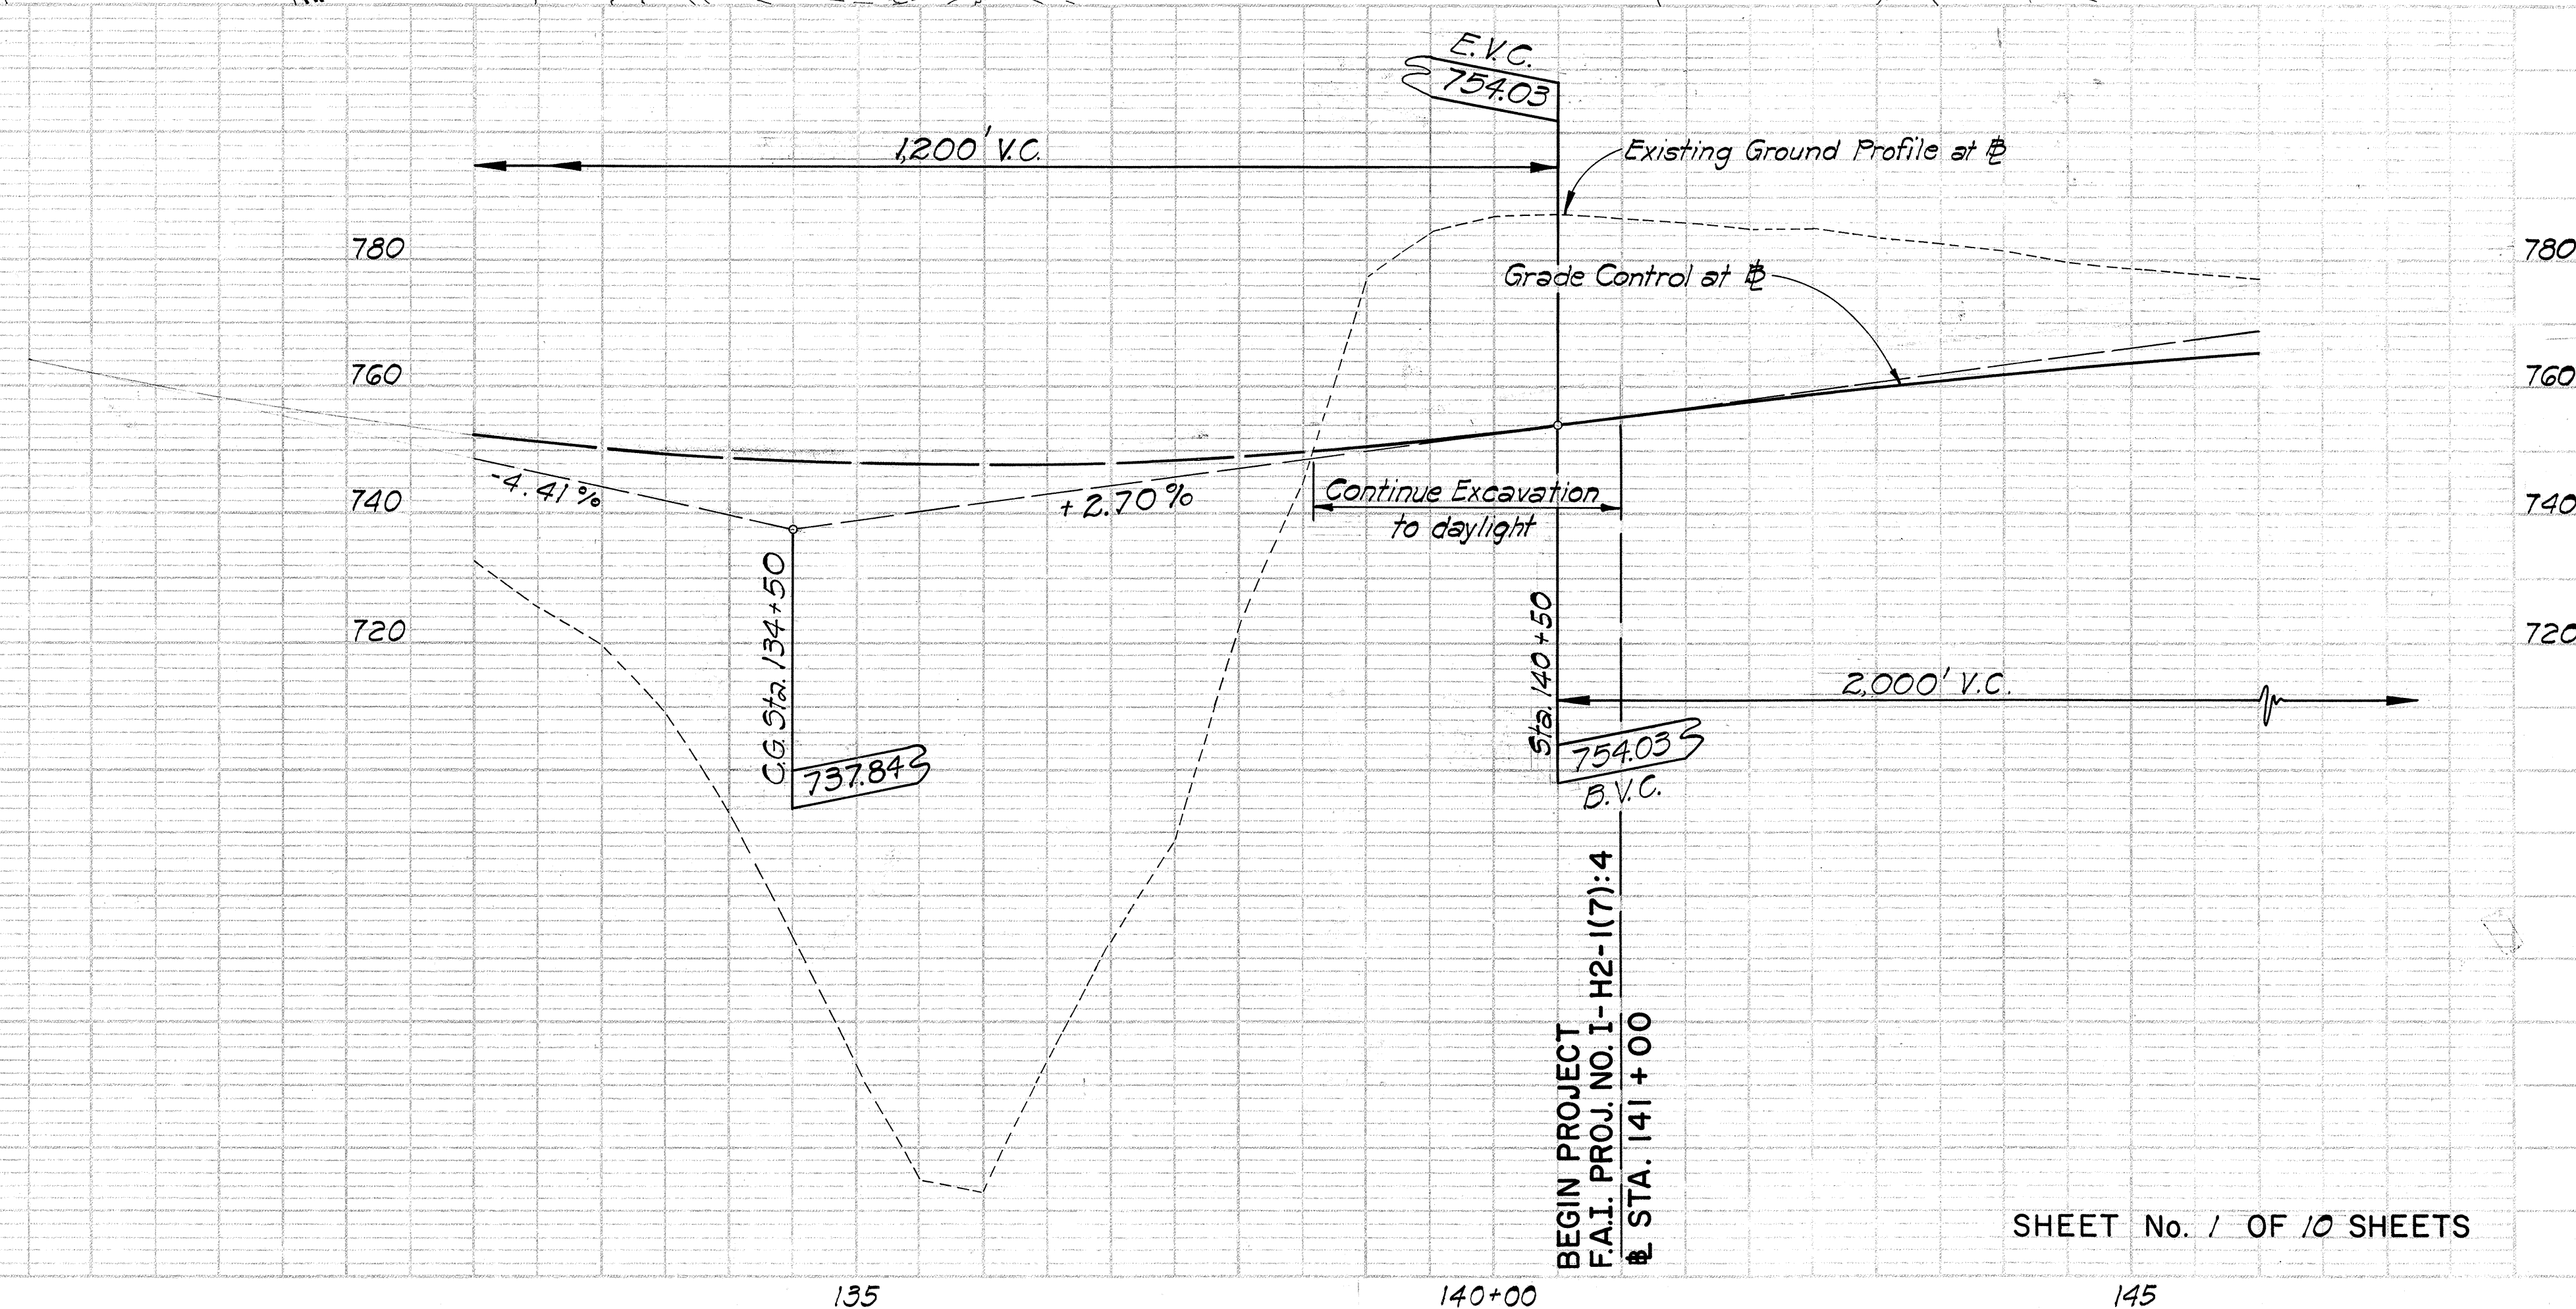


GENERAL NOTES

- Origin of Azimuth: Central Meridian 158°00'00" (Zone III)
- Field Office and Project Site Laboratory:
 - The locations of the proposed Field Office and Project Site Laboratory are shown on plan Sht. Nos. 20 & 21.
 - For additional requirements see Section 636 of the Special Provisions.
- The symbol  indicates boring locations. For boring logs see sht. nos. 27 & 28.
- Highway Lighting System Sleeves:
 - PVC Conduits encased in concrete jacket for highway lighting systems shall be installed under Roadway Construction and paid for under the respective contract items. For locations of these sleeves, see sheet nos. 31, 32, 33, 34, 35 & 36 and for details, see sheet no. 43.
- Special Construction Requirements
 - The cuts at Sta. 138+00± to Sta. 141+25± shall be excavated to the rough finish grades by March 31, 1974.
 - The cuts at Inbound Sta. 222+75± to Sta. 225+85± shall be excavated to the rough finish grades by April 30, 1974.
 - The drainage system between Inbound Sta. 225+00± and Sta. 230+50± shall be considered one of the first orders of work.
- Final elevations of Reference Survey Monuments to be installed under this project shall be inserted by the Engineer on the As-Built plans.

FED. ROAD DIST. NO.	STATE	FED. AID PROJ. NO.	FISCAL YEAR	SHEET NO.	TOTAL SHEETS
HAWAII	HAW.	I-H2-1(7)-4	1973	11	220


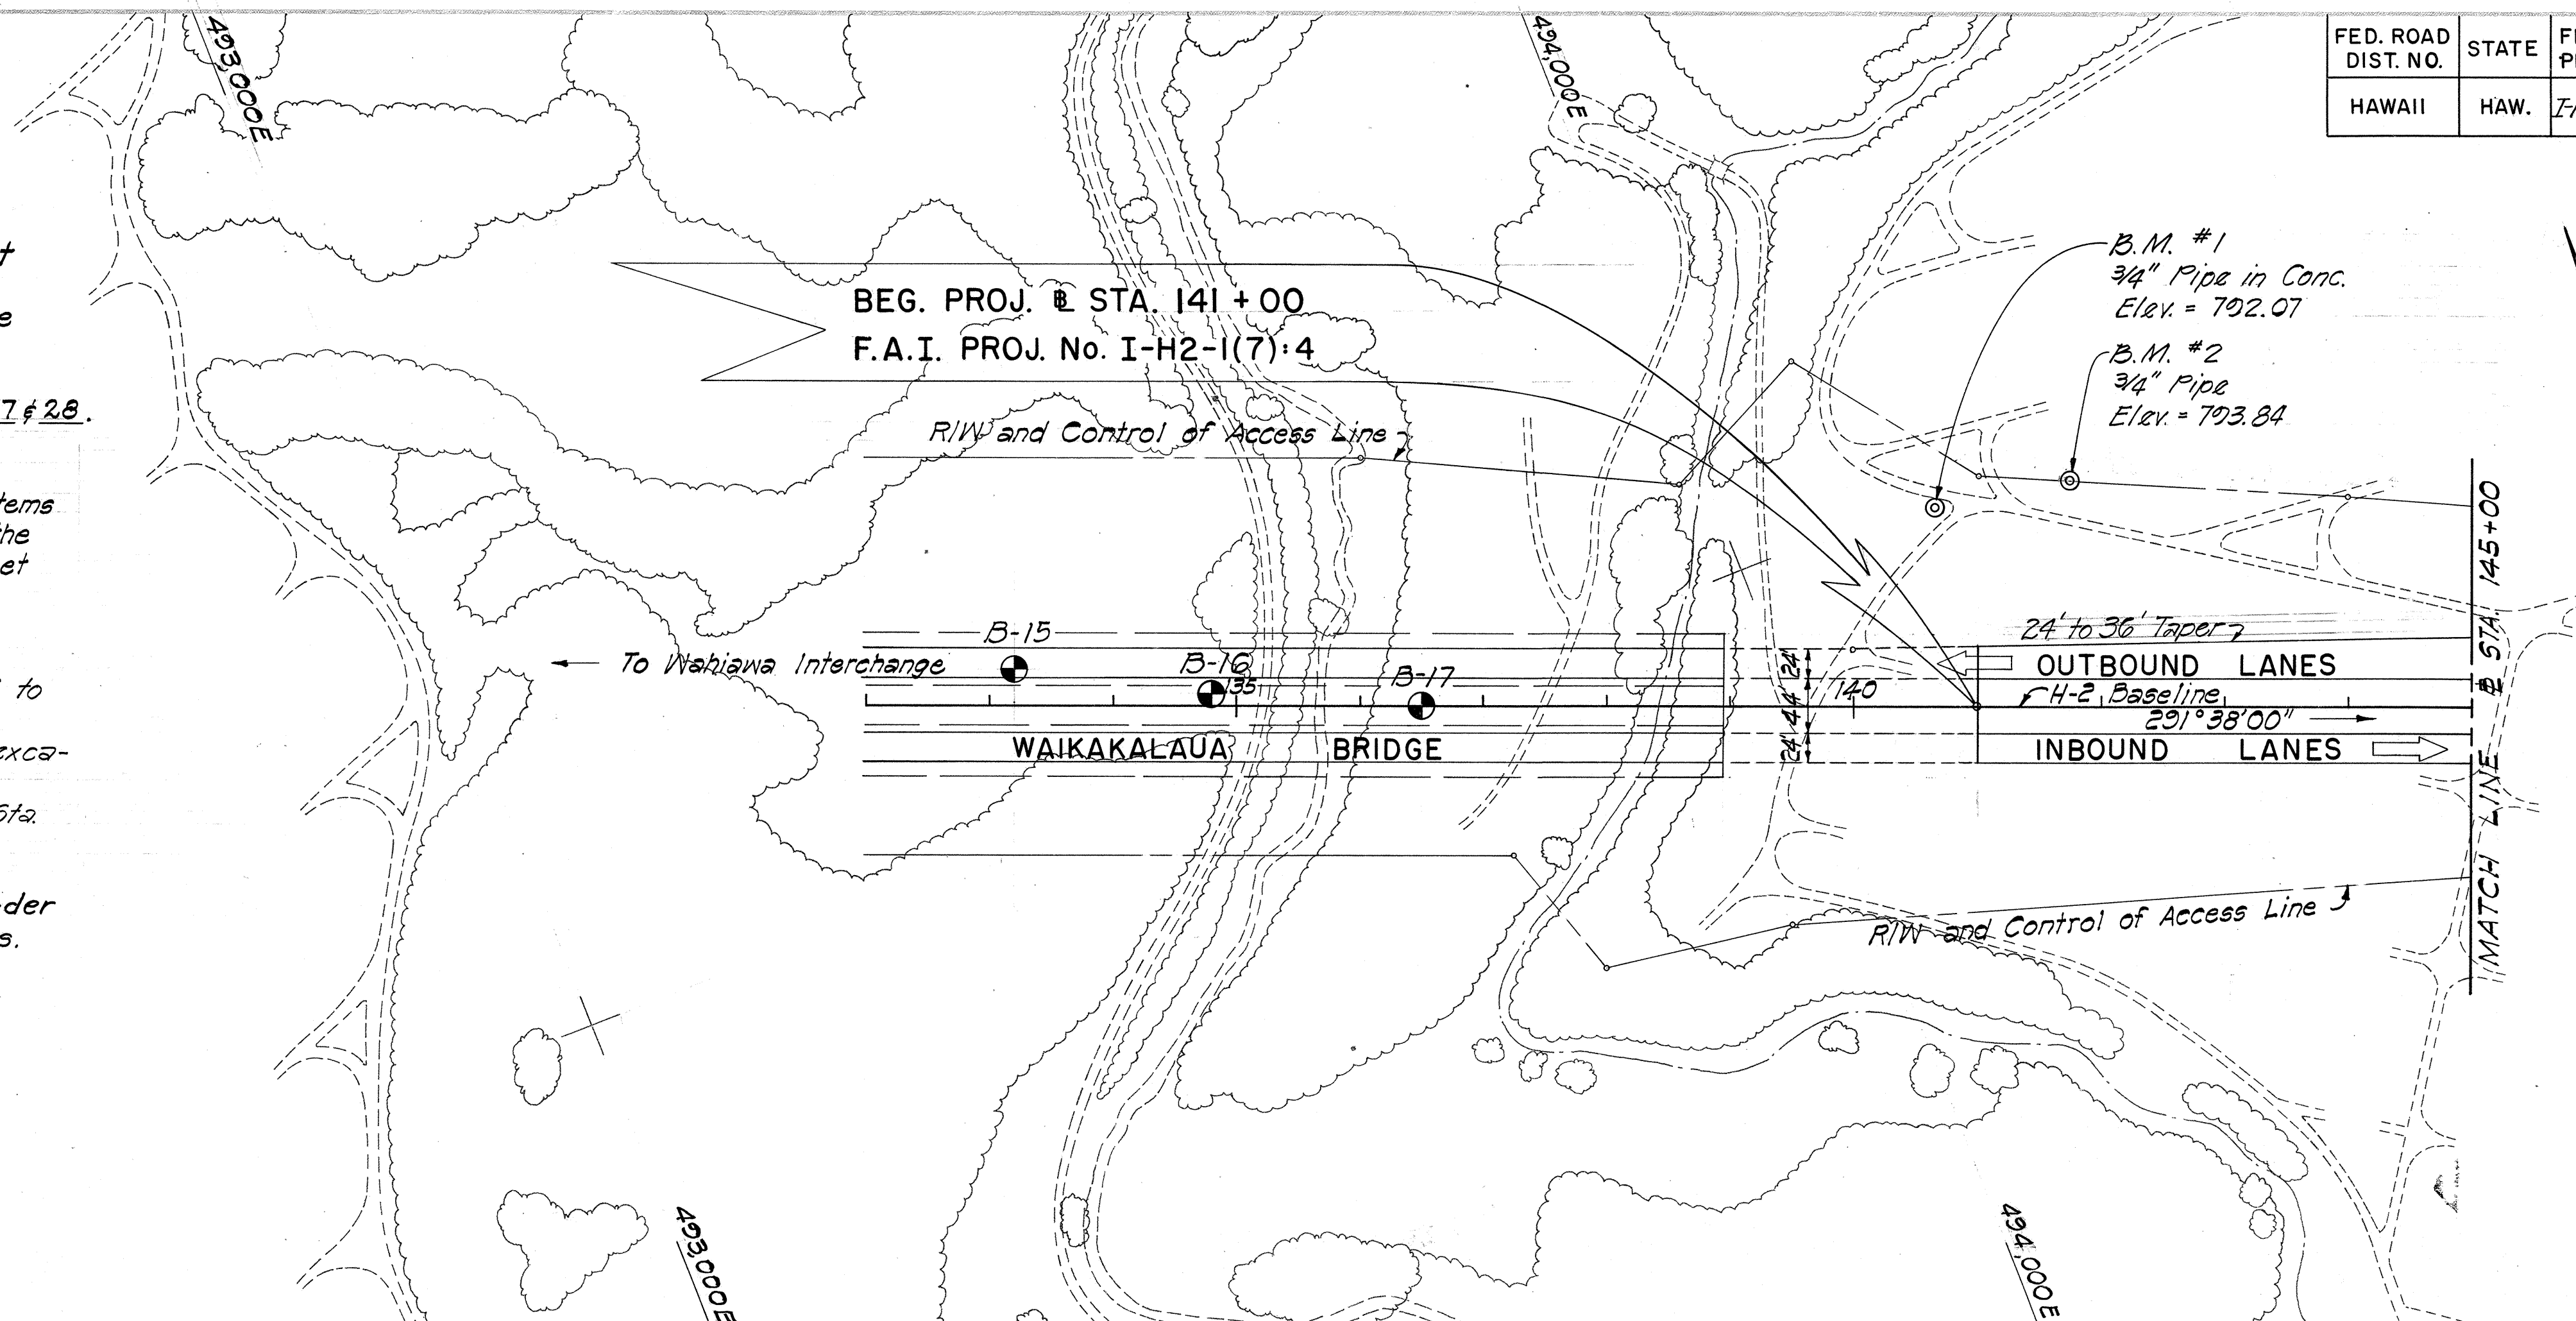


PLAN	SURVEYED	DATE
	NOTED	BY
	NOTE BOOK	ADJUSTMENT CHECKED
	NO.	ST. OF WAY CHECKED

PROFILE	SURVEYED	DATE
	NOTED	BY
	NOTE BOOK	ADJUSTMENT CHECKED
	NO.	STATIONING NOTATION CHG.

CURVE DATA TABLE			
NO.	N. COORDINATE	E. COORDINATE	DATA
1	P.C. 112,485.35	495,000.99	Δ 30°07'00"
	P.T. 111,709.17	496,042.61	R 2,500.00'
	C.C. 110,161.44	494,079.32	L 1,314.09'
	P.I. 112,237.38	495,626.21	T 672.60'

FED. ROAD DIST. NO.	STATE	FED. AID PROJ. NO.	FISCAL YEAR	SHEET NO.	TOTAL SHEETS
HAWAII	HAW.	I-412-1(7)4	1973	12	229

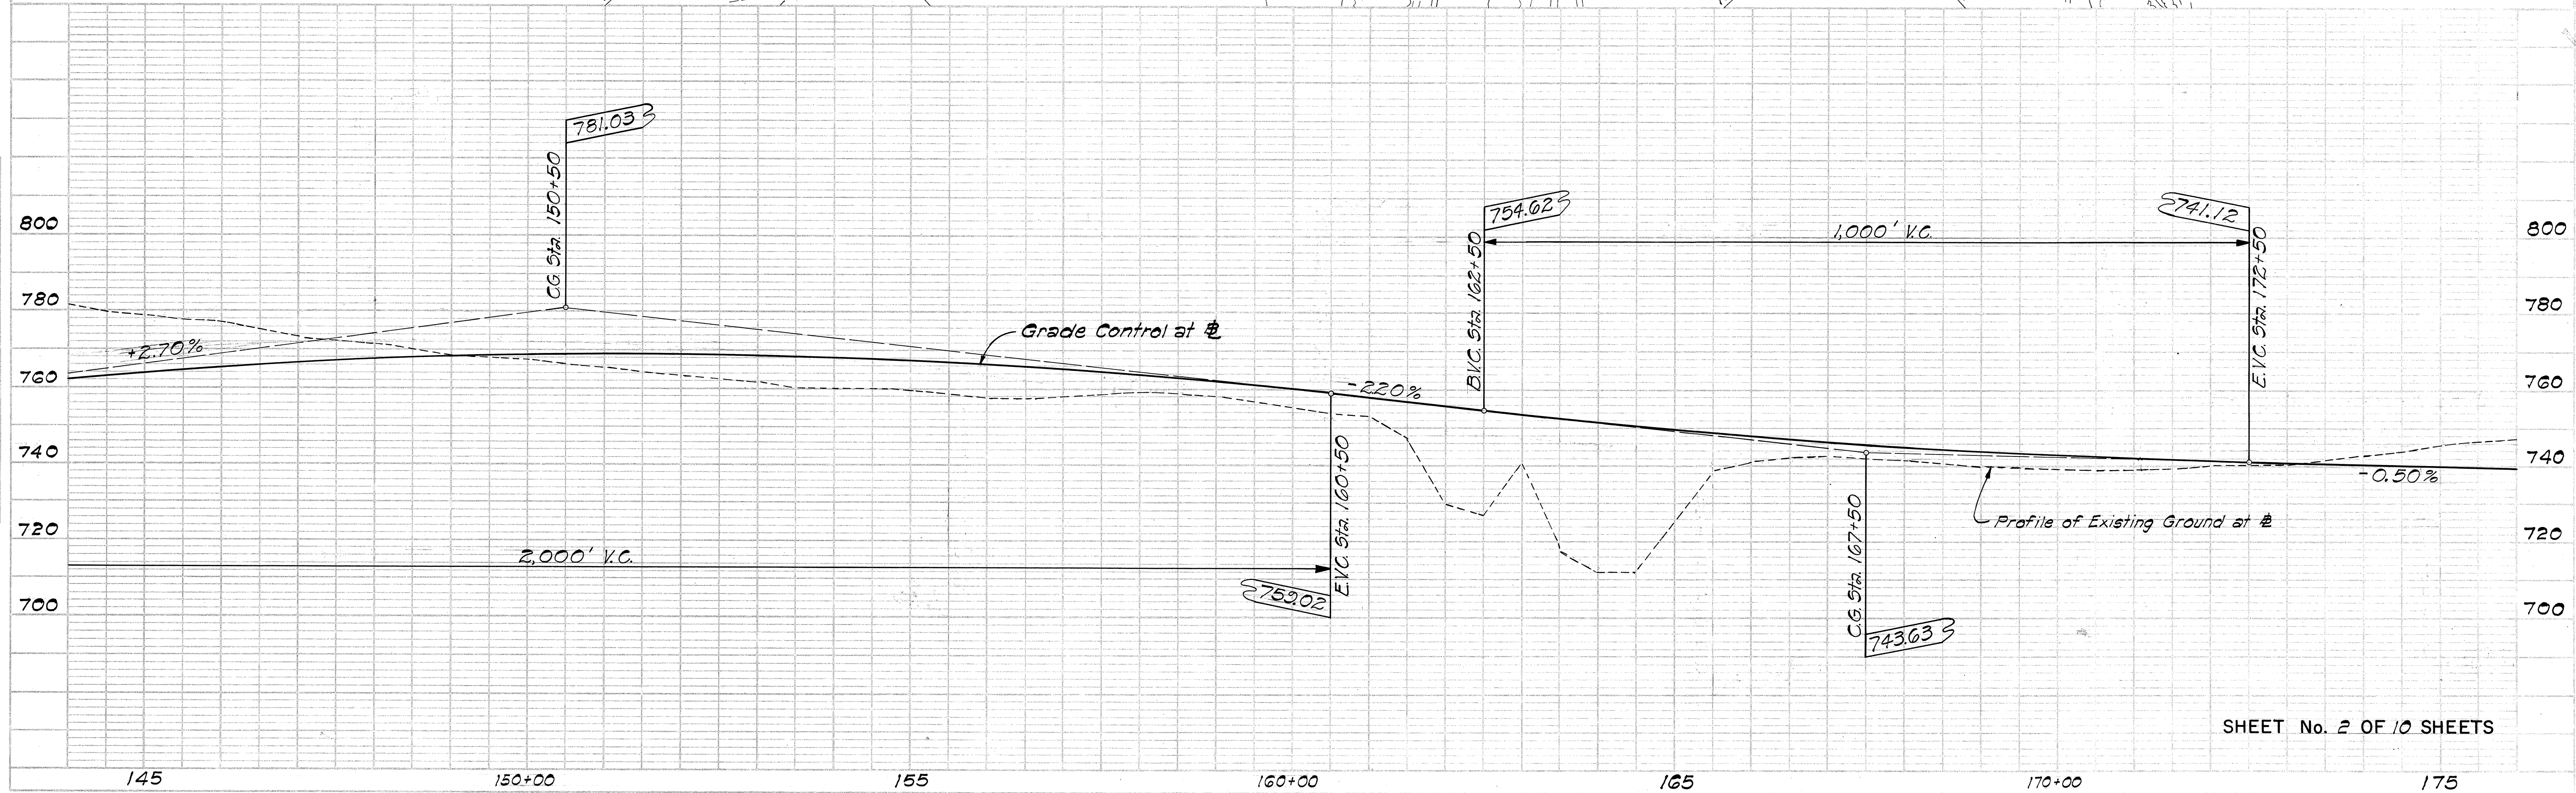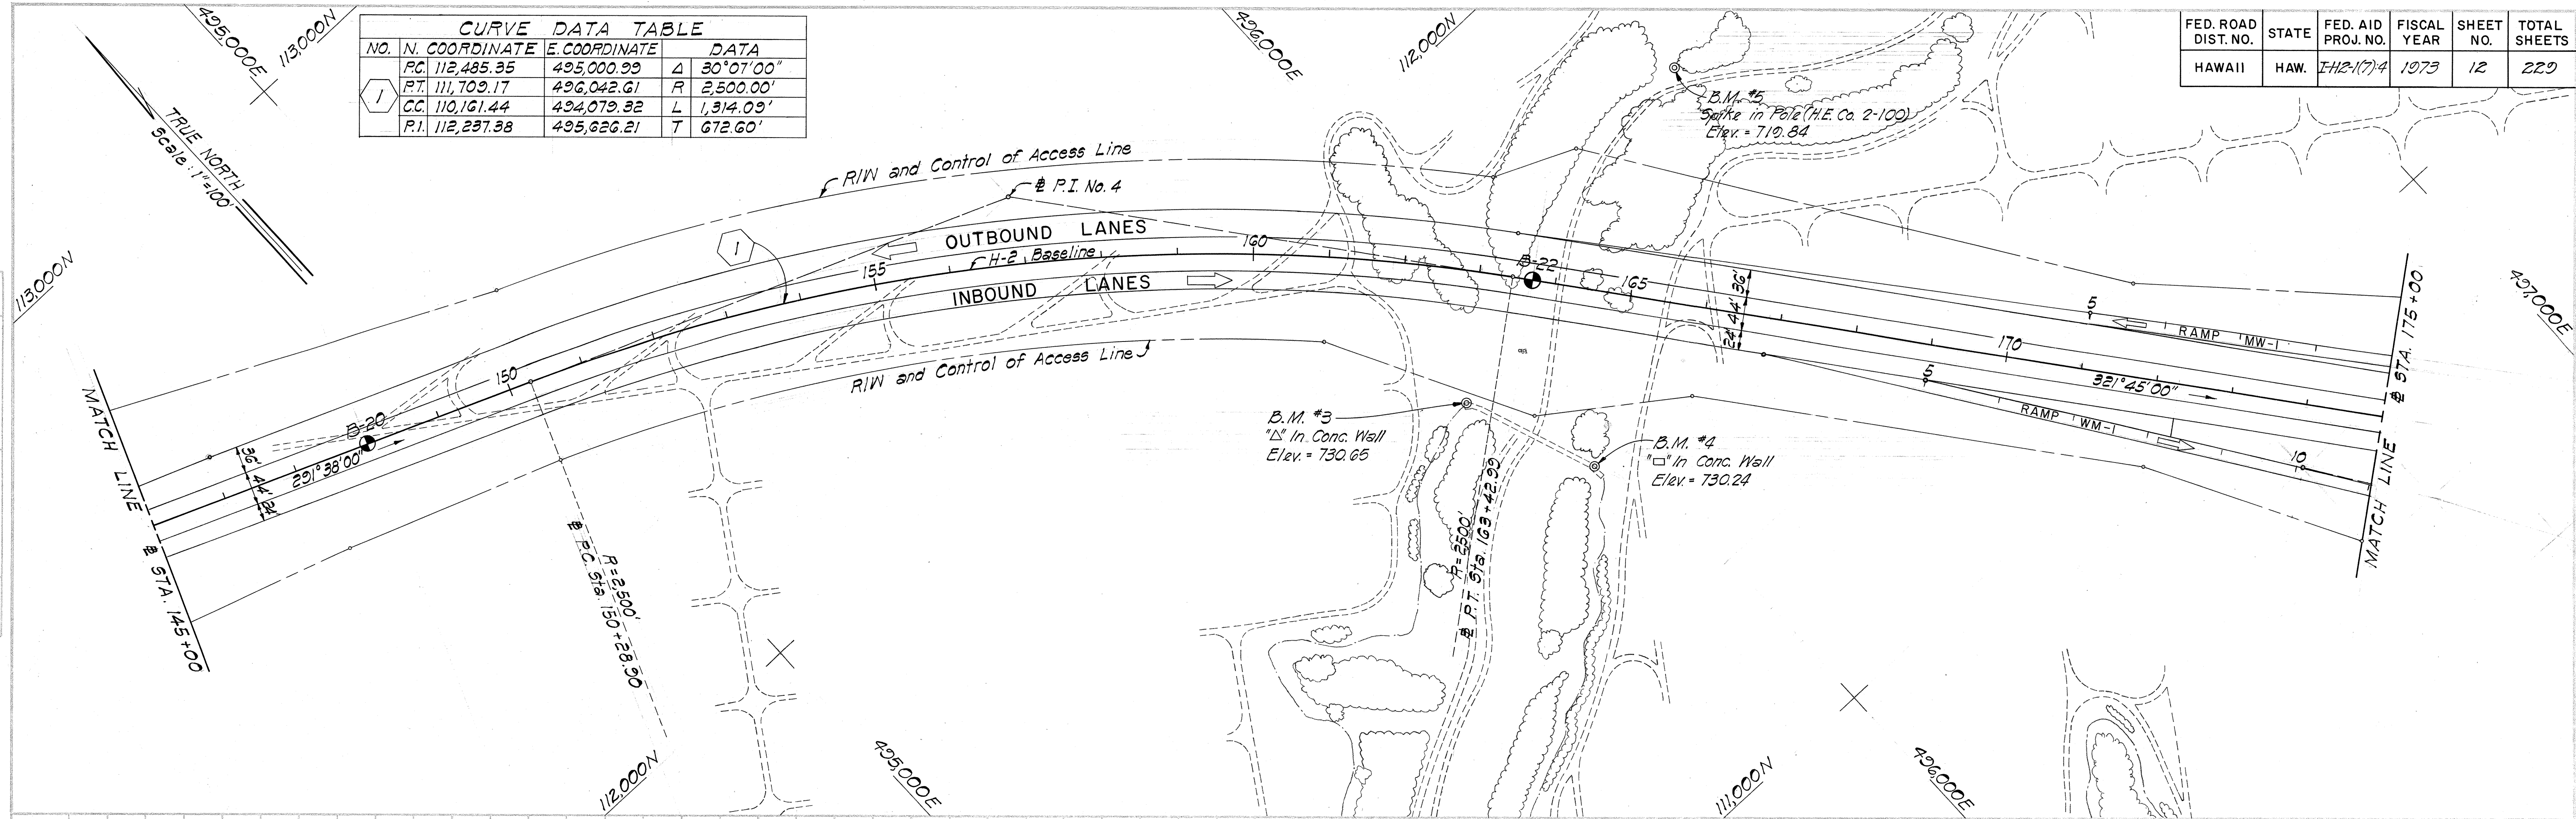


SHEET No. 2 OF 10 SHEETS

FED. ROAD DIST. NO.	STATE	FED. AID PROJ. NO.	FISCAL YEAR	SHEET NO.	TOTAL SHEETS
HAWAII	HAW.	I-H2-1(7):4	1973	13	229

SURVEY PLOTTED BY	DATE
DESIGNED BY	
QUANTITIES BY	
CHECKED BY	
ORIGINAL PLAN	
NOTE BOOK	
No.	

CURVE DATA TABLE				
NO.	N. COORDINATE	E. COORDINATE	DATA	
2	PC 109,923.38	497,450.41	Δ	21° 10' 56"
	PT 109,149.19	498,336.05	R	3,200'
	CC 111,904.48	499,963.43	L	1,183.04'
	PI 109,453.49	497,820.85	T	598.35'
3	PC 109,130.25	498,324.85	Δ	6° 19' 04"
	PT 108,966.78	498,640.09	R	3,222'
	CC 111,904.48	499,963.43	L	355.28'
	PI 109,039.82	498,477.96	T	177.82'
4	PC 109,168.13	498,547.23	Δ	6° 19' 04"
	PT 109,006.90	498,658.16	R	3,178'
	CC 111,904.48	499,963.43	L	350.43'
	PI 109,078.94	498,498.25	T	175.39'

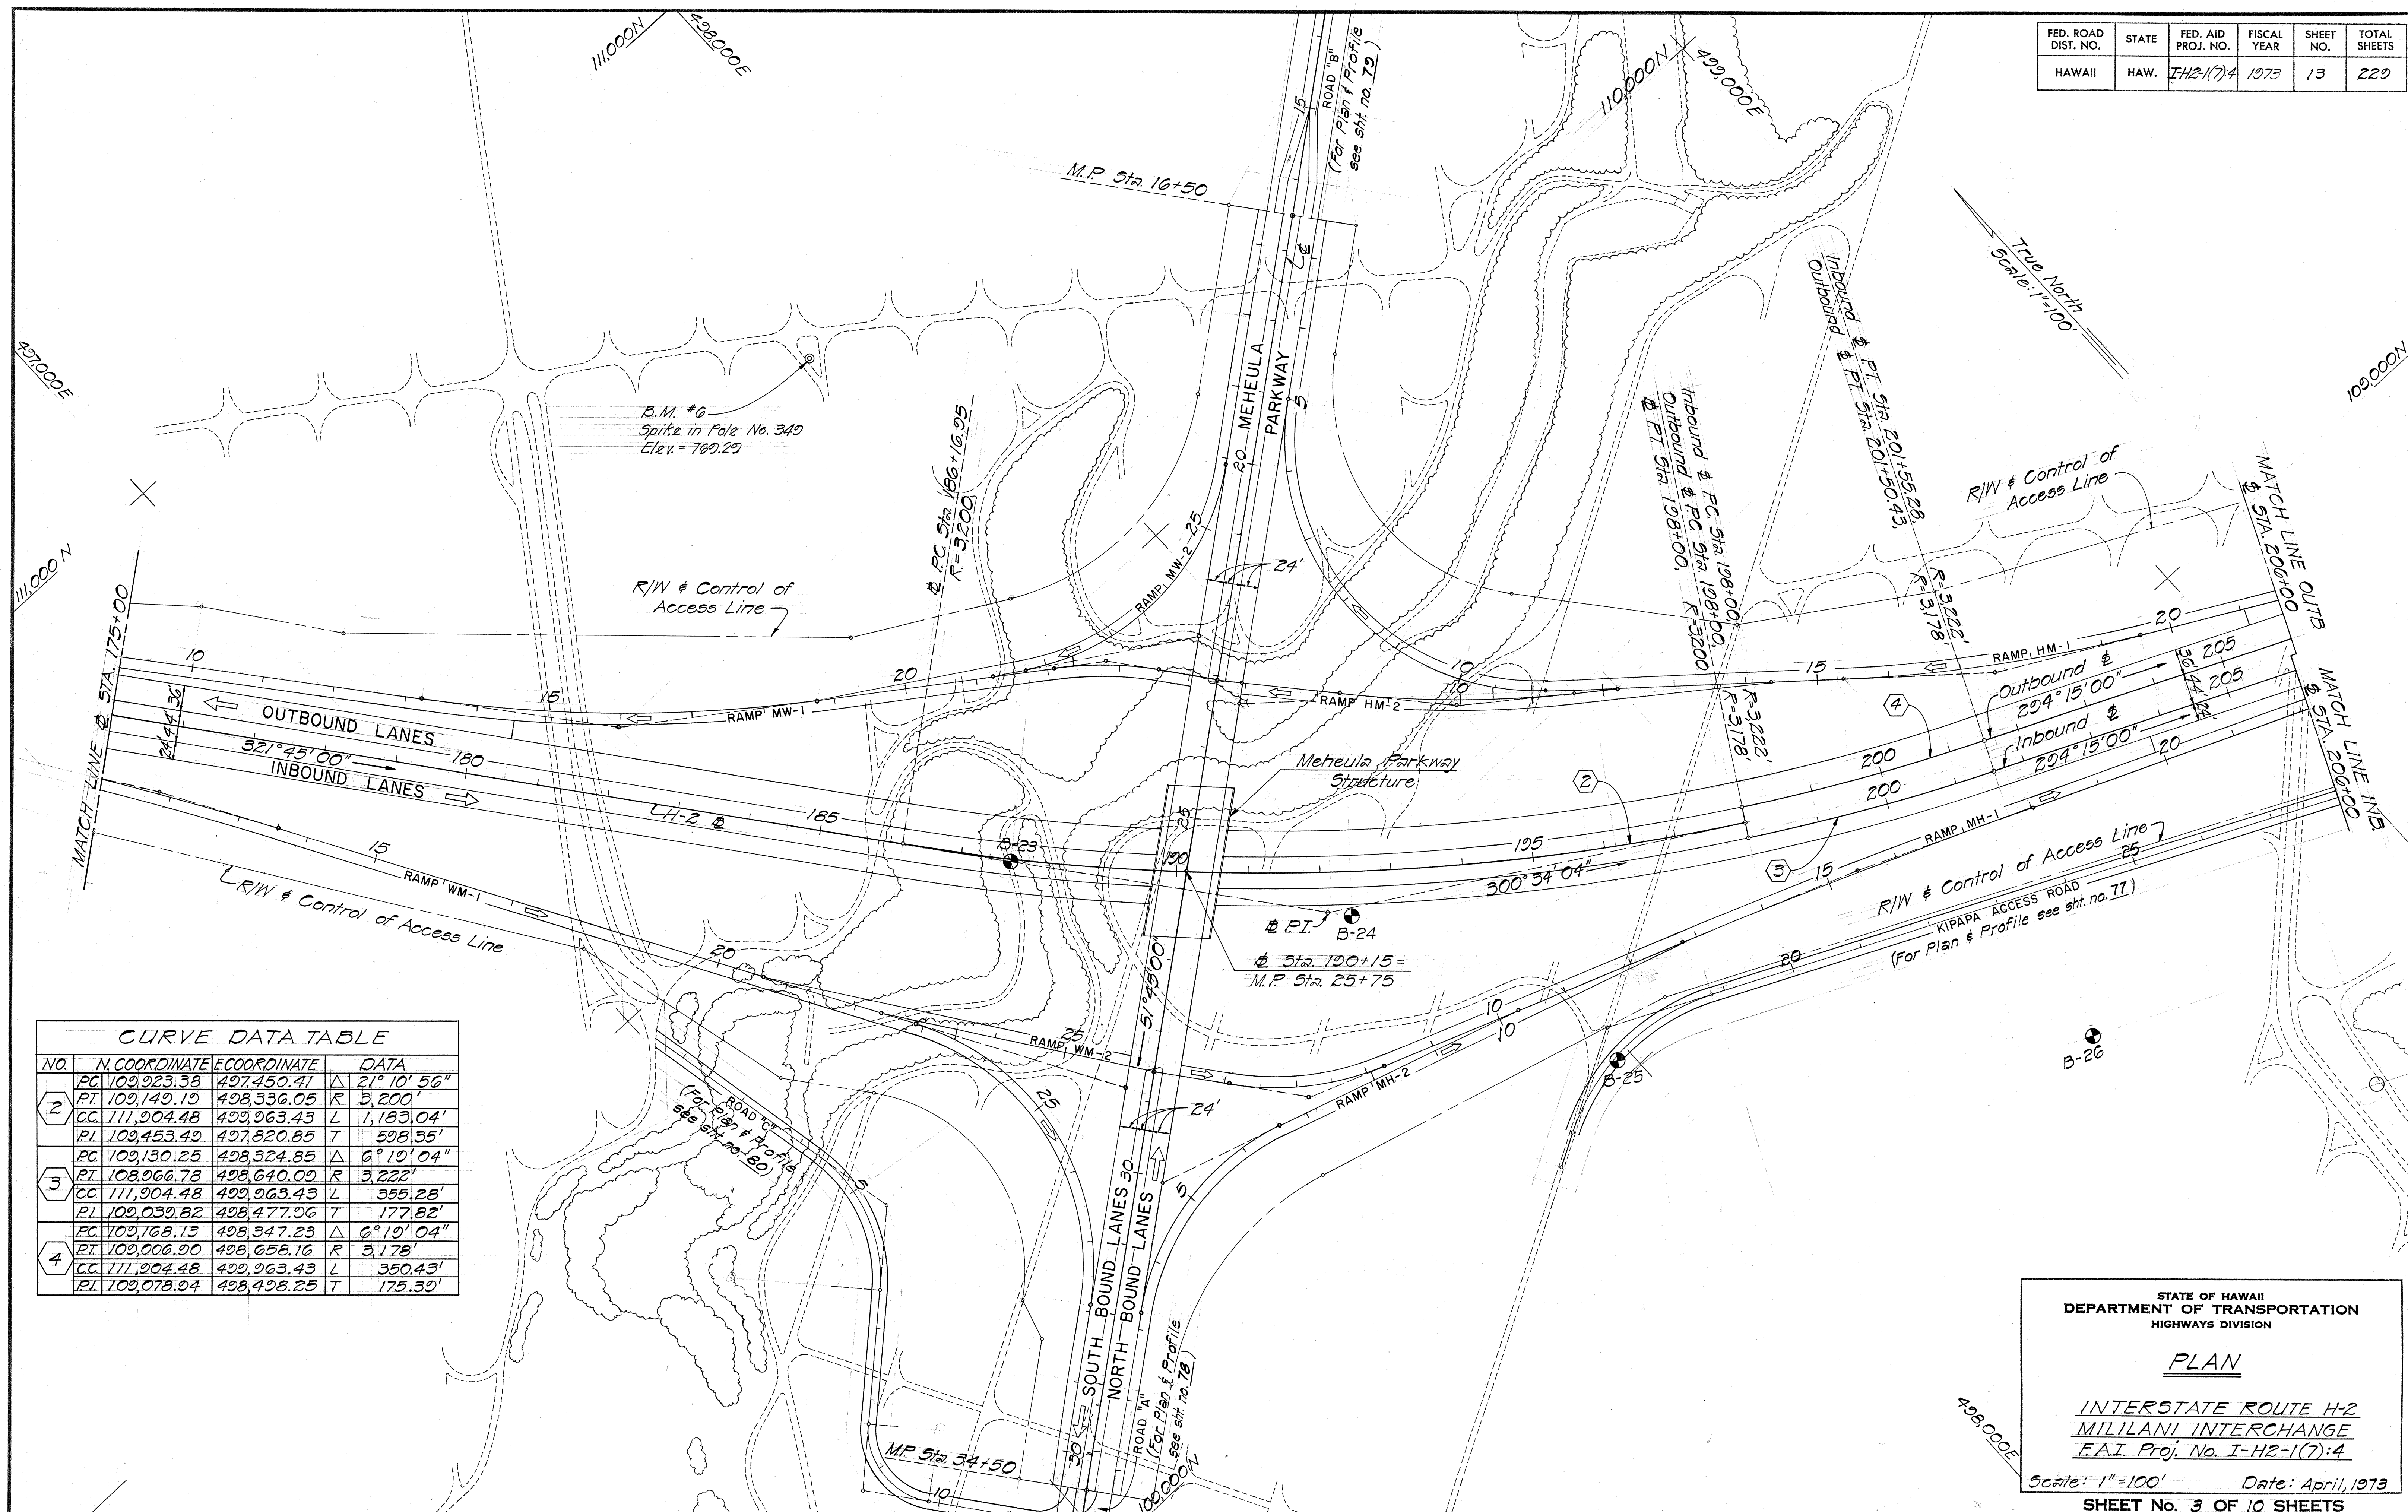

STATE OF HAWAII
DEPARTMENT OF TRANSPORTATION
HIGHWAYS DIVISION

PLAN


INTERSTATE ROUTE H-2
MILILANI INTERCHANGE
F.A.I. Proj. No. I-H2-1(7):4

Scale: 1"=100' Date: April, 1973
SHEET No. 3 OF 10 SHEETS

FED. ROAD DIST. NO.	STATE	FED. AID PROJ. NO.	FISCAL YEAR	SHEET NO.	TOTAL SHEETS
HAWAII	HAW.	I-H2-1(7)-4	1973	14	220

FINAL SURVEY	BY	DATE
SURVEYED		
FLOTTED		
NOTE BOOK		
NO.		
AREAS CHECKED		

ORIGINAL SURVEY	BY	DATE
SURVEYED		
FLOTTED		
NOTE BOOK		
NO.		
AREAS CHECKED		

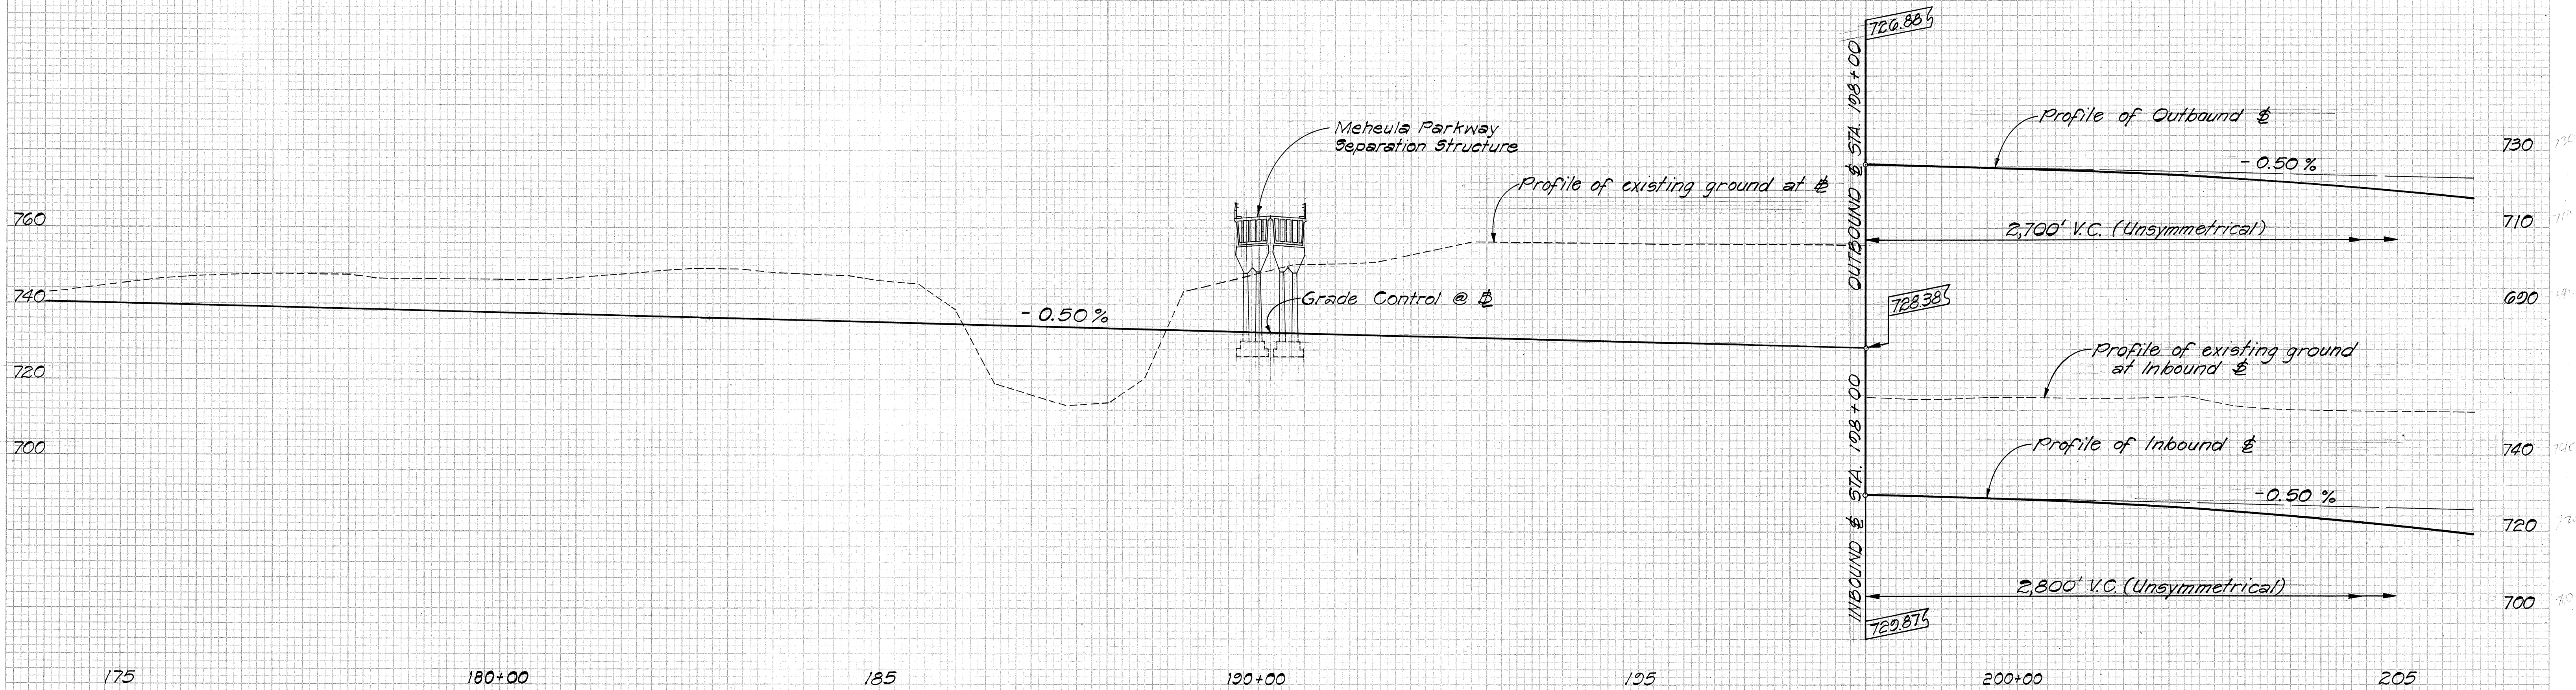

STATE OF HAWAII
DEPARTMENT OF TRANSPORTATION
HIGHWAYS DIVISION


PROFILE

INTERSTATE ROUTE H-2
MILILANI INTERCHANGE
F.A.I. Proj. No. I-H2-1(7)-4


Scale: Horiz: 1" = 100'
Vert: 1" = 20' Date: April, 1973

SHEET No. 4 OF 10 SHEETS

FED. ROAD DIST. NO.	STATE	FED. AID PROJ. NO.	FISCAL YEAR	SHEET NO.	TOTAL SHEETS
HAWAII	HAW.	I-H2-(17):4	1973	15	229

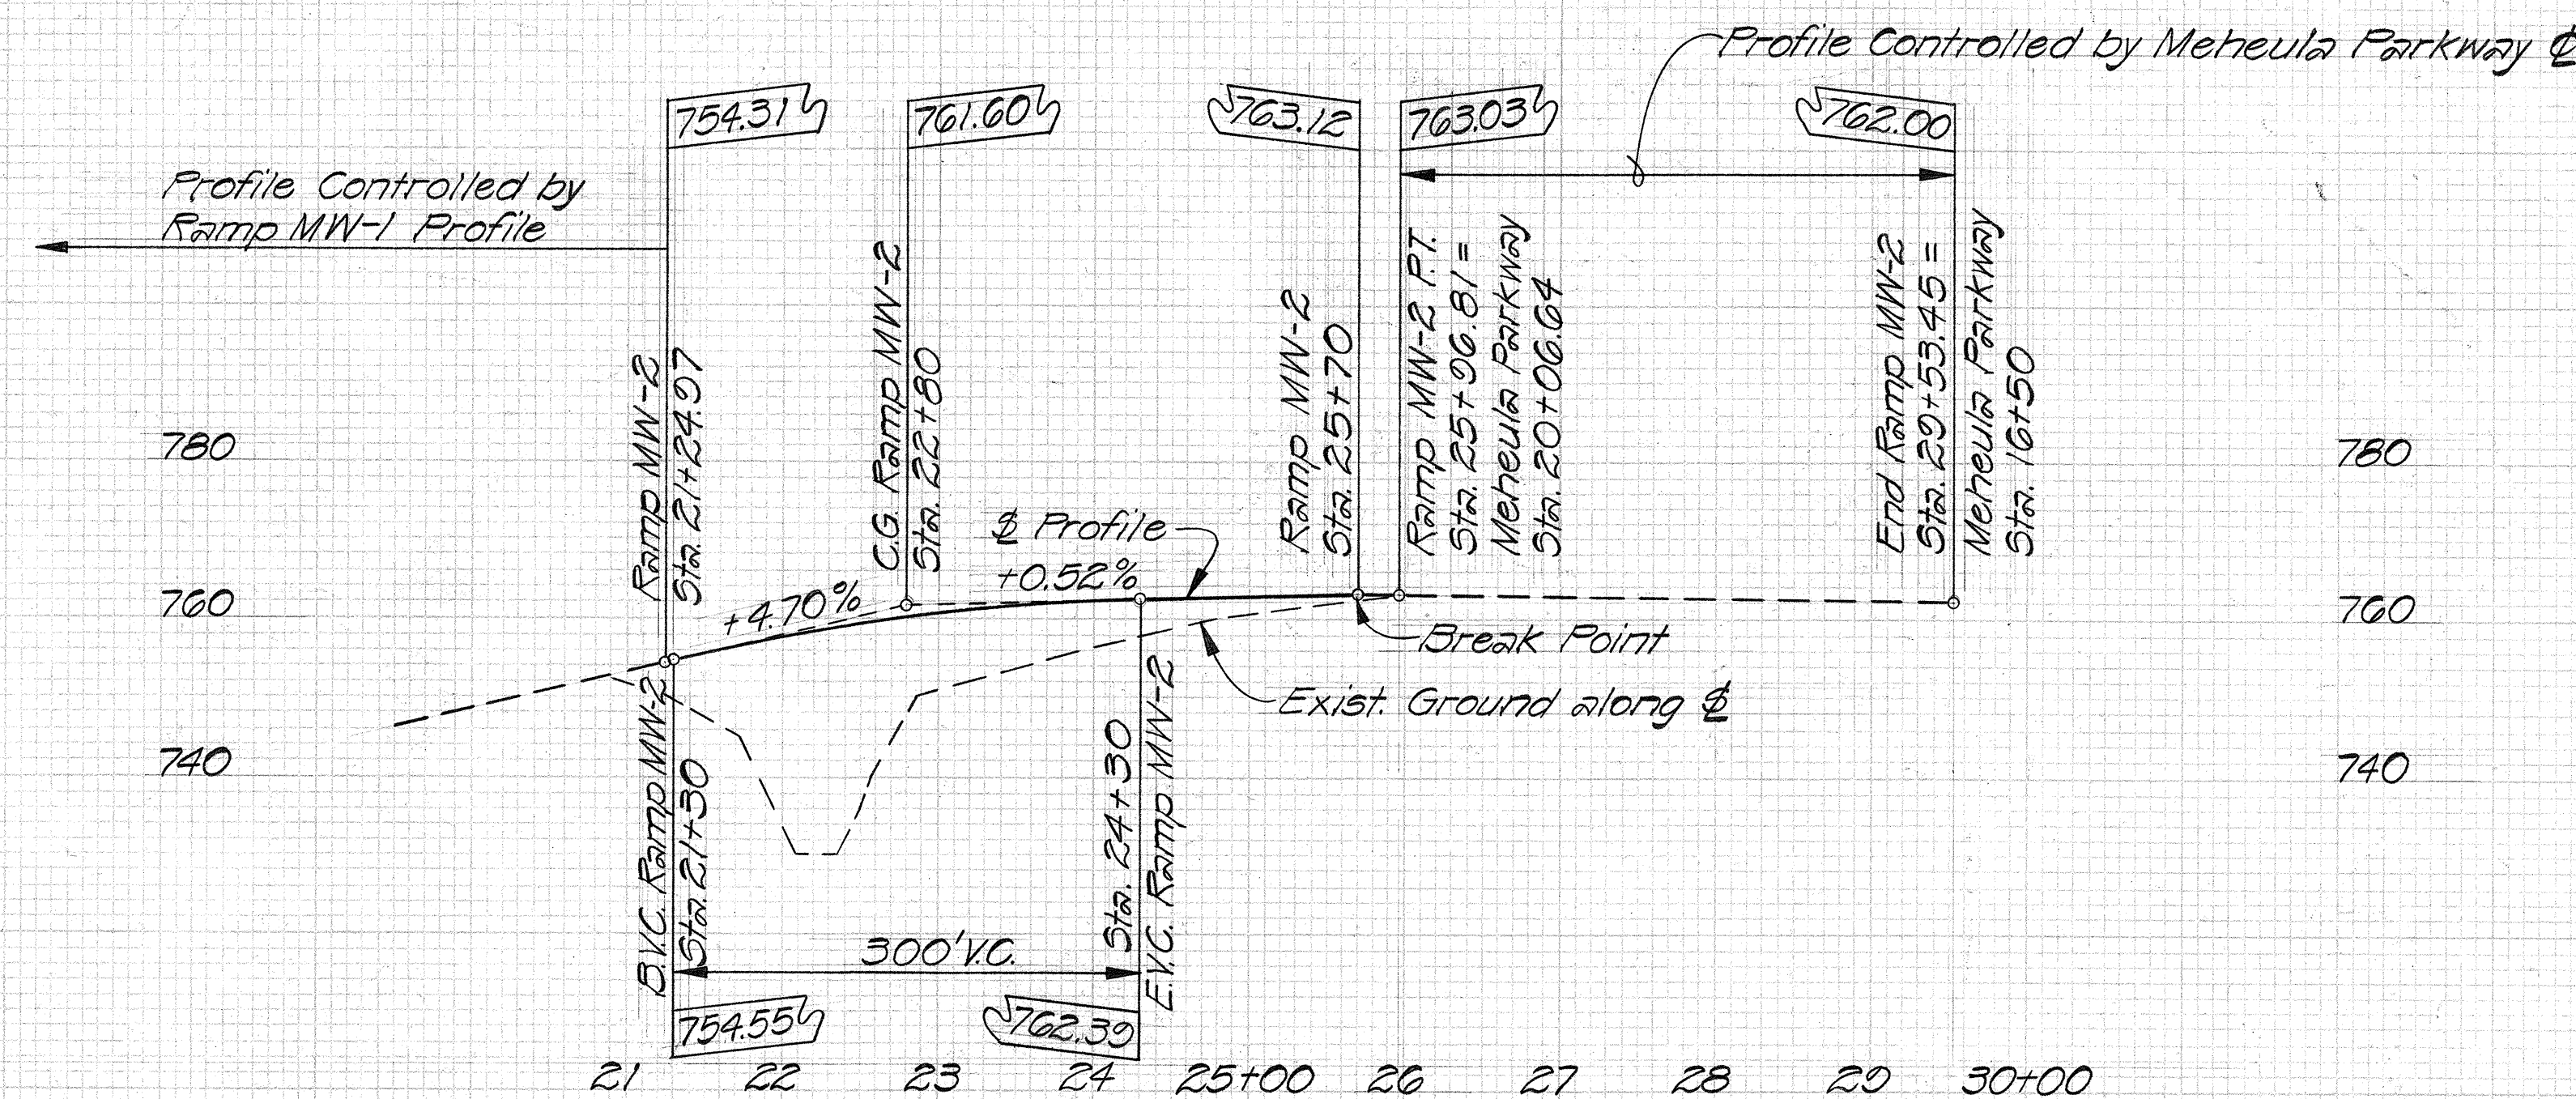

PROFILE - RAMP MW-2
Scale: Hor. 1"=100'
Vert. 1"=20'

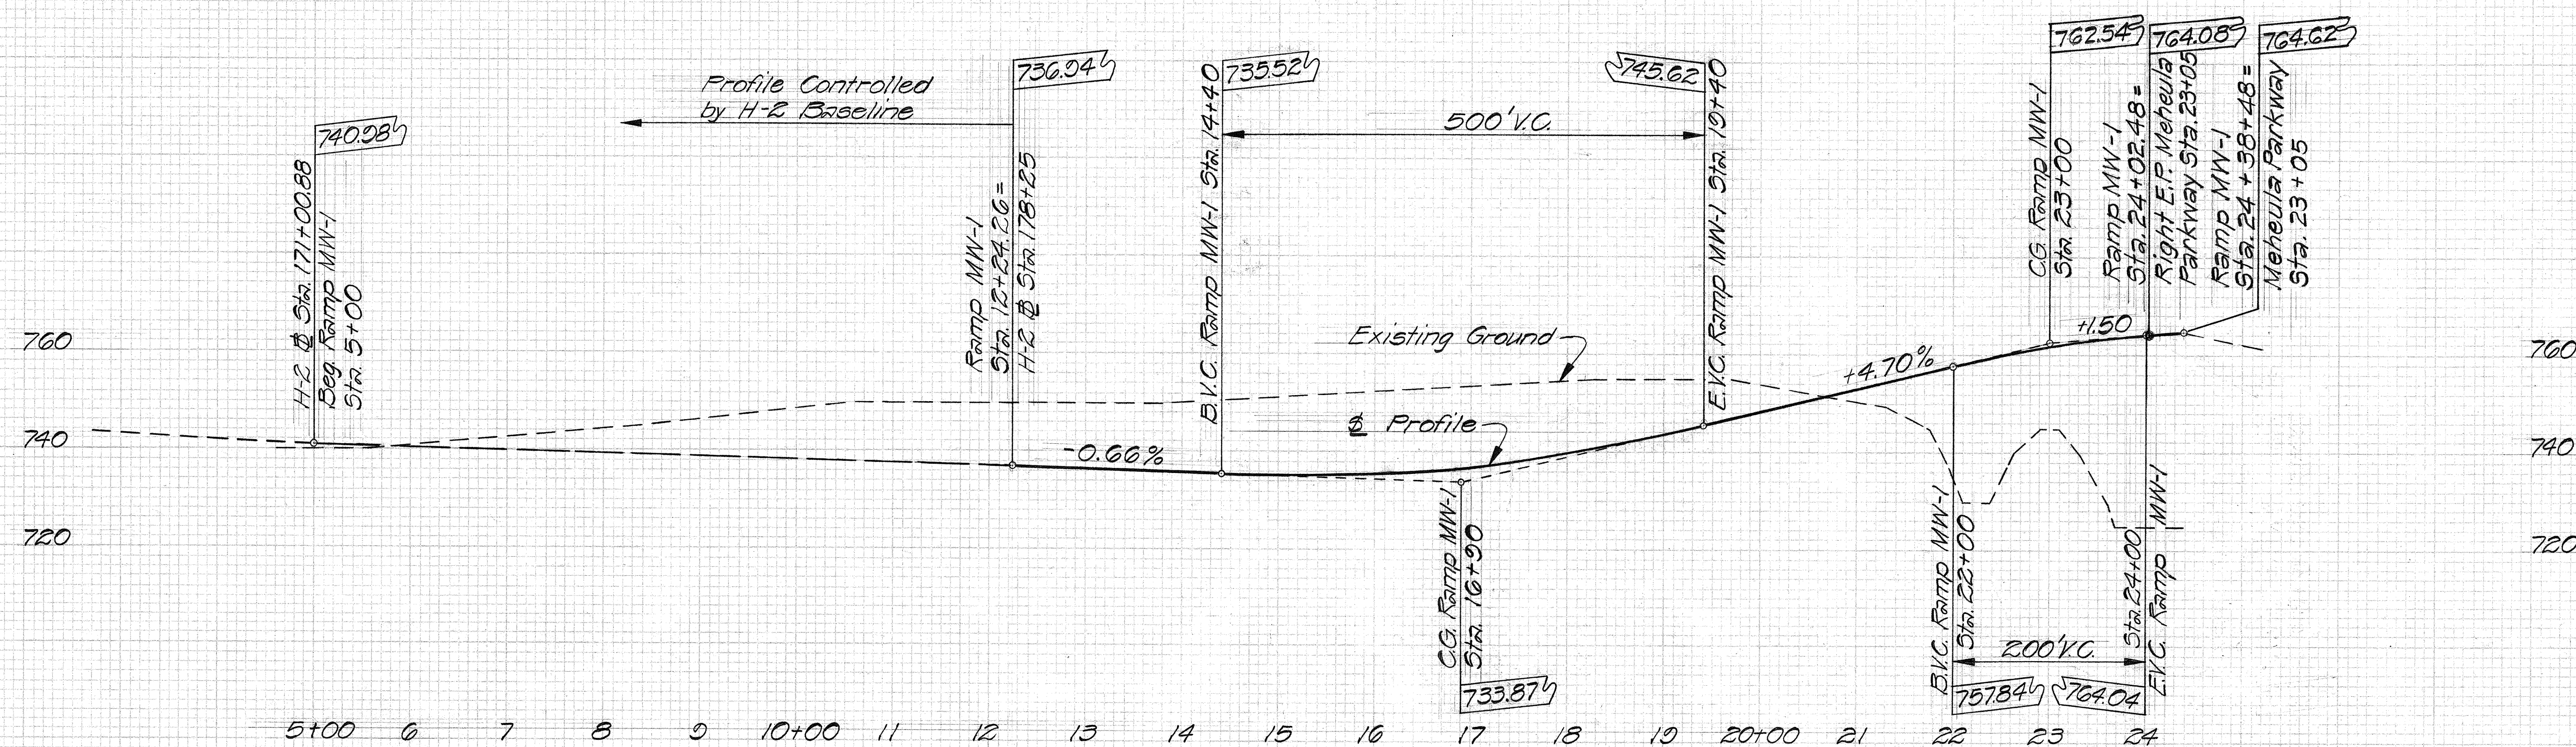

PROFILE - RAMP MW-1
Scale: Hor. 1"=100'
Vert. 1"=20'


STATE OF HAWAII
DEPARTMENT OF TRANSPORTATION
HIGHWAYS DIVISION
PROFILE 5
RAMP MW-1 AND RAMP MW-2

INTERSTATE ROUTE H-2
MILILANI INTERCHANGE
F.A.I. PROJ. NO. I-H2-(17):4


Scale: Hor. 1"=100'
Vert. 1"=20' Date: April, 1973
SHEET No. 5 OF 10 SHEETS

FINAL SURVEY	SURVEYED	BY	DATE
NOTE BOOK	PLOTTED		
NO.	AREAS		
	AREAS CHECKED		


ORIGINAL				BY	DATE
SURVEY	SURVIVED				
PLANT	PLANTED				
WIDE BARK	LEAVES				
NO.	AREAS CHECKED				

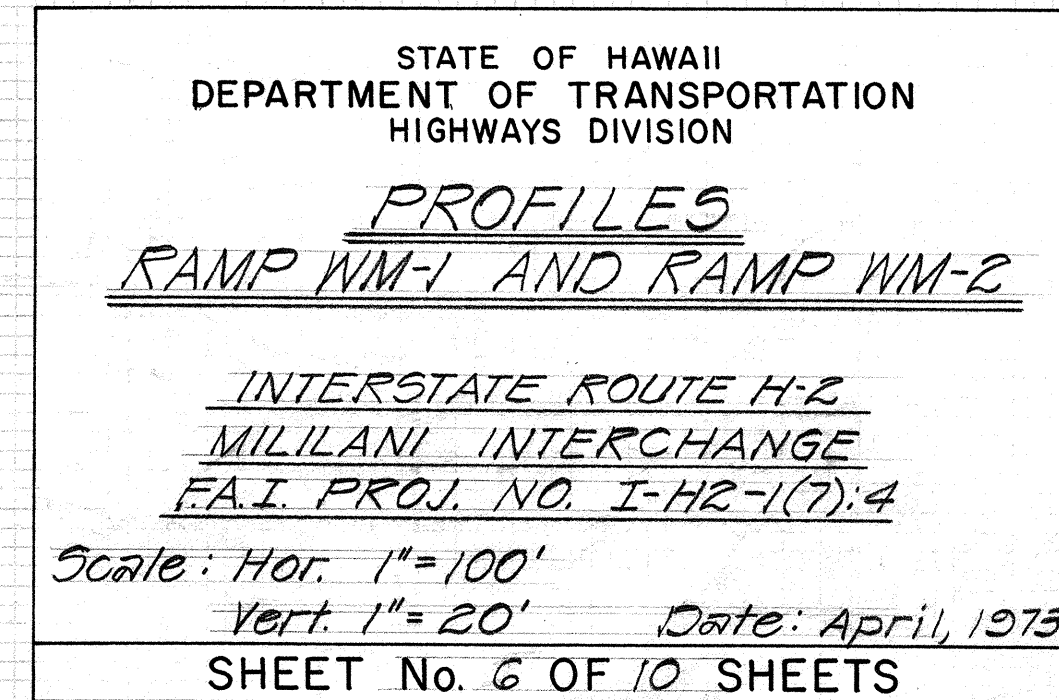

FED. ROAD DIST. NO.	STATE	FED. AID PROJ. NO.	FISCAL YEAR	SHEET NO.	TOTAL SHEETS
HAWAII	HAW.	I-H2-1(7):4	1973	17	229

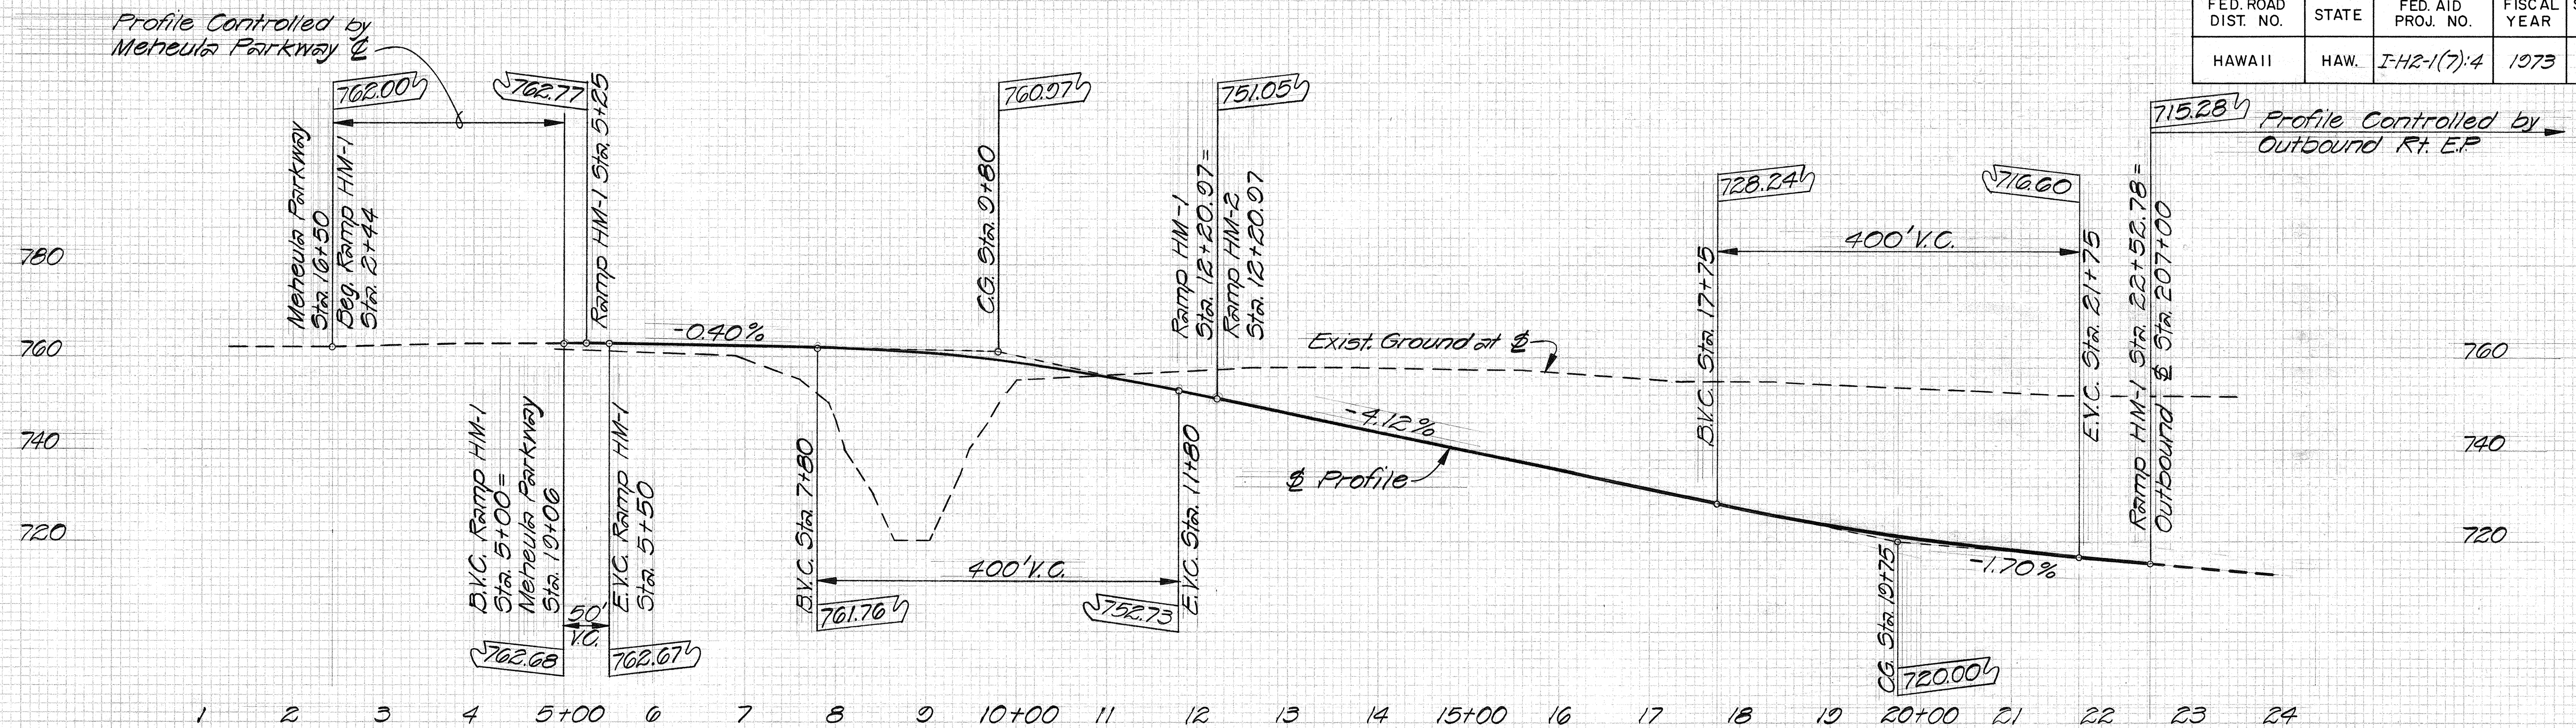

PROFILE - RAMP HM-1
Scale: Hor. 1"=100'
Vert. 1"=20'

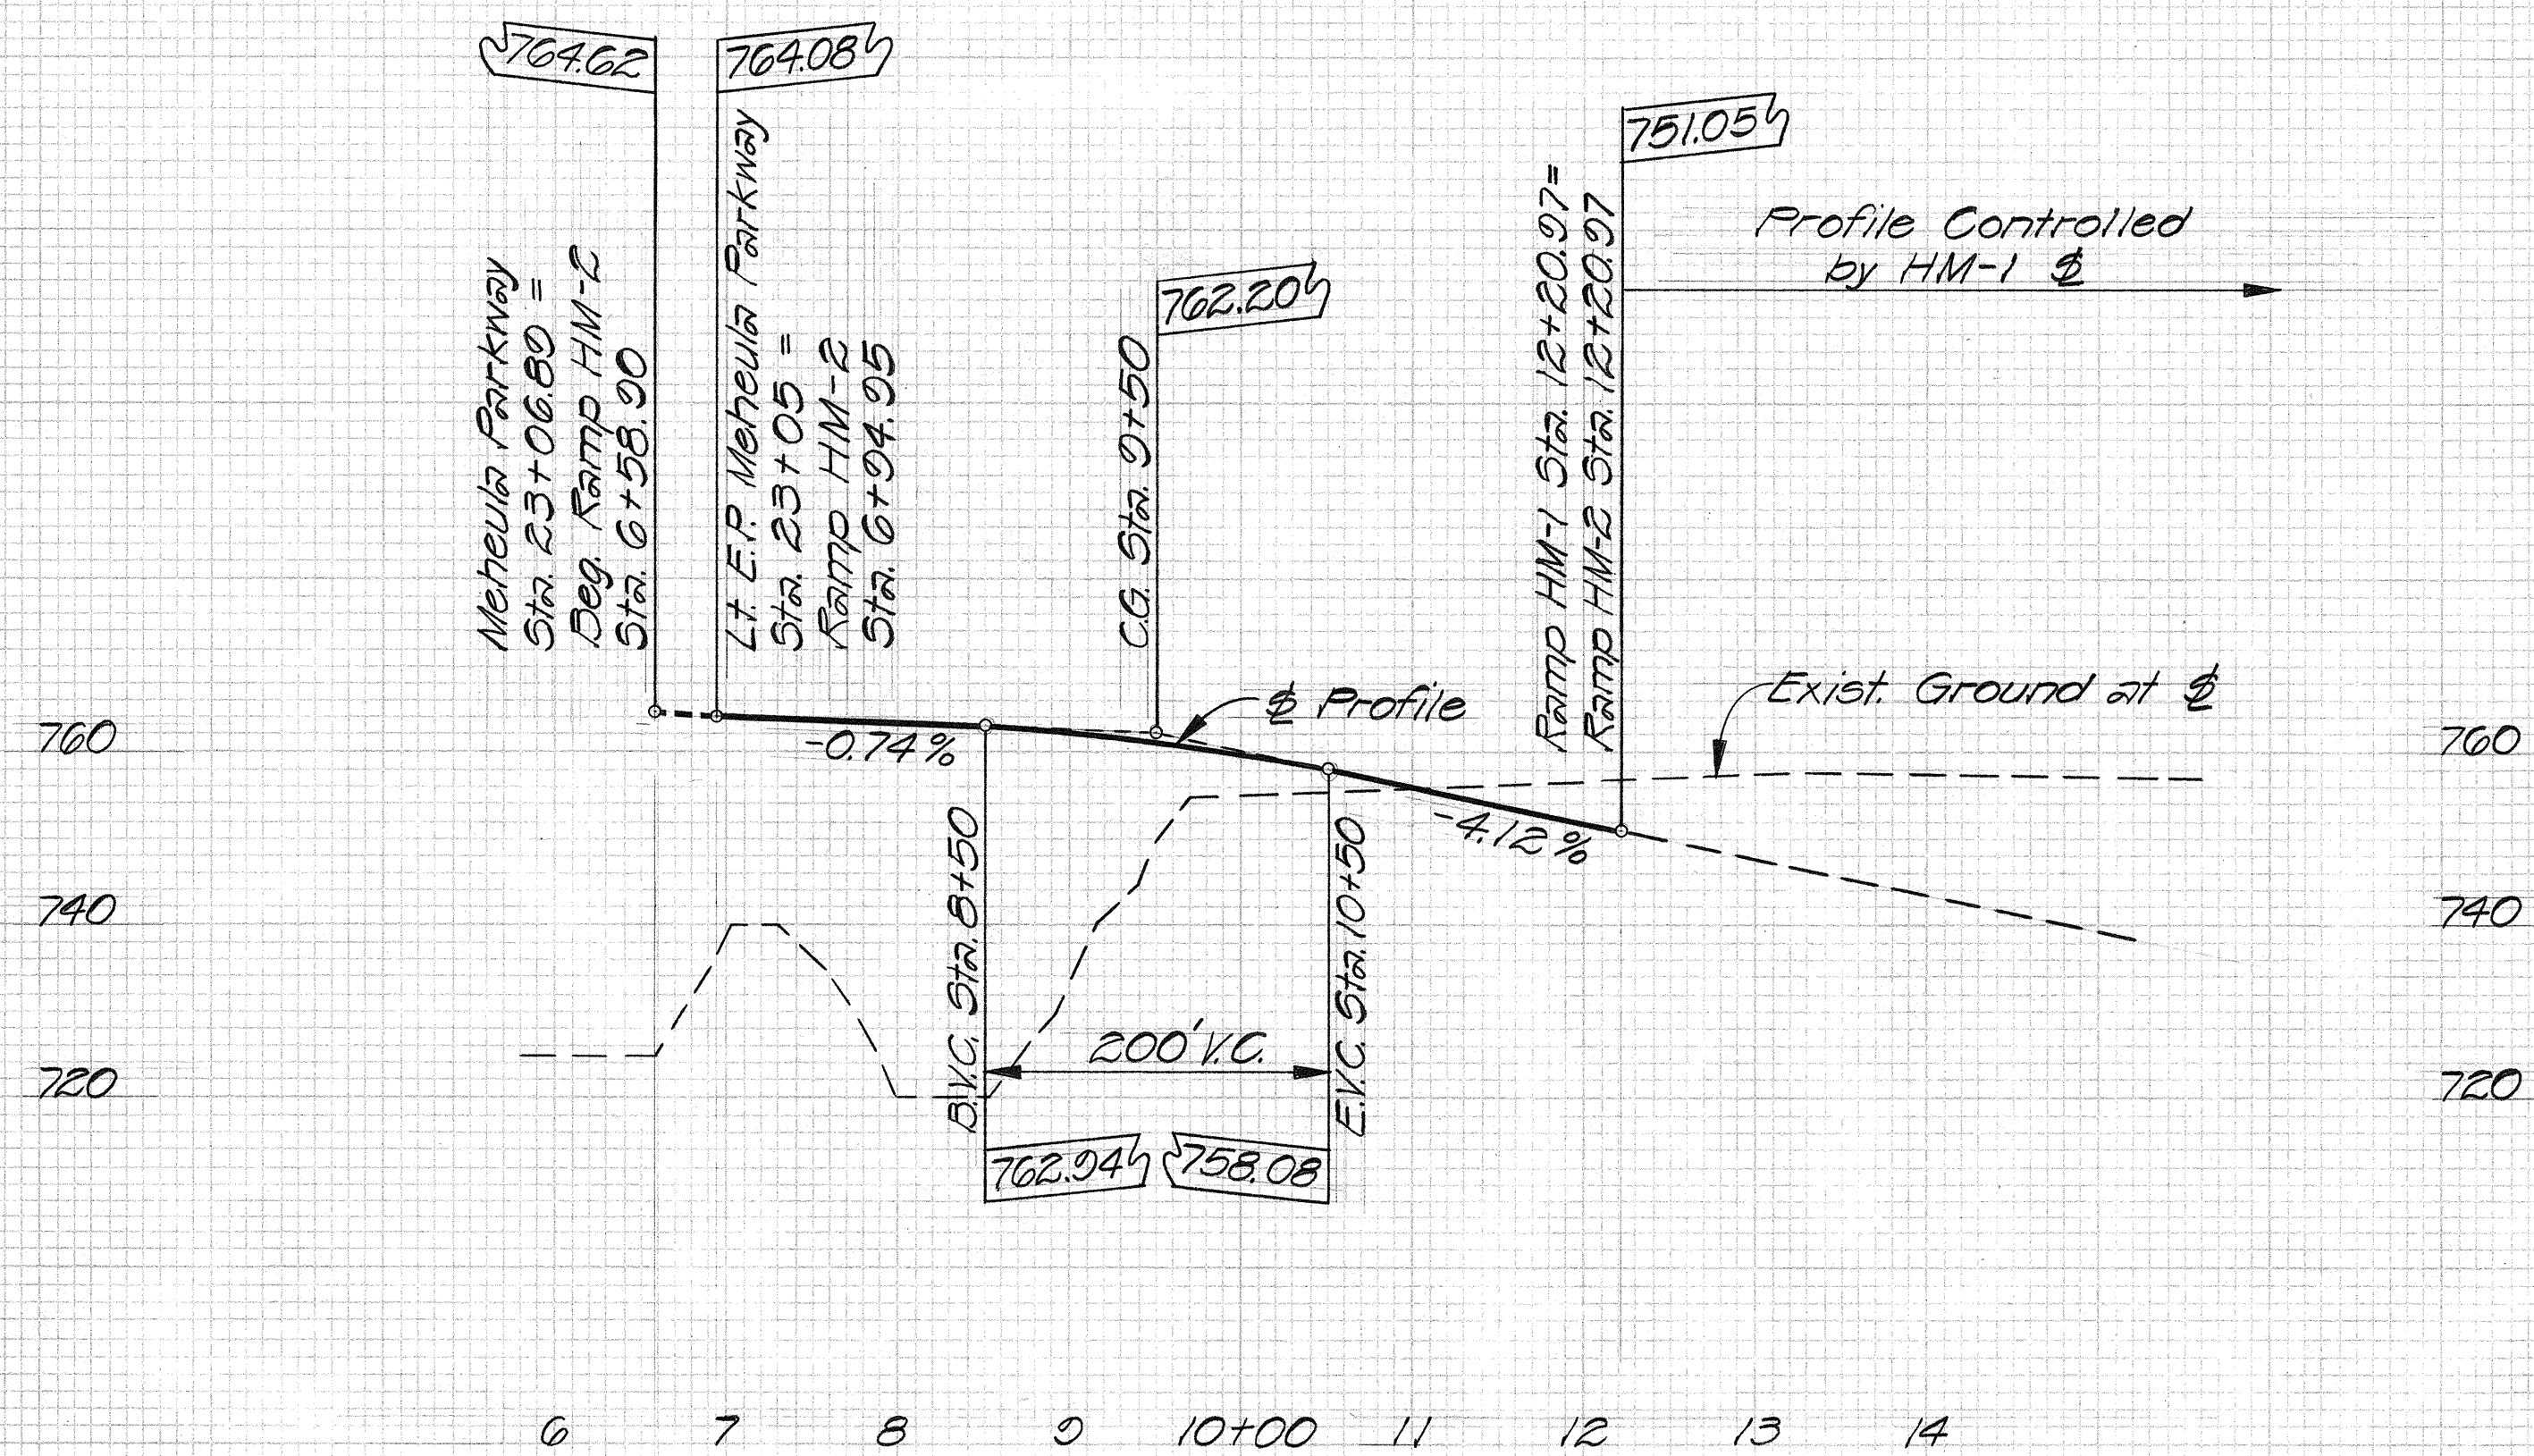

PROFILE - RAMP HM-2
Scale: Hor. 1"=100'
Vert. 1"=20'

STATE OF HAWAII
DEPARTMENT OF TRANSPORTATION
HIGHWAYS DIVISION


PROFILES
RAMP HM-1 AND RAMP HM-2

INTERSTATE ROUTE H-2
MILILANI INTERCHANGE
F.A.I. PROJ. NO. I-H2-1(7):4


Scale: Hor. 1"=100'
Vert. 1"=20' Date: April, 1973

SHEET No. 7 OF 10 SHEETS

FED. ROAD DIST. NO.	STATE	FED. AID PROJ. NO.	FISCAL YEAR	SHEET NO.	TOTAL SHEETS
HAWAII	HAW.	I-H2-1(7):4	1973	18	229

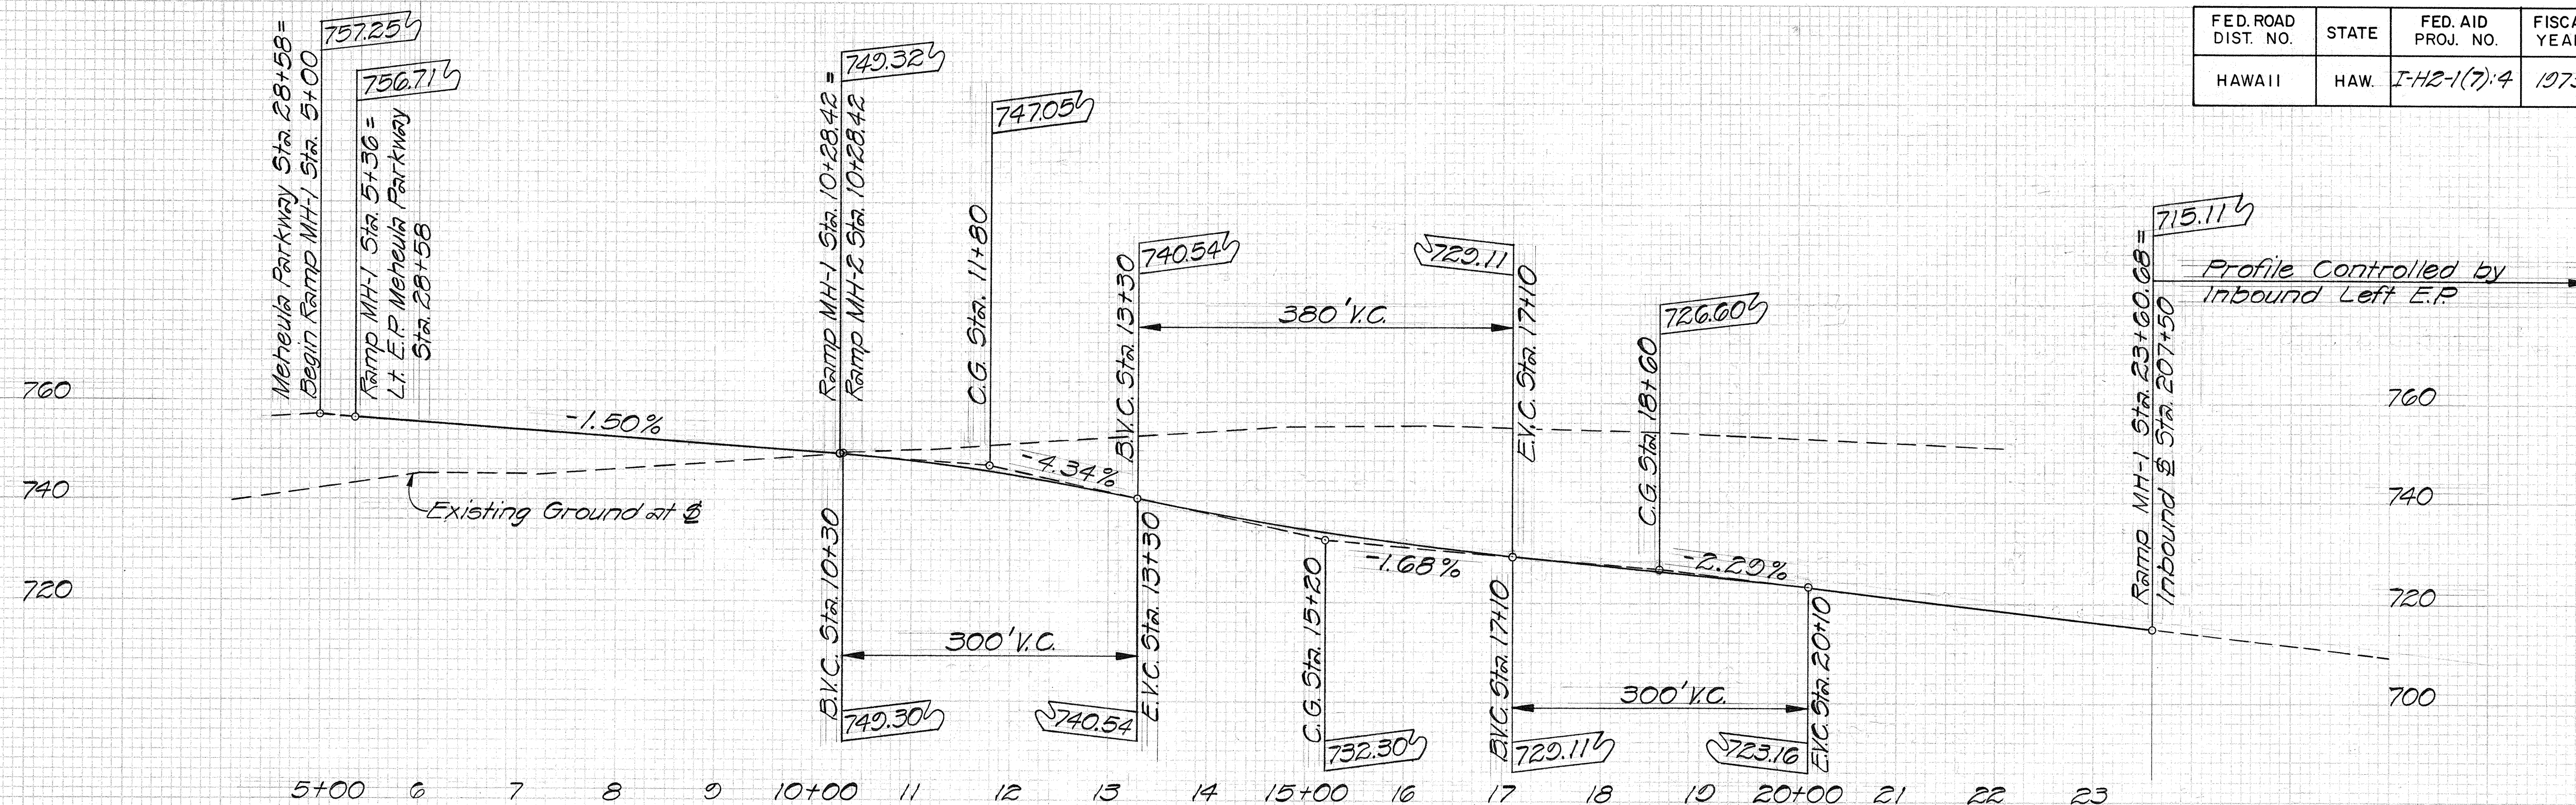

§ PROFILE - RAMP MH-1
Scale: Hor. 1"=100'
Vert. 1"=20'

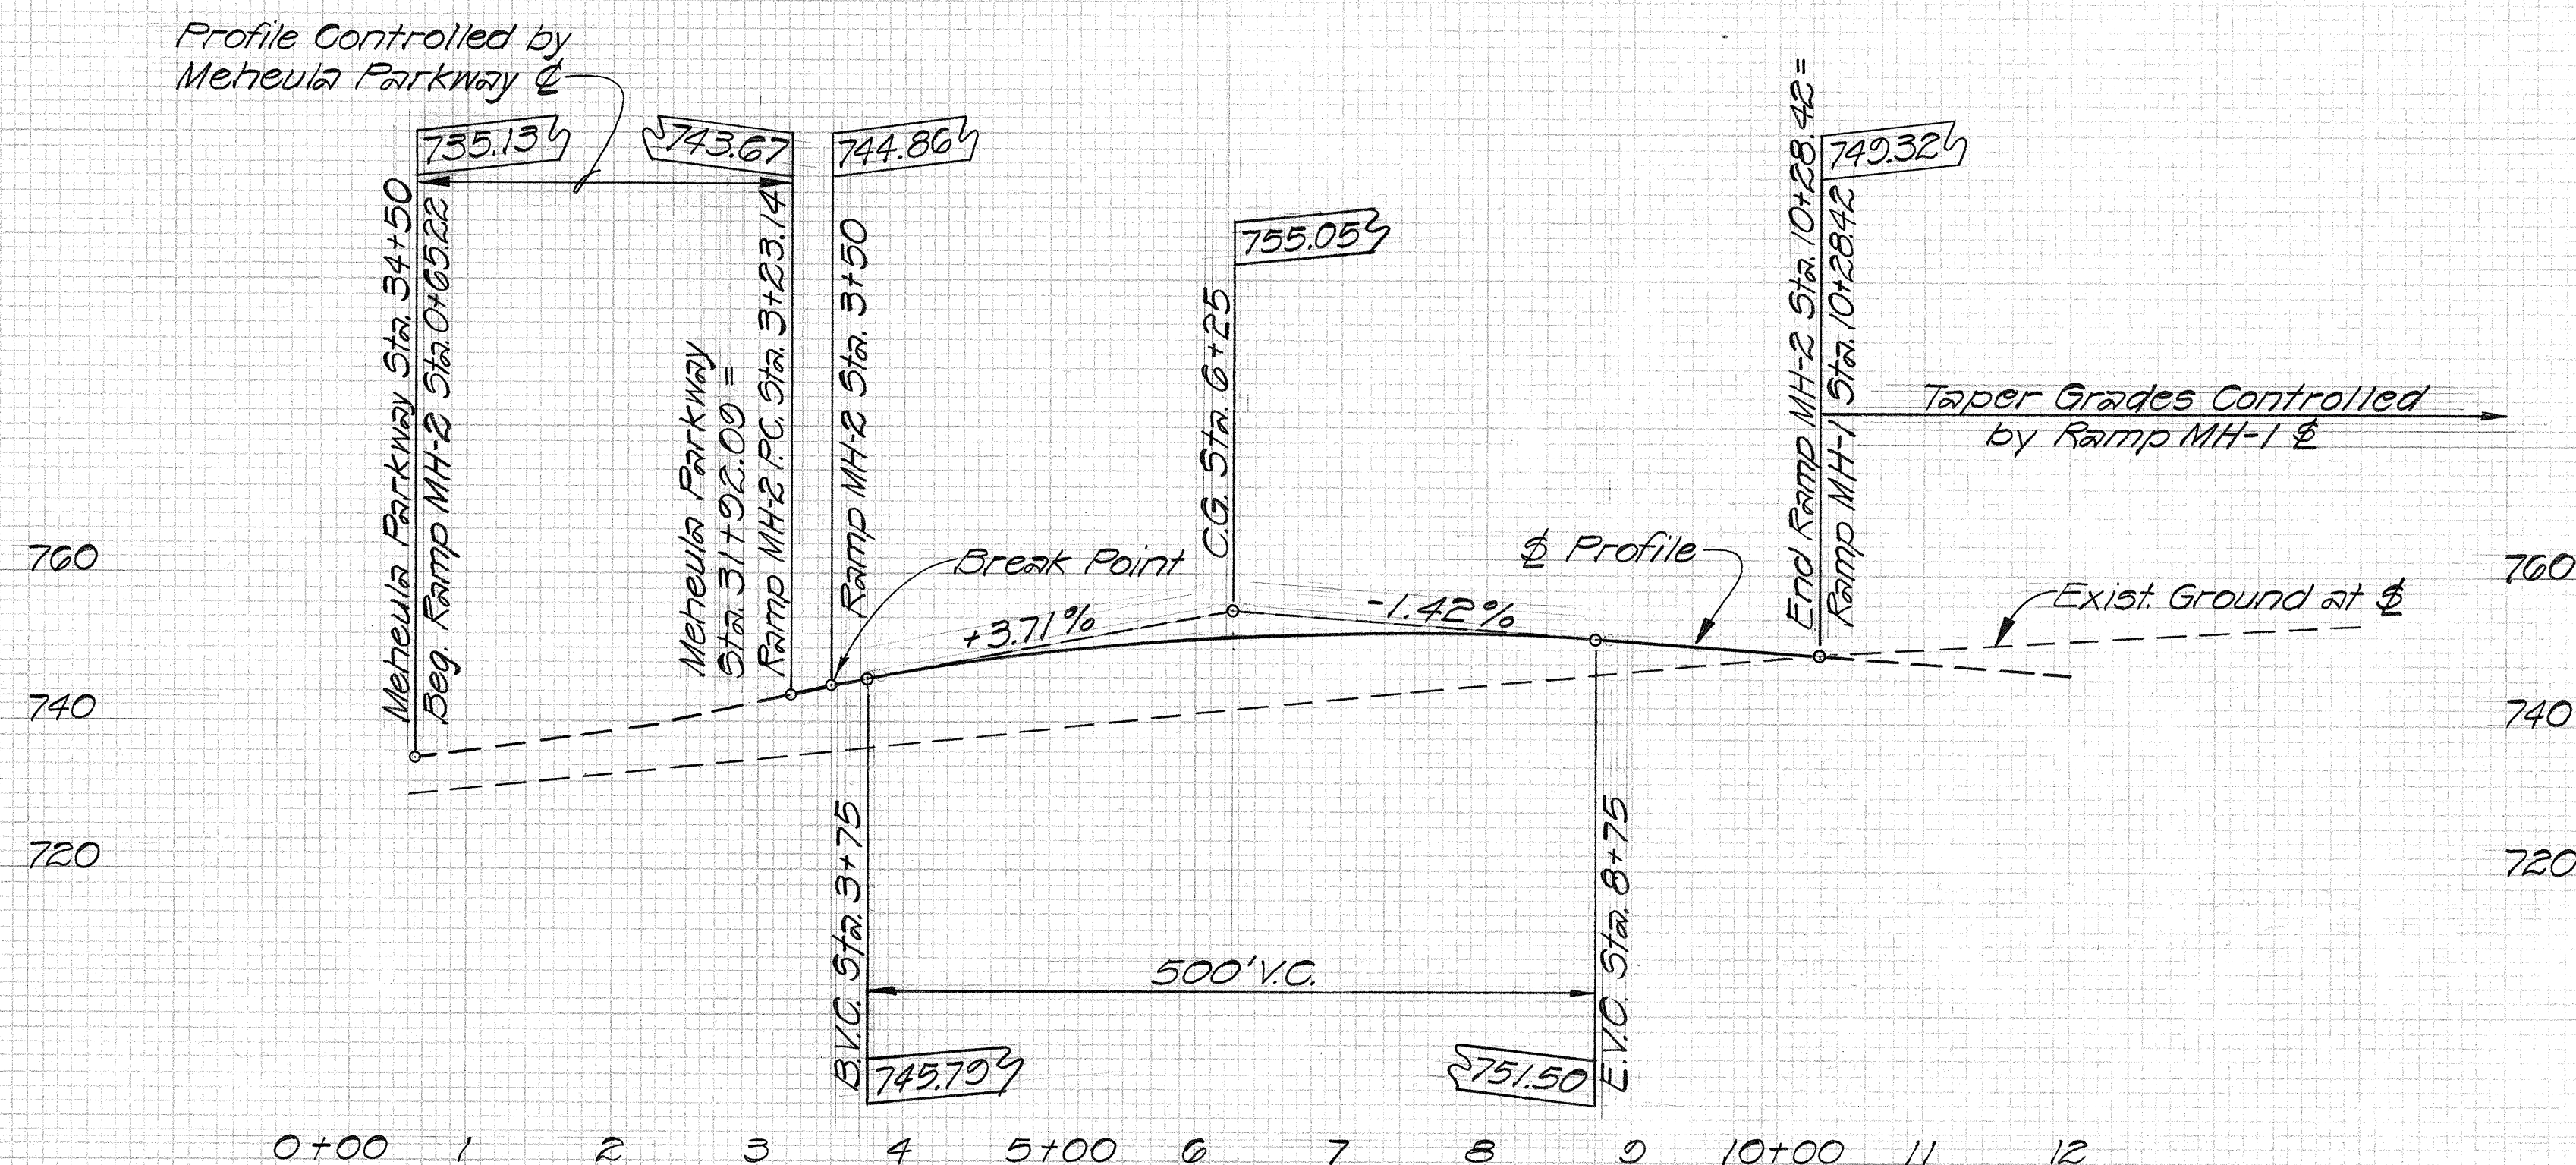

§ PROFILE - RAMP MH-2
Scale: Hor. 1"=100'
Vert. 1"=20'

STATE OF HAWAII
DEPARTMENT OF TRANSPORTATION
HIGHWAYS DIVISION

PROFILES
RAMP MH-1 AND RAMP MH-2

INTERSTATE ROUTE H-2
MILILANI INTERCHANGE
E.A.I. PROJ. NO. I-H2-1(7):4



Scale: Hor. 1"=100'
Vert. 1"=20' Date: April, 1973

SHEET No. 8 OF 10 SHEETS

CURVE DATA TABLE				
NO.	N. COORDINATE	E. COORDINATE	DATA	
5	P.C.	108,335.65	500,041.37	Δ 21° 08' 00"
	P.T.	107,825.45	500,774.86	R 2,436.00
	C.C.	106,114.50	499,040.86	T 454.42
	P.I.	108,148.91	500,455.69	L 898.51
6	P.C.	108,412.20	499,978.34	Δ 21° 08' 00"
	P.T.	107,867.76	500,761.21	R 2,600.00
	C.C.	106,041.62	498,910.47	T 485.01
	P.I.	108,213.00	500,422.55	L 959.00

FED. ROAD DIST. NO.	STATE	FED. AID PROJ. NO.	FISCAL YEAR	SHEET NO.	TOTAL SHEETS
HAWAII	HAW.	I-H2-1(7):4	1973	19	220

NOTE: For B.M. #7 and #9, see sheet no. 13

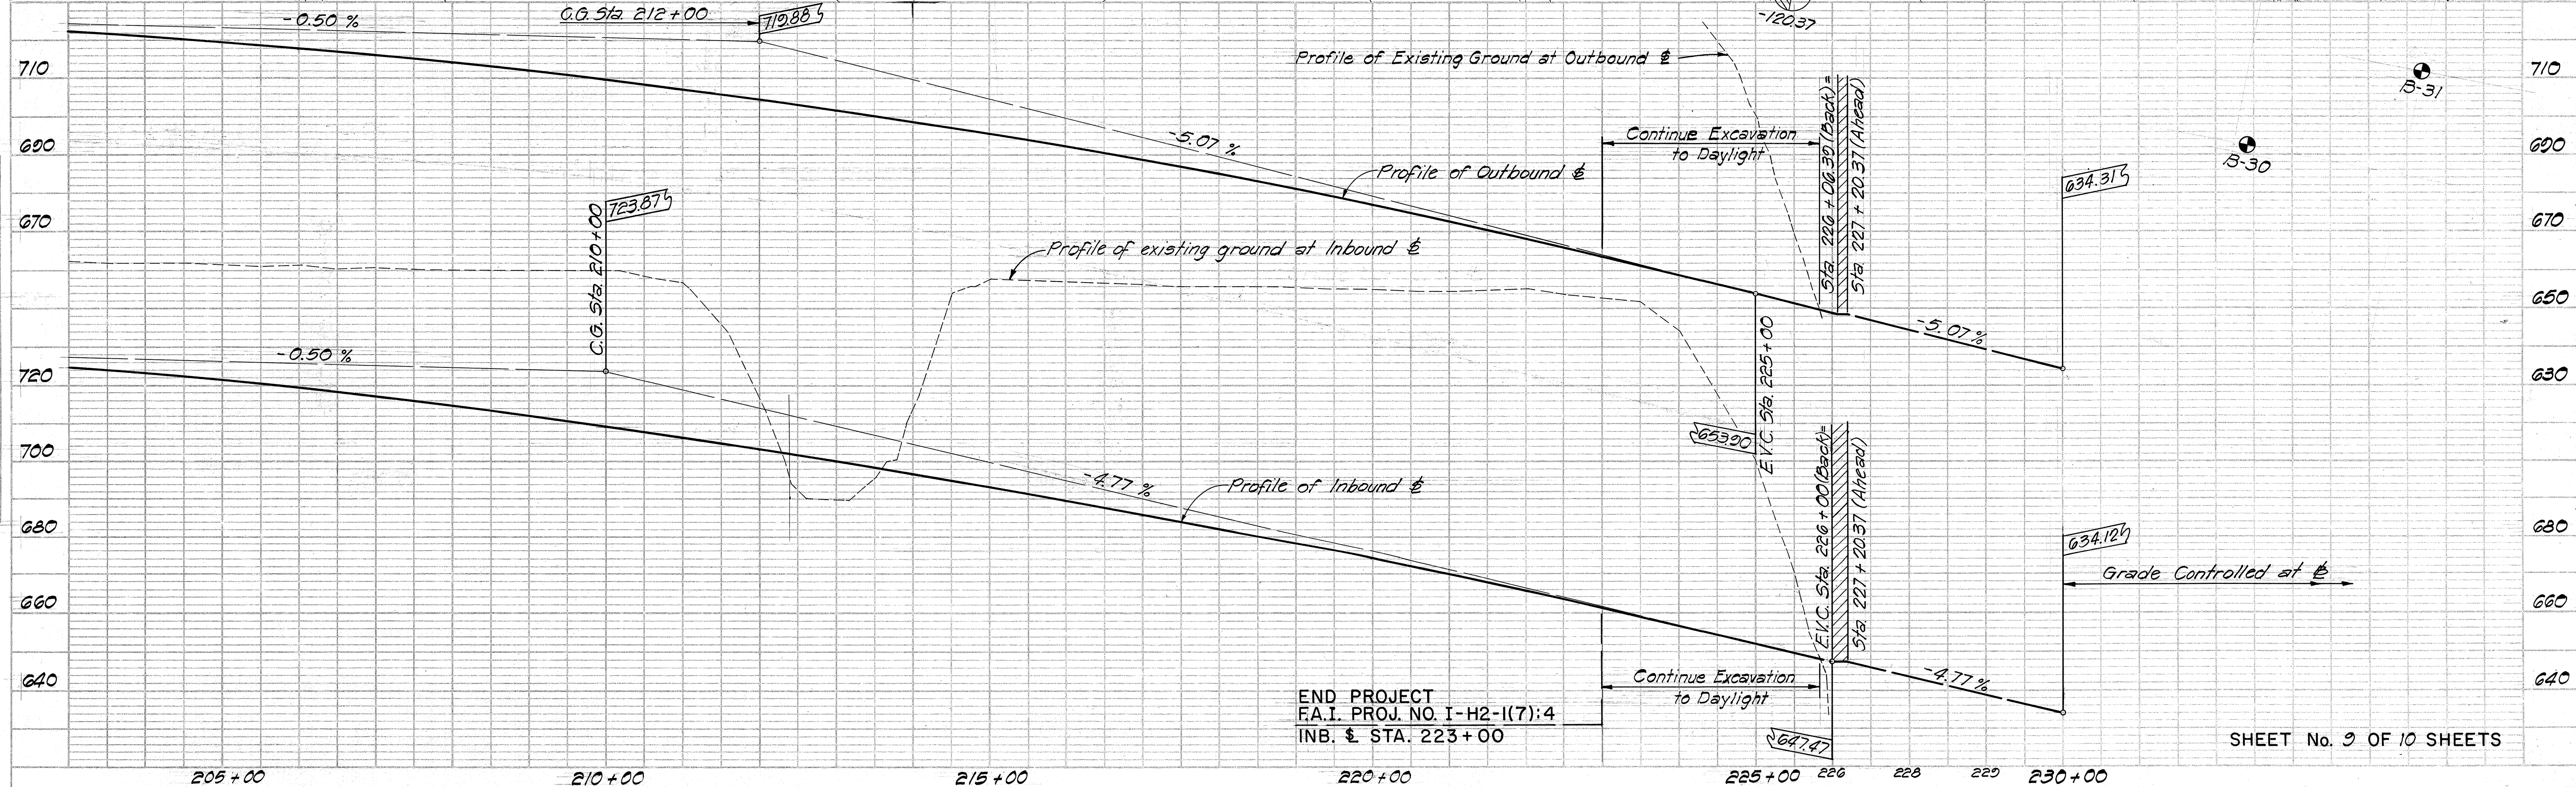
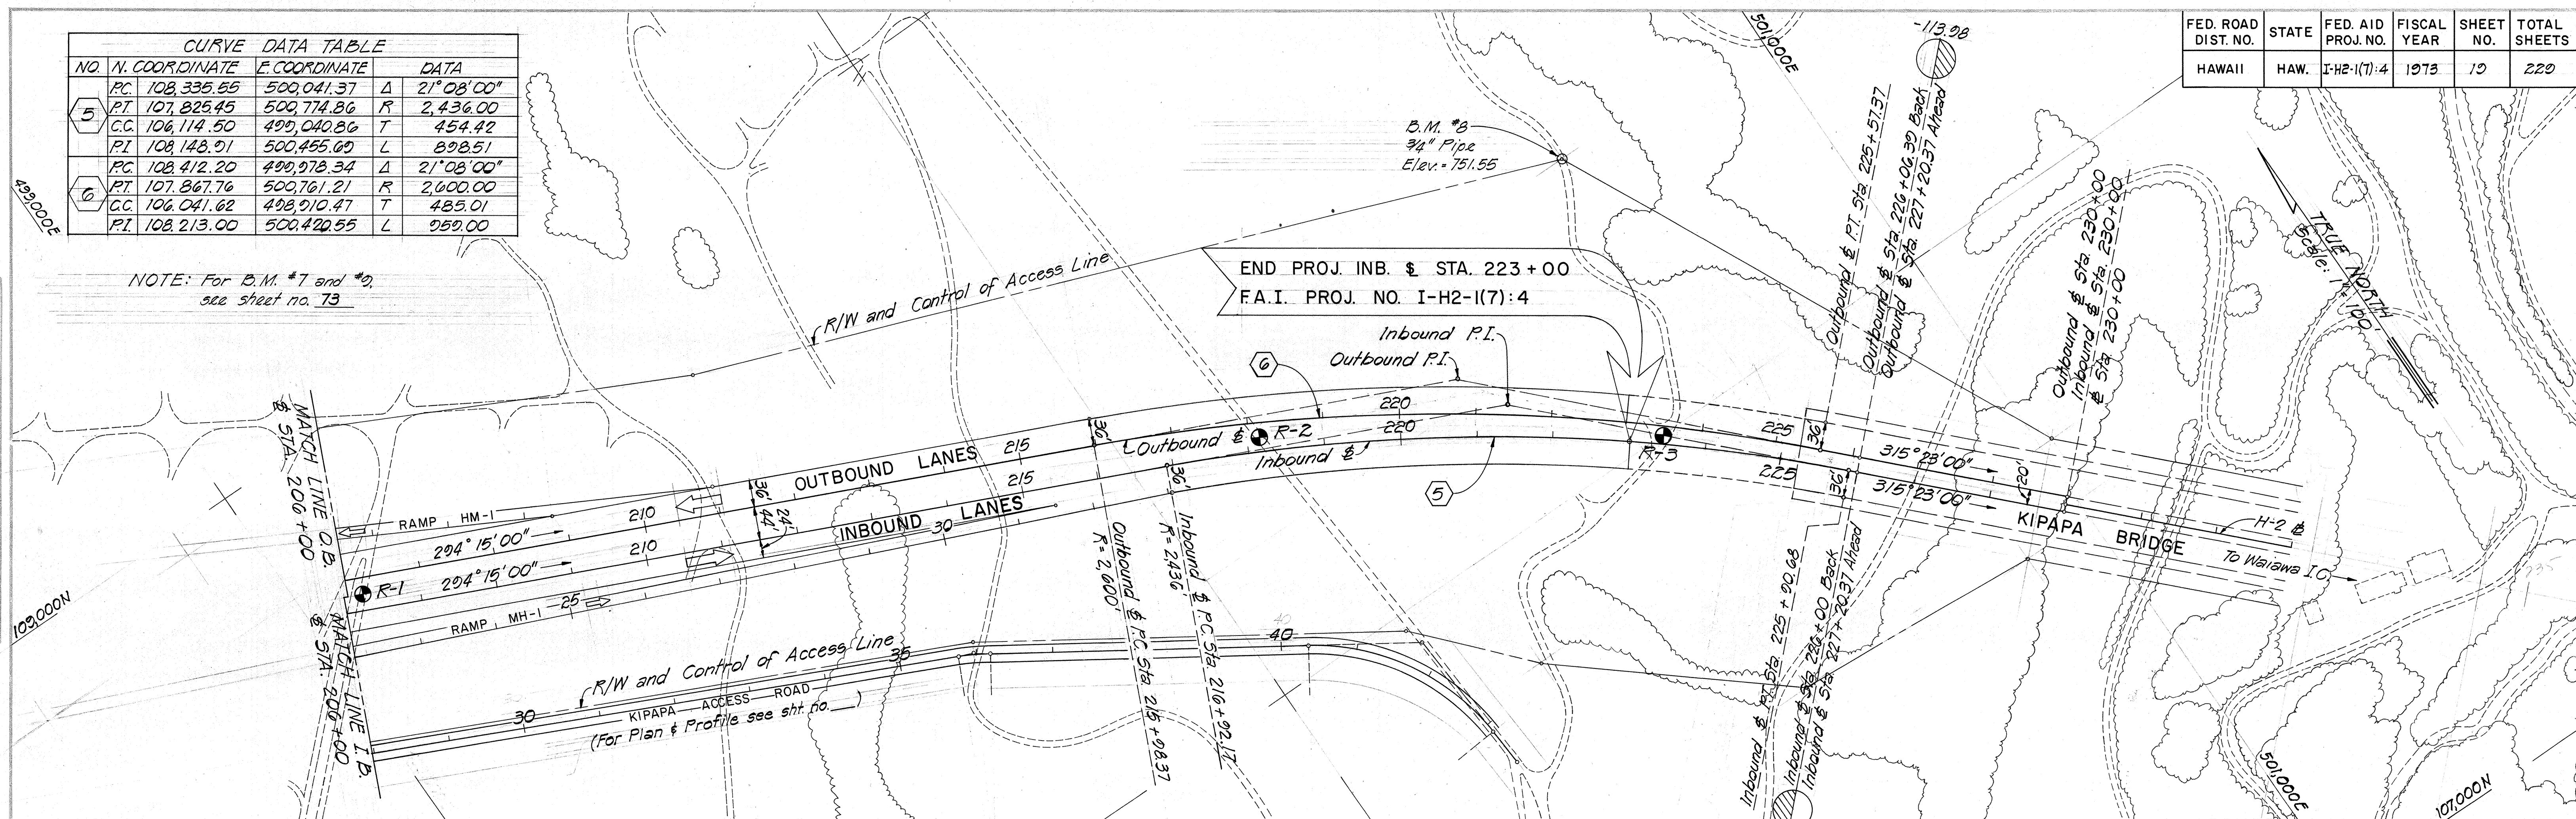


SHEET No. 9 OF 10 SHEETS

FED. ROAD DIST. NO.	STATE	FED. AID PROJ. NO.	FISCAL YEAR	SHEET NO.	TOTAL SHEETS
HAWAII	HAW.	I-H2-1(7)-4	1978	20	229

PLAN	DATE	BY
SURVEYED		
NOTE BOOK		
NO.		

PROFILE	DATE	BY
SURVEYED		
NOTE BOOK		
NO.		

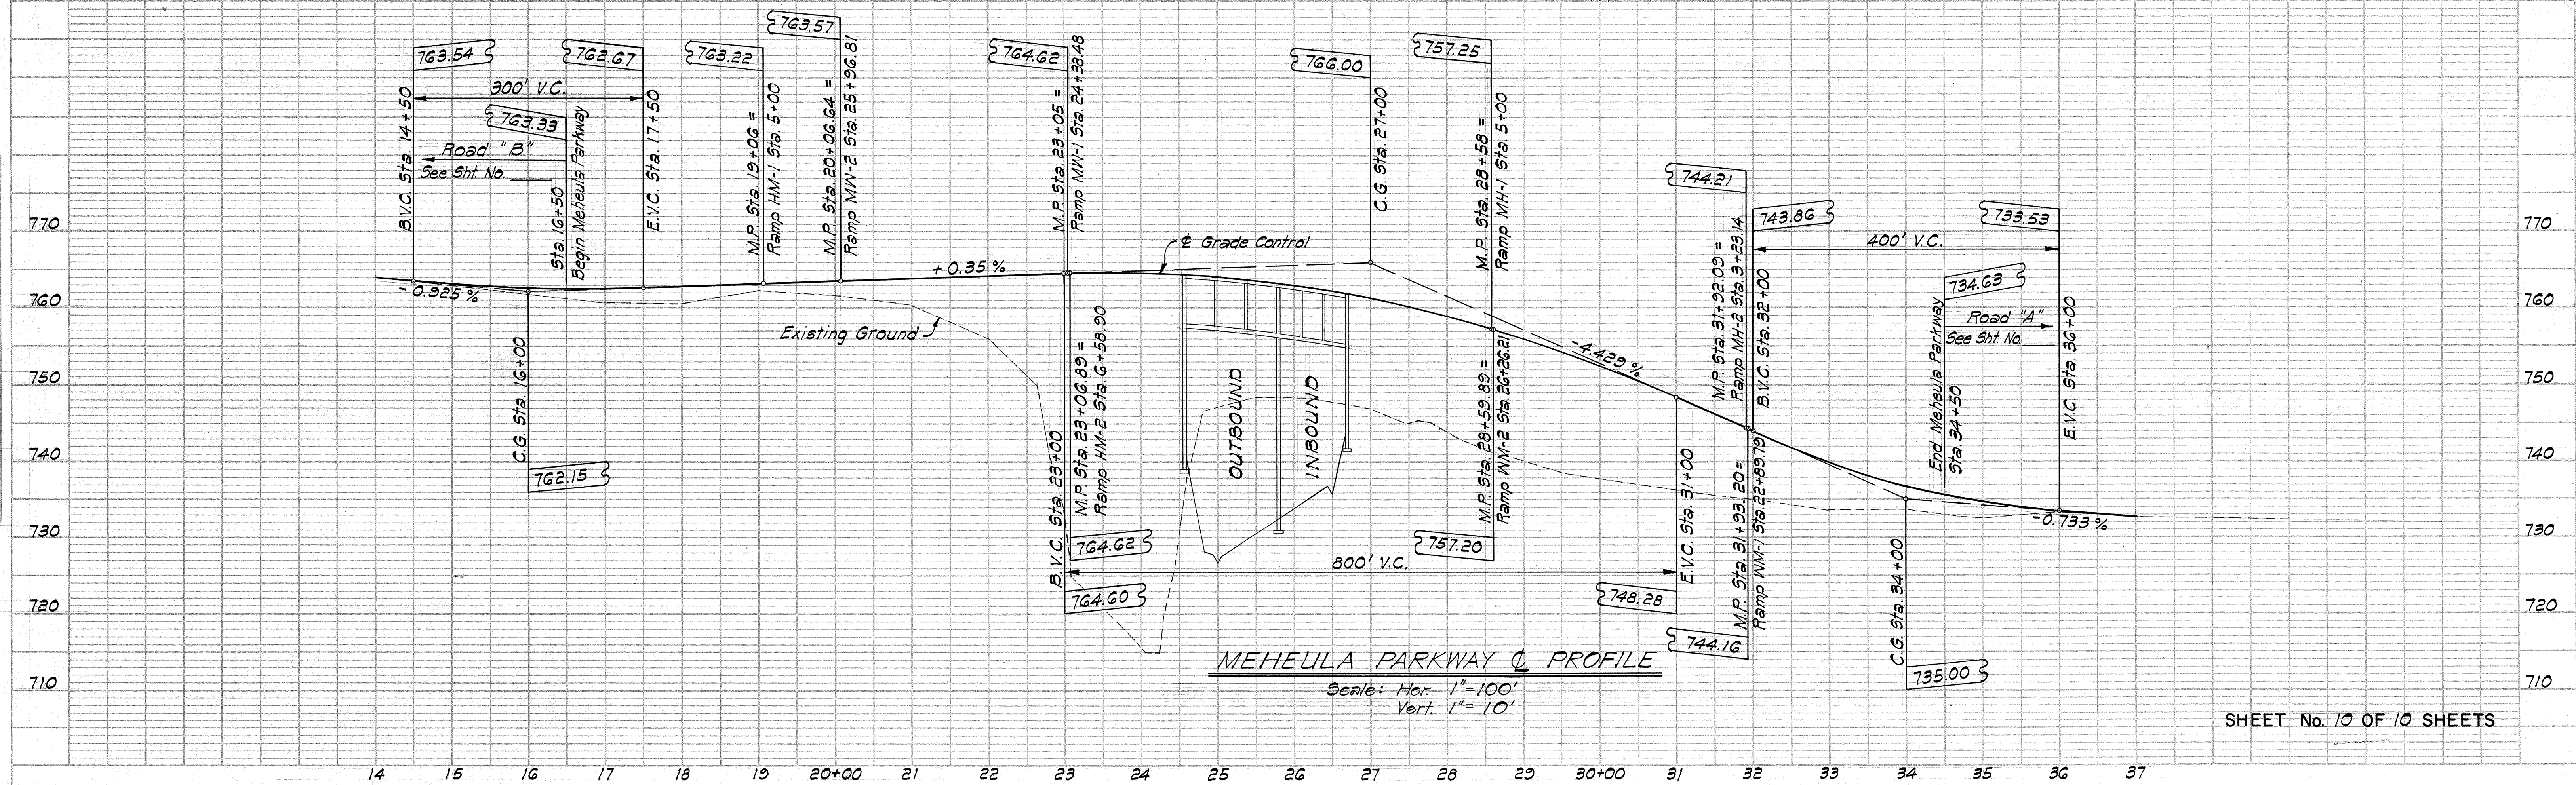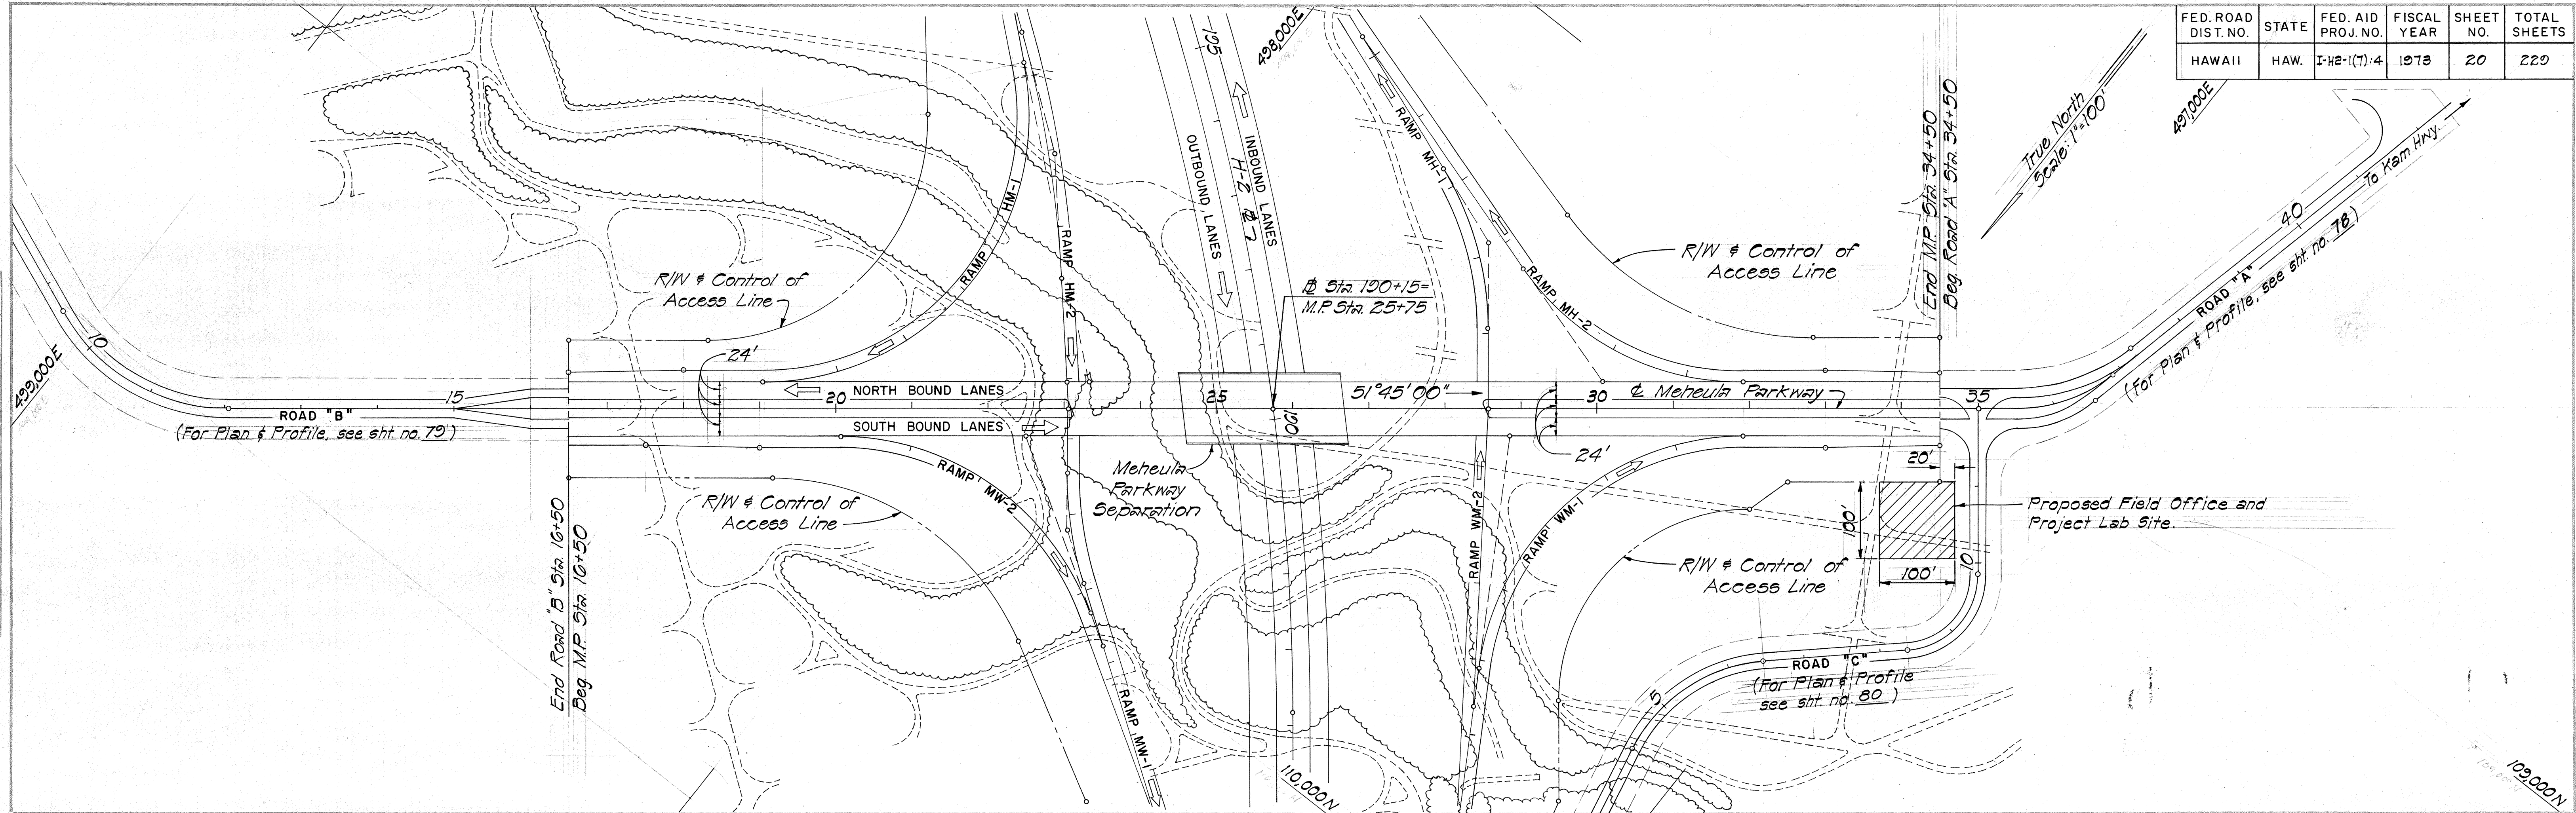

SHEET No. 10 OF 10 SHEETS