

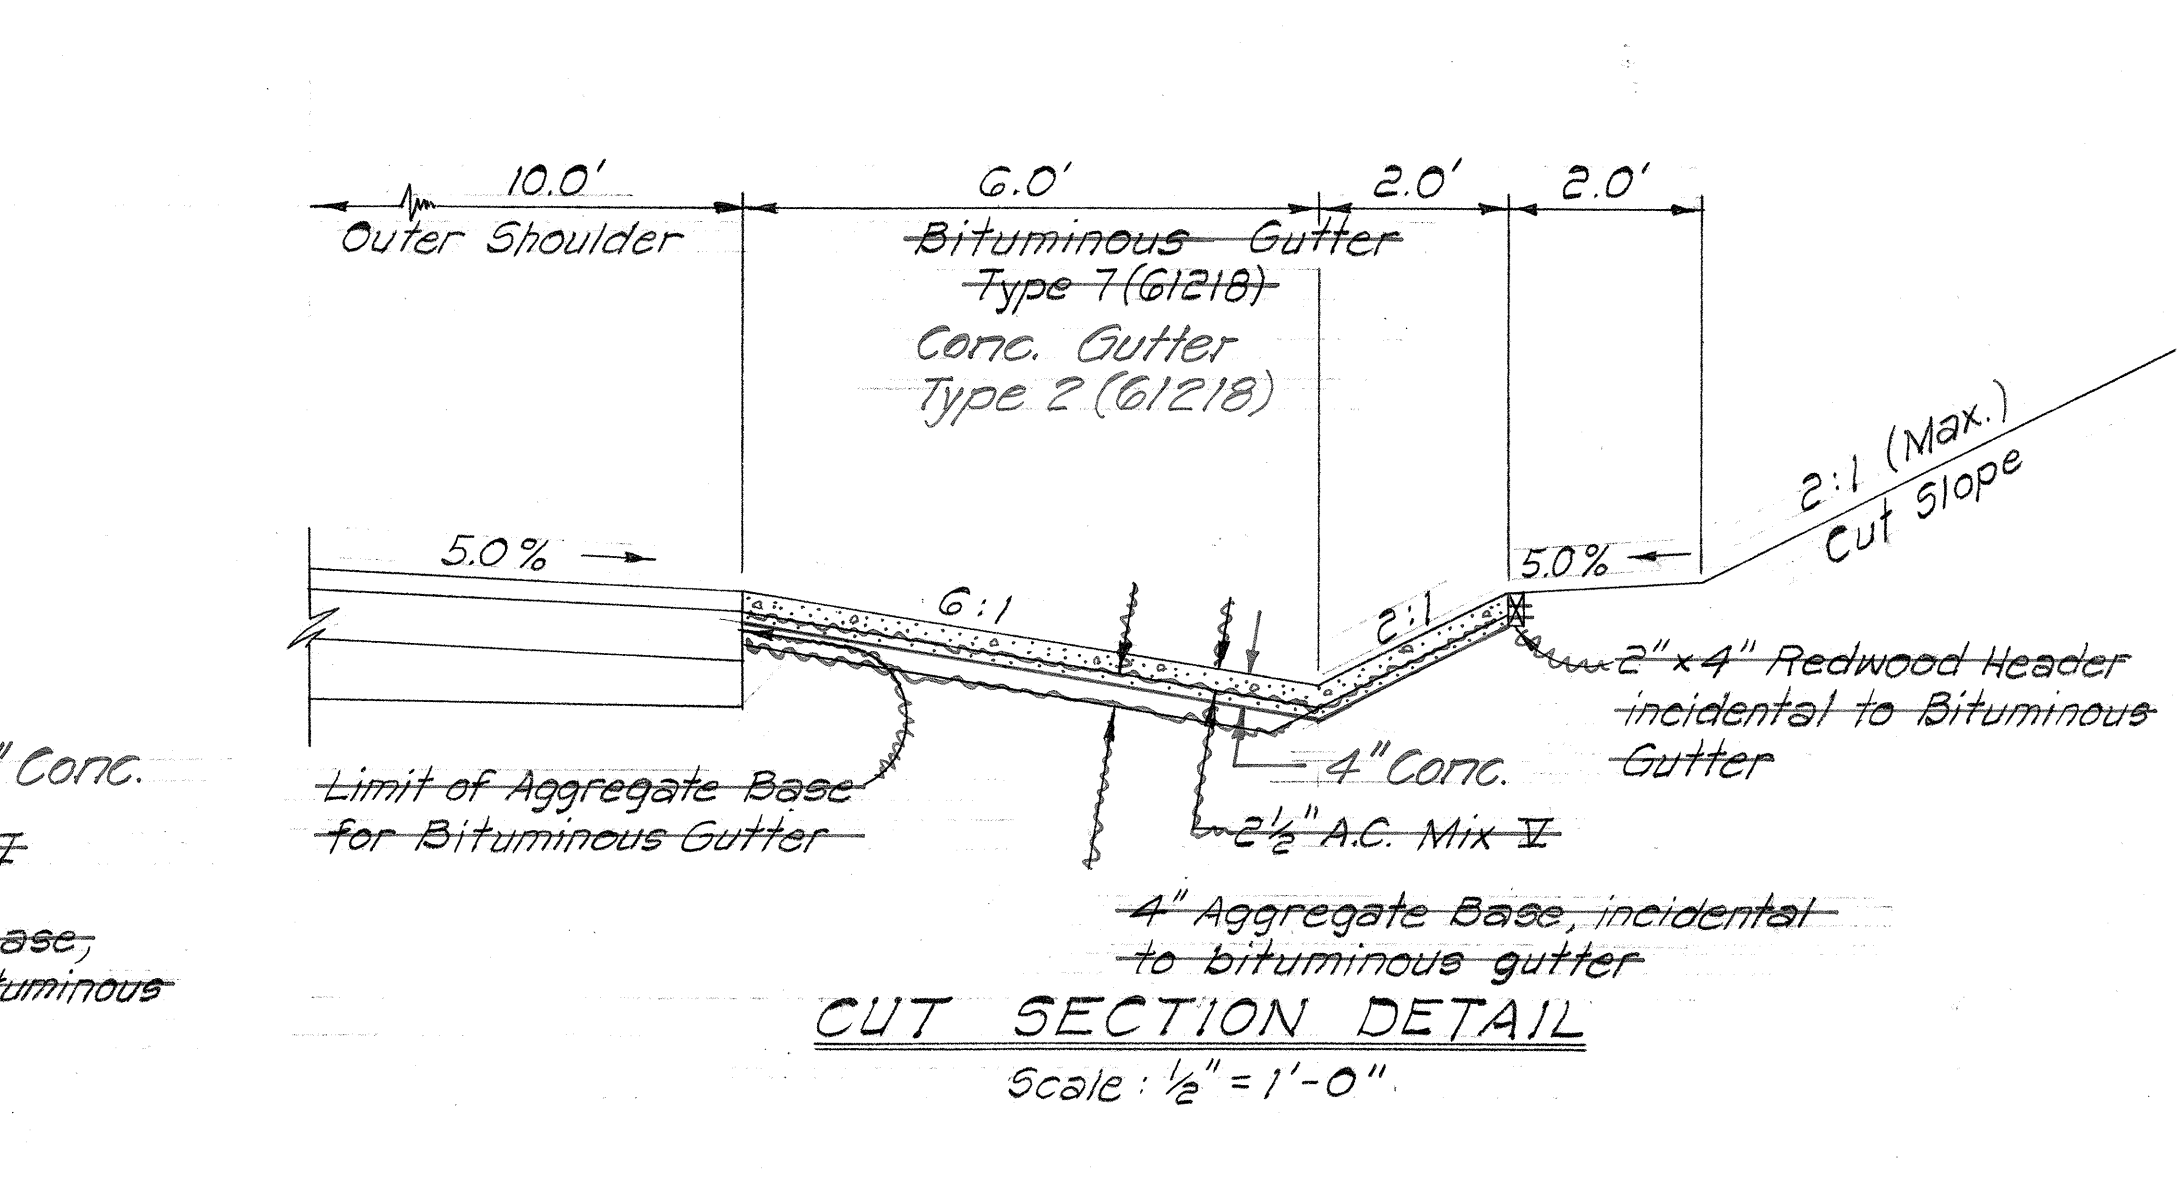
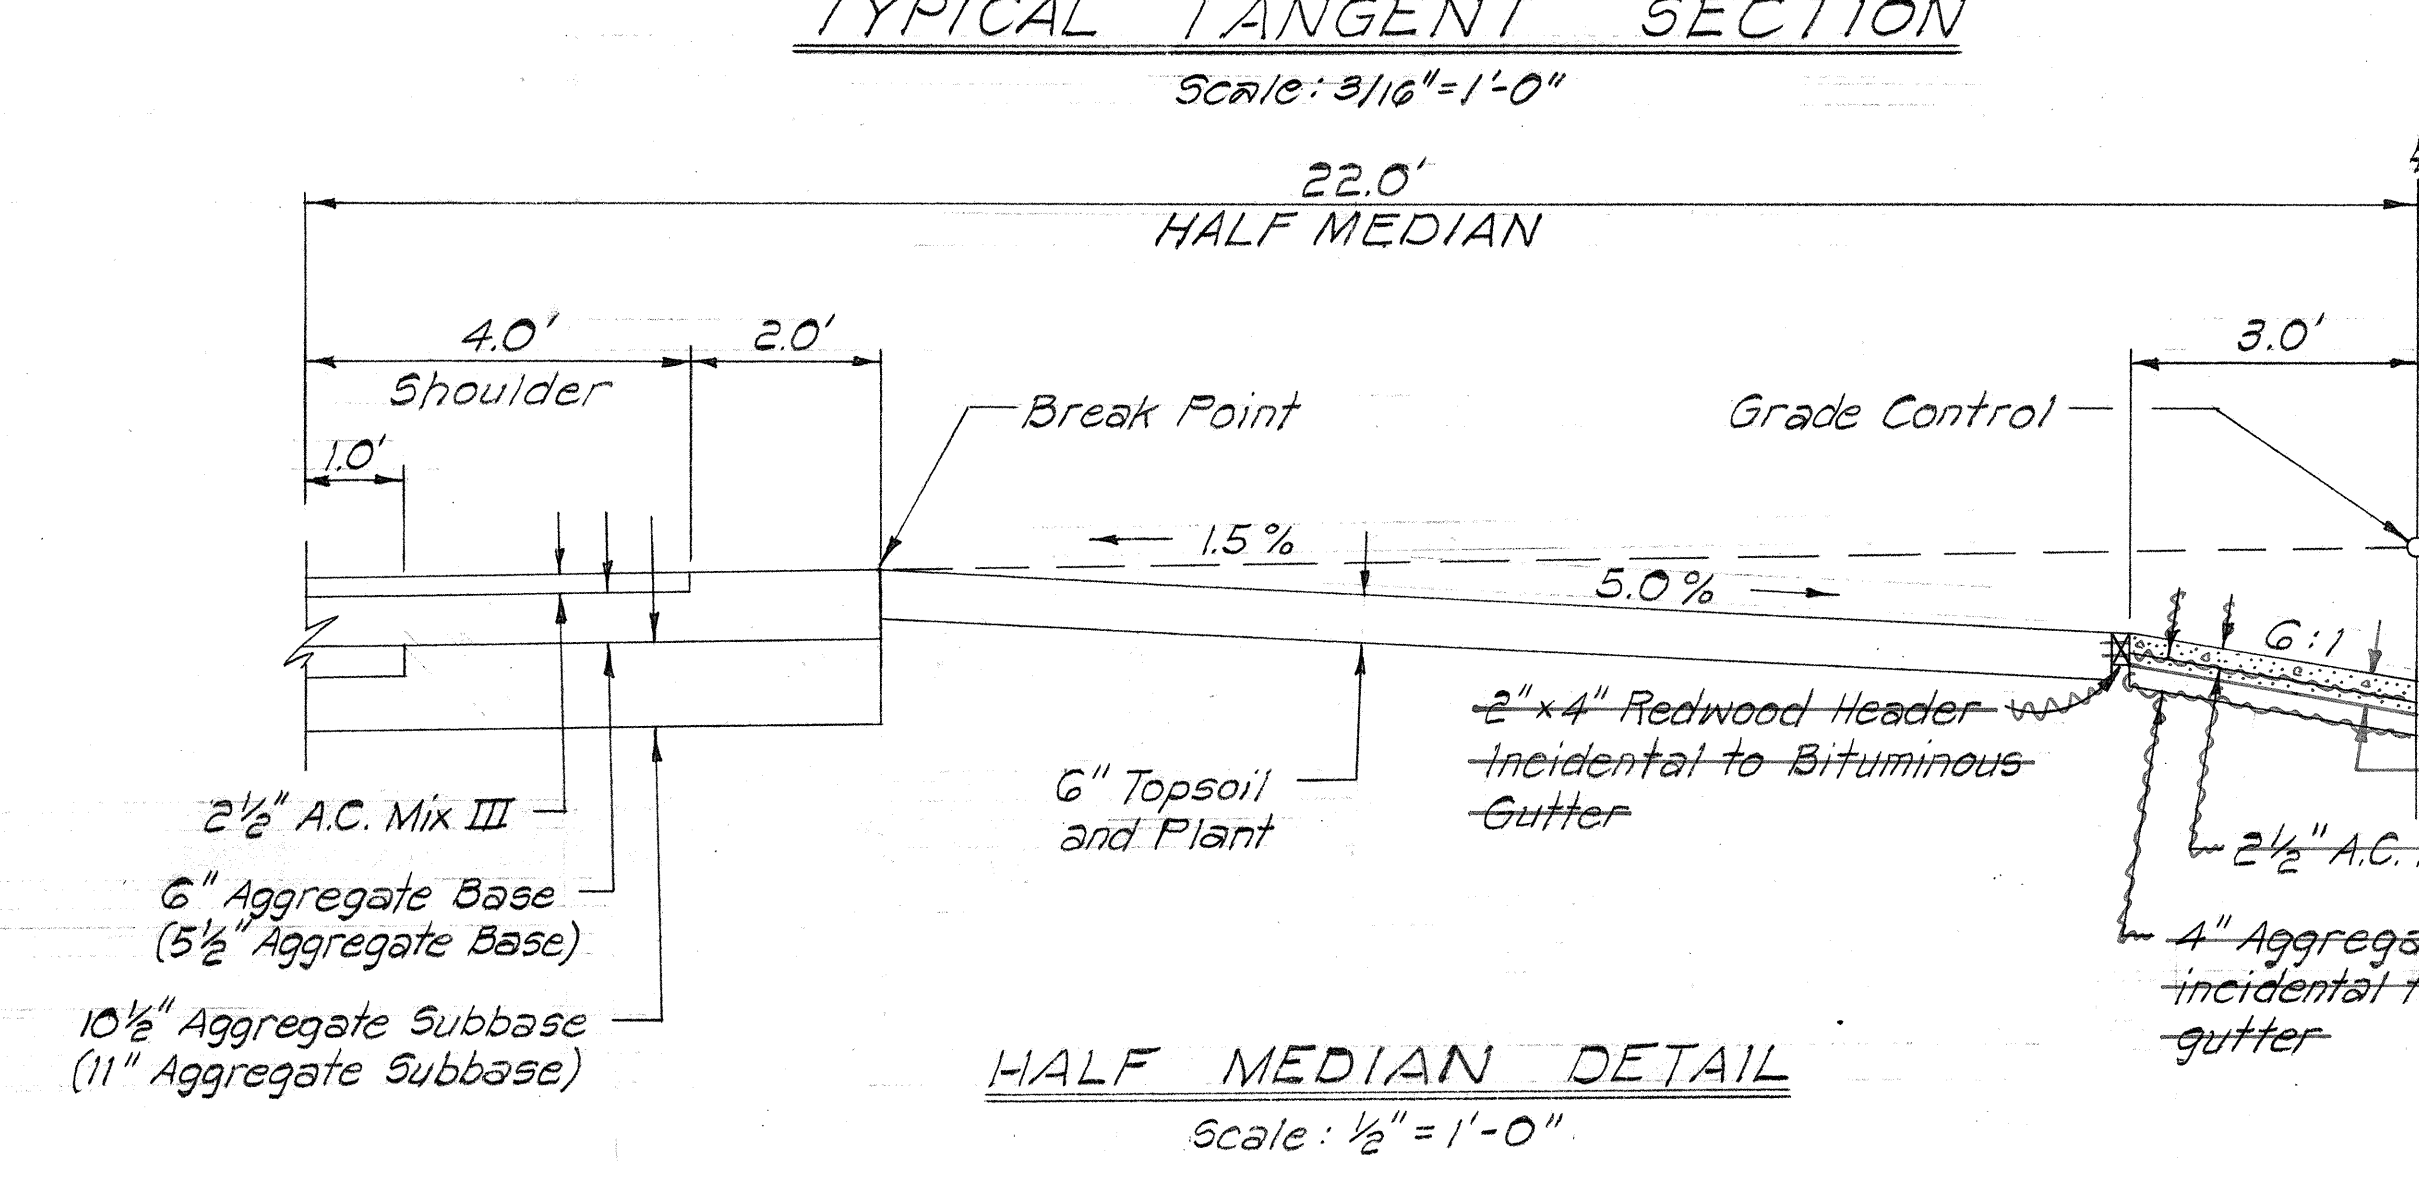
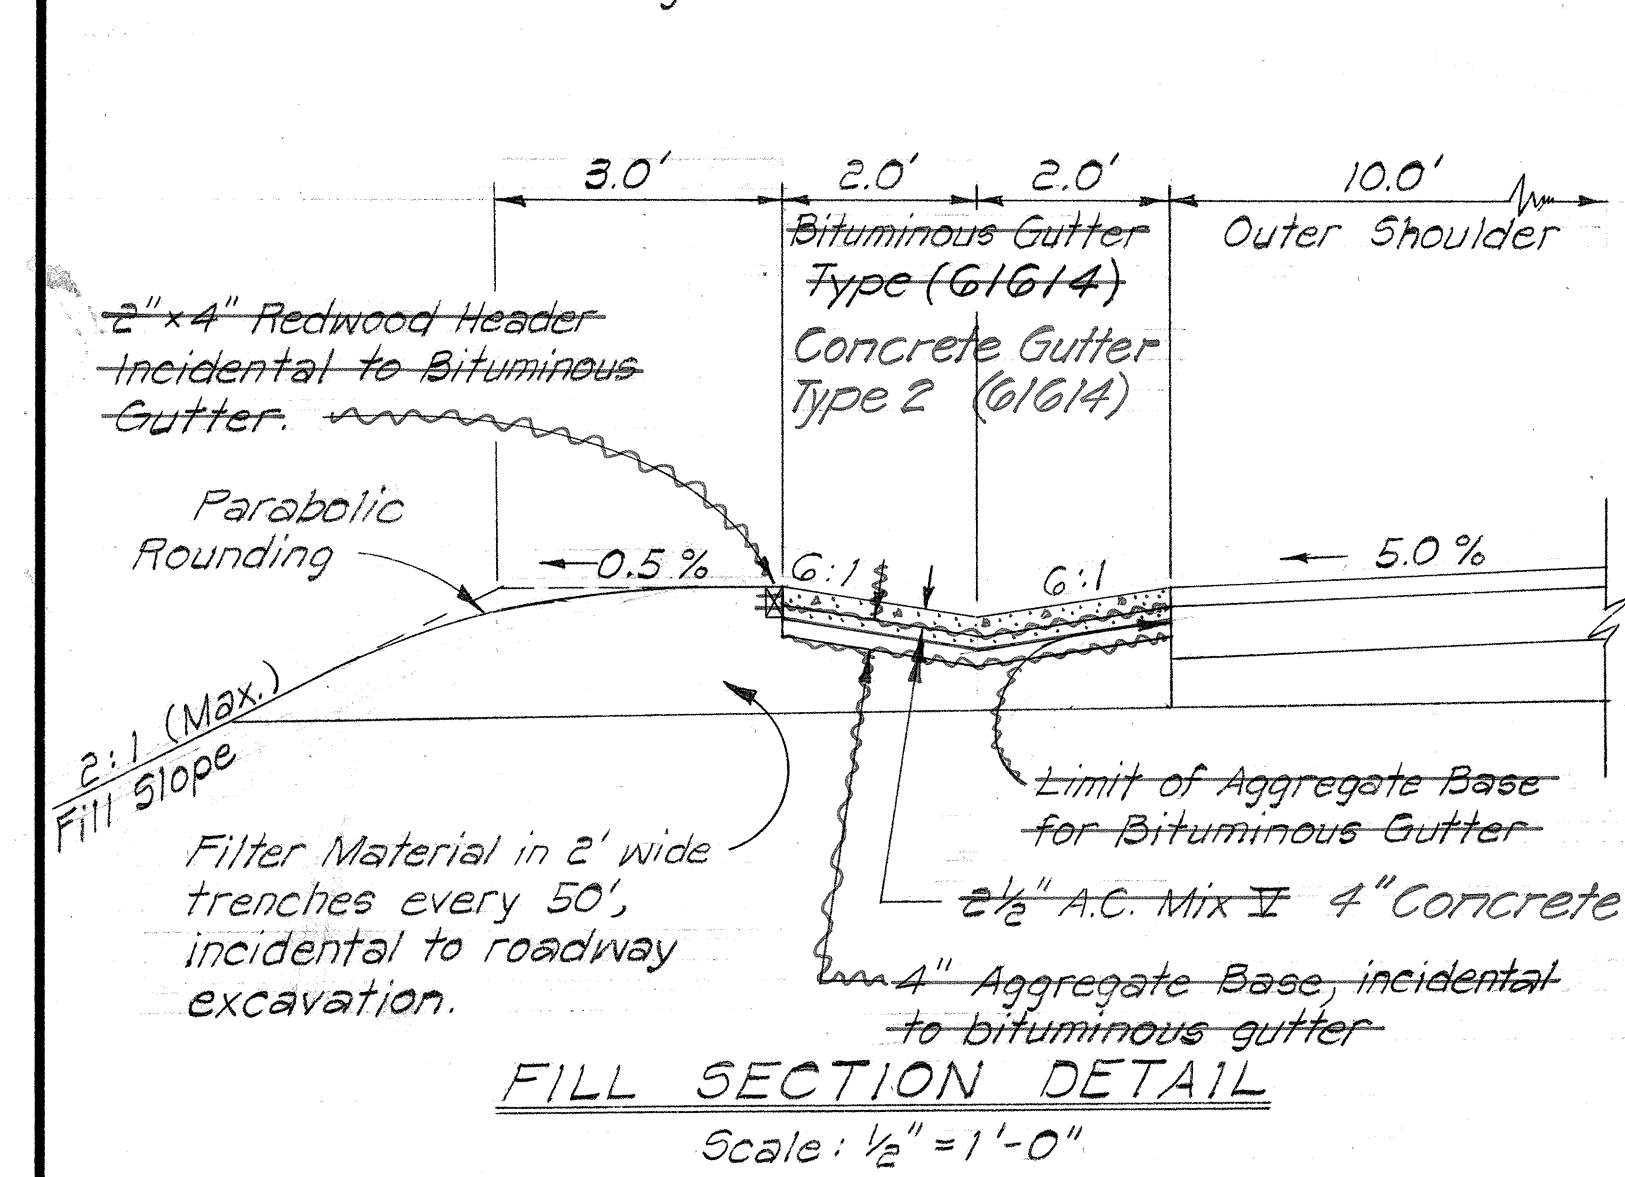
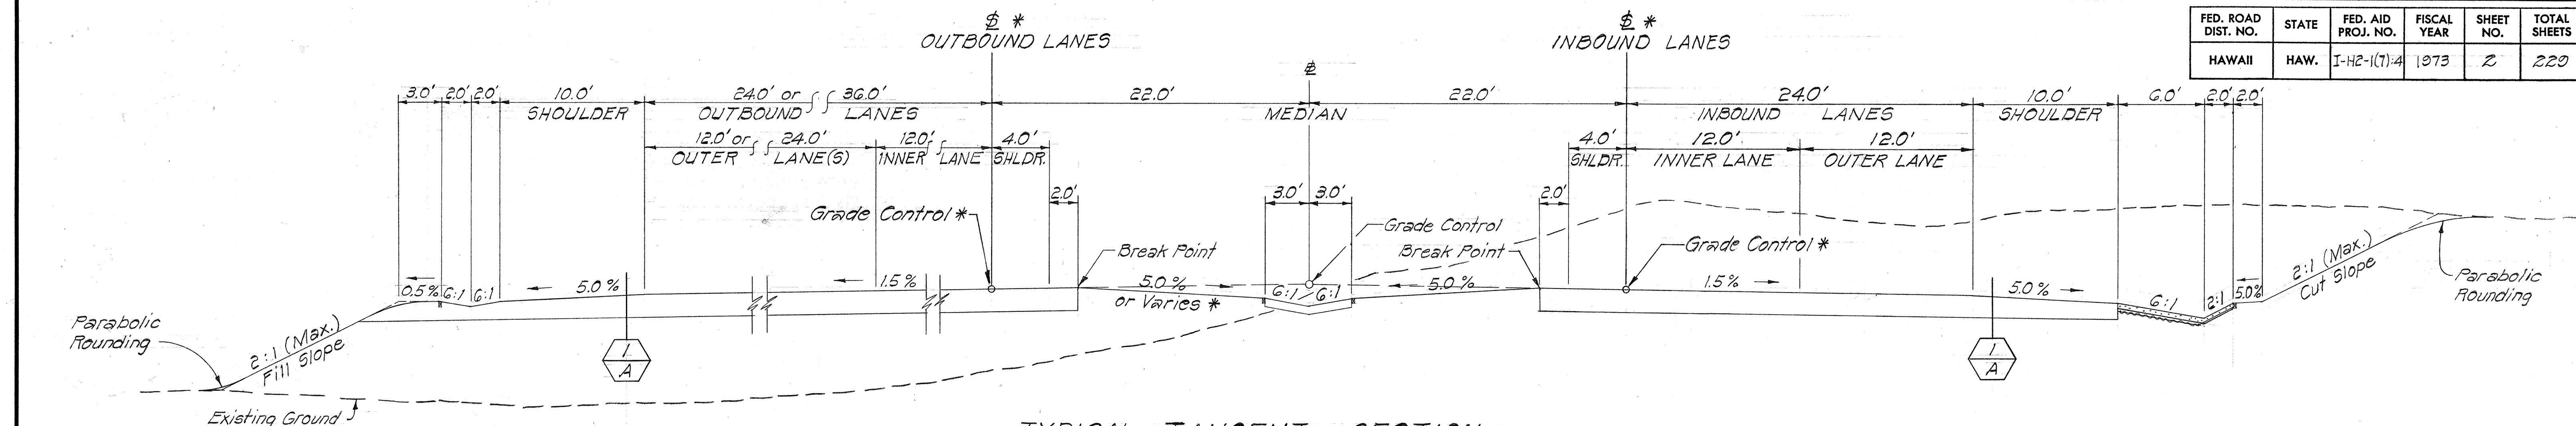


FED. ROAD DIST. NO.	STATE	FED. AID PROJ. NO.	FISCAL YEAR	SHEET NO.	TOTAL SHEETS
HAWAII	HAW.	I-H2-1(7)-4	1973	2	220

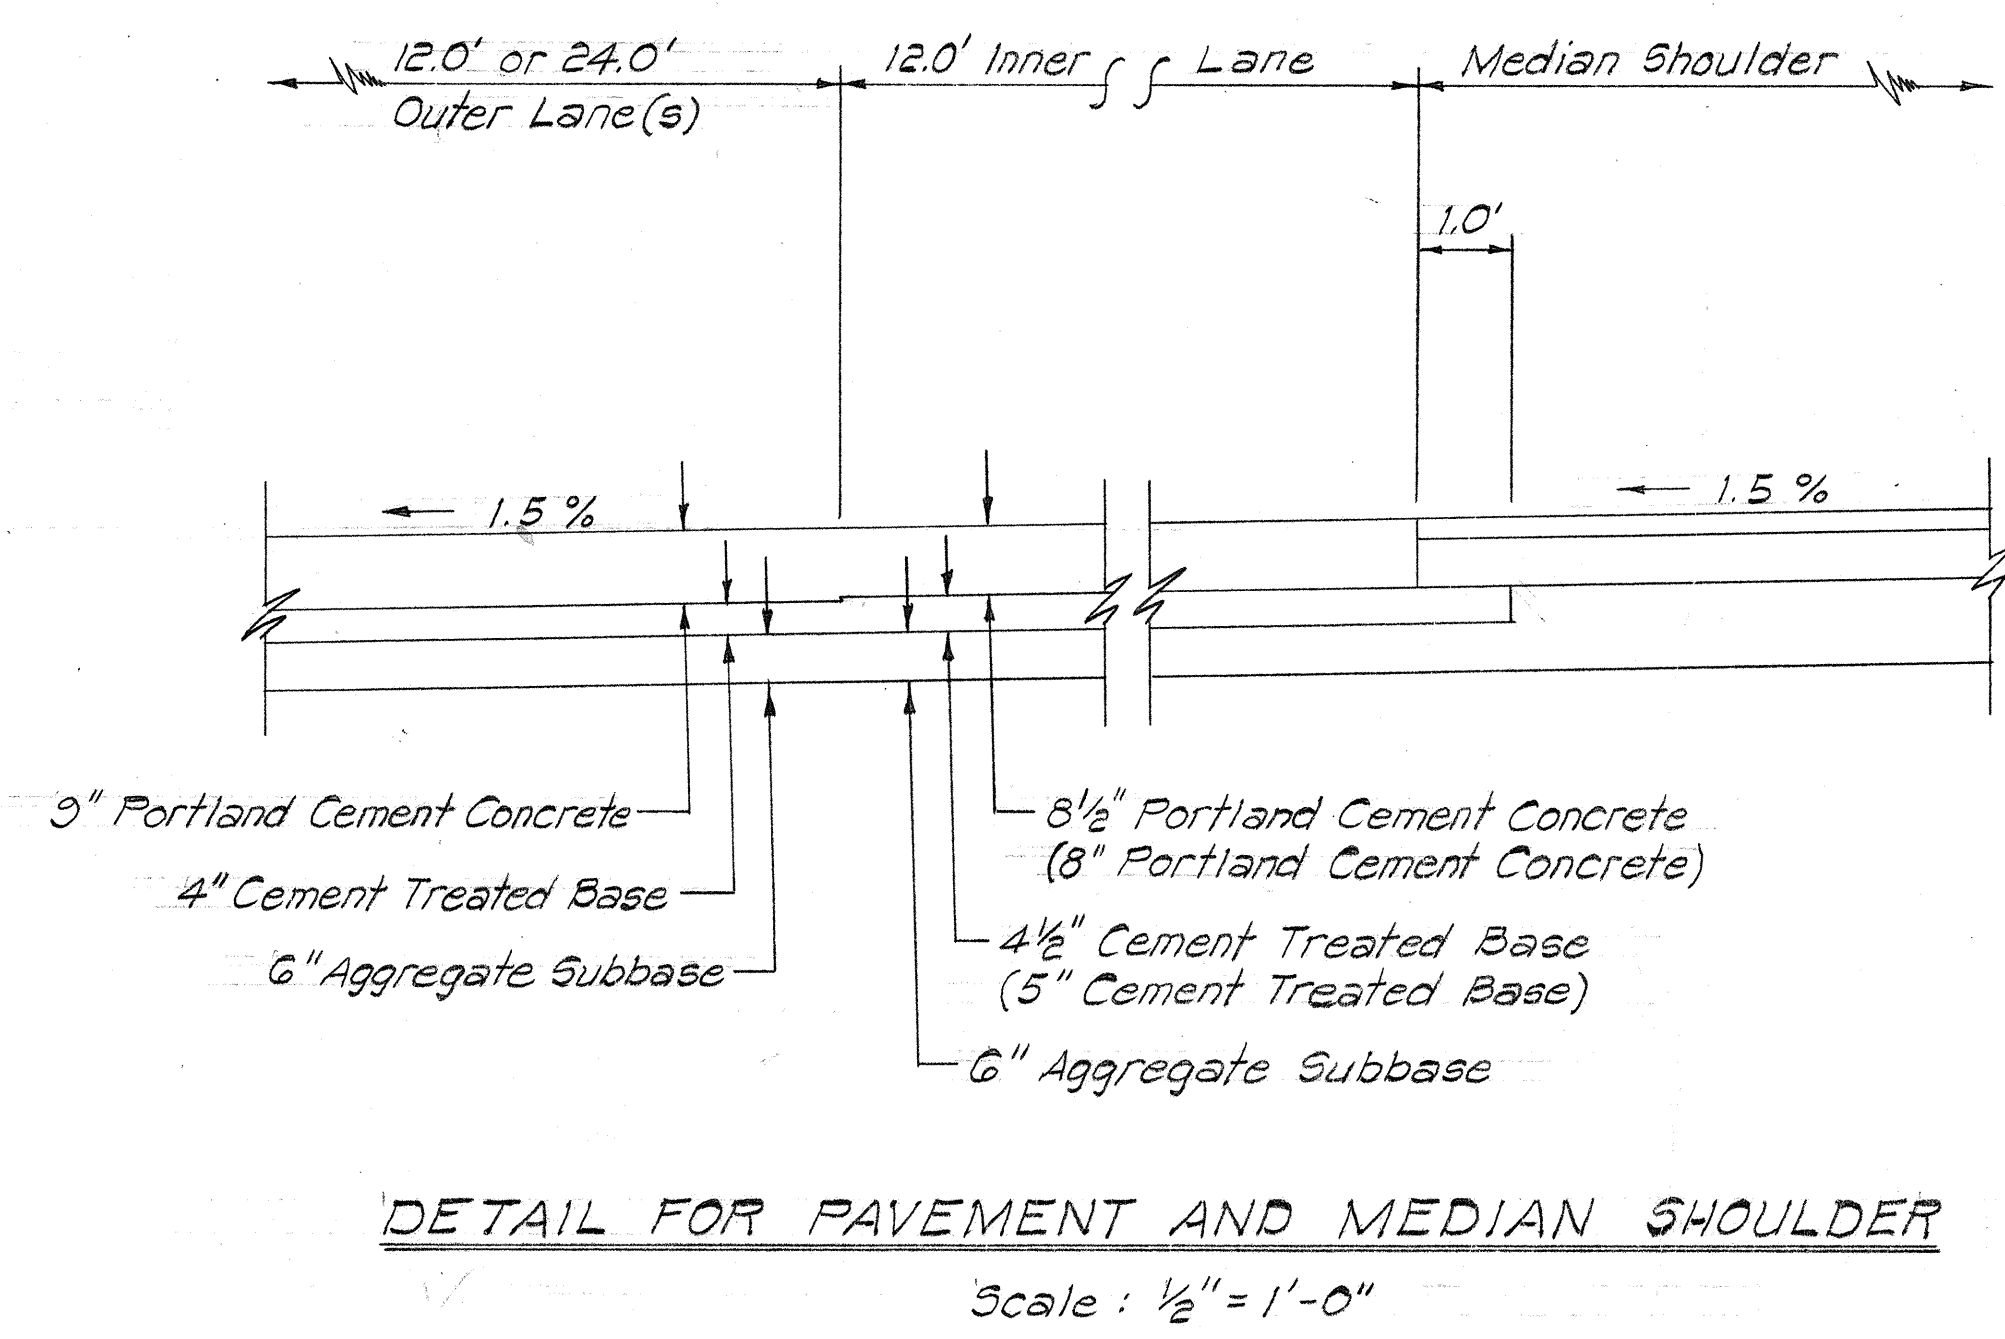

- GENERAL NOTES**
- 1. TYPICAL SECTIONS:**
 - a. For 3-Lane Sections, the thickness shown in parenthesis shall be used.
 - b. * Applicable only to Tangent Sections of the freeway between Sta. 198+00 to End of Project.
 - c. The limit of grading shall be the finish grade as shown.
 - d. Filter material in Fill Sections will not be paid separately but will be considered incidental to roadway excavation.
 - 2. BITUMINOUS GUTTER SECTIONS:**
 - a. The Aggregate Base required for gutter shall be incidental to bituminous gutter.
 - b. A.C. Mix II shall conform to the requirements of Section 603 - Curb and/or Gutter of the Special Provisions.
 - c. 2" x 4" Header shall be construction grade lumber or better, rough finish. (Incidental to Bituminous Gutter)
 - 3. SURFACE TOLERANCES:** See ADD. No. 1
 - a. Surface Tolerances as set forth in Subsection 203.02(c)(3) - Surface Tolerances of the Standard Specifications shall apply only to Pineapple Road and Access Roads and where gutters are to be constructed under this contract.
 - 4. PLANTING:**
 - a. For planting details, see "Erosion Control" plans.







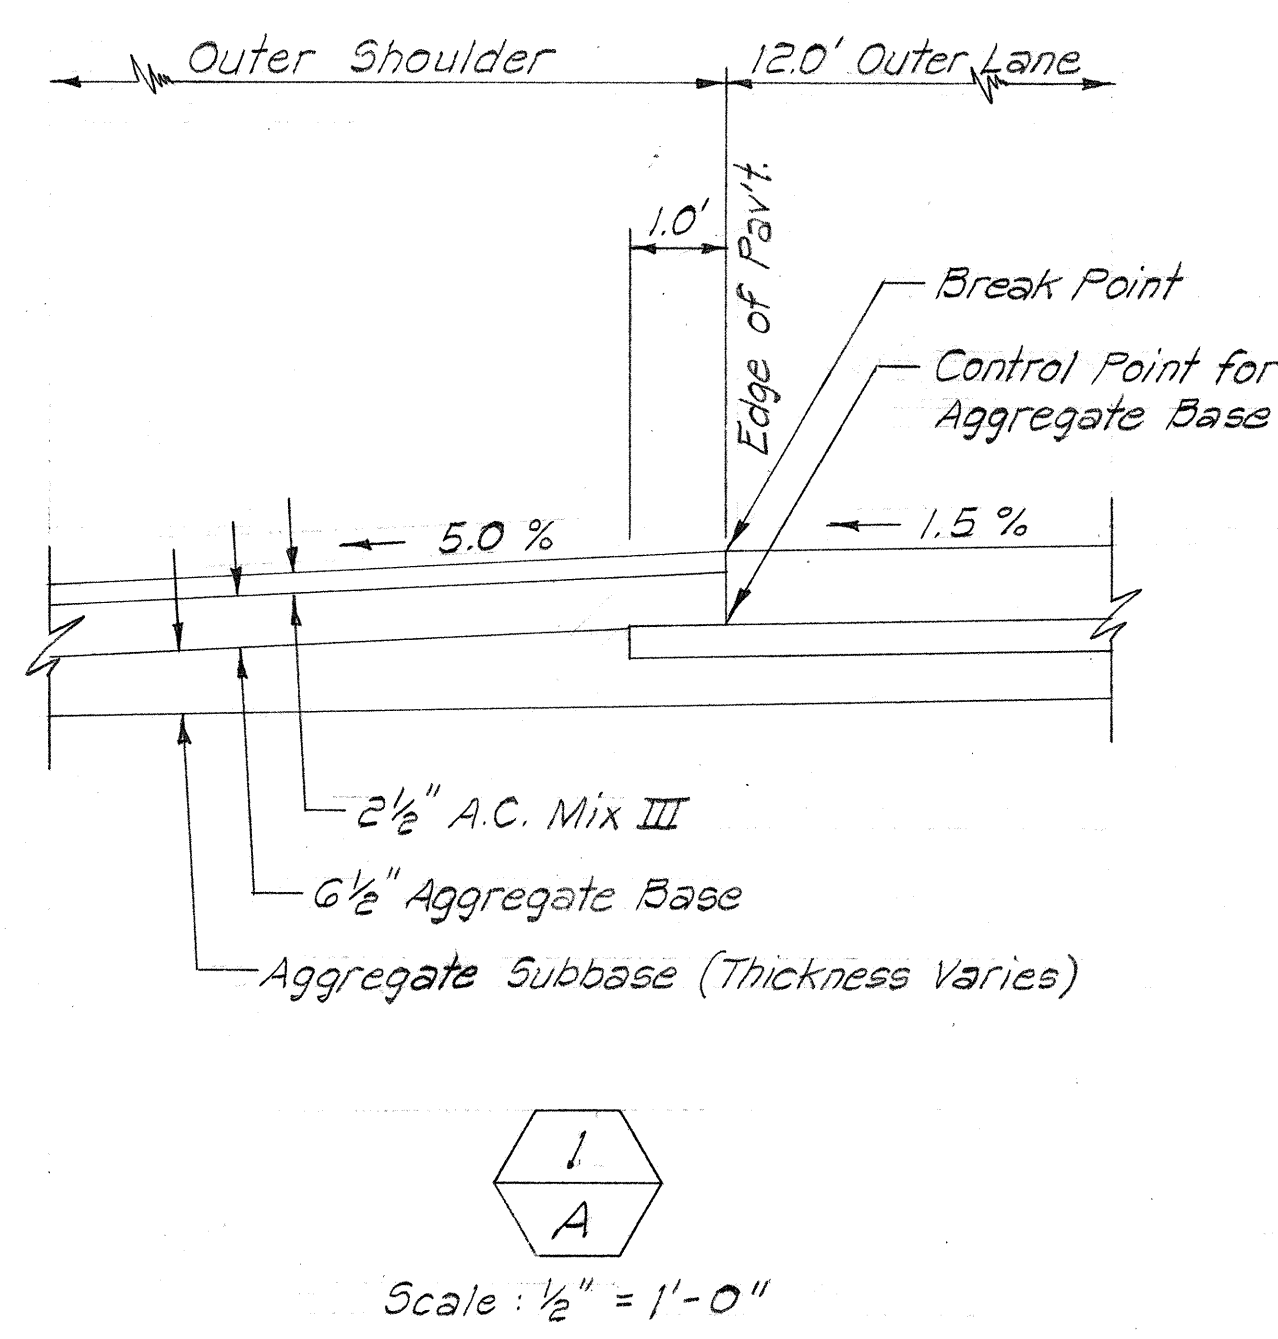


STATE OF HAWAII
DEPARTMENT OF TRANSPORTATION
HIGHWAYS DIVISION

TYPICAL SECTIONS
INTERSTATE ROUTE H-2
MILILANI INTERCHANGE
F.A.I. Proj. No. I-H2-1(7)-4
Scale: As Shown Date: April, 1973
SHEET No. 1 OF 2 SHEETS

DATE	_____
DESIGNED BY	_____
CHECKED BY	_____
NOTED BY	_____
NO.	_____

FED. ROAD DIST. NO.	STATE	FED. AID PROJ. NO.	FISCAL YEAR	SHEET NO.	TOTAL SHEETS
HAWAII	HAW.	I-H2-1(7)4	1973	3	229

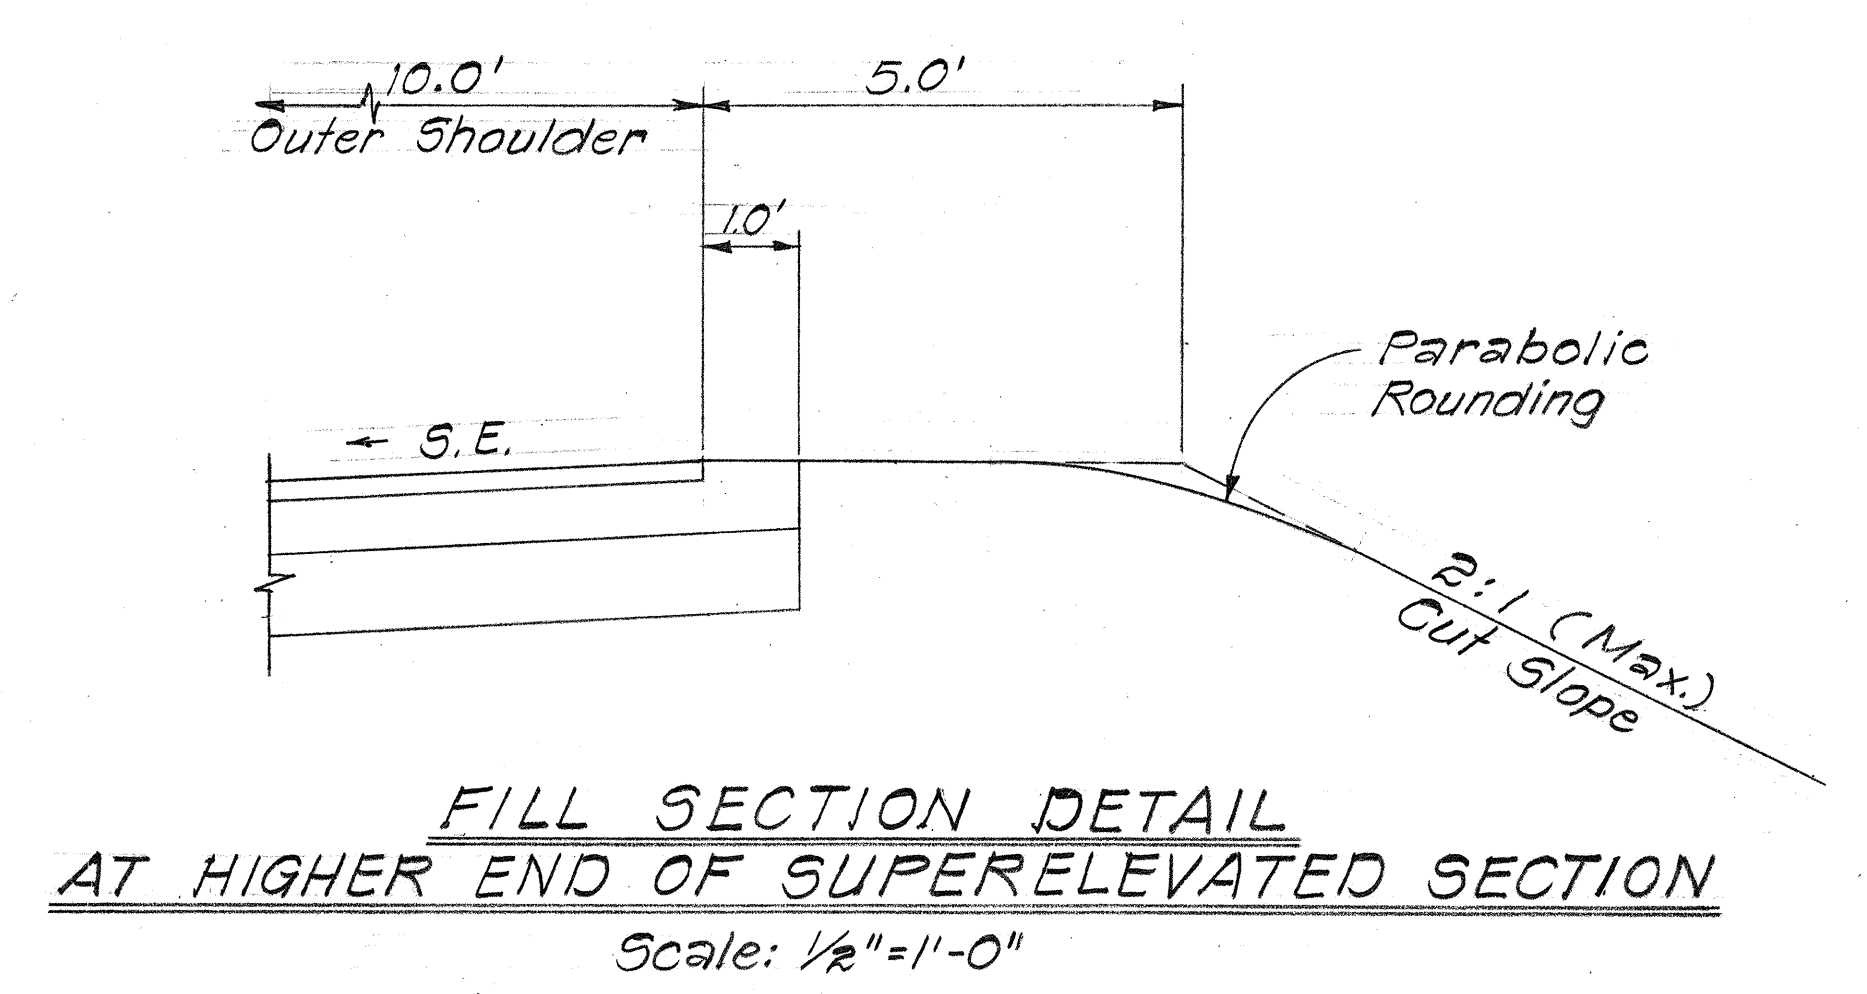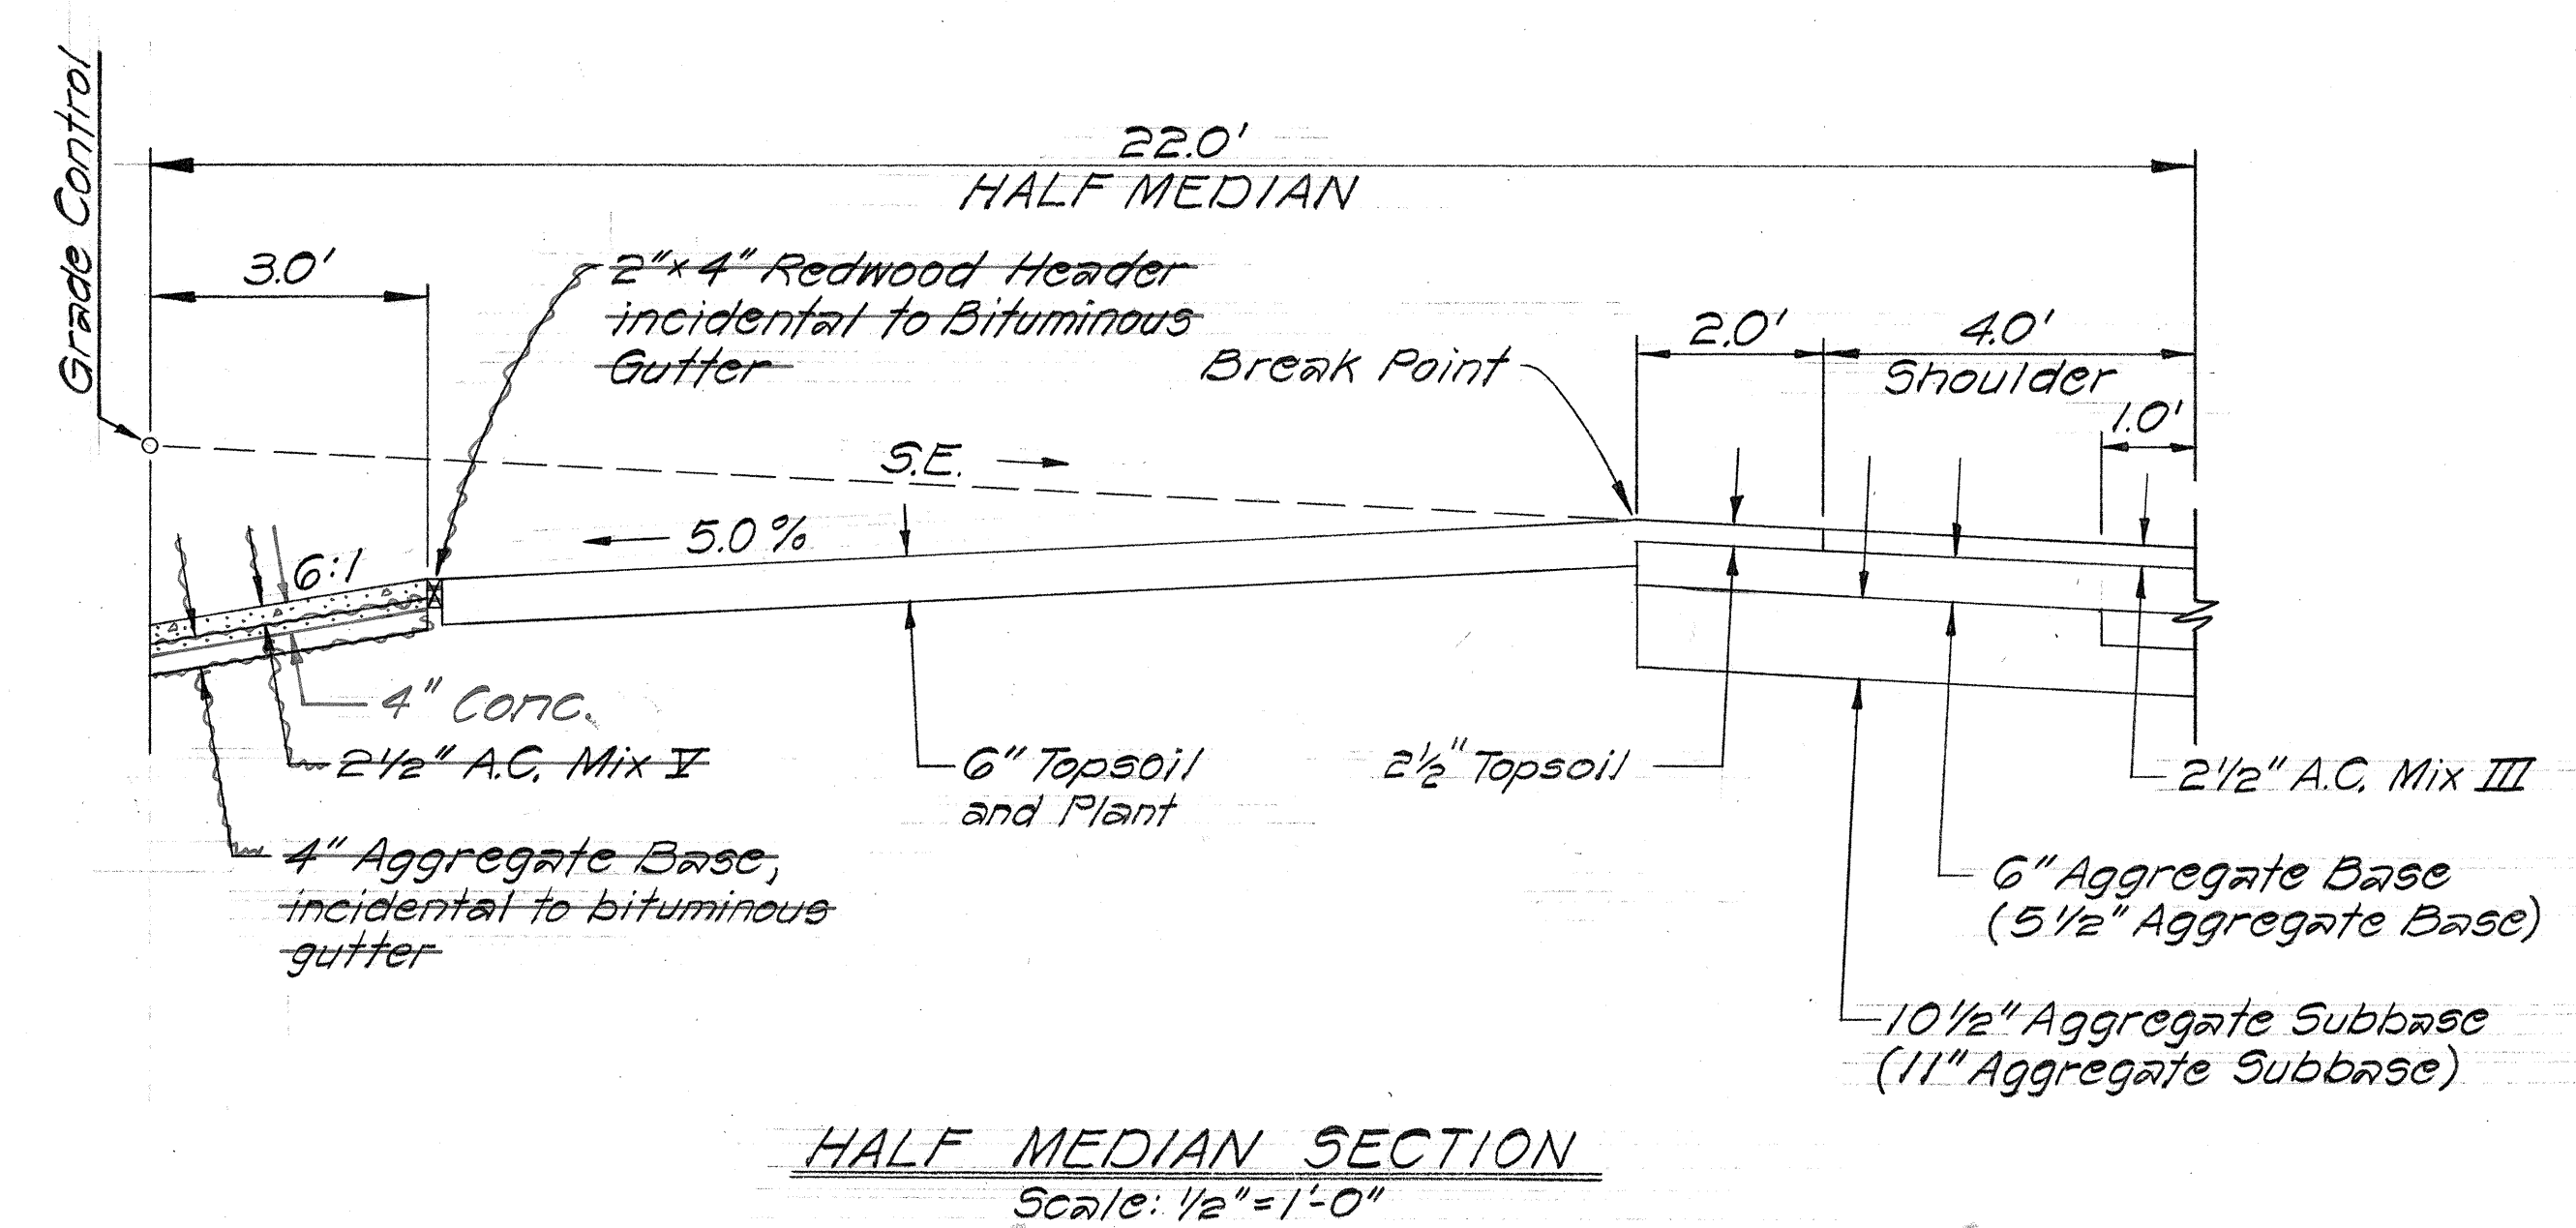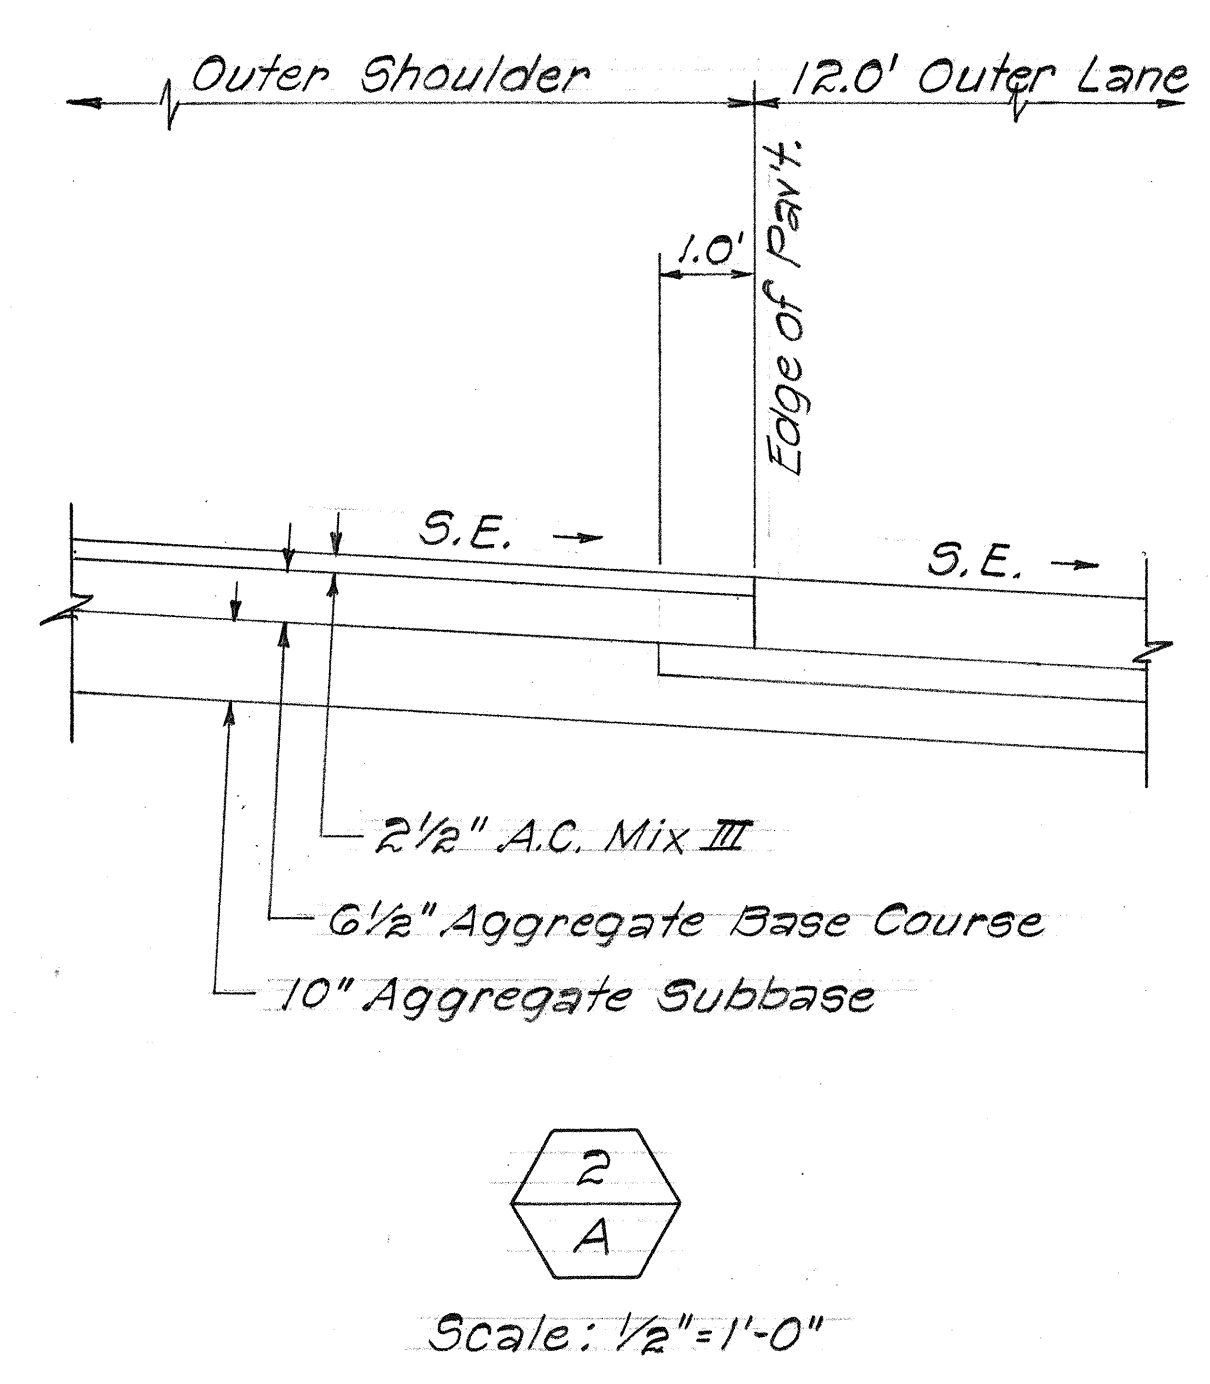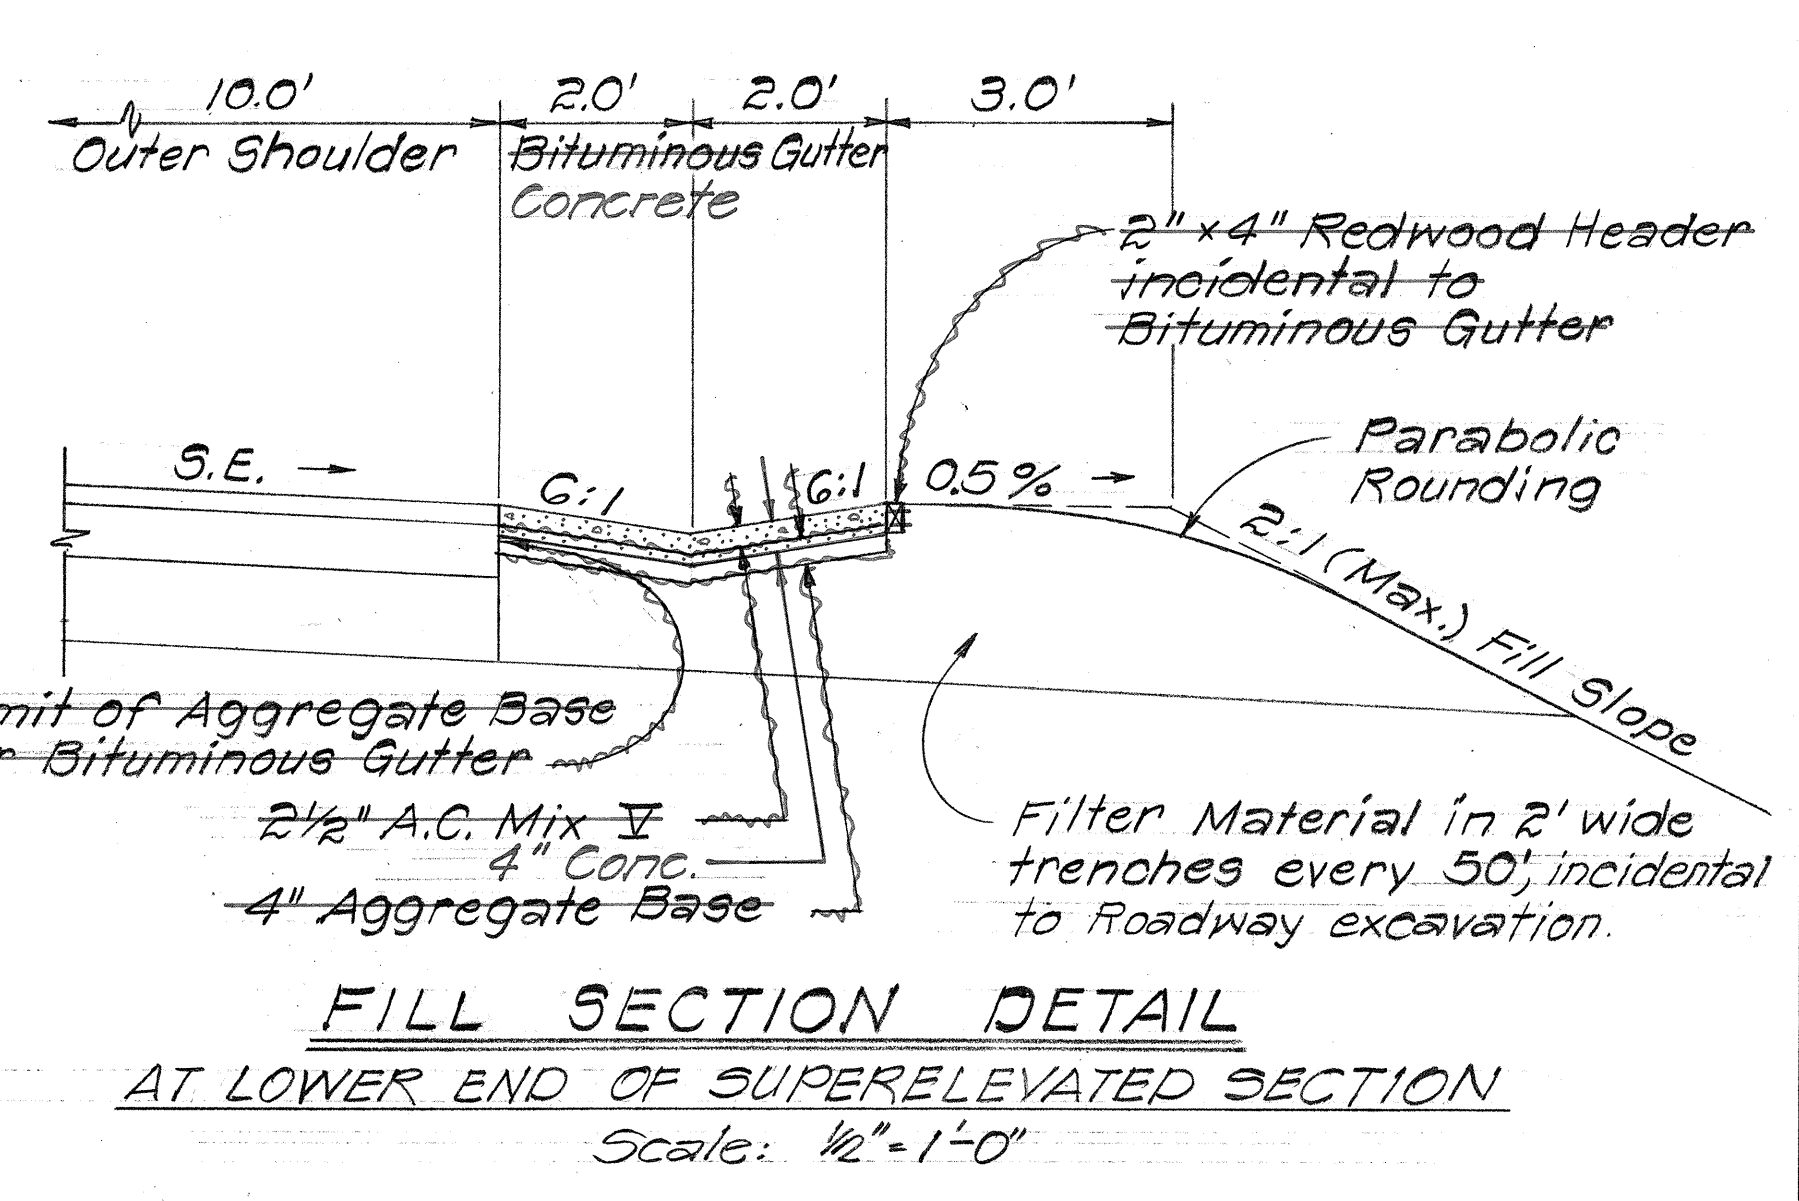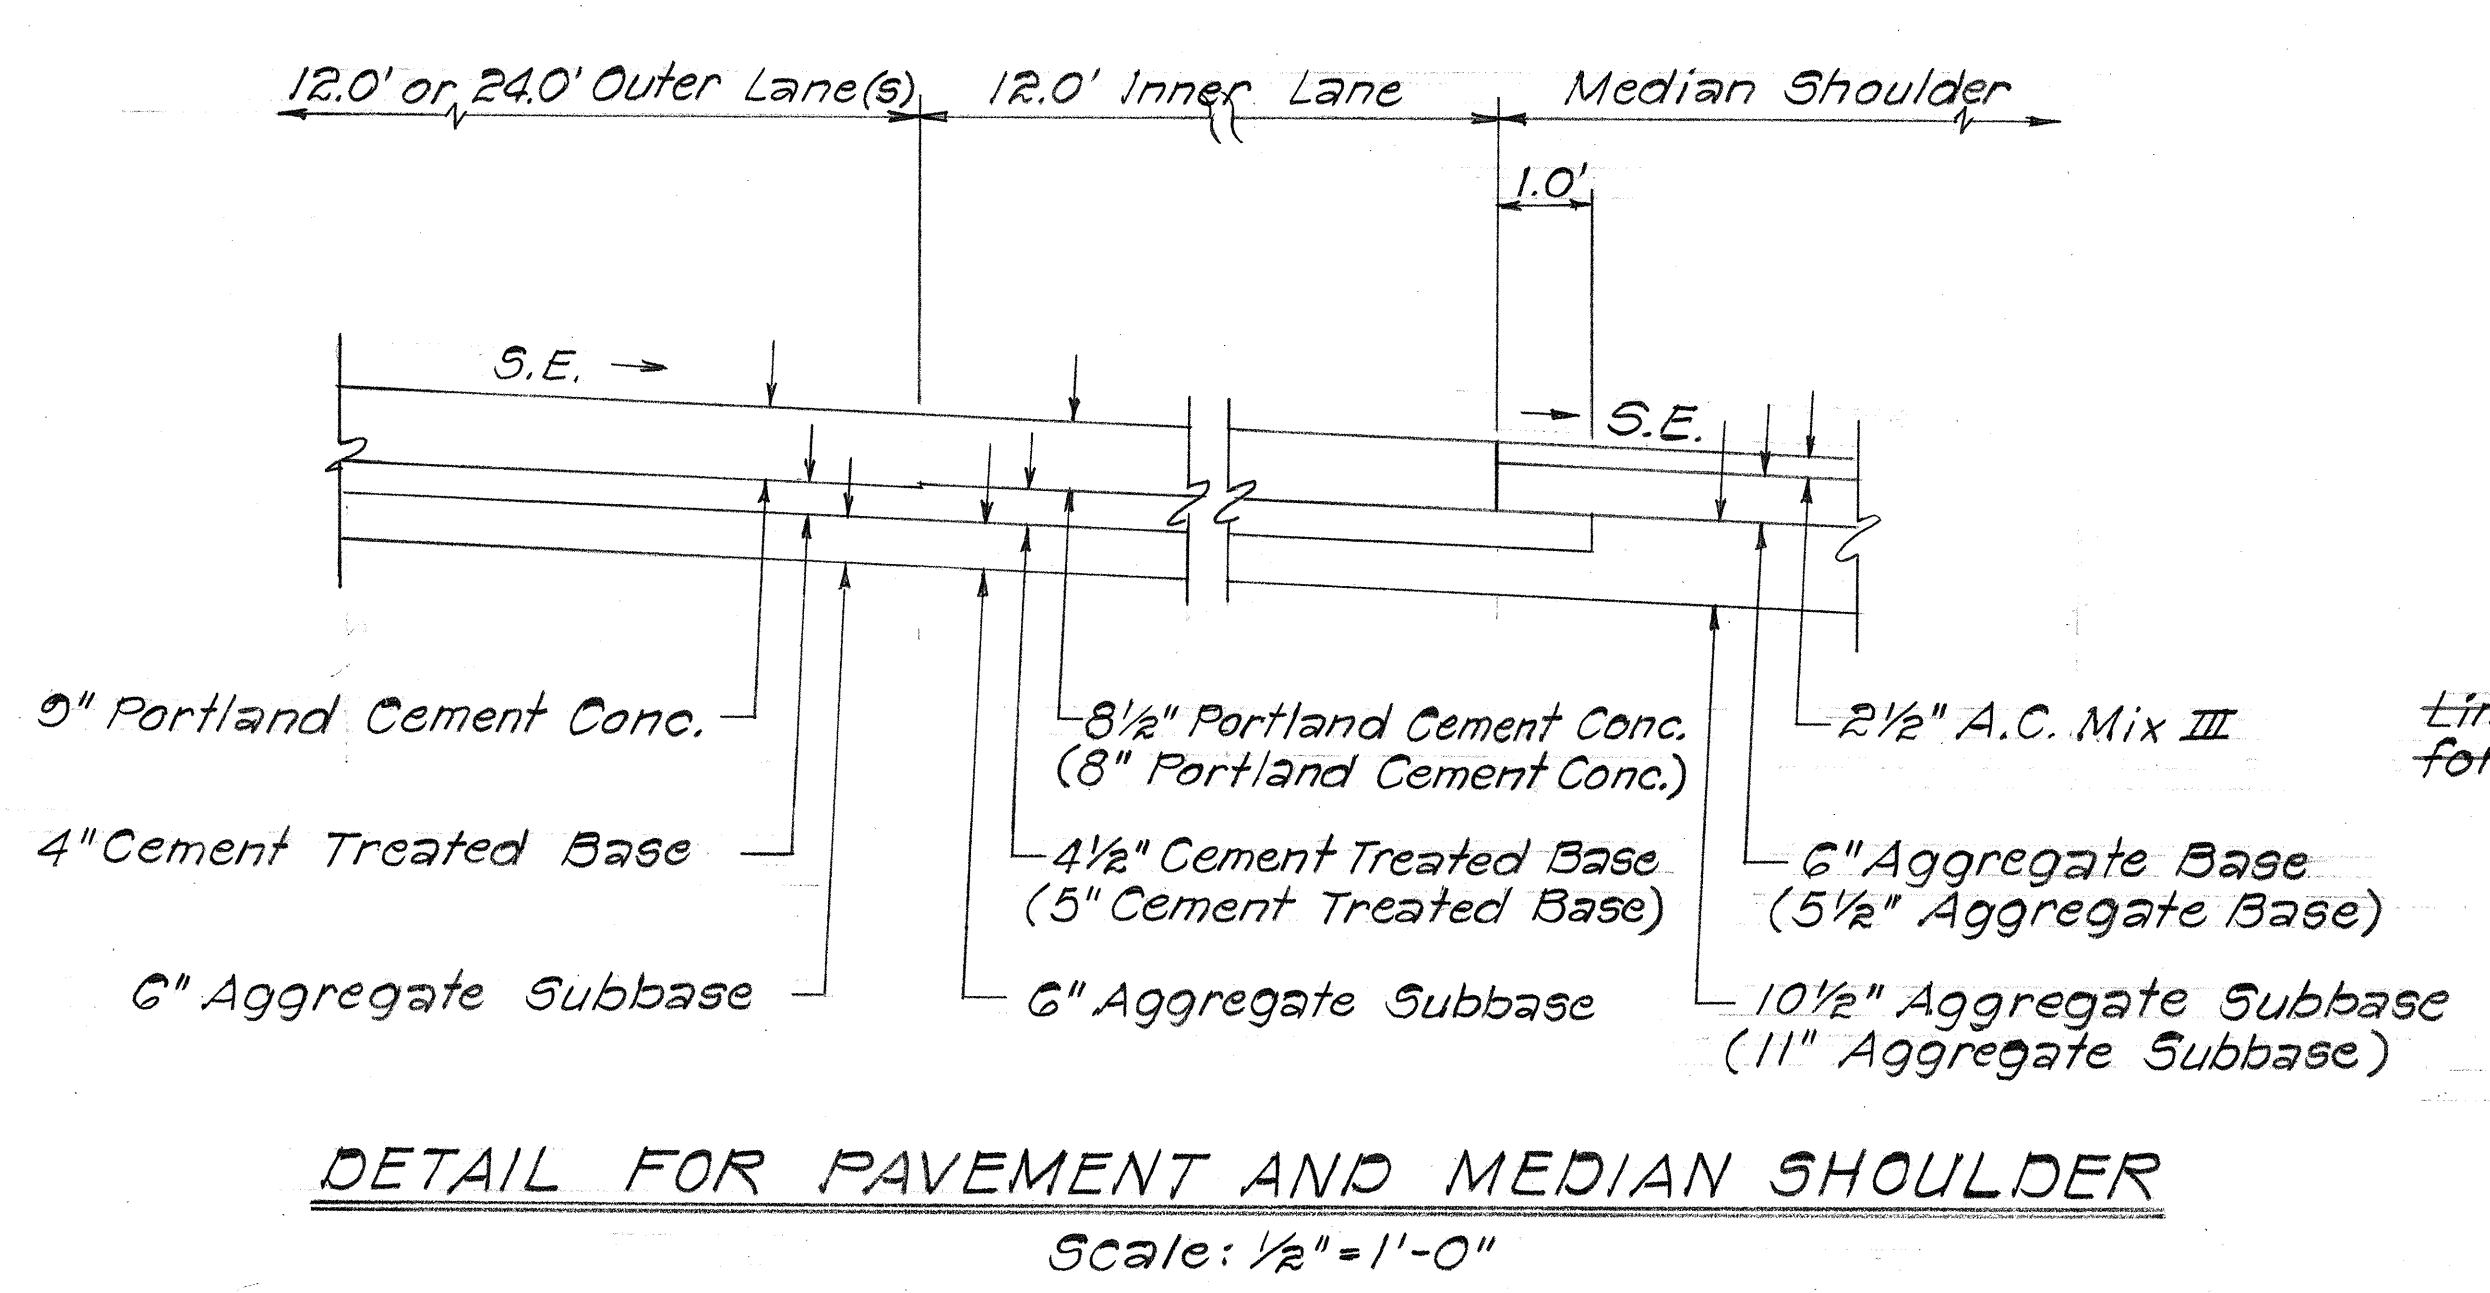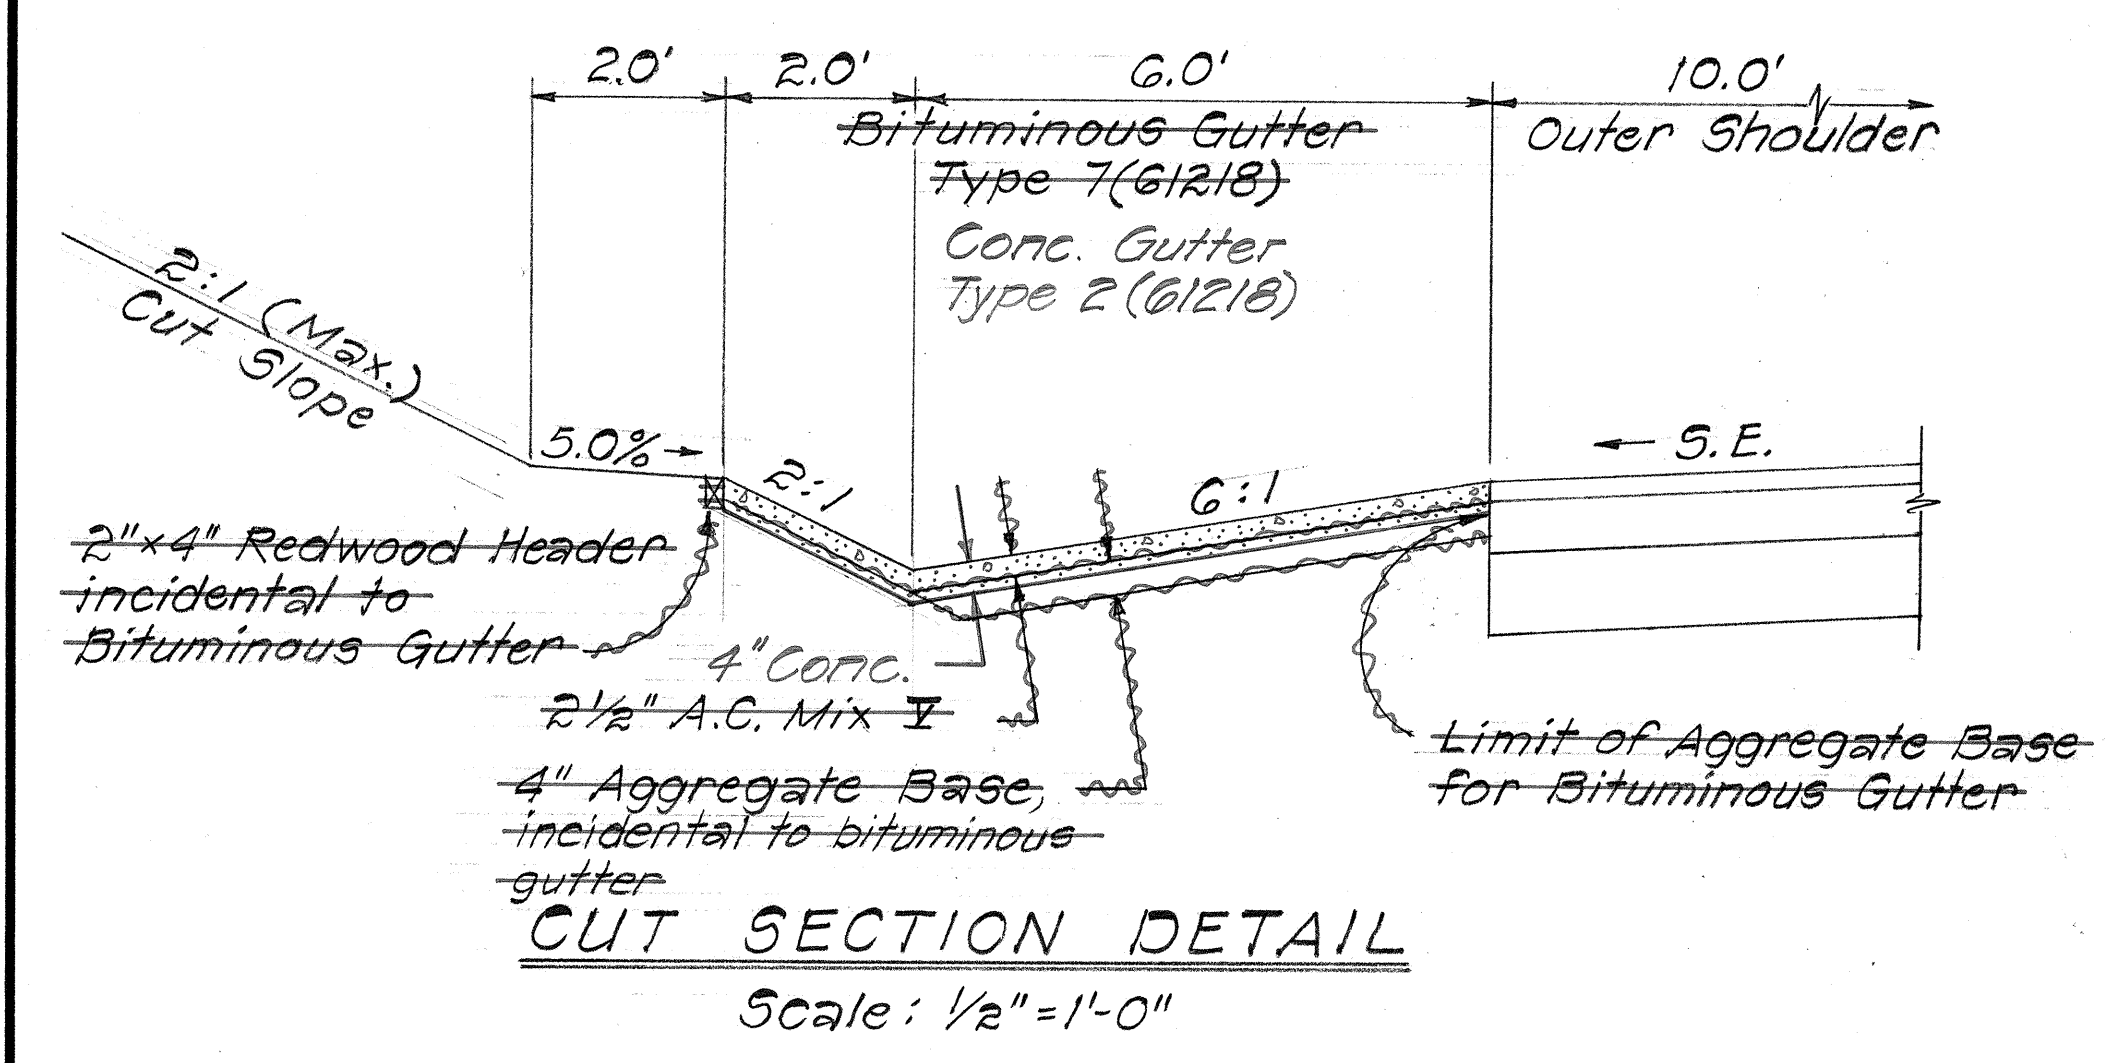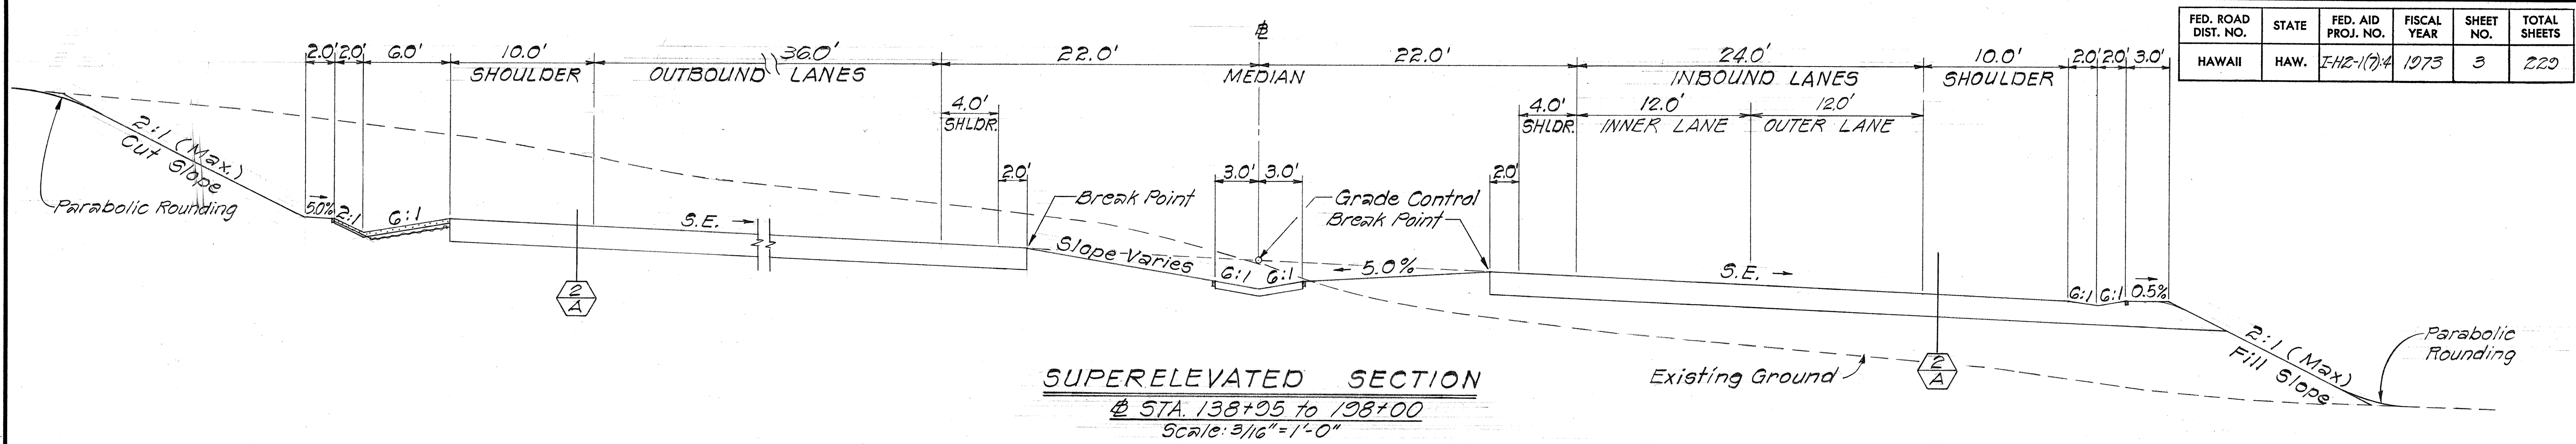


NOTE: For 3-Lane Section, thickness shown in parenthesis shall be used.

STATE OF HAWAII
 DEPARTMENT OF TRANSPORTATION
 HIGHWAYS DIVISION
TYPICAL SECTIONS
 INTERSTATE ROUTE H-2
 MILILANI INTERCHANGE
 F.A.I. Proj. No. I-H2-1(7)4
 Scale: As Shown Date: April, 1973
 SHEET No. 2 OF 3 SHEETS

SURVEY PLATTED BY	DATE
DRAWN BY	
DESIGNED BY	
NOTED BY	
CHECKED BY	
ORIGINAL PLAN	
NOTE BOOK	
No.	


FED. ROAD DIST. NO.	STATE	FED. AID PROJ. NO.	FISCAL YEAR	SHEET NO.	TOTAL SHEETS
HAWAII	HAW.	I-H2-1(7):4	1973	4	220

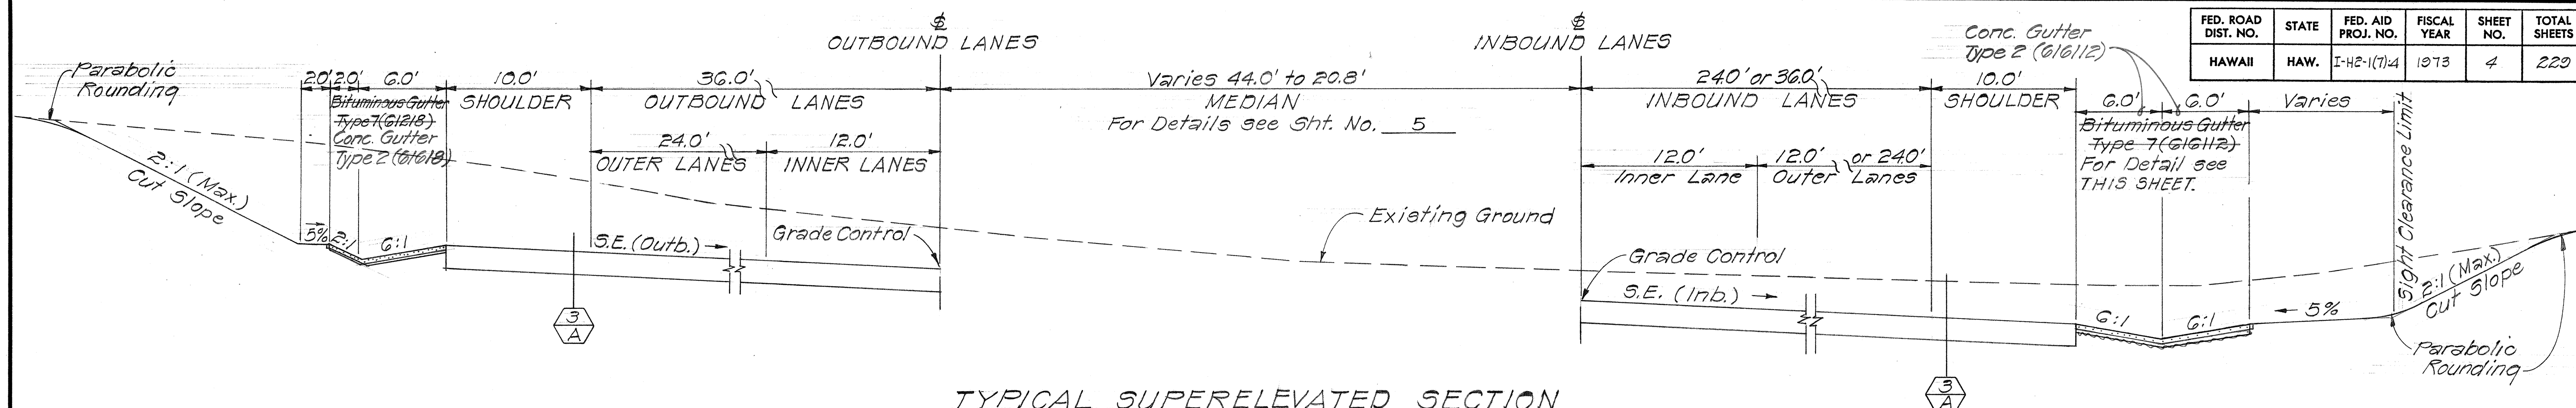

TYPICAL SUPERELEVATED SECTION



Sta. 198+00 to INB. # Sta. 223+00

Scale: 3/16" = 1'-0"

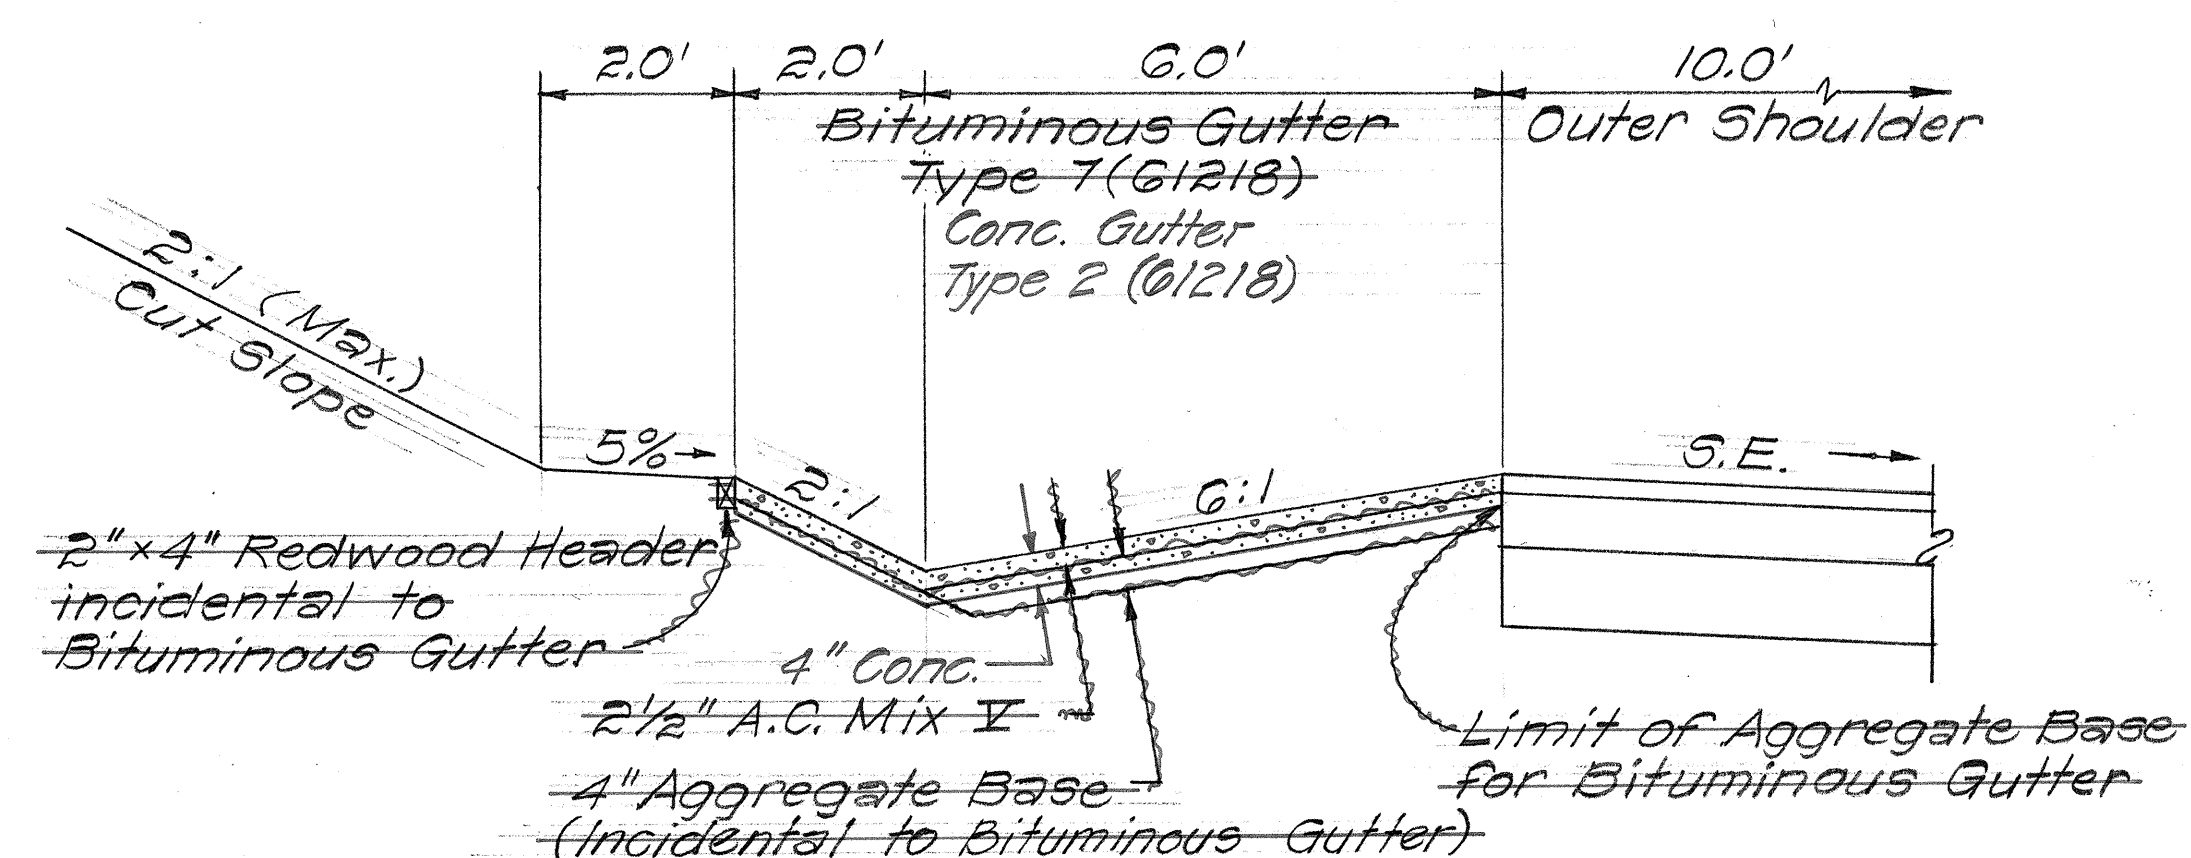


CUT SECTION DETAIL

Scale: 1/2" = 1'-0"

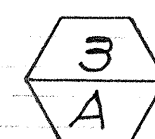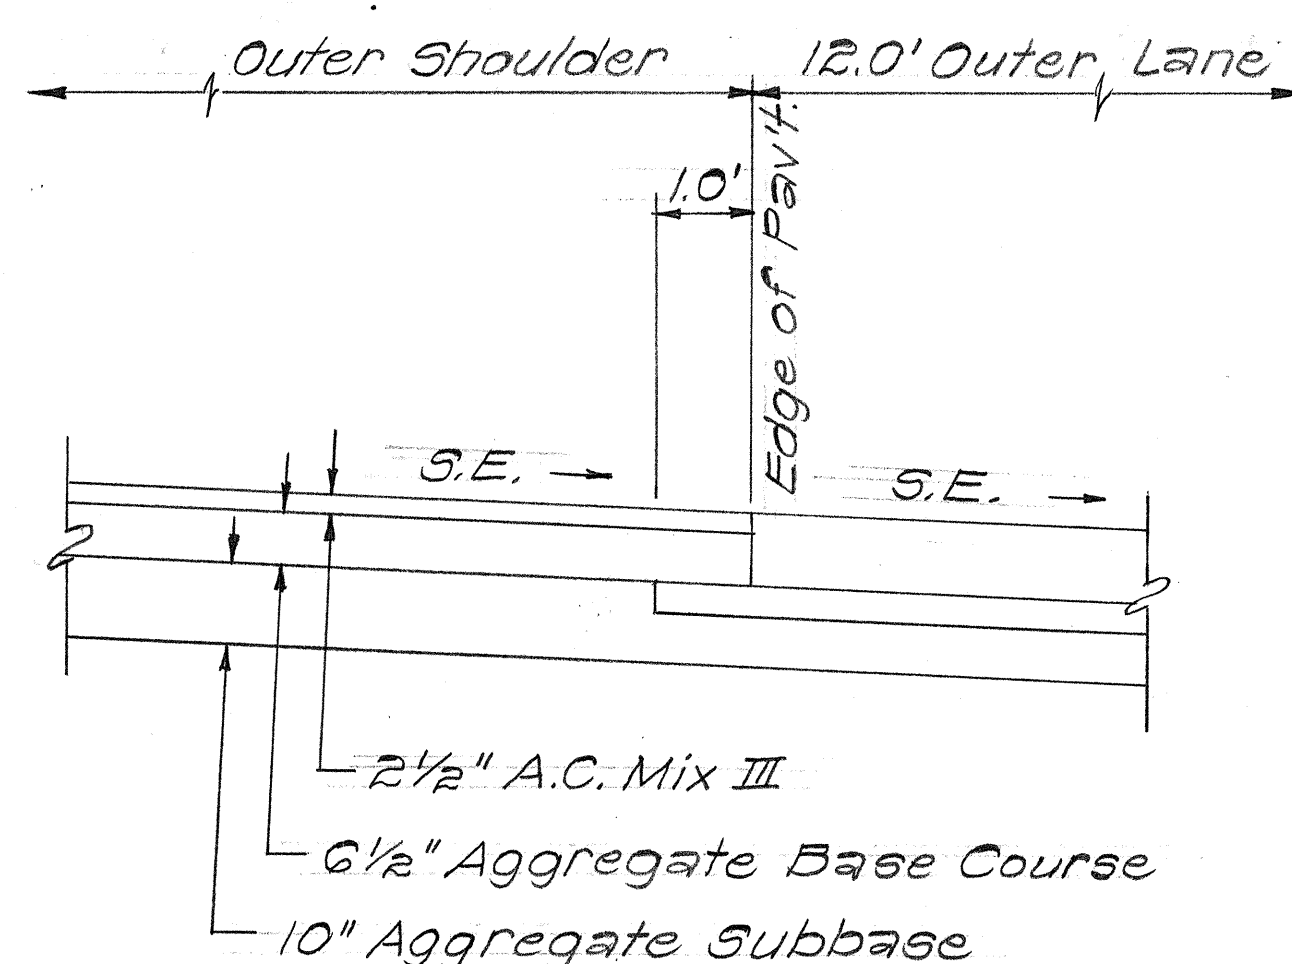


Scale: 1/2" = 1'-0"

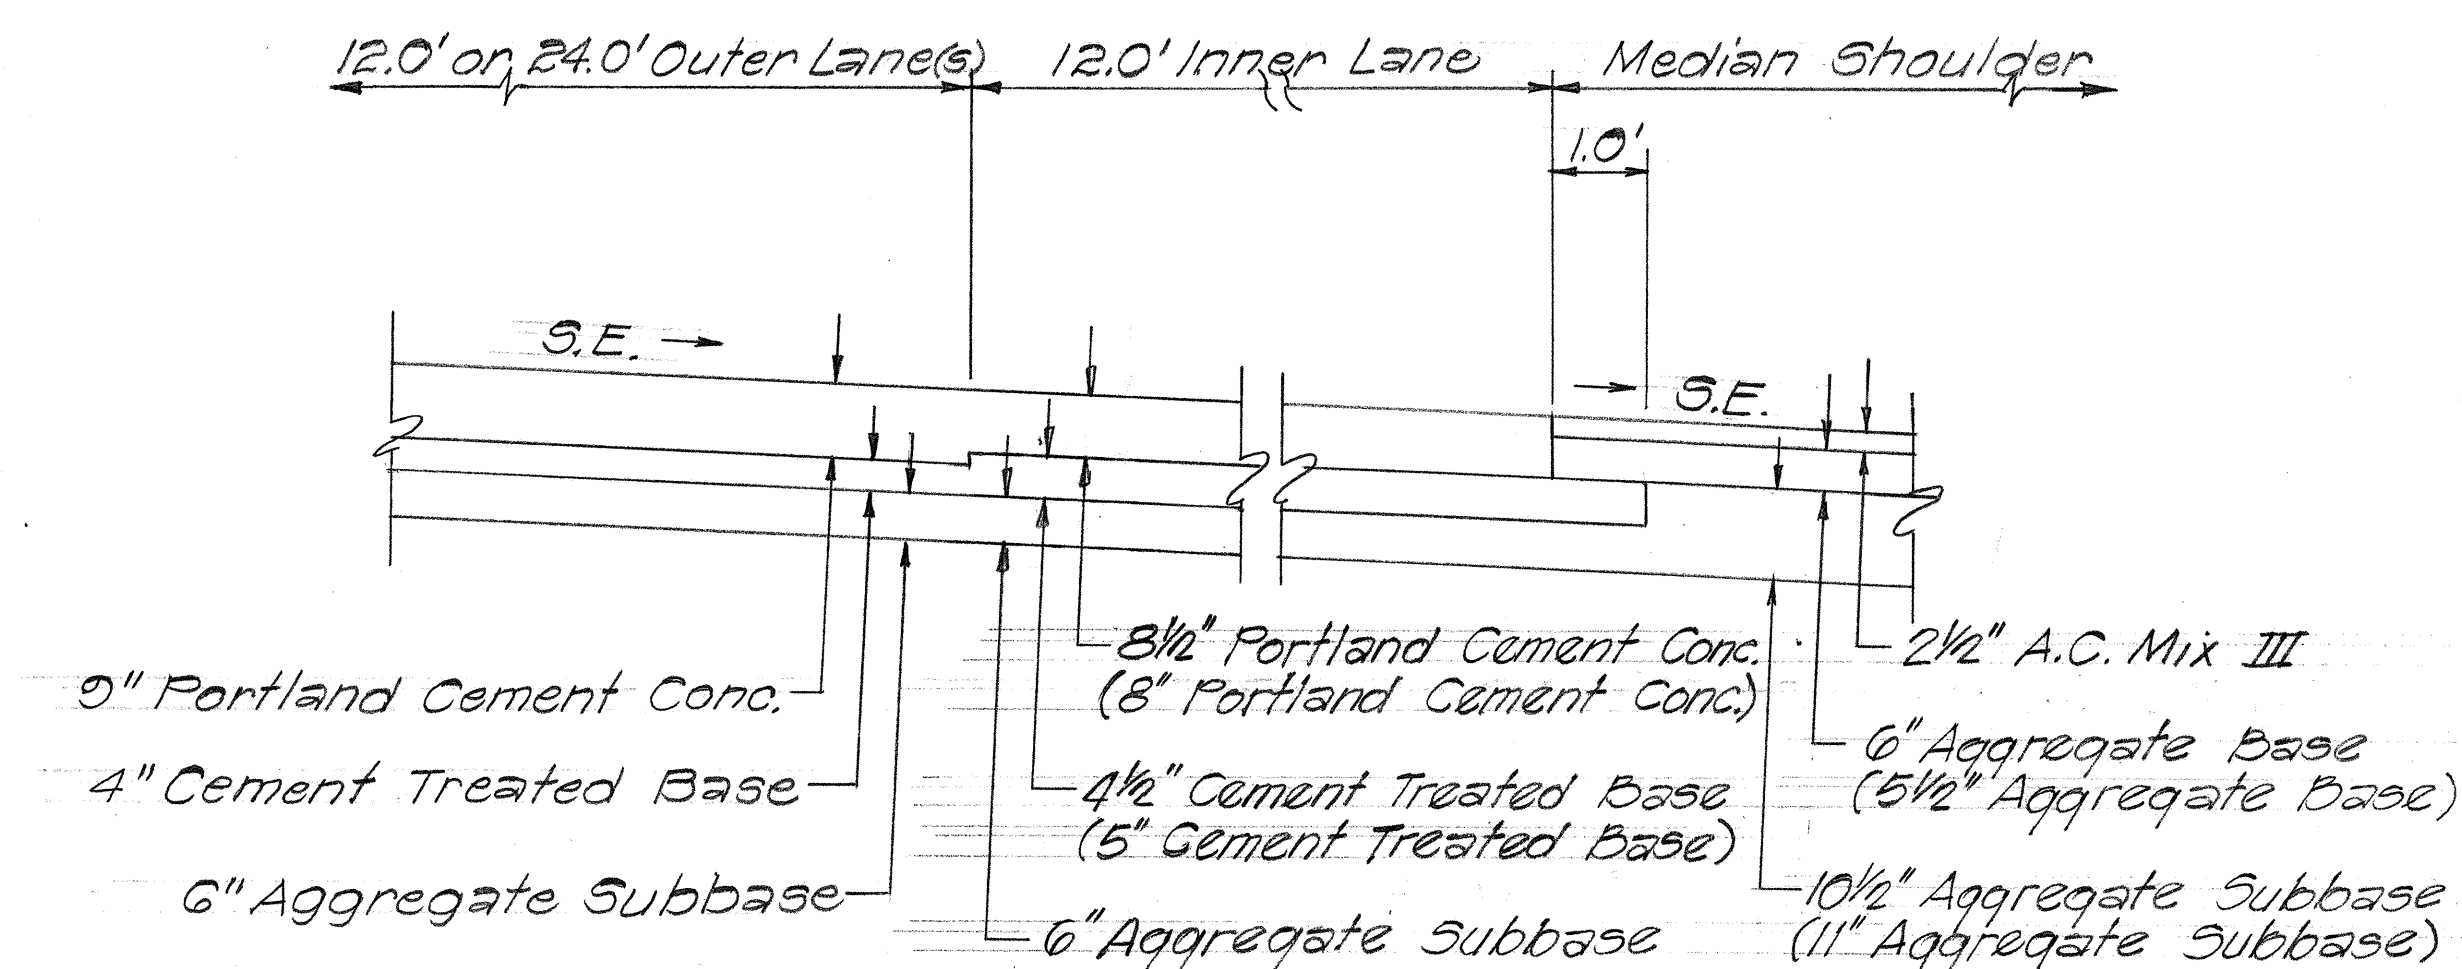

DETAIL FOR PAVEMENT AND MEDIAN SHOULDER

Scale: 1/2" = 1'-0"

NOTE: For 3-Lane Section, thickness shown in parenthesis shall be used.

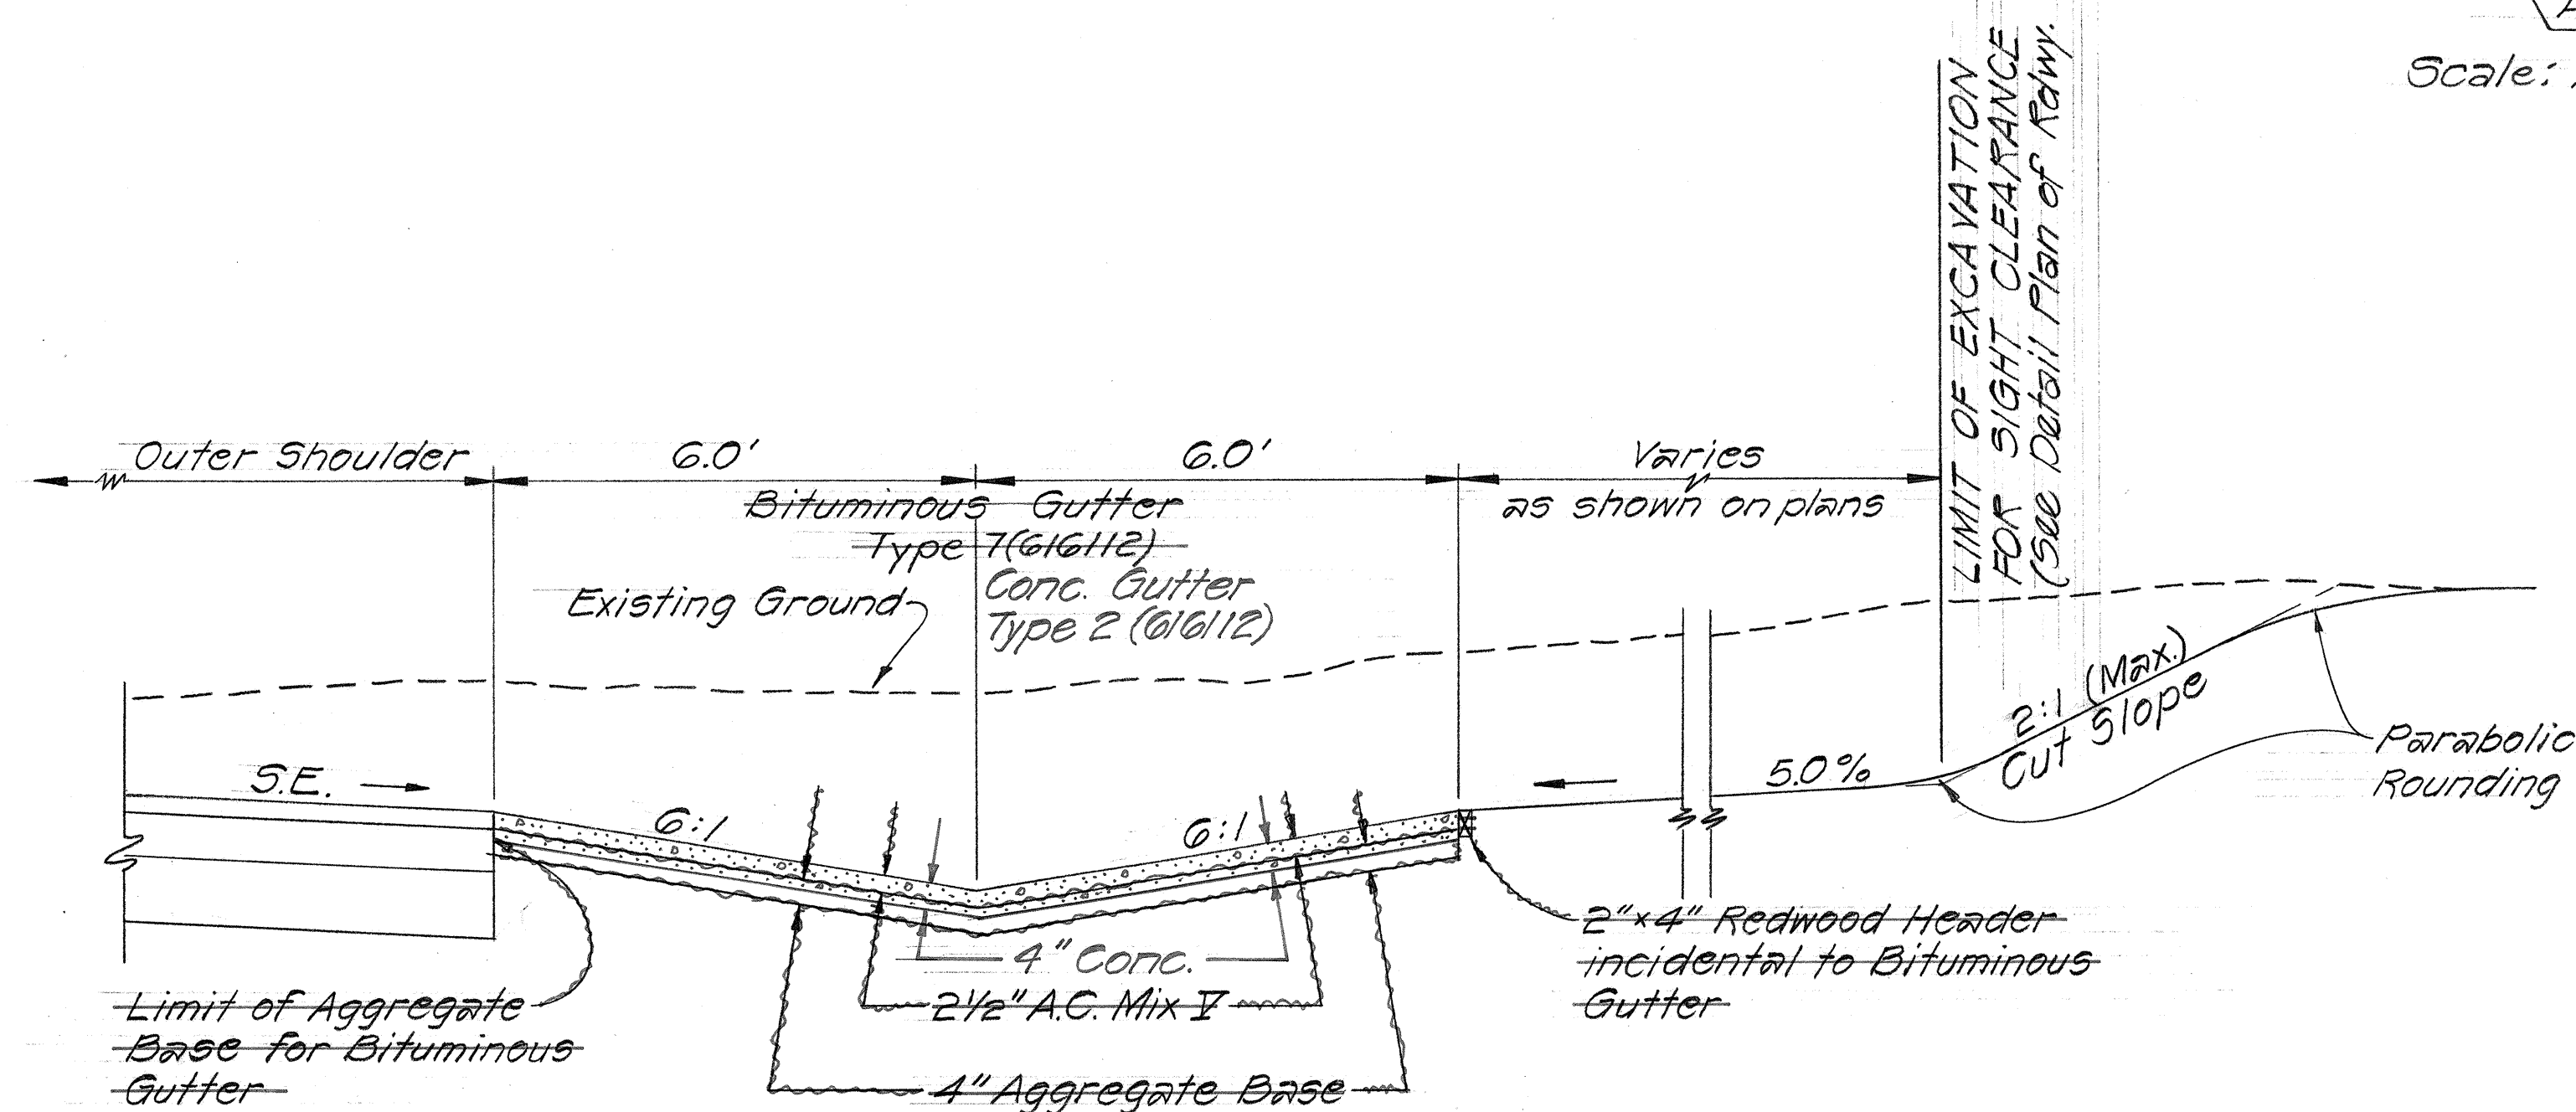

DETAIL FOR SPECIAL CUT SECTION

Scale: 1/2" = 1'-0"

SURVEY PLATTED BY	DATE
DRAWN BY	
DESIGNED BY	
QUANTITIES BY	
CHECKED BY	
ORIGINAL PLAN	
NOTE BOOK	
No.	

STATE OF HAWAII
 DEPARTMENT OF TRANSPORTATION
 HIGHWAYS DIVISION


TYPICAL SECTIONS

INTERSTATE ROUTE H-2
 MILILANI INTERCHANGE
 F.A.I. Proj. No. I-H2-1(7):4


Scale: As Shown Date: April, 1973

SHEET No. 3 OF 3 SHEETS


FED. ROAD DIST. NO.	STATE	FED. AID PROJ. NO.	FISCAL YEAR	SHEET NO.	TOTAL SHEETS
HAWAII	HAW.	I-H2-1(7)-4	1973	6	220

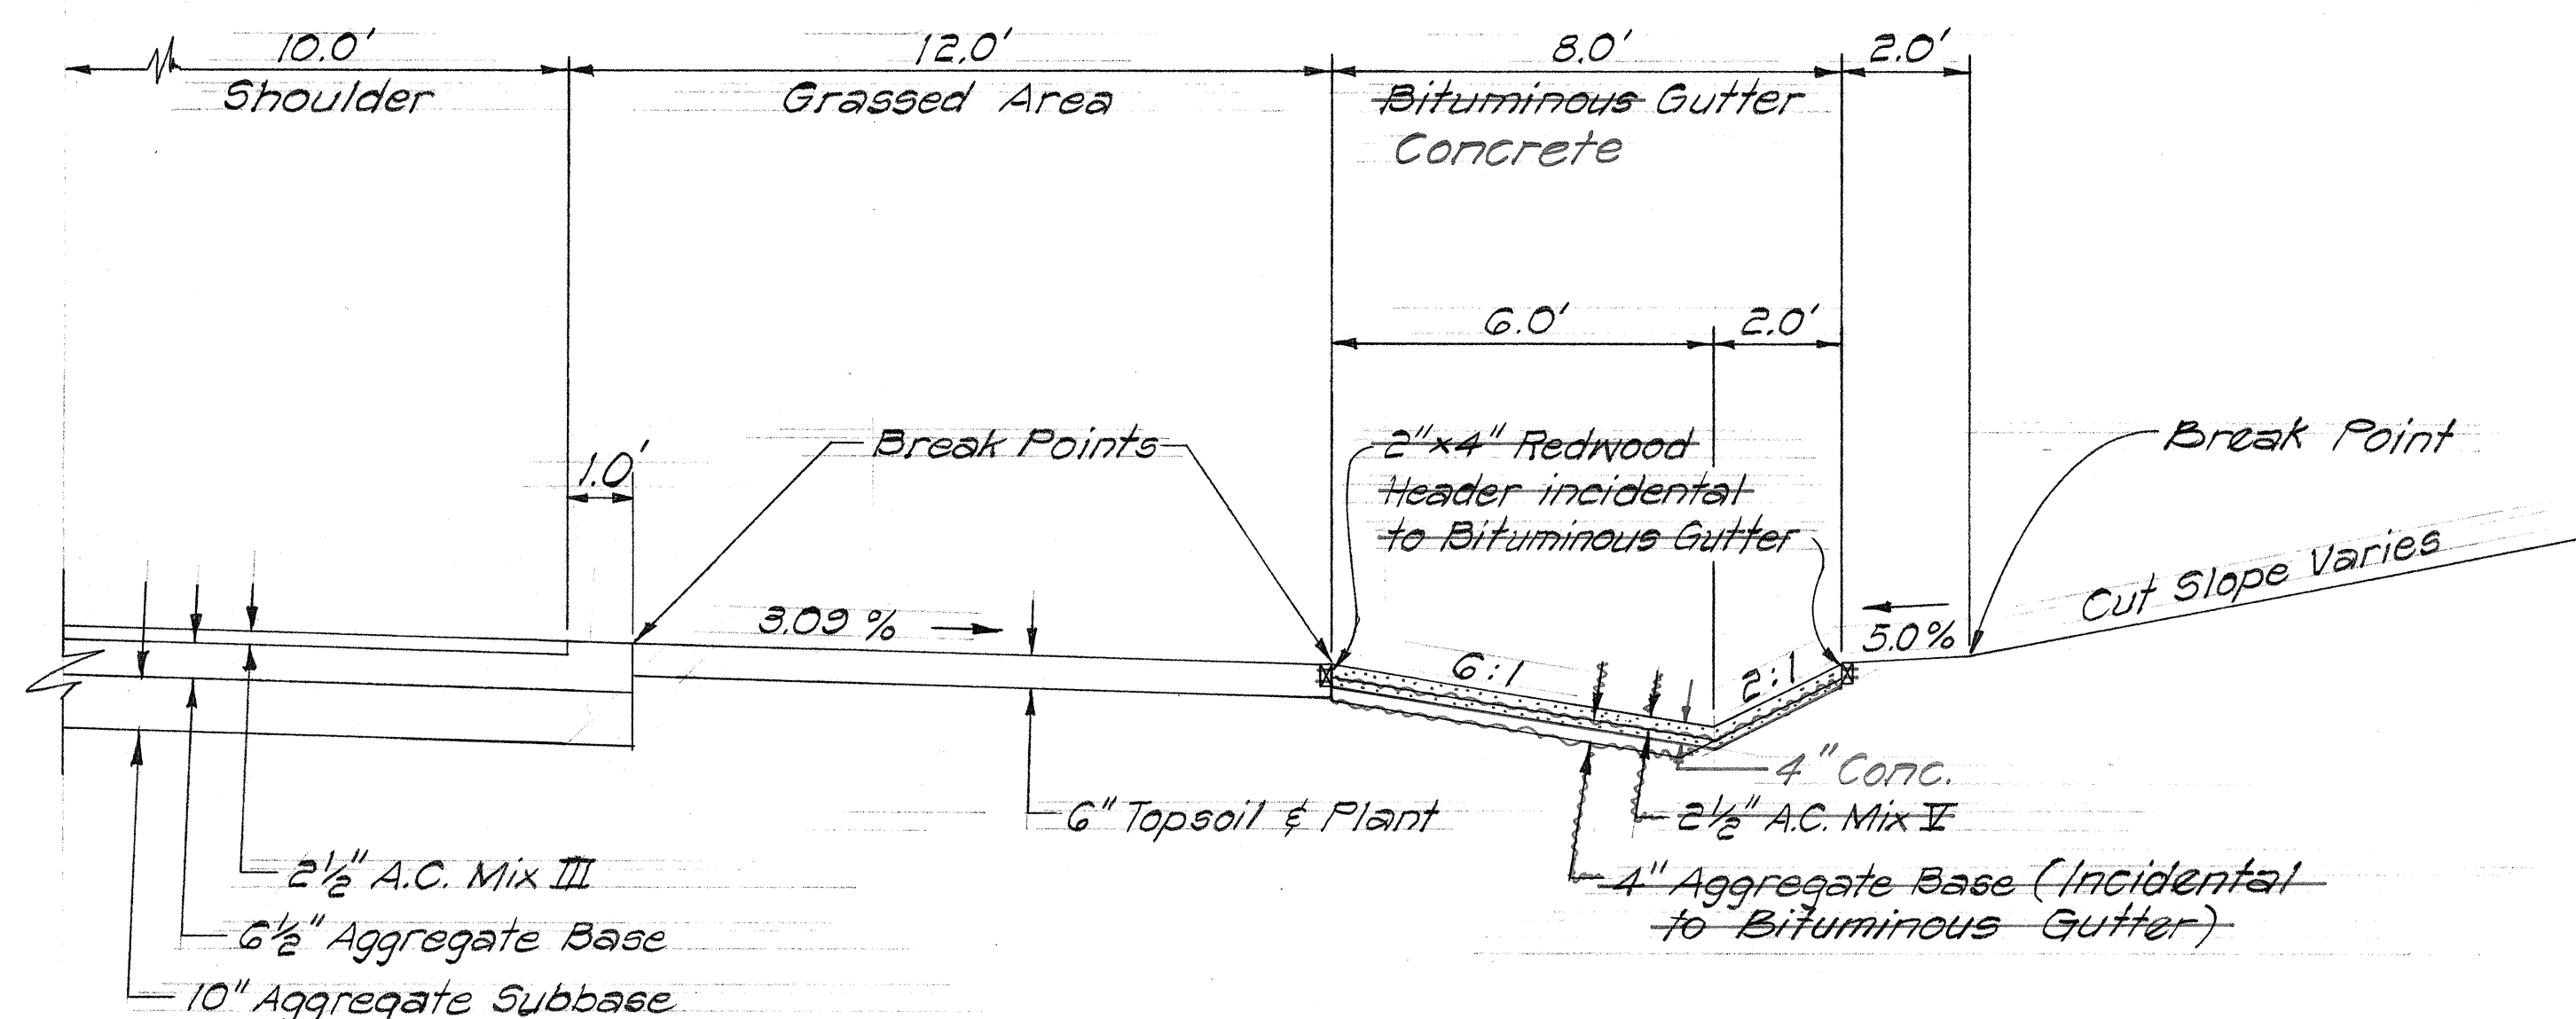


TYPICAL INBOUND GRASS STRIP TANGENT SECTION
BETWEEN STA. 175+00 TO 181+00
Scale: $\frac{3}{8}$ " = 1'-0"

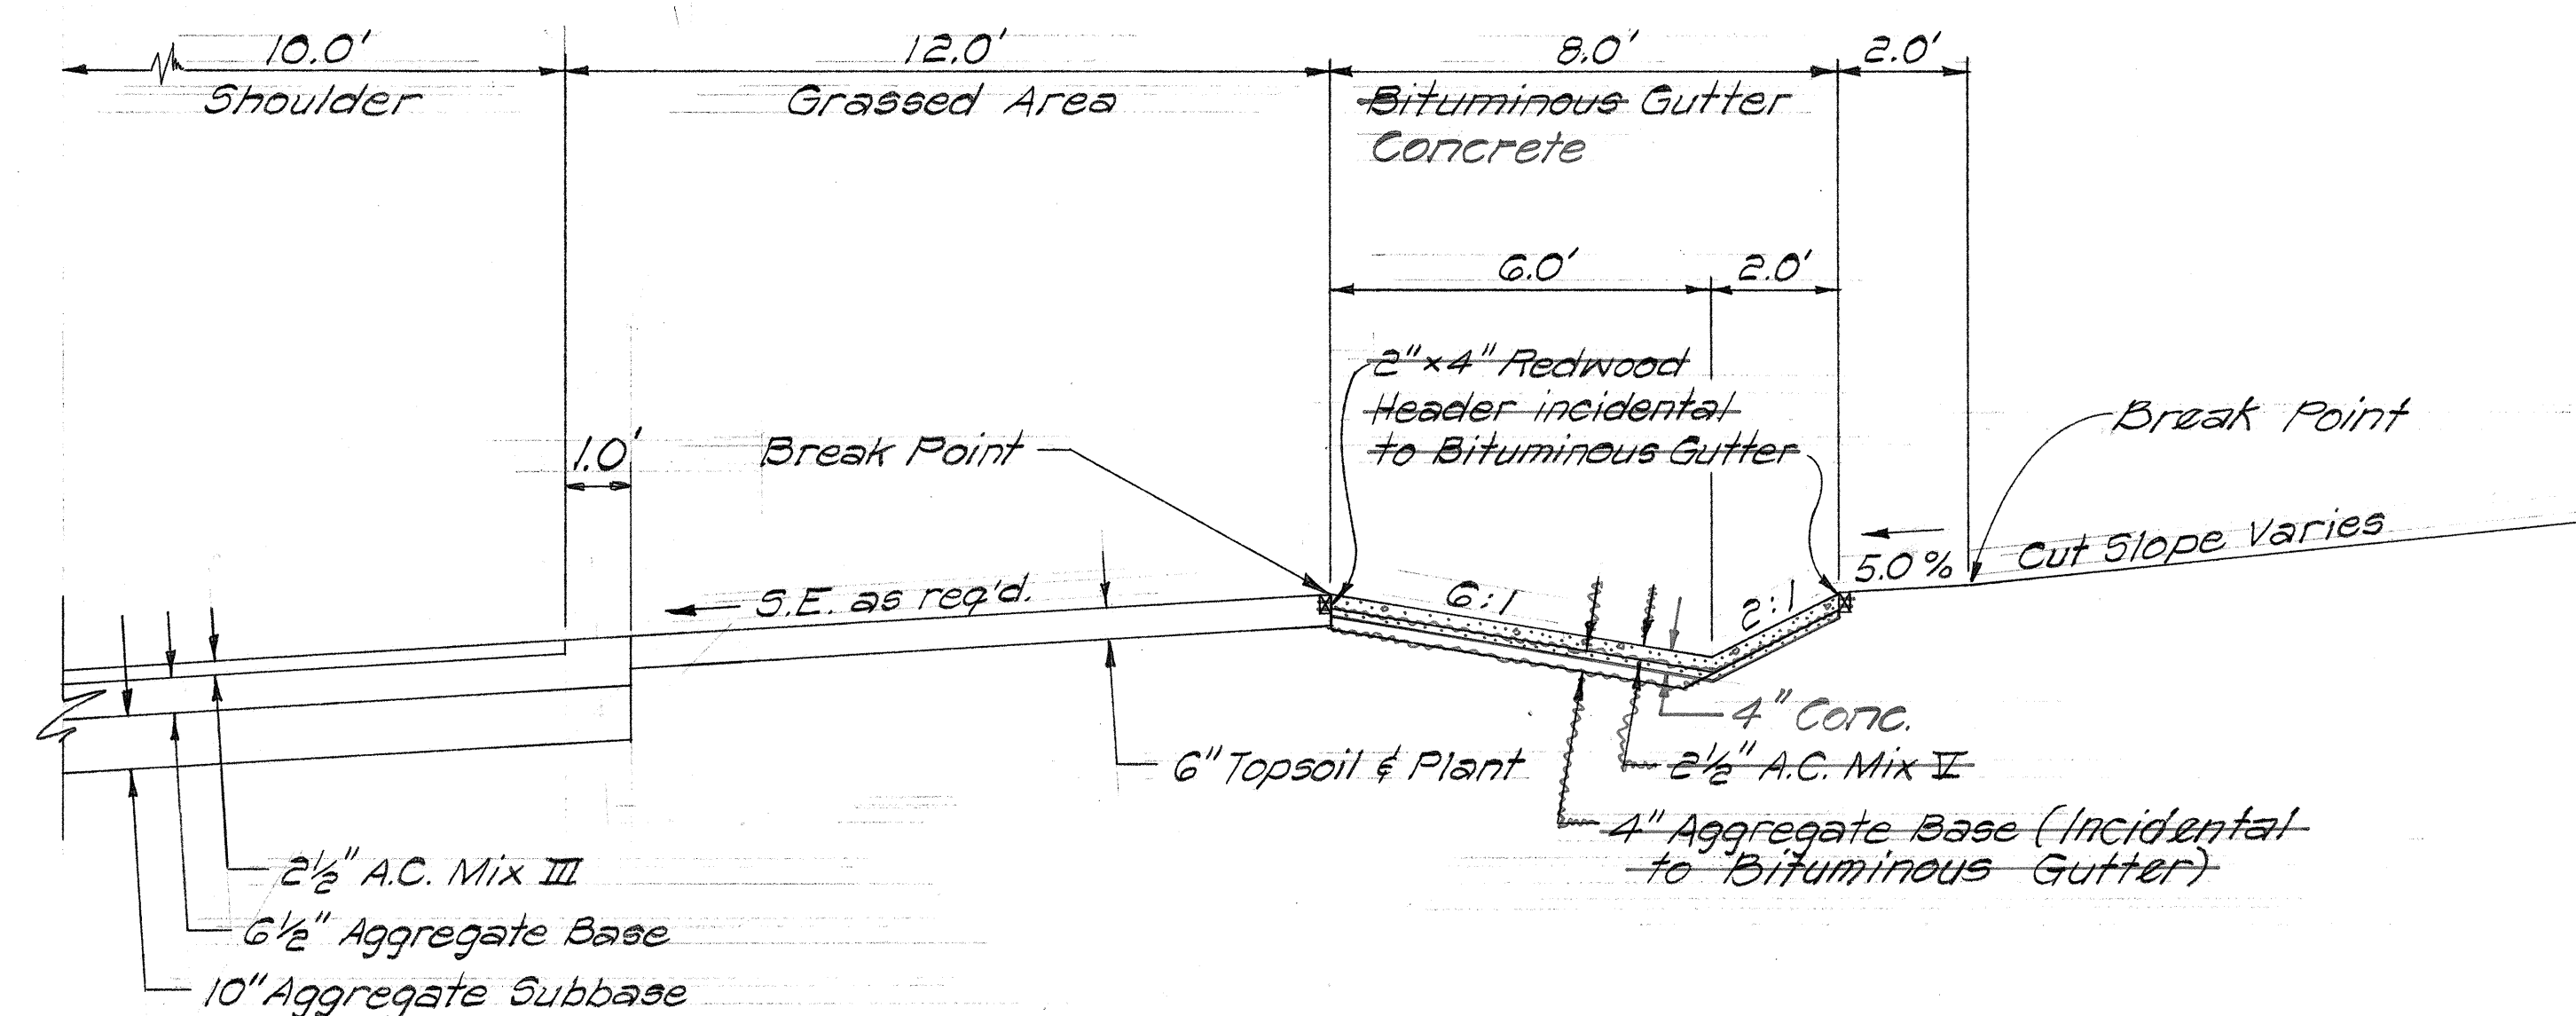

TYPICAL INBOUND GRASS STRIP SUPERELEVATED SECTION
BETWEEN STA. 181+00 TO 199+50
Scale: $\frac{3}{8}$ " = 1'-0"

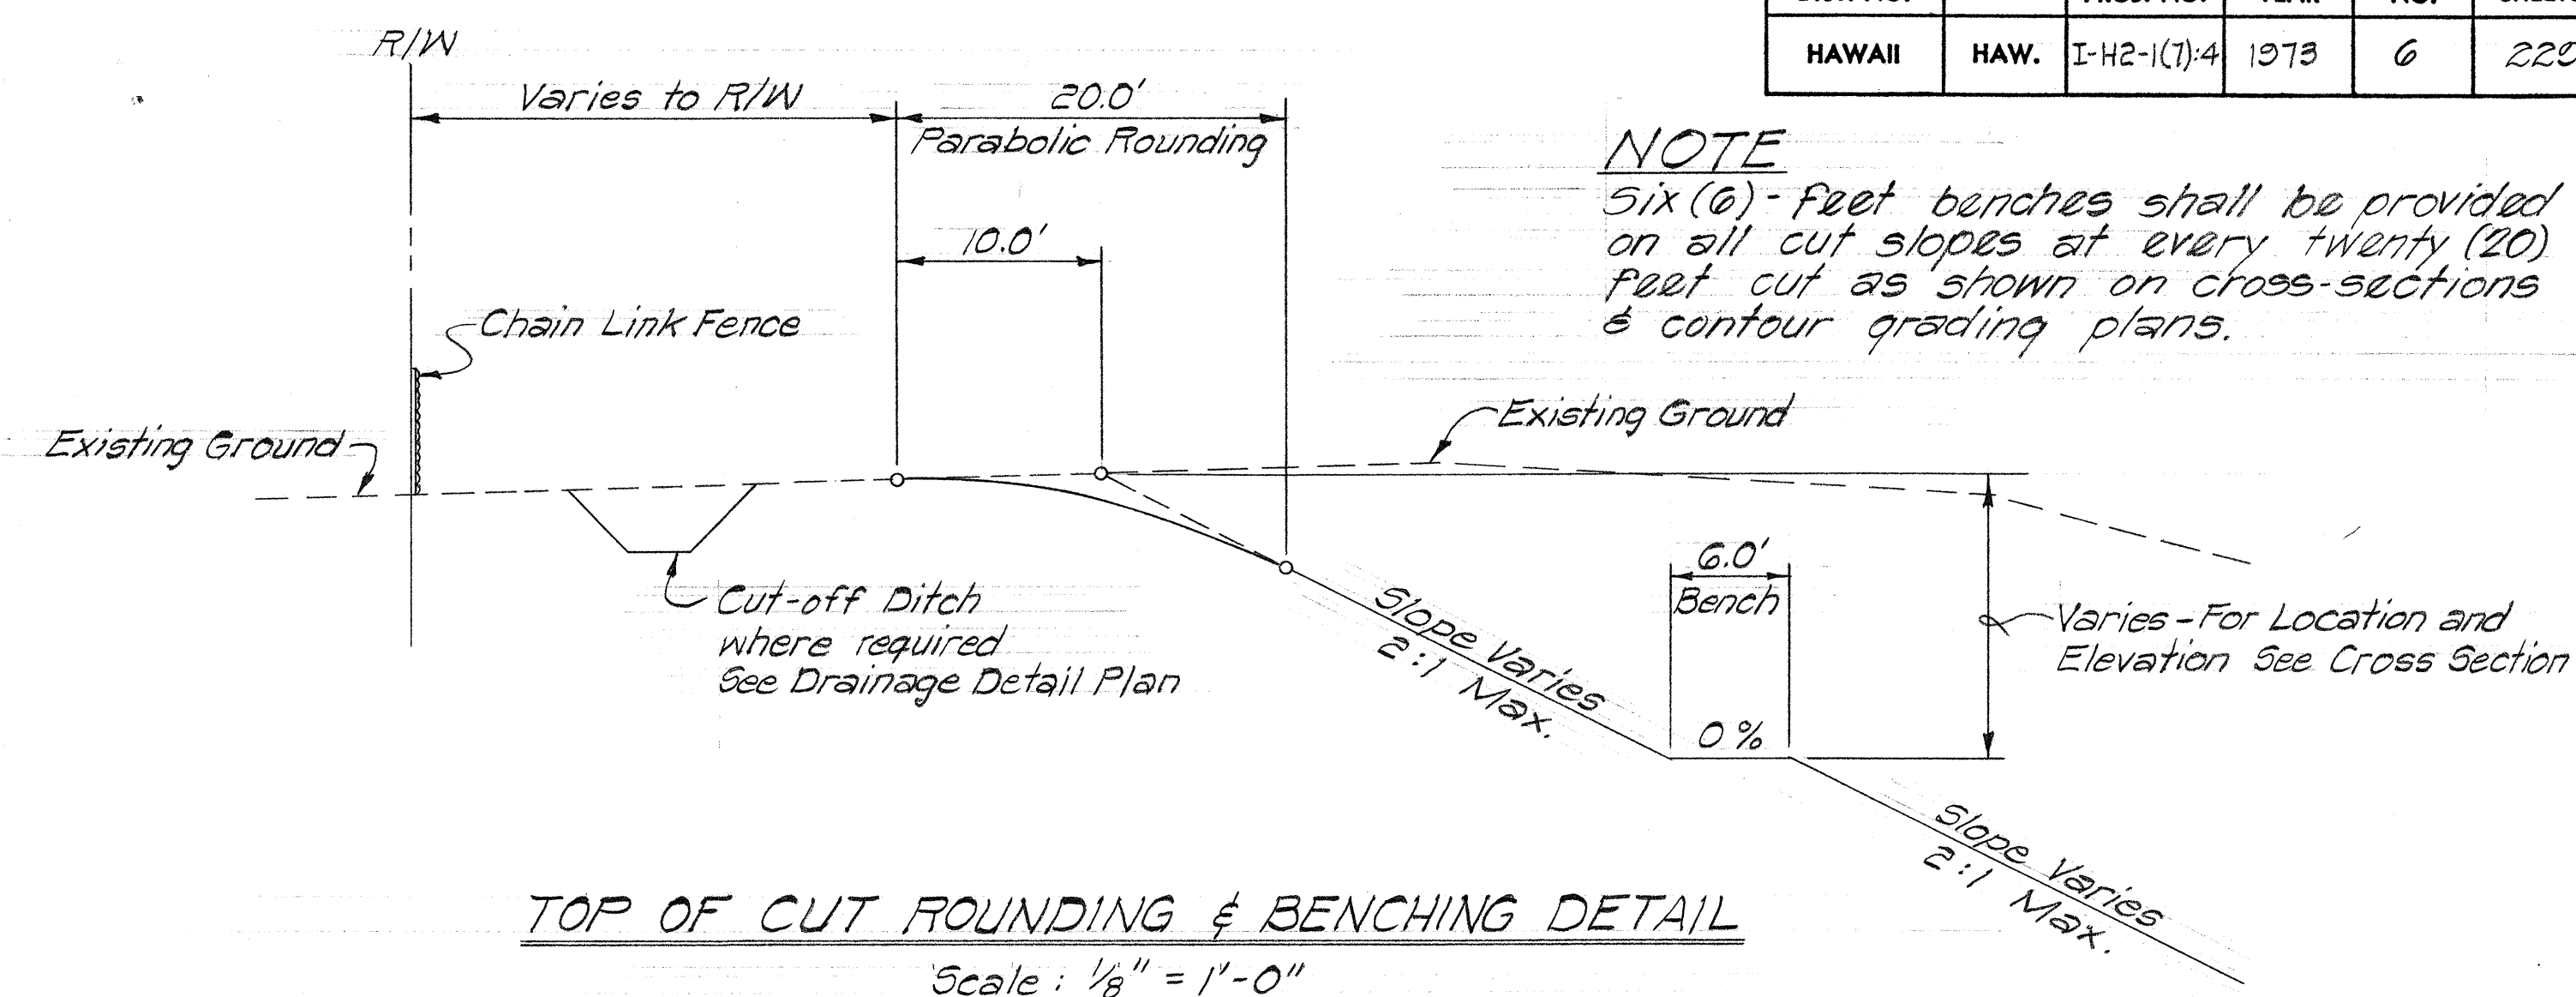

TOP OF CUT ROUNDING & BENCHING DETAIL
Scale: $\frac{1}{8}$ " = 1'-0"

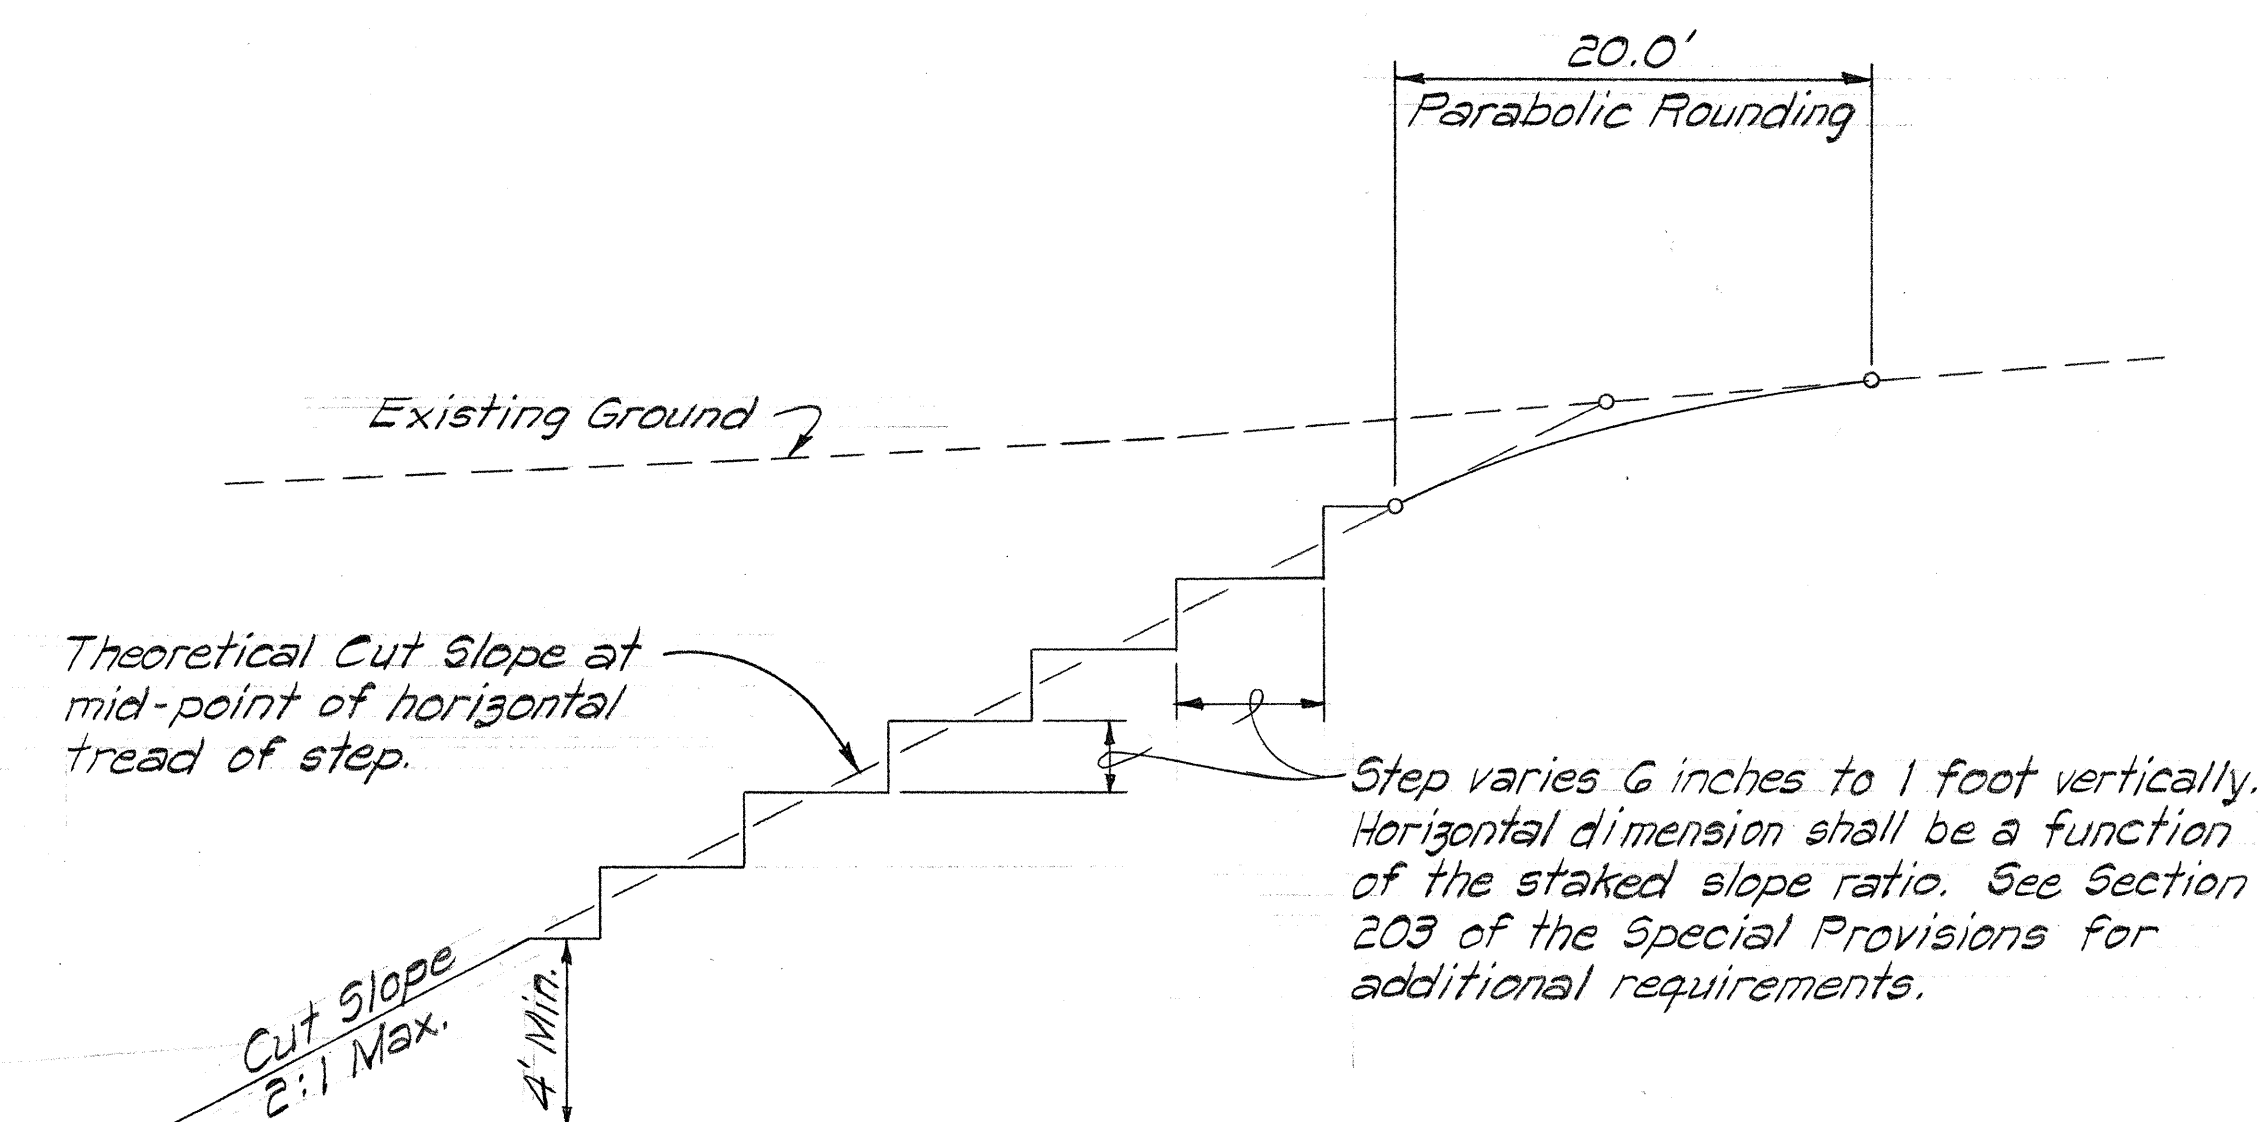


SERRATED CUT SLOPE DETAIL
Scale: $\frac{1}{8}$ " = 1'-0"

DESIGNED BY	DATE
DRAWN BY	
CHECKED BY	
NOTED BY	
NO.	


STATE OF HAWAII DEPARTMENT OF TRANSPORTATION HIGHWAYS DIVISION
TYPICAL SECTIONS
INTERSTATE ROUTE H-2 MILILANI INTERCHANGE F.A.I. Proj. No. I-H2-1(7)-4
Scale: As Shown Date: April, 1973
SHEET No. 5 OF 9 SHEETS

FED. ROAD DIST. NO.	STATE	FED. AID PROJ. NO.	FISCAL YEAR	SHEET NO.	TOTAL SHEETS
HAWAII	HAW.	I-H2-1(7)-4	1973	7	220

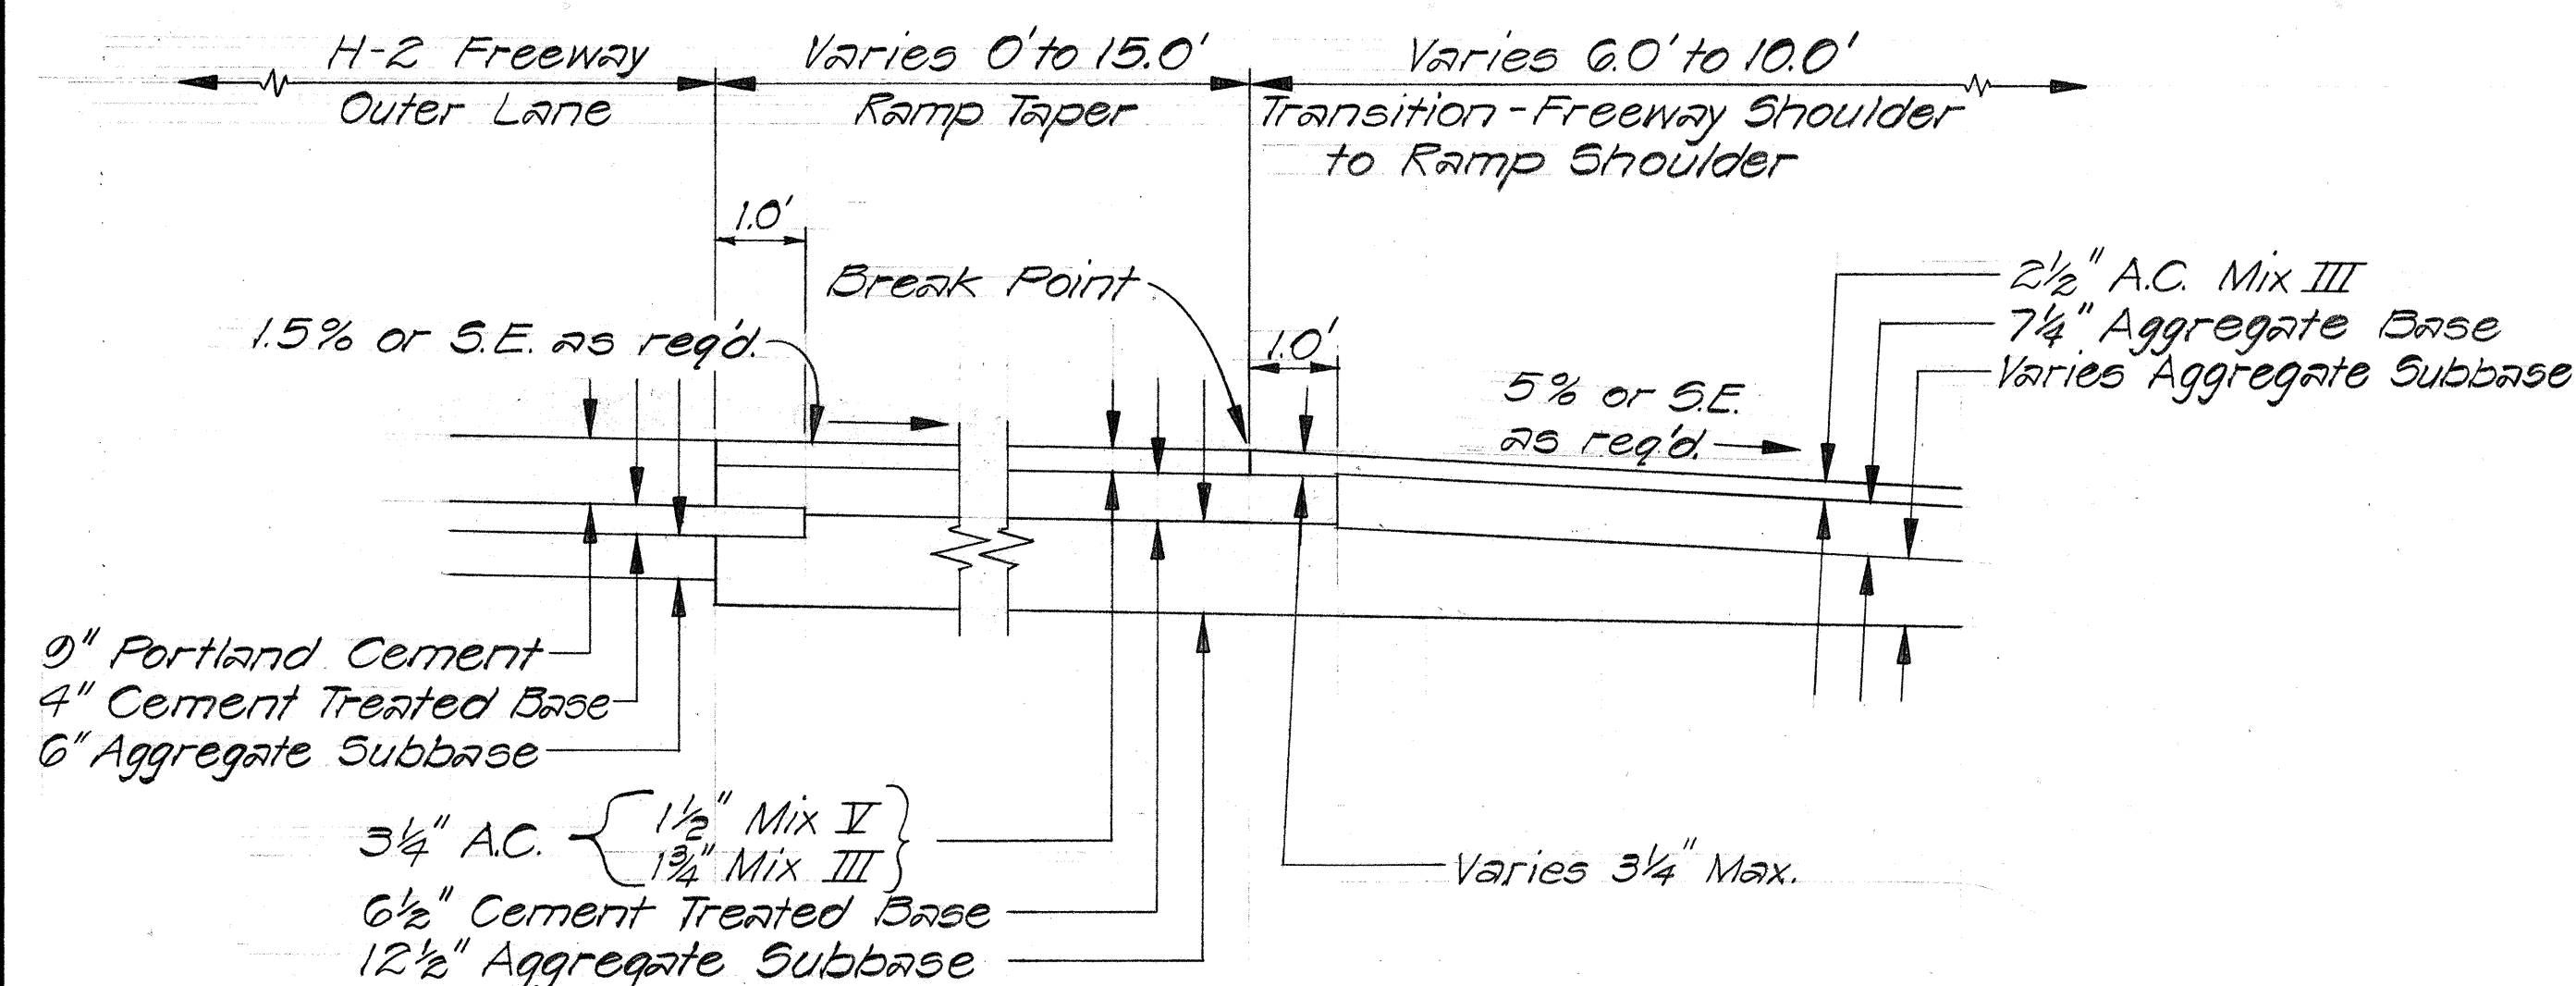


TYPICAL SECTION ~ RAMP TAPER

Scale: 1/2" = 1'-0"

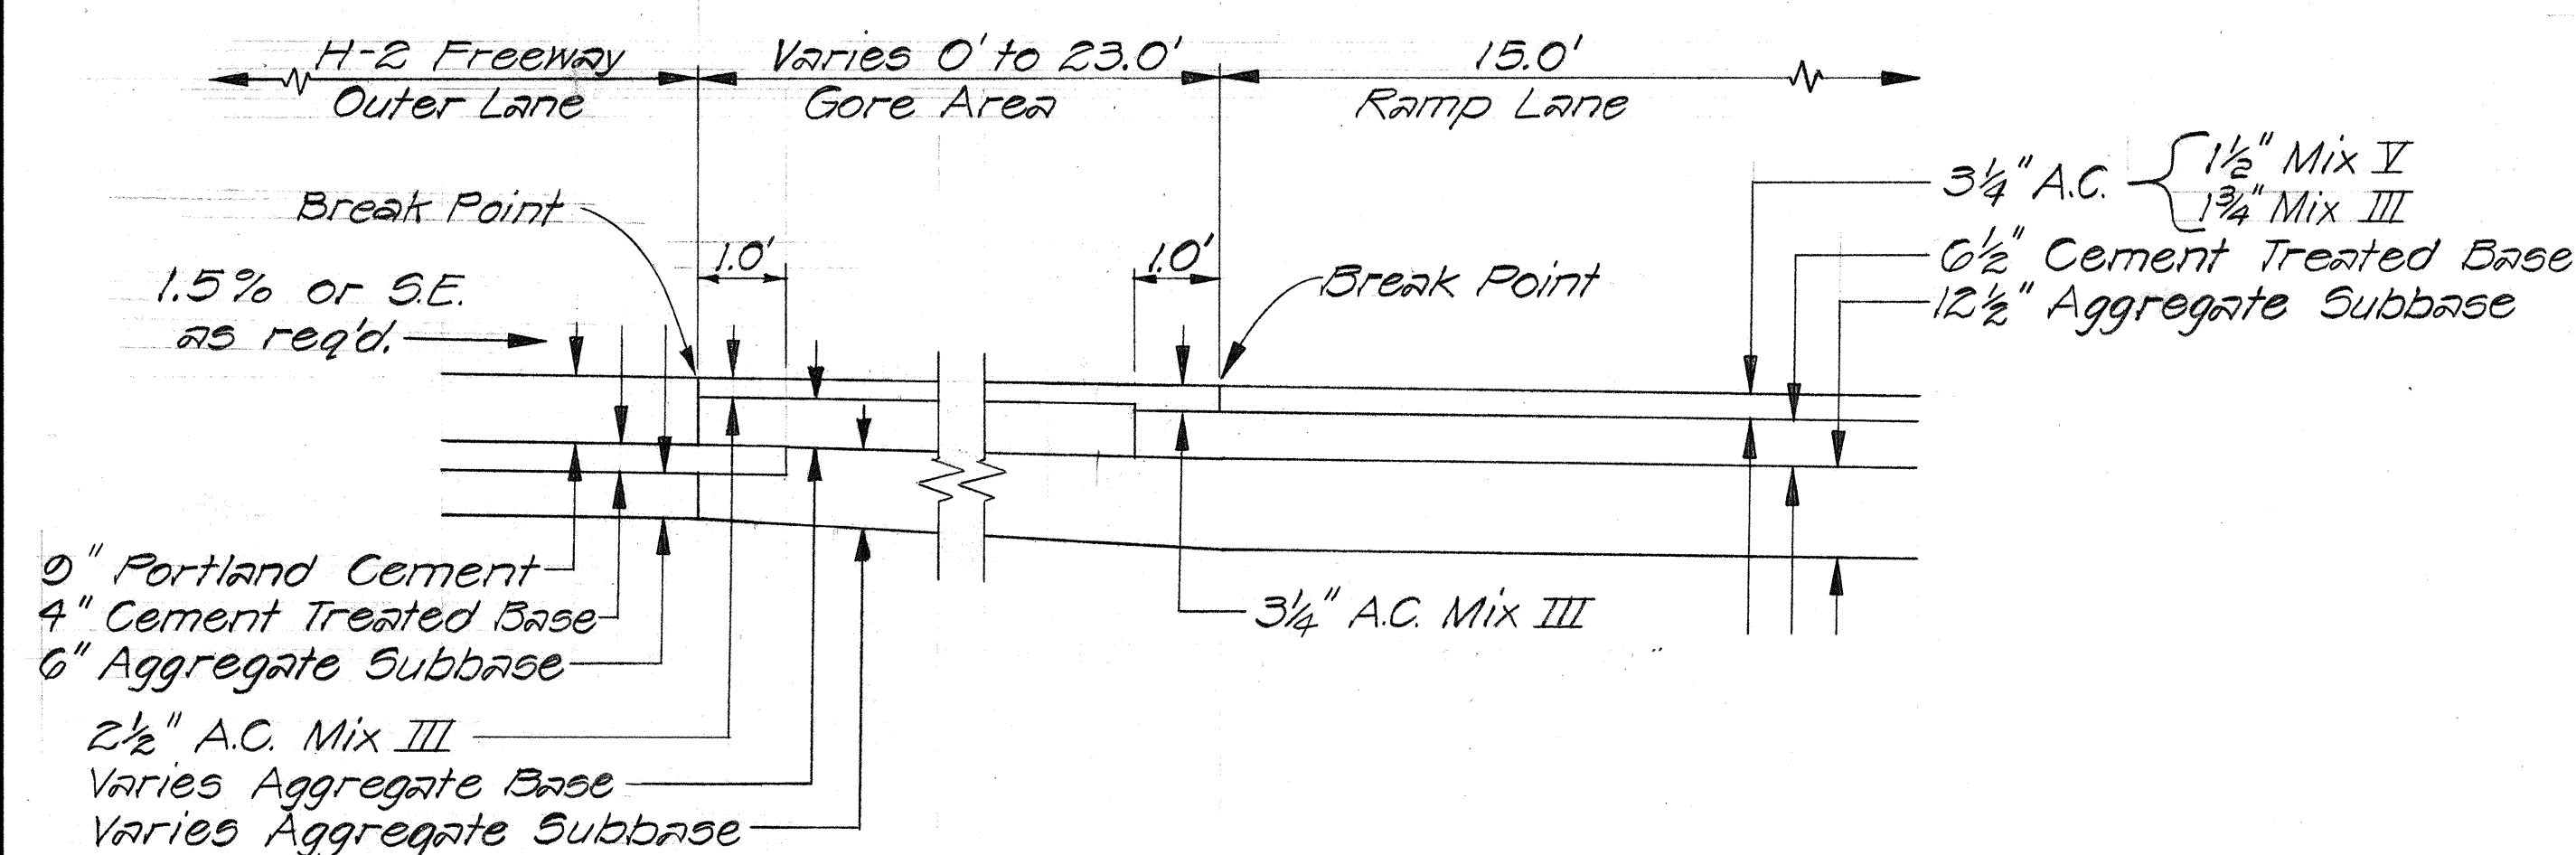


TYPICAL TRANSITION GORE AREA BETWEEN OUTER FREEWAY LANE AND RAMP LANE

Scale: 1/2" = 1'-0"

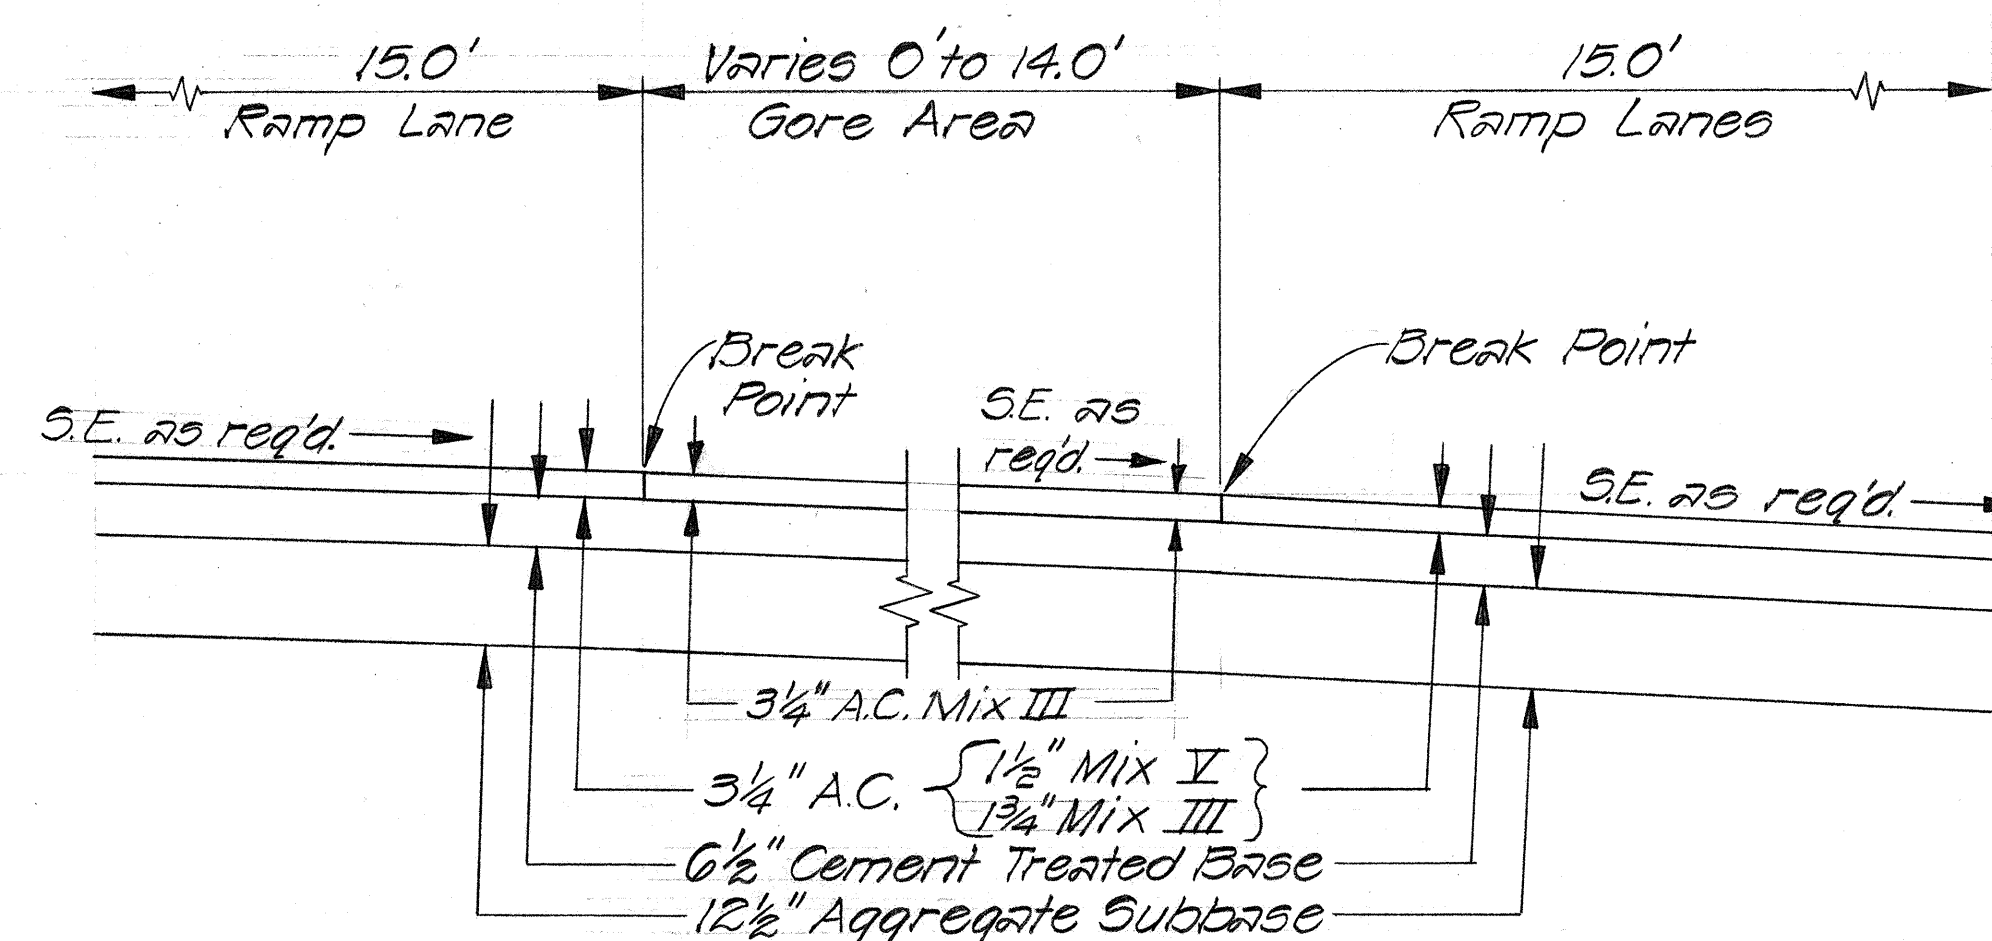


TYPICAL TRANSITION GORE AREA BETWEEN RAMP LANE

Scale: 1/2" = 1'-0"

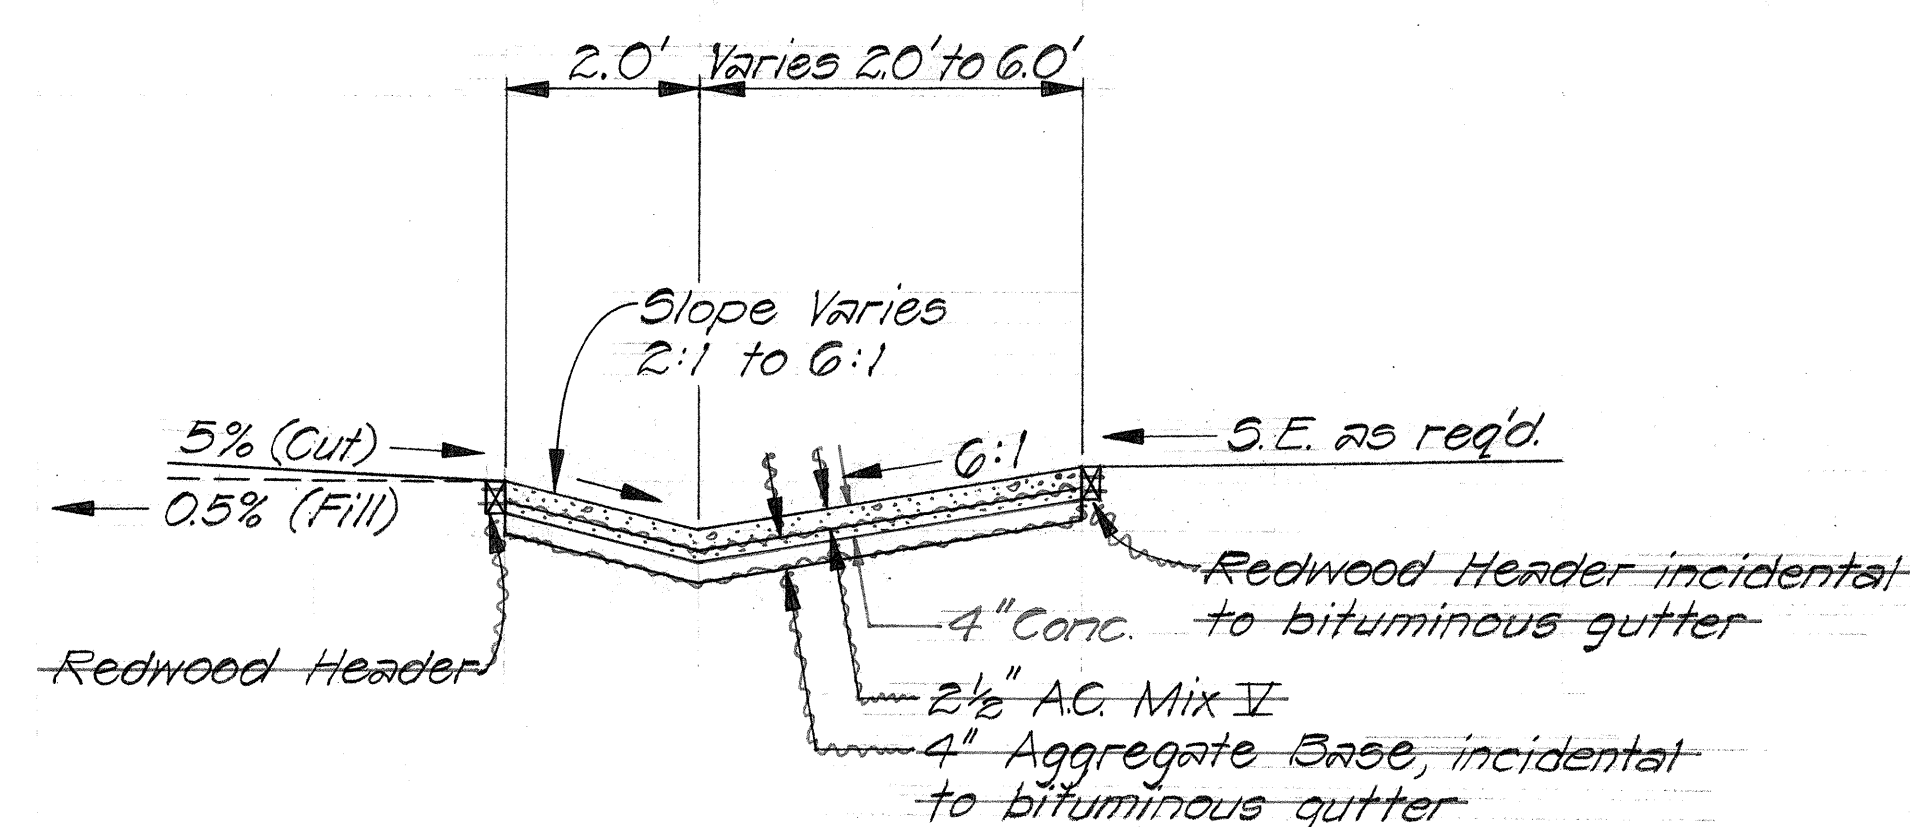


TYPICAL GUTTER TRANSITION

Scale: 1/2" = 1'-0"

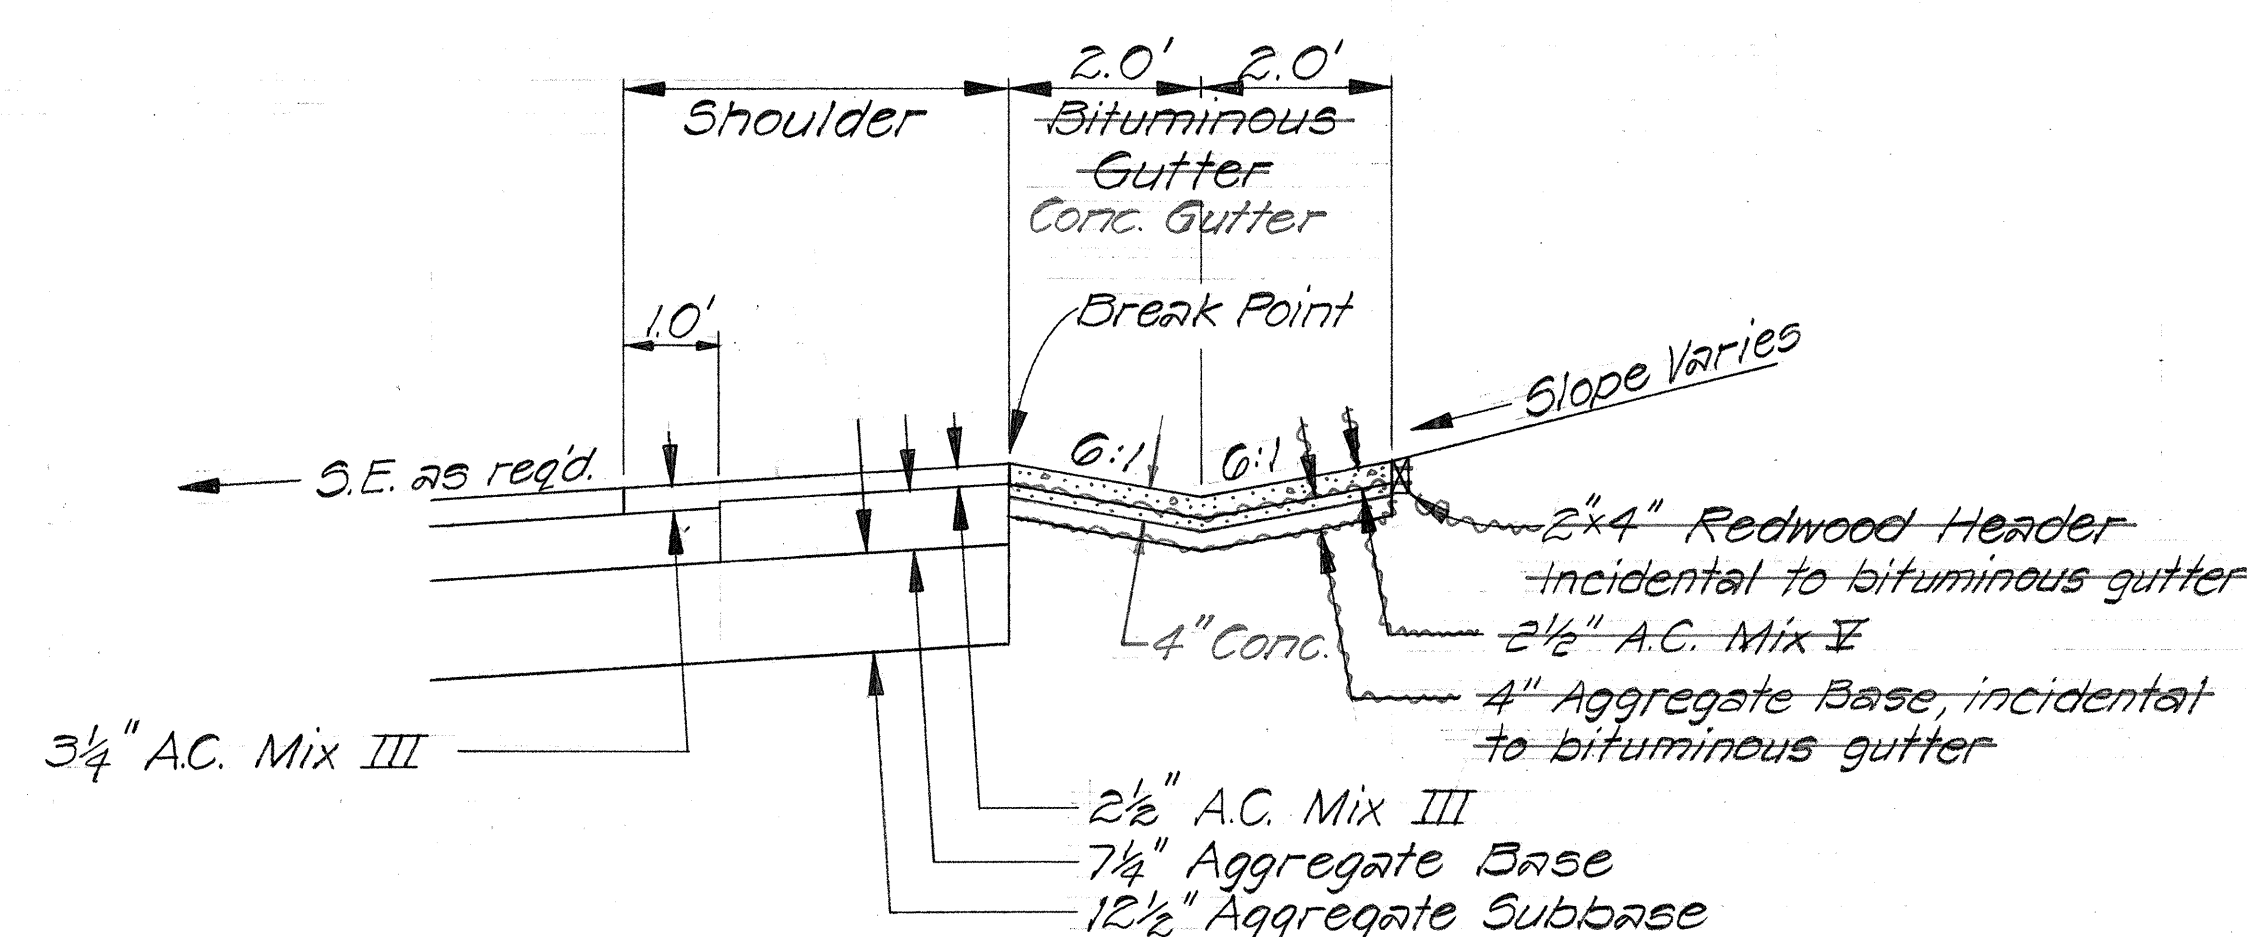

GUTTER DETAIL AT HIGHER END (WHERE SHOWN ON DETAIL ROADWAY PLANS)

Scale: 1/2" = 1'-0"

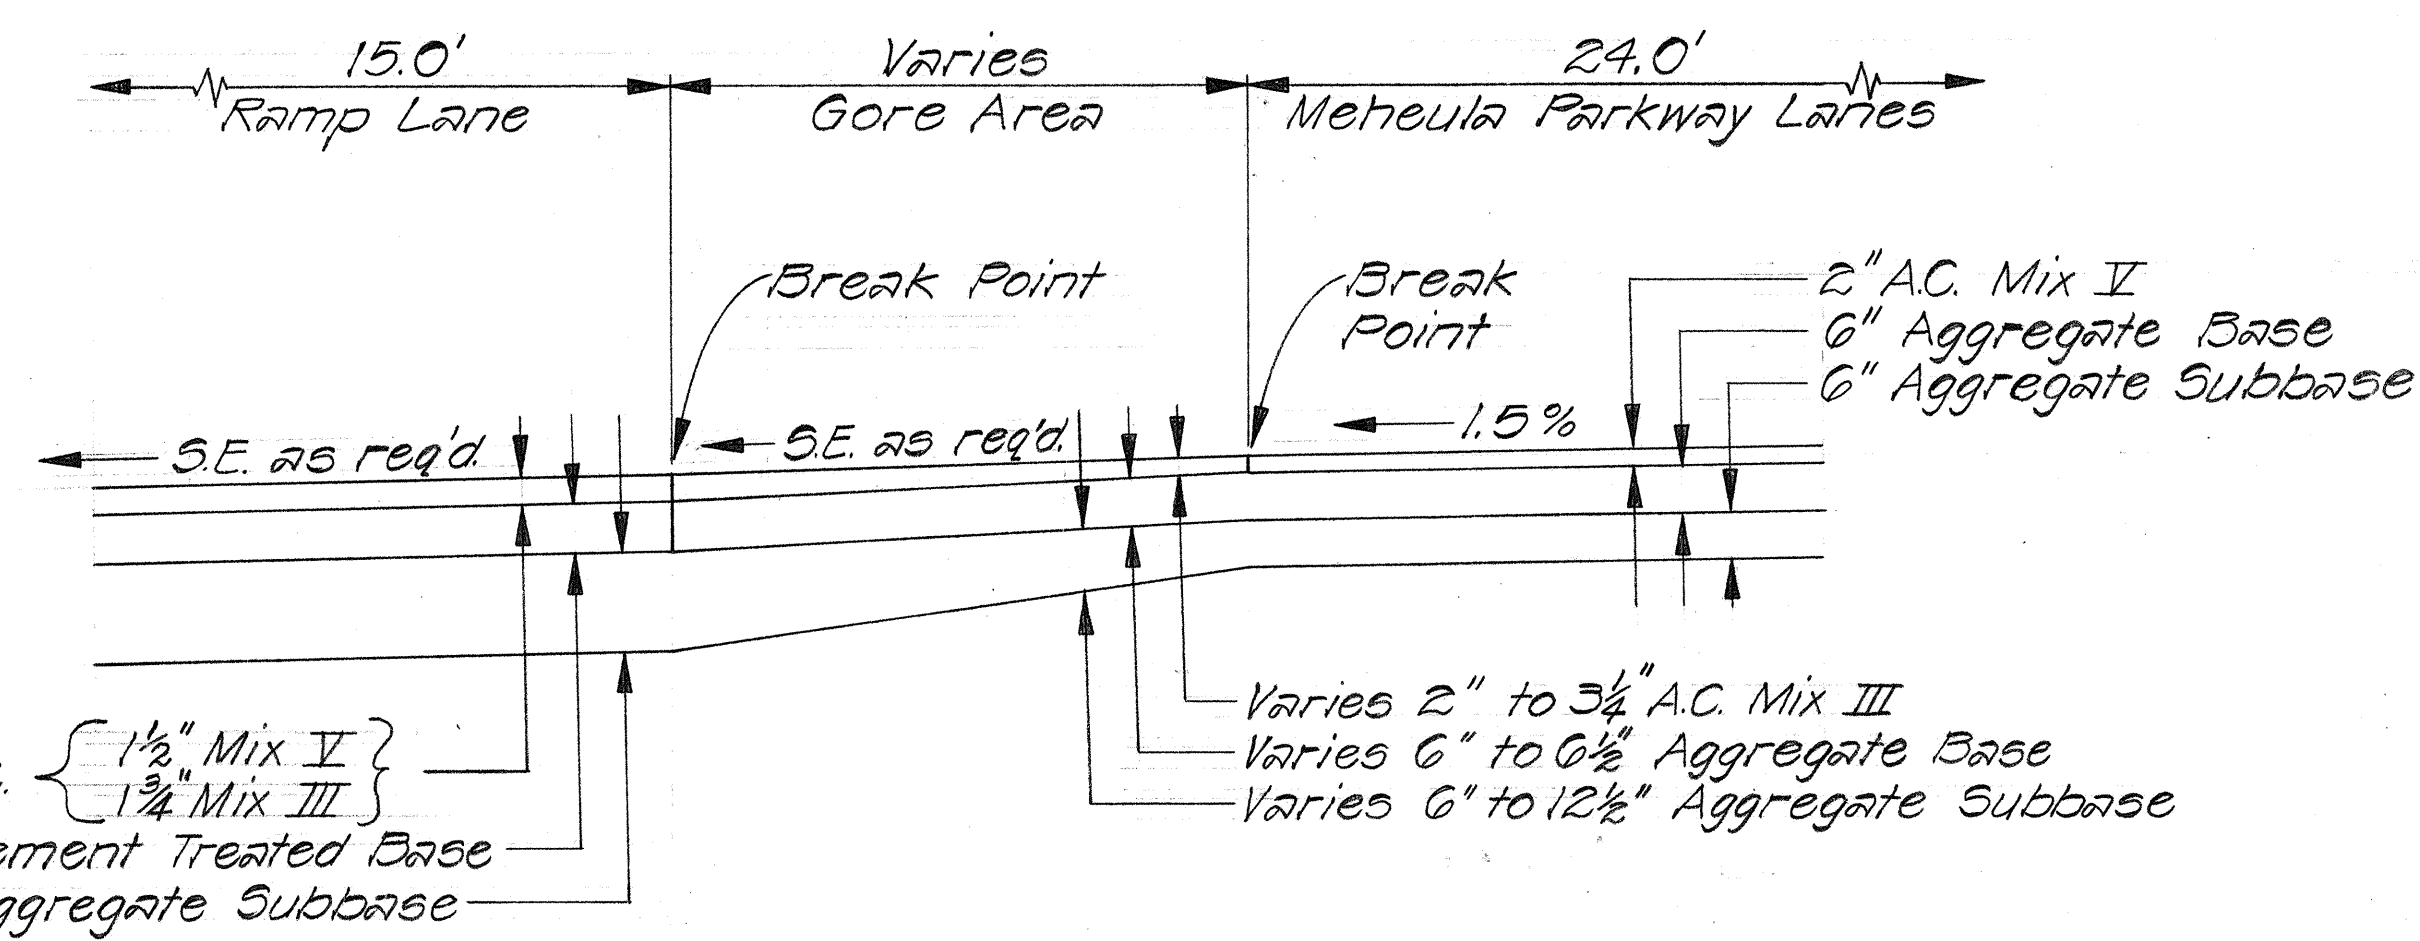

TYPICAL TRANSITION GORE AREA BETWEEN MEHEULA PARKWAY & RAMP LANES

Scale: 1/2" = 1'-0"

STATE OF HAWAII
DEPARTMENT OF TRANSPORTATION
HIGHWAYS DIVISION


TYPICAL SECTION

INTERSTATE ROUTE H-2
MILILANI INTERCHANGE
F.A.I. Proj. No. I-H2-1(7)-4

Scale: As Shown Date: April, 1973


SHEET No. 6 OF 9 SHEETS

FED. ROAD DIST. NO.	STATE	FED. AID PROJ. NO.	FISCAL YEAR	SHEET NO.	TOTAL SHEETS
HAWAII	HAW.	I-H2-1(7):4	1973	8	220

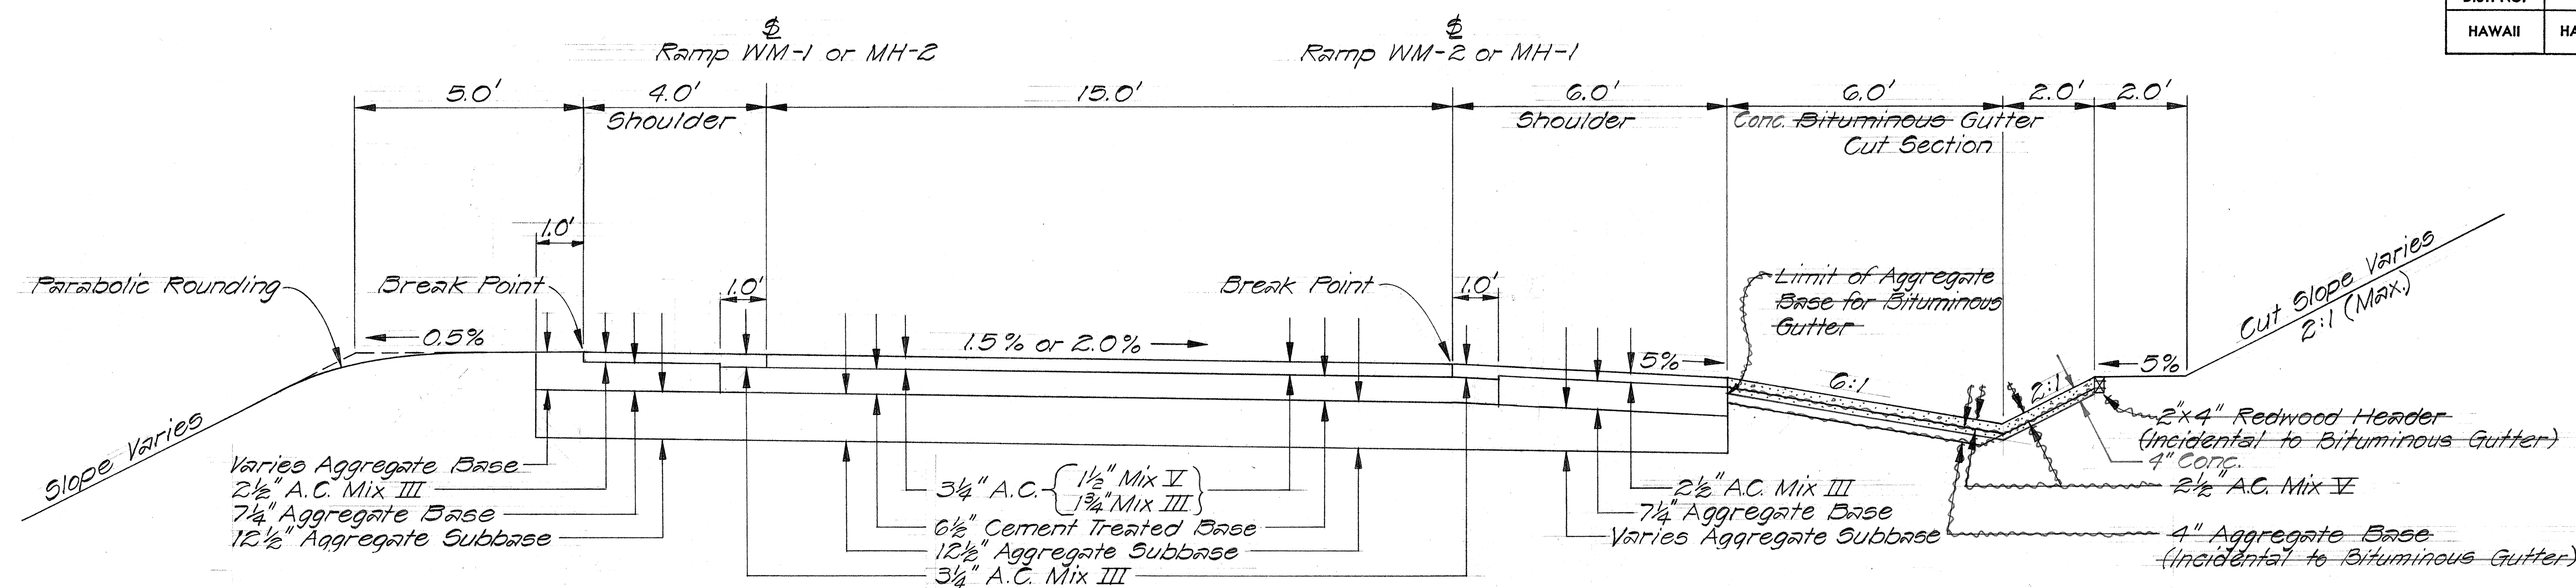

NORMAL TANGENT SECTION ~ RAMPs WM-1 & WM-2; MH-1 & MH-2

Scale: $\frac{1}{2}$ " = 1'-0"

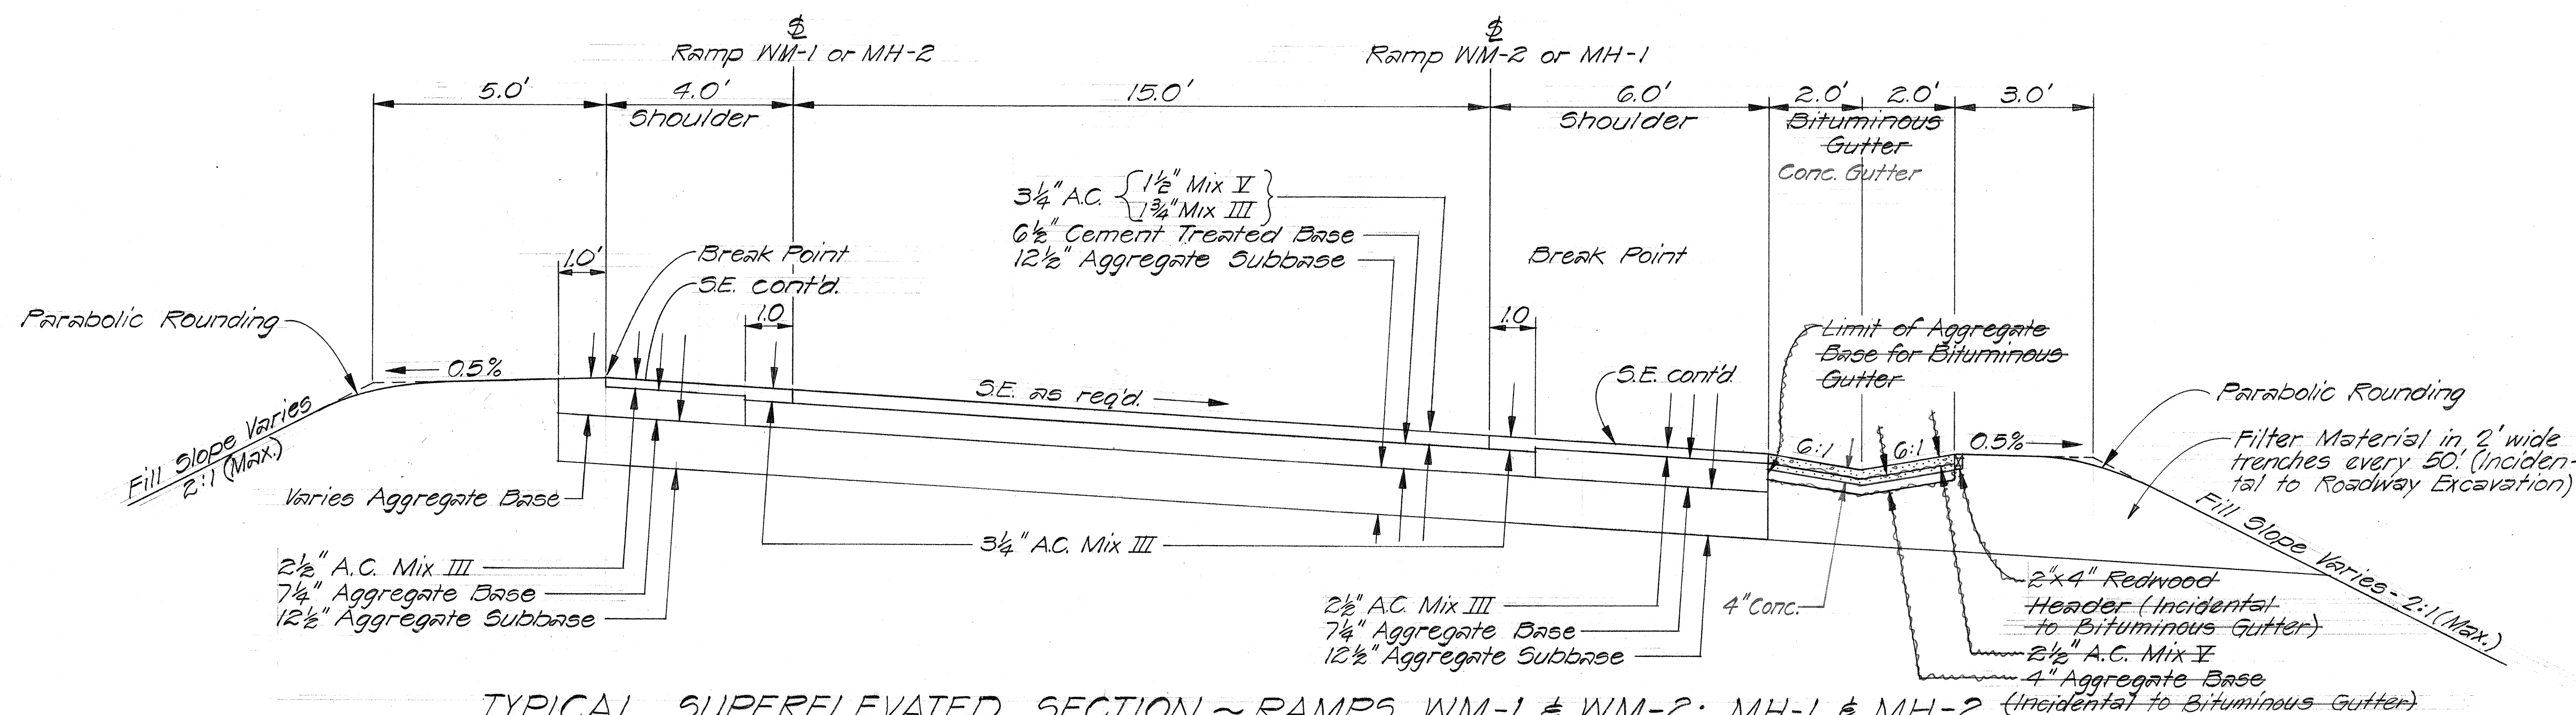

TYPICAL SUPERELEVATED SECTION ~ RAMPs WM-1 & WM-2; MH-1 & MH-2

Scale: $\frac{1}{2}$ " = 1'-0"

Note: For ramp lanes on Meheula Parkway beyond P.T. or P.C. Station of ramps, same pavement thicknesses as Meheula Parkway shall be used.

STATE OF HAWAII
DEPARTMENT OF TRANSPORTATION
HIGHWAYS DIVISION

TYPICAL SECTIONS


INTERSTATE ROUTE H-2
MILILANI INTERCHANGE
F.A.I. Proj. No. I-H2-1(7):4

Scale: As Shown Date: April, 1973

SHEET No. 7 OF 9 SHEETS


DATE	
SURVEY PLOTTED BY	
DRAWN BY	
CHECKED BY	
NOTE BOOK	
No.	

FED. ROAD DIST. NO.	STATE	FED. AID PROJ. NO.	FISCAL YEAR	SHEET NO.	TOTAL SHEETS
HAWAII	HAW.	I-H2-1(7):4	1973	9	226

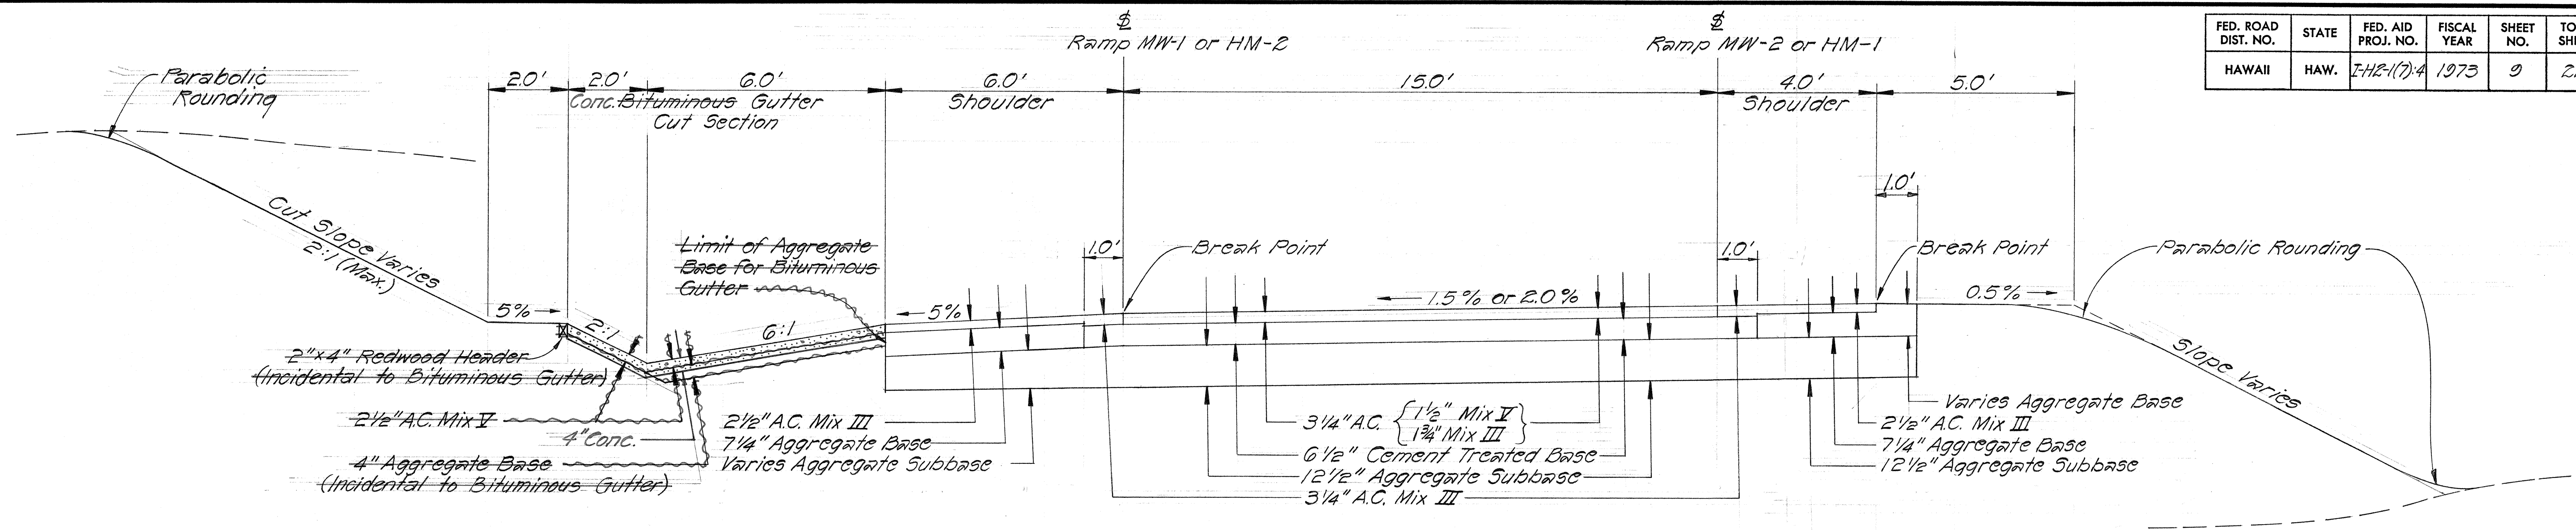

NORMAL TANGENT SECTION ~ RAMPS MW-1 & MW-2; HM-1 & HM-2

Scale: 1/2" = 1'-0"

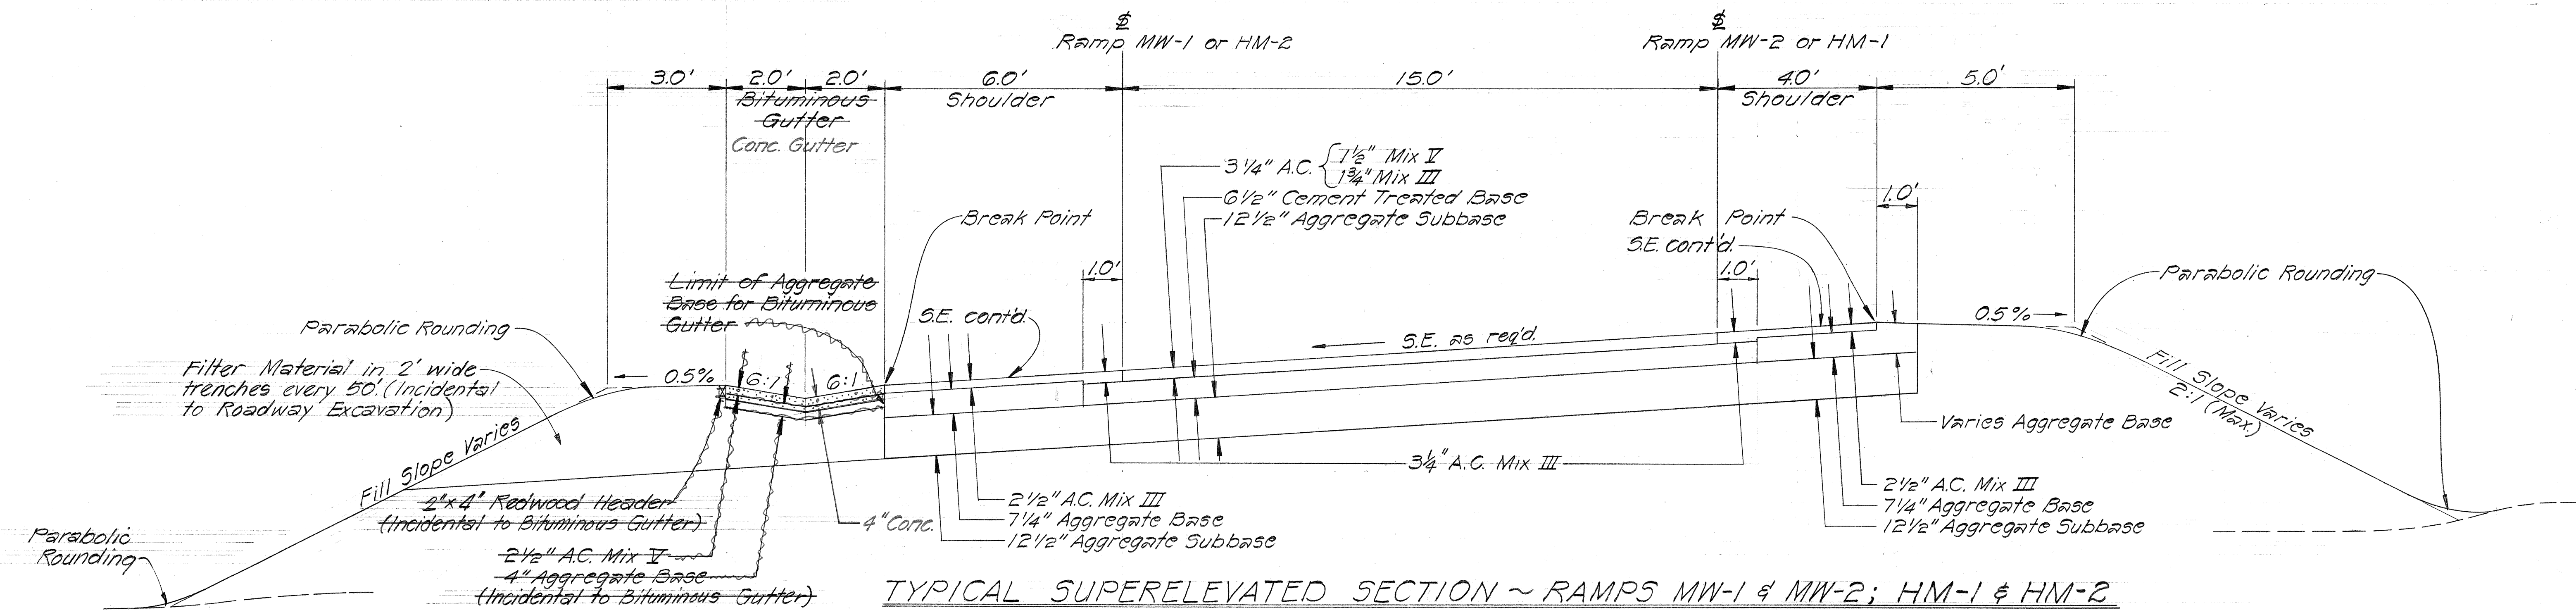

TYPICAL SUPERELEVATED SECTION ~ RAMPS MW-1 & MW-2; HM-1 & HM-2

Scale: 1/2" = 1'-0"

NOTES:

1. For ramp lanes on Meheula Parkway beyond P.T. or P.C. station of ramps, same pavement thicknesses as Meheula Parkway shall be used.
2. Bituminous Gutters on Ramps shall be installed as required. For locations, see Detail Plans of Roadway.

STATE OF HAWAII
DEPARTMENT OF TRANSPORTATION
HIGHWAYS DIVISION

TYPICAL SECTIONS


INTERSTATE ROUTE H-2
MILILANI INTERCHANGE
F.A.I. Proj. No. I-H2-1(7):4

Scale: As Shown Date: April, 1973



SHEET No. 8 OF 9 SHEETS

SURVEY PLOTTED BY	DATE
DESIGNED BY	
QUANTITIES BY	
CHECKED BY	
ORIGINAL PLAN	
NOTE BOOK	
No.	

FED. ROAD DIST. NO.	STATE	FED. AID PROJ. NO.	FISCAL YEAR	SHEET NO.	TOTAL SHEETS
HAWAII	HAW.	I-H2-1(7)-4	1973	10	220

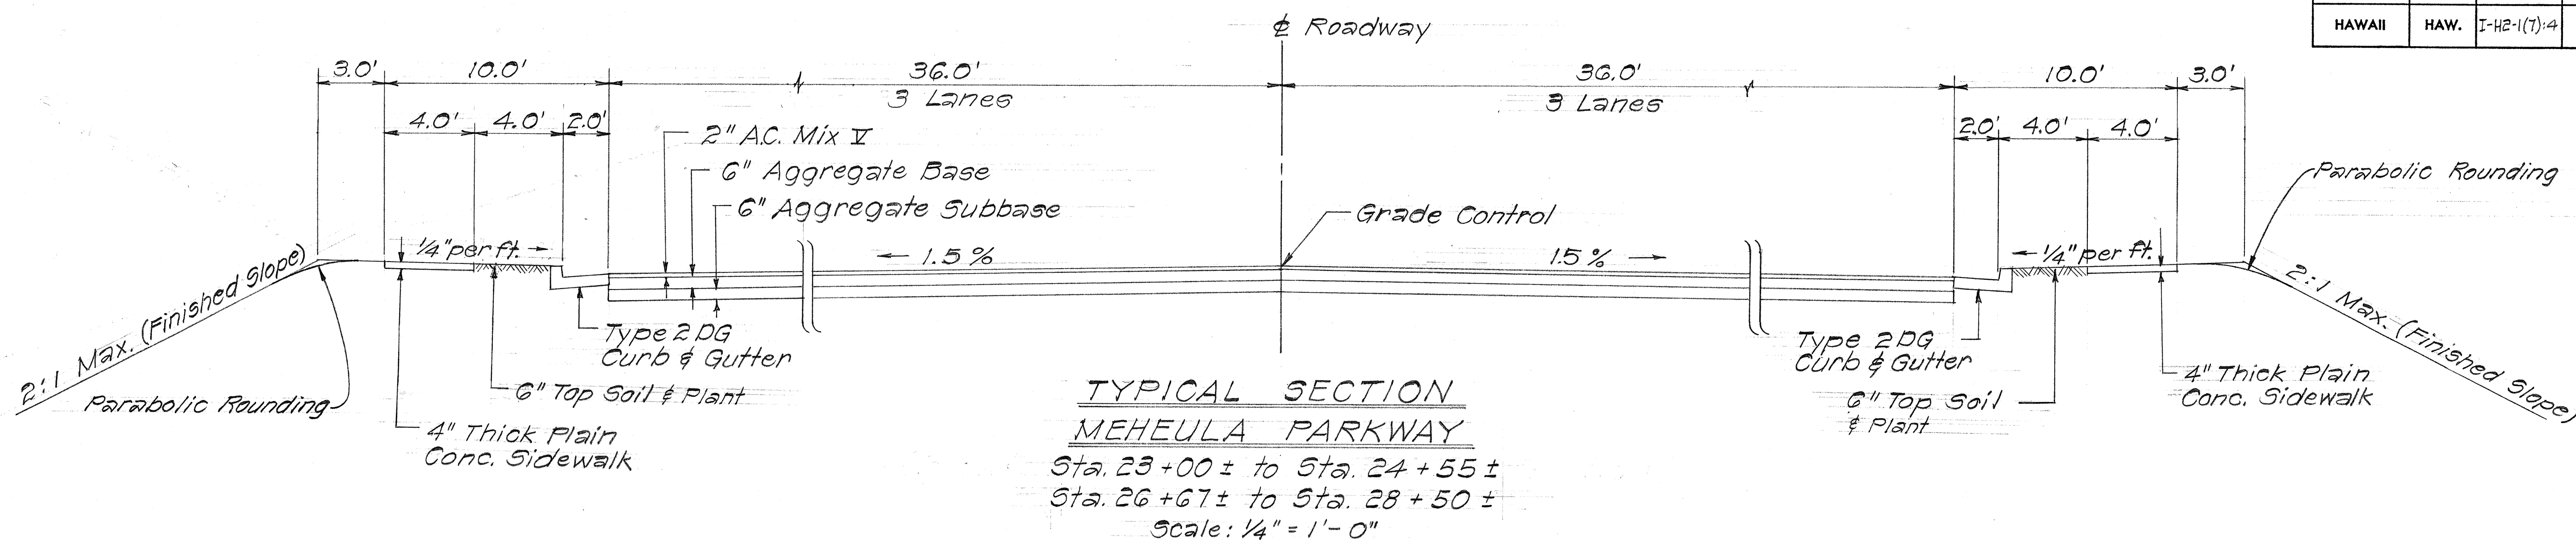

NOTE:
For Finished Slopes
see Contour Grading
Plan and/or X-Sections.

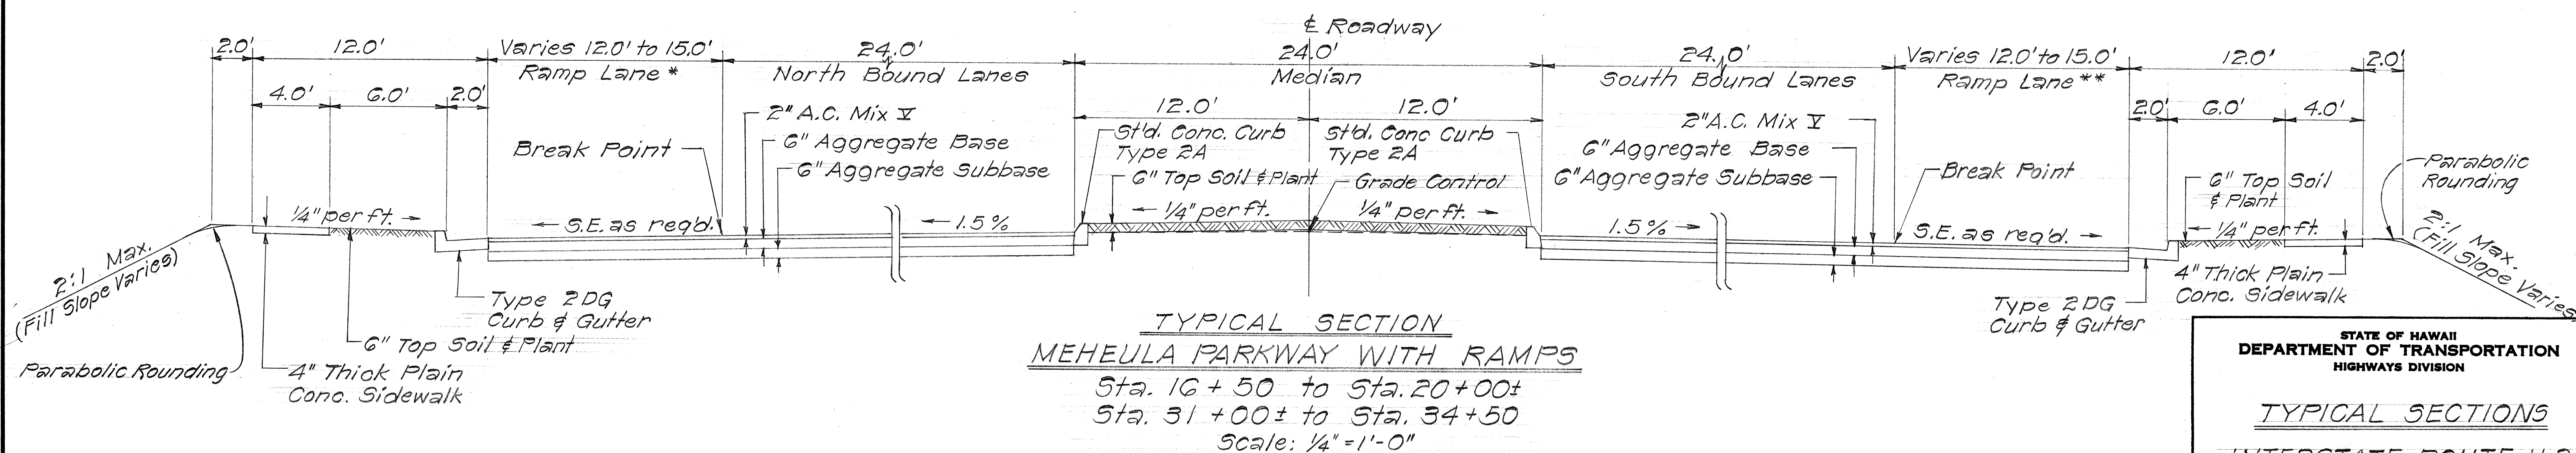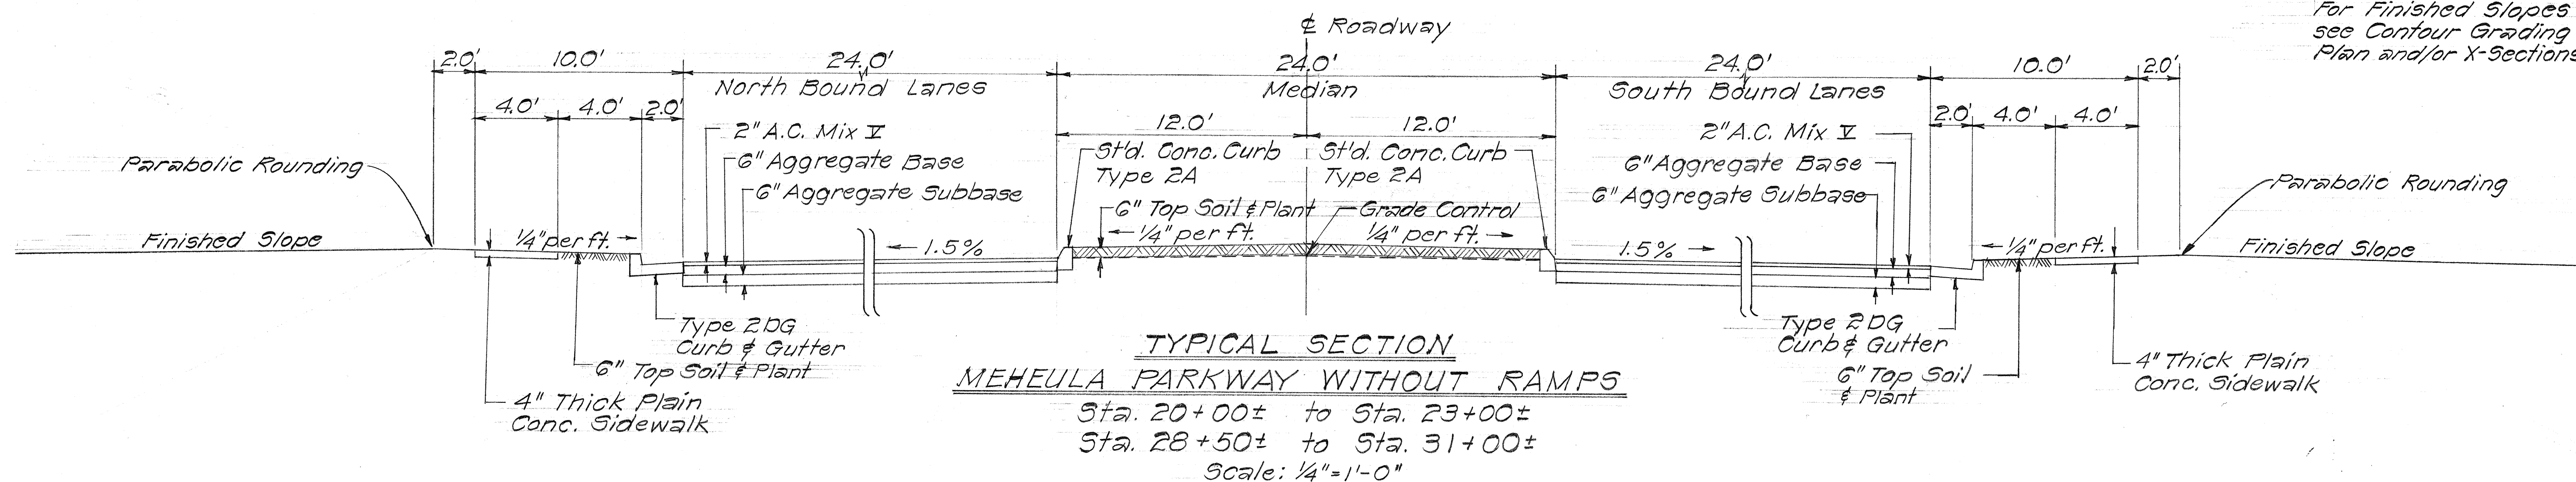

* On-Ramp Ramp HM-1 (Sta. 2+44 to Sta. 10+06)
Off-Ramp Ramp HM-2 (Sta. 0+65.22 to Sta. 3+23.14)

** Off-Ramp Ramp MW-2 (Sta. 25+06.81 to Sta. 29+53.45)
On-Ramp Ramp MW-1 (Sta. 30+46.59 to Sta. 31+03.20)

STATE OF HAWAII
DEPARTMENT OF TRANSPORTATION
HIGHWAYS DIVISION

TYPICAL SECTIONS

INTERSTATE ROUTE H-2
MILILANI INTERCHANGE
F.A.I. Proj. No. I-H2-1(7)-4

Scale: As Shown Date: April, 1973

SHEET No. 9 OF 9 SHEETS