


220 200 160 120 80 40 0 40 80 120 160 200





FED. ROAD DIST. NO.	STATE	FED. AID PROJ. NO.	FISCAL YEAR	SHEET NO.	TOTAL SHEETS
HAWAII	HAW.	I-H2-1(10):6	1973	91	104

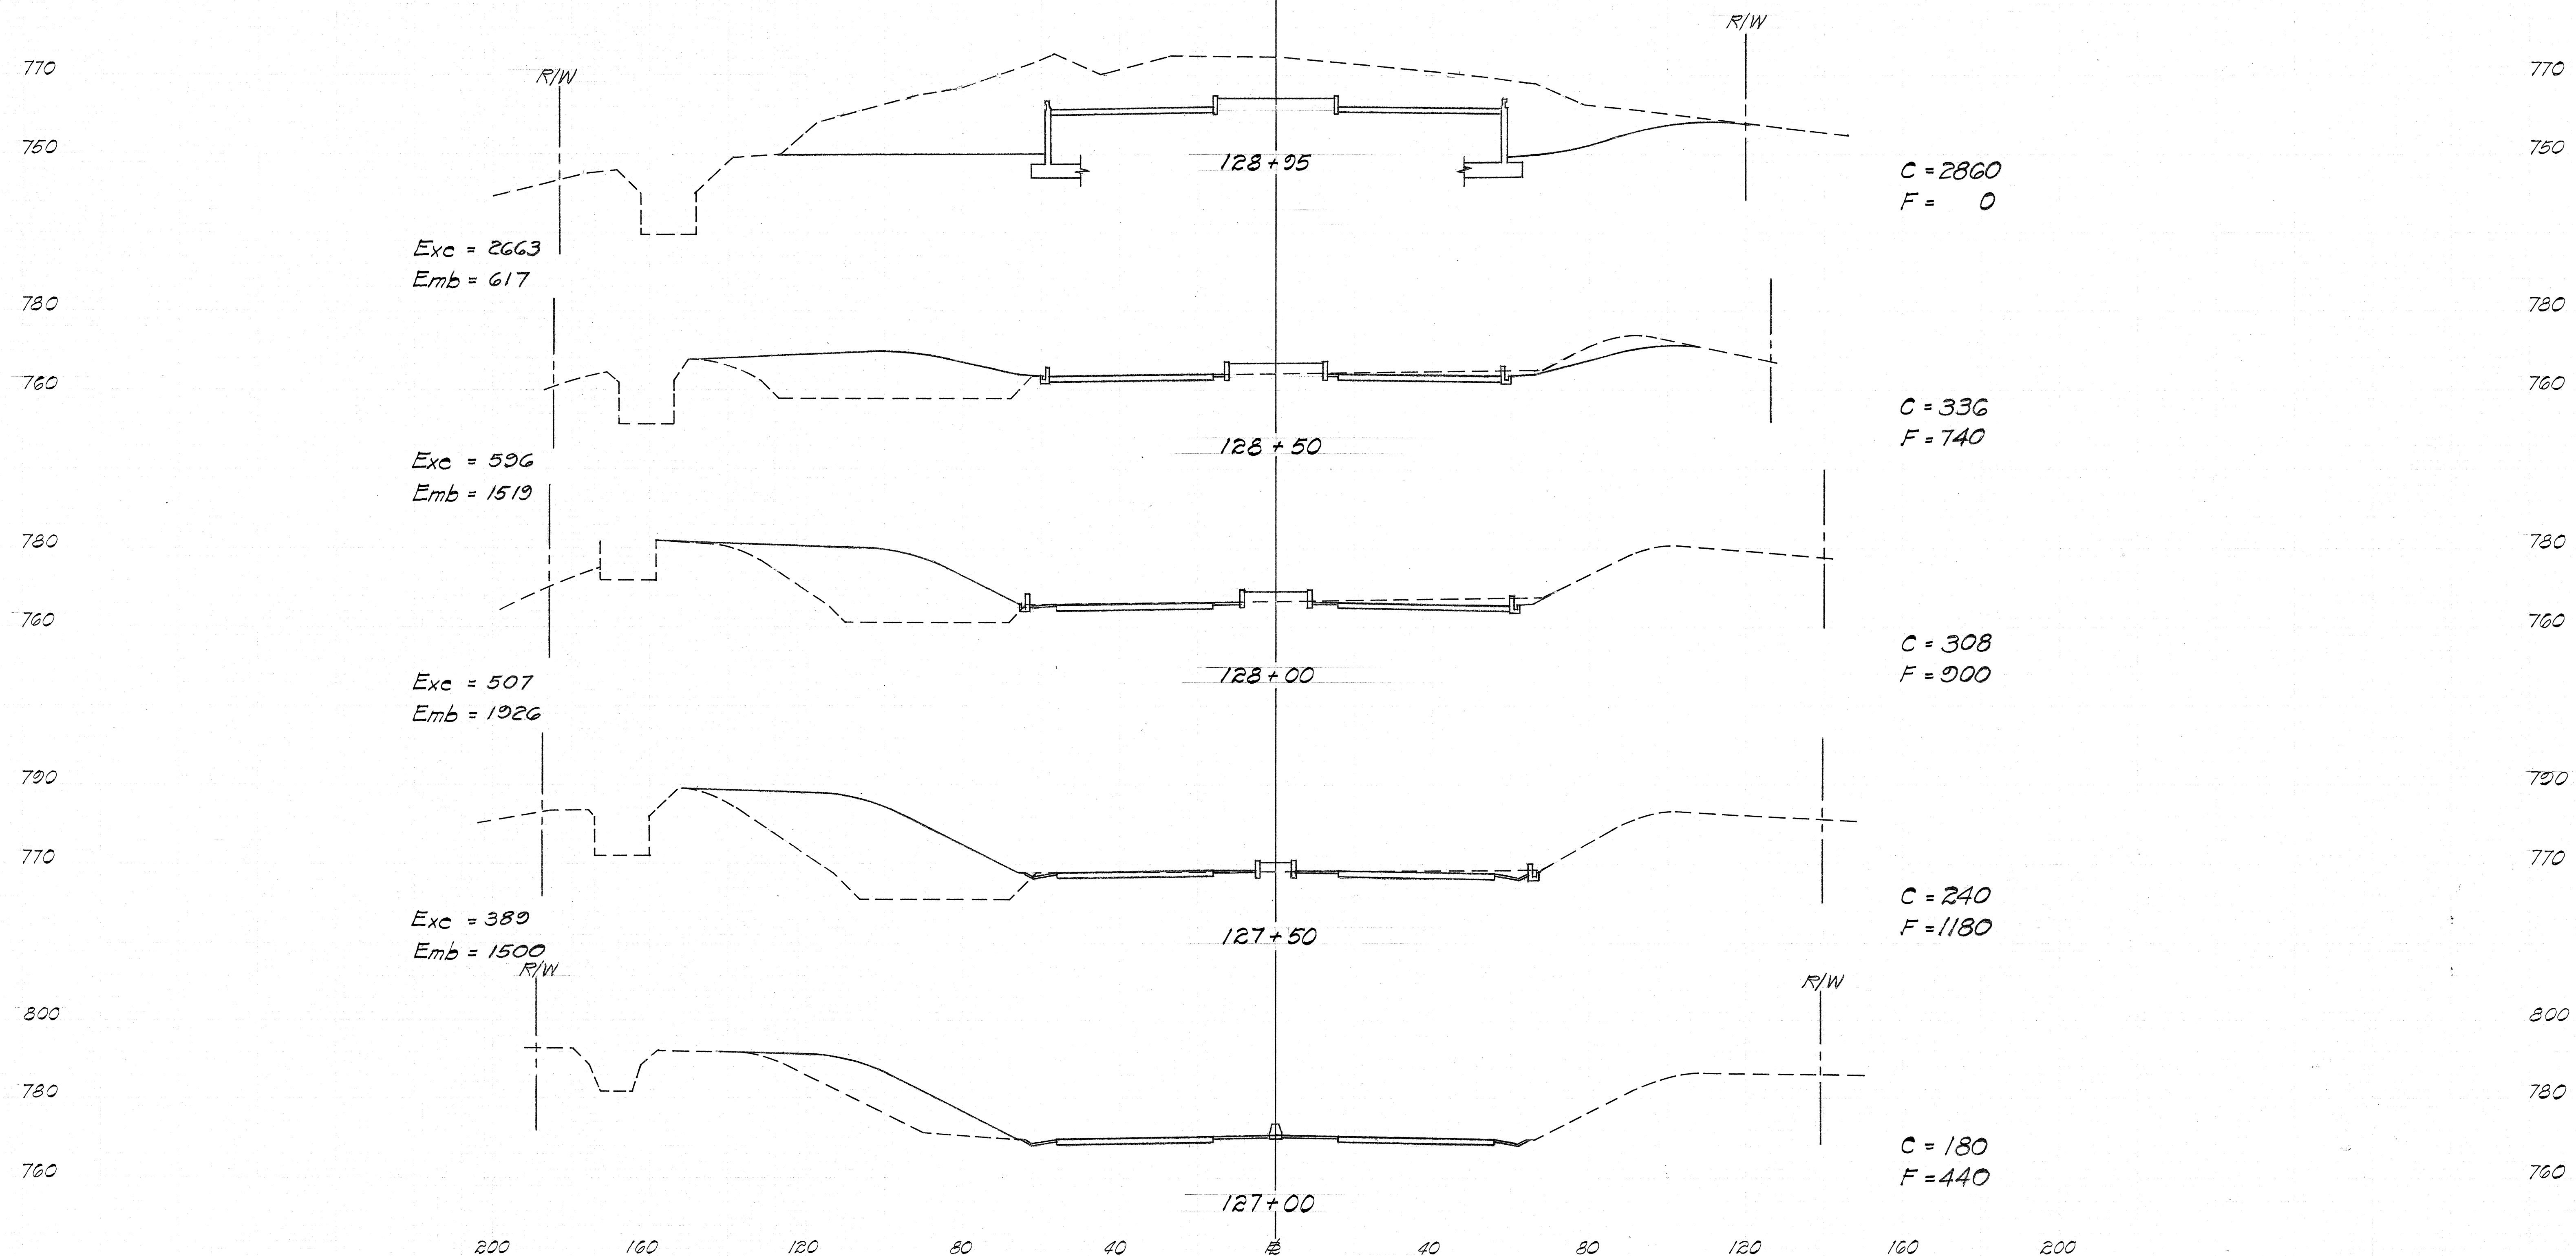

FED. ROAD DIST. NO.	STATE	FED. AID PROJ. NO.	FISCAL YEAR	SHEET NO.	TOTAL SHEETS
HAWAII	HAW.	I-H2-1(10):G	1973	92	104

FINAL SURVEY	DATE
NO. 1	
NO. 2	
NO. 3	
NO. 4	
NO. 5	
NO. 6	
NO. 7	
NO. 8	
NO. 9	
NO. 10	

ORIGINAL SURVEY	DATE
NO. 1	
NO. 2	
NO. 3	
NO. 4	
NO. 5	
NO. 6	
NO. 7	
NO. 8	
NO. 9	
NO. 10	

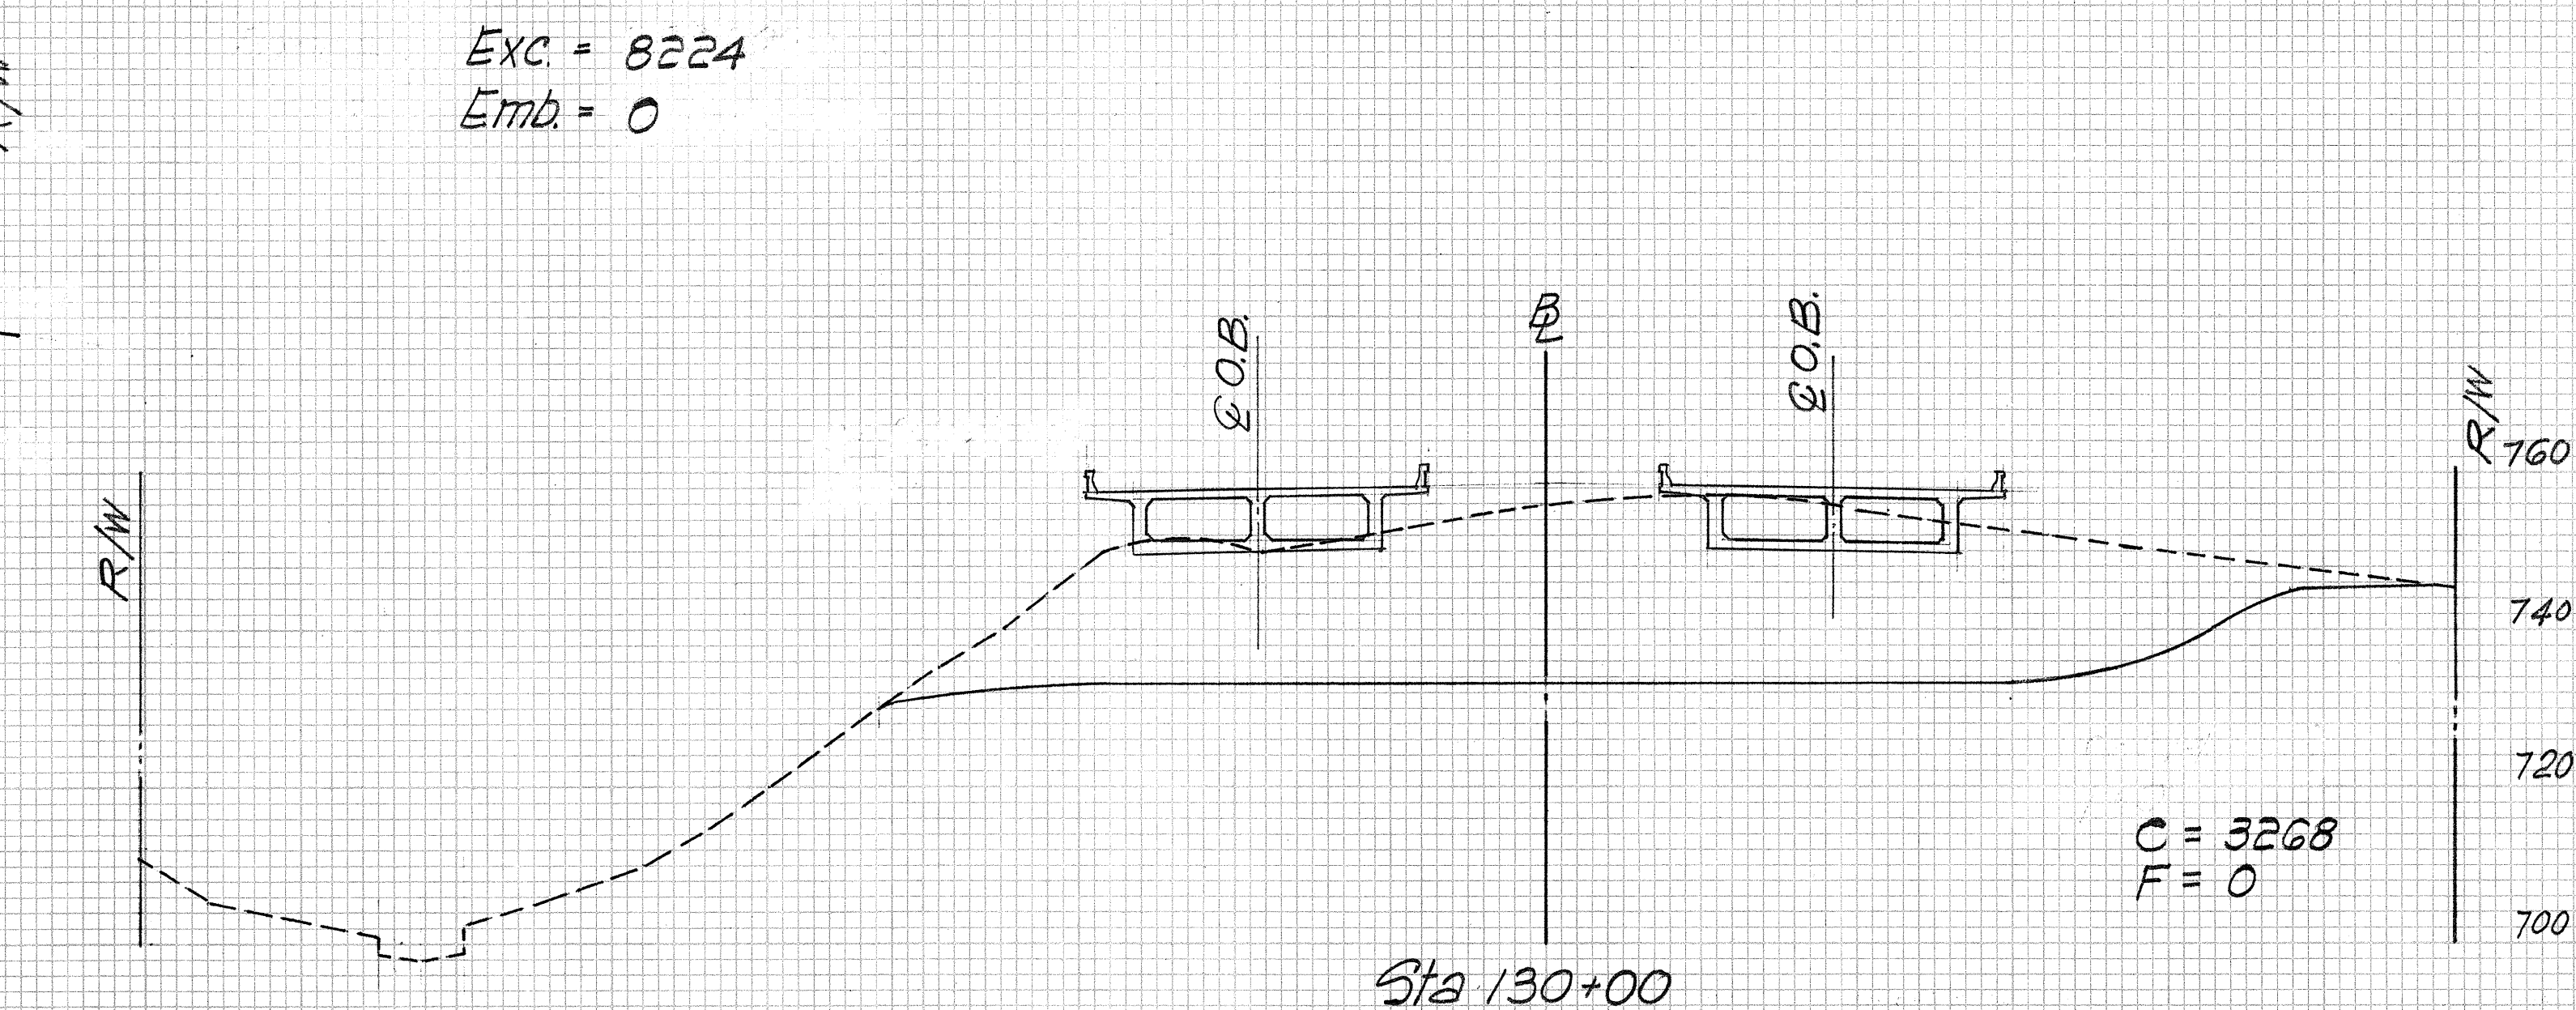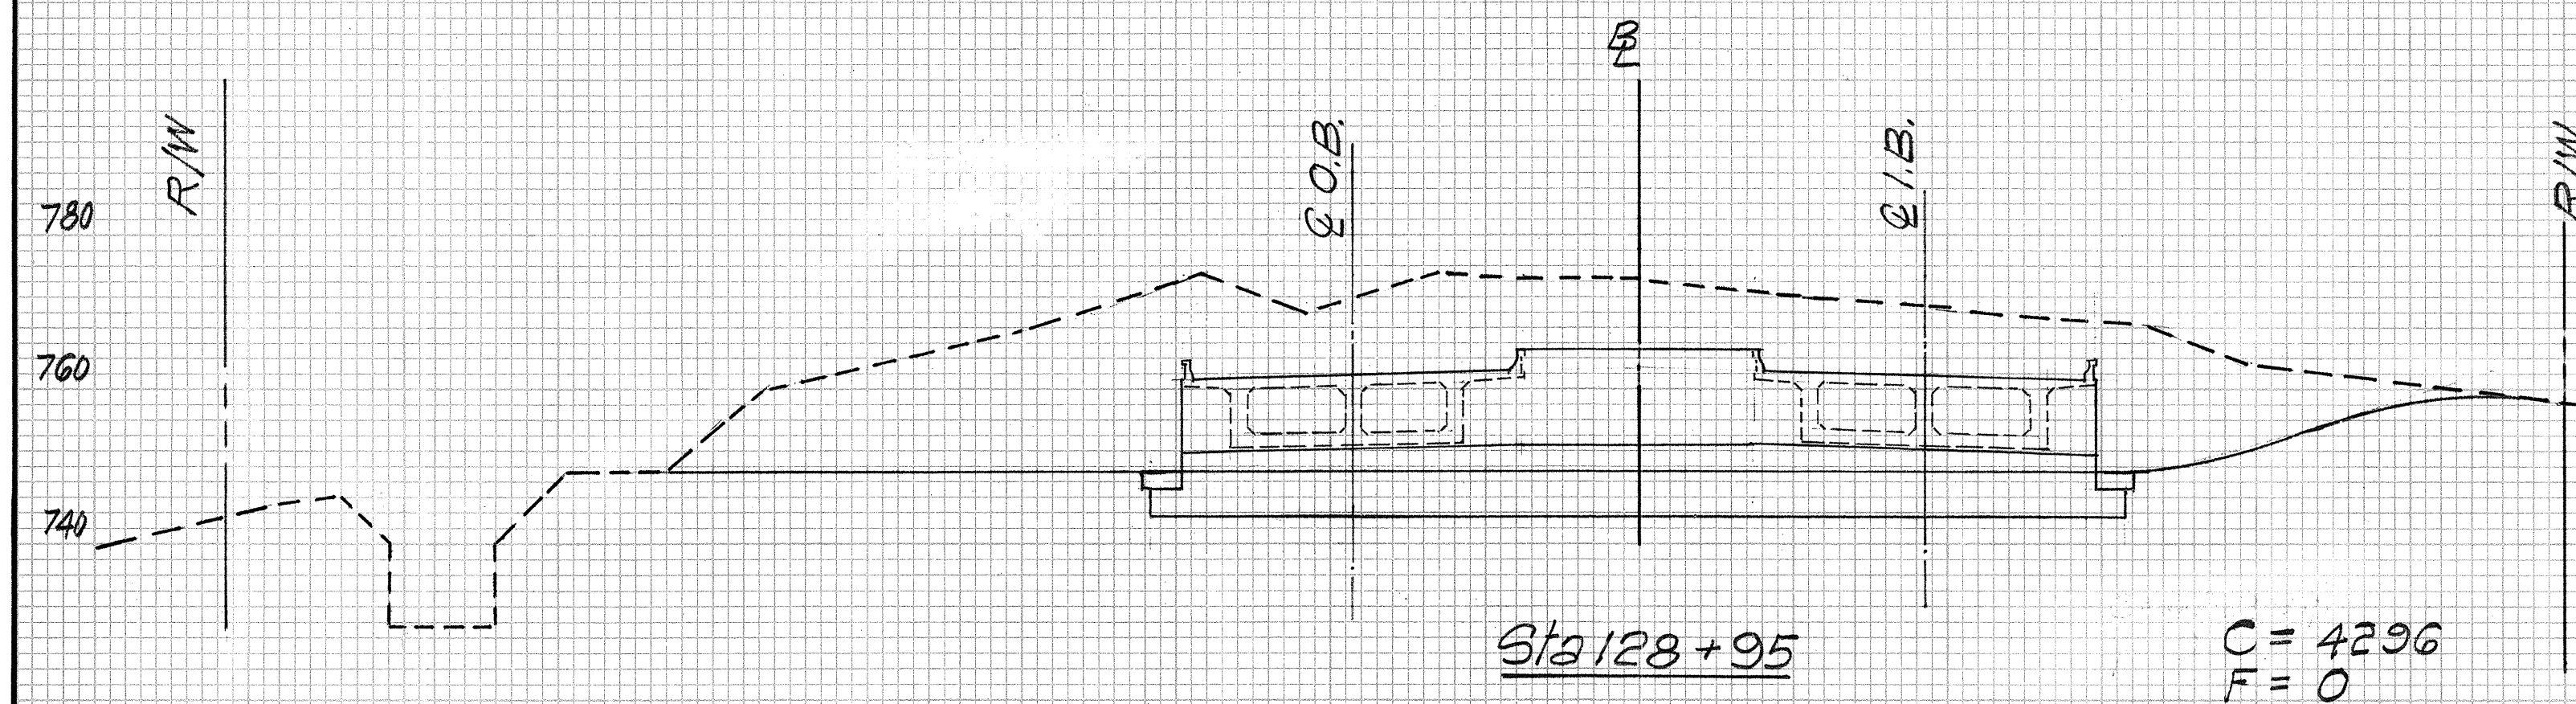
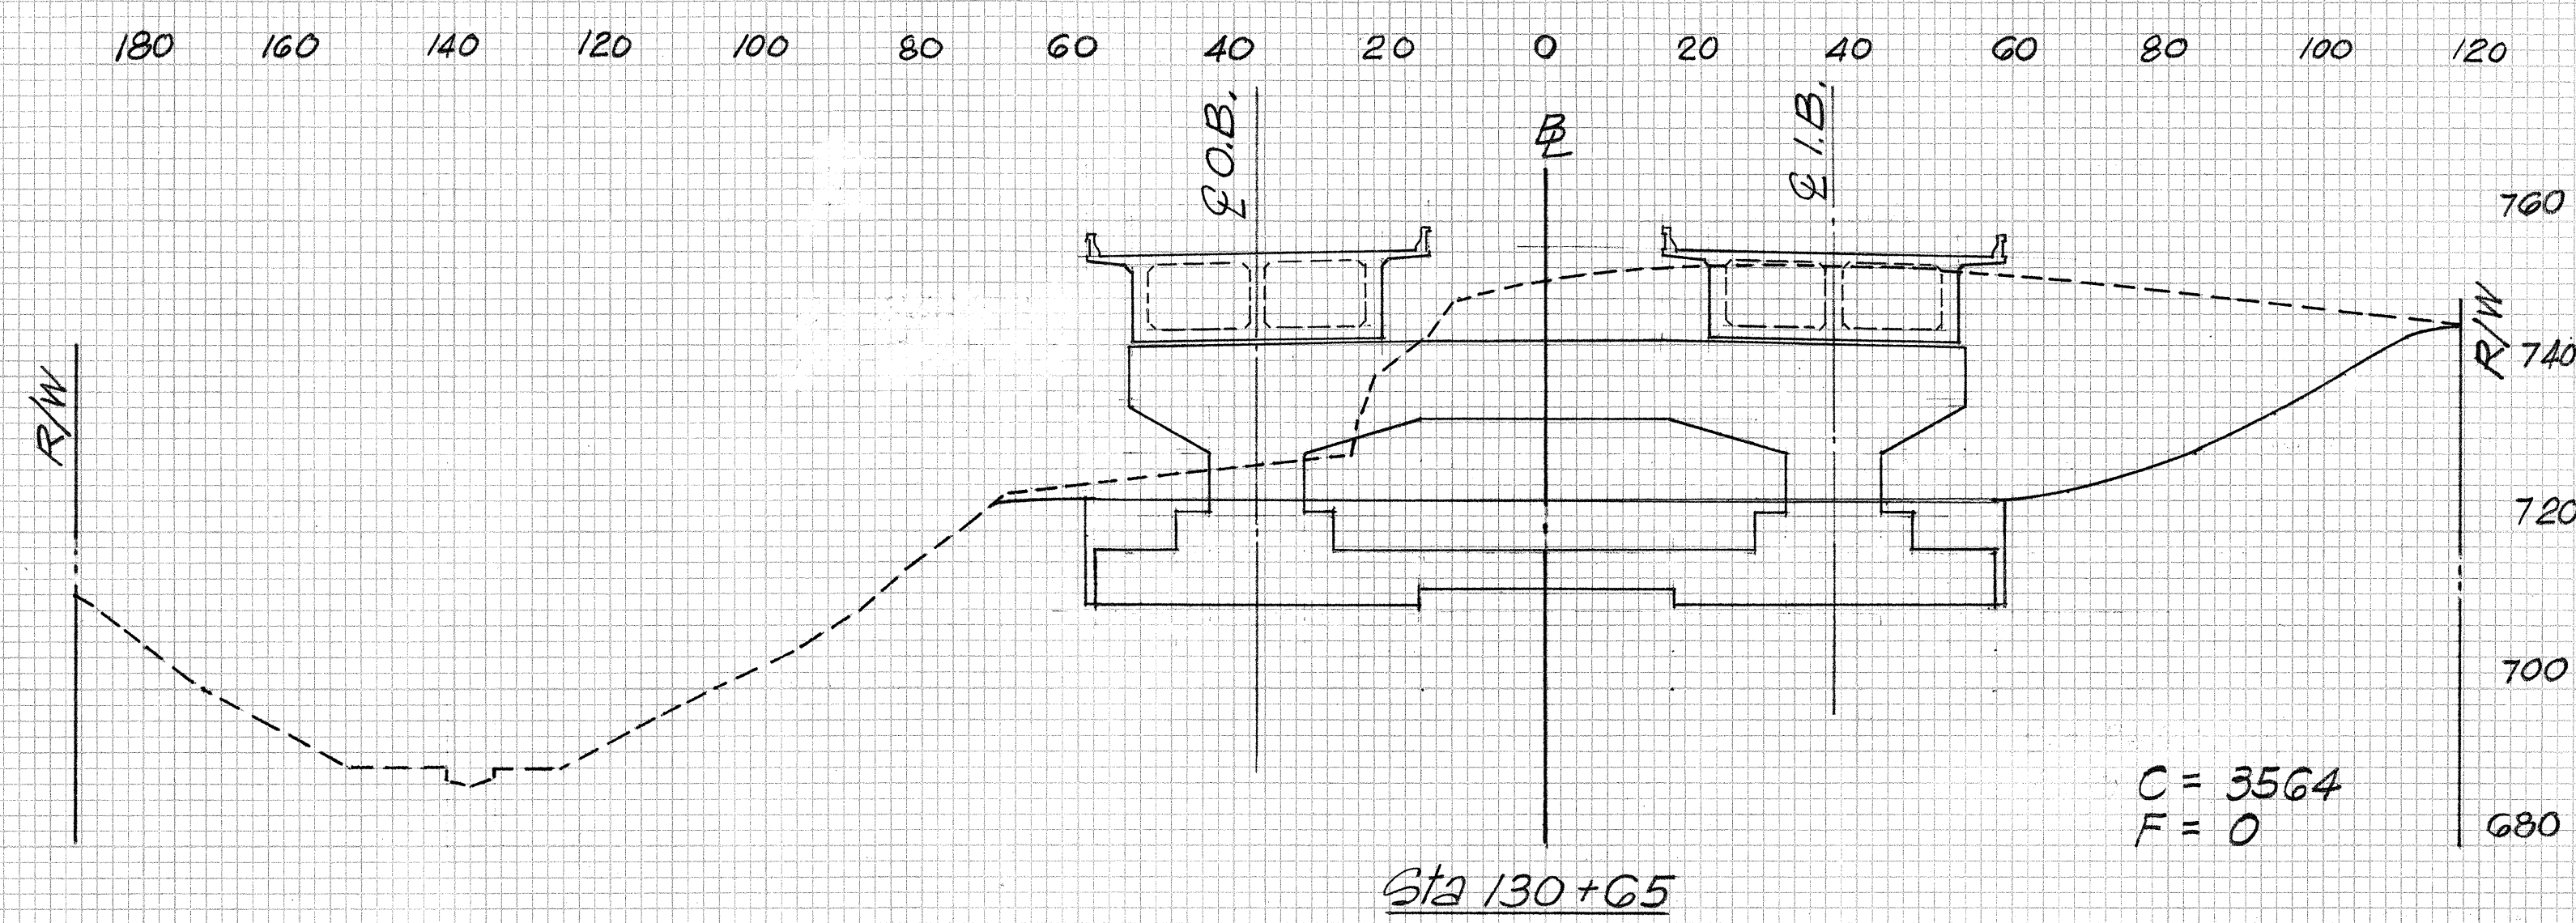
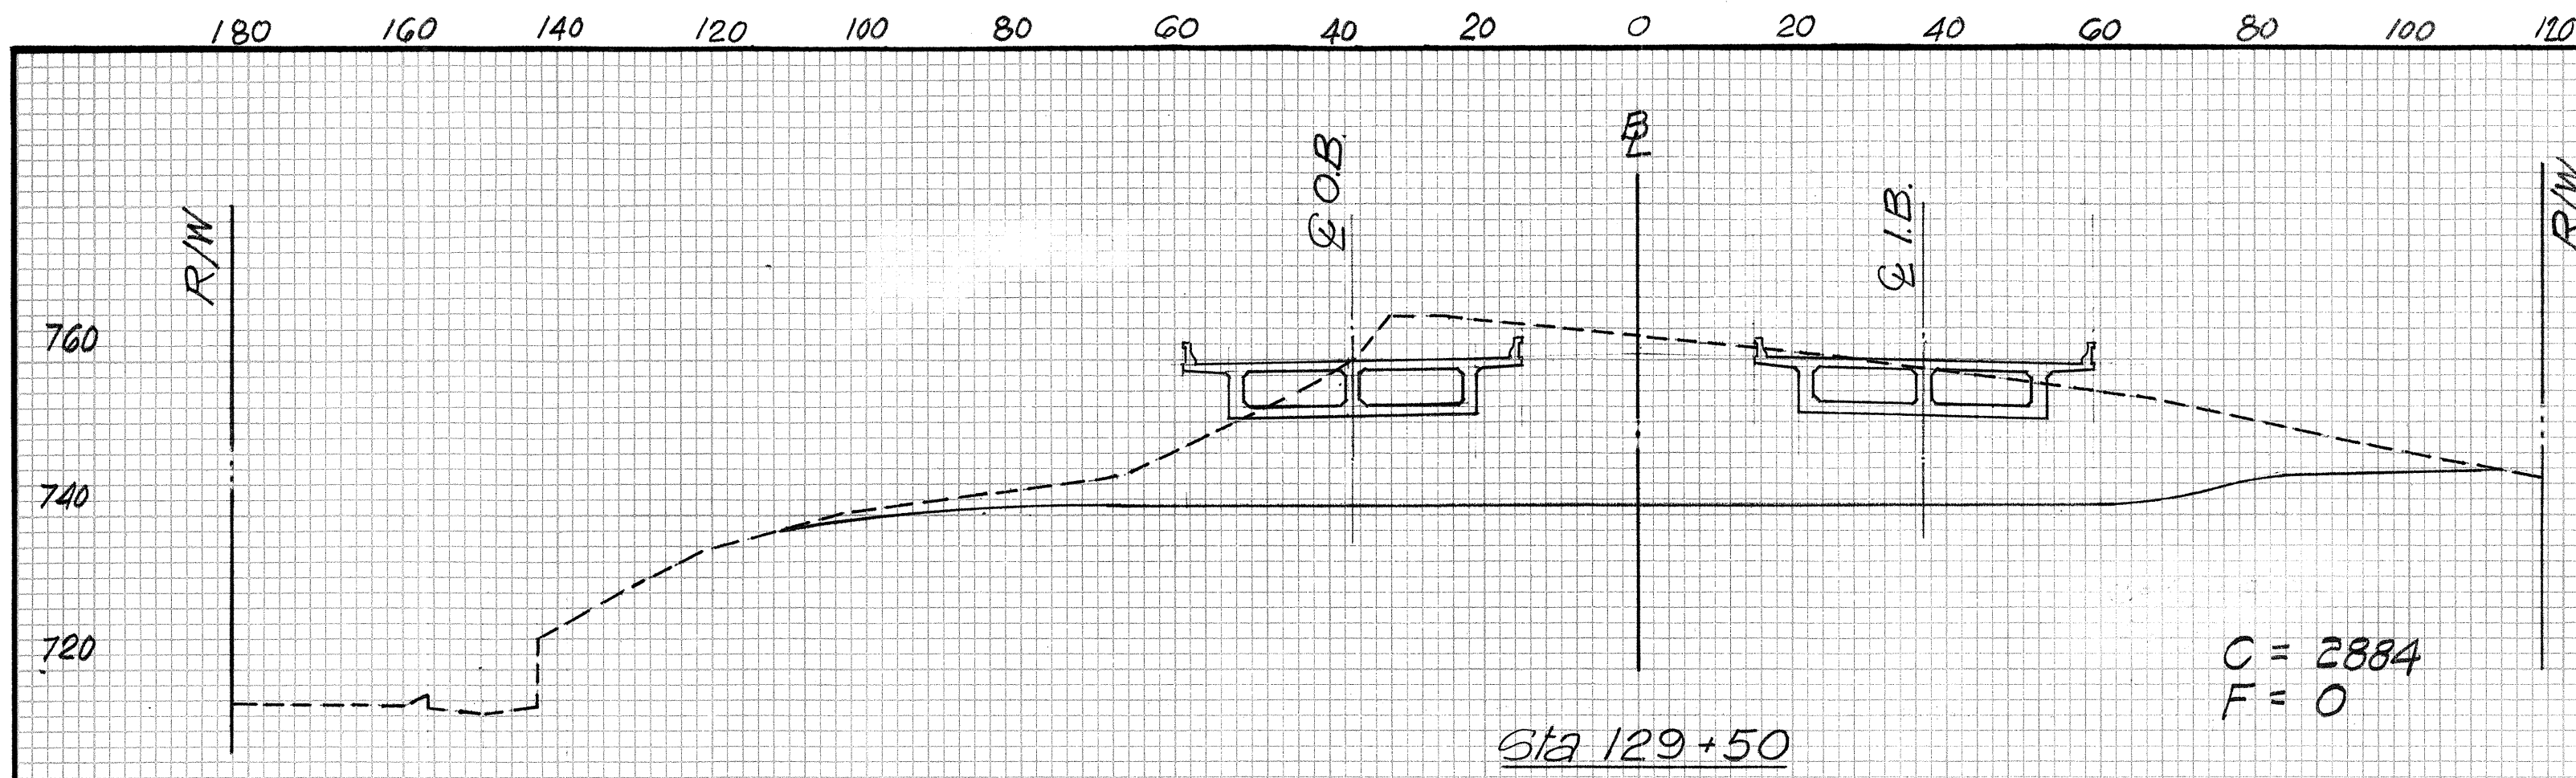


CROSS SECTIONS
 Scale: Hor. - 1"=20'
 Vert. - 1"=20'

CROSS SECTIONS
 STA 128+55 TO STA 130+65
 INTERSTATE ROUTE H-2
 F.A.I. PROJ. NO. I-H2-1(10):G
 Scale: Hor. 1"=20'
 Vert. 1"=20' May, 1973

200 180 160 140 120 100 80 60 40 20 0 20 40 60 80 100 120


FED. ROAD DIST. NO.	STATE	FED. AID PROJ. NO.	FISCAL YEAR	SHEET NO.	TOTAL SHEETS
HAWAII	HAW.	I-H2-1(10):G	1973	93	104

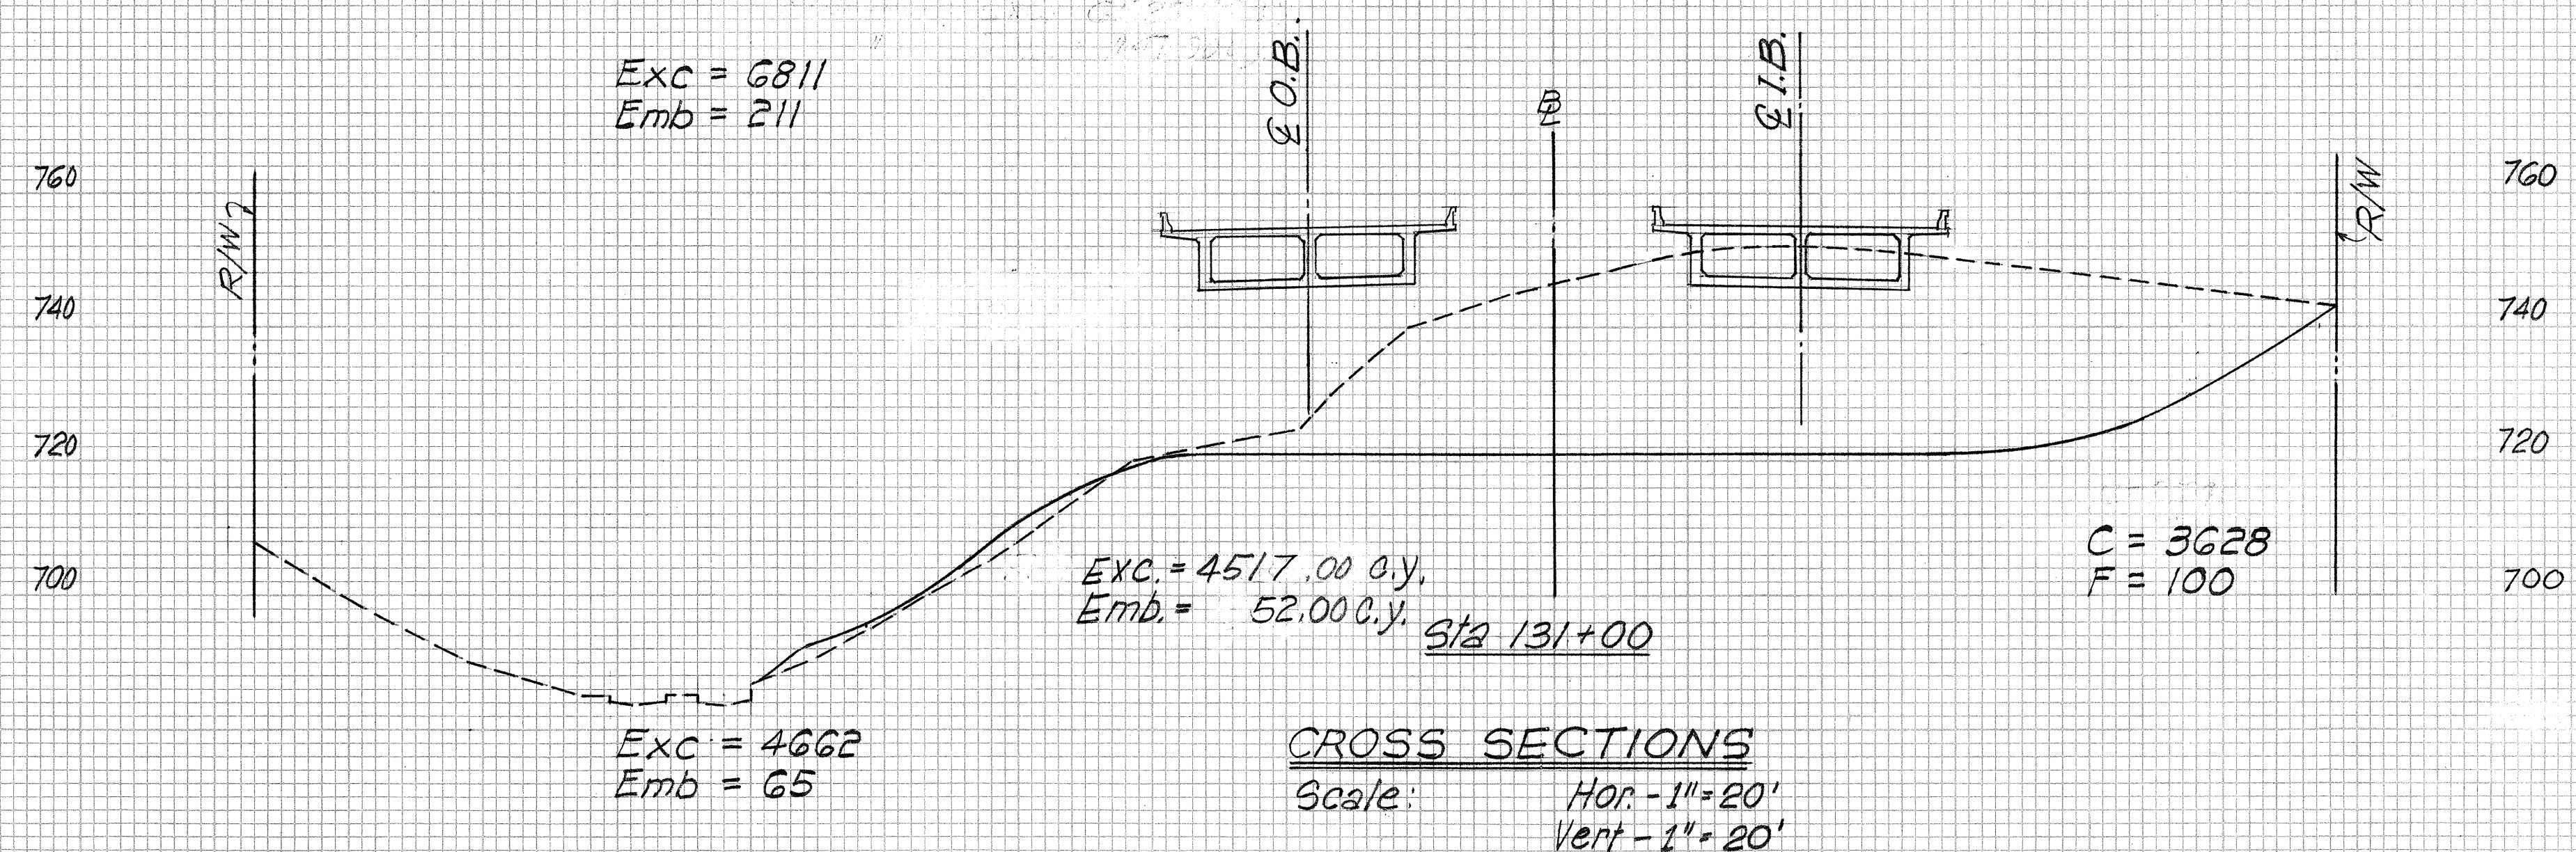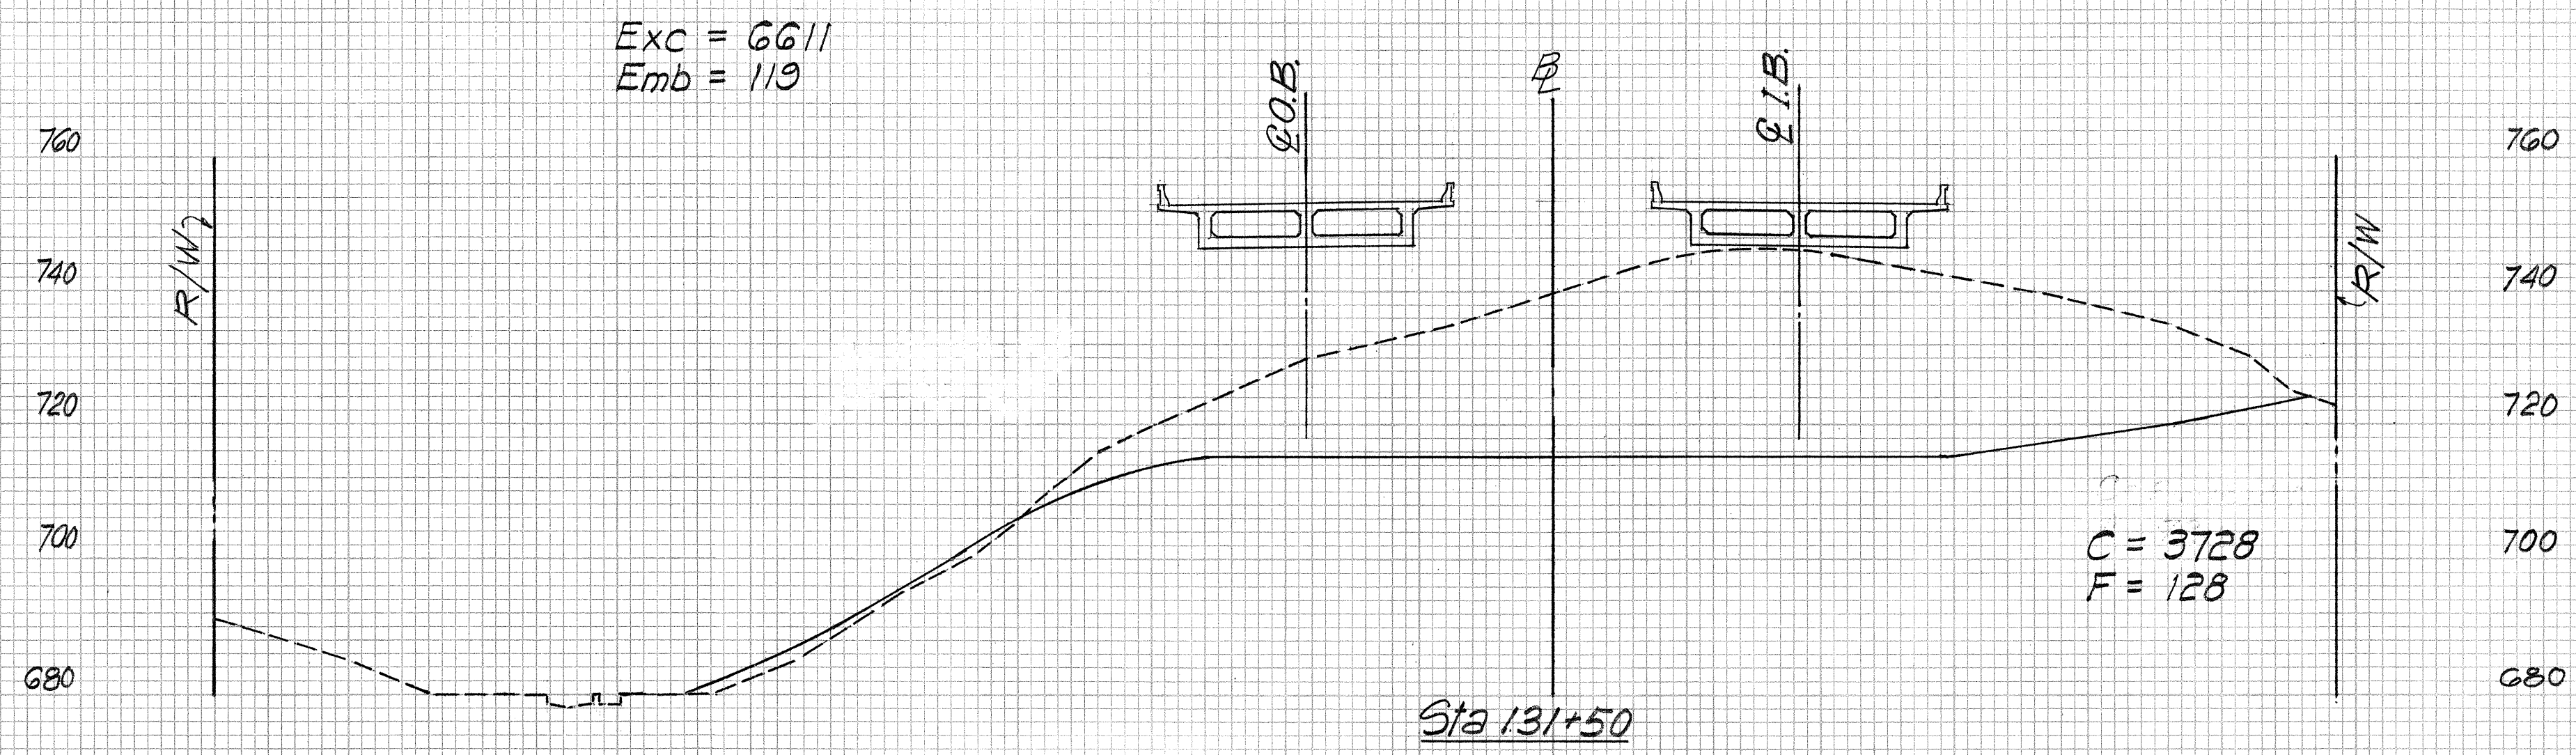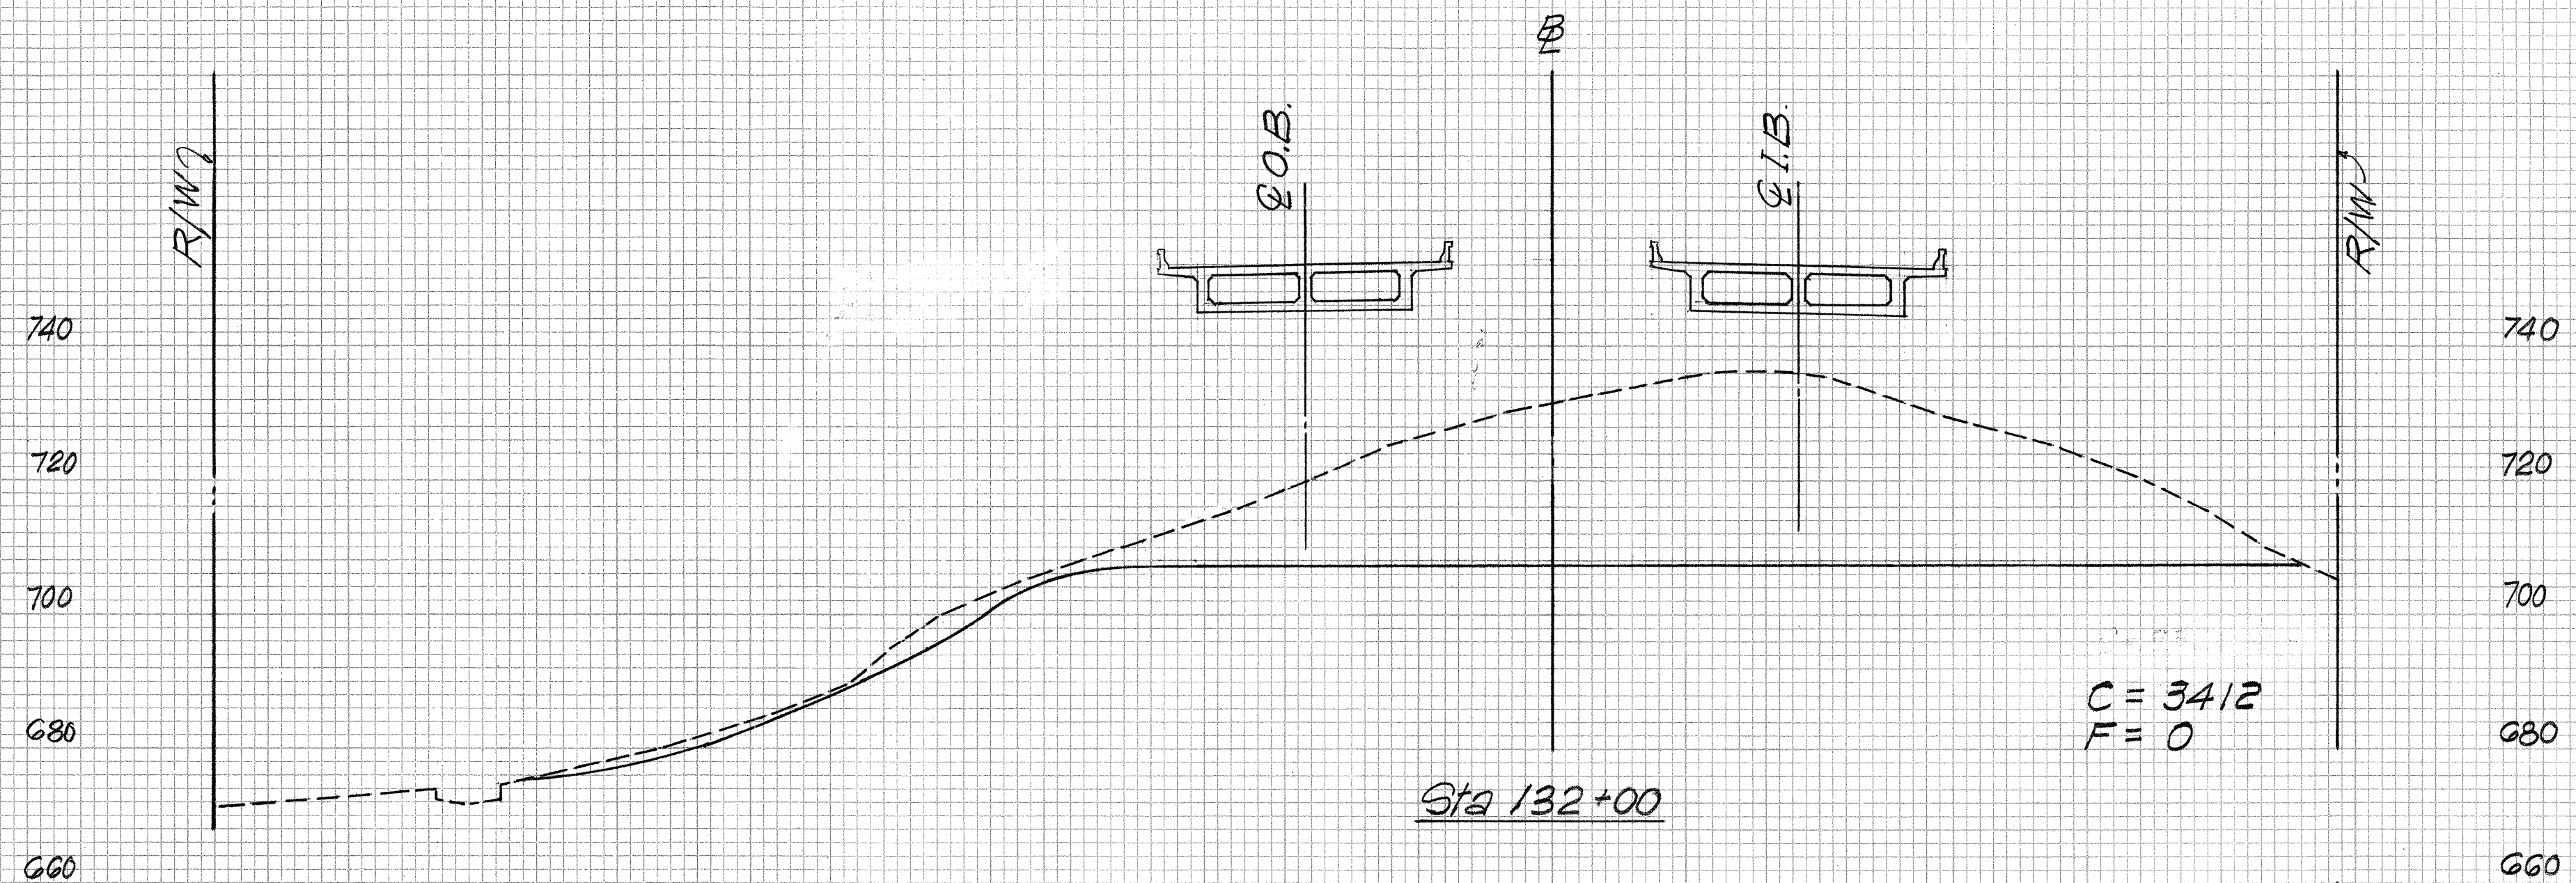

CROSS SECTIONS
B STA 131+00 TO STA 132+00
INTERSTATE ROUTE H-2
FA. 1, PROJ. NO. I-H2-1(10):G
Scale: Hor. 1" = 20'
Vert. 1" = 20' May, 1973

FINAL				
SURVEY	SURVEYED _____		BY _____	DATE _____
	PLOTTED _____			
NOTE BOOK	TEMPLATE _____			
	AREAS _____			
NO. _____	AREAS CHECKED _____			

ORIGINAL			
SURVEY	SURVEYED _____	BY _____	DATE _____
	PLOTTED _____		
NOTE BOOK	TEMPLATE _____		
	AREAS _____		
NO. _____	AREAS CHECKED _____		

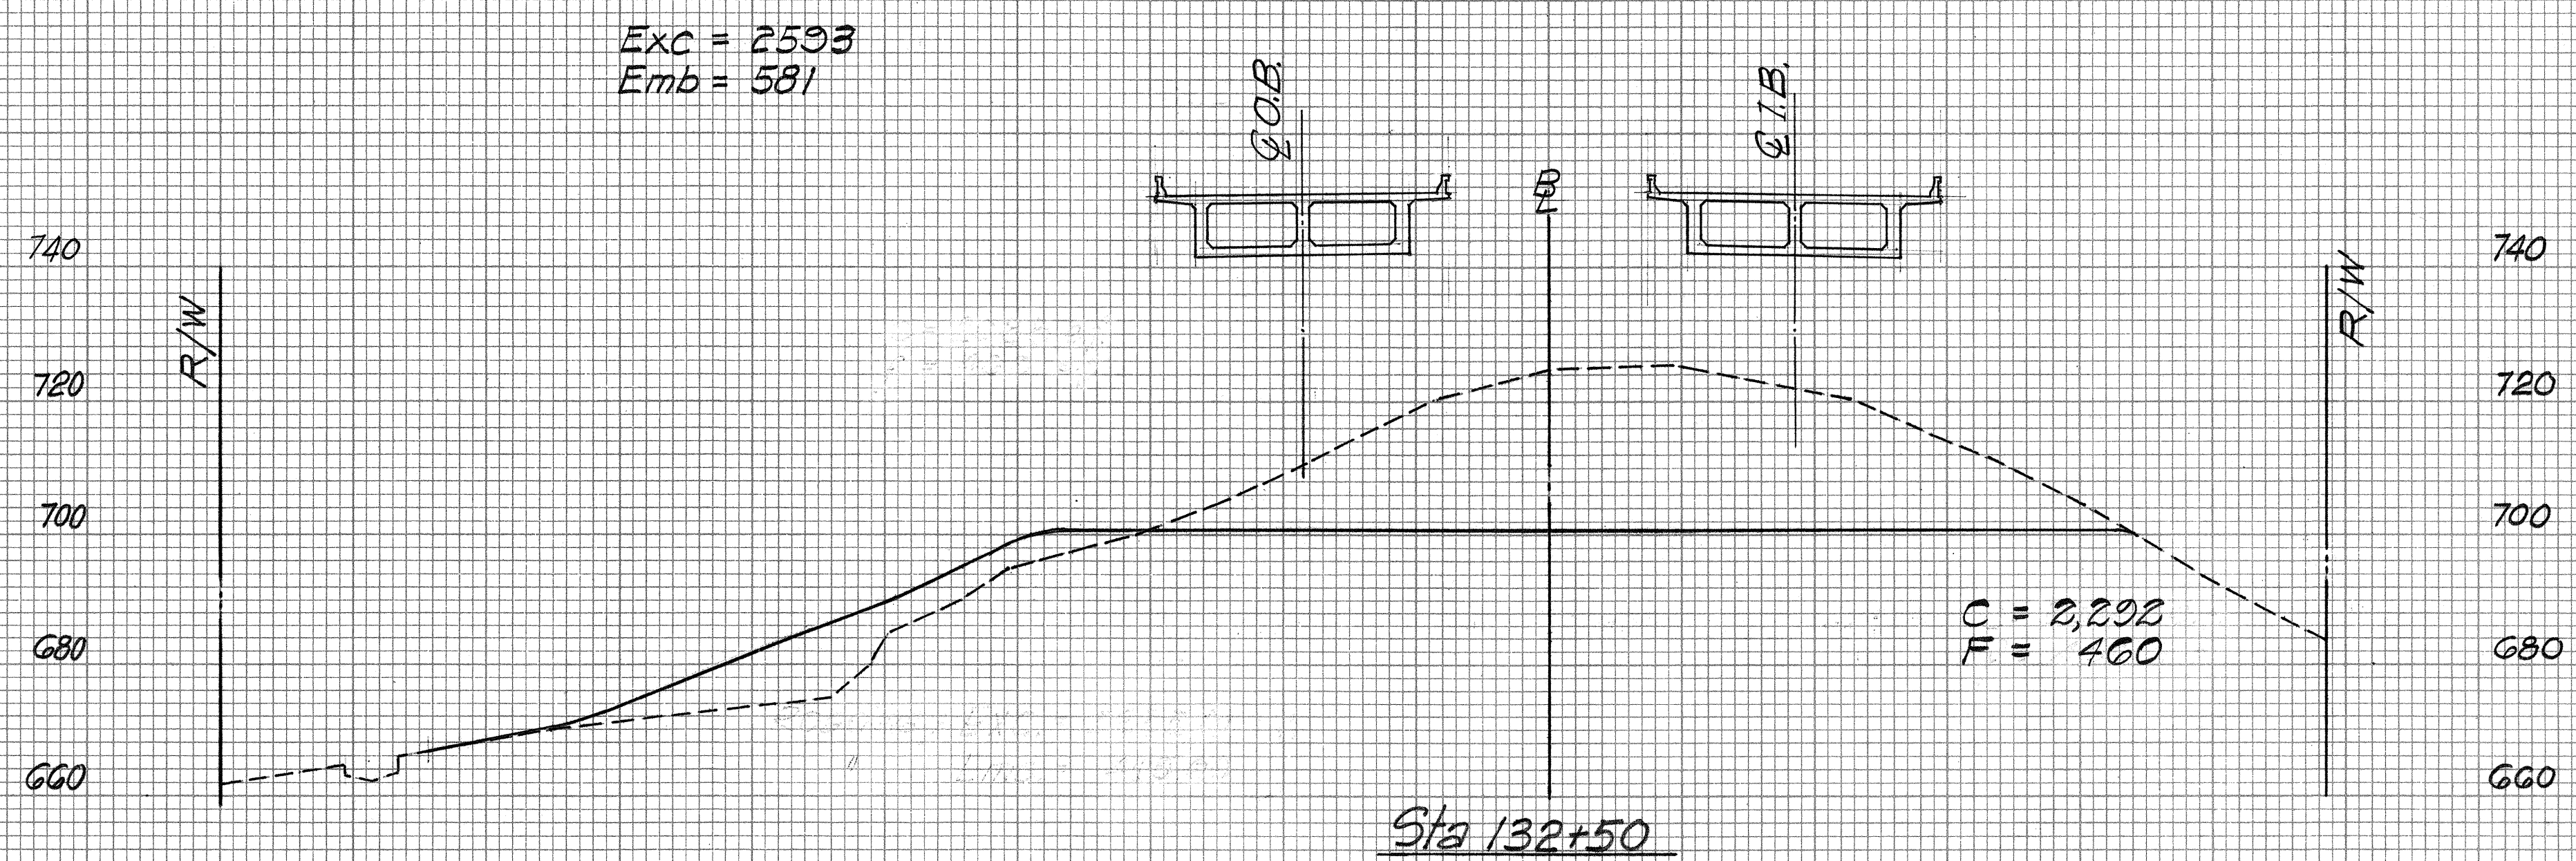

CROSS SECTIONS
B STA 132+50 TO STA 133+50
INTERSTATE ROUTE H-2
F.A.I. PROJ. NO. I- H2-1(10):G
Scale: Hor. 1" = 20'
Vert. 1" = 20' May, 1973

FINAL SURVEY NOTE BOOK	SURVEYED _____	BY _____	DATE _____
	PLOTTED _____		
	TEMPLATE _____		
	AREAS _____		
NO. _____	AREAS CHECKED _____		

ORIGINAL SURVEY	SURVEYED	BY	DATE
	PLOTTED		
NOTE BOOK	TEMPLATE		
NO.	AREAS CHECKED		




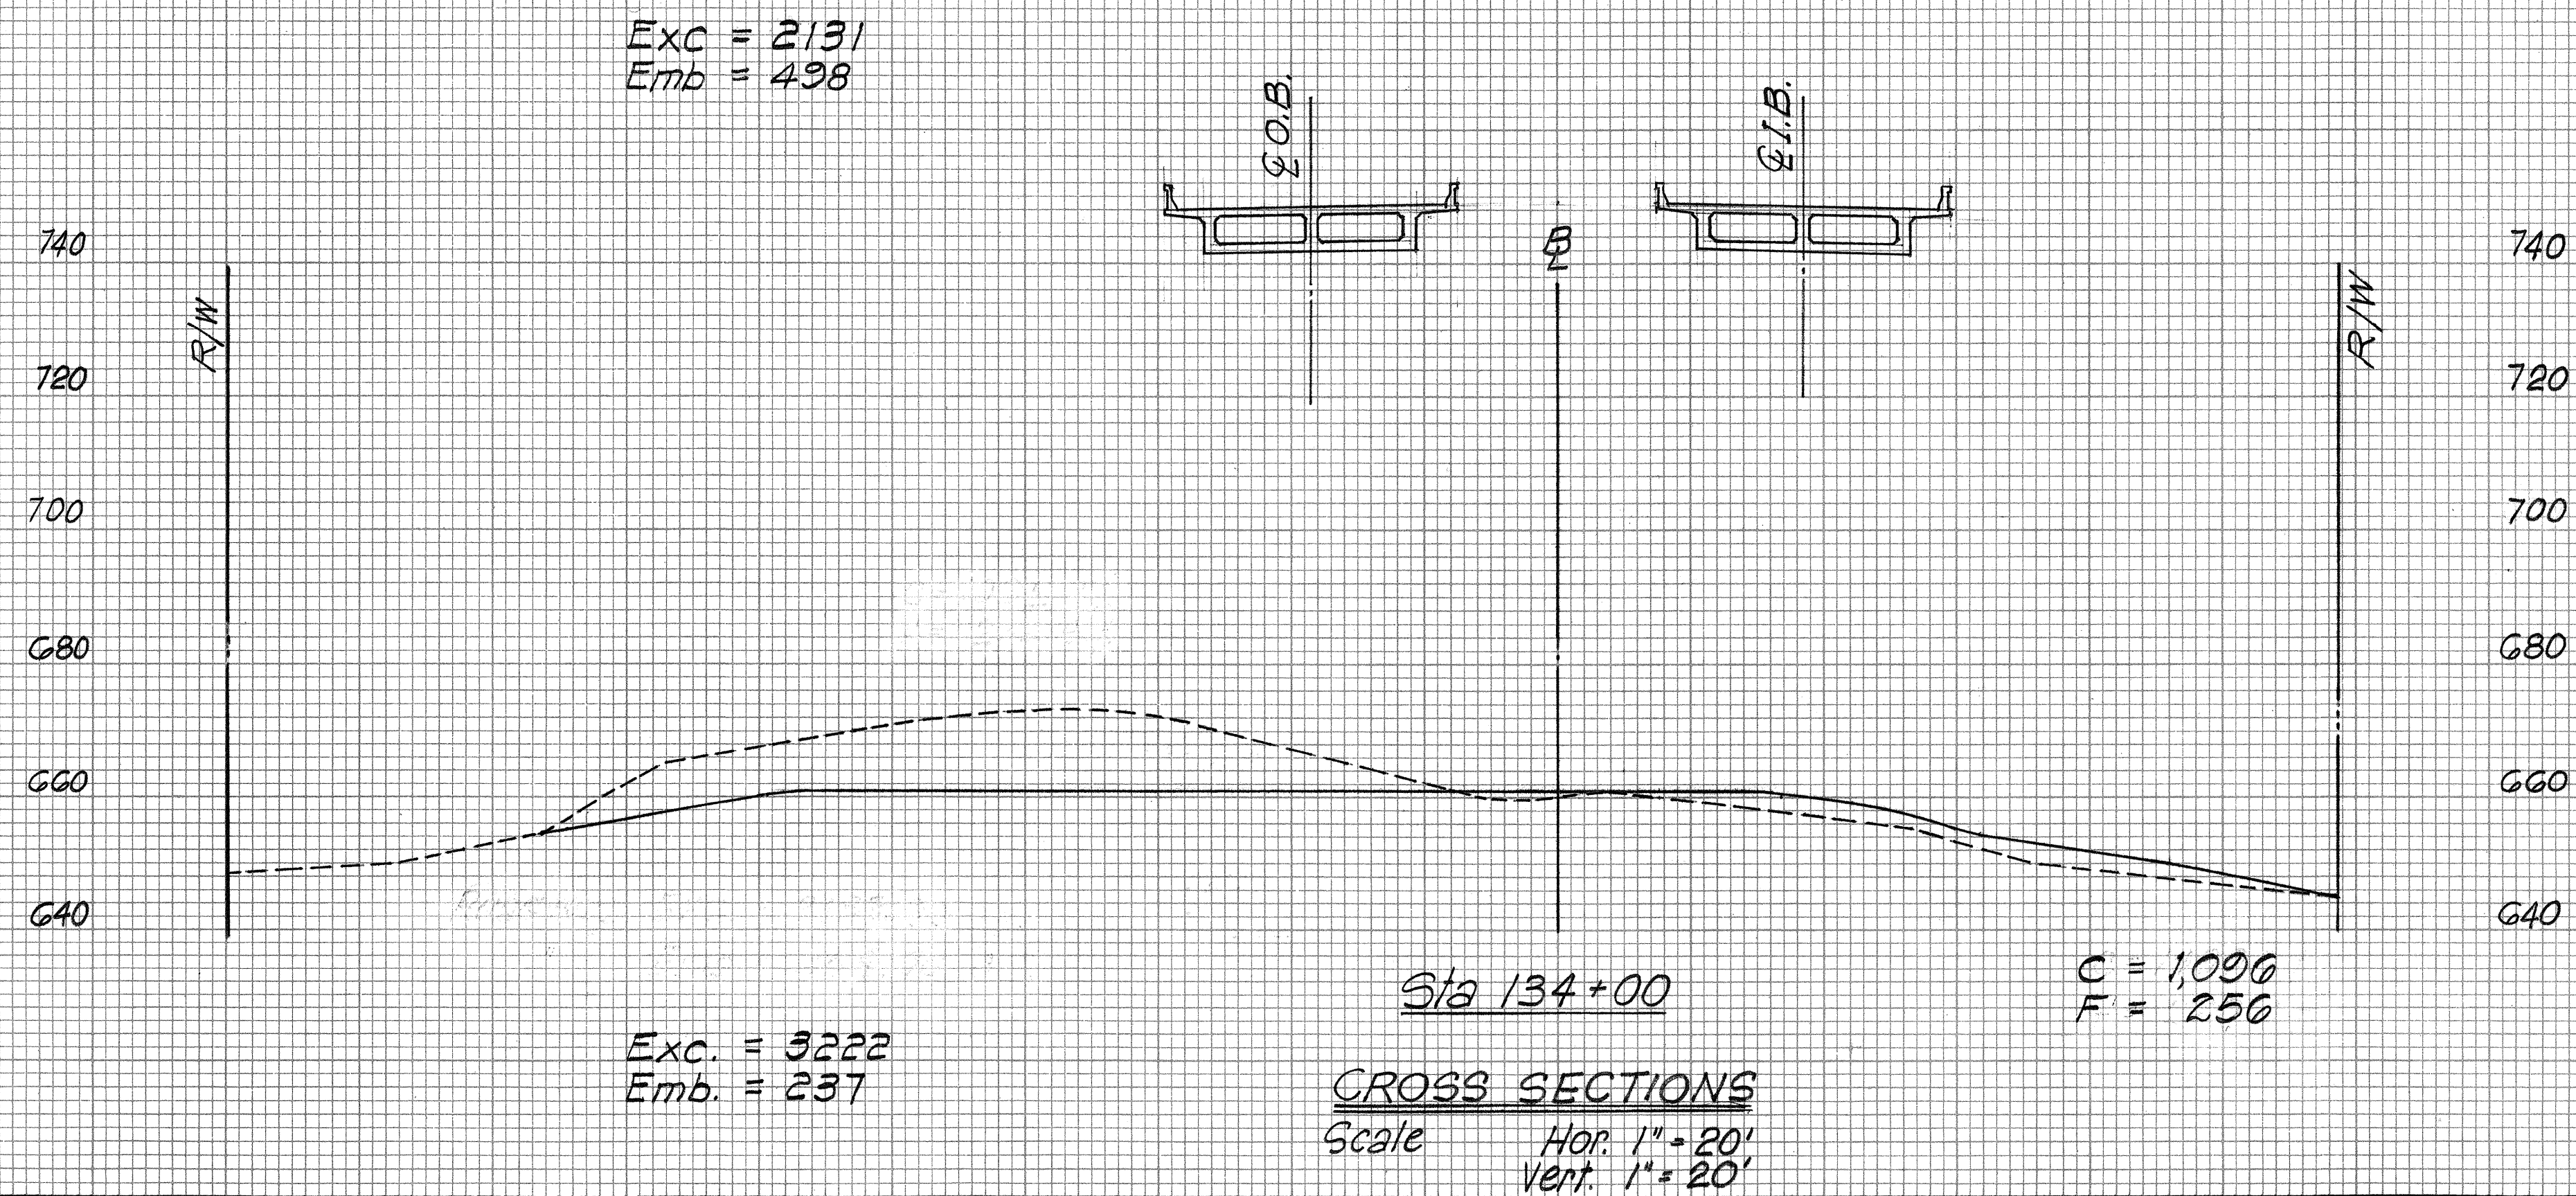


PLATE 3 - CROSS SECTION, F. A. S.
CLEARPRINT PAPER CO., S. F. CAL. NO. 1000H-3

FINAL SURVEY	DATE	BY
	SURVEYED	PLOTTED
	NOTE BOOK	TEMPLATE
	NO.	AREAS CHECKED

ORIGINAL SURVEY	DATE	BY
	SURVEYED	PLOTTED
	NOTE BOOK	TEMPLATE
	NO.	AREAS CHECKED

FED. ROAD DIST. NO.	STATE	FED. AID PROJ. NO.	FISCAL YEAR	SHEET NO.	TOTAL SHEETS
HAWAII	HAW.	I-H2-1(10):6	1973	96	104

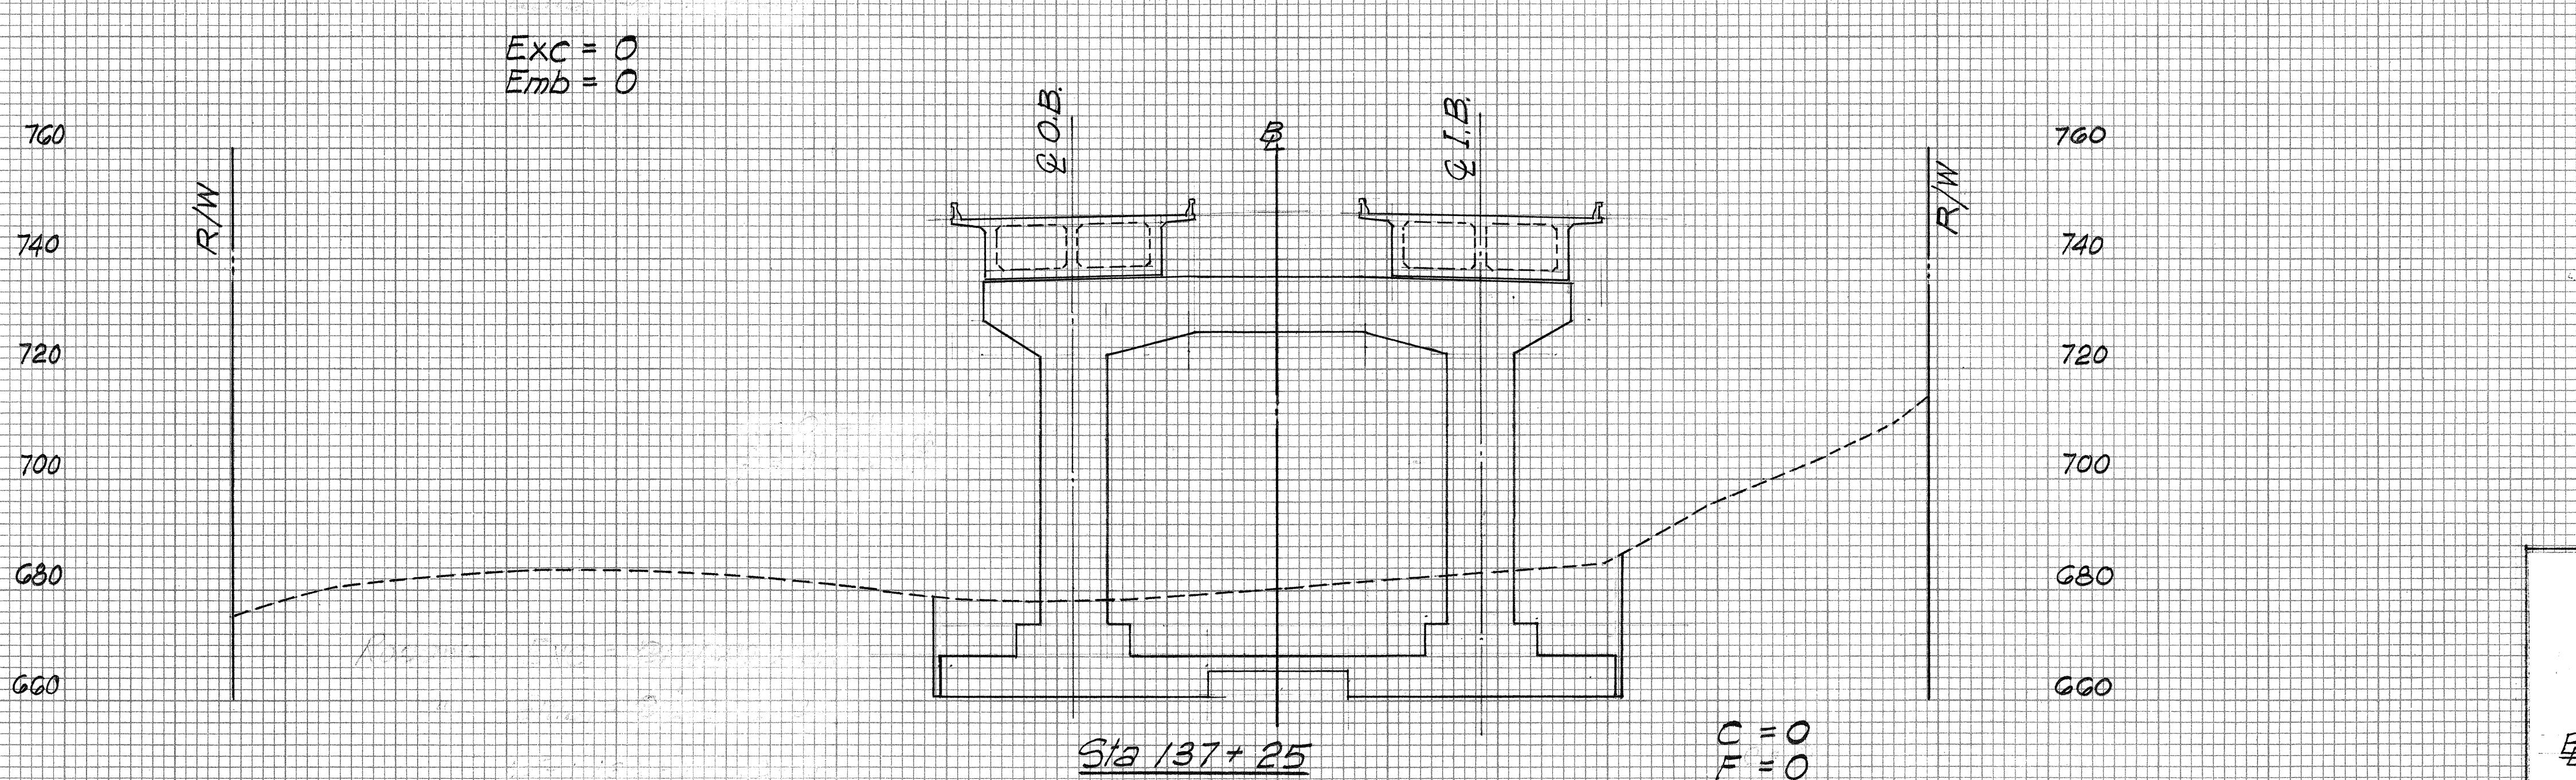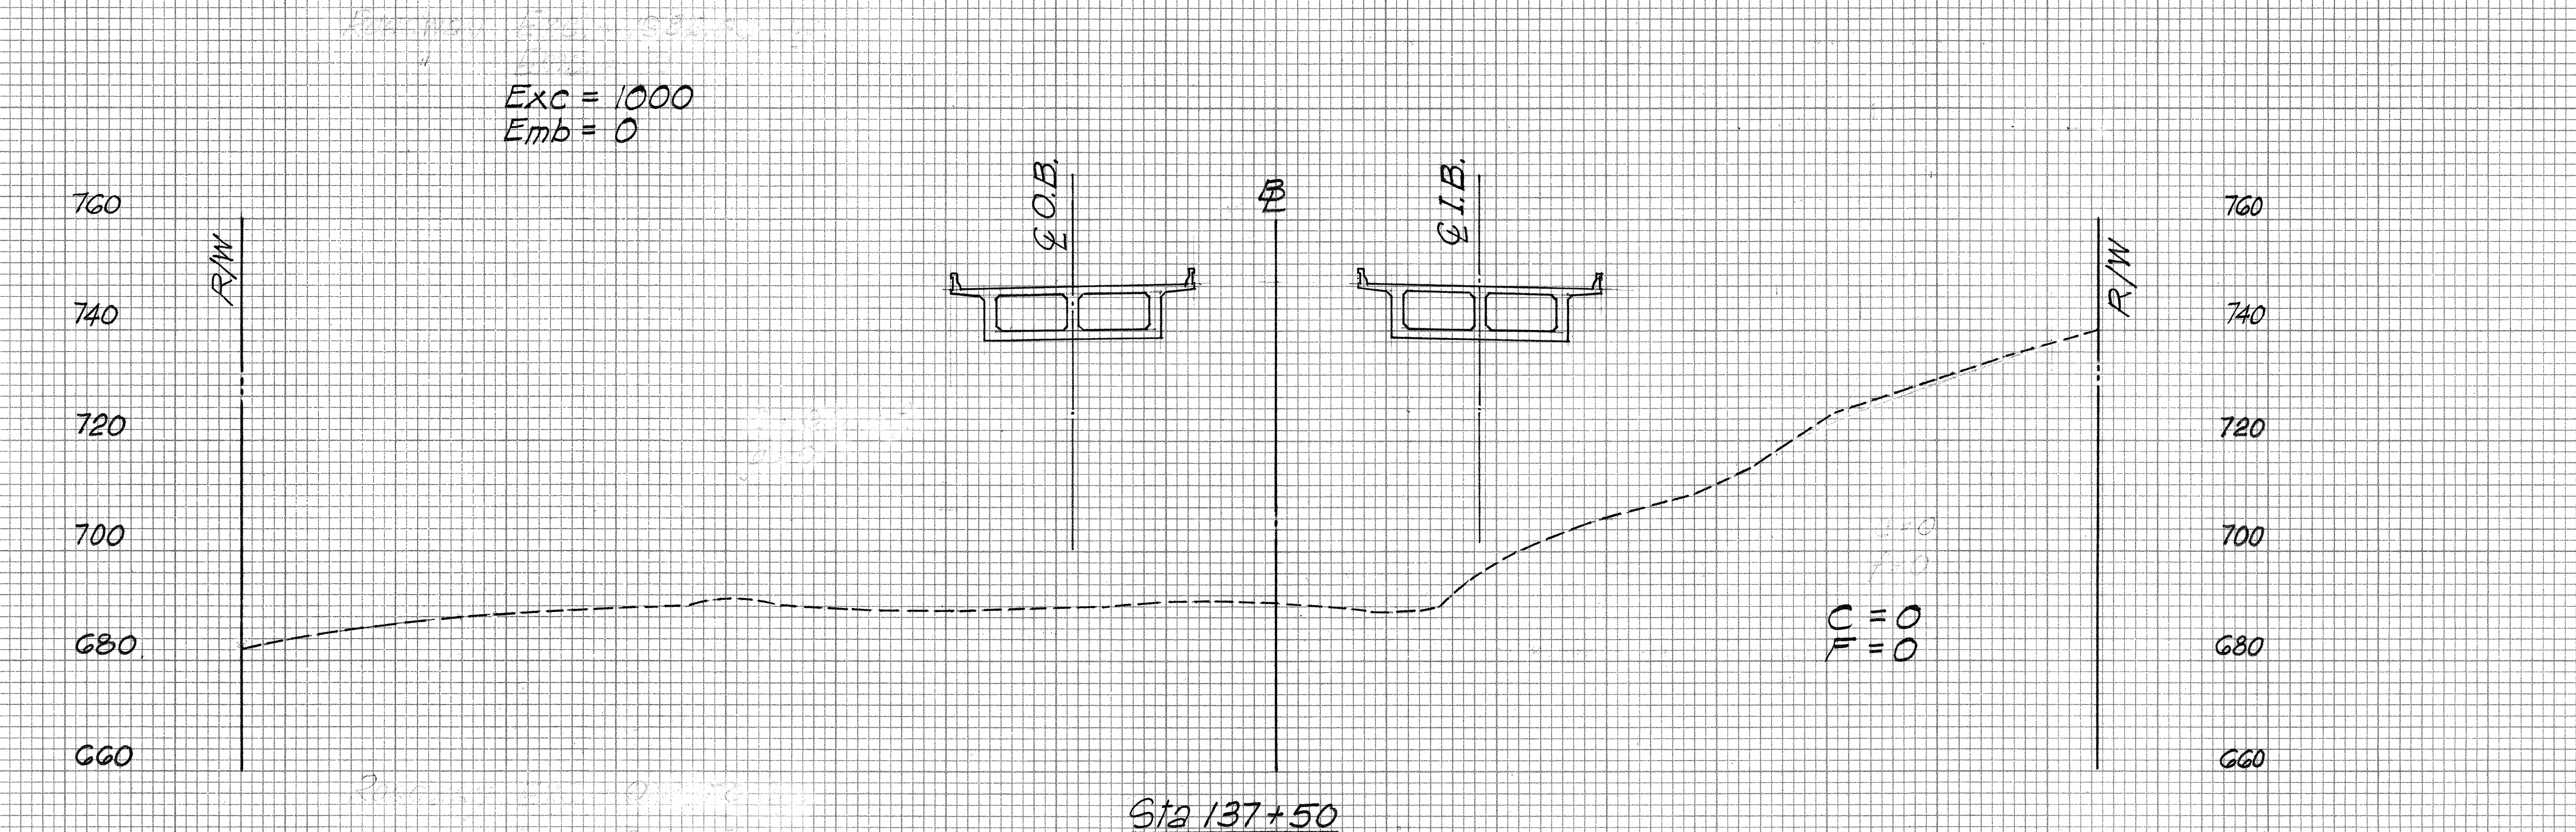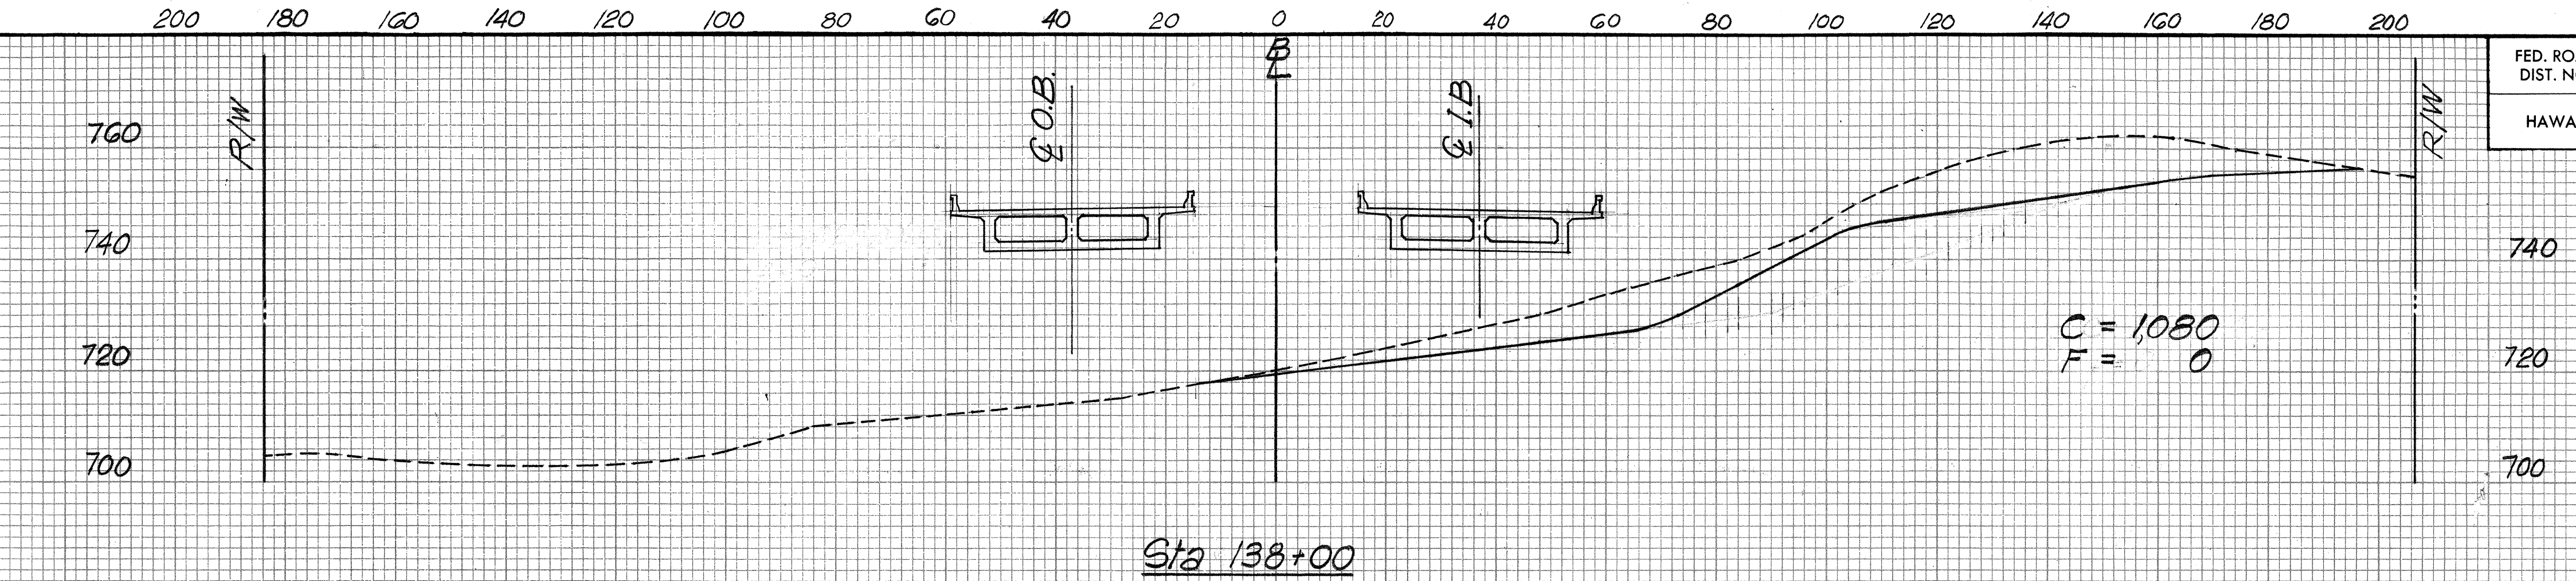

CROSS SECTIONS
Scale Hor. 1" = 20'
Vert. 1" = 20'

CROSS SECTIONS
B STA 137+25 TO STA 138+00
INTERSTATE ROUTE H-2
F.A.I. PROJ. NO. I-H2-1(10):6
Scale: Hor. 1" = 20'
Vert. 1" = 20' May, 1973

260 240 220 200 180 160 140 120 100 80 60 40 20 0 20 40 60 80 100 120 140 160 180 200

ORIGINAL SURVEY	SURVEYED _____	BY	DATE
NOTE BOOK	PLOTTED _____		
NO.	TEMPLATE _____		
	AREAS CHECKED _____		

