


FED. ROAD DIST. NO.	STATE	FED. AID PROJ. NO.	FISCAL YEAR	SHEET NO.	TOTAL SHEETS
HAWAII	HAW.	I-H2-1(10):6	1973	6	104

NOTE

- Concrete Guard Rail, Type 4F & 4G
 - For cross-section details and offset, refer to sheet no. 13.
 - For gutter and shelf transition details, refer to sheet no. 14 & 15.
 - For profile of the top of concrete guard rail, refer to sheet no. 15.
- For P.C.C. pavement construction details, refer to sheet no. 18.
- For installation details of reference survey monuments, refer to sheet no. 20.
- For installation details of 6' high chain link fence and gate, refer to sheet no. 21 and Section 607 of the Special Provisions.
- For listing of various items of work, refer to sheet no. 12.

B.M. #1 (599-14, DISK)
Elev. = 802.38'
443' 9/8 Lt. From
Sta. 126+06

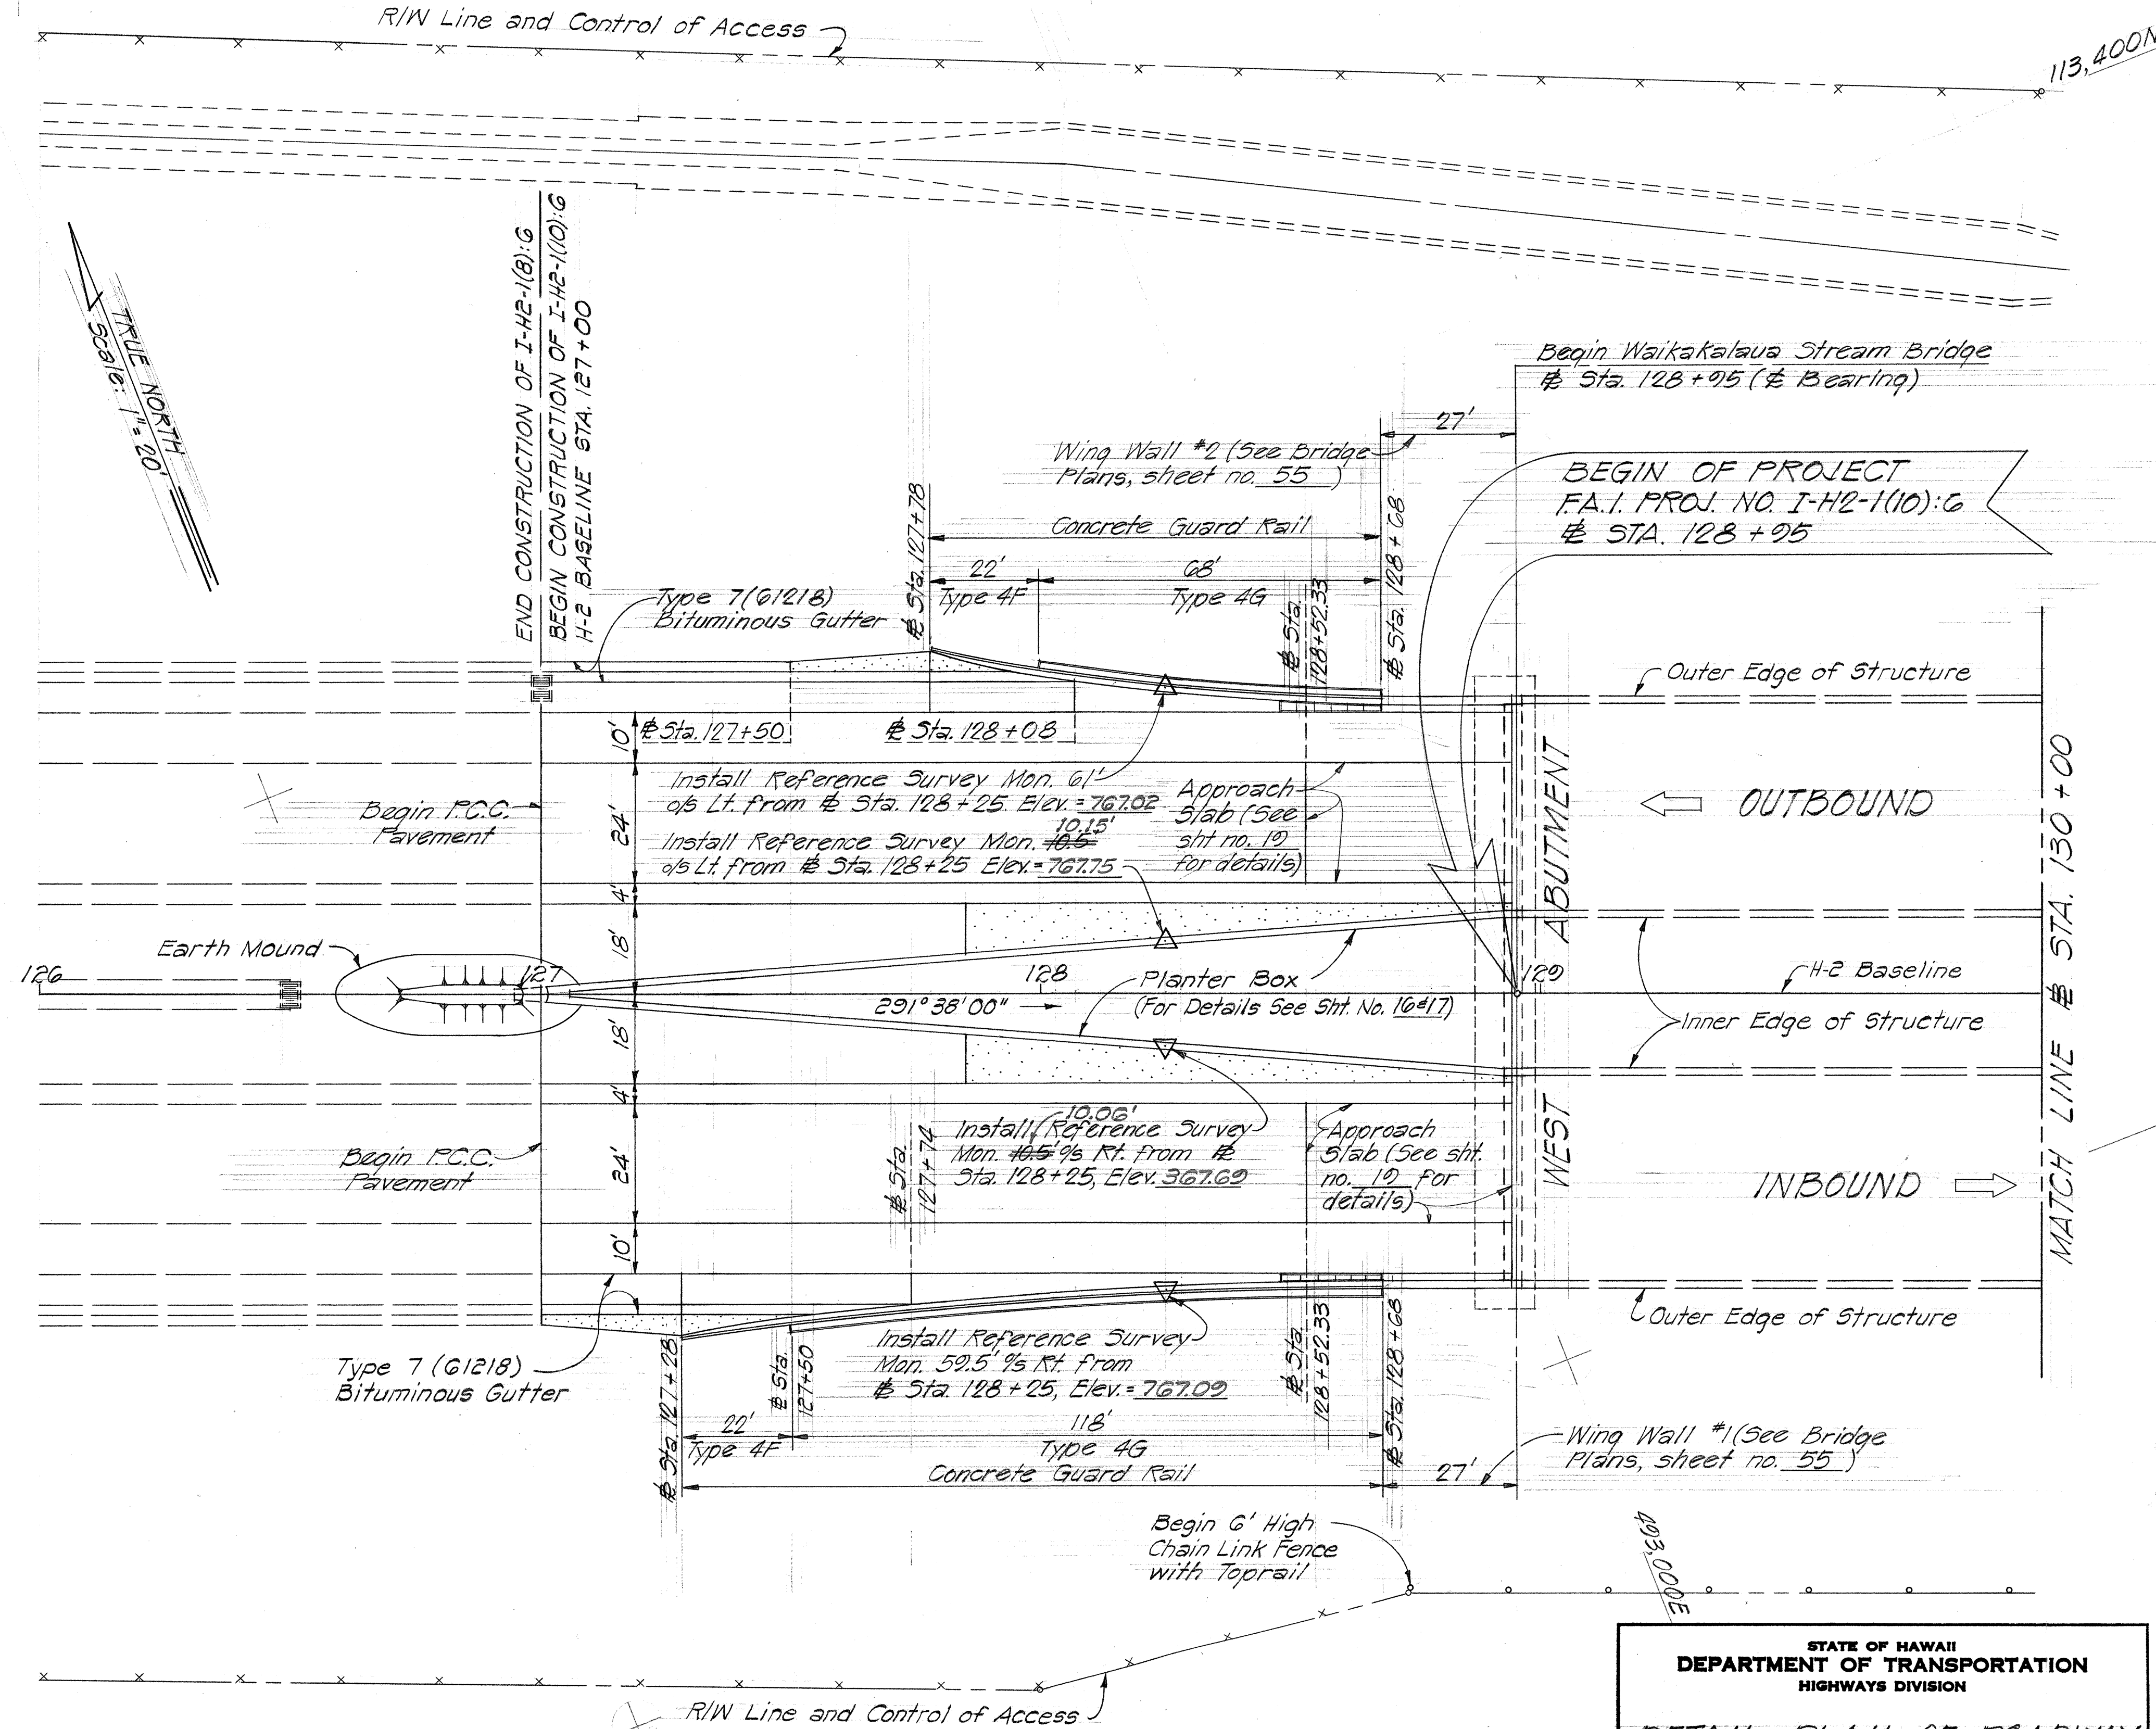

STATE OF HAWAII
DEPARTMENT OF TRANSPORTATION
HIGHWAYS DIVISION

DETAIL PLAN OF ROADWAY

INTERSTATE ROUTE H-2
WAIKAKALAUA STREAM BRIDGE
F.A.I. PROJ. NO. I-H2-1(10):6


Scale: 1" = 20' Date: June 1973

SHEET No. 1 OF 3 SHEETS

ORIGINAL PLAN	SURVEY PLOTTED BY	DATE
	DRAWN BY	"
NOTE BOOK	TRACED BY	"
	DESIGNED BY	"
	QUANTITIES BY	"
	CHECKED BY	"
No.		



FED. ROAD DIST. NO.	STATE	FED. AID PROJ. NO.	FISCAL YEAR	SHEET NO.	TOTAL SHEETS
HAWAII	HAW.	I-H2-1(10)-6	1973	8	104

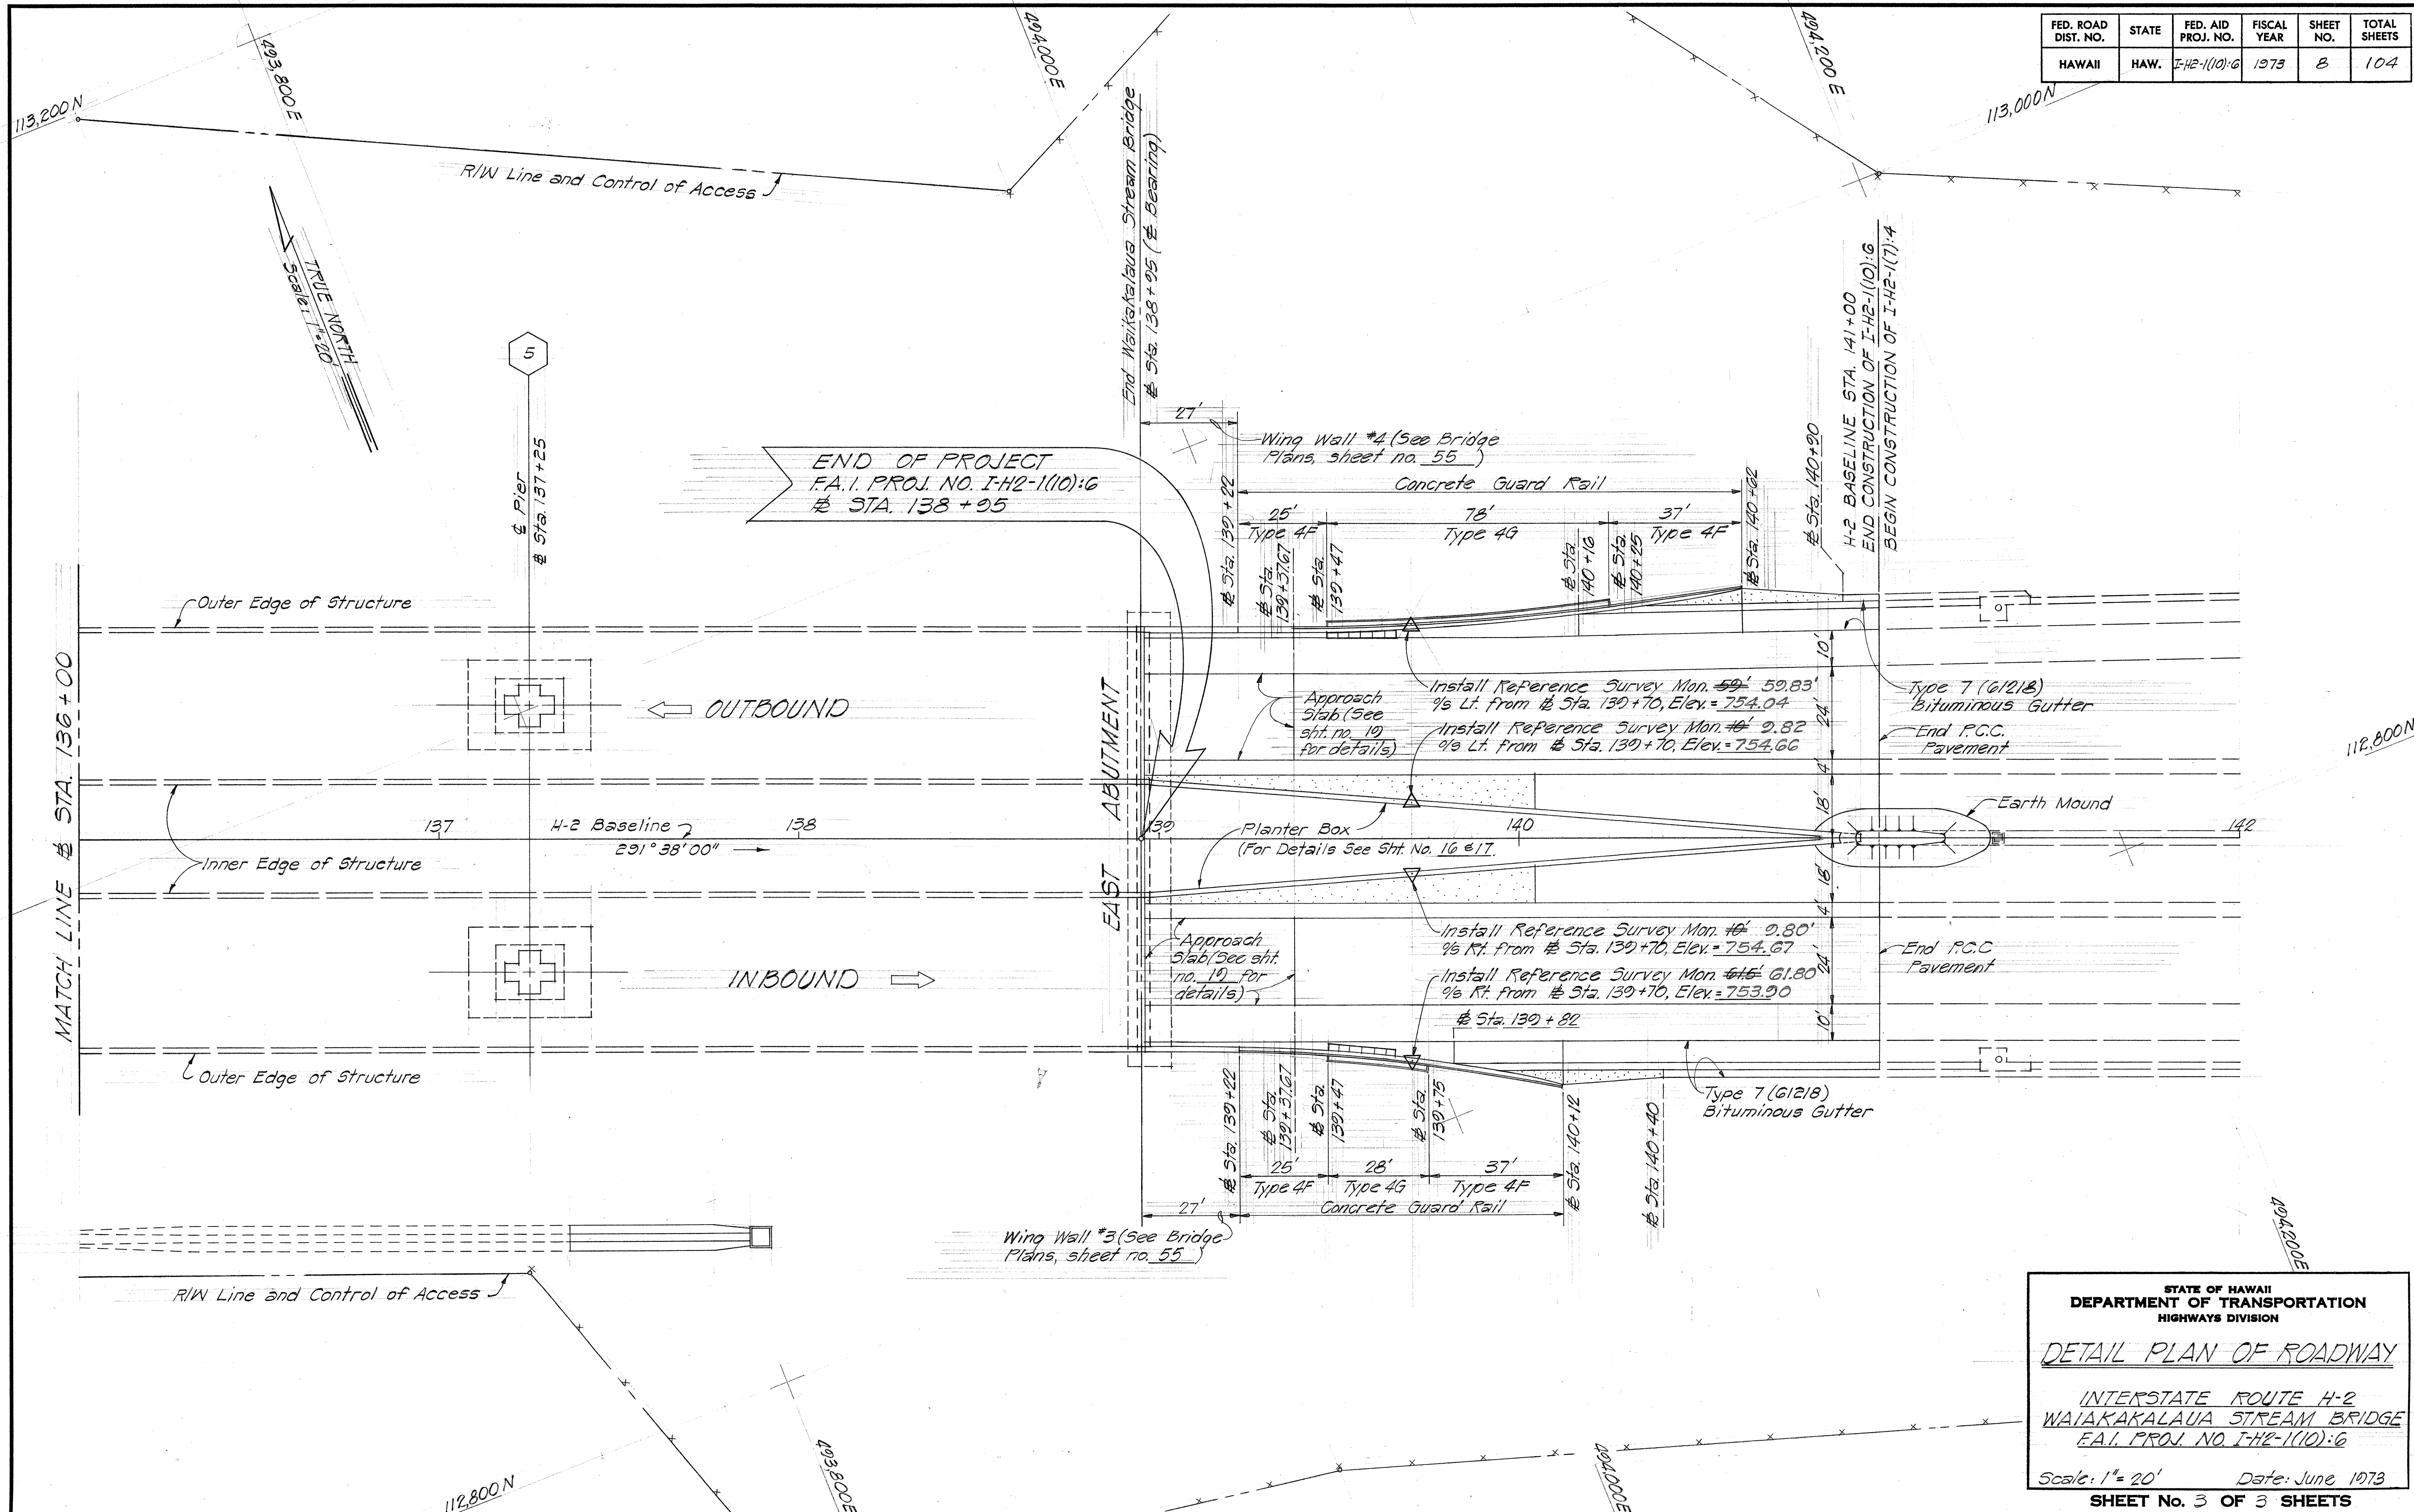

STATE OF HAWAII
DEPARTMENT OF TRANSPORTATION
HIGHWAYS DIVISION

DETAIL PLAN OF ROADWAY

INTERSTATE ROUTE H-2
WAIKAKALAUA STREAM BRIDGE
F.A.I. PROJ. NO. I-H2-1(10)-6

Scale: 1" = 20' Date: June 1973

SHEET No. 3 OF 3 SHEETS

DATE	_____
SURVEY PLOTTED BY	_____
DRAWN BY	_____
TRACED BY	_____
NOTED BY	_____
CHECKED BY	_____
NO.	_____