


PLAN
 SURVEYED
 NOTE BOOK
 NO.

PROFILE
 SURVEYED
 NOTE BOOK
 NO.

FED. ROAD DIST. NO.	STATE	FED. AID PROJ. NO.	FISCAL YEAR	SHEET NO.	TOTAL SHEETS
HAWAII	HAW.	I-H2-1(10):6	1973	4	104

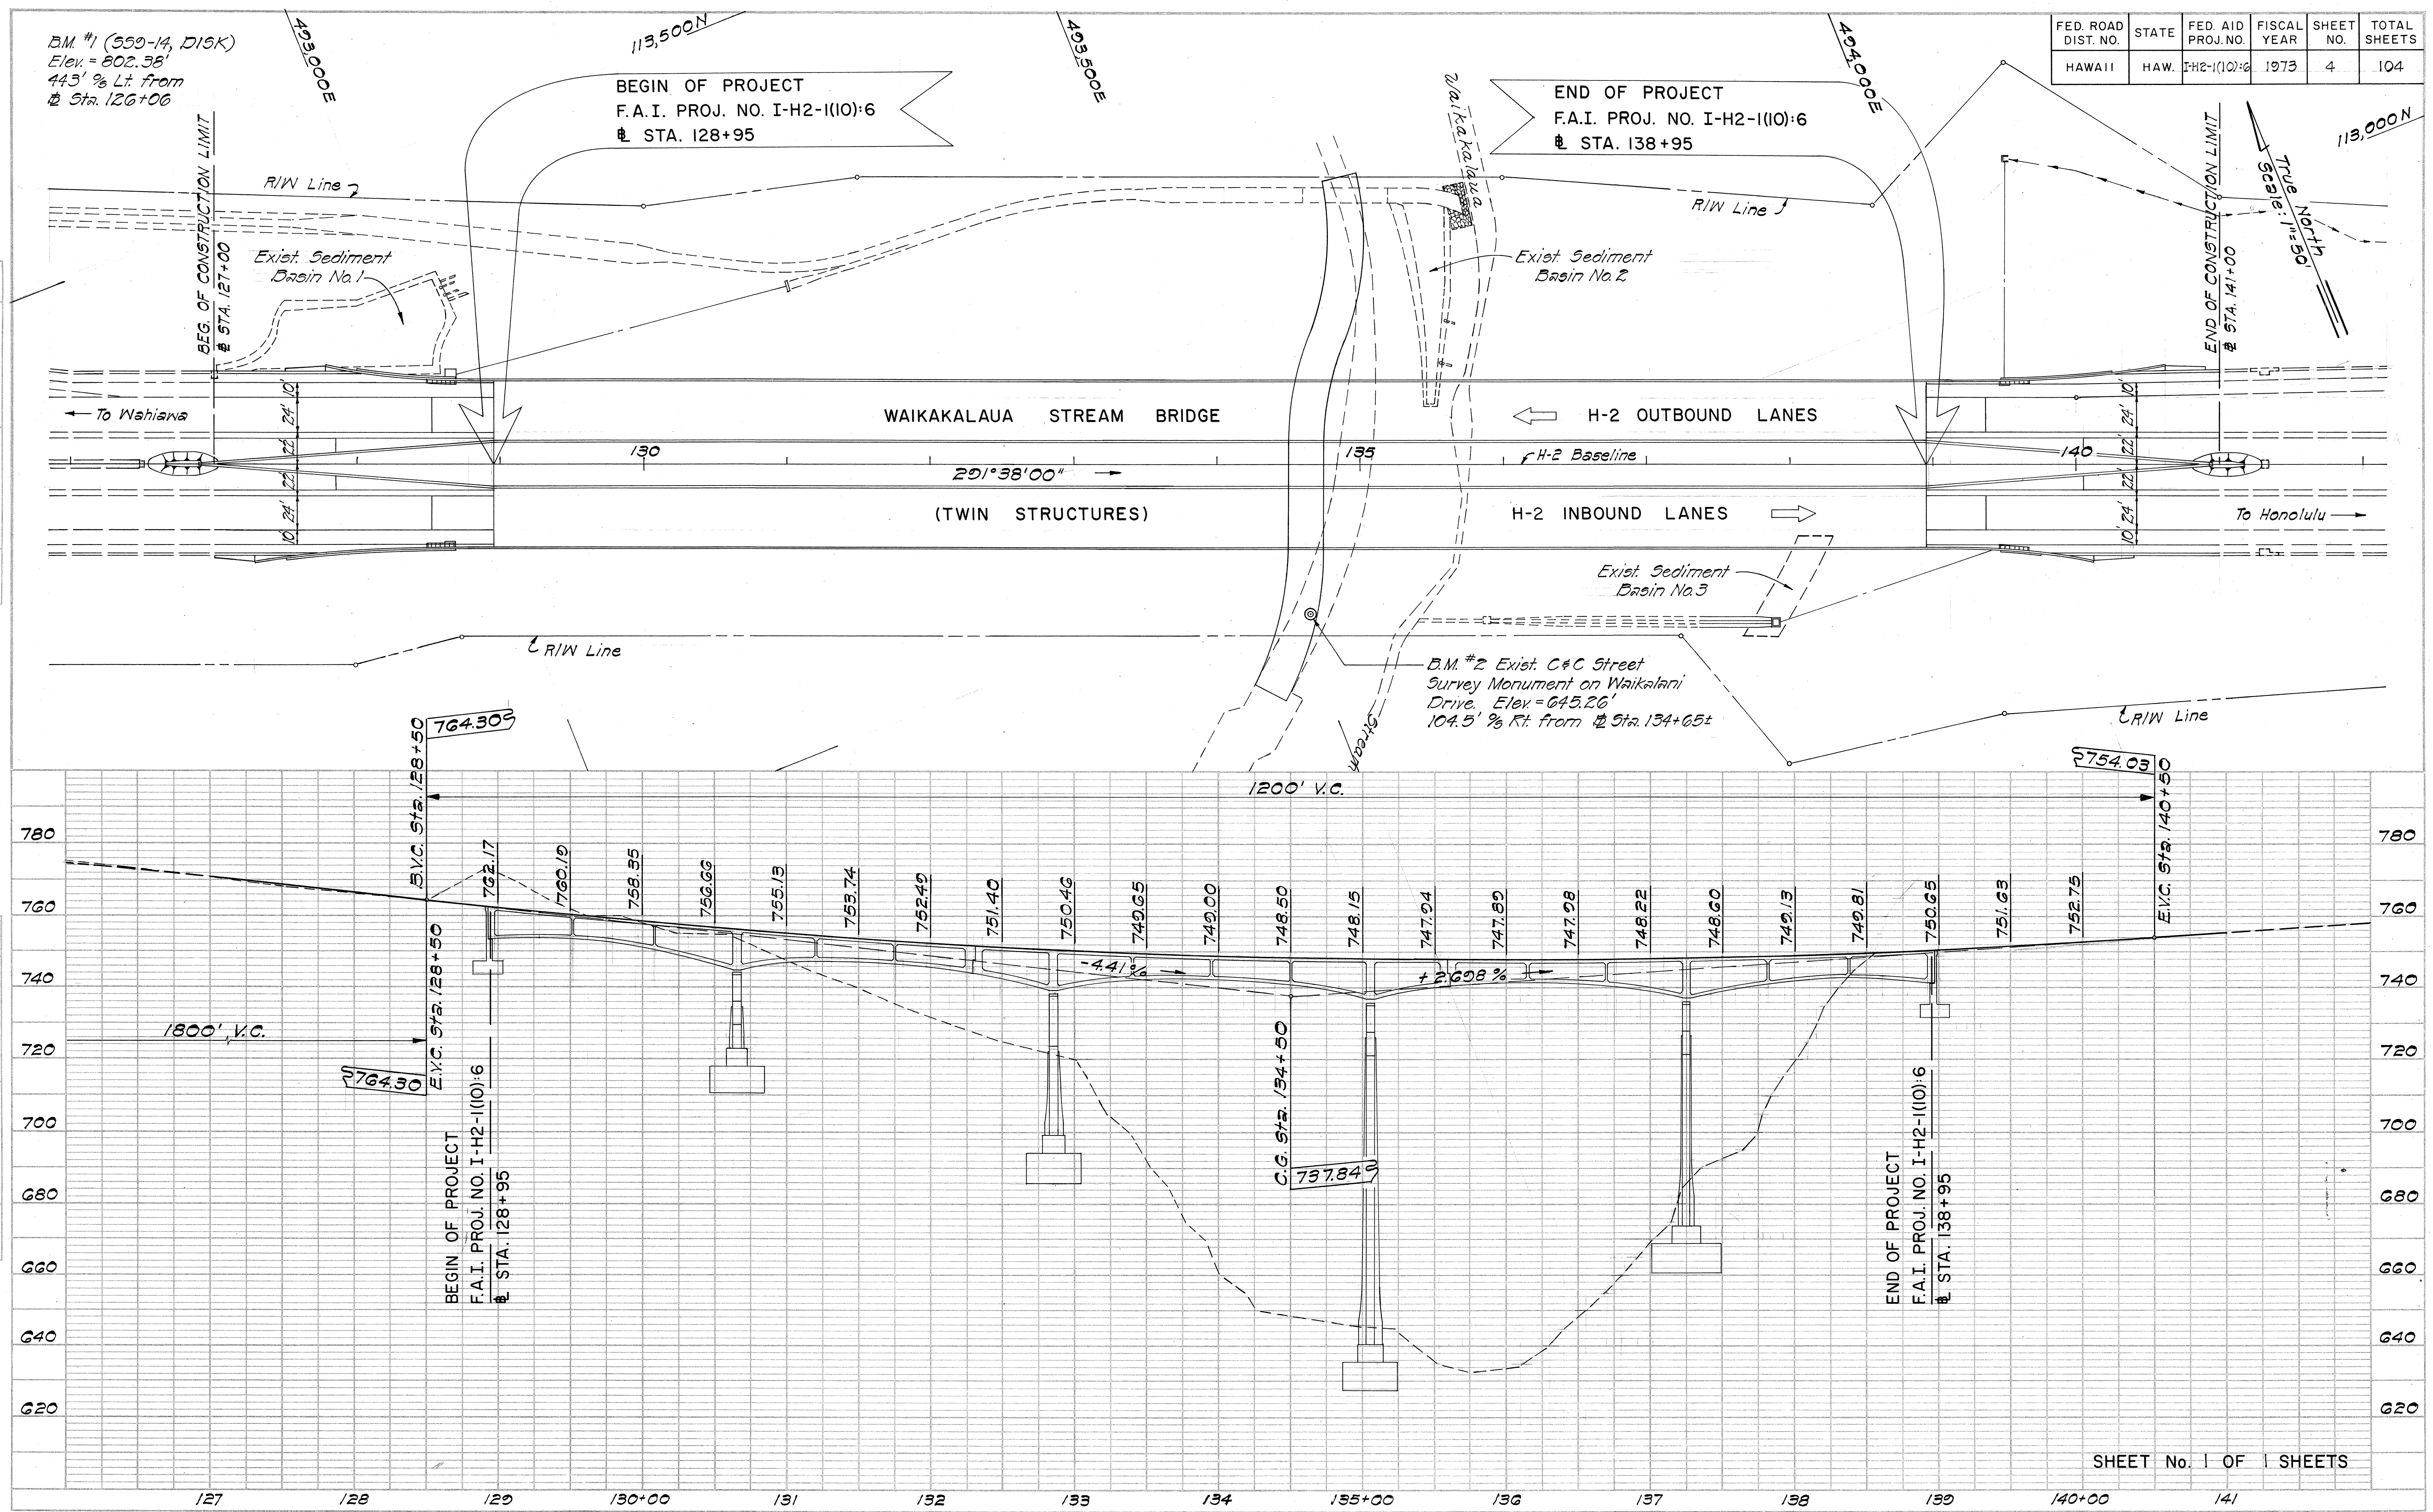

SHEET No. 1 OF 1 SHEETS