


FED. ROAD DIST. NO.	STATE	FED. AID PROJ. NO.	FISCAL YEAR	SHEET NO.	TOTAL SHEETS
HAWAII	HAW.	I-H2-1(10):6	1973	5	104

DATE	BY	CHECKED
10/1/73	W. J. HARRIS	W. J. HARRIS
NO.	NO.	NO.
101	101	101

DATE	BY	CHECKED
10/1/73	W. J. HARRIS	W. J. HARRIS
NO.	NO.	NO.
101	101	101

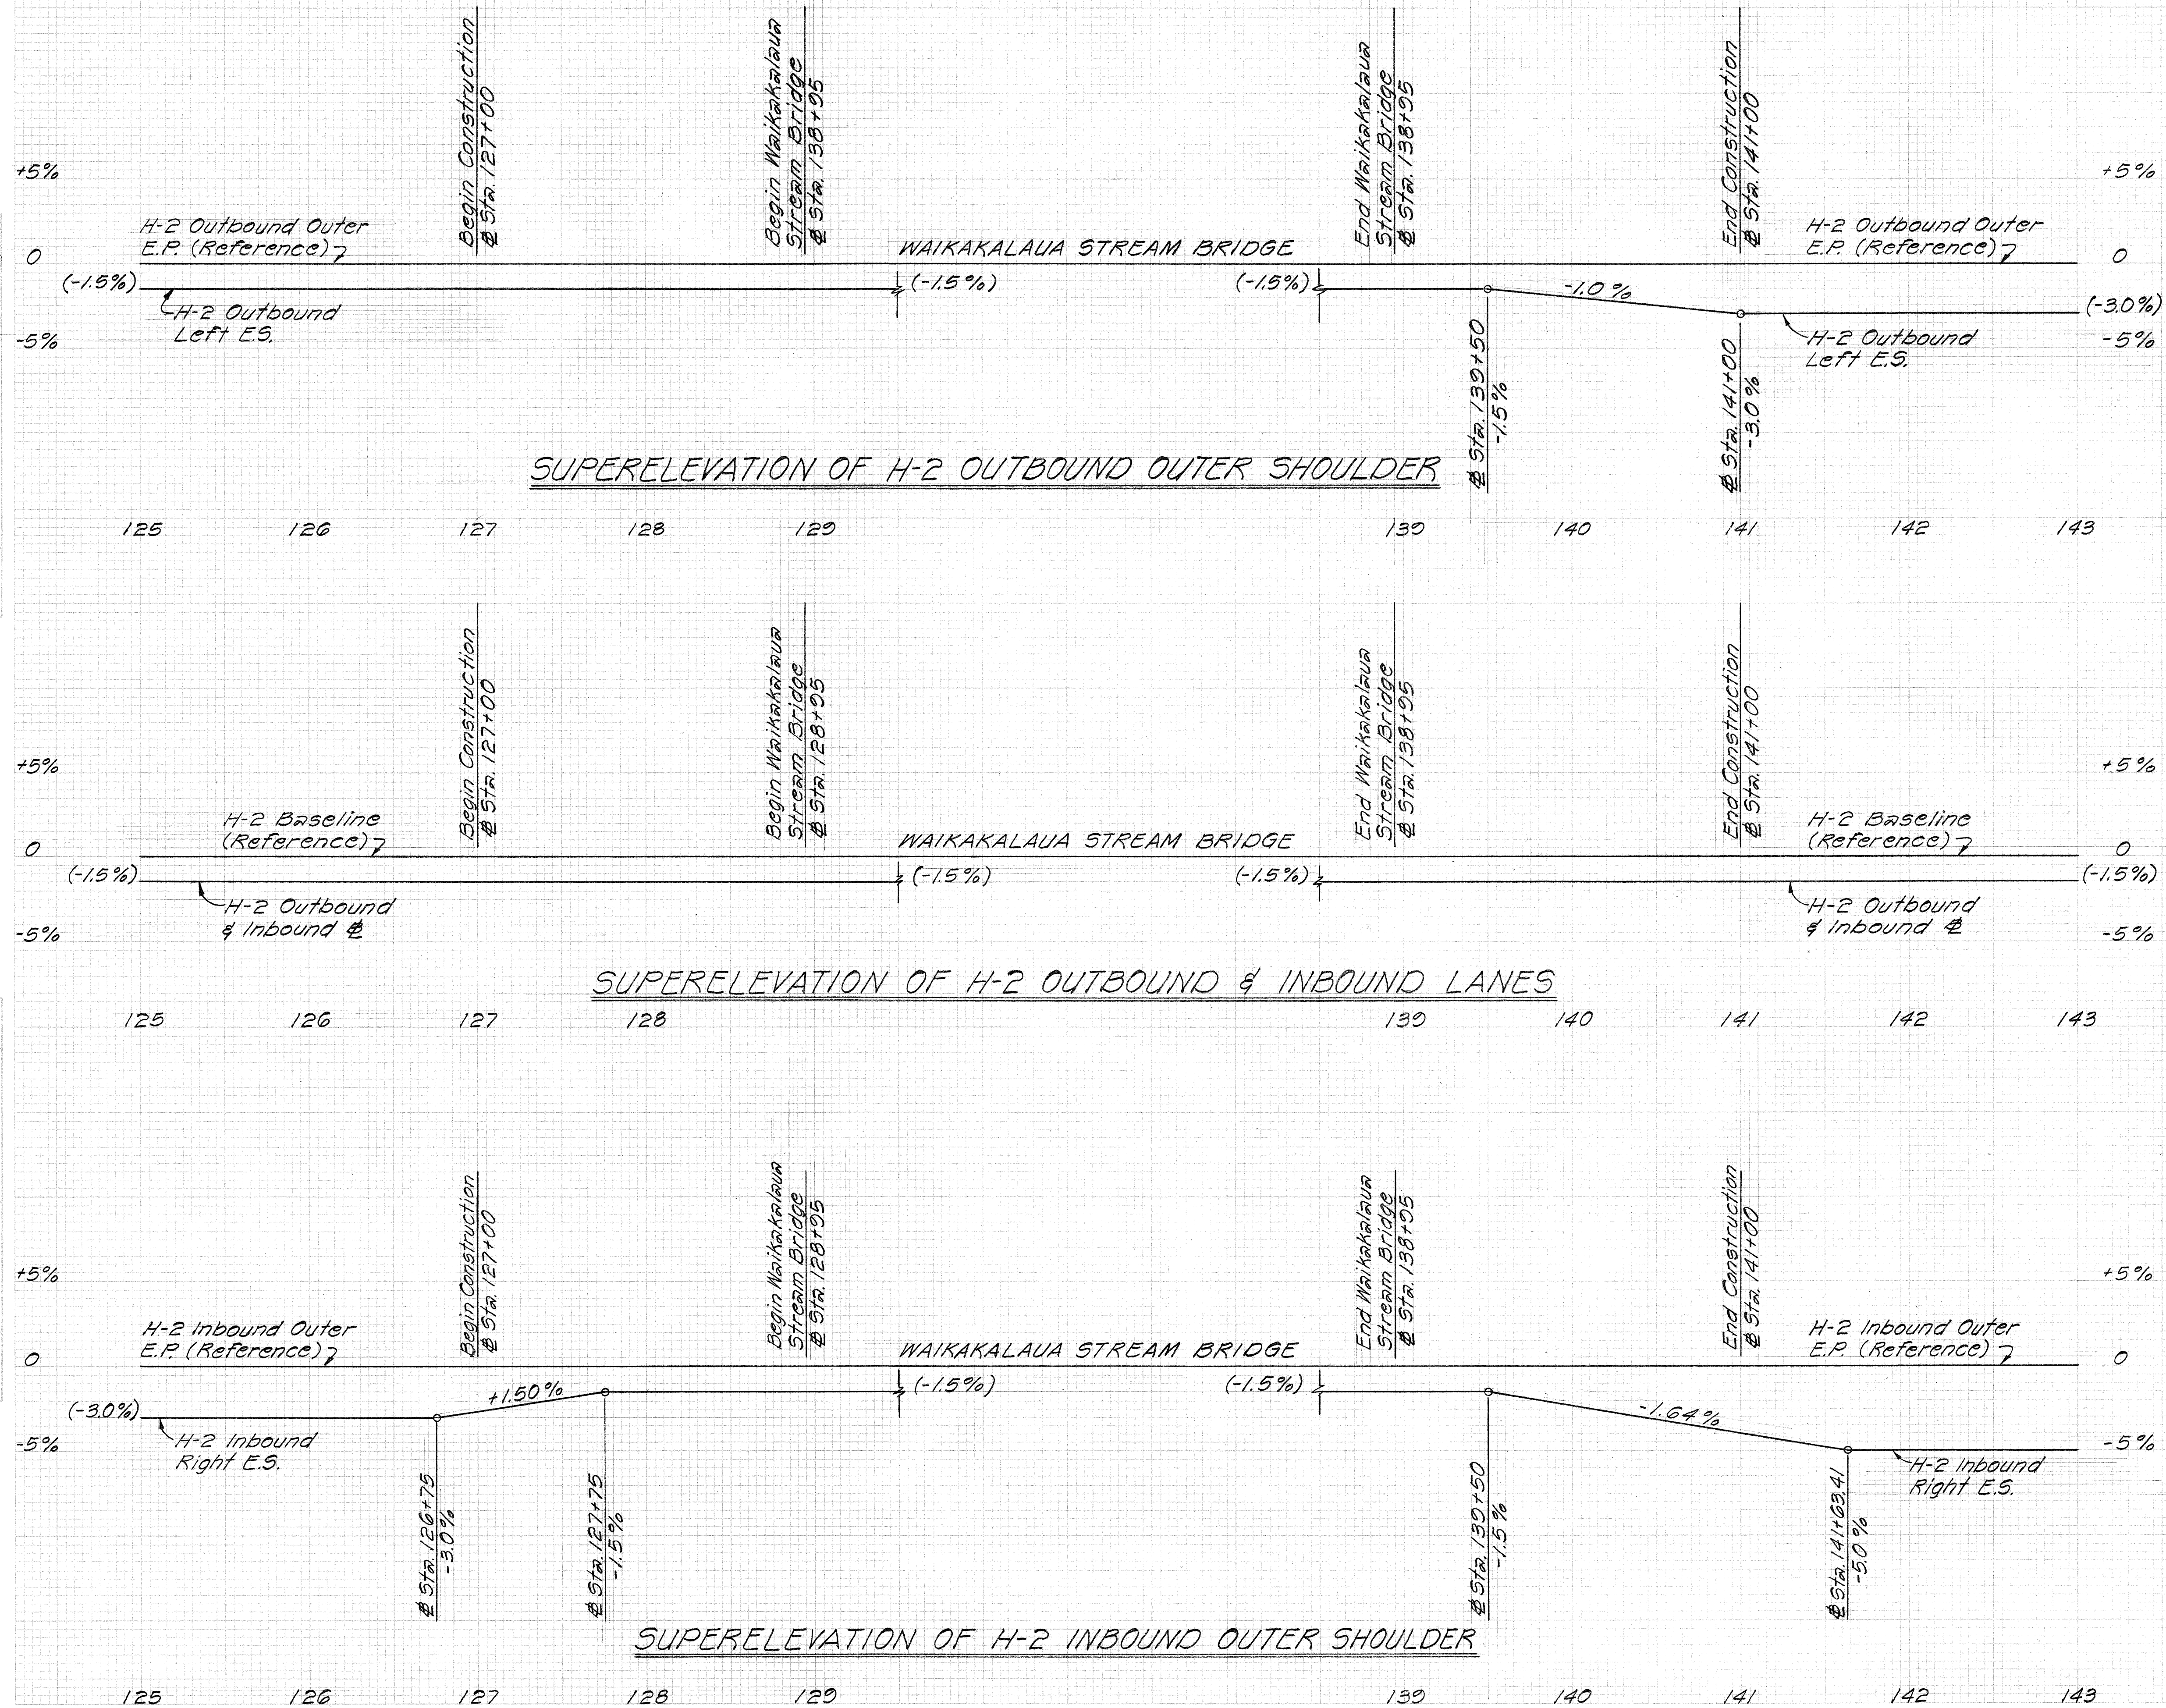

STATE OF HAWAII
DEPARTMENT OF TRANSPORTATION
HIGHWAYS DIVISION

SUPERELEVATION DIAGRAMS

INTERSTATE ROUTE H-2
WAIKAKALAU STREAM BRIDGE
E.A.I. Proj. No. I-H2-1(10):6

Scale: Horiz. 1" = 50'
Vert. 1" = 5%

Date: June 1973

SHEET NO. 1 OF 5 SHEETS