

INDEX TO DRAWINGS	
SHEET NO.	DESCRIPTION
1	TITLE SHEET
2	GENERAL NOTES, ABBREVIATIONS, AND SYMBOLS
3	TYPICAL SECTION
4	PLAN & PROFILE
5	SUPERELEVATION DIAGRAMS
6-8	DETAIL PLAN OF ROADWAY
9-10	WAIKALANI DRIVE EXTENSION PLANS
11	EROSION CONTROL
12-27	MISC. & STANDARD DETAILS
28-30	TRAFFIC PLANS & DETAILS
31-41	DRAINAGE PLANS & DETAILS
*42-90	WAIKAKALAUA STREAM BRIDGE
91-98	CROSS SECTIONS
99-104	WAIKAKALAUA ACCESS ROAD

* PLAN SHEET NOS. C.O.72 S-1, C.O.72 S-2, C.O.72 S-3 & C.O.84R S-1 ARE SUPPLEMENTARY SHEETS TO THIS PROJECT.

TOTAL SHEET COUNT AFTER "AS-BUILT" POSTINGS: 108 SHEETS

STATE OF HAWAII

DEPARTMENT OF TRANSPORTATION

HIGHWAYS DIVISION

HONOLULU, HAWAII

"AS-BUILT"

PLANS FOR

CONSTRUCTION OF A PORTION OF



INTERSTATE ROUTE H-2

WAIKAKALAUA STREAM BRIDGE

FED. AID INTERSTATE PROJ. NO. I-H2-I(10):6

DISTRICT OF EWA

ISLAND OF OAHU

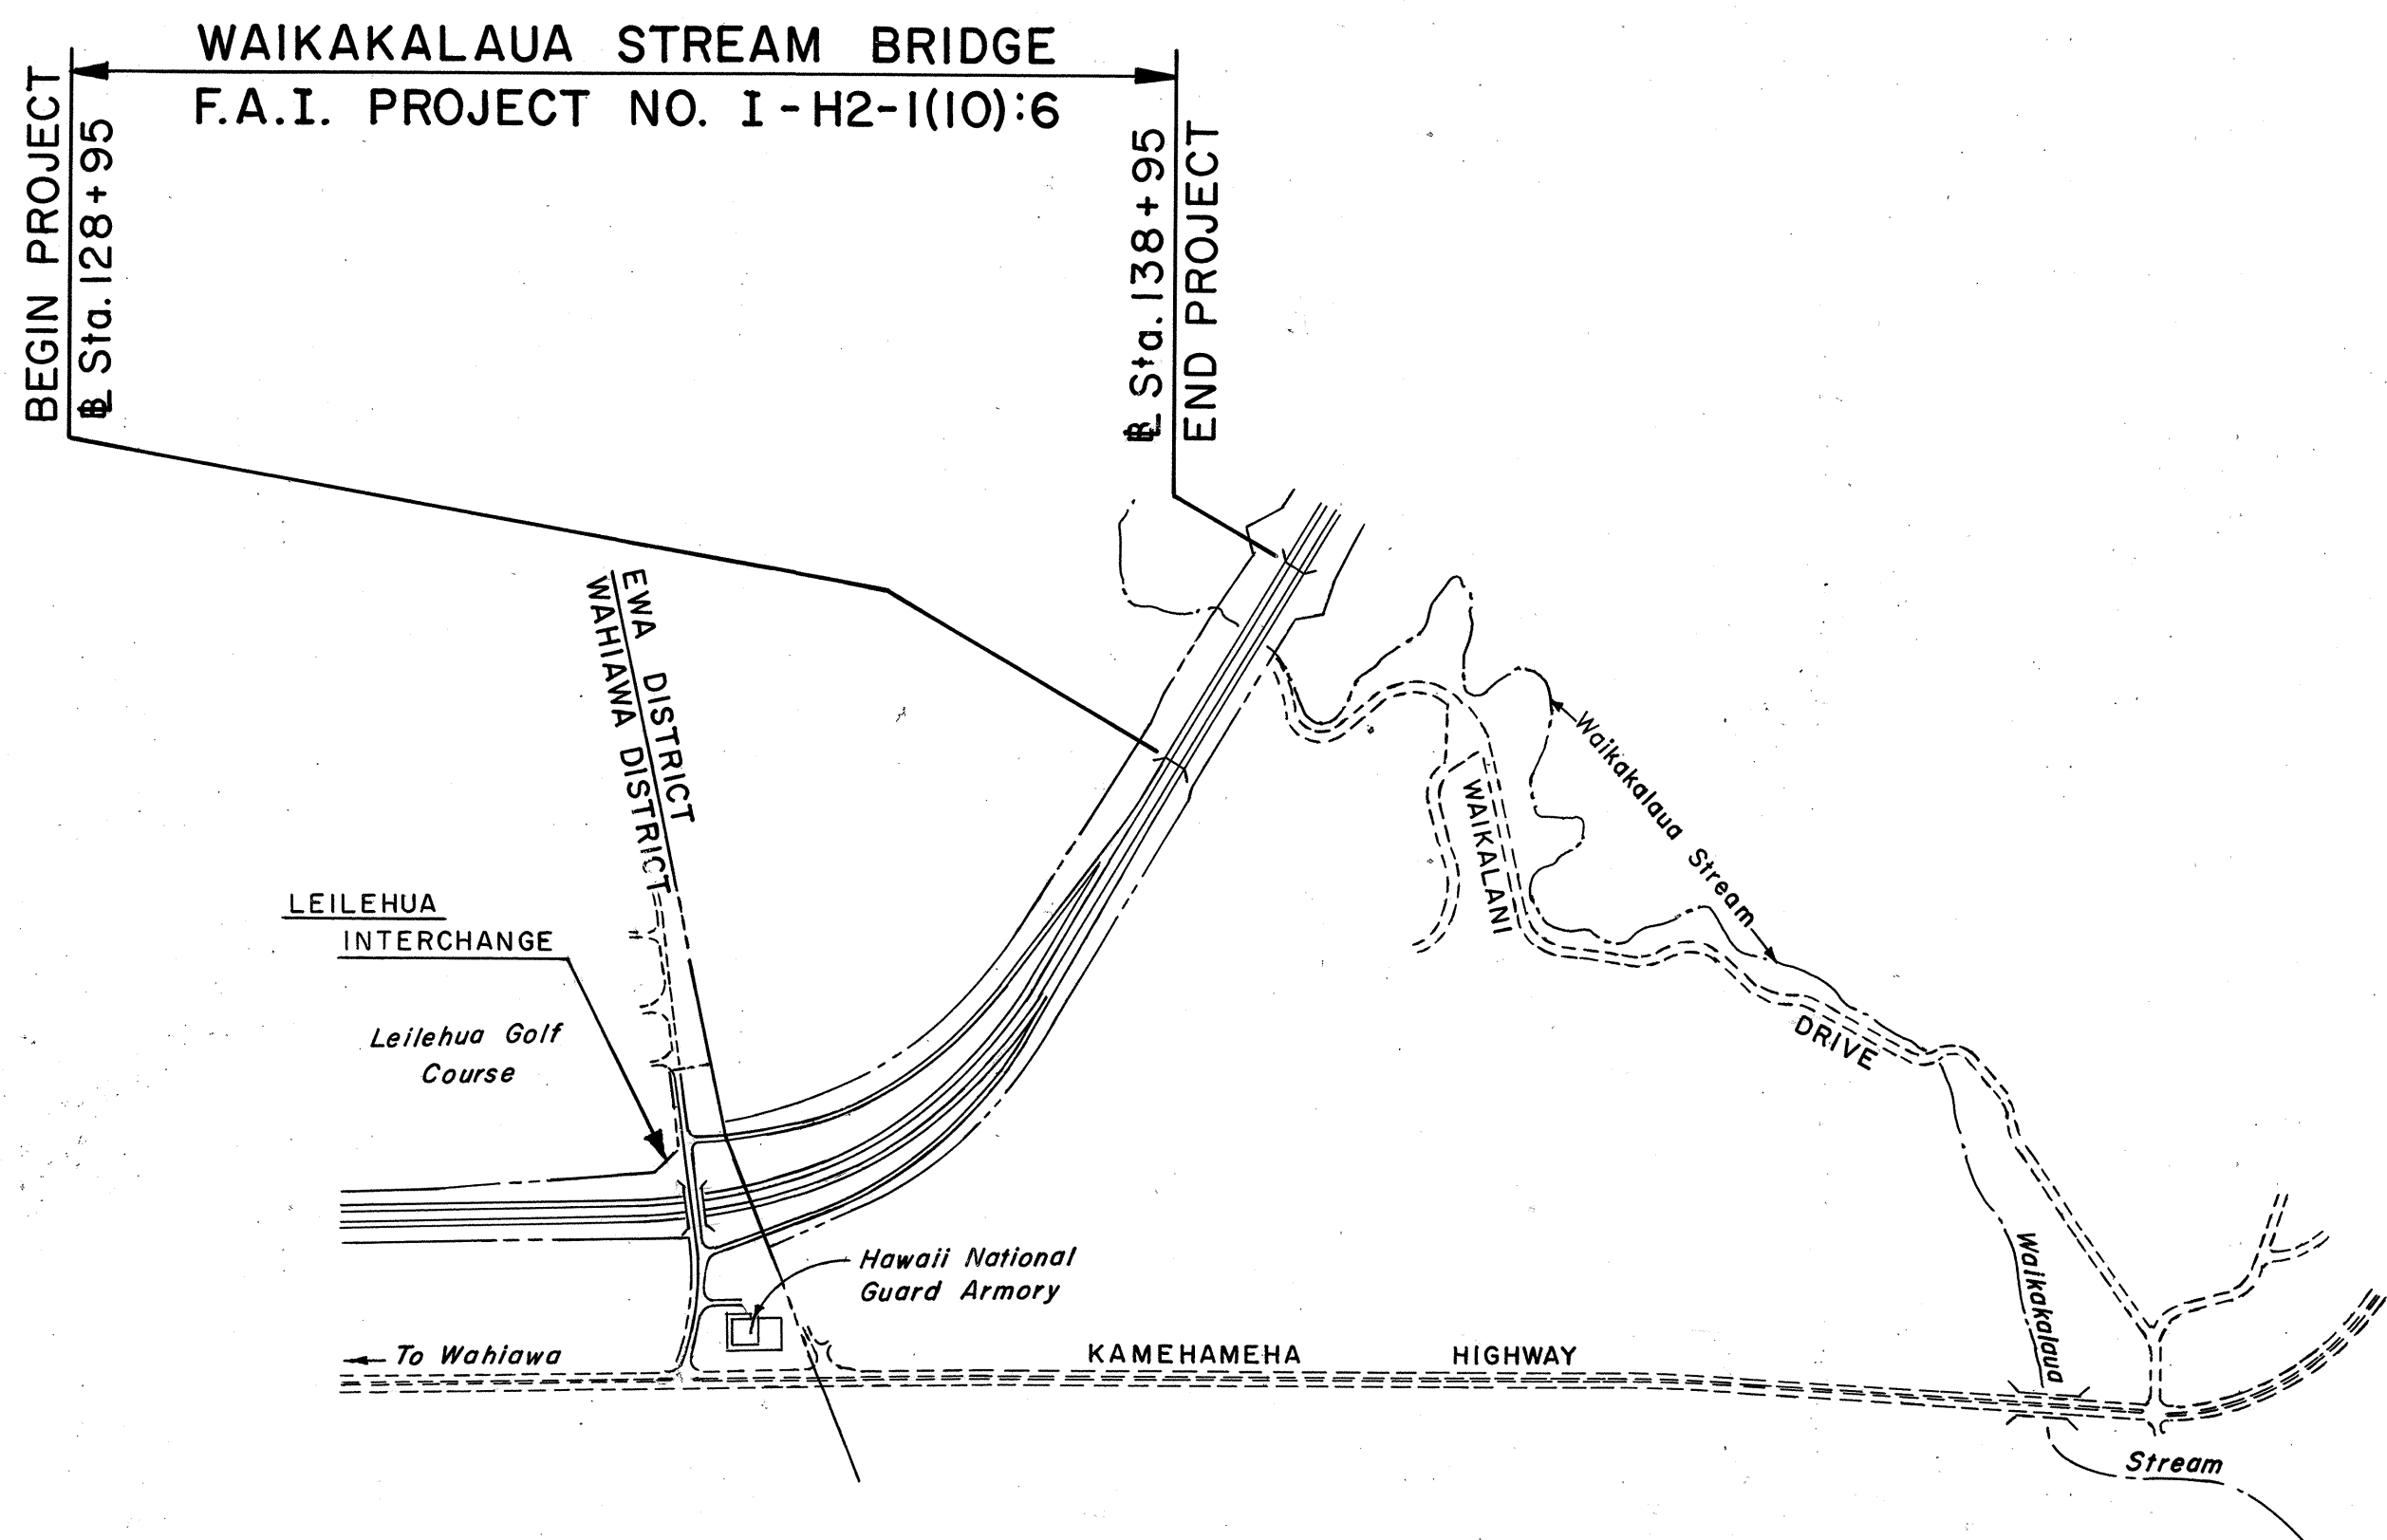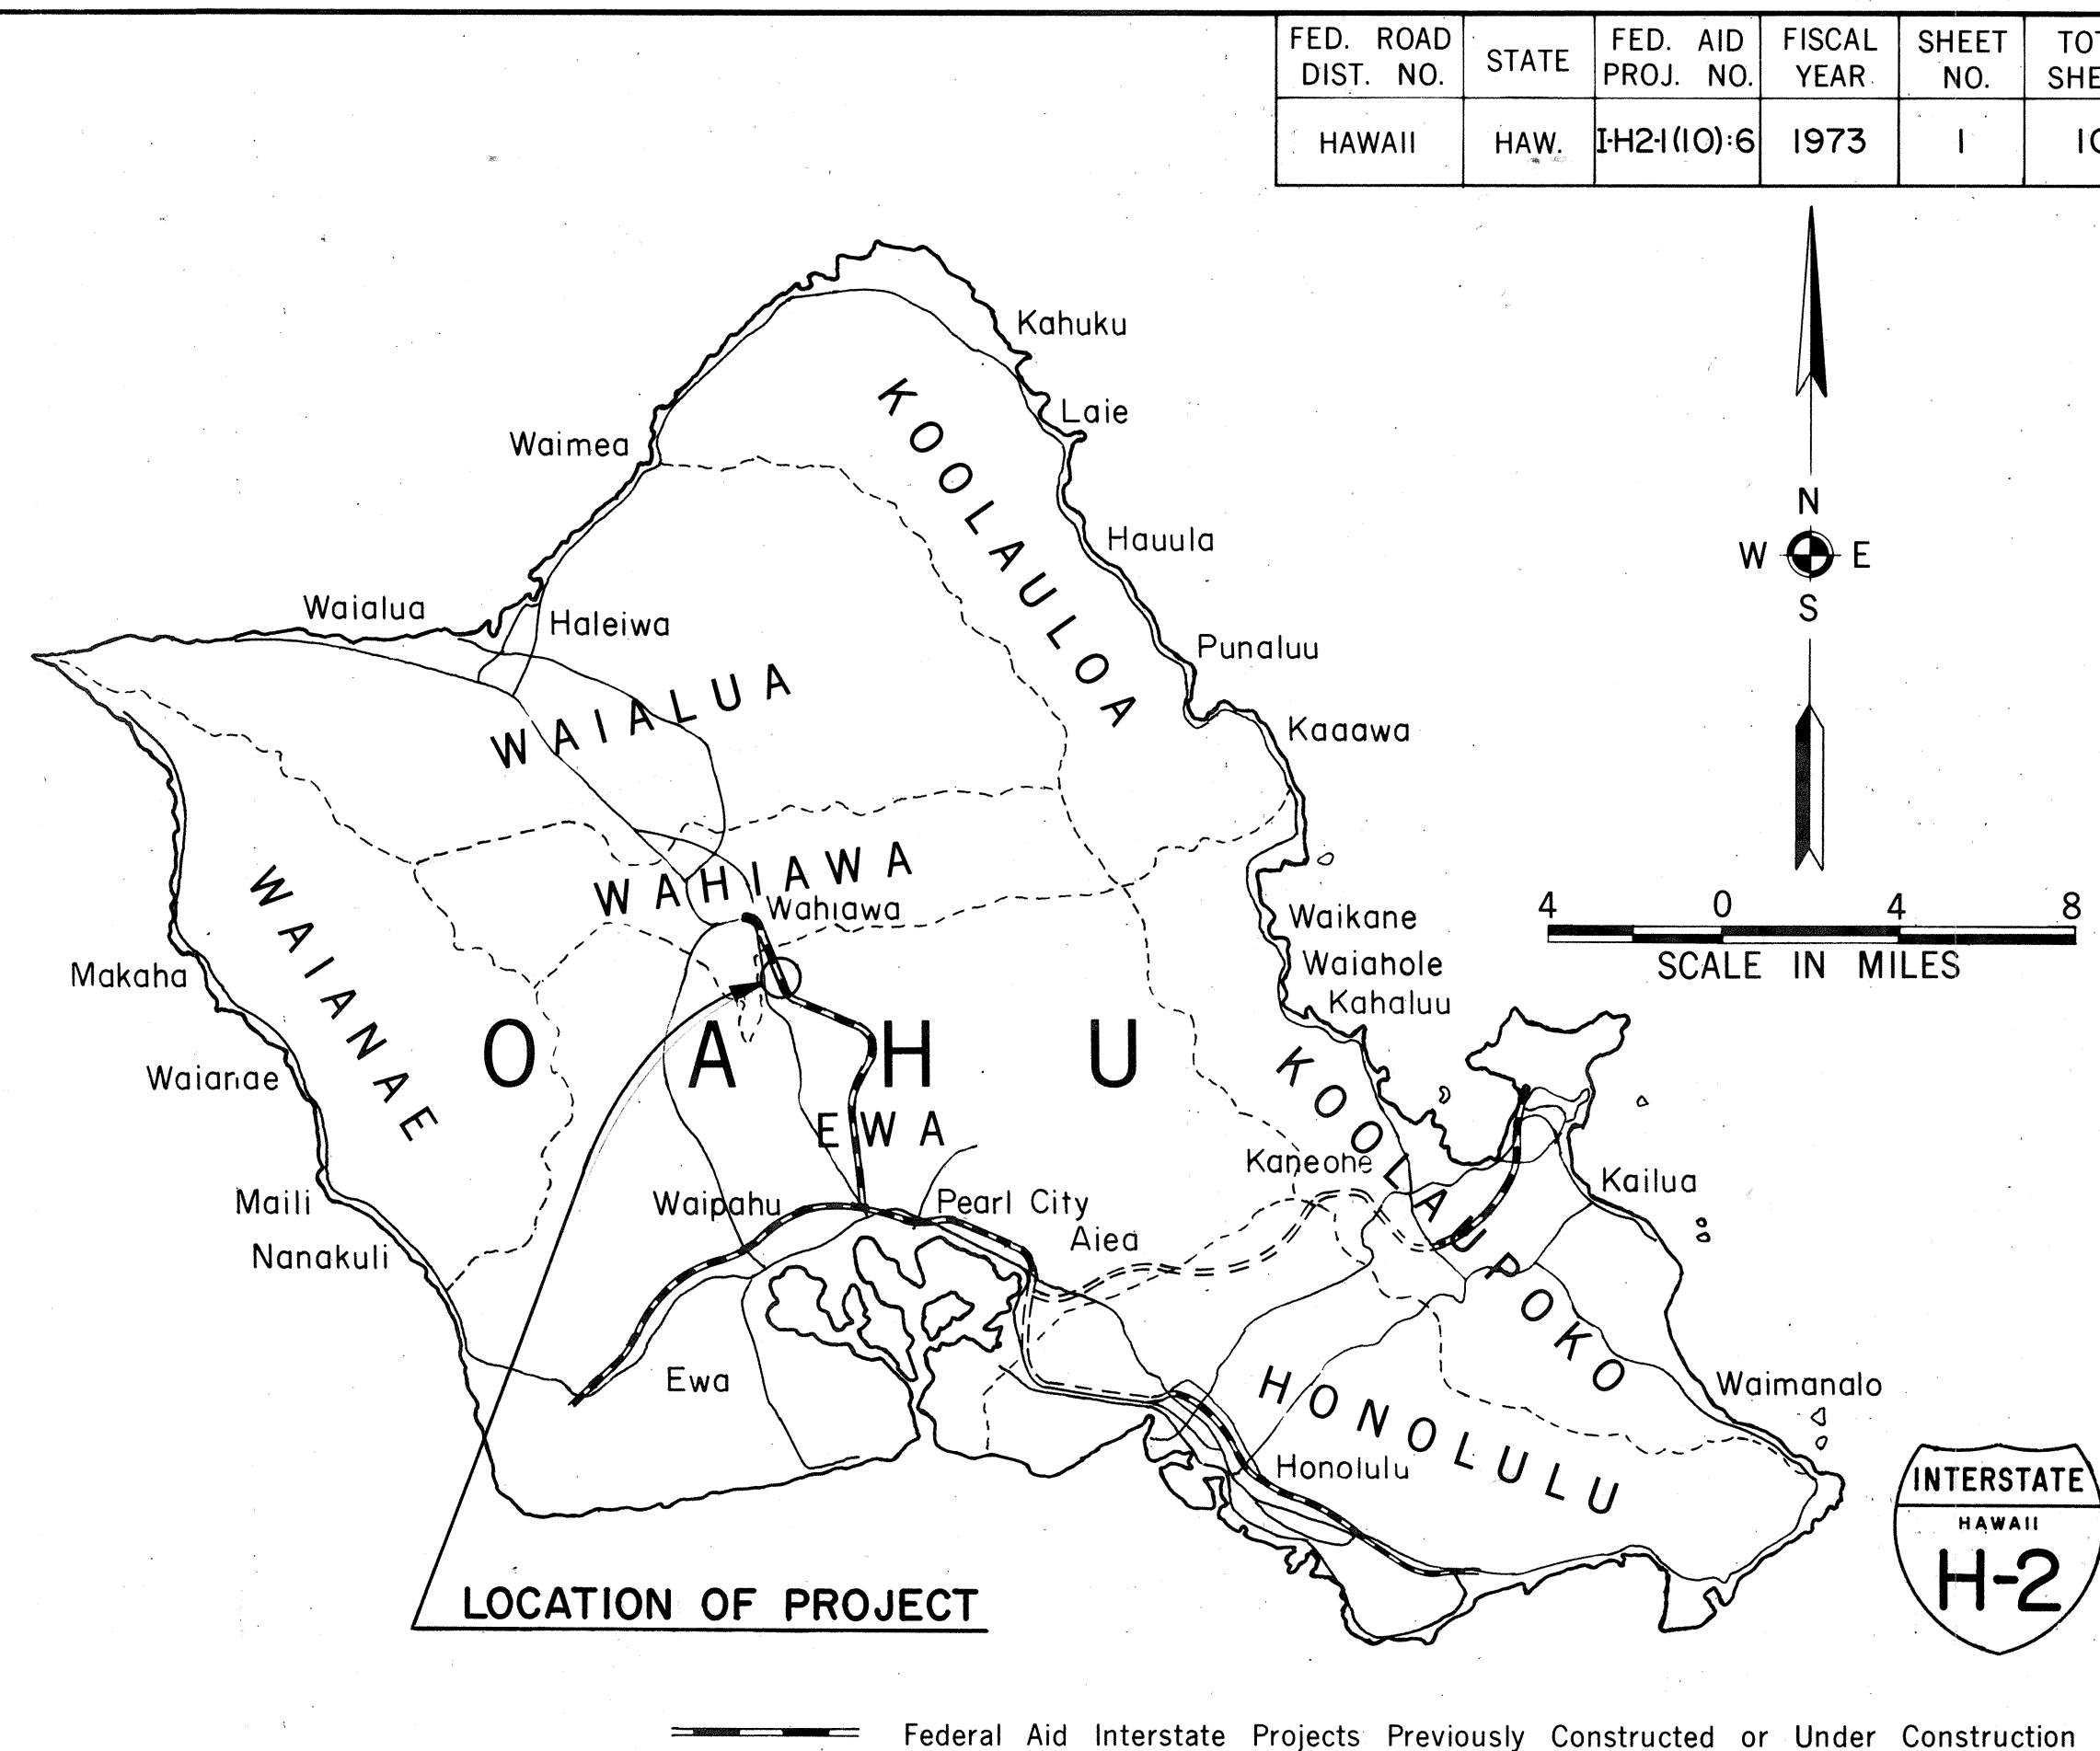

ALL CHANGES MADE DURING CONSTRUCTION HAVE BEEN INCORPORATED ON THESE PLANS IN RED EXCEPT CHANGES IN THE ORIGINAL THEORETICAL QUANTITIES. FOR ACTUAL QUANTITIES, REFER TO PROJECT LEDGER AND/OR COMPUTATION BOOK.

David Tomashiro
 RESIDENT ENGINEER

4/18/79
 DATE

DESIGN CLASSIFICATION	
CURRENT ADT (1973)	 0
INTERIM ADT (1977)	.. 20,500
DESIGN ADT (1993)	... 35,900
DHV	 10 %
D	 55/45
T ₂₄	 1,200
V	 70 mph
CONTROL OF ACCESS	... FULL

GROSS LENGTH OF PROJECT..... 0.189 MI.
 BRIDGES OVER 20.00' SPAN..... 0.189 MI.
 NET LENGTH OF ROADWAY..... 0.000 MI.

DEPARTMENT OF TRANSPORTATION
 FEDERAL HIGHWAY ADMINISTRATION
 APPROVED: *Robert Deane*
 DIVISION ENGINEER

6-14-73
 DATE

DEPARTMENT OF TRANSPORTATION
 STATE OF HAWAII
 APPROVED: *Trummy Lee*
 FOR DIR. OF TRANSPORTATION

6/20/73
 DATE

"C"
 DESIGN UNIT
 Mike Miura
 P. S. & E. BY
 548-7490 June, 1973
 PHONE DATE