

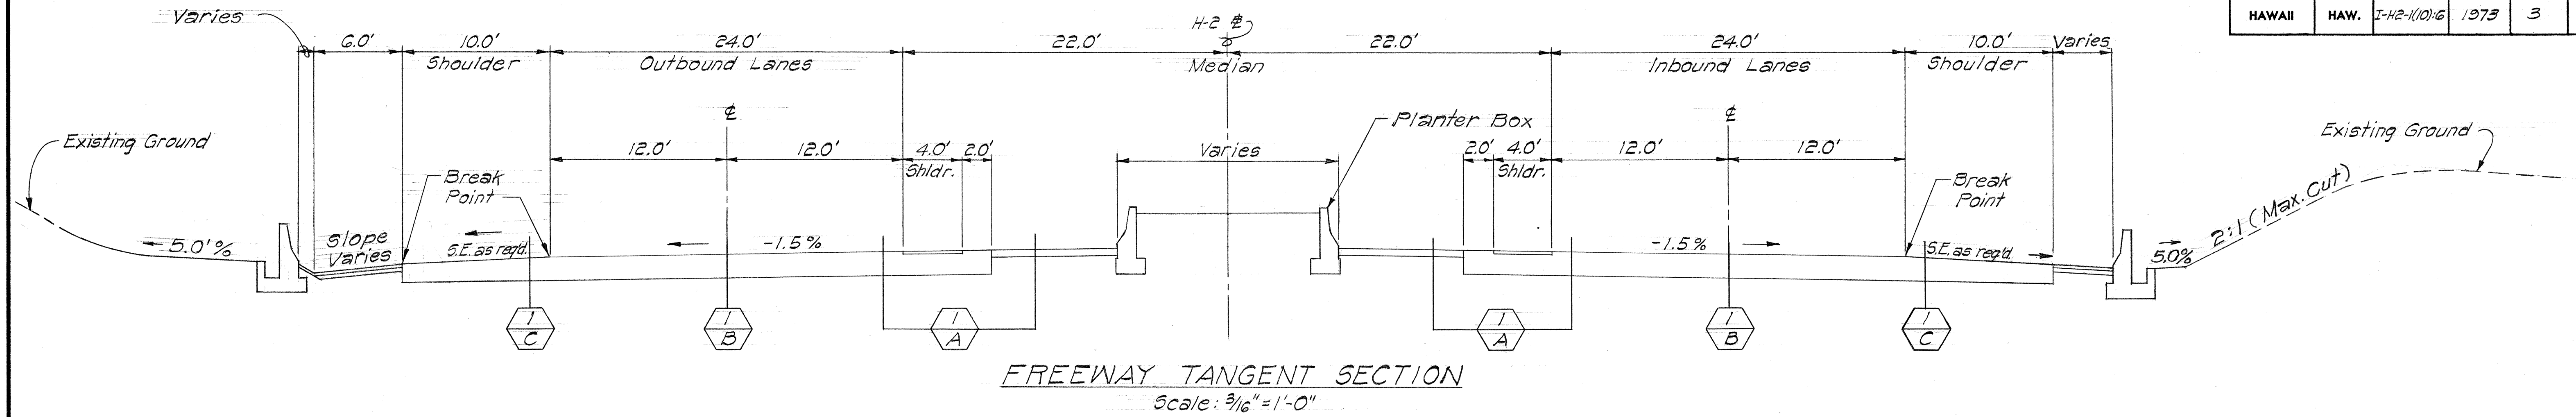


FED. ROAD DIST. NO.	STATE	FED. AID PROJ. NO.	FISCAL YEAR	SHEET NO.	TOTAL SHEETS
HAWAII	HAW.	I-H2-1(10)G	1973	3	104



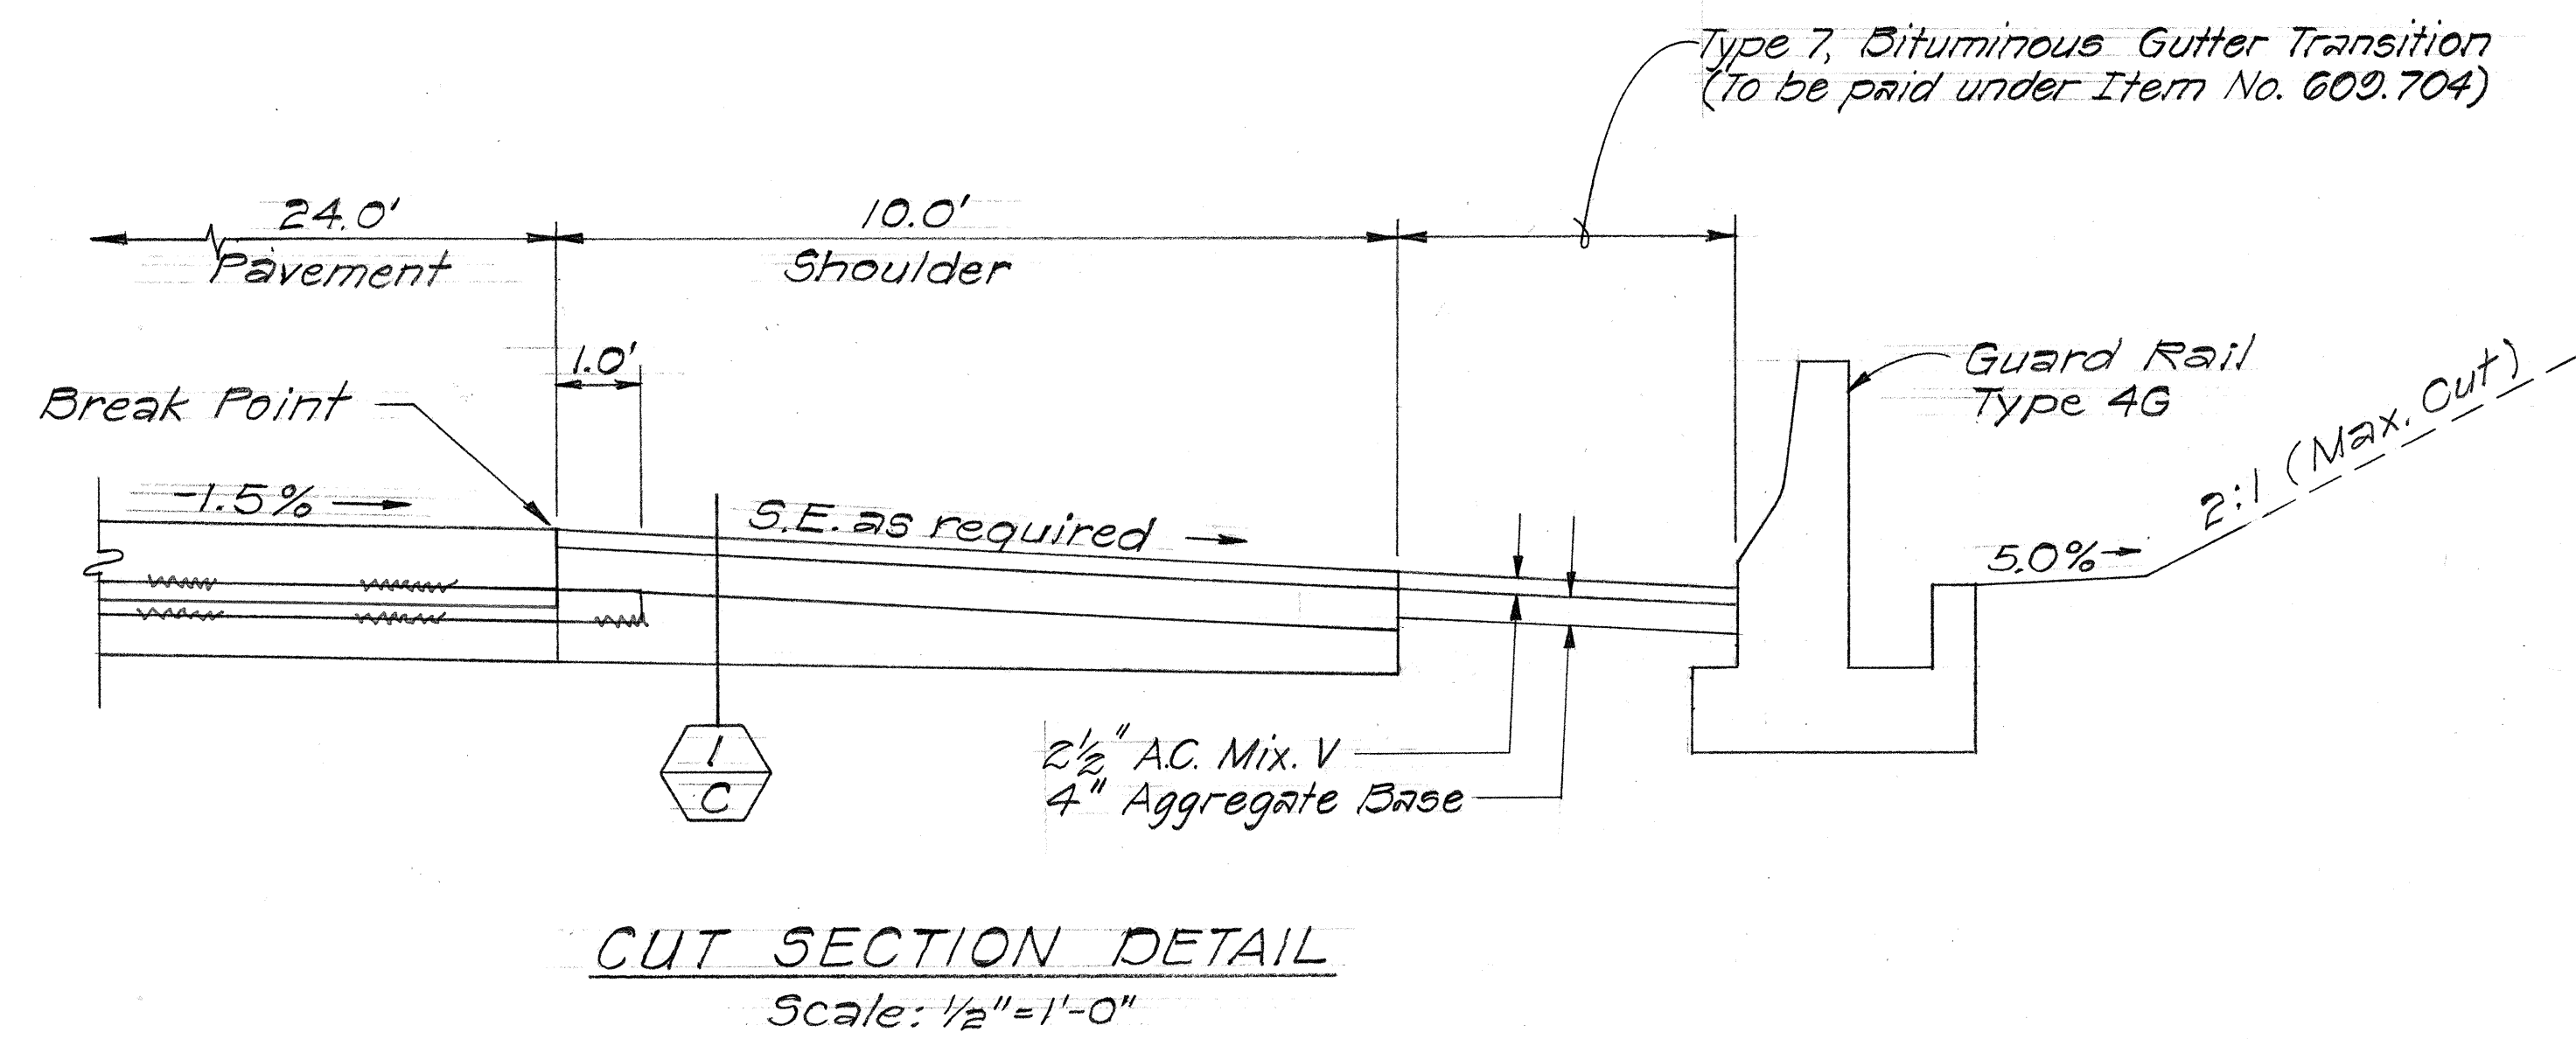


Grade Control is at H-2 Baseline from Sta. 127+00 to 128+95 and from Sta. 138+95 to 141+00

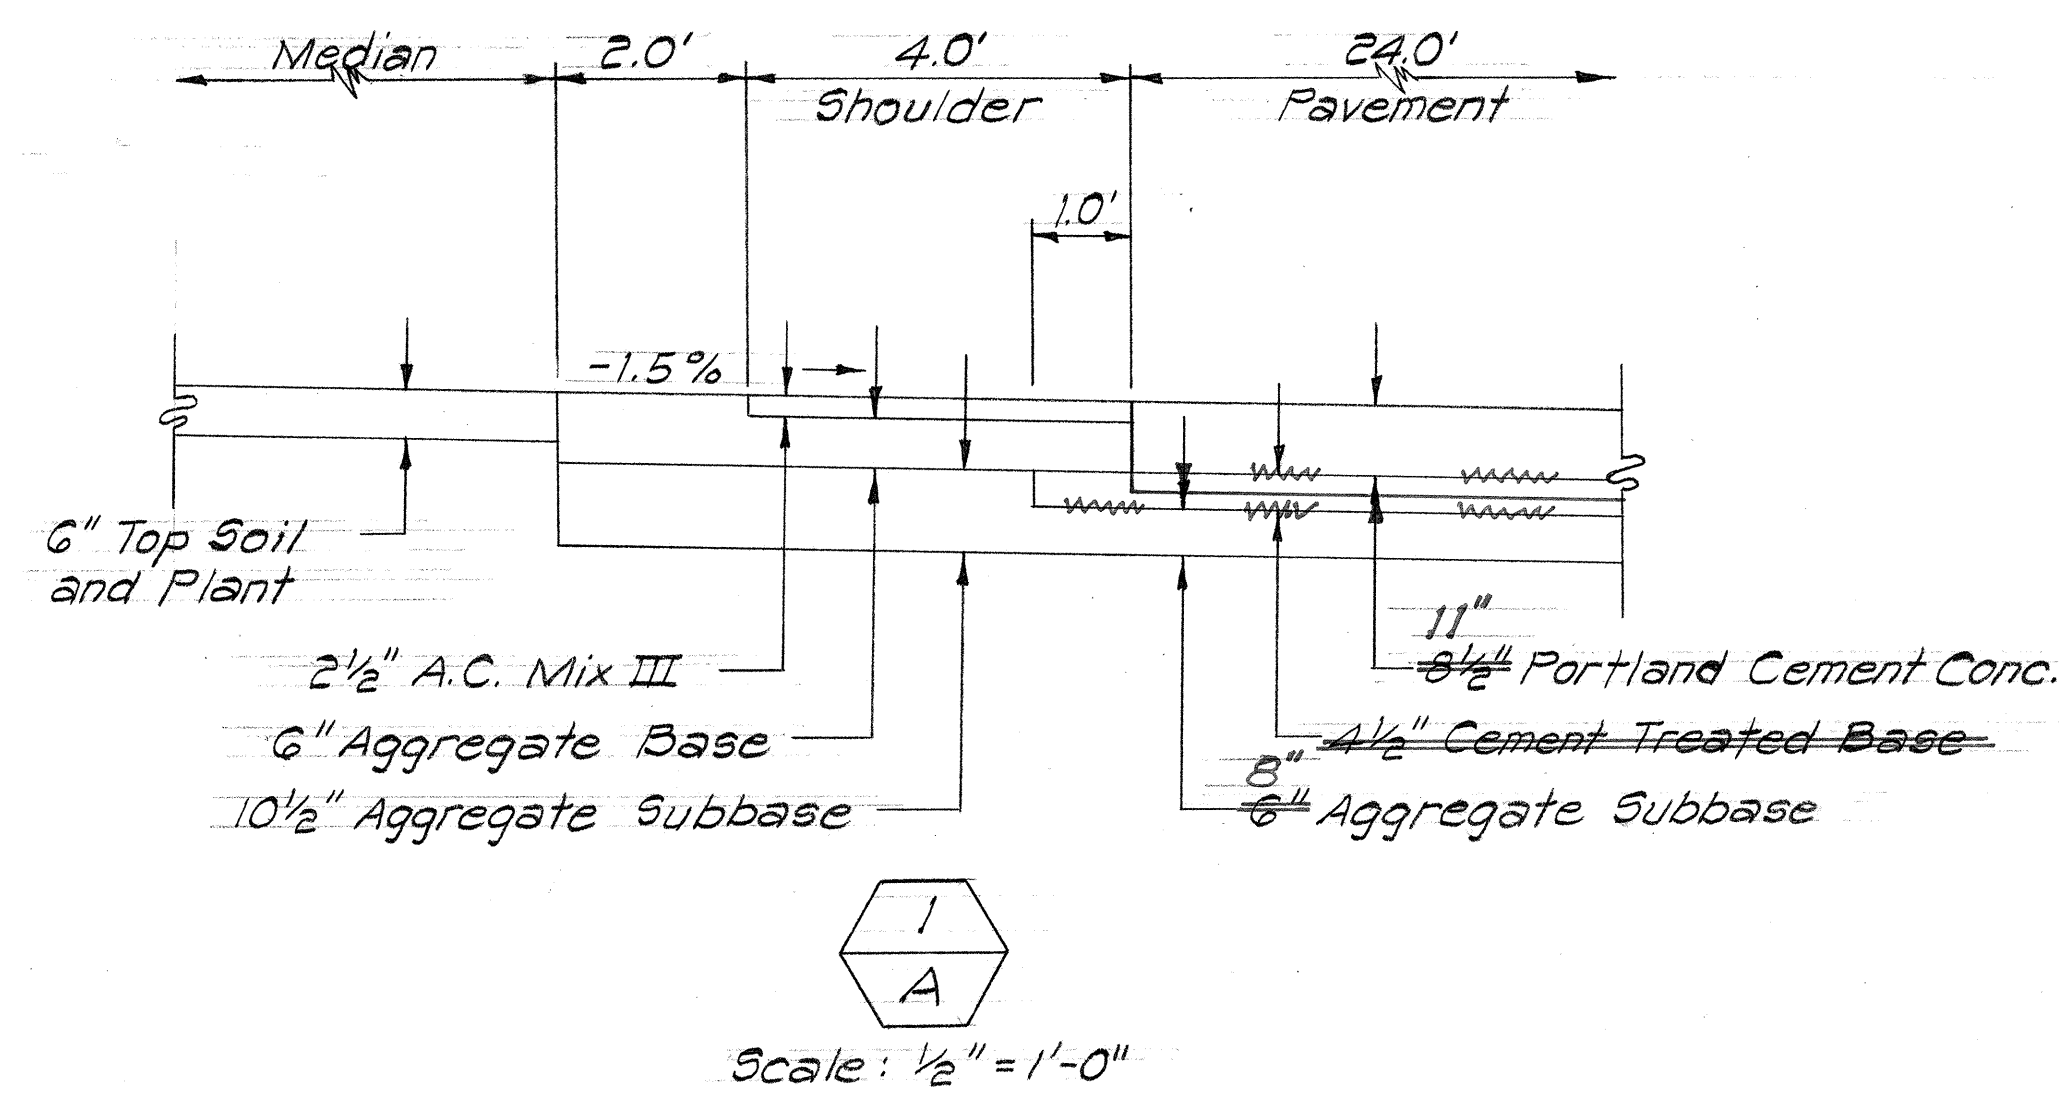

CUT SECTION DETAIL

Scale: $\frac{1}{2}" = 1'-0"$

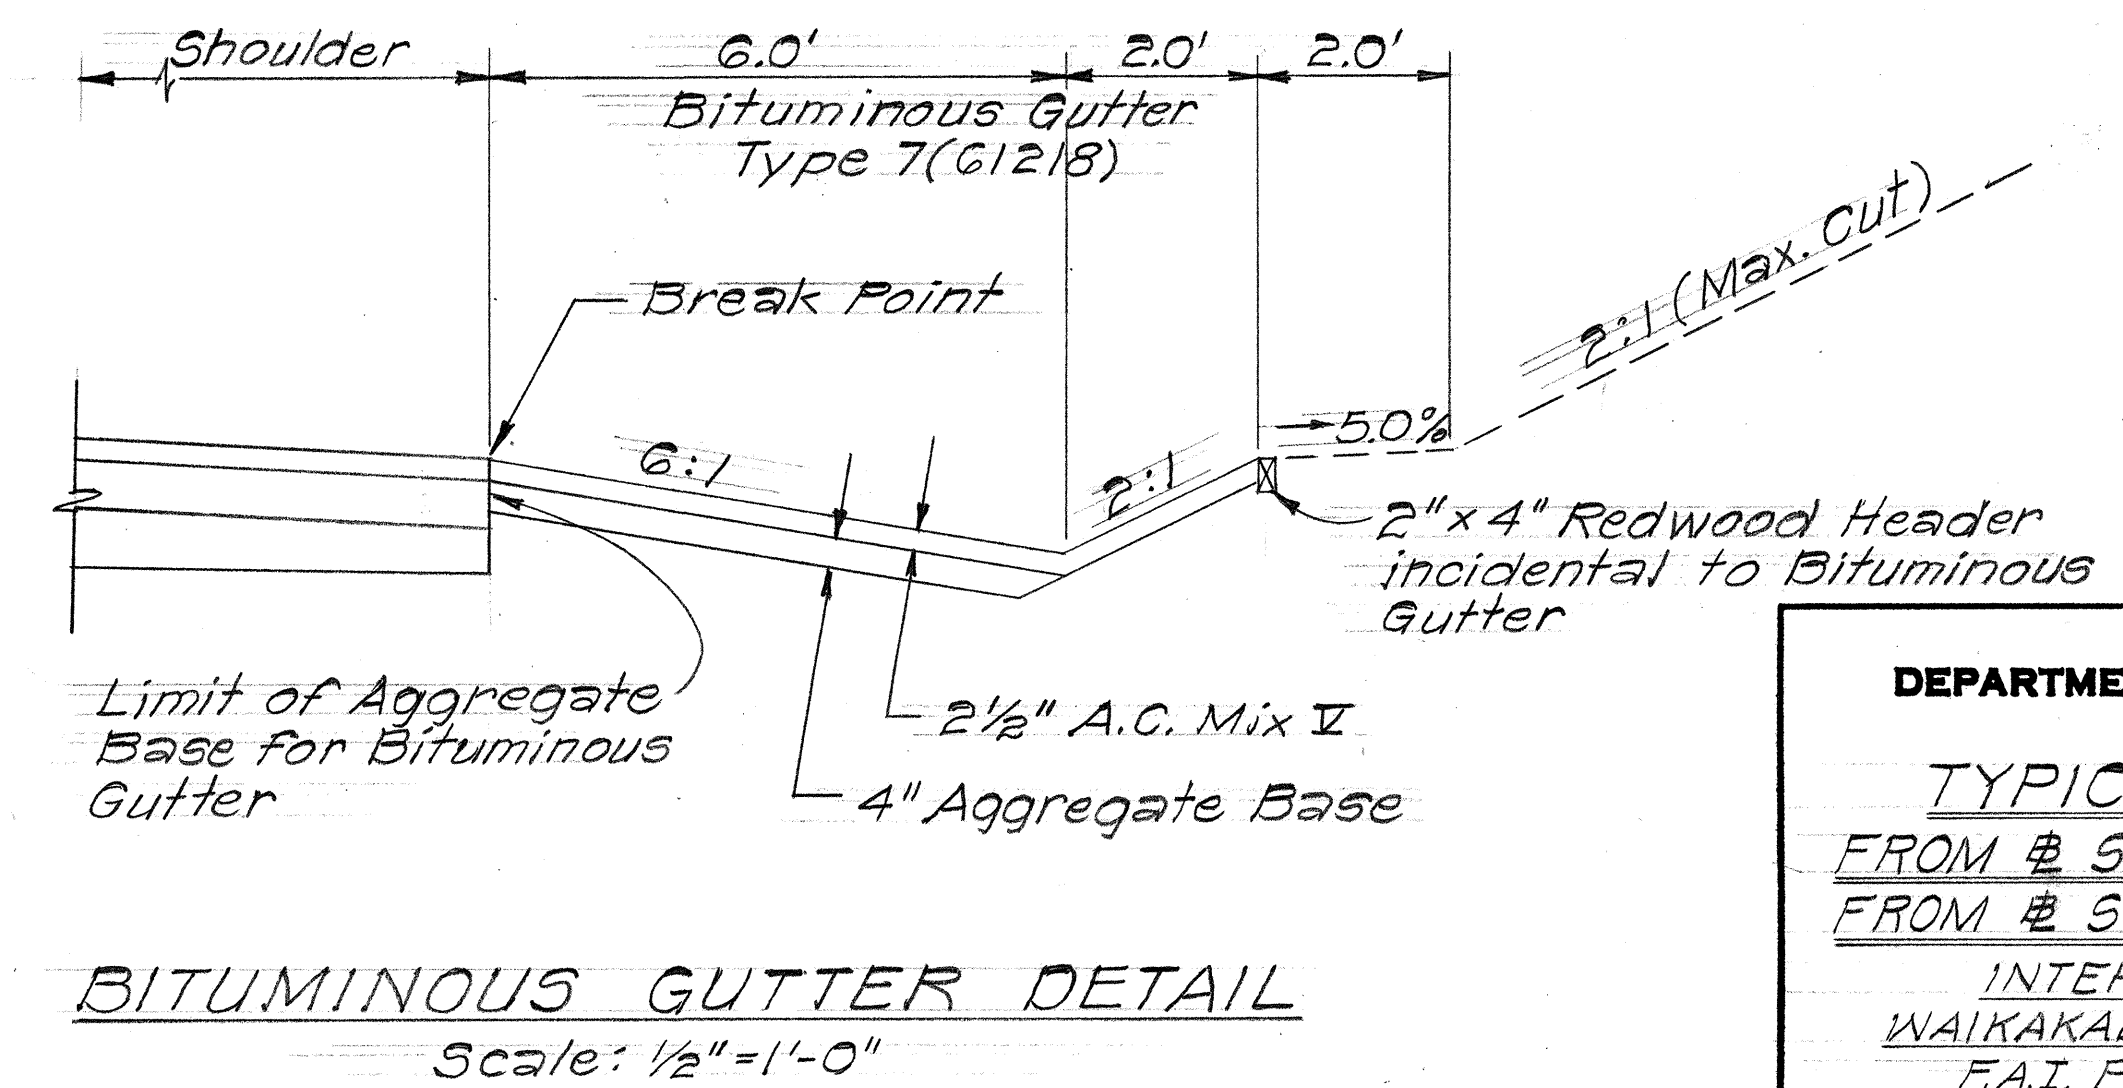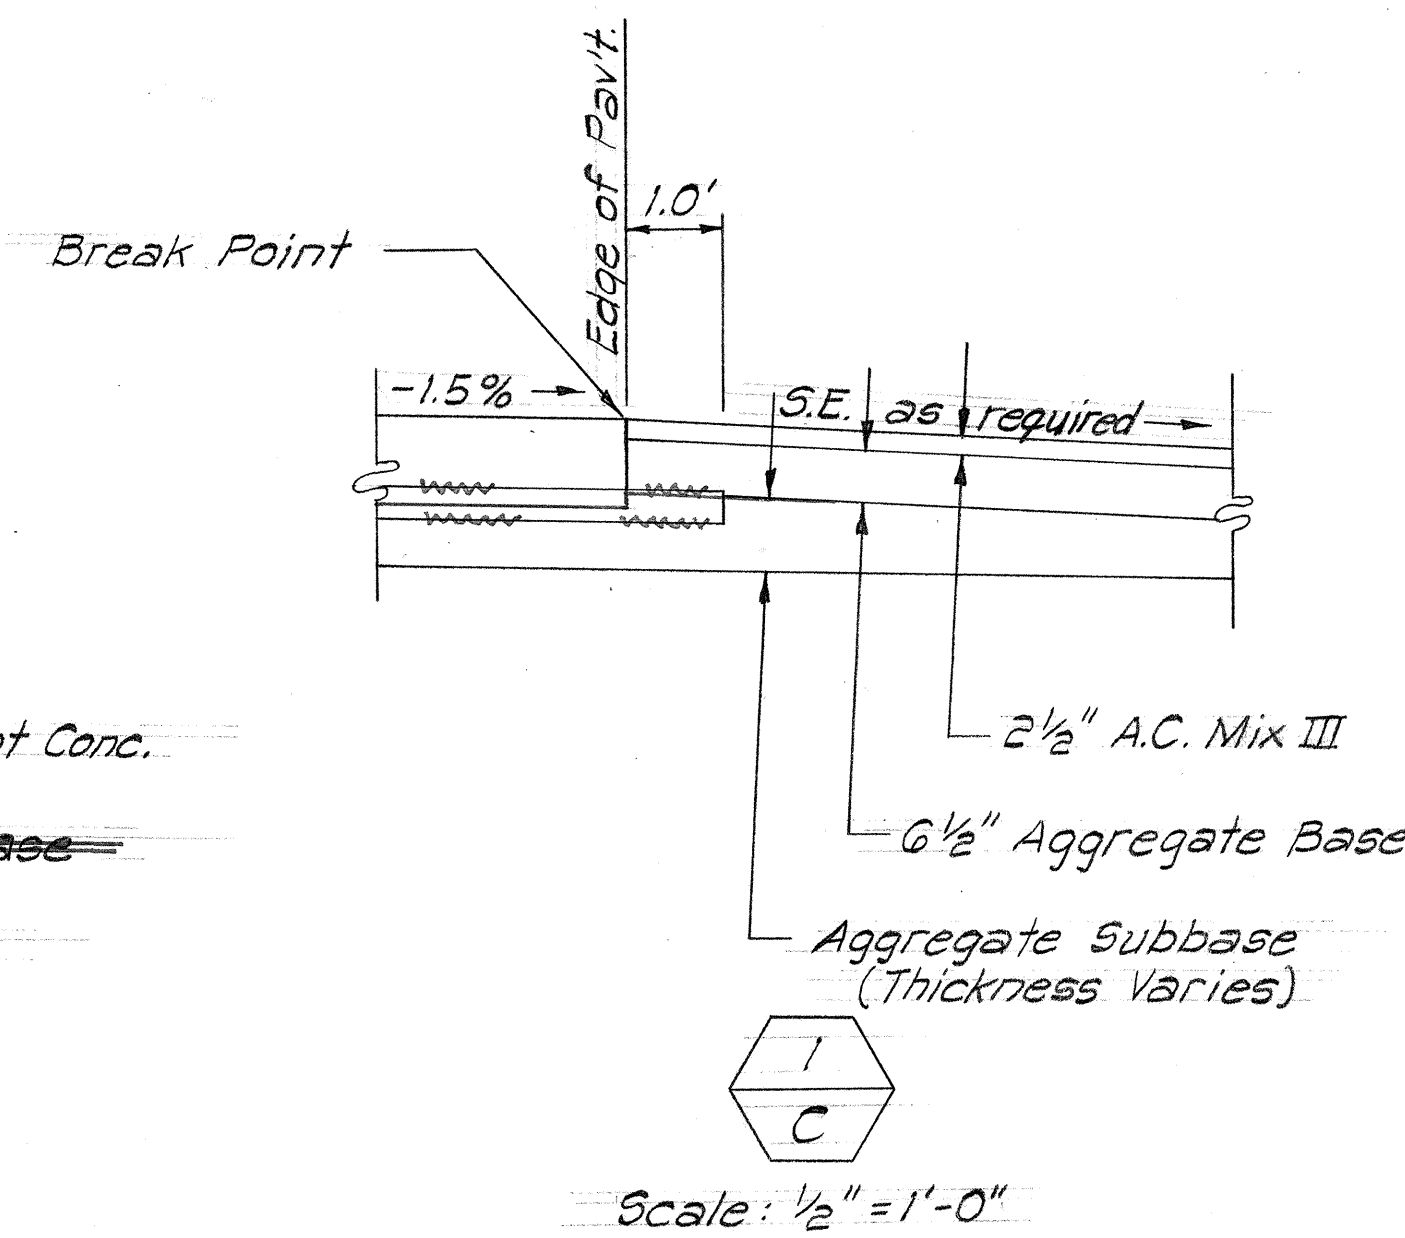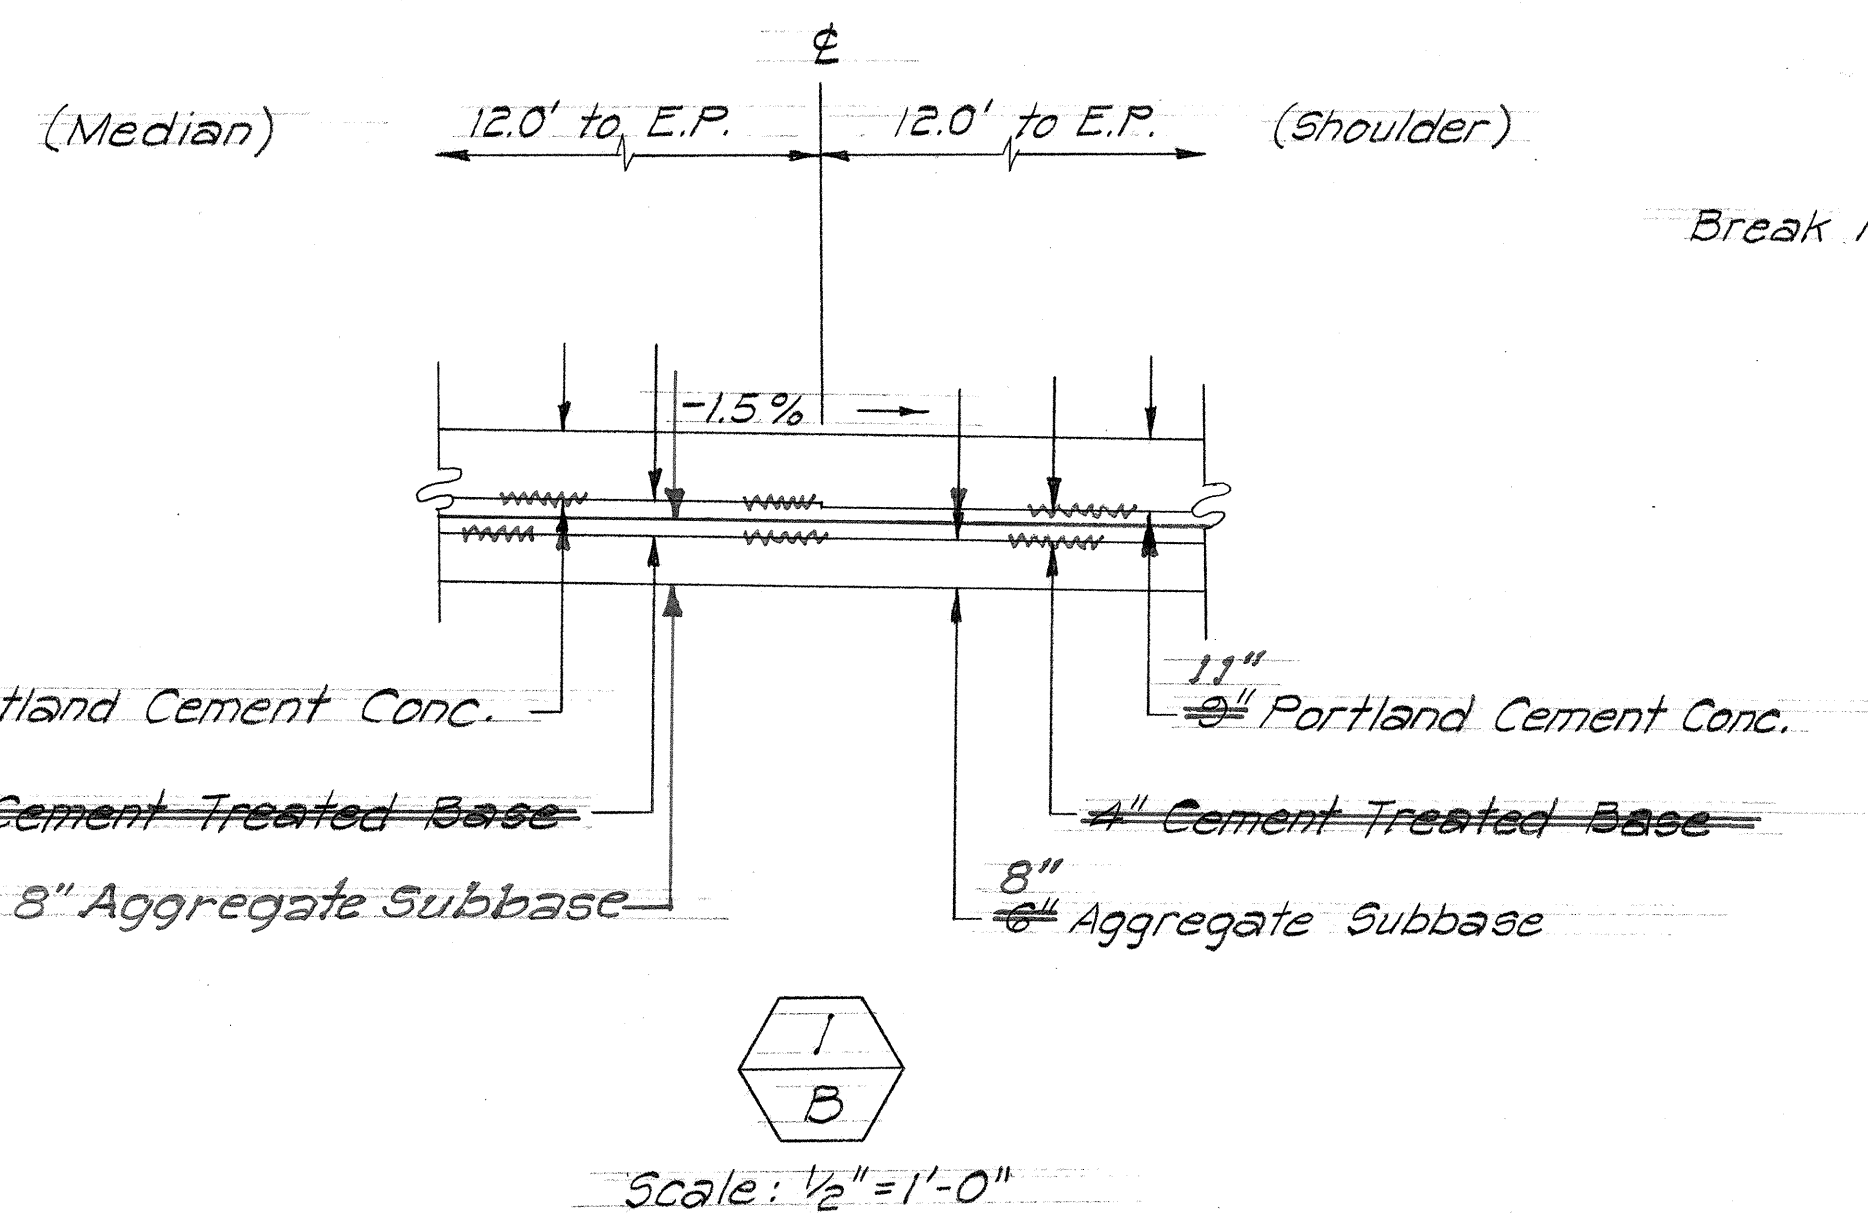

STATE OF HAWAII DEPARTMENT OF TRANSPORTATION HIGHWAYS DIVISION	
TYPICAL SECTIONS	
FROM STA. 127+00 TO 128+95	
FROM STA. 138+95 TO 141+00	
INTERSTATE ROUTE H-2	
WAIKAKALAUA STREAM BRIDGE	
F.A.I. Proj. No. I-H2-1(10)G	
Scale: As Shown	Date: May, 1973
SHEET No. 1 OF 1 SHEETS	