


FED. ROAD DIST. NO.	STATE	FED. AID PROJ. NO.	FISCAL YEAR	SHEET NO.	TOTAL SHEETS
HAWAII	HAW.	I-H2-1(10)6	1973	9	104

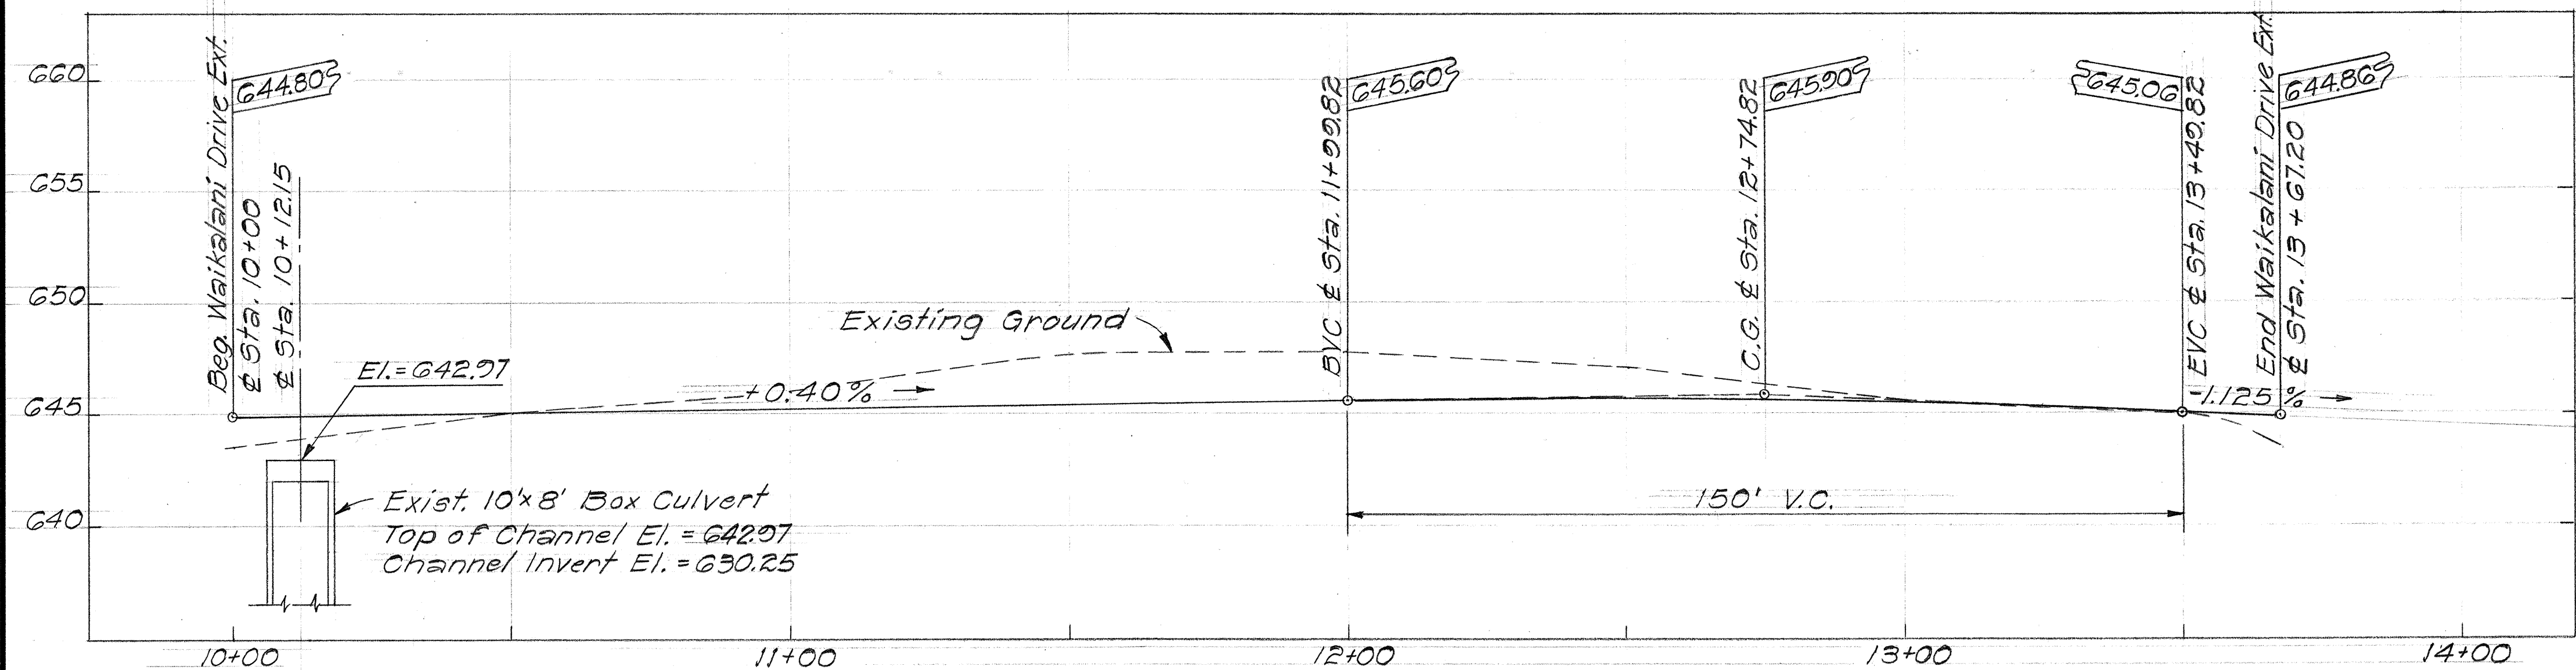

WAIKALANI DRIVE EXTENSION ~ PROFILE

Scale: Vert. 1" = 5'
Hor. 1" = 20'

CONSTRUCTION NOTE

4-inch wide white stripe shall be painted on the # of Waikalani Drive Extension and will be paid under Item No. 642.01.

NOTE:

Waikalani Drive Extension was constructed by Headrick Development, Inc. For construction plans see Permit No. 5605 (1975). Box Culvert Extension also constructed by Headrick Development, Inc. For construction plans see Permit No. 5630 (1974).

This work Deleted from contract


STATE OF HAWAII
DEPARTMENT OF TRANSPORTATION
HIGHWAYS DIVISION

WAIKALANI DRIVE EXTENSION

INTERSTATE ROUTE H-2
WAIKAKALAWA STREAM BRIDGE
PROJECT NO. I-H2-1(10)6

Scale: As Shown Date: May, 1973


SHEET No. 1 OF 2 SHEETS

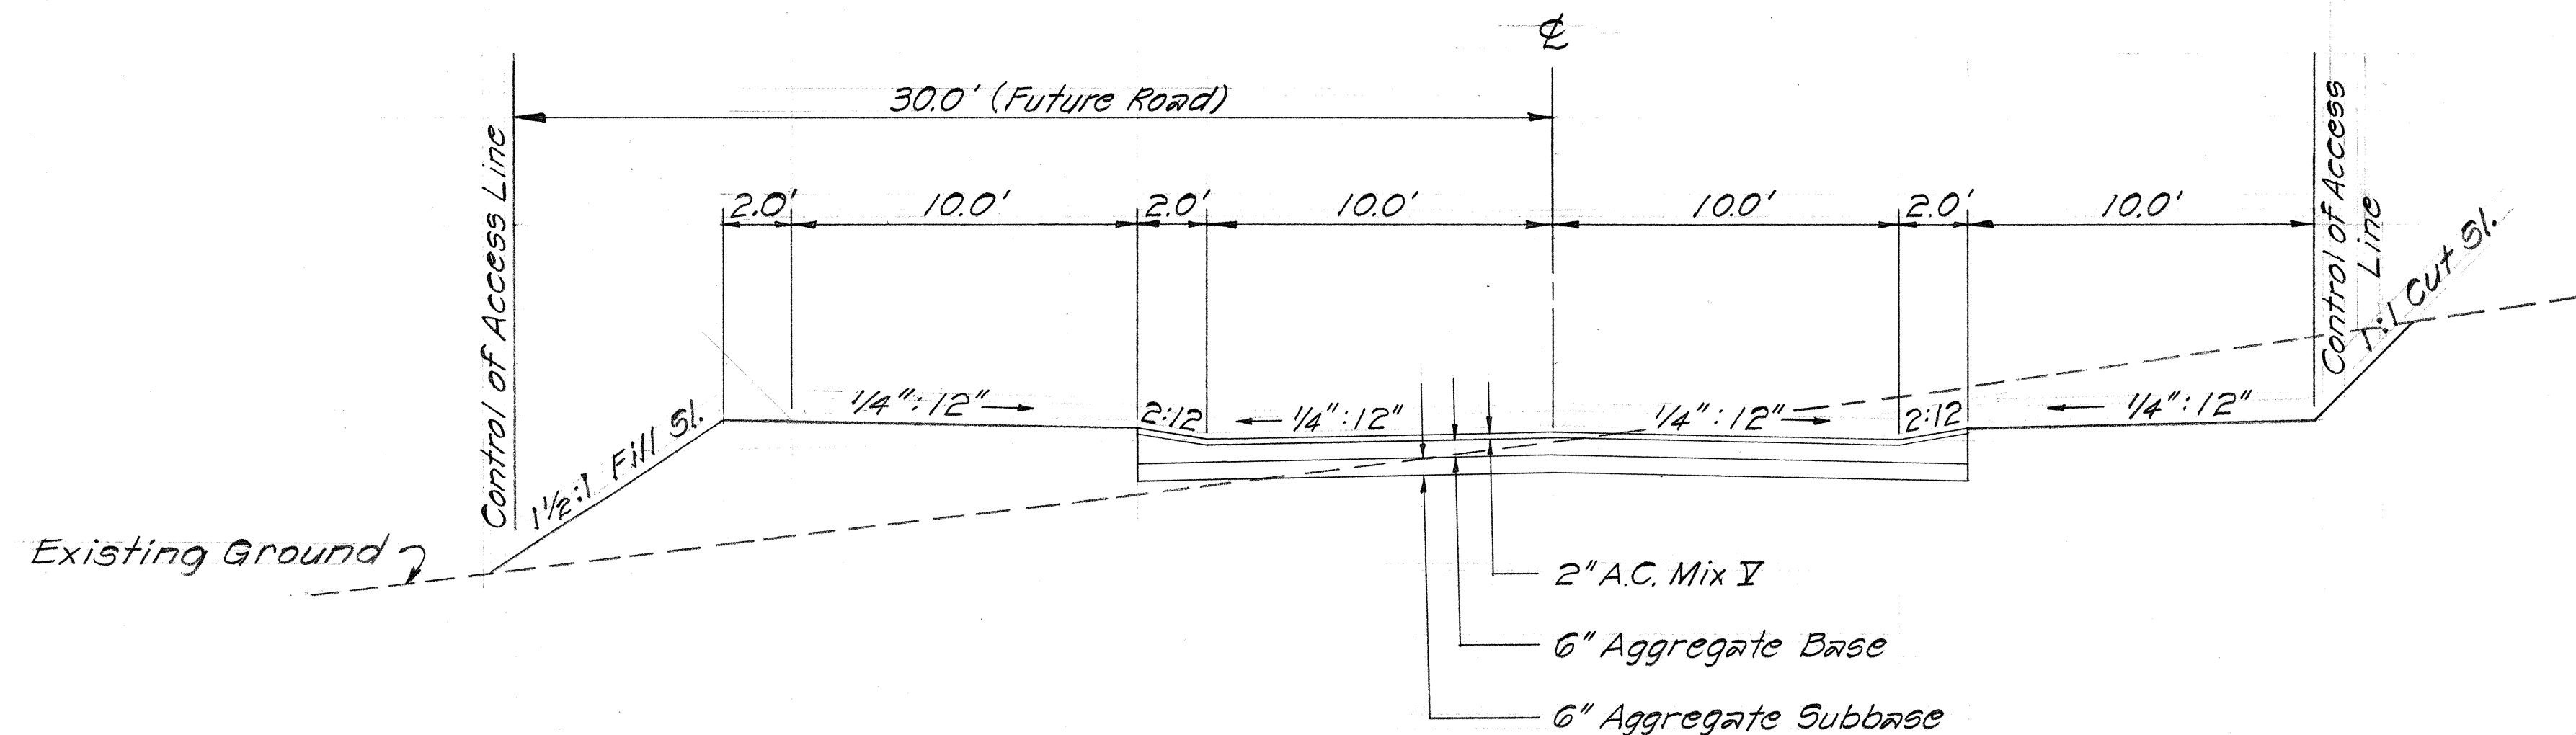

TYPICAL SECTION FOR WAIKALANI DRIVE EXTENSION

Scale: 1/4" = 1'-0"

DATE	_____
SURVEY PLOTTED BY	_____
DRAWN BY	_____
TRACED BY	_____
NOTED BY	_____
CHECKED BY	_____
ORIGINAL PLAN	_____
NOTE BOOK	_____
No.	_____

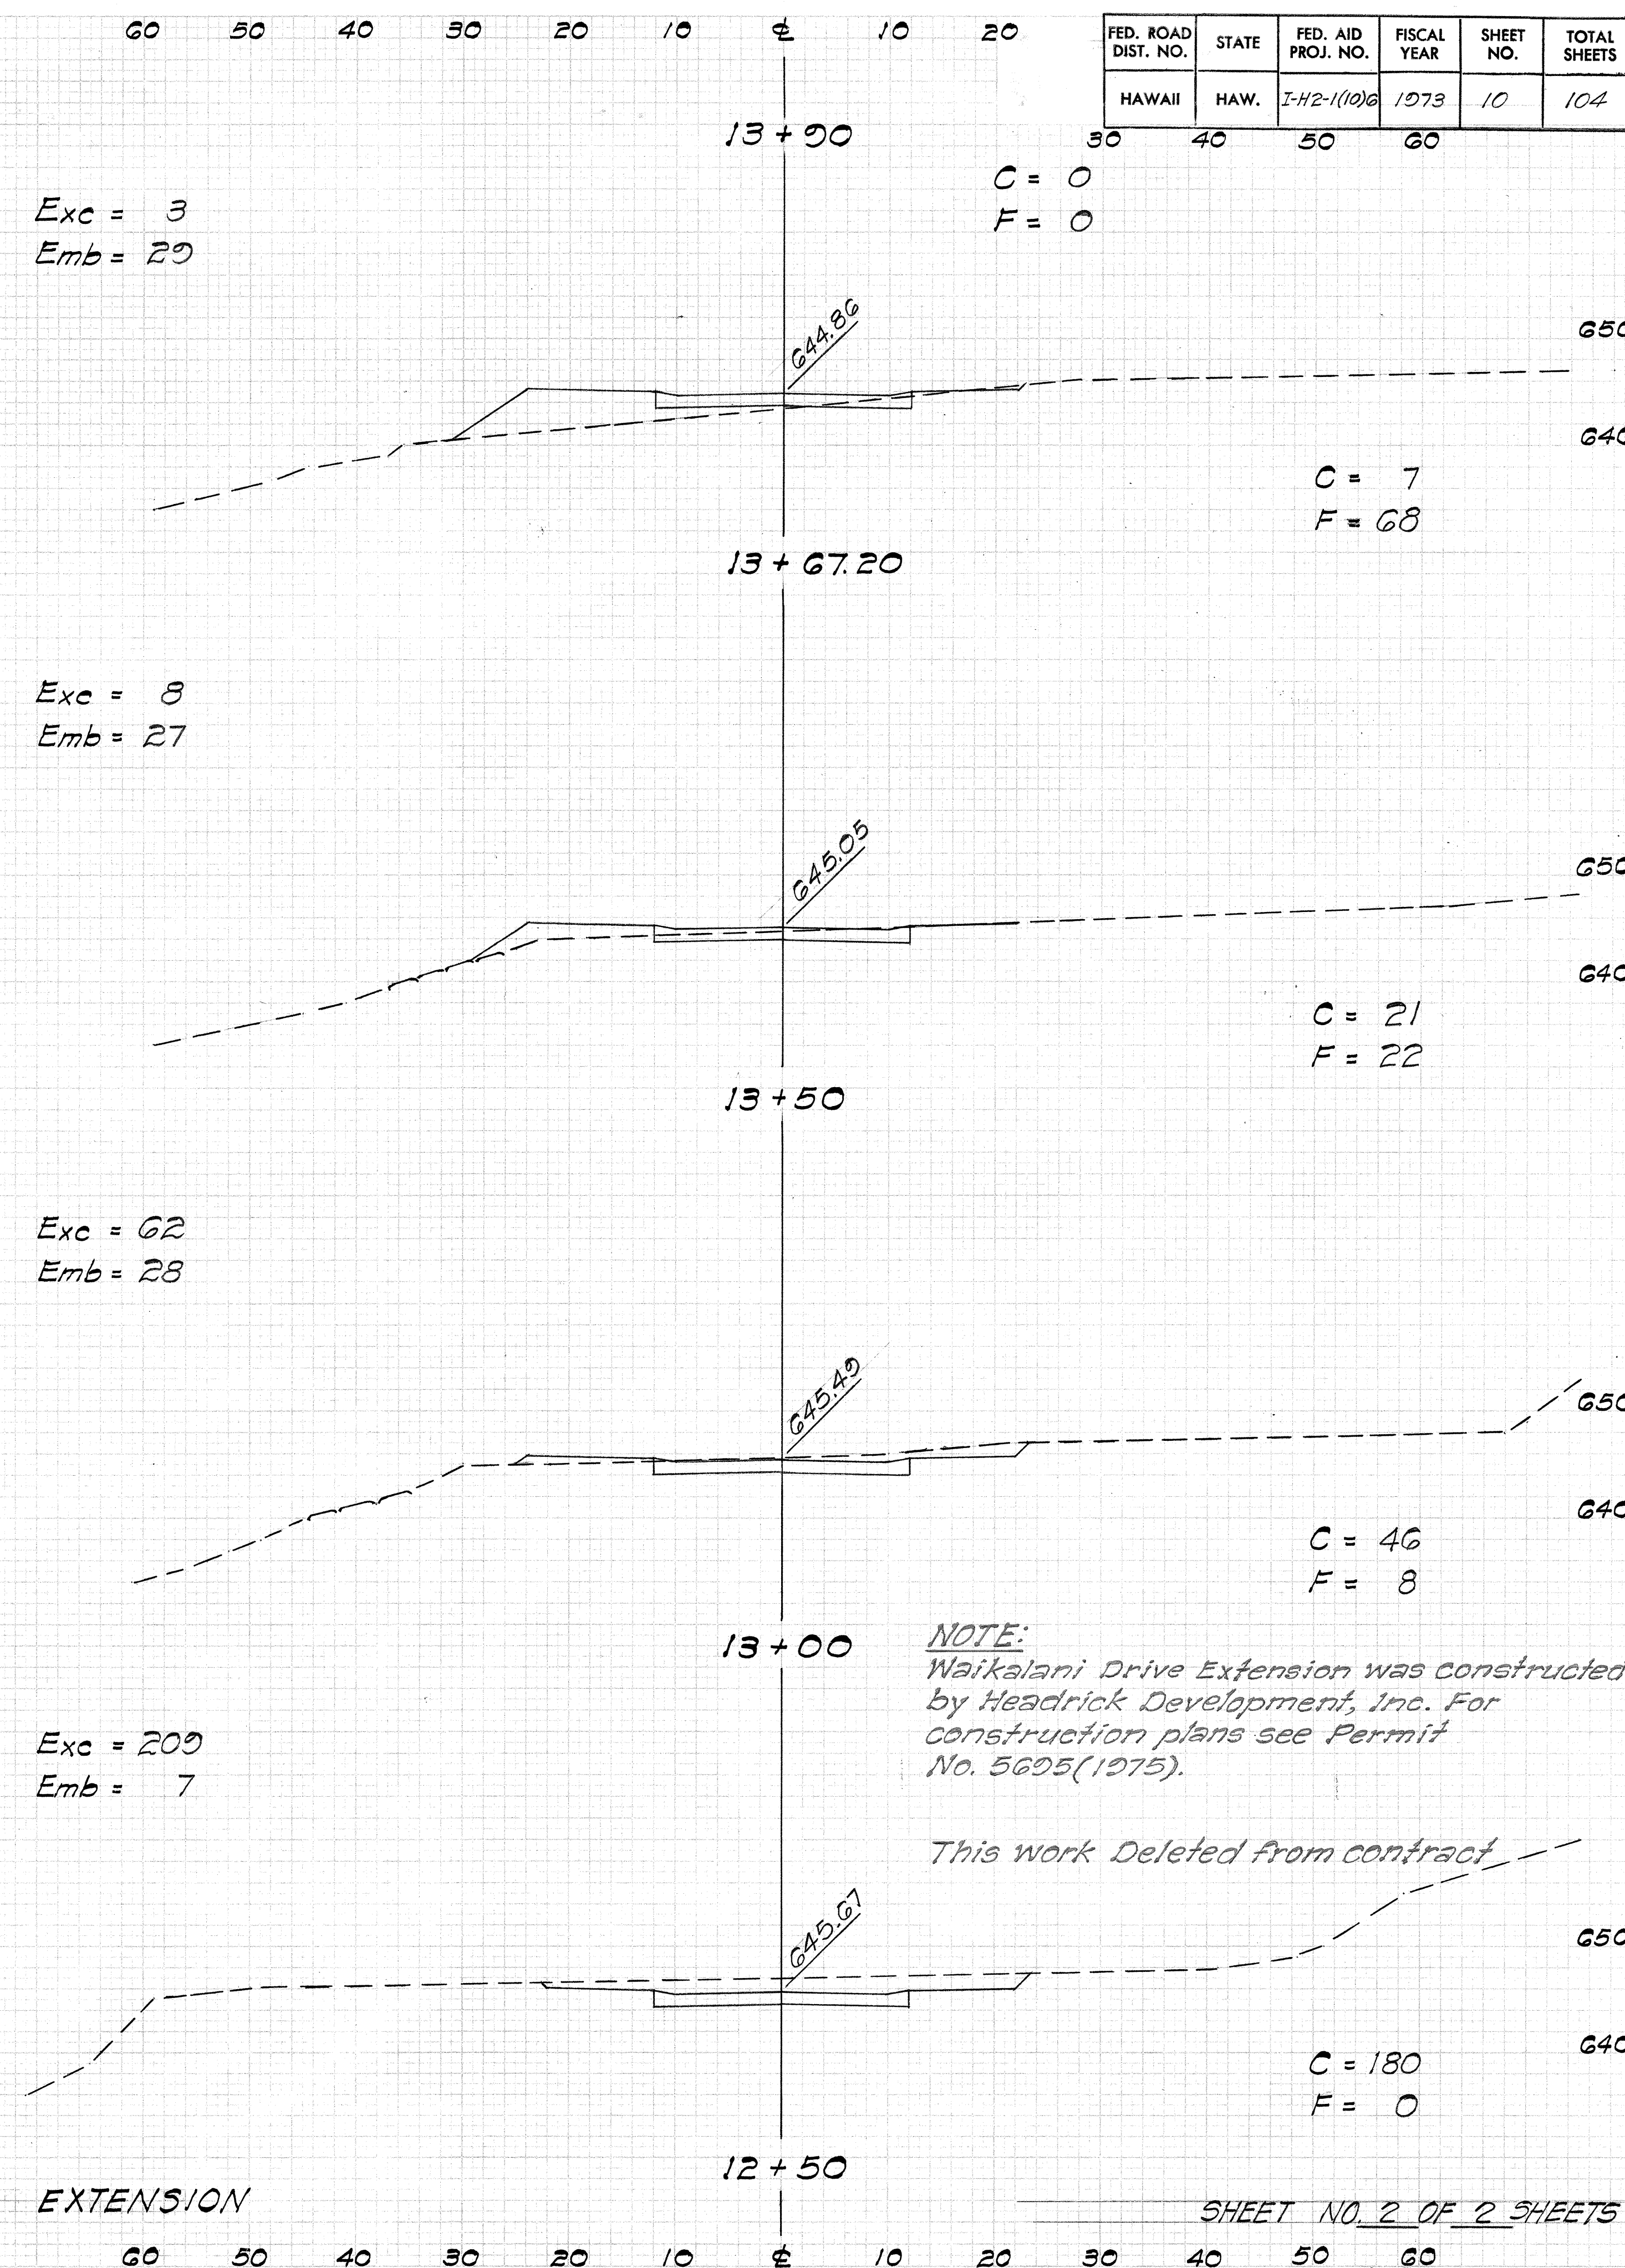

This work Deleted from contract

SHEET NO. 2 OF 2 SHEETS