



FED. ROAD DIST. NO.	STATE	FED. AID PROJ. NO.	FISCAL YEAR	SHEET NO.	TOTAL SHEETS
HAWAII	HAW.	I-11-1(97):B	1973	11	27


ZONE II-8
SHEET # 4

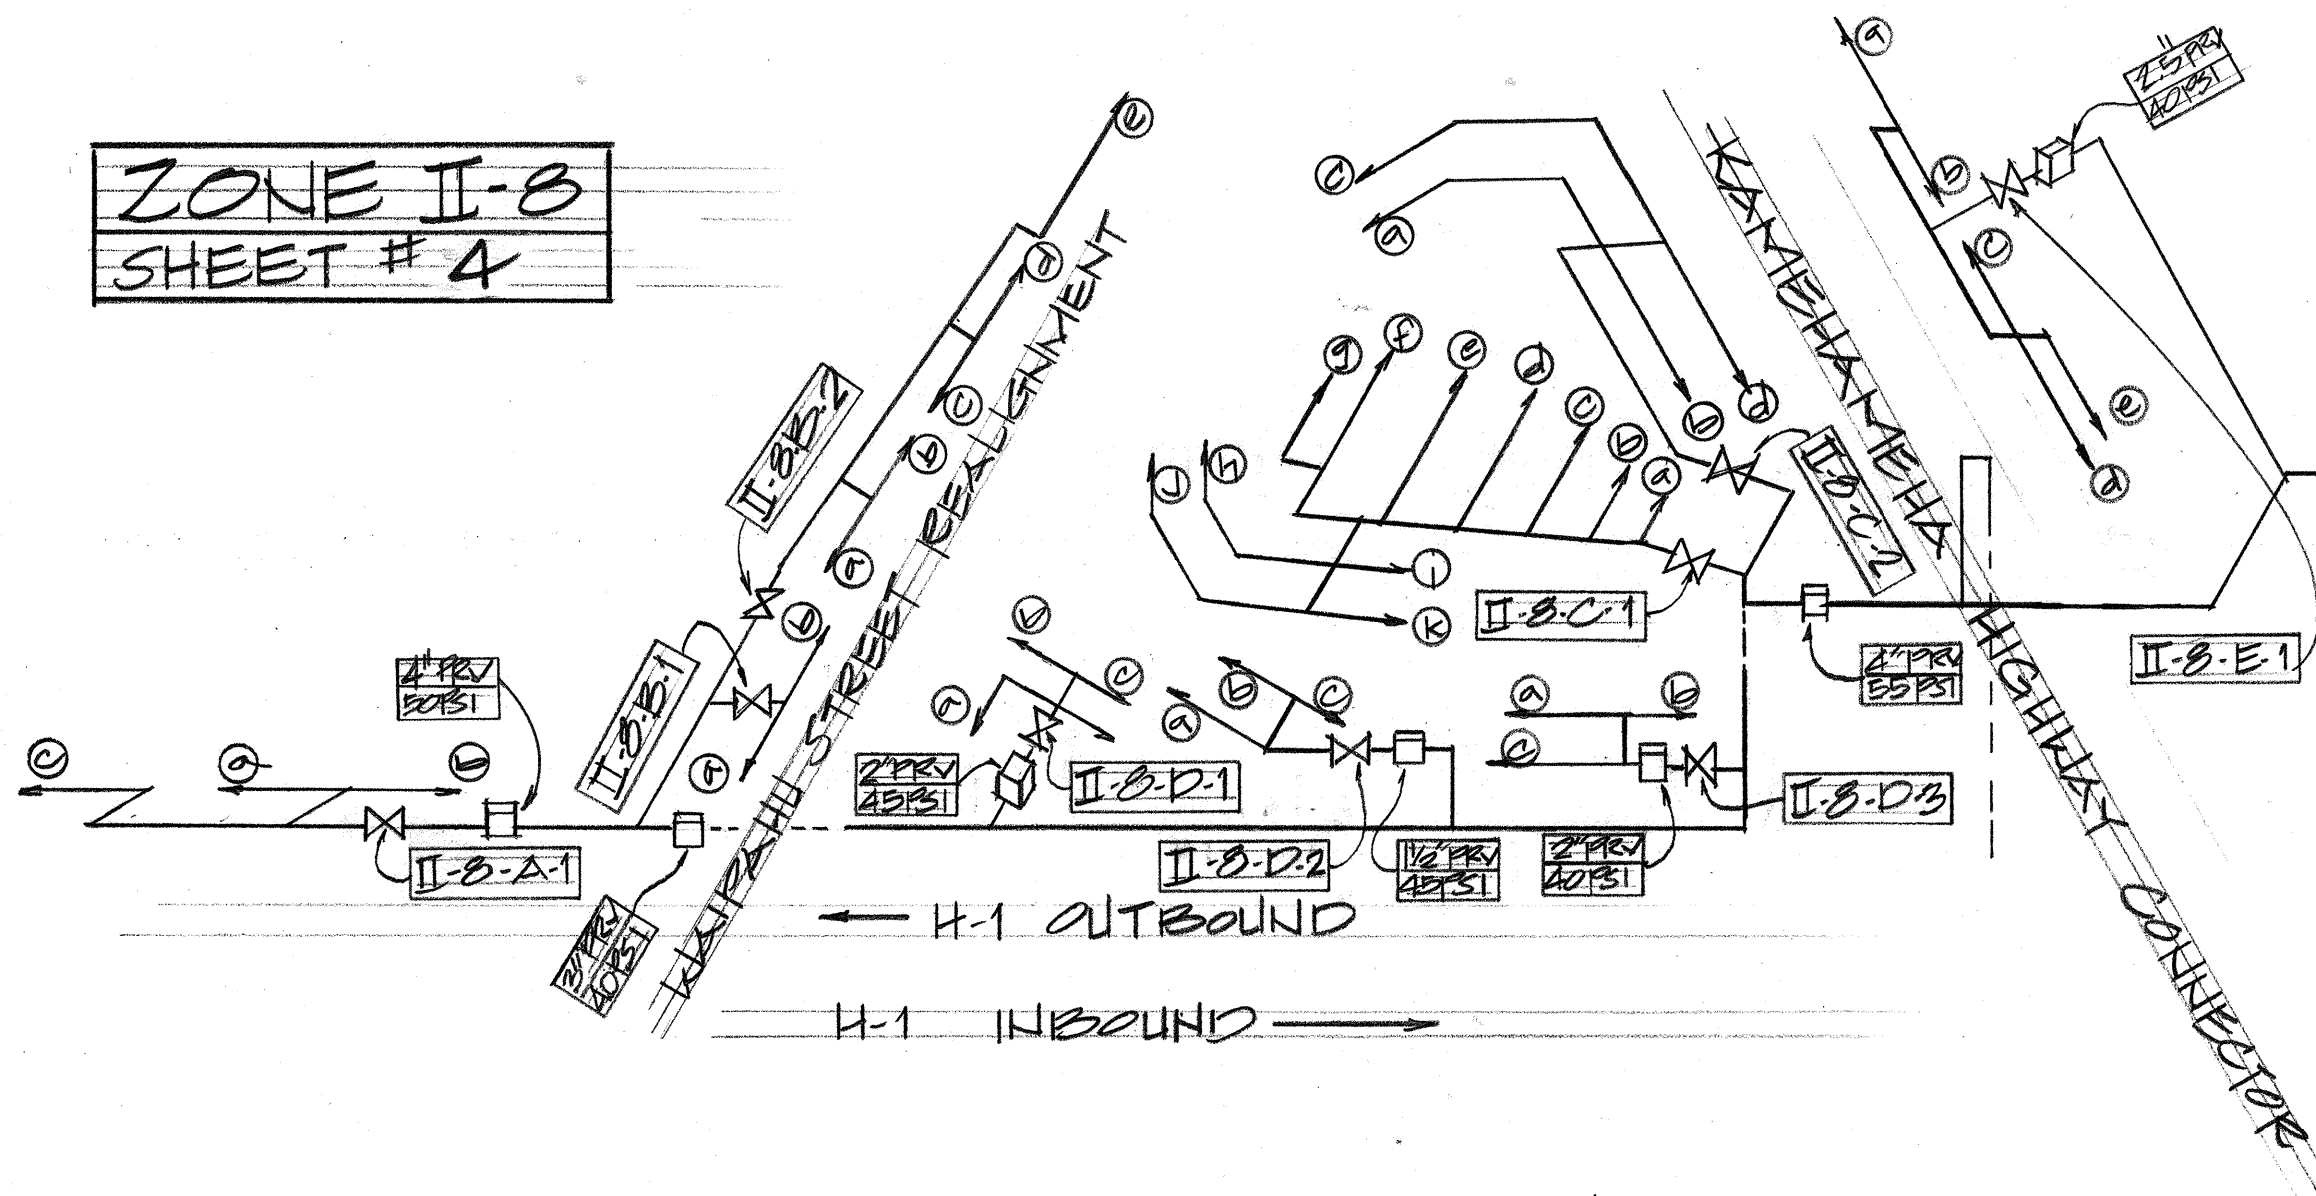



ZONE II-9
SHEET # 5

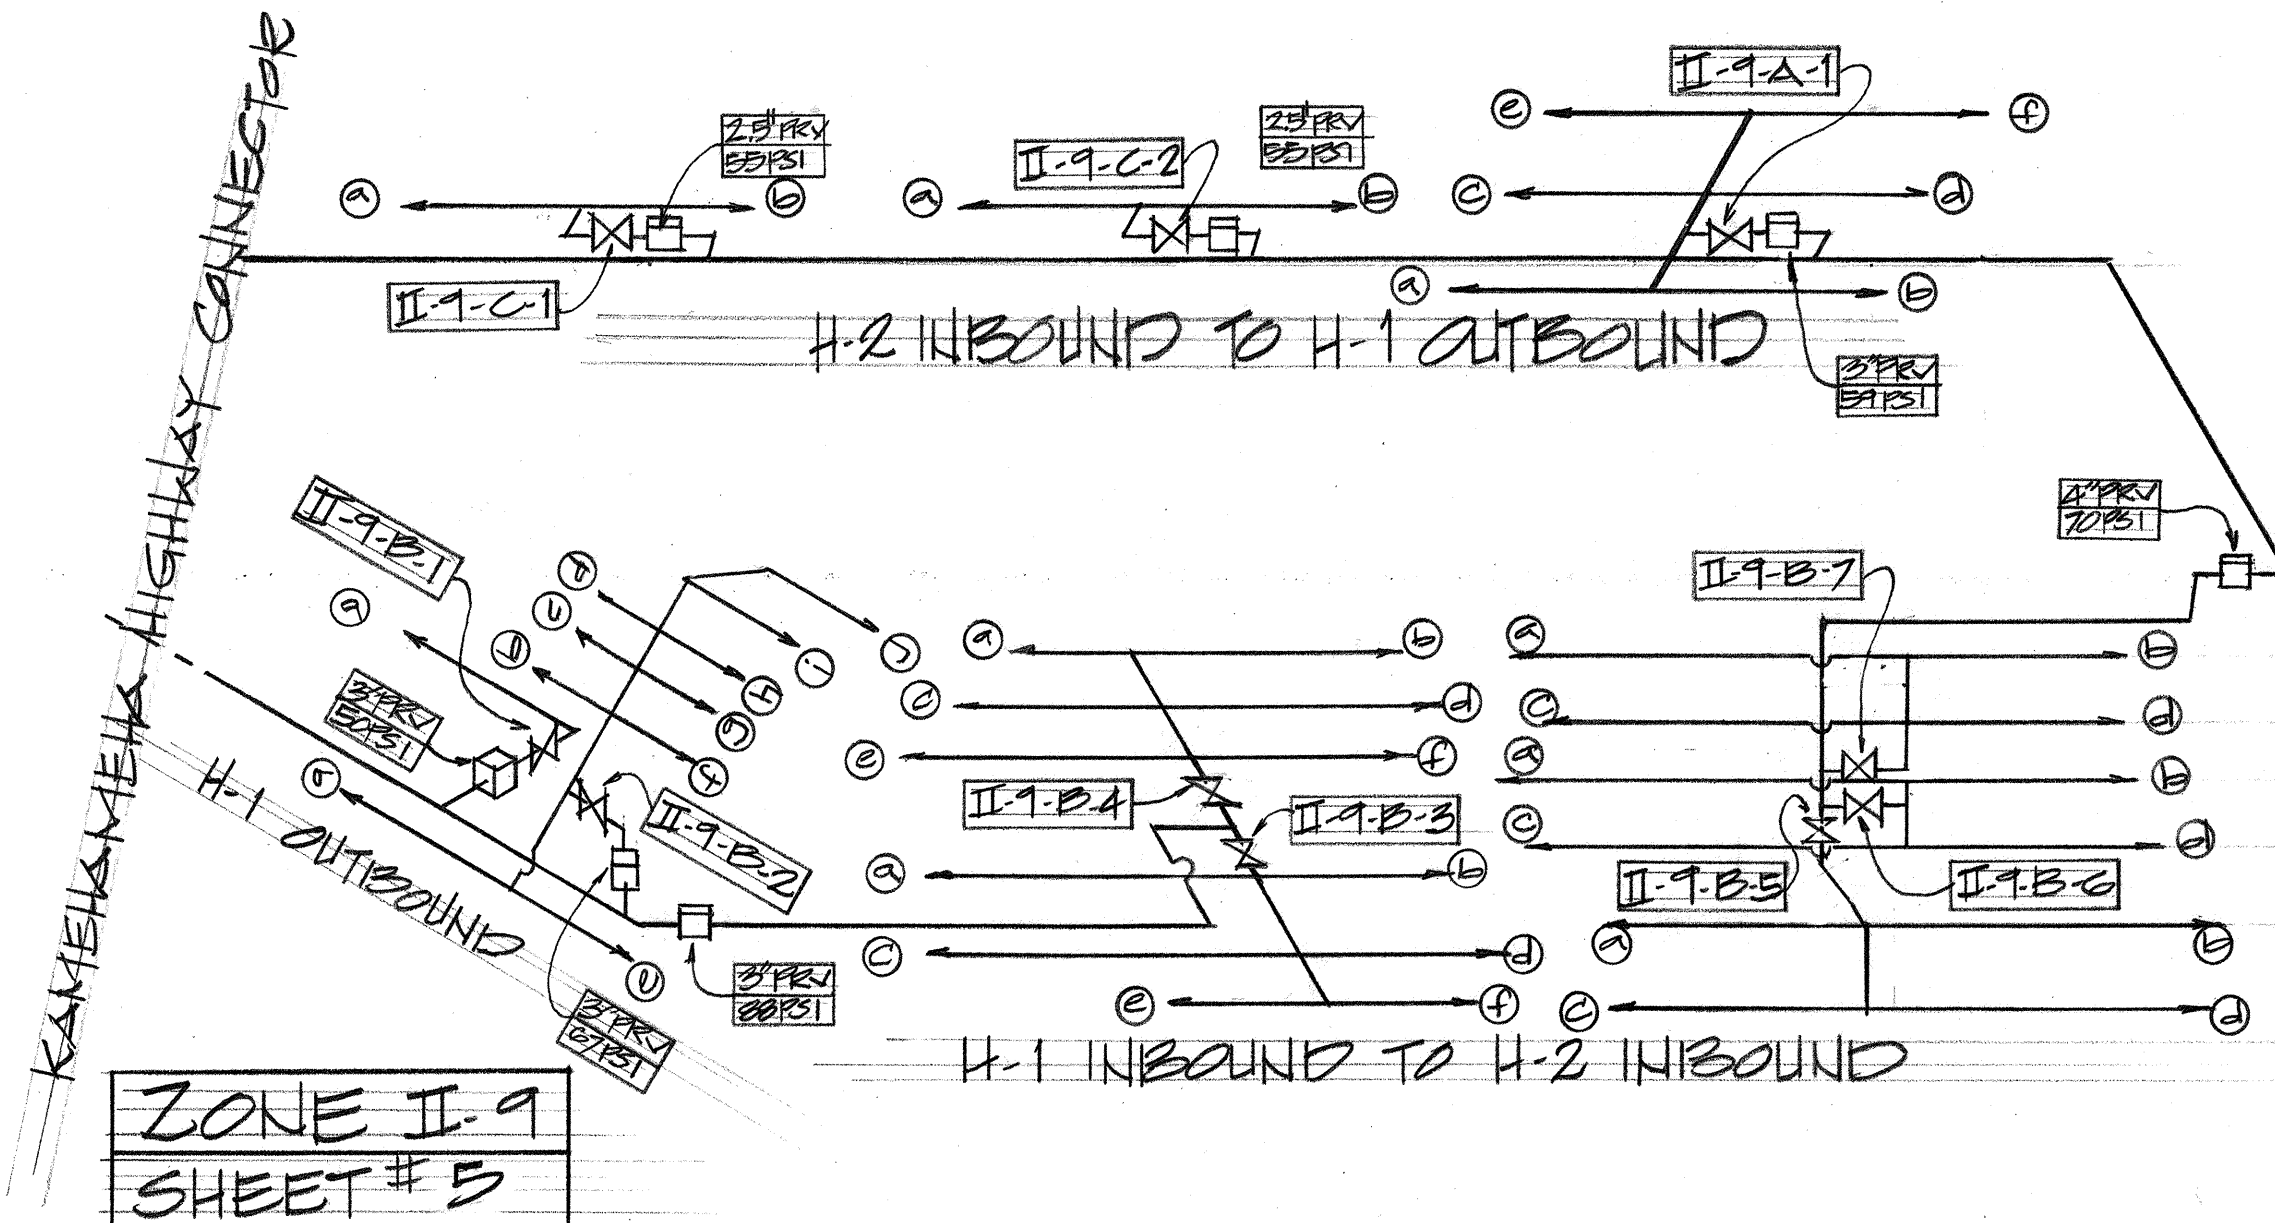

ZONE II-10
SHEET # 6

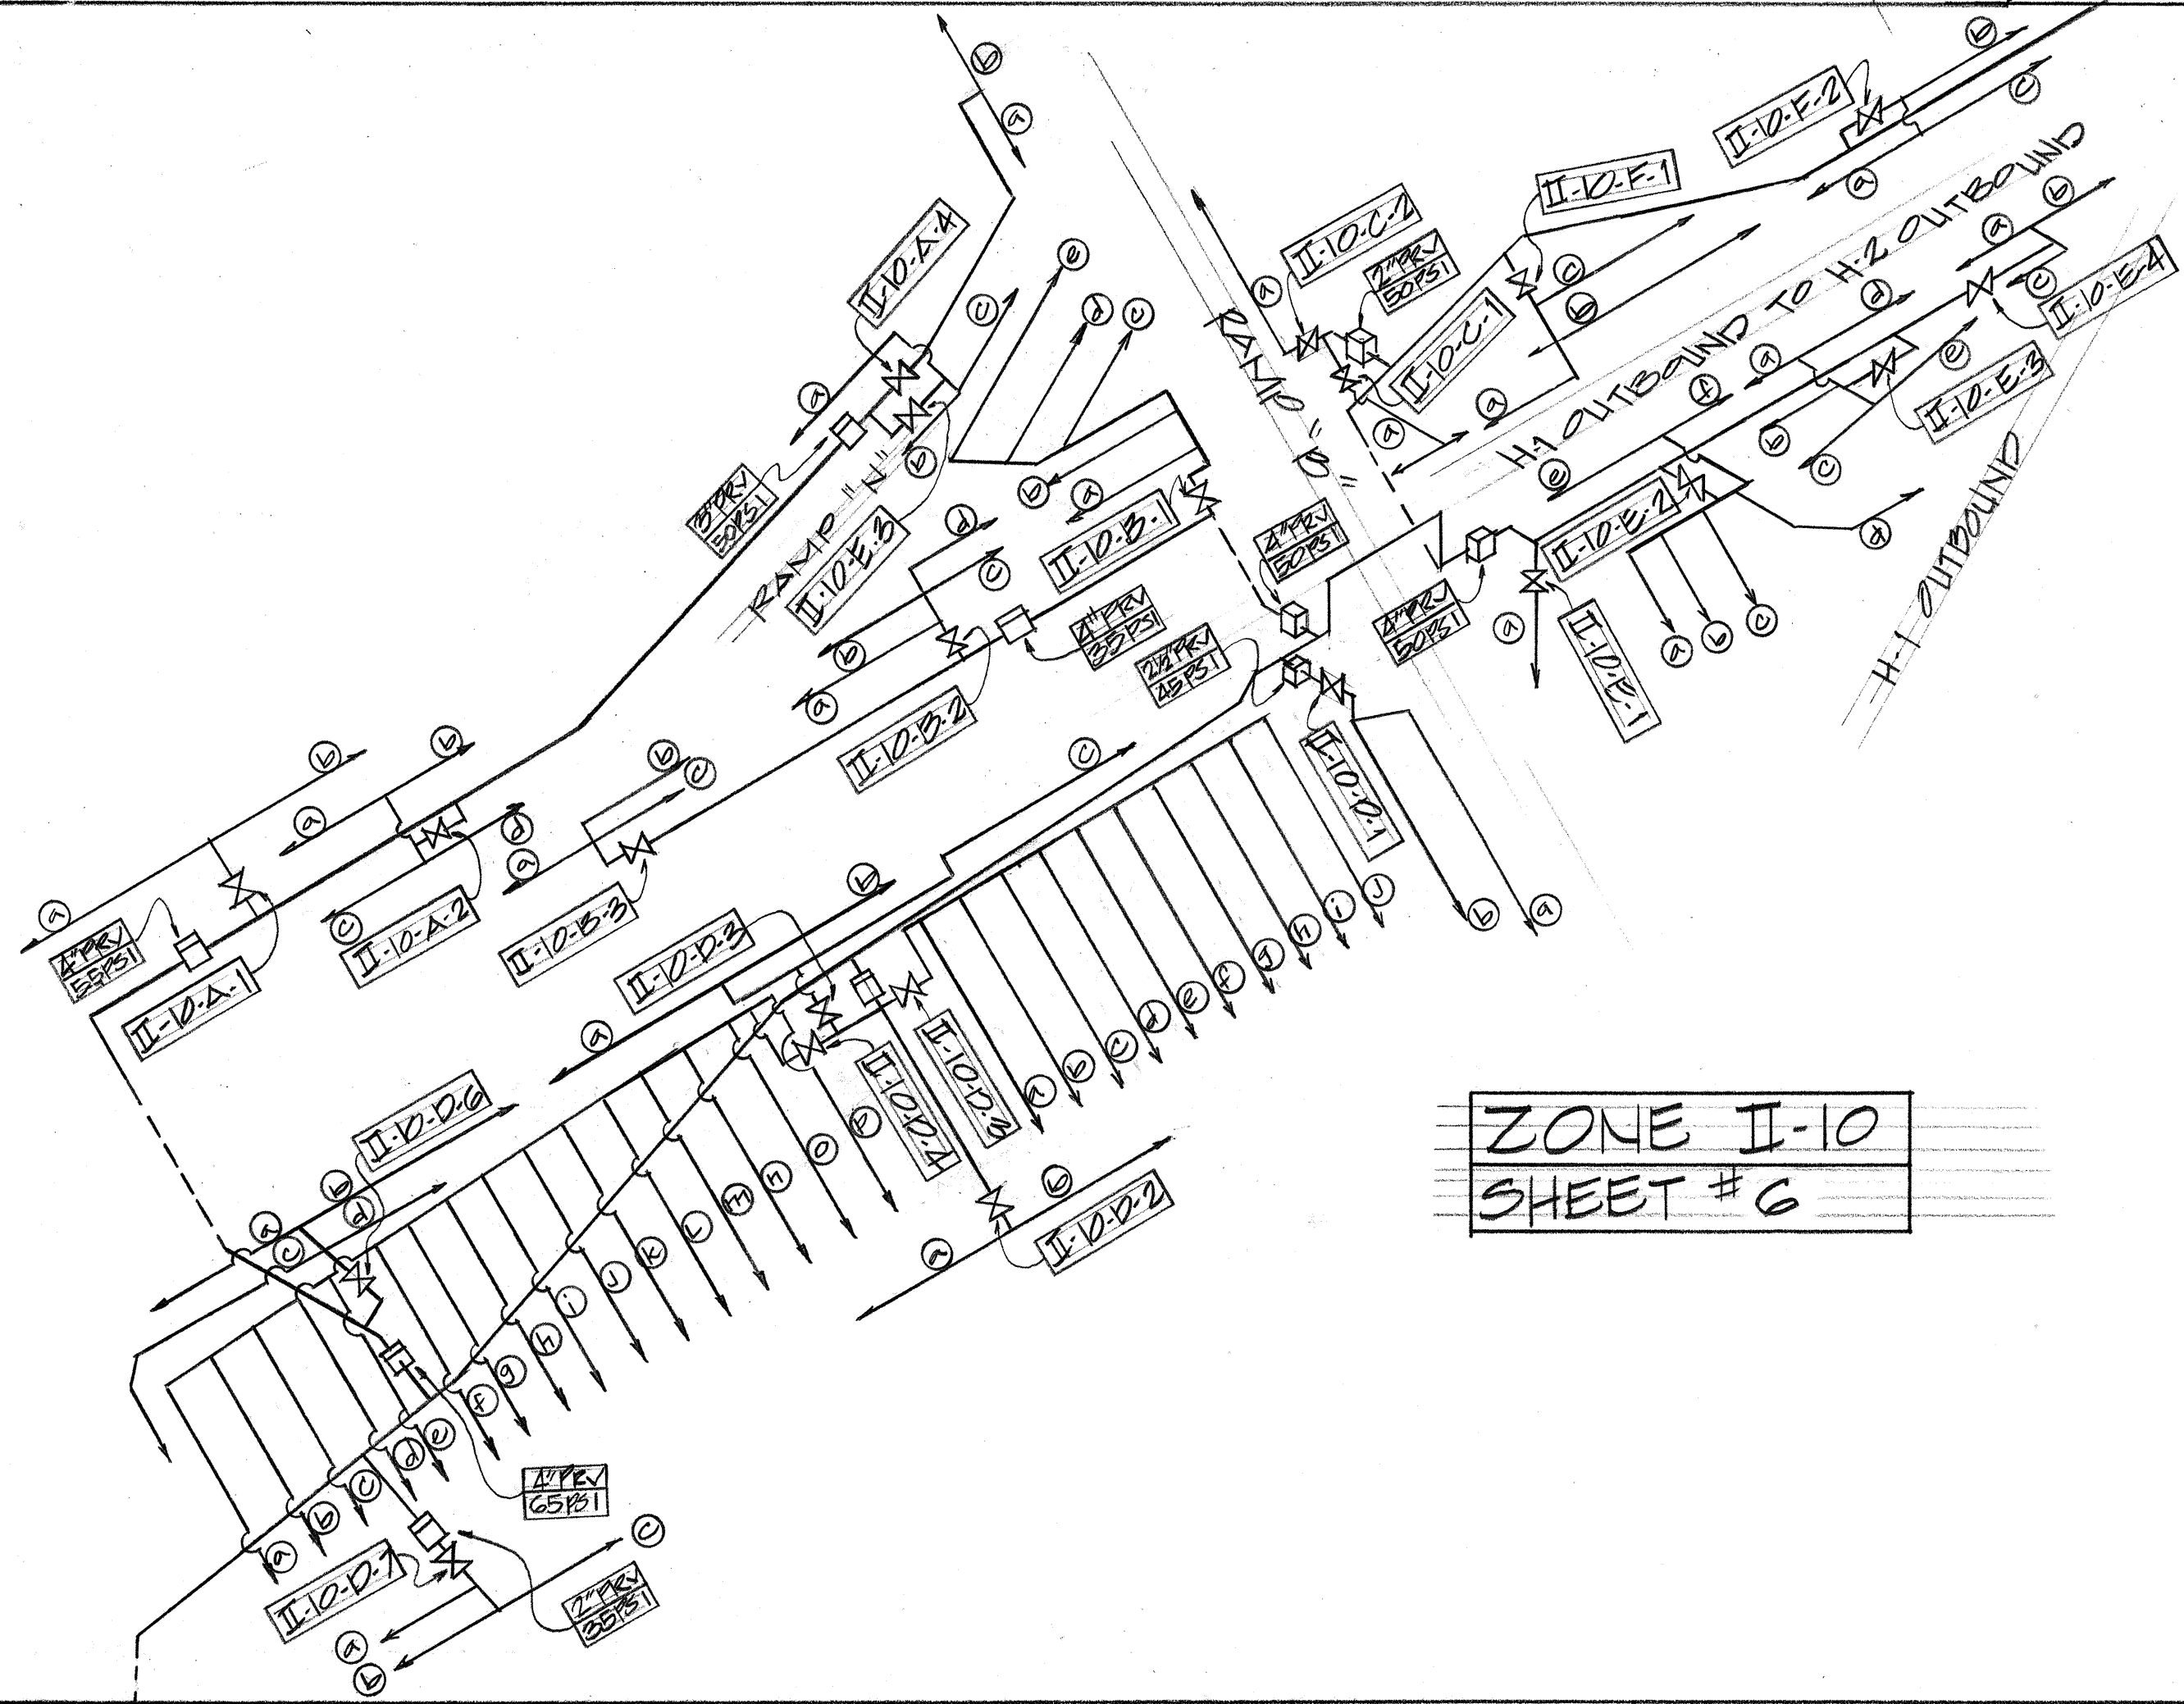

ZONE II-11
SHEET # 7

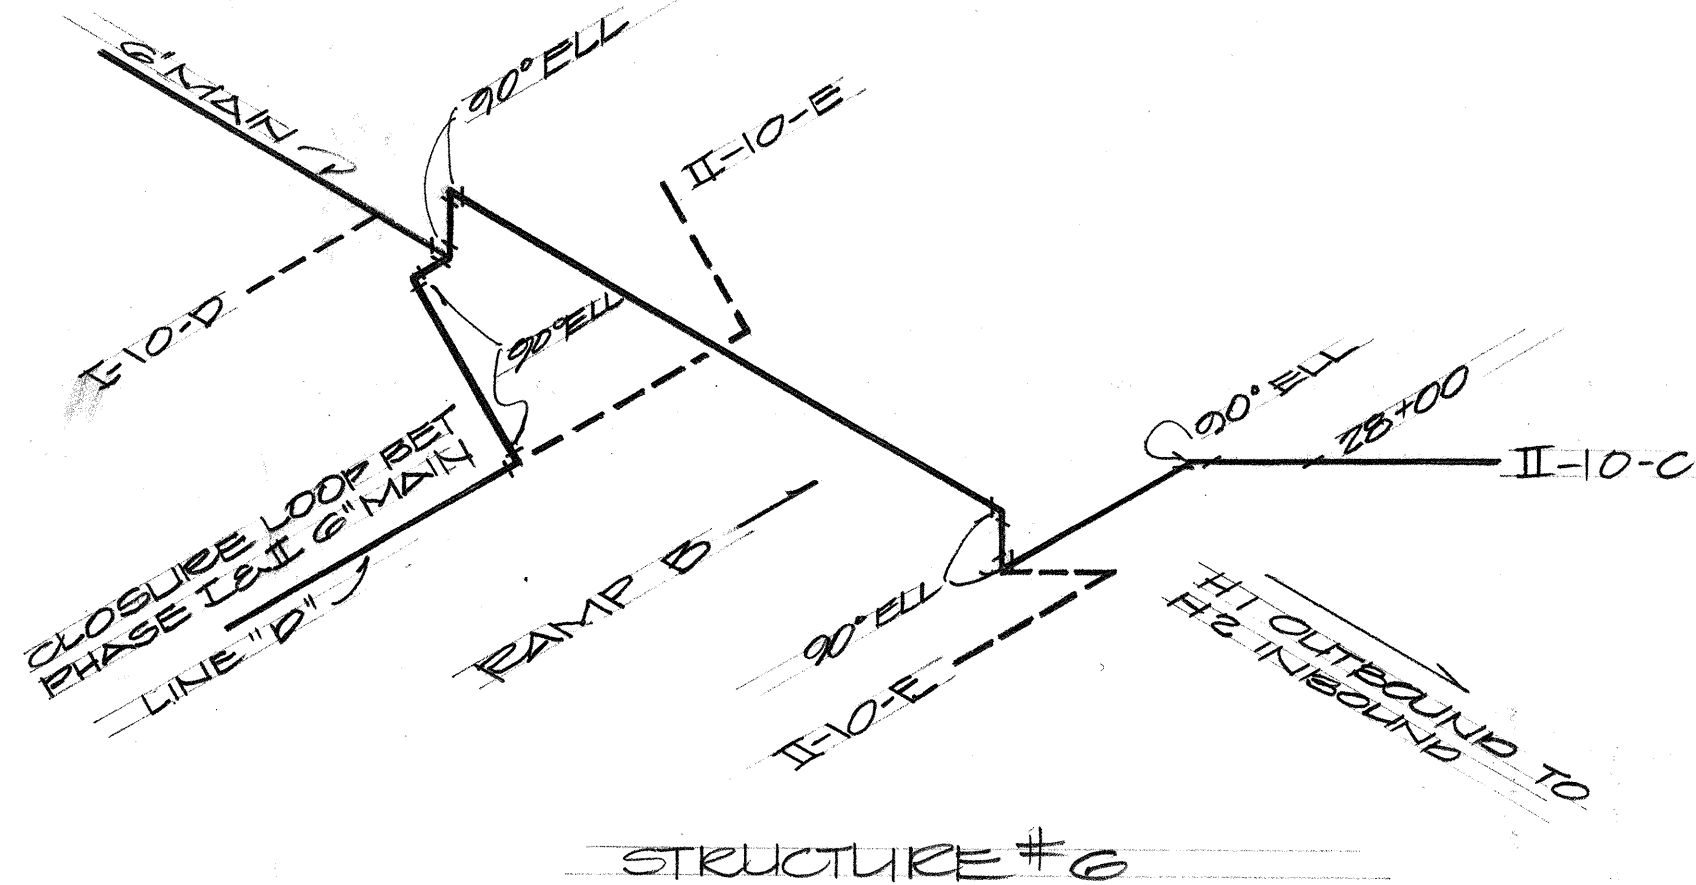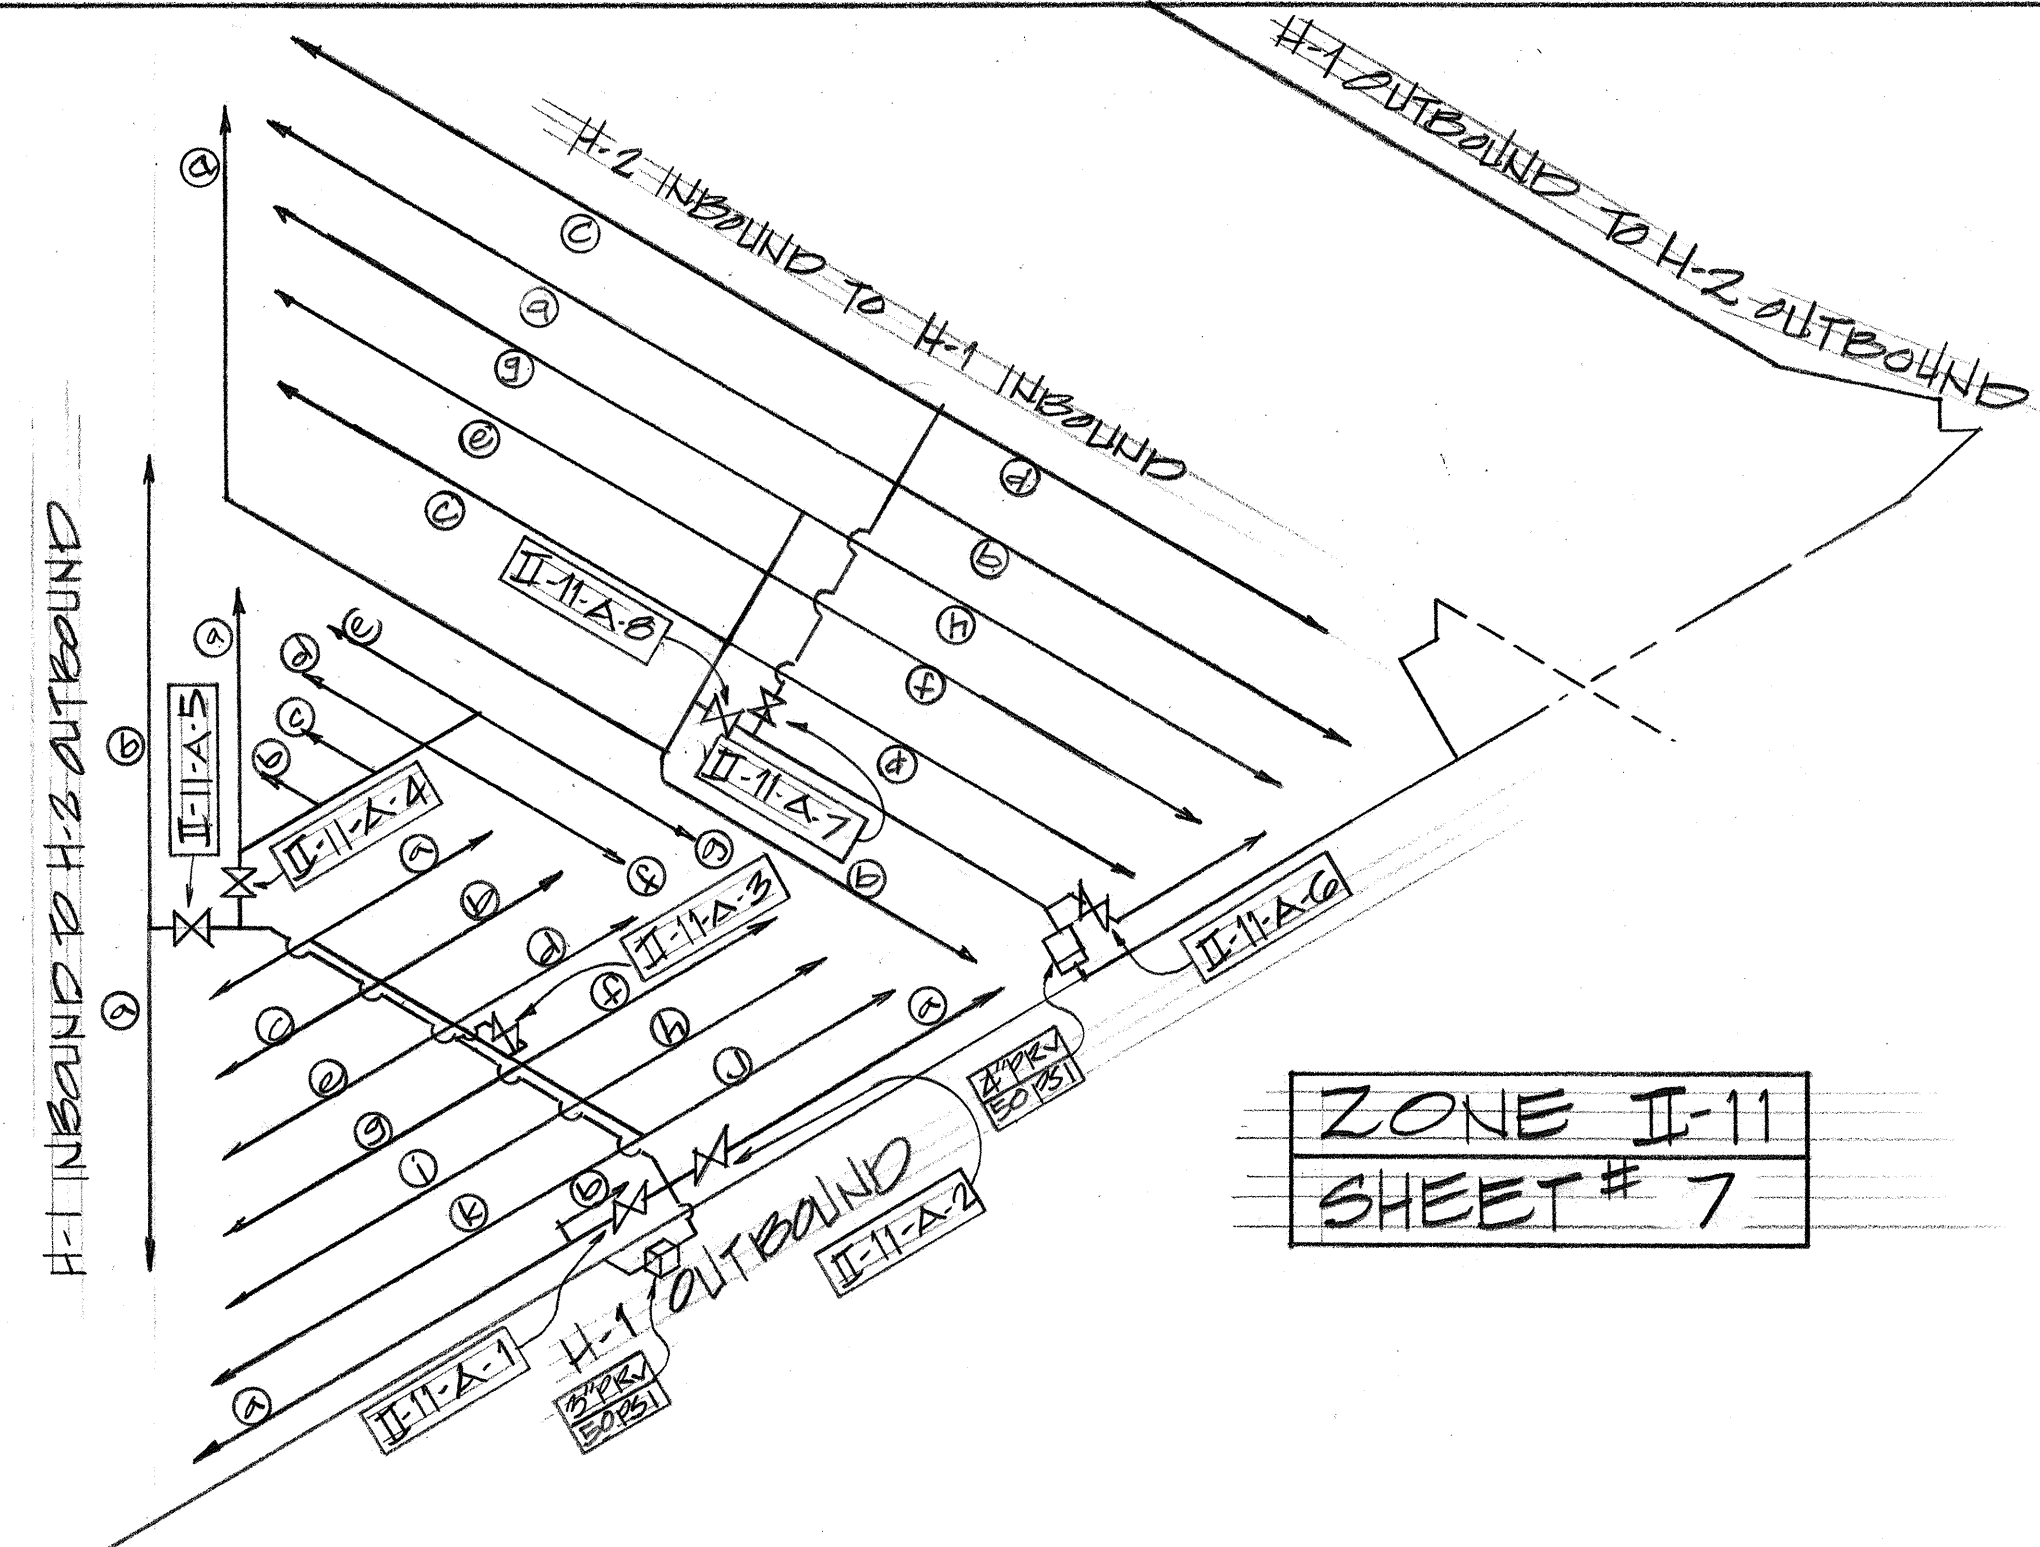

DELETE THIS SHEET SEE
SHEET NO. 11 S-1

PHILLIP K. H. YEE & ASSOCIATES
CONSULTING ENGINEERS
243 Liliuokalani Ave., Rm. 101
Honolulu, Hawaii 96813

CURTIS O. H. YEE
REGISTERED PROFESSIONAL ENGINEER
No. 2624-E
HAWAII, U.S.A.

THIS WORK WAS PREPARED BY ME
OR UNDER MY SUPERVISION.

STATE OF HAWAII
DEPARTMENT OF TRANSPORTATION
HIGHWAYS DIVISION






WAIAWA INTERCHANGE
WATER SPRINKLER SYSTEM
PROJ # I-11-1(97):B

SPRINKLER BRANCH
ISOMETRICS

SHEET No. 11 OF 18 SHEETS

ORIGINAL PLAN	SURVEY PLOTTED BY	DATE
NOTE BOOK	DRAWN BY	
	TRACED BY	
	QUANTITIES BY	
	CHECKED BY	

FED. ROAD DIST. NO.	STATE	FED. AID PROJ. NO.	FISCAL YEAR	SHEET NO.	TOTAL SHEETS
HAWAII	HAW.	I-HI-1(97):8	1973	115-1	27

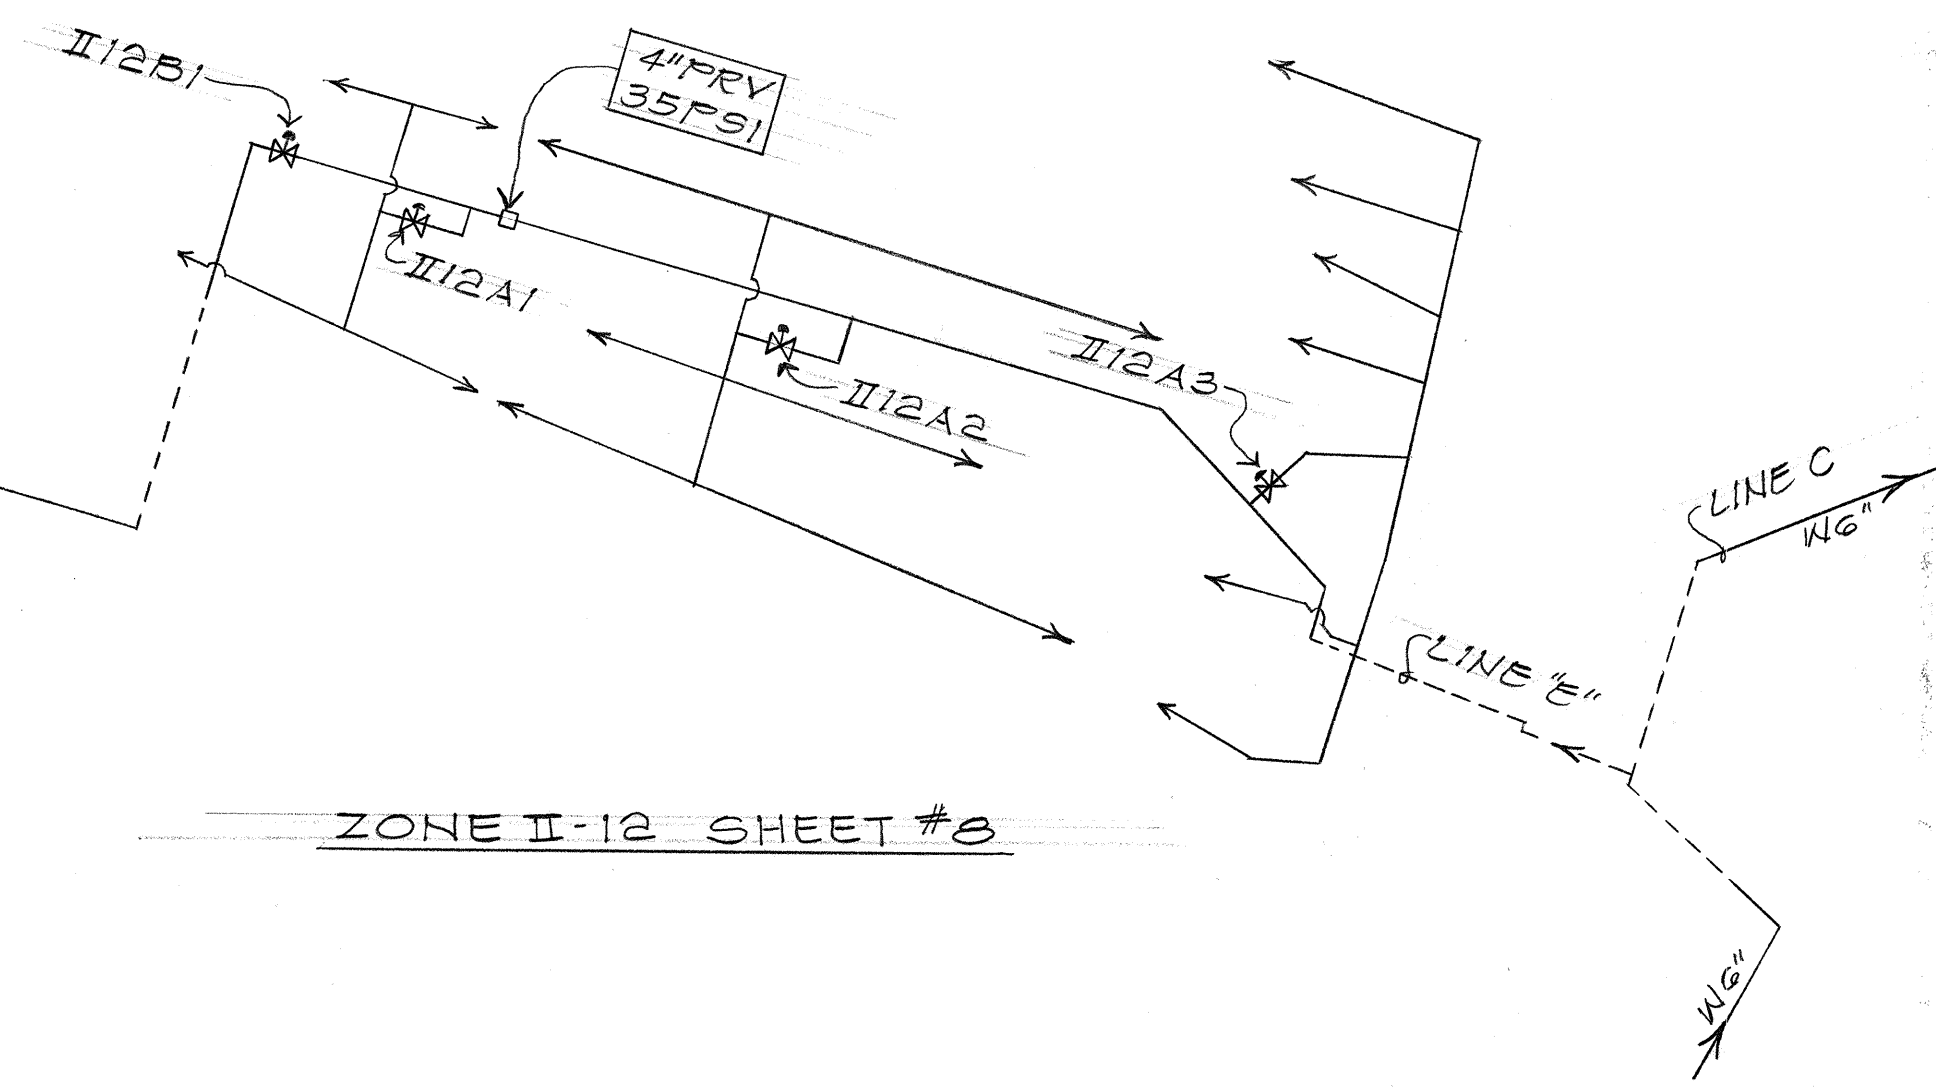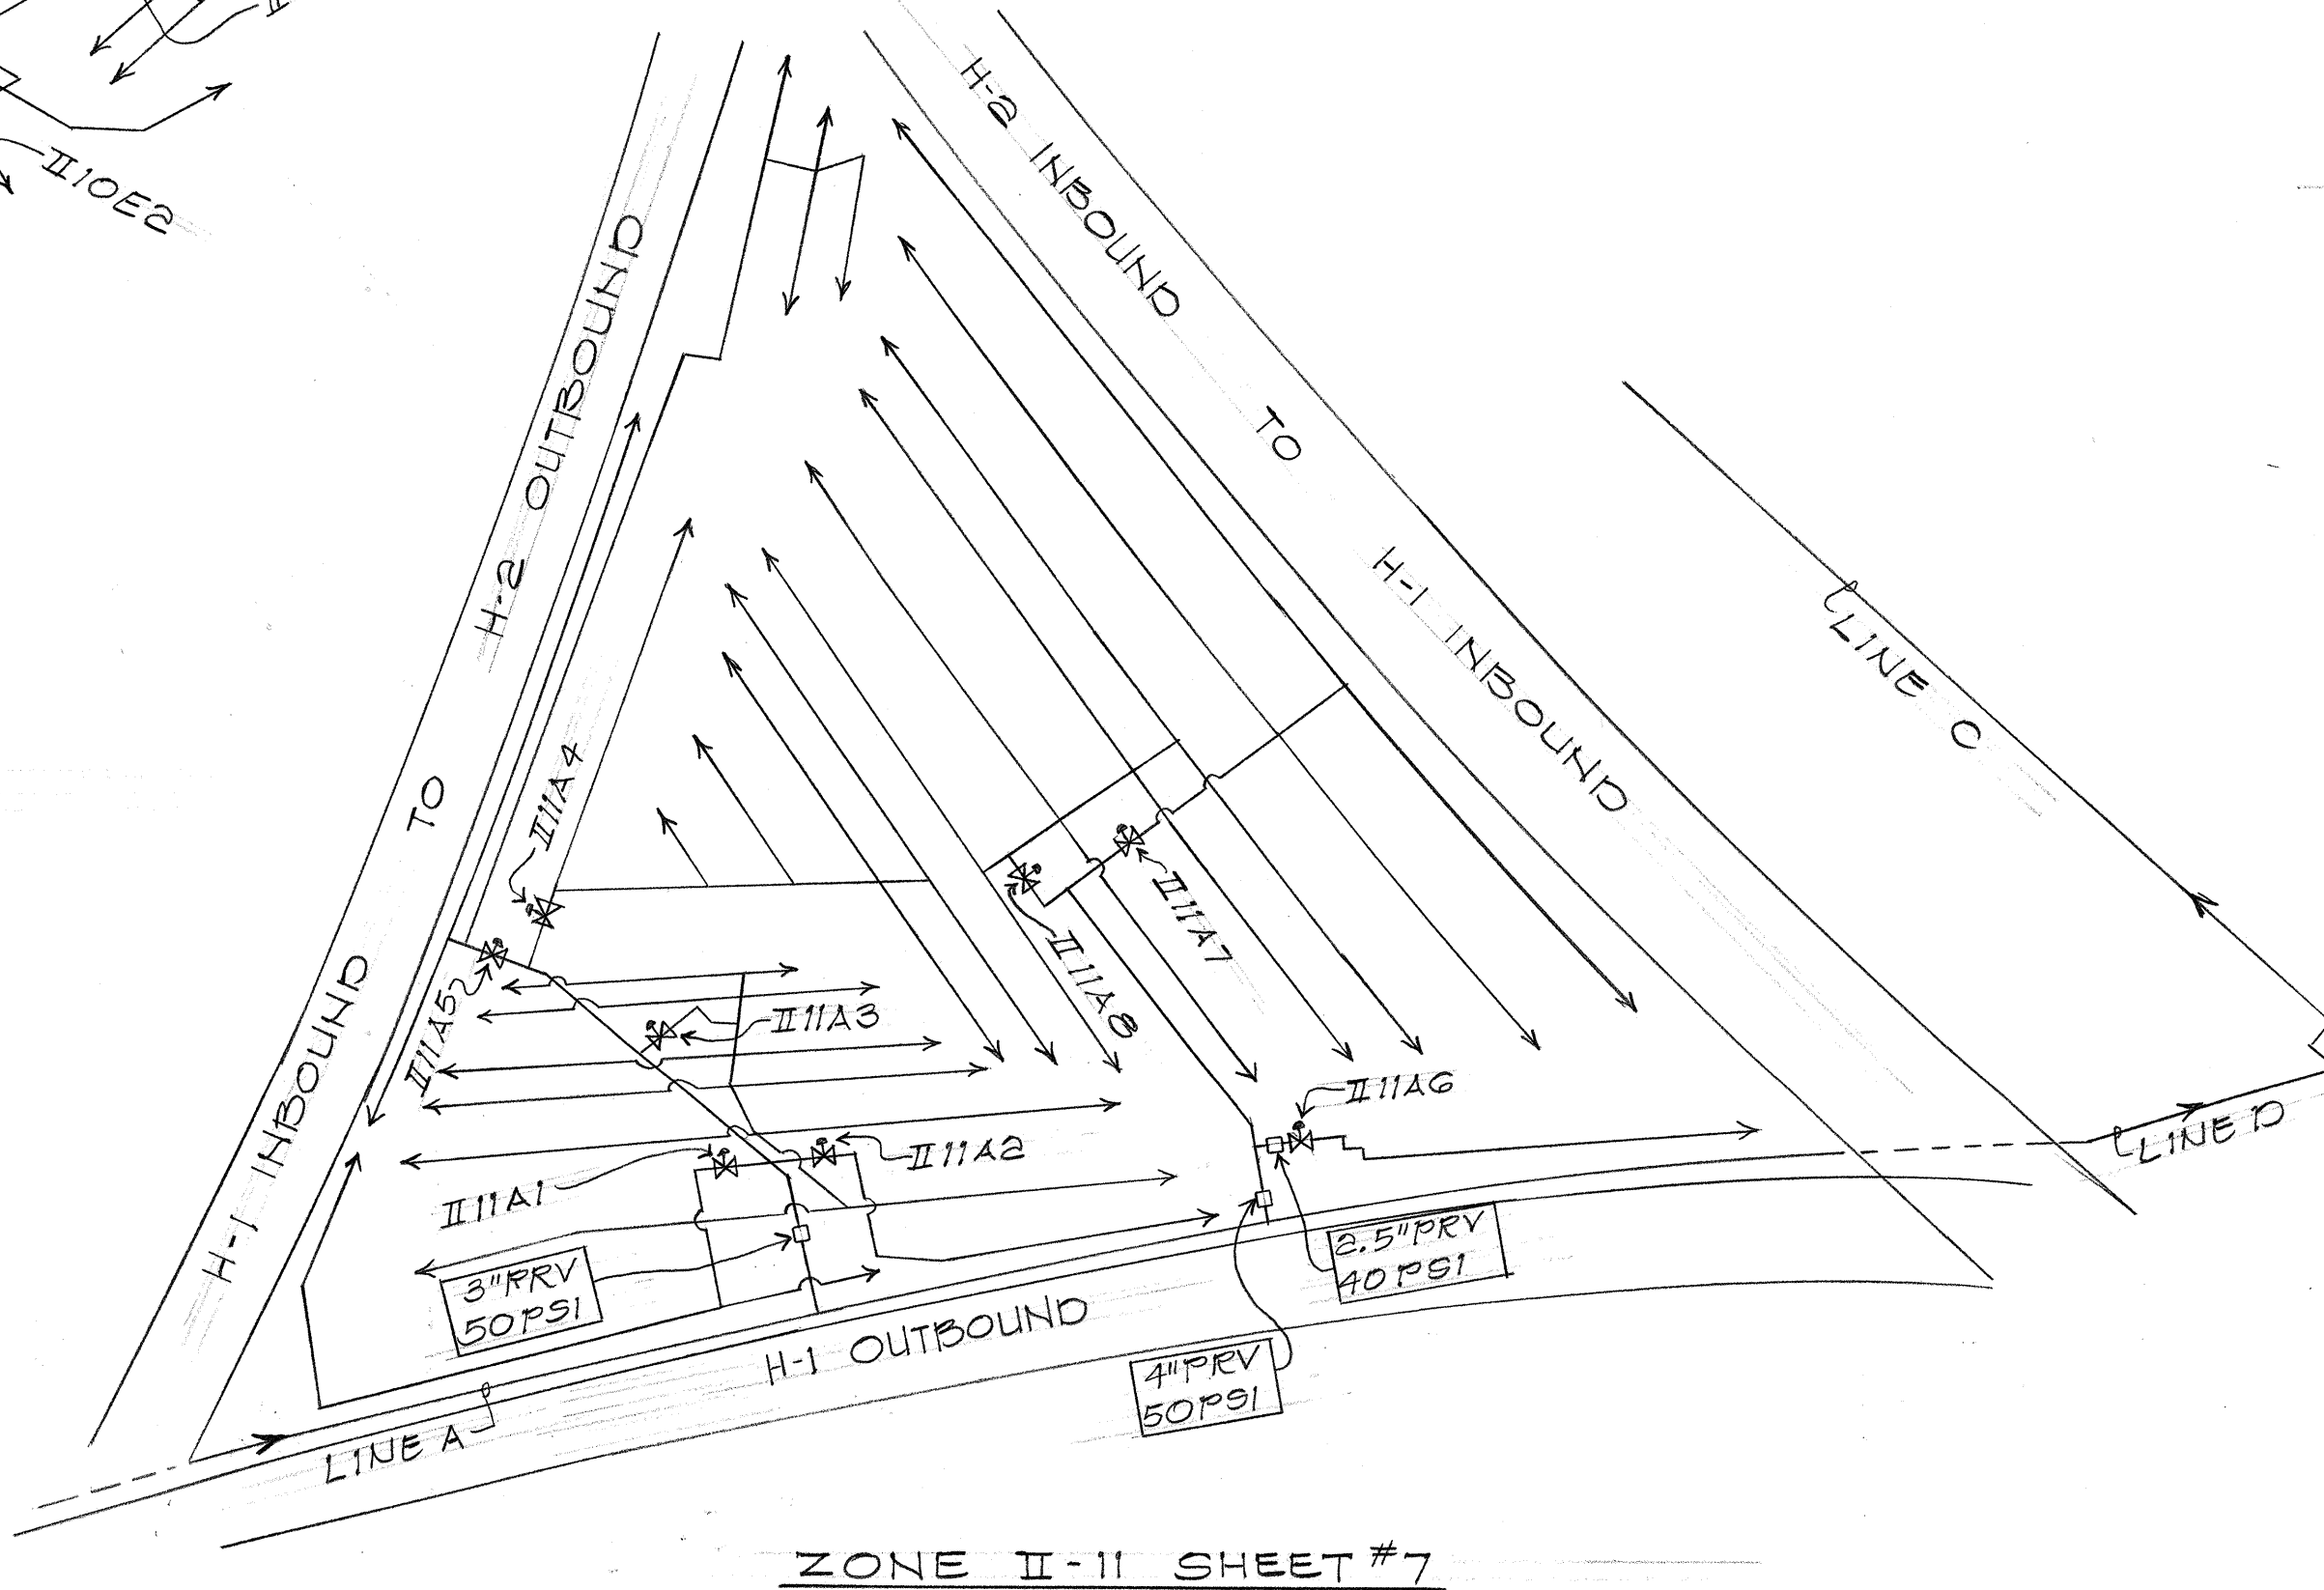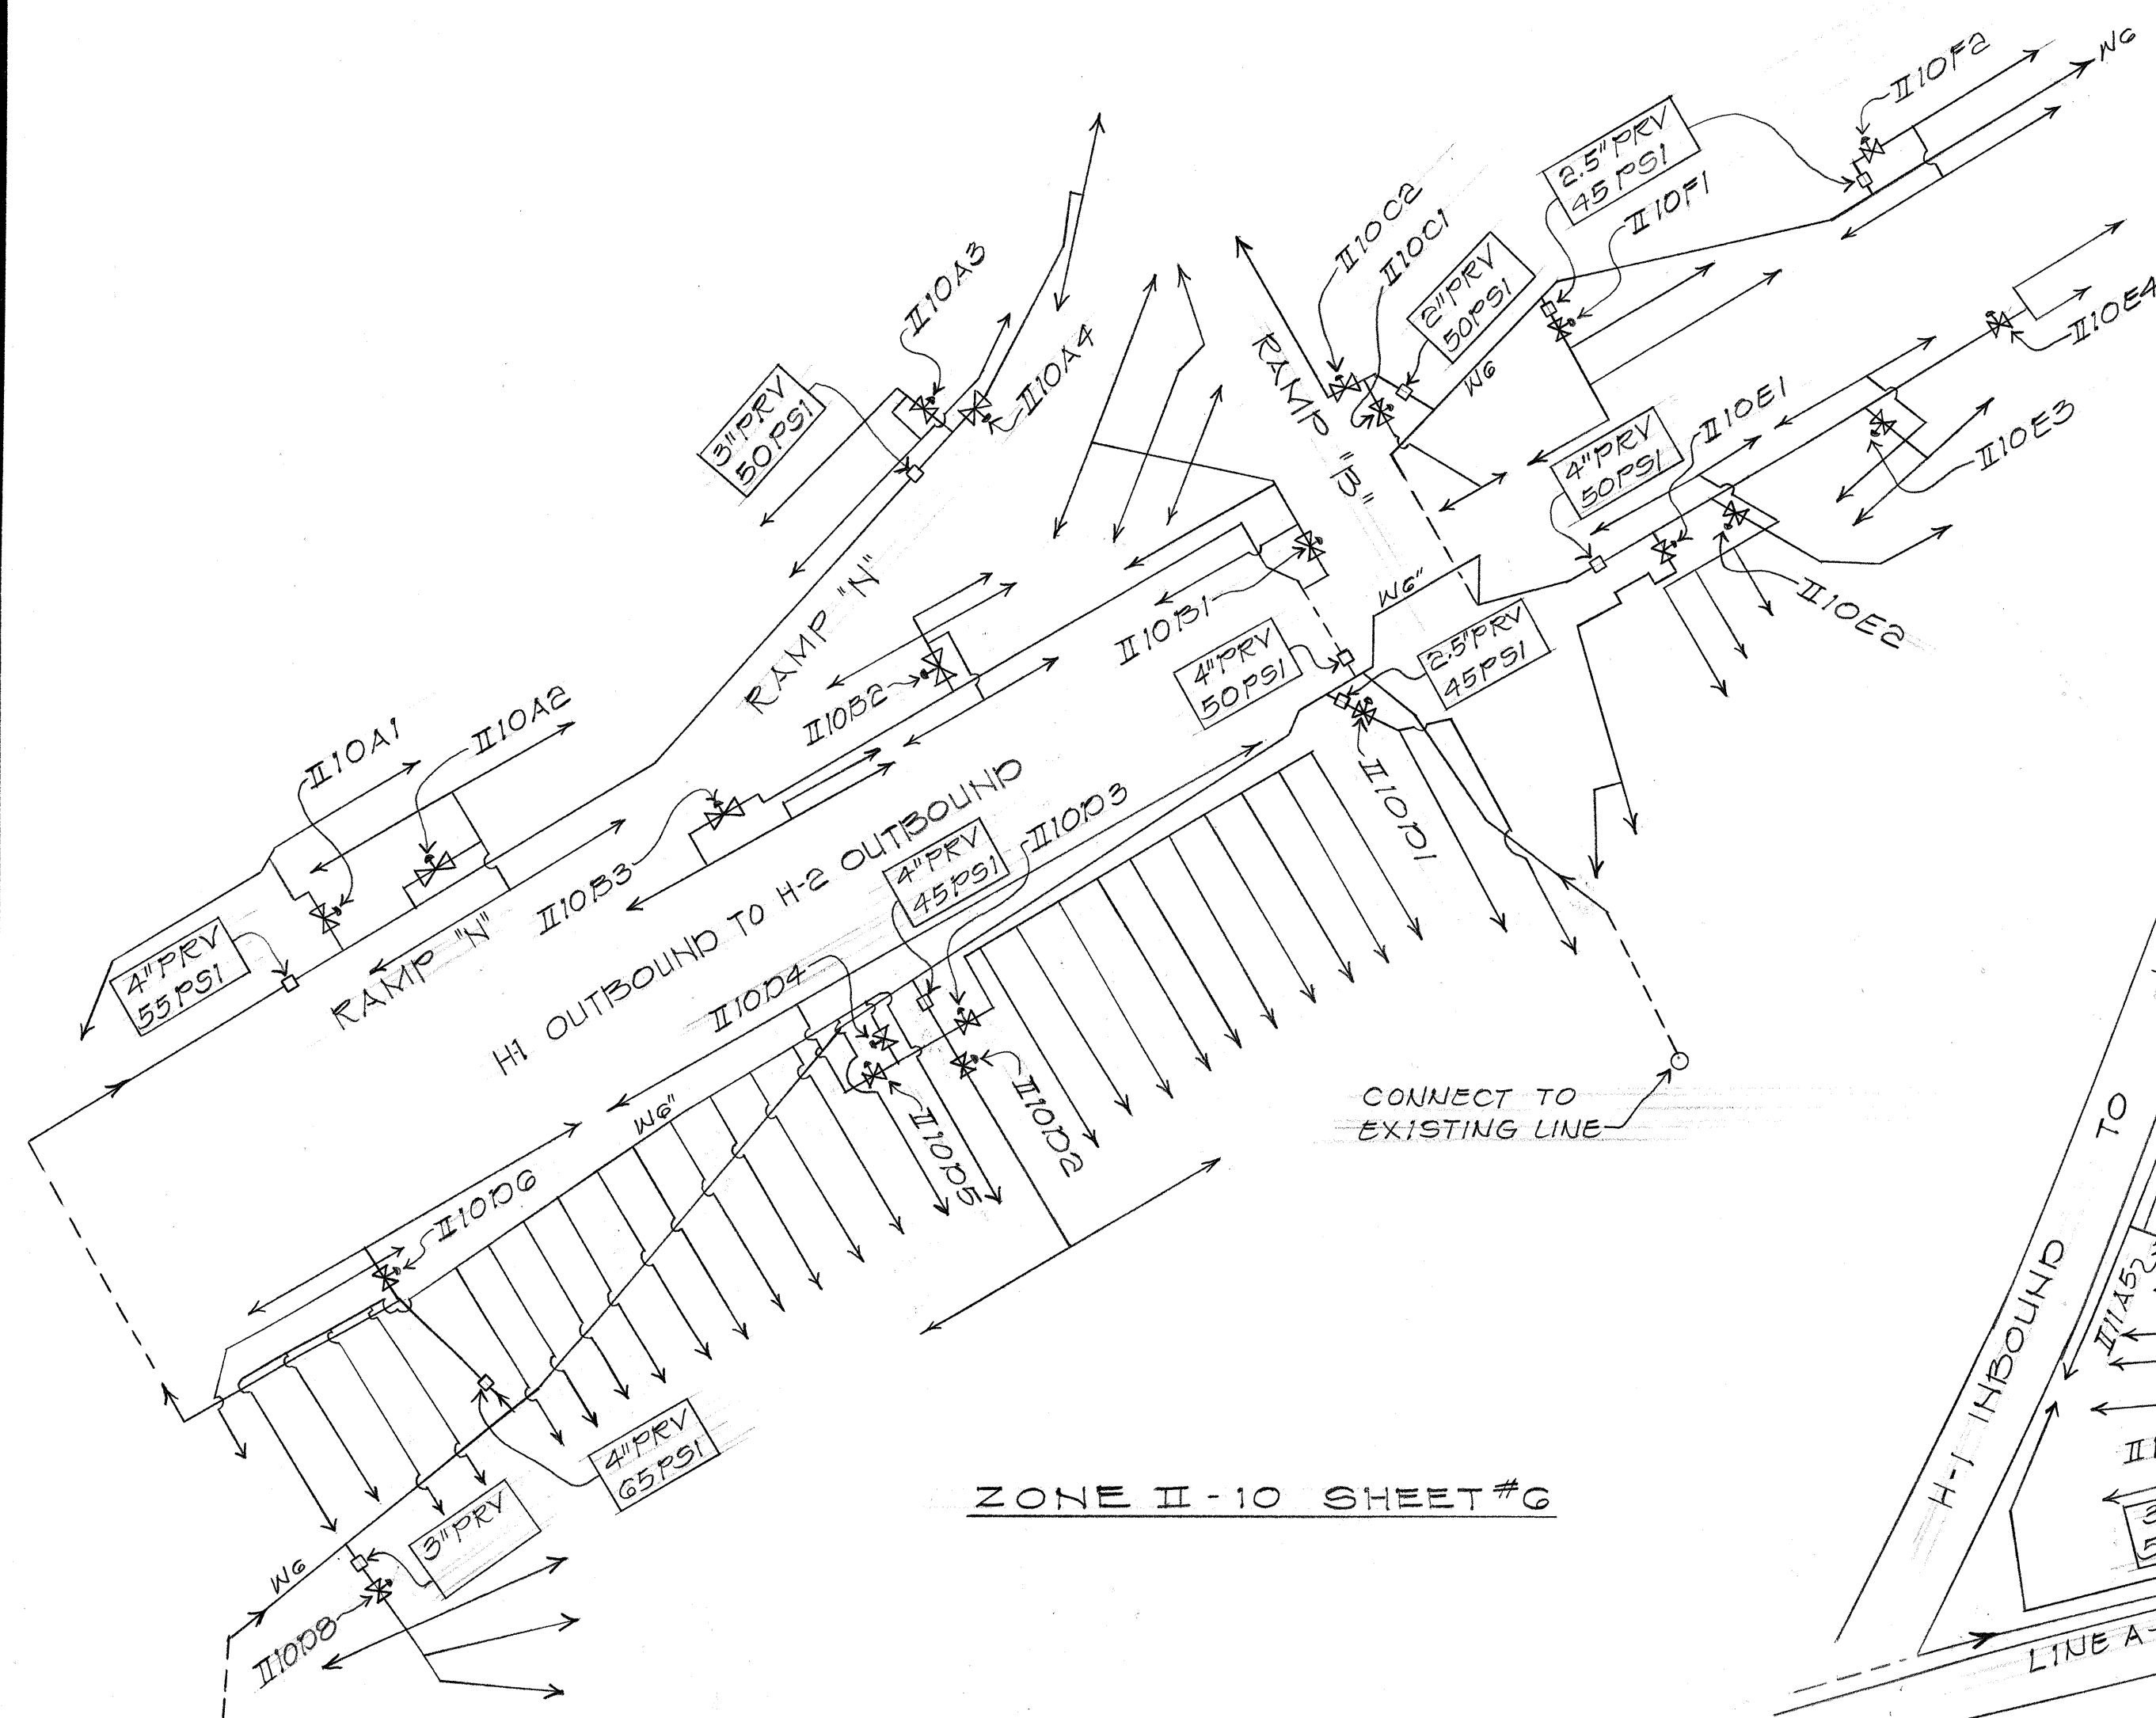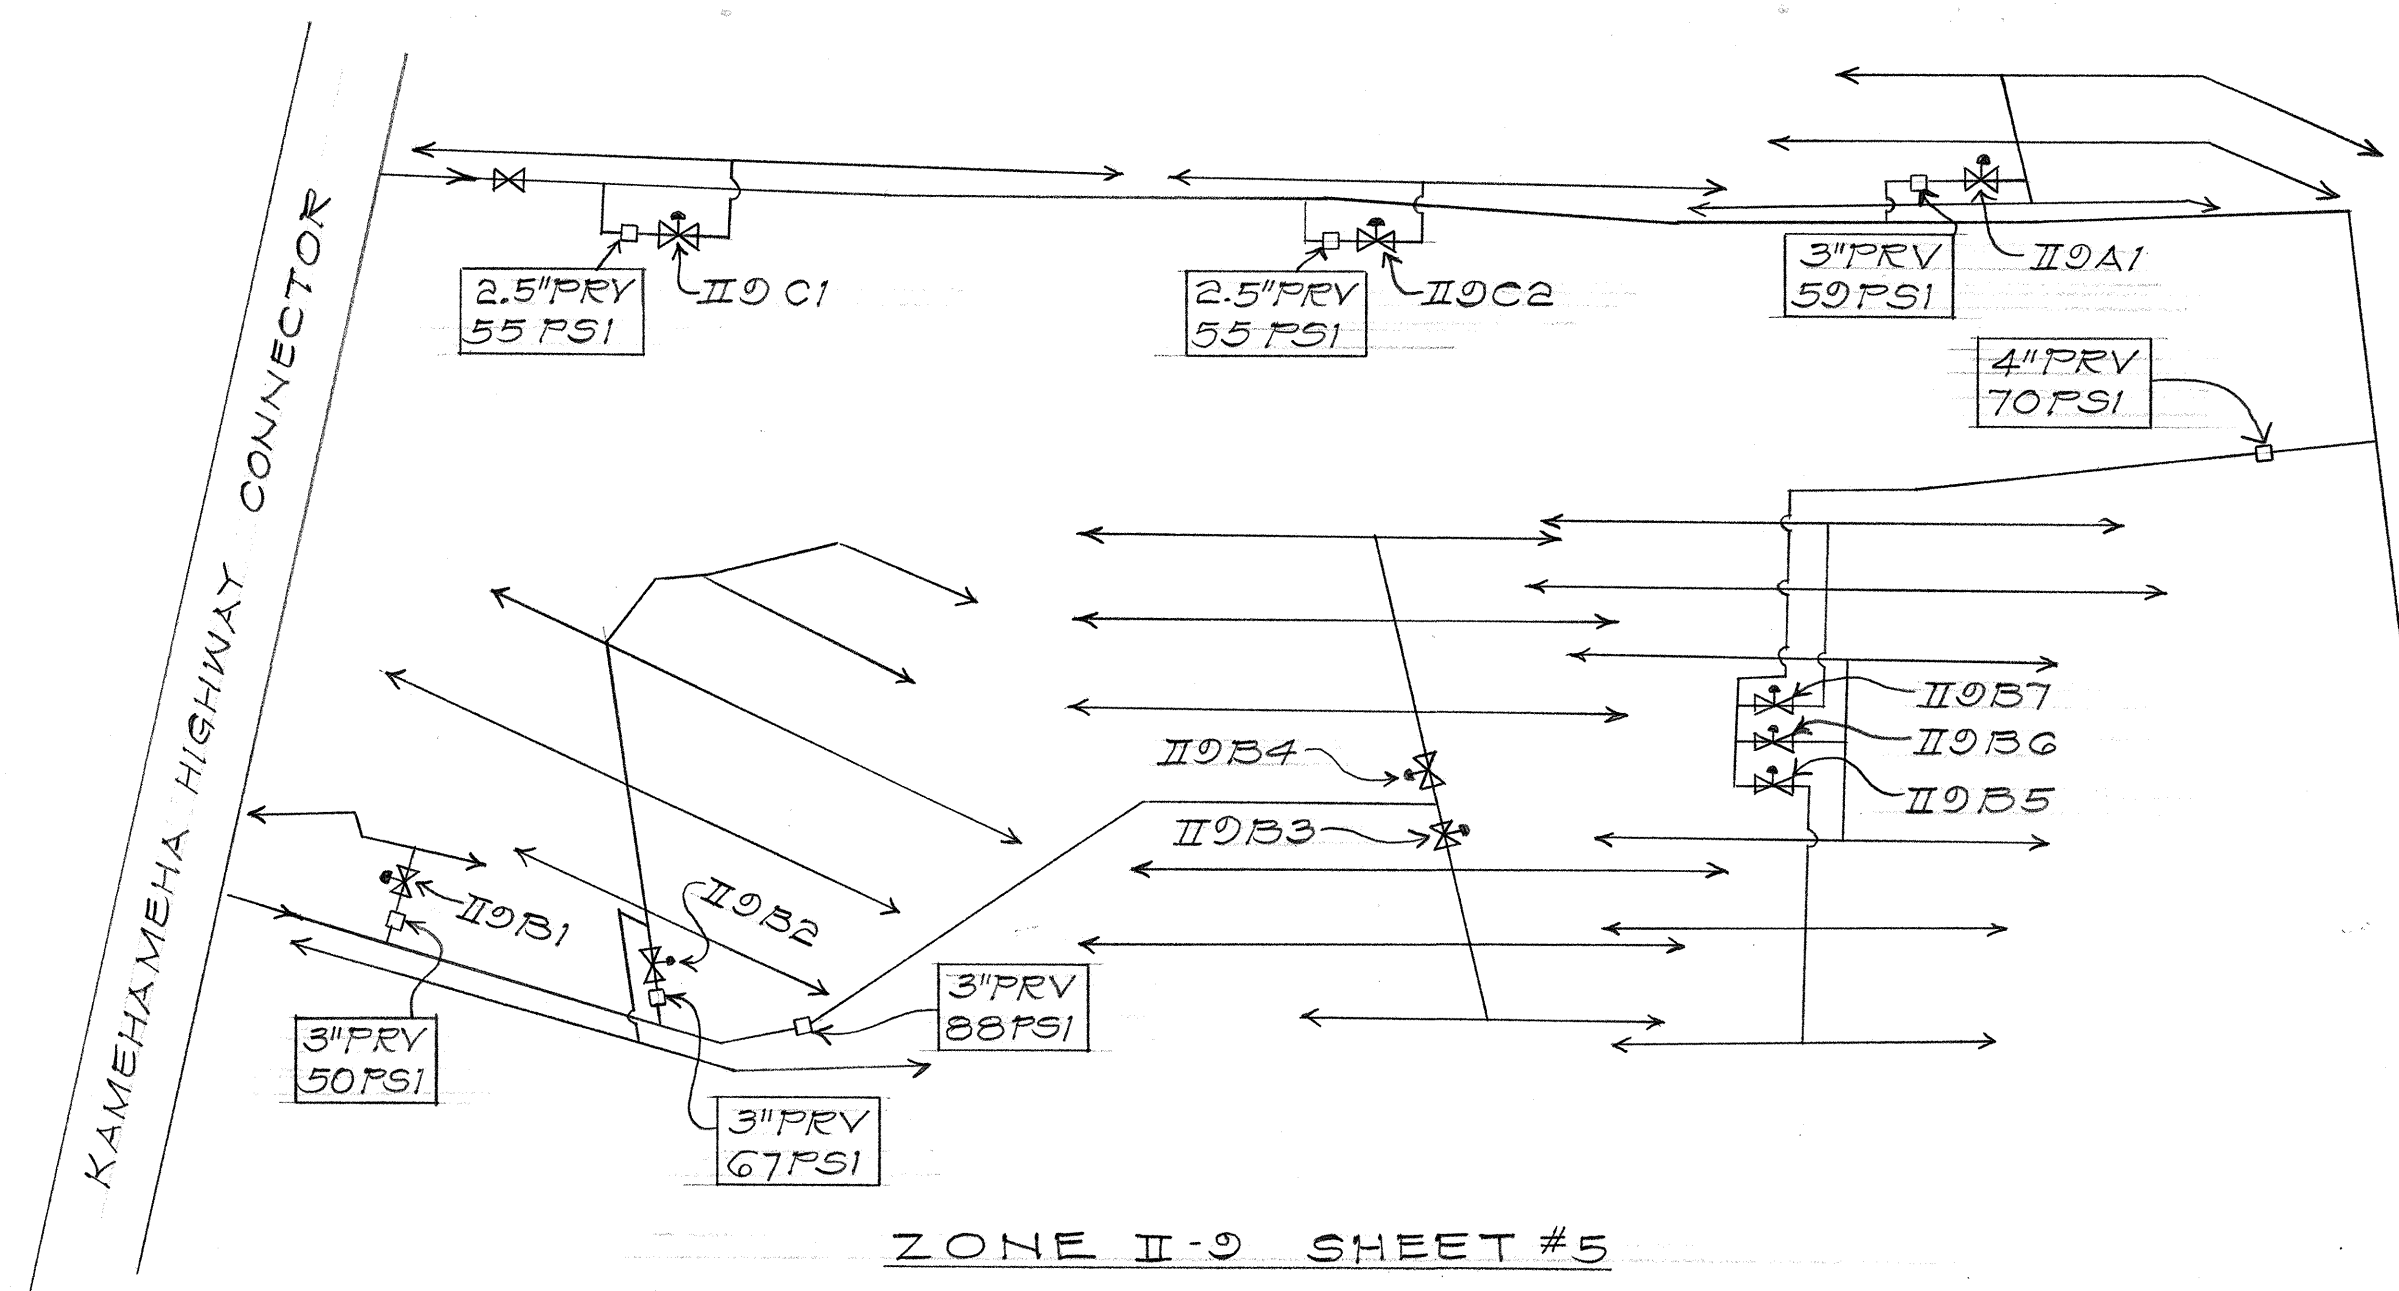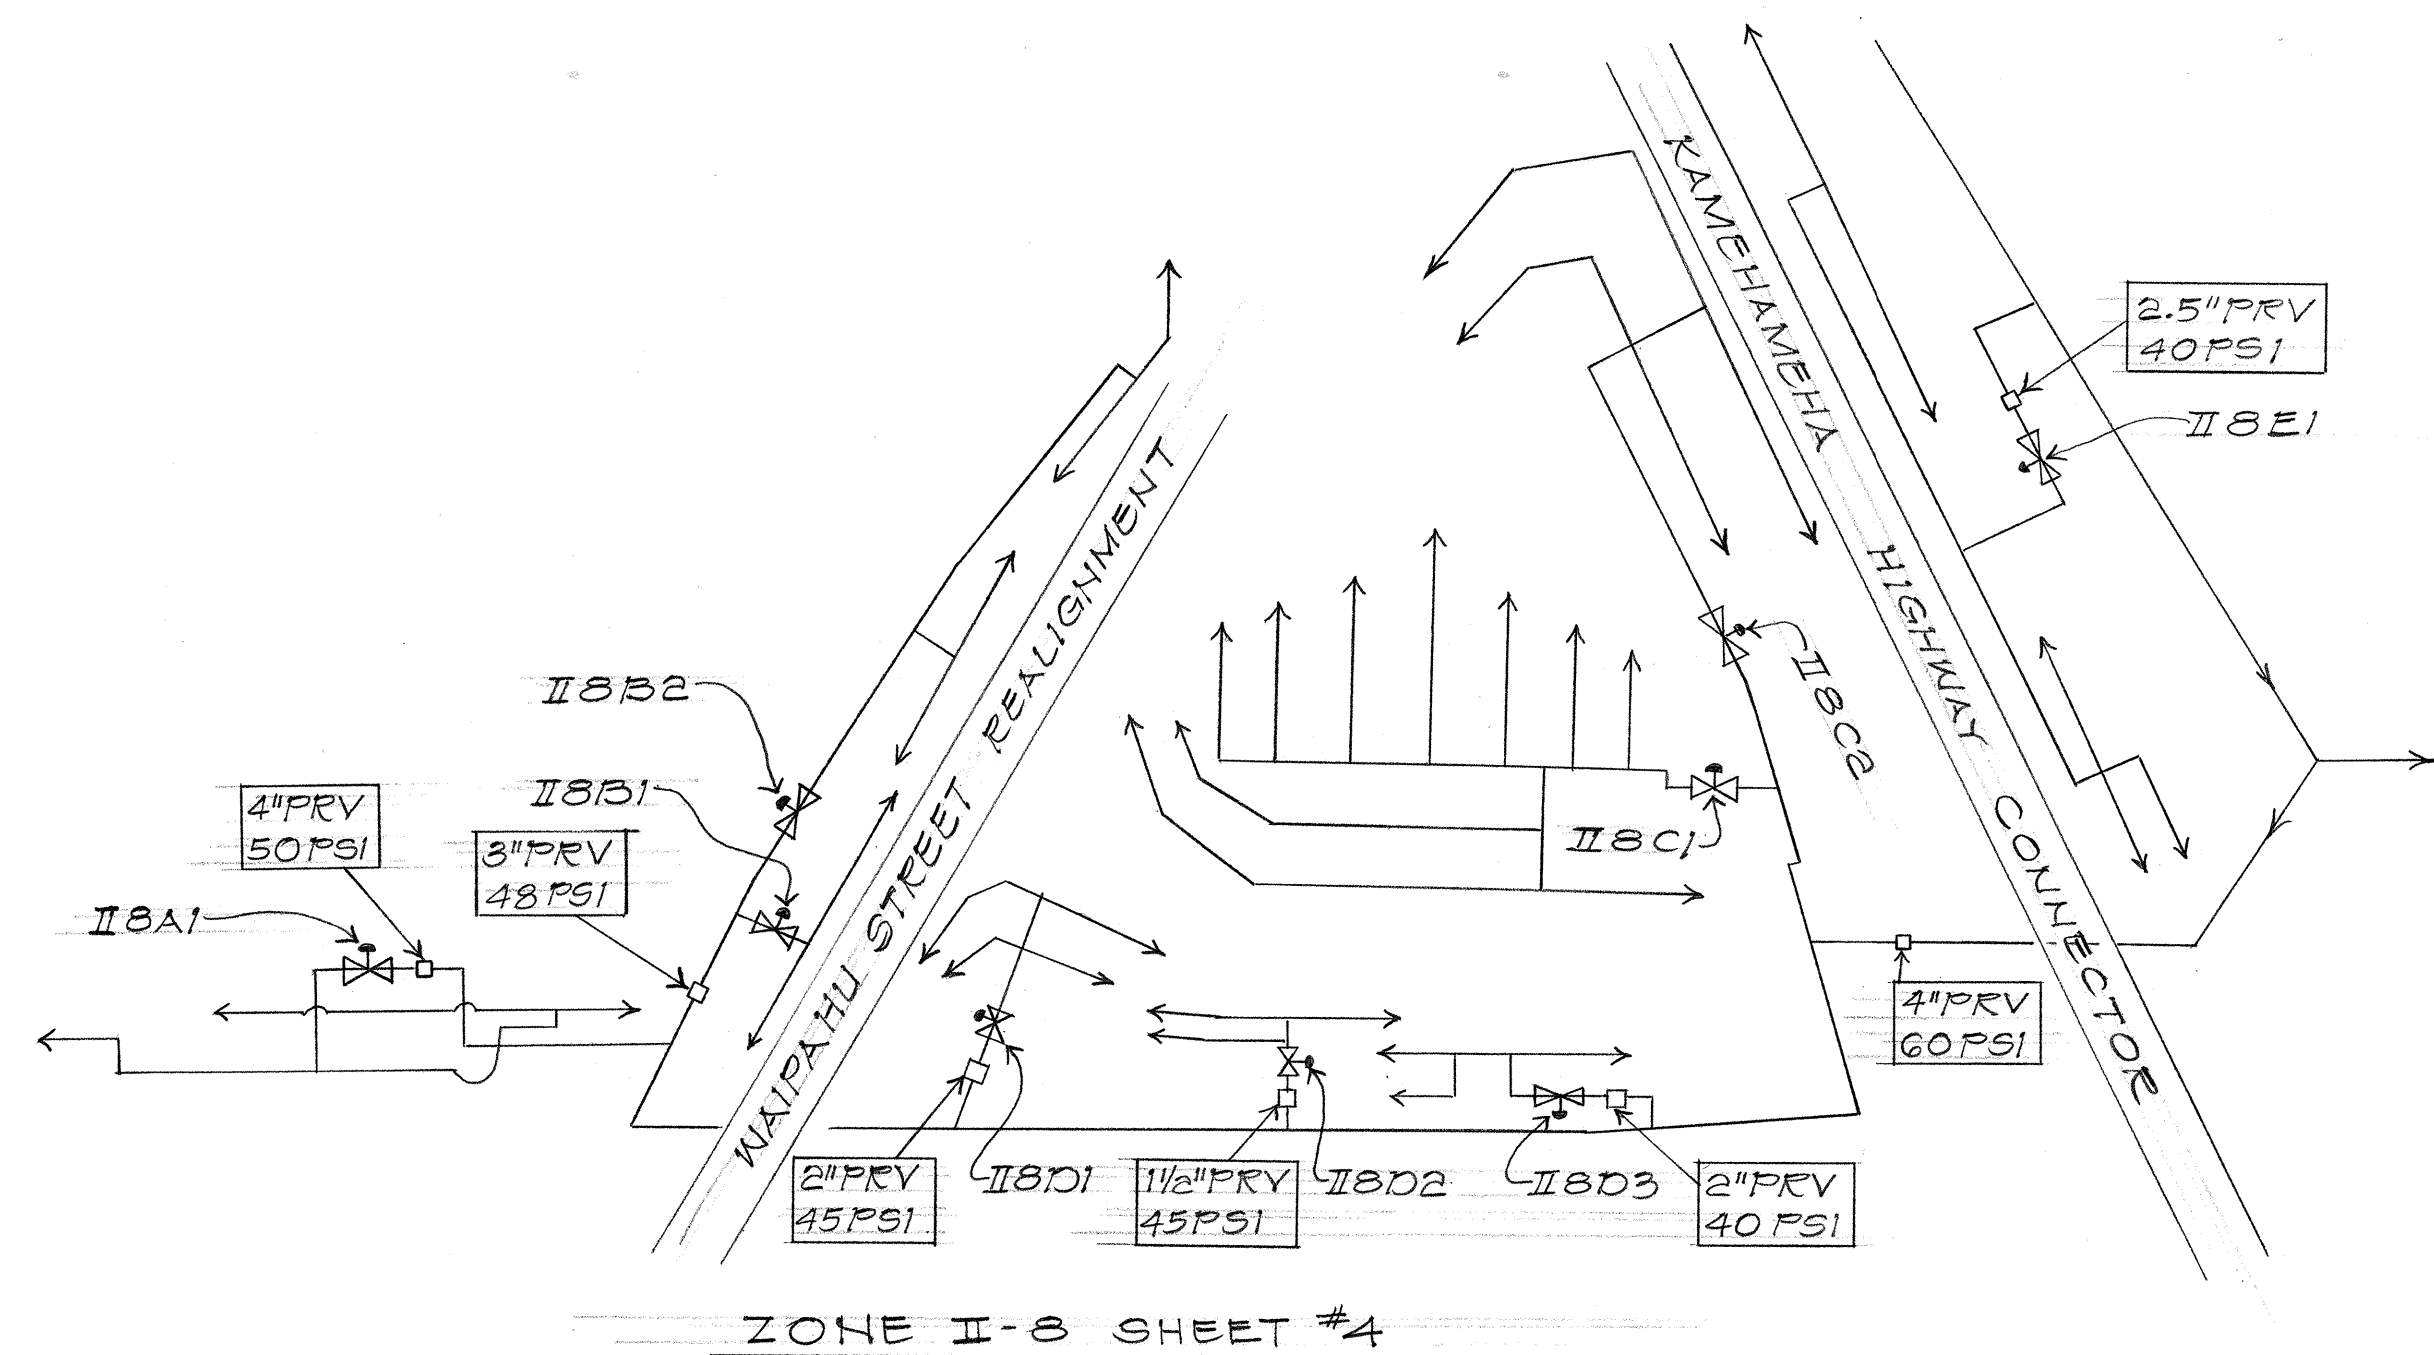

THIS SHEET SUPERSEDES SHEET NO. 11

STATE OF HAWAII
DEPARTMENT OF TRANSPORTATION
HIGHWAYS DIVISION
WAIANA INTERCHANGE
WATER SPRINKLER SYSTEM
PROJ. NO. I-HI-1(97):8
ISOMETRIC DIAGRAMS
OF BRANCHES
SHEET NO. 115-1 OF 18 SHEETS

SURVEY PLOTTED BY	DATE
DRAWN BY	
TRACED BY	
DESIGNED BY	
CHECKED BY	
ORIGINAL PLAN	
NOTE BOOK	
No.	