
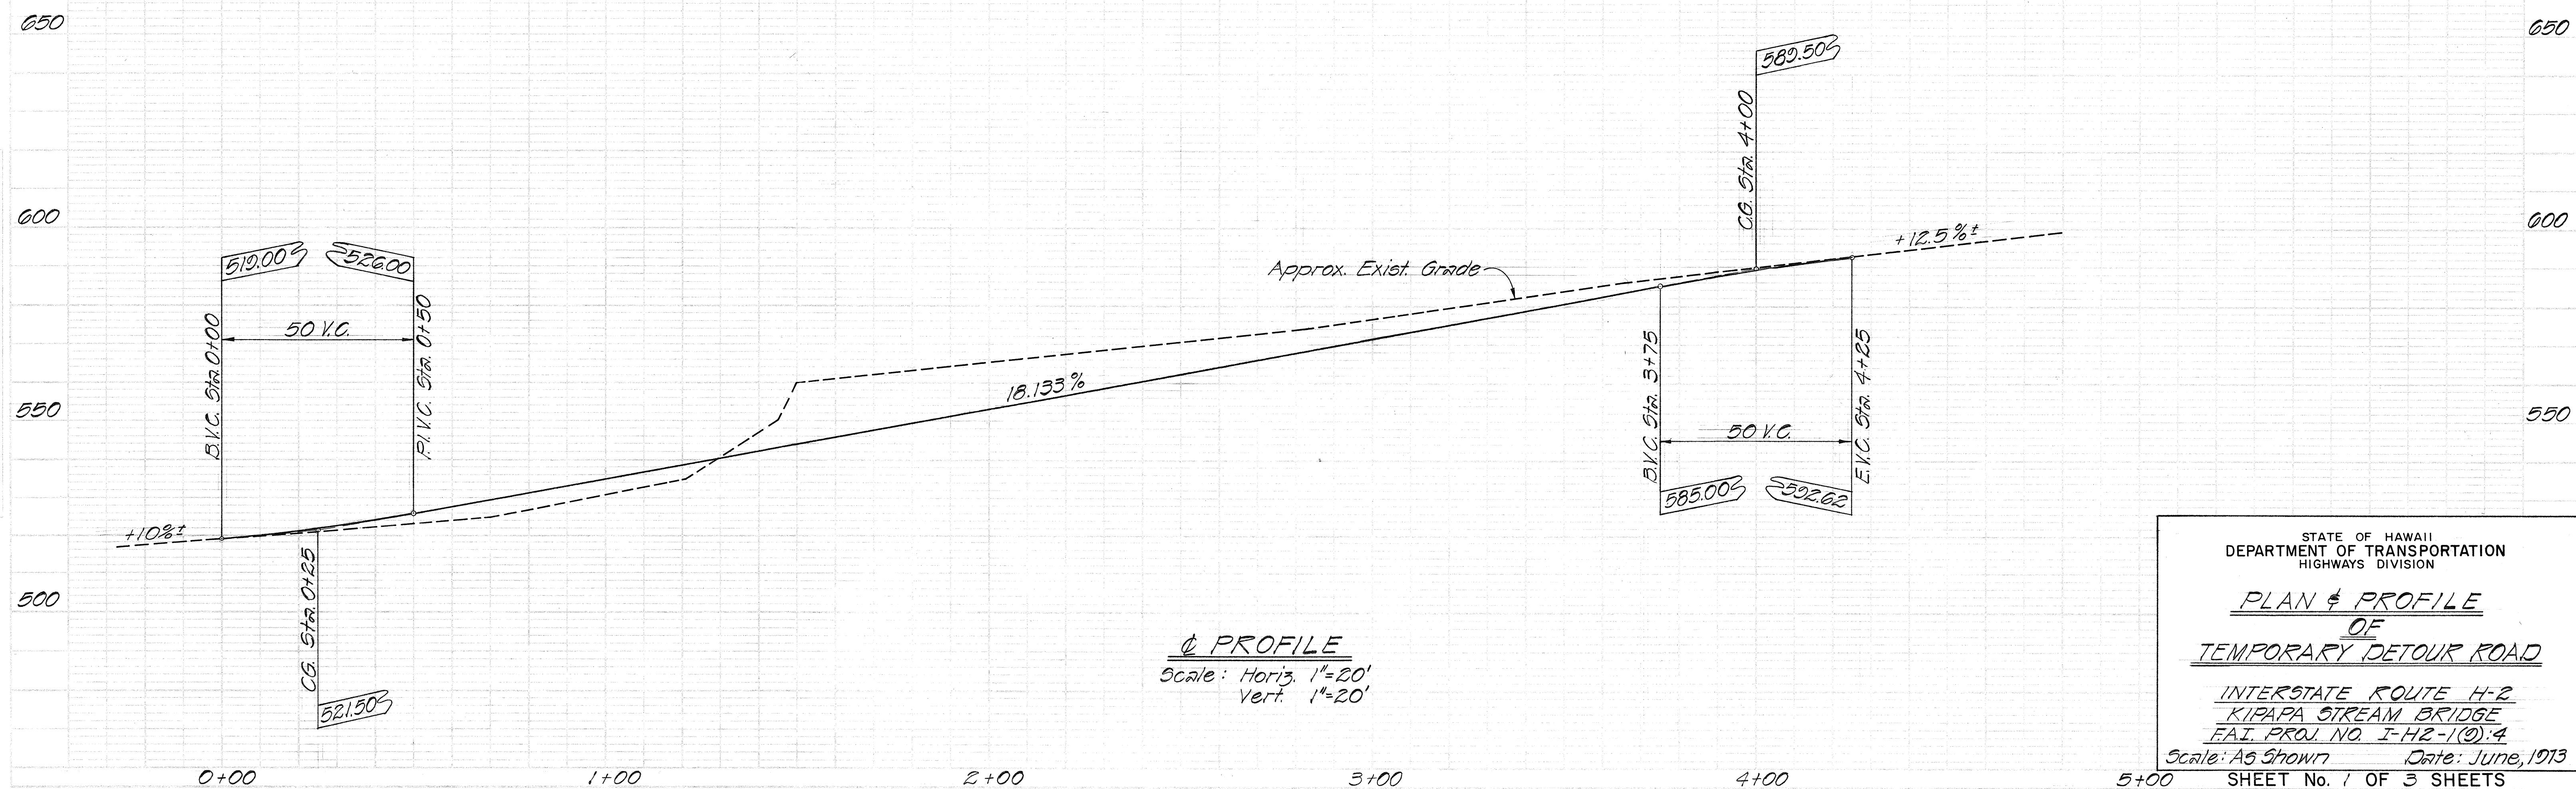


FED. ROAD DIST. NO.	STATE	FED. AID PROJ. NO.	FISCAL YEAR	SHEET NO.	TOTAL SHEETS
HAWAII	HAW.	I-H2-1(9)4	1973	13	122

DATE	REVISION
8/74	Revised structure footing location.

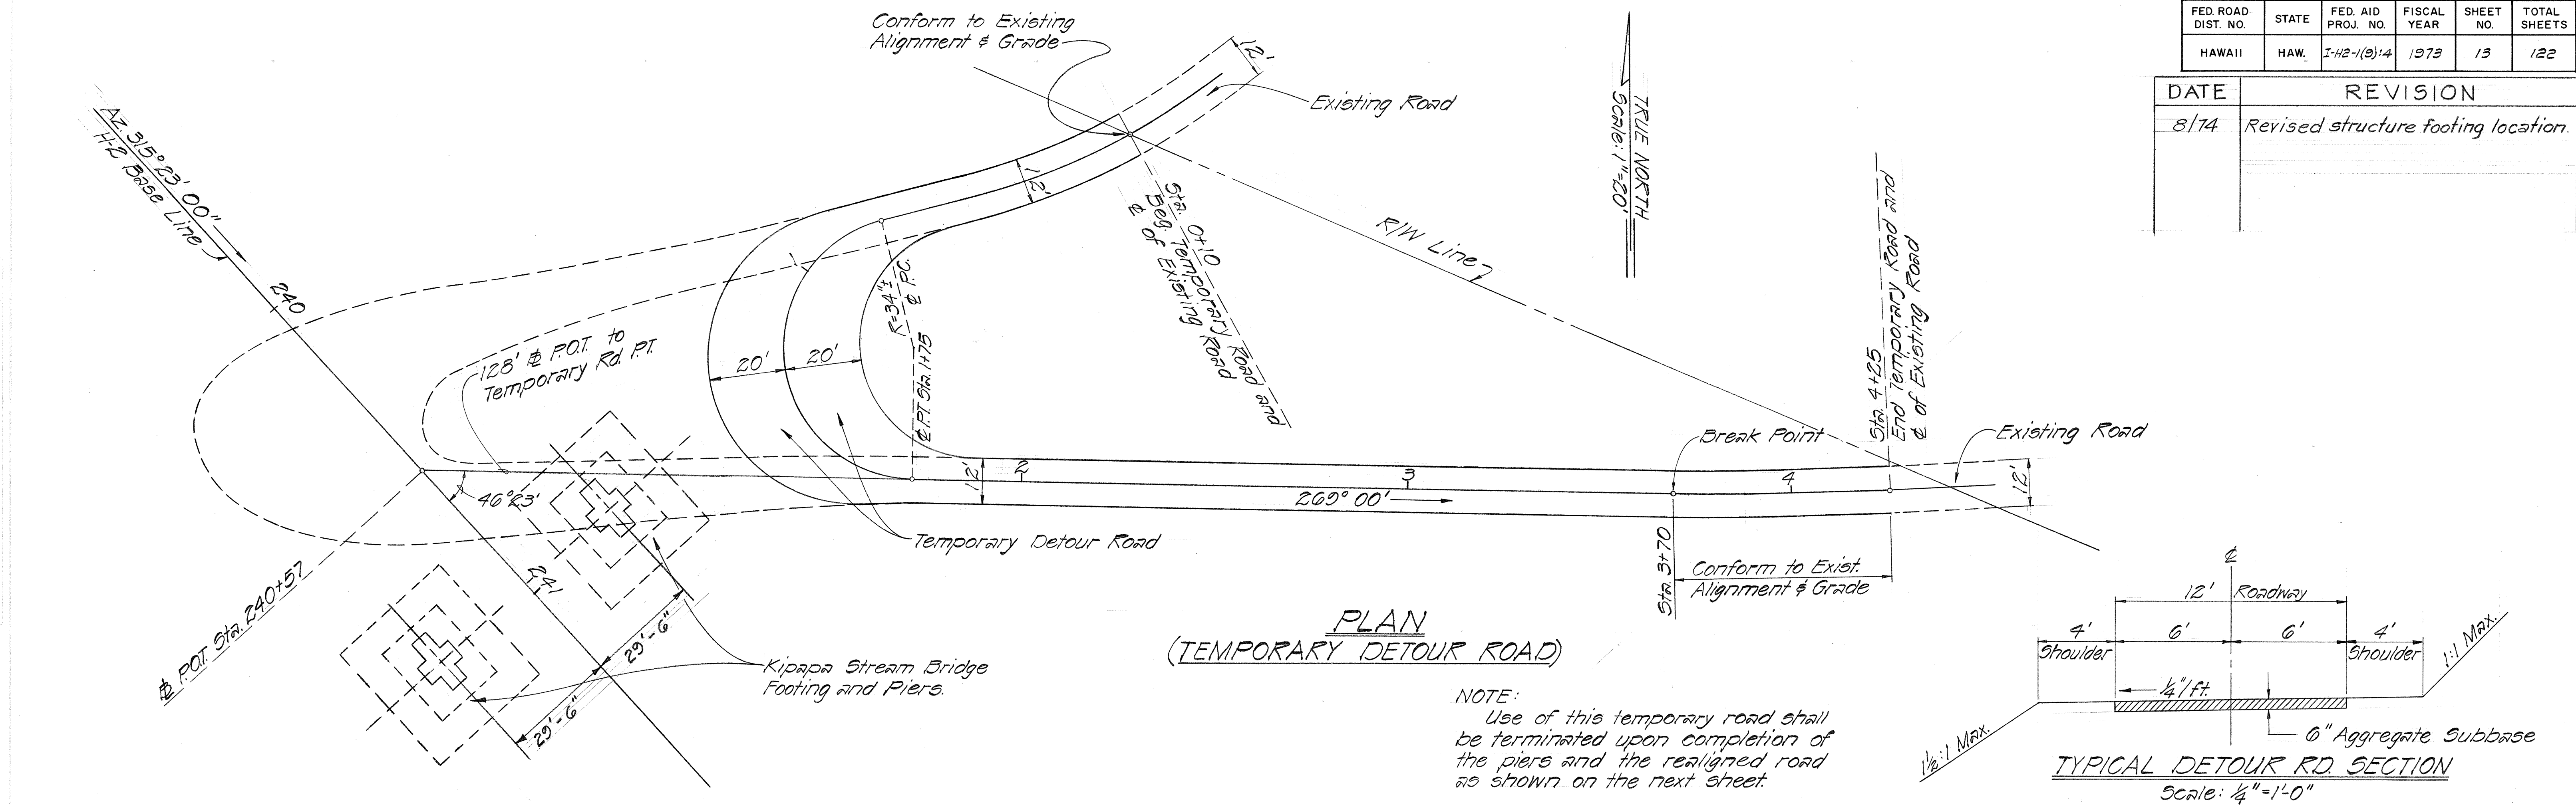

STATE OF HAWAII
DEPARTMENT OF TRANSPORTATION
HIGHWAYS DIVISION



**PLAN & PROFILE
OF
TEMPORARY DETOUR ROAD**

INTERSTATE ROUTE H-2
KIPAPA STREAM BRIDGE
FAI PROJ. NO. I-H2-1(9)4
Scale: As Shown Date: June, 1973

SHEET No. 1 OF 3 SHEETS

C.O.13

FED. ROAD DIST. NO.	STATE	FED. AID PROJ. NO.	FISCAL YEAR	SHEET NO.	TOTAL SHEETS
HAWAII	HAW.	I-H2-1(9):4	1973	14	122

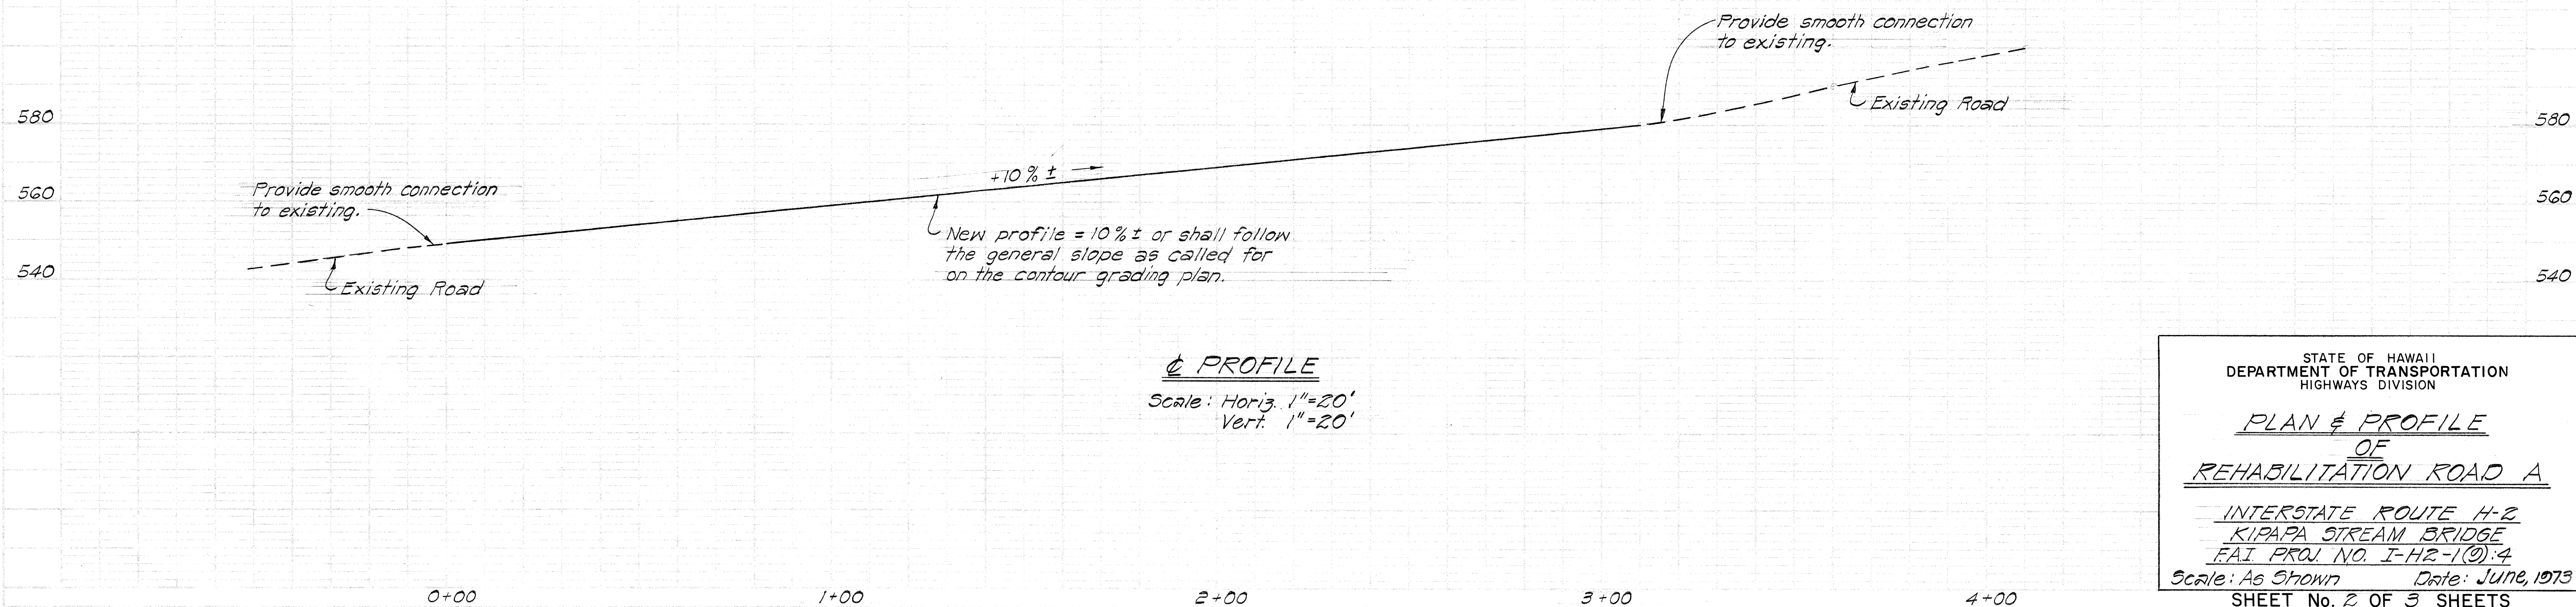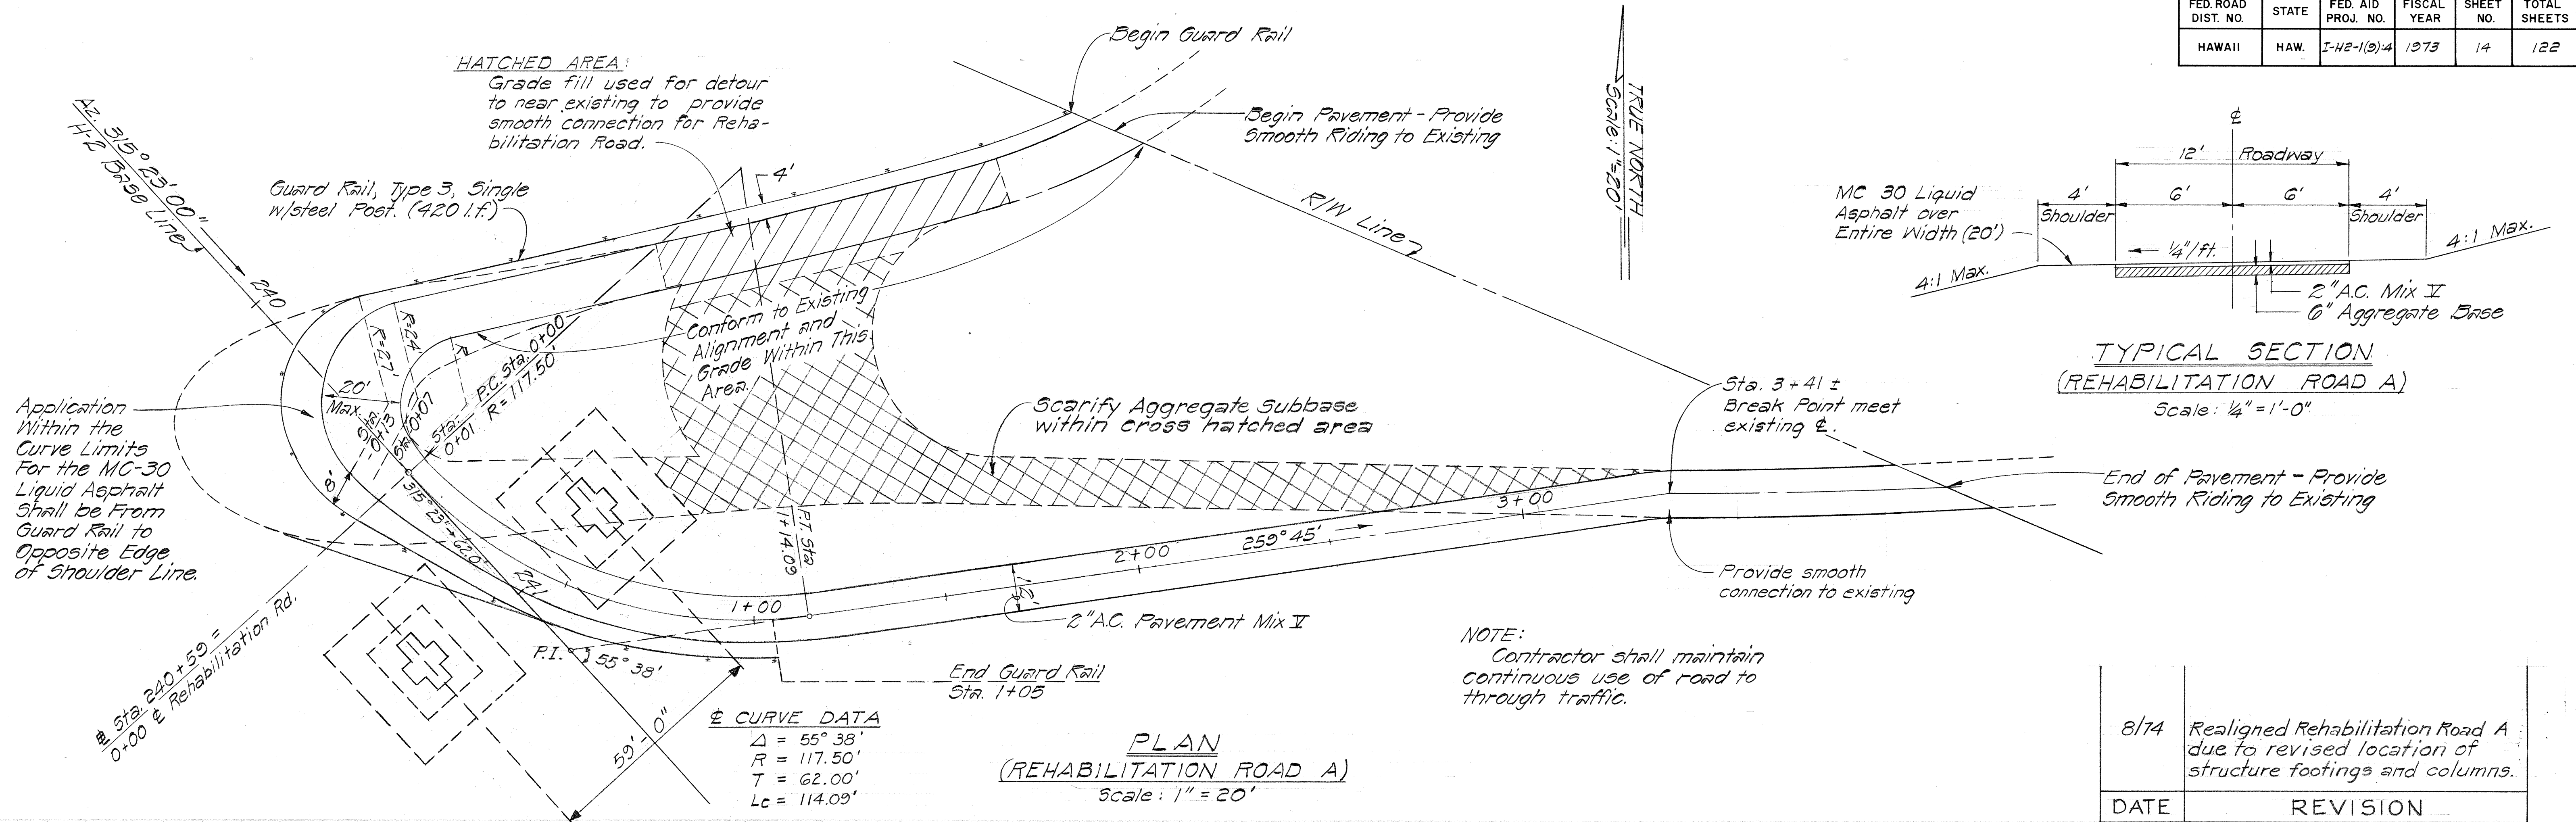

STATE OF HAWAII
DEPARTMENT OF TRANSPORTATION
HIGHWAYS DIVISION



PLAN & PROFILE OF REHABILITATION ROAD A

INTERSTATE ROUTE H-2
KIPAPA STREAM BRIDGE
FAI PROJ. NO. I-H2-1(9):4

Scale: As Shown Date: June, 1973


SHEET No. 2 OF 3 SHEETS

C.O.14

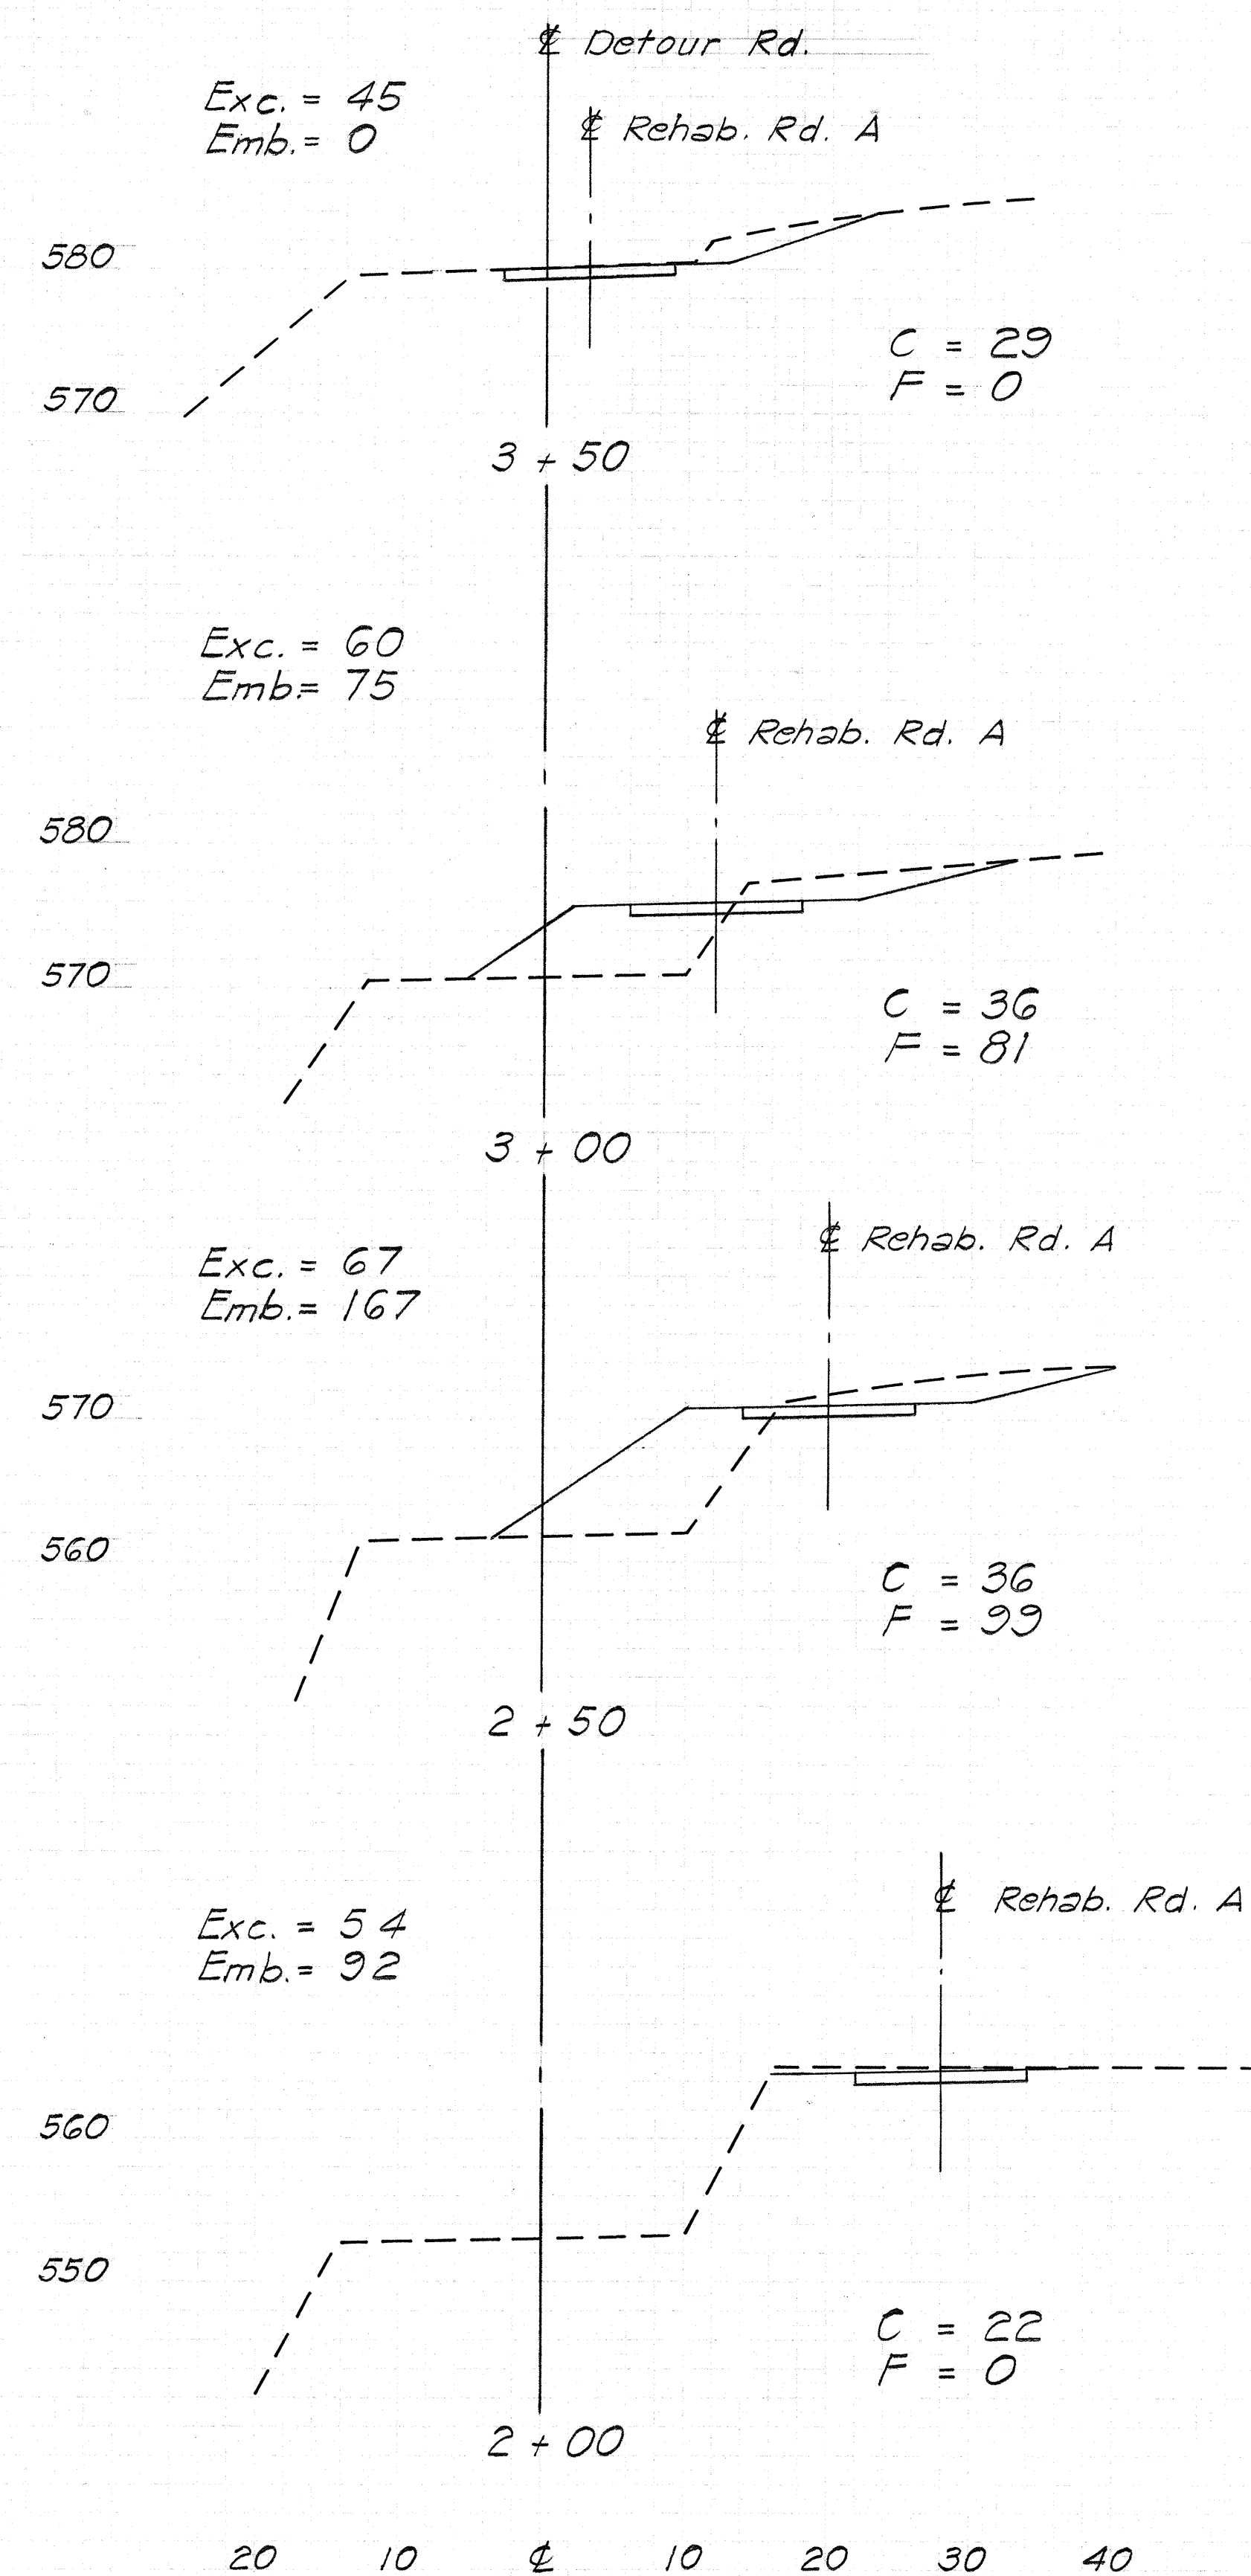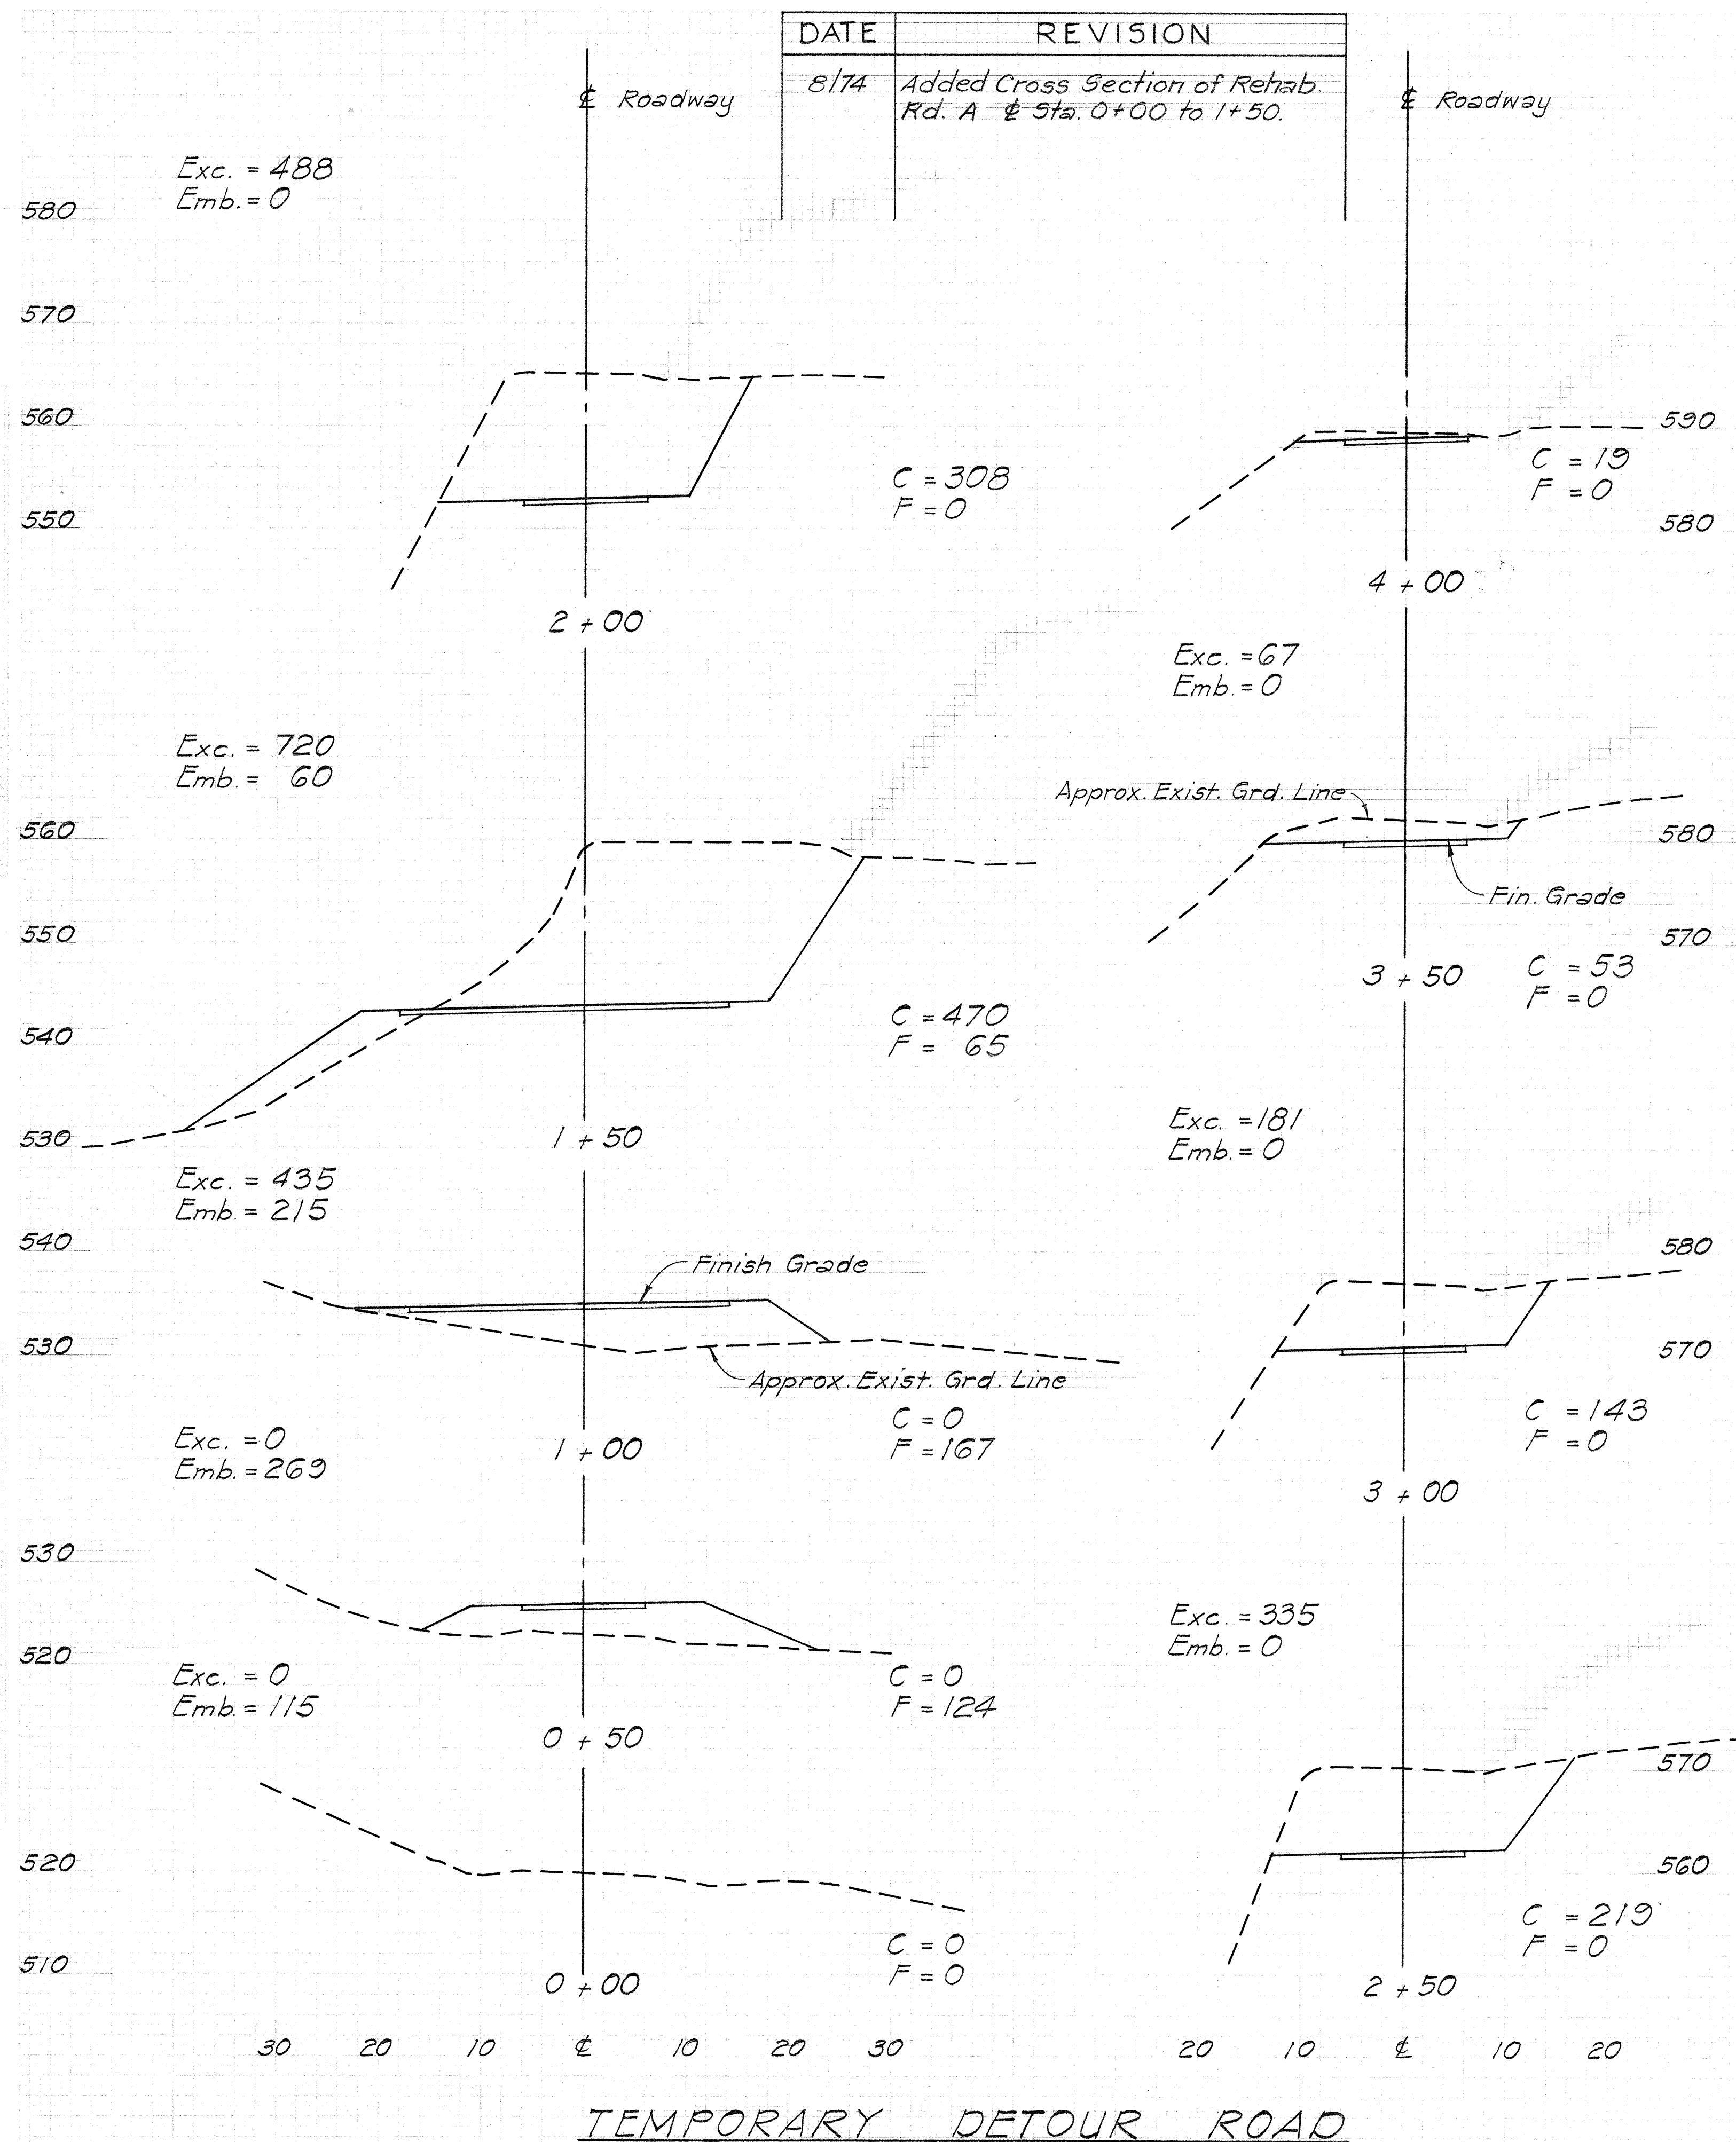

NOTE:

Portion of Rehabilitation Rd. without cross-section shall follow the general slope as called for on the Contour Grading Plan.

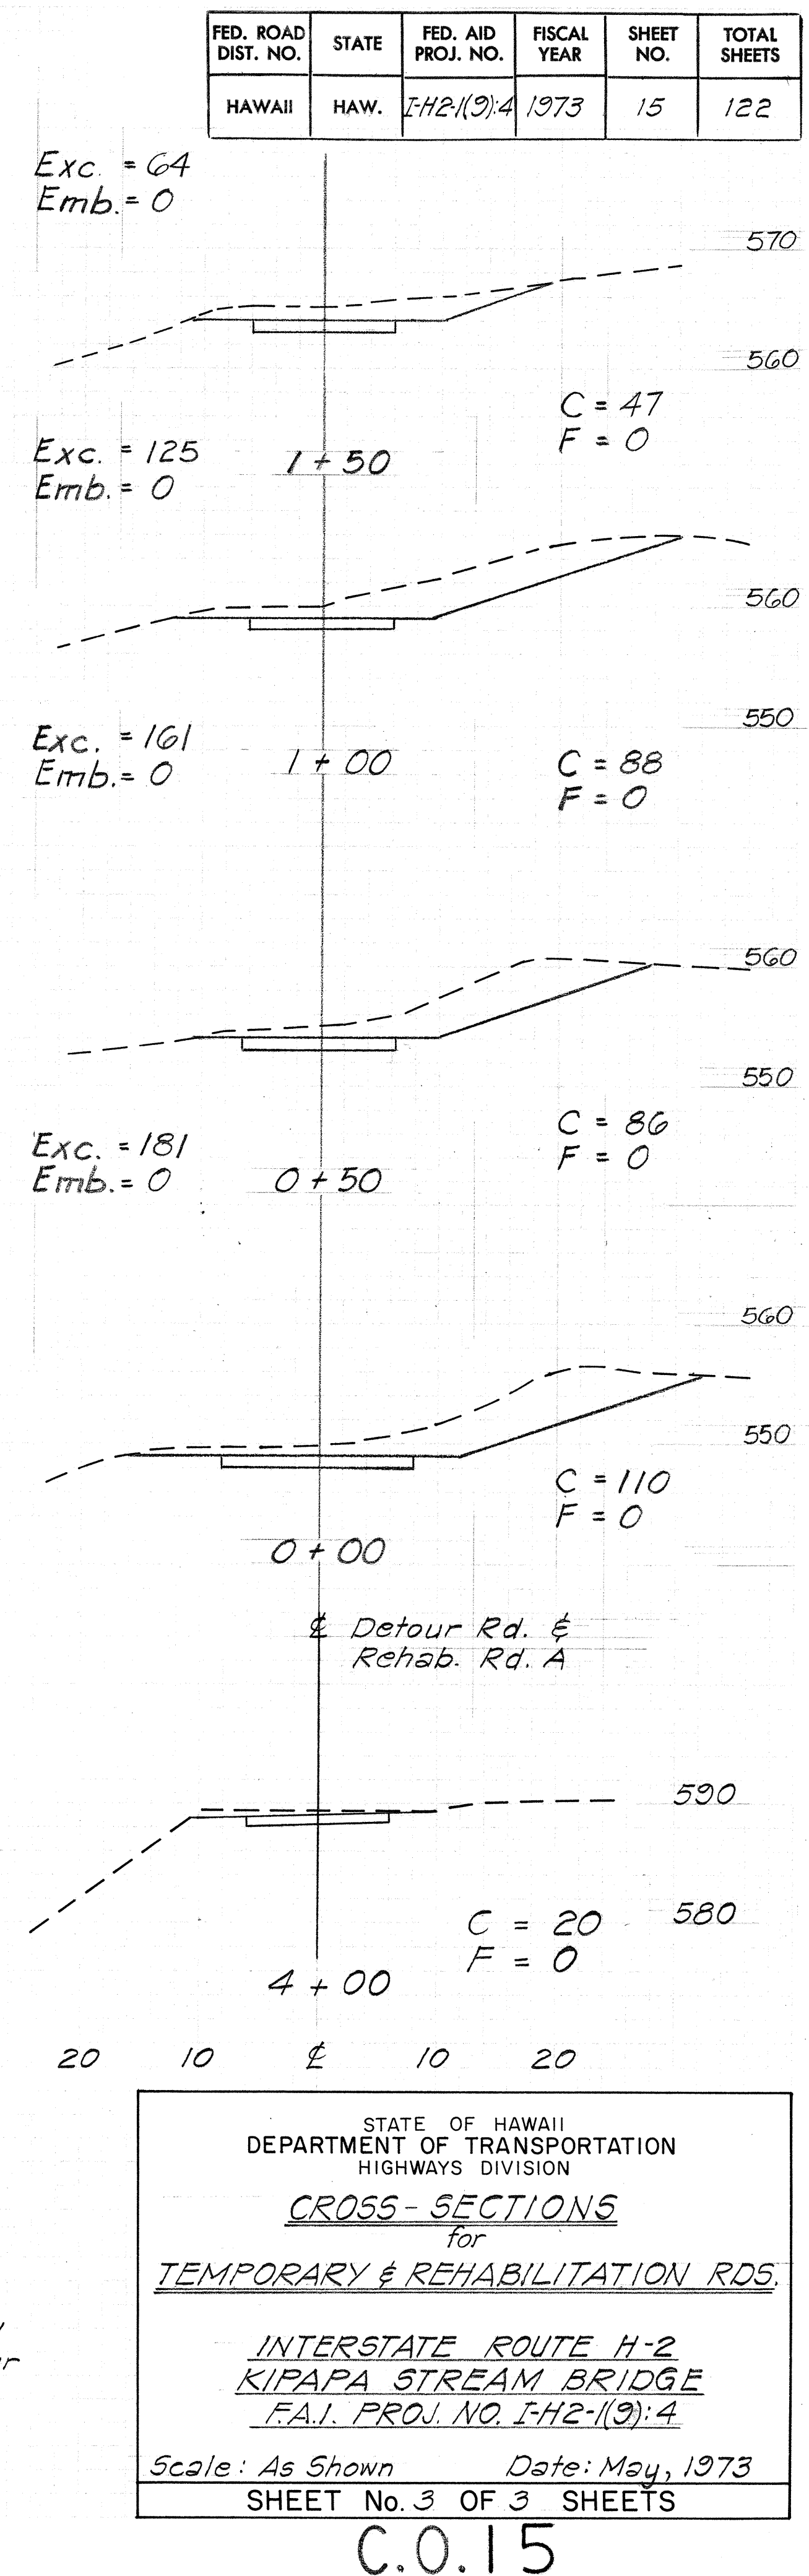

STATE OF HAWAII
DEPARTMENT OF TRANSPORTATION
HIGHWAYS DIVISION

CROSS-SECTIONS
for
TEMPORARY & REHABILITATION RDS.

**INTERSTATE ROUTE H-2
KIPAPA STREAM BRIDGE
F.A.I. PROJ. NO. I-42-1(3)4**

Scale: As Shown Date: May, 1973
SHEET No. 3 OF 3 SHEETS

C.O.15