

INDEX TO DRAWINGS	
SHEET NO.	DESCRIPTION
1	TITLE SHEET
2-4	TYPICAL SECTIONS
5-6	PLAN & PROFILE
7	SUPERELEVATION DIAGRAMS
8	ROADWAY BORING LOGS
9-10	DETAIL PLAN OF ROADWAY
11-12	MISC. ROADWAY PLANS
13-15	R/W CONSTRUCTION & TEMPORARY DETOUR PLAN
16	EROSION CONTROL PLAN
17-27	MISC. & ST'D. ROADWAY DETAILS
28-36	TRAFFIC CONTROL PLANS & DETAILS
37-46	DRAINAGE PLANS & DETAILS
47-57	UTILITIES (ELECTRIC & TELEPHONE)
58-114	KIPAPA STREAM BRIDGE
115-122	CROSS SECTION


* 21RS-1 & 21RS-2 GUARD RAIL STANDARD DETAILS
▲ C.O.38, C.O.39 & C.O.39S-1 SPRINKLER TRANSMISSION LINE & DETAILS
● C.O.93S-1, C.O.93S-2 & C.O.93S-3 6" SPRINKLER TRANSMISSION LINE & DETAILS
PLAN SHT. NO. 114 WAS DELETED WHEN VECF DRAWINGS WERE PREPARED.
TOTAL SHEET COUNT AFTER "AS-BUILT"
POSTINGS: 127 SHEETS

STATE OF HAWAII
DEPARTMENT OF TRANSPORTATION
HIGHWAYS DIVISION

HONOLULU, HAWAII
"AS-BUILT"
PLANS FOR
CONSTRUCTION OF A PORTION OF
INTERSTATE ROUTE H-2
KIPAPA STREAM BRIDGE


FEDERAL AID INTERSTATE PROJ. NO. I-H2-1(9):4

DISTRICT OF EWA
ISLAND OF OAHU

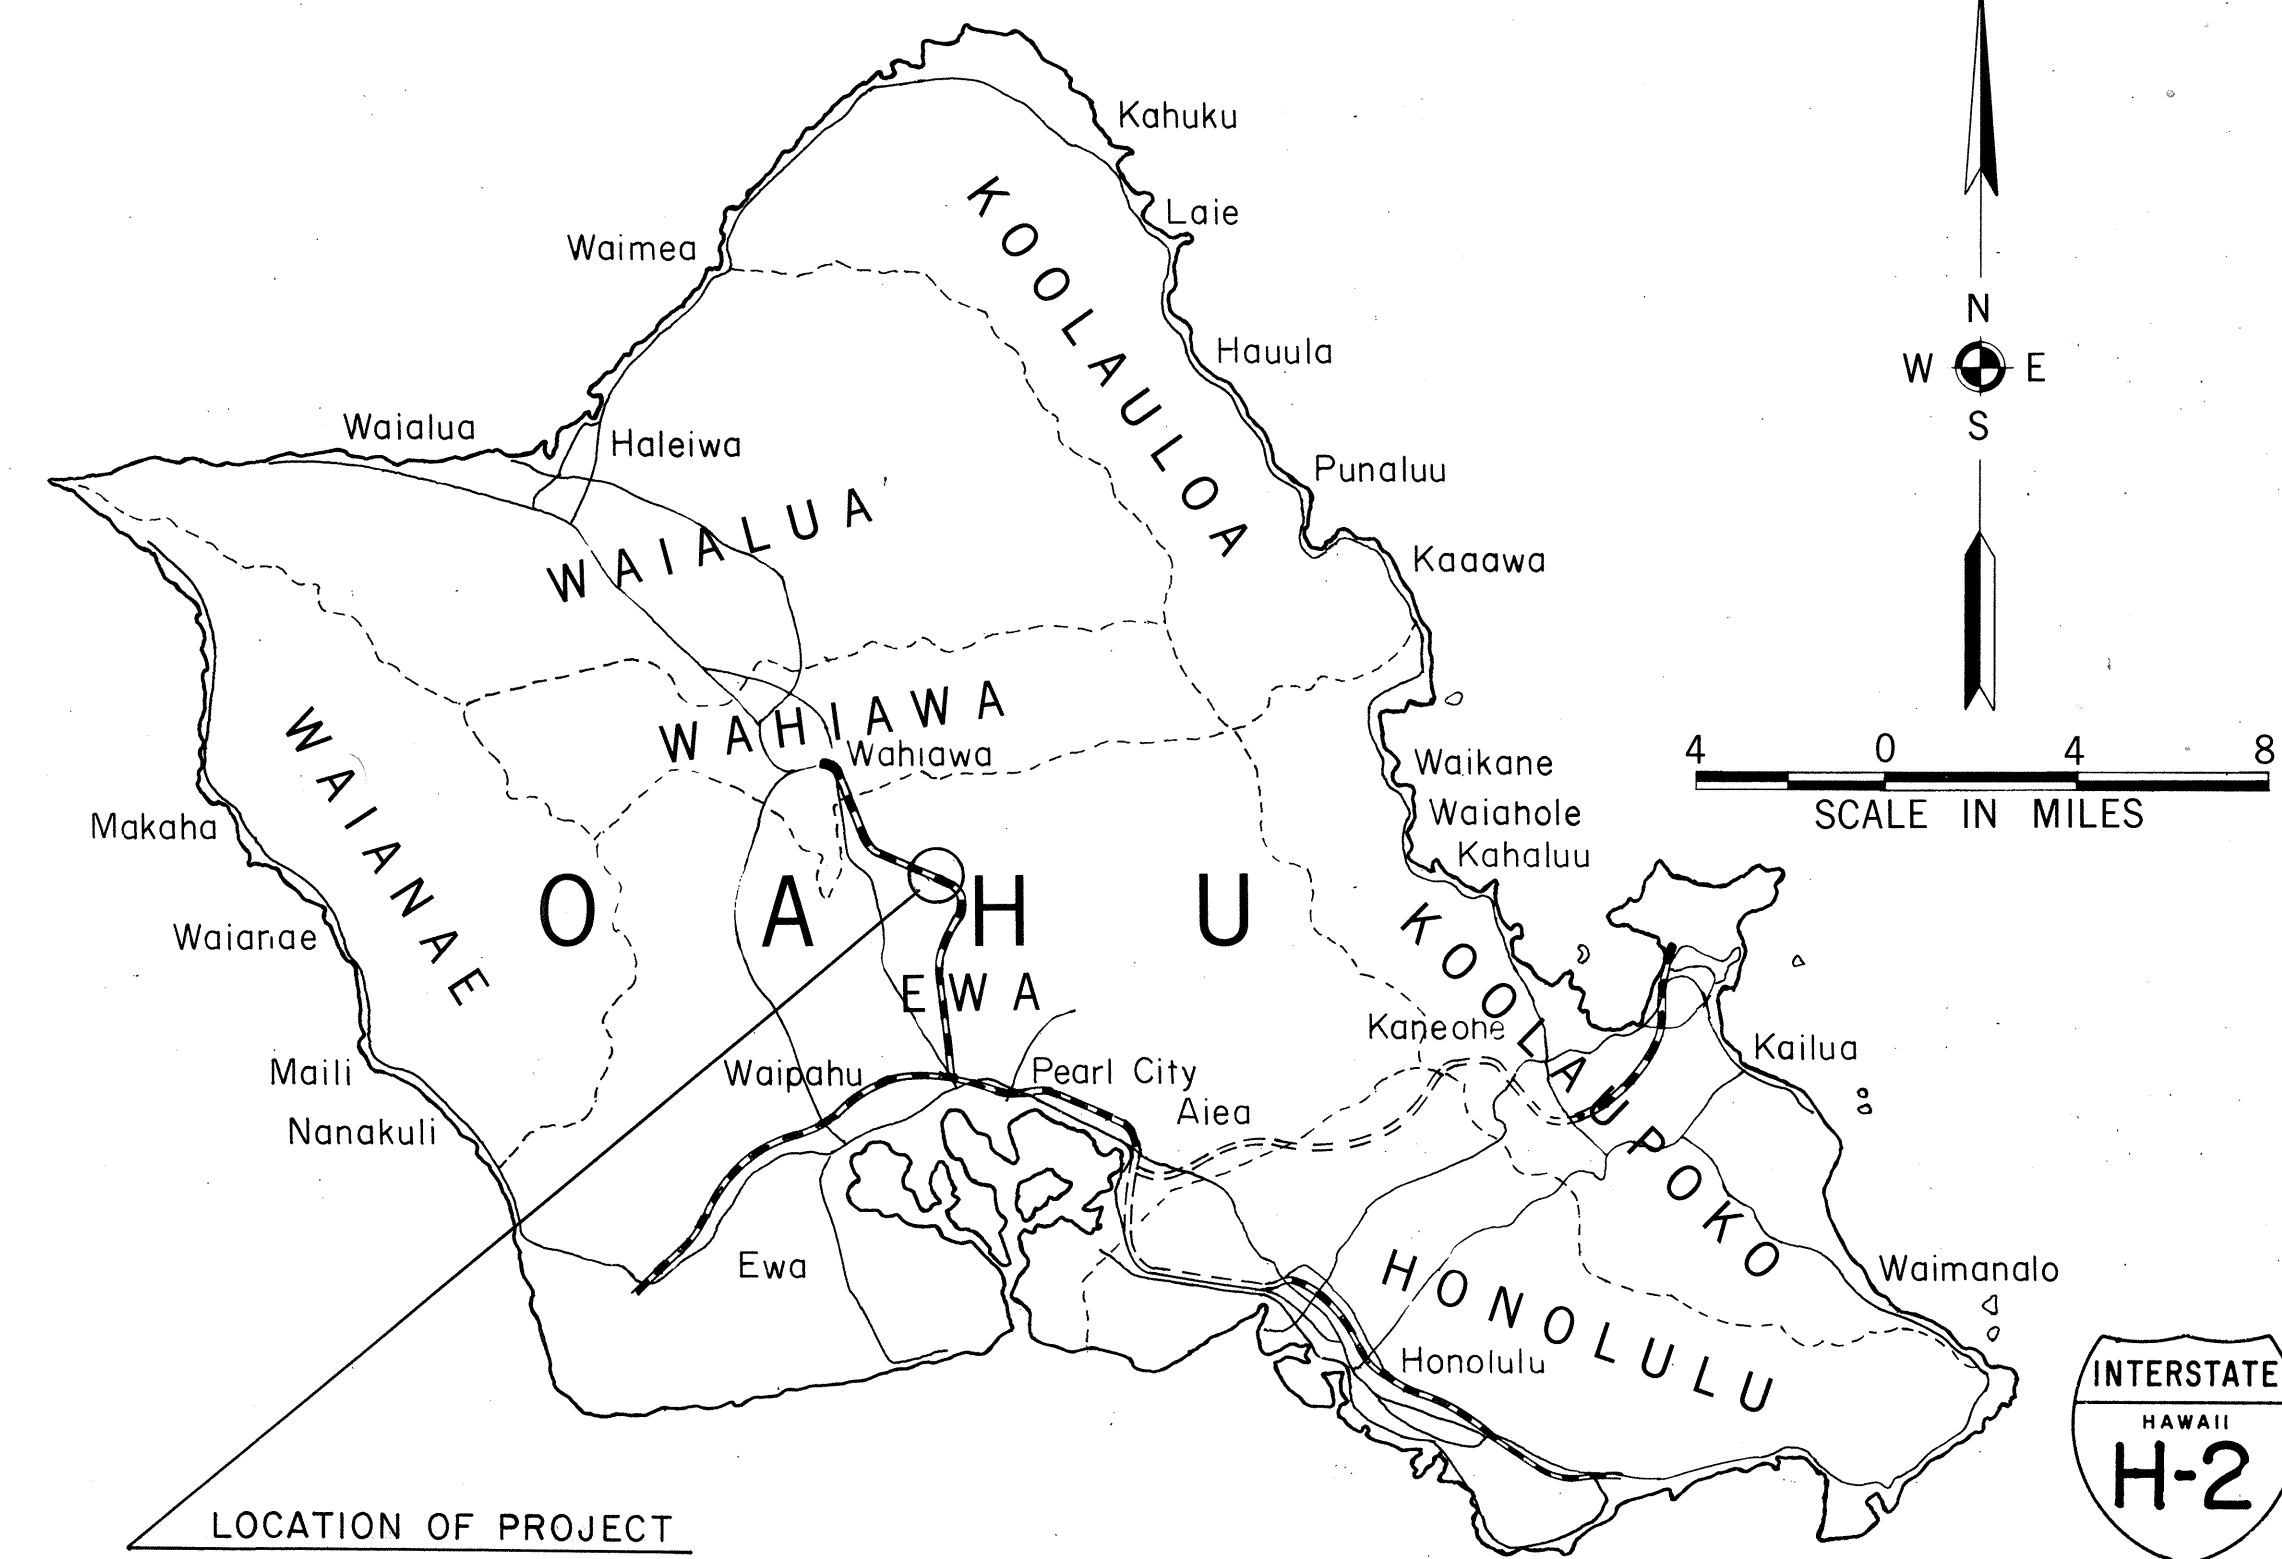

CHANGES MADE DURING CONSTRUCTION HAVE BEEN INCORPORATED ON THESE PLANS EXCEPT CHANGES IN THE ORIGINAL THEORETICAL QUANTITIES. FOR ACTUAL QUANTITIES, REFER TO PROJECT LEDGER AND/OR COMPUTATION BOOK.

Albert C. Nishi
RESIDENT ENGINEER
17 Aug. 1983
DATE

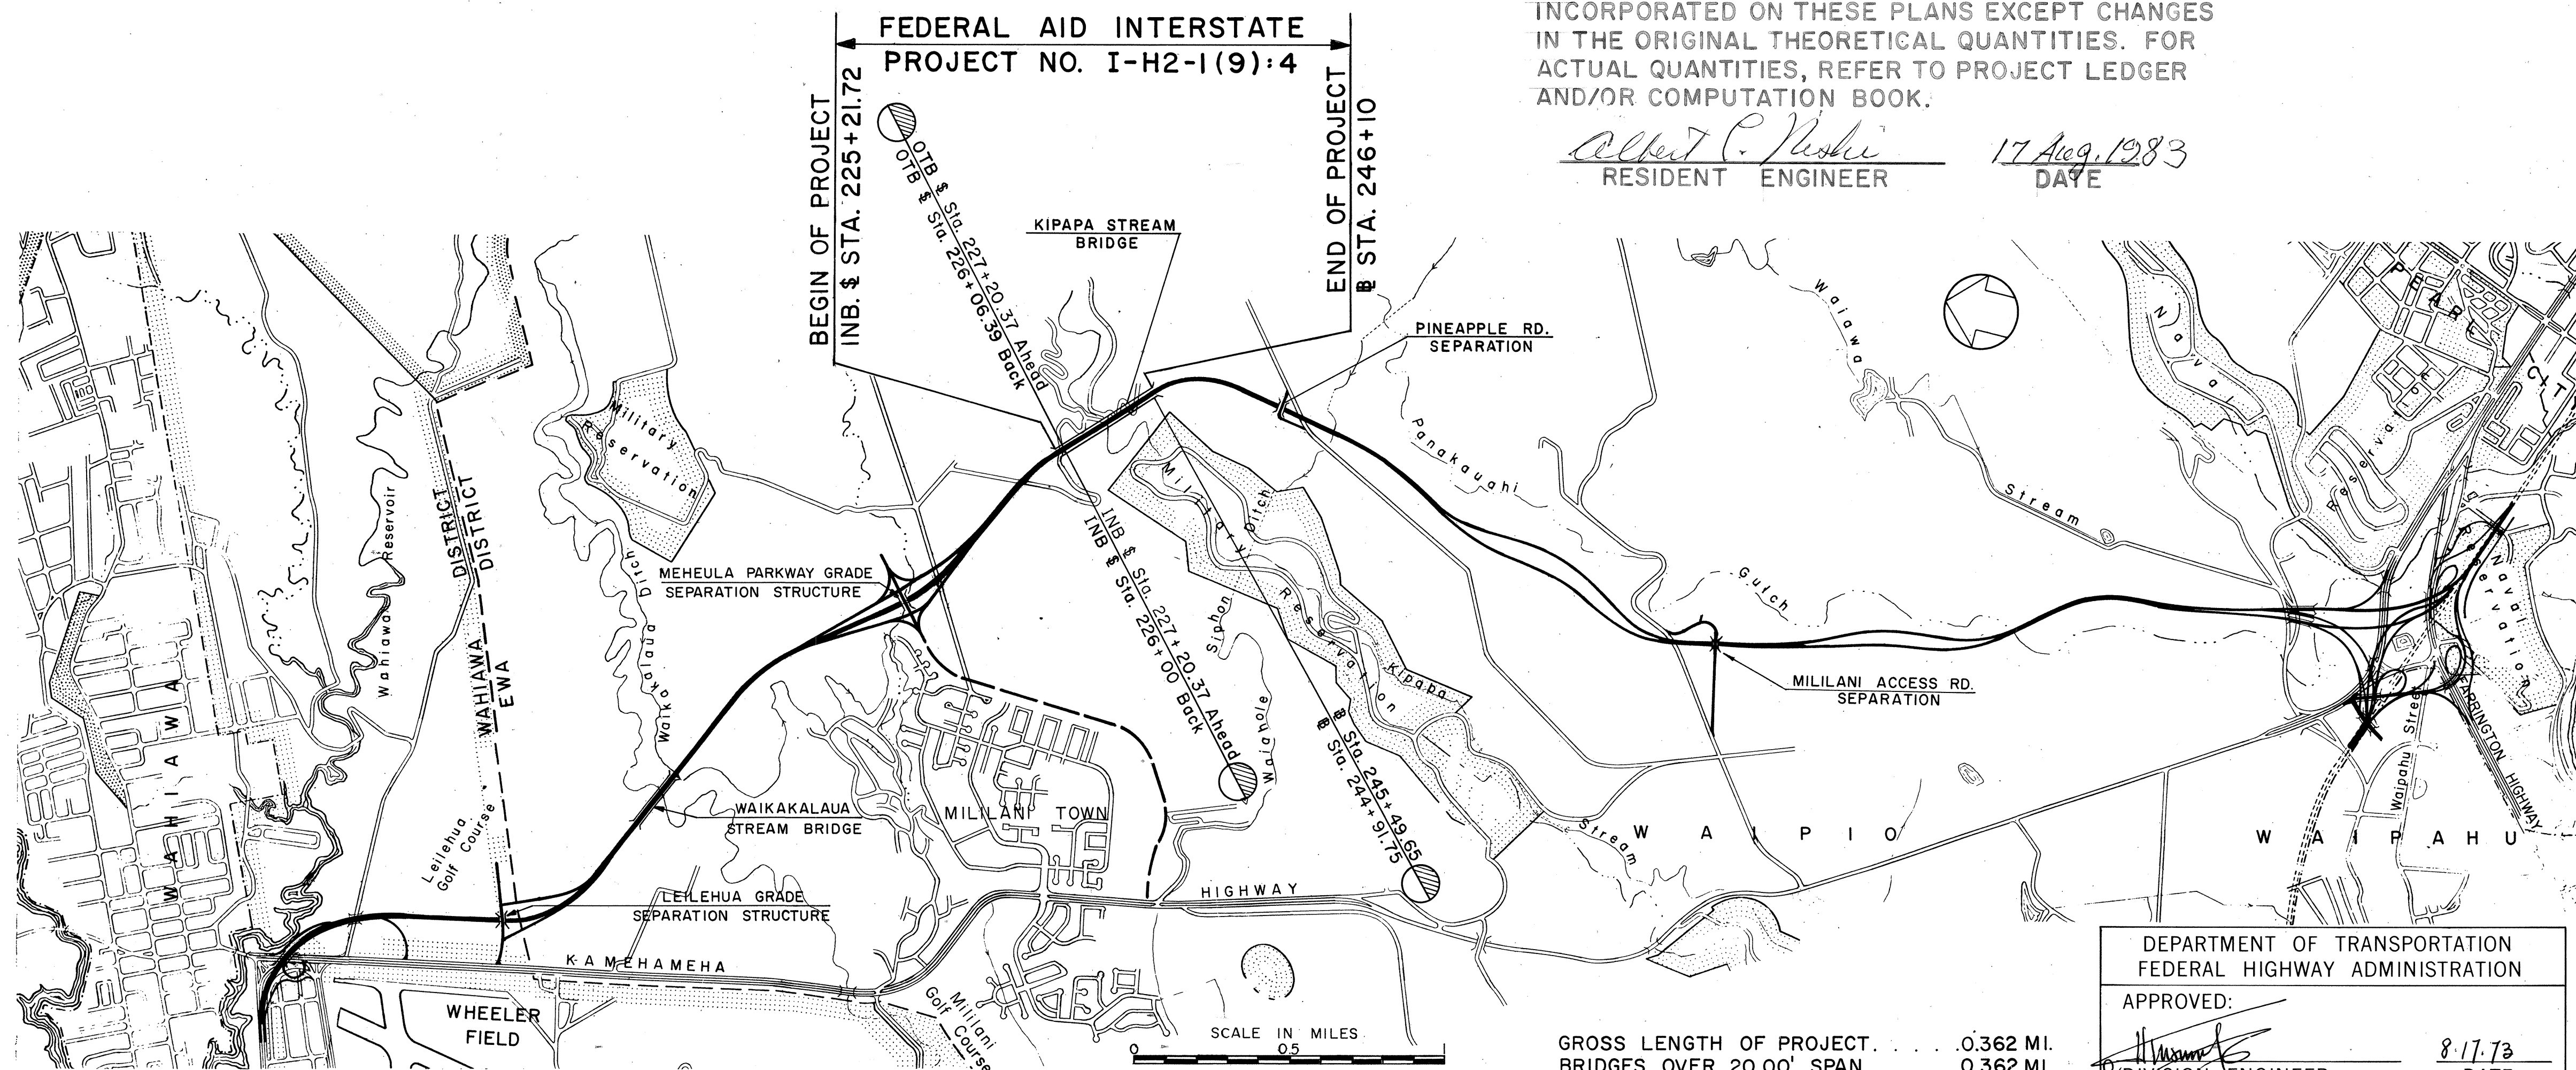

GROSS LENGTH OF PROJECT 0.362 MI.
BRIDGES OVER 20.00' SPAN 0.362 MI.
NET LENGTH OF ROADWAY 0.000 MI.

DESIGN CLASSIFICATION	
CURRENT ADT (1973)	0
INTERIM ADT (1977)	27,800
DESIGN ADT (1993)	47,200
DHV	10 %
D	55/45
T24	1,200
V	70 MPH
CONTROL OF ACCESS	FULL

DEPARTMENT OF TRANSPORTATION
FEDERAL HIGHWAY ADMINISTRATION
APPROVED: *[Signature]* 8-17-73
DIVISION ENGINEER DATE

DEPARTMENT OF TRANSPORTATION
STATE OF HAWAII
APPROVED: *Mummy Lee* 8/7/73
DIR. OF TRANSPORTATION DATE

A. Nishimura
DESIGNED BY
Design Unit "F"
P. S. & E. BY
548-7537
PHONE
June, 1973
DATE