

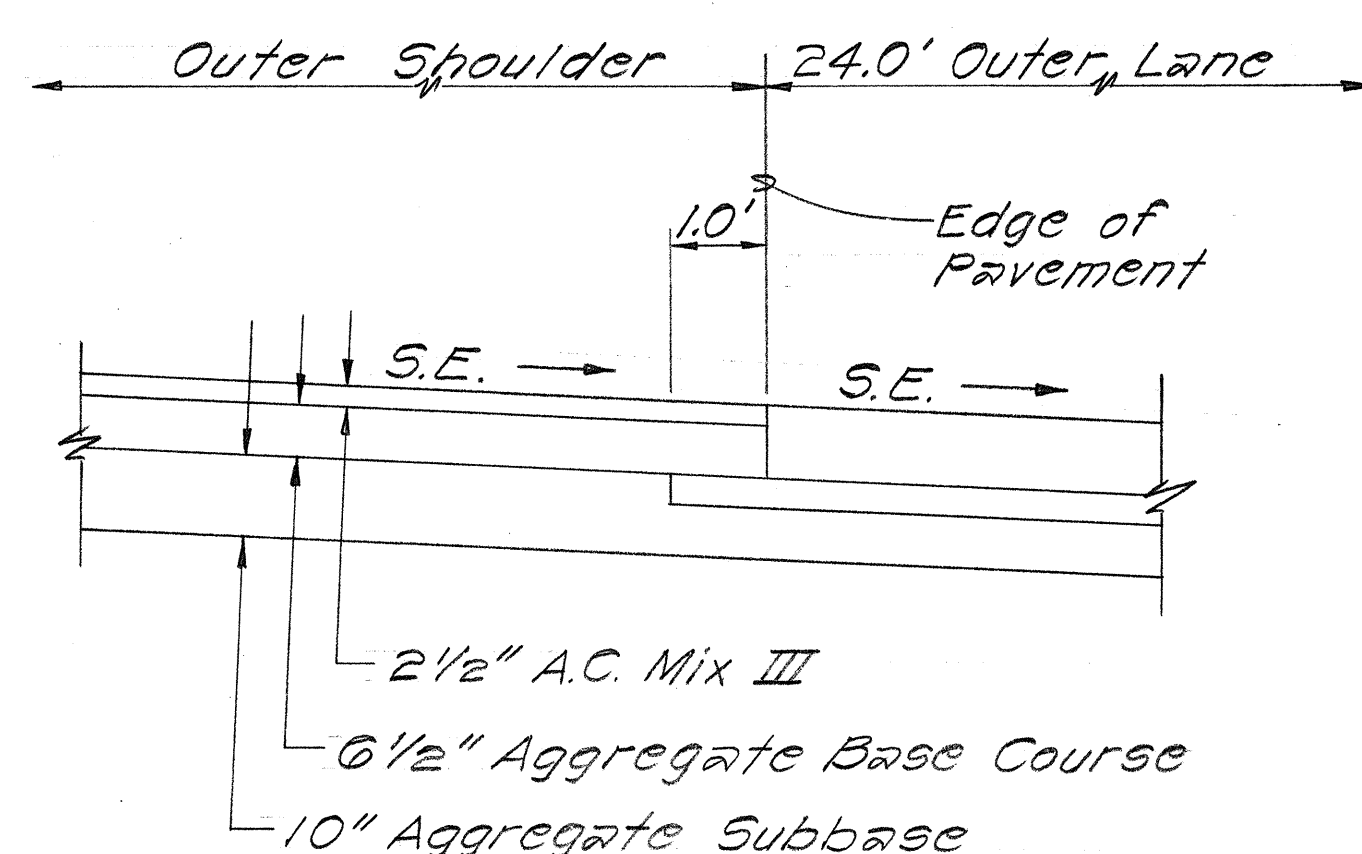
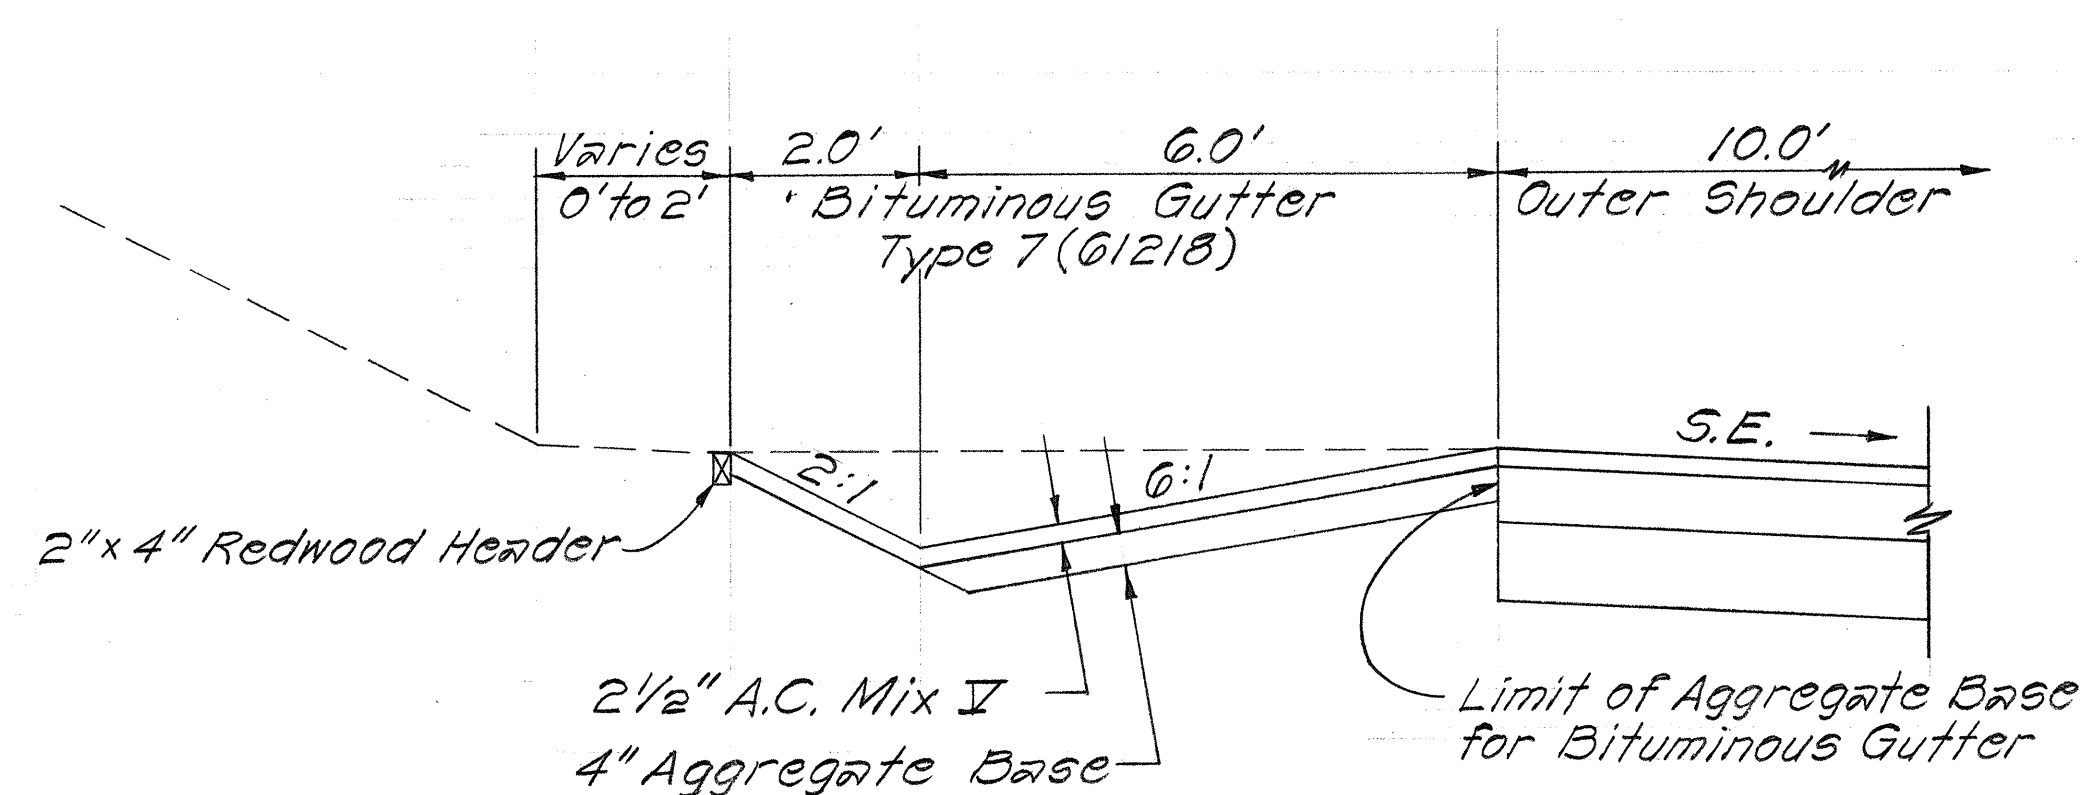


FED. ROAD DIST. NO.	STATE	FED. AID PROJ. NO.	FISCAL YEAR	SHEET NO.	TOTAL SHEETS
HAWAII	HAW.	I-H2-1(2):4	1973	2	122

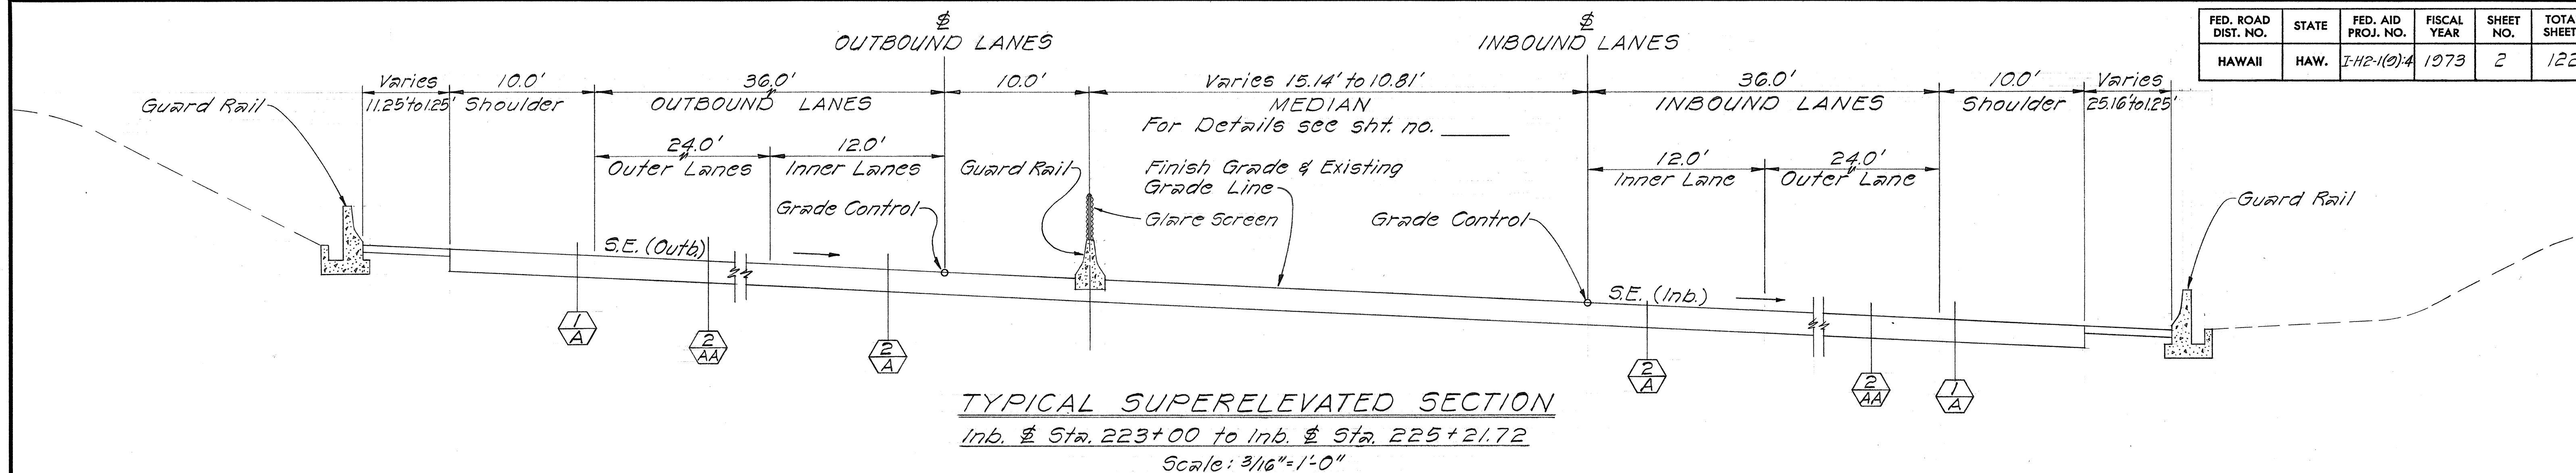


1
A
Scale: $\frac{1}{2}'' = 1'-0''$

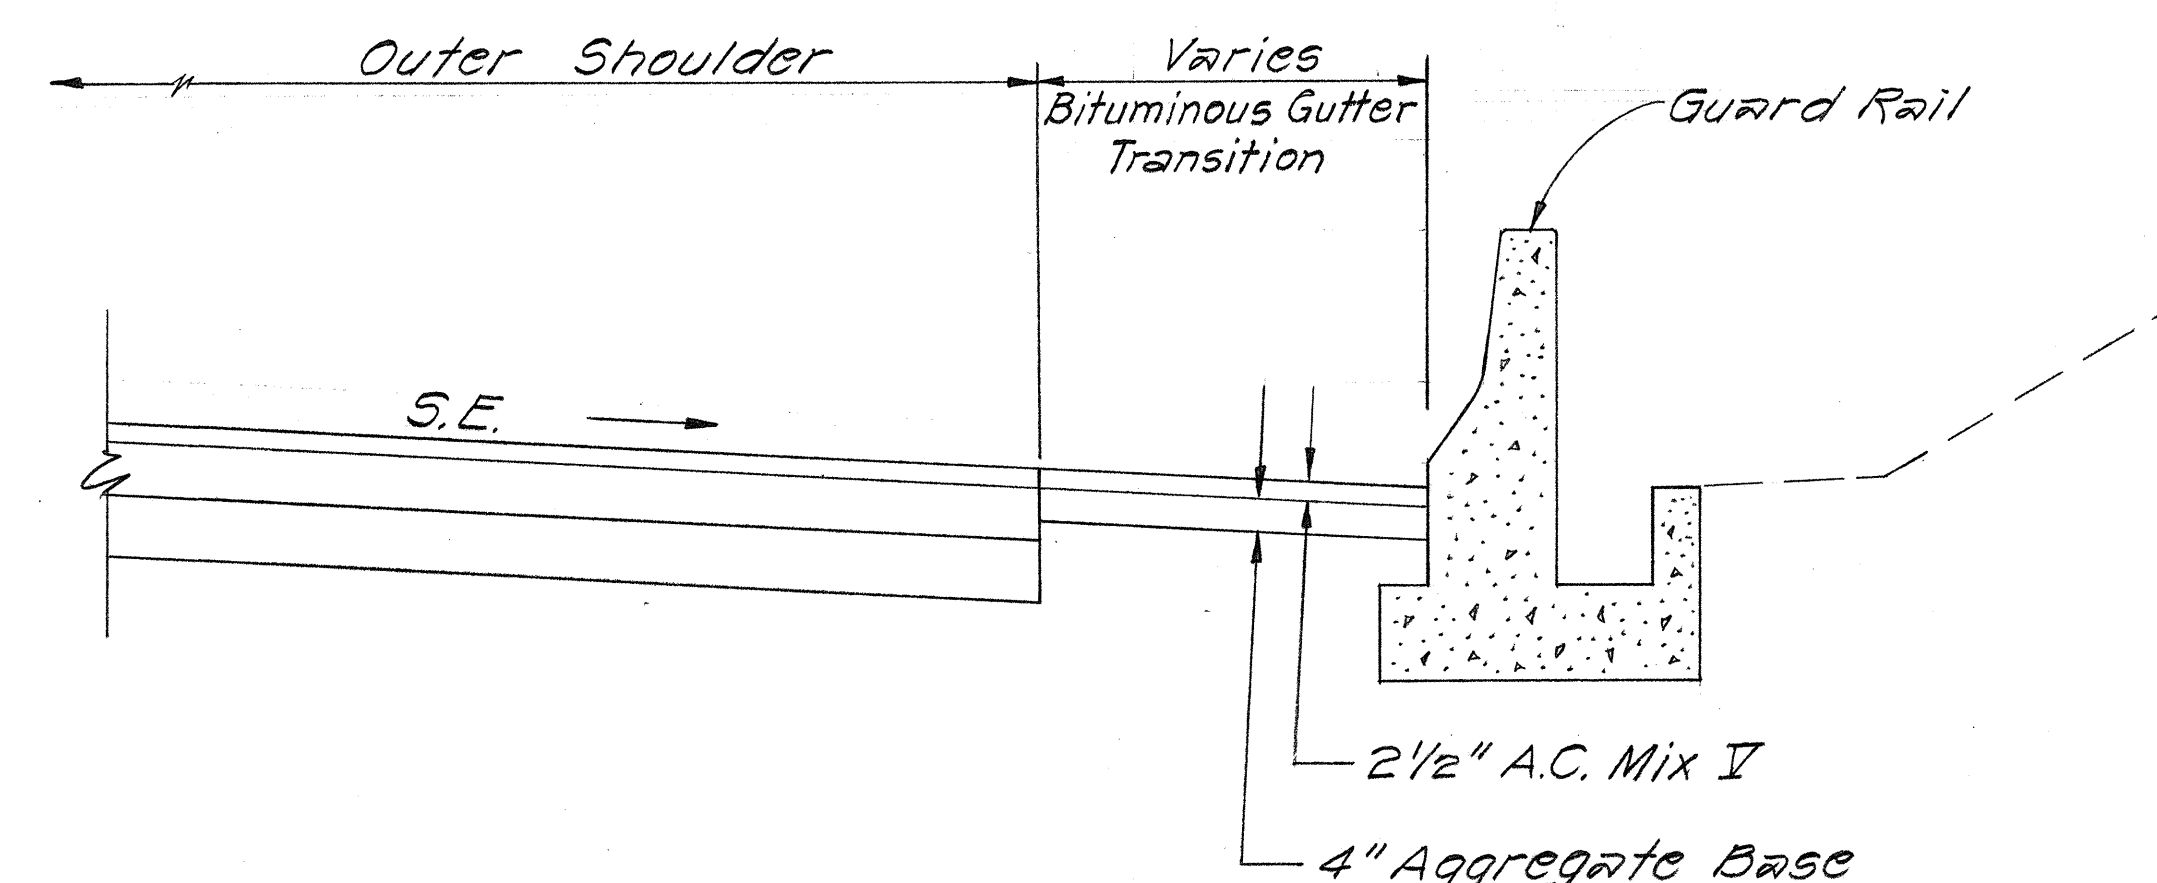


GENERAL NOTES ~ TYPICAL SECTIONS

1. BITUMINOUS GUTTER SECTIONS:
 - a. The Aggregate Base, weed killer (non-emergent) and prime coat required for gutter shall be incidental to bituminous gutter.
 - b. A.C. Mix I shall conform to the requirements of Section 602 - Curb and/or Gutter of the Special Provisions.
 - c. 2"x4" Redwood Header shall be construction grade lumber or better, rough finish. (Incidental to Bituminous Gutter)
2. For Guard Rail Plan, see sht. no. 12.
3. For Approach Slab Location, see sht. nos. 9 & 10.
4. For location of Glare Screen, see Detail Plan of Roadway.
5. For Bituminous Gutter Transition, see sht. nos. 38 & 39.

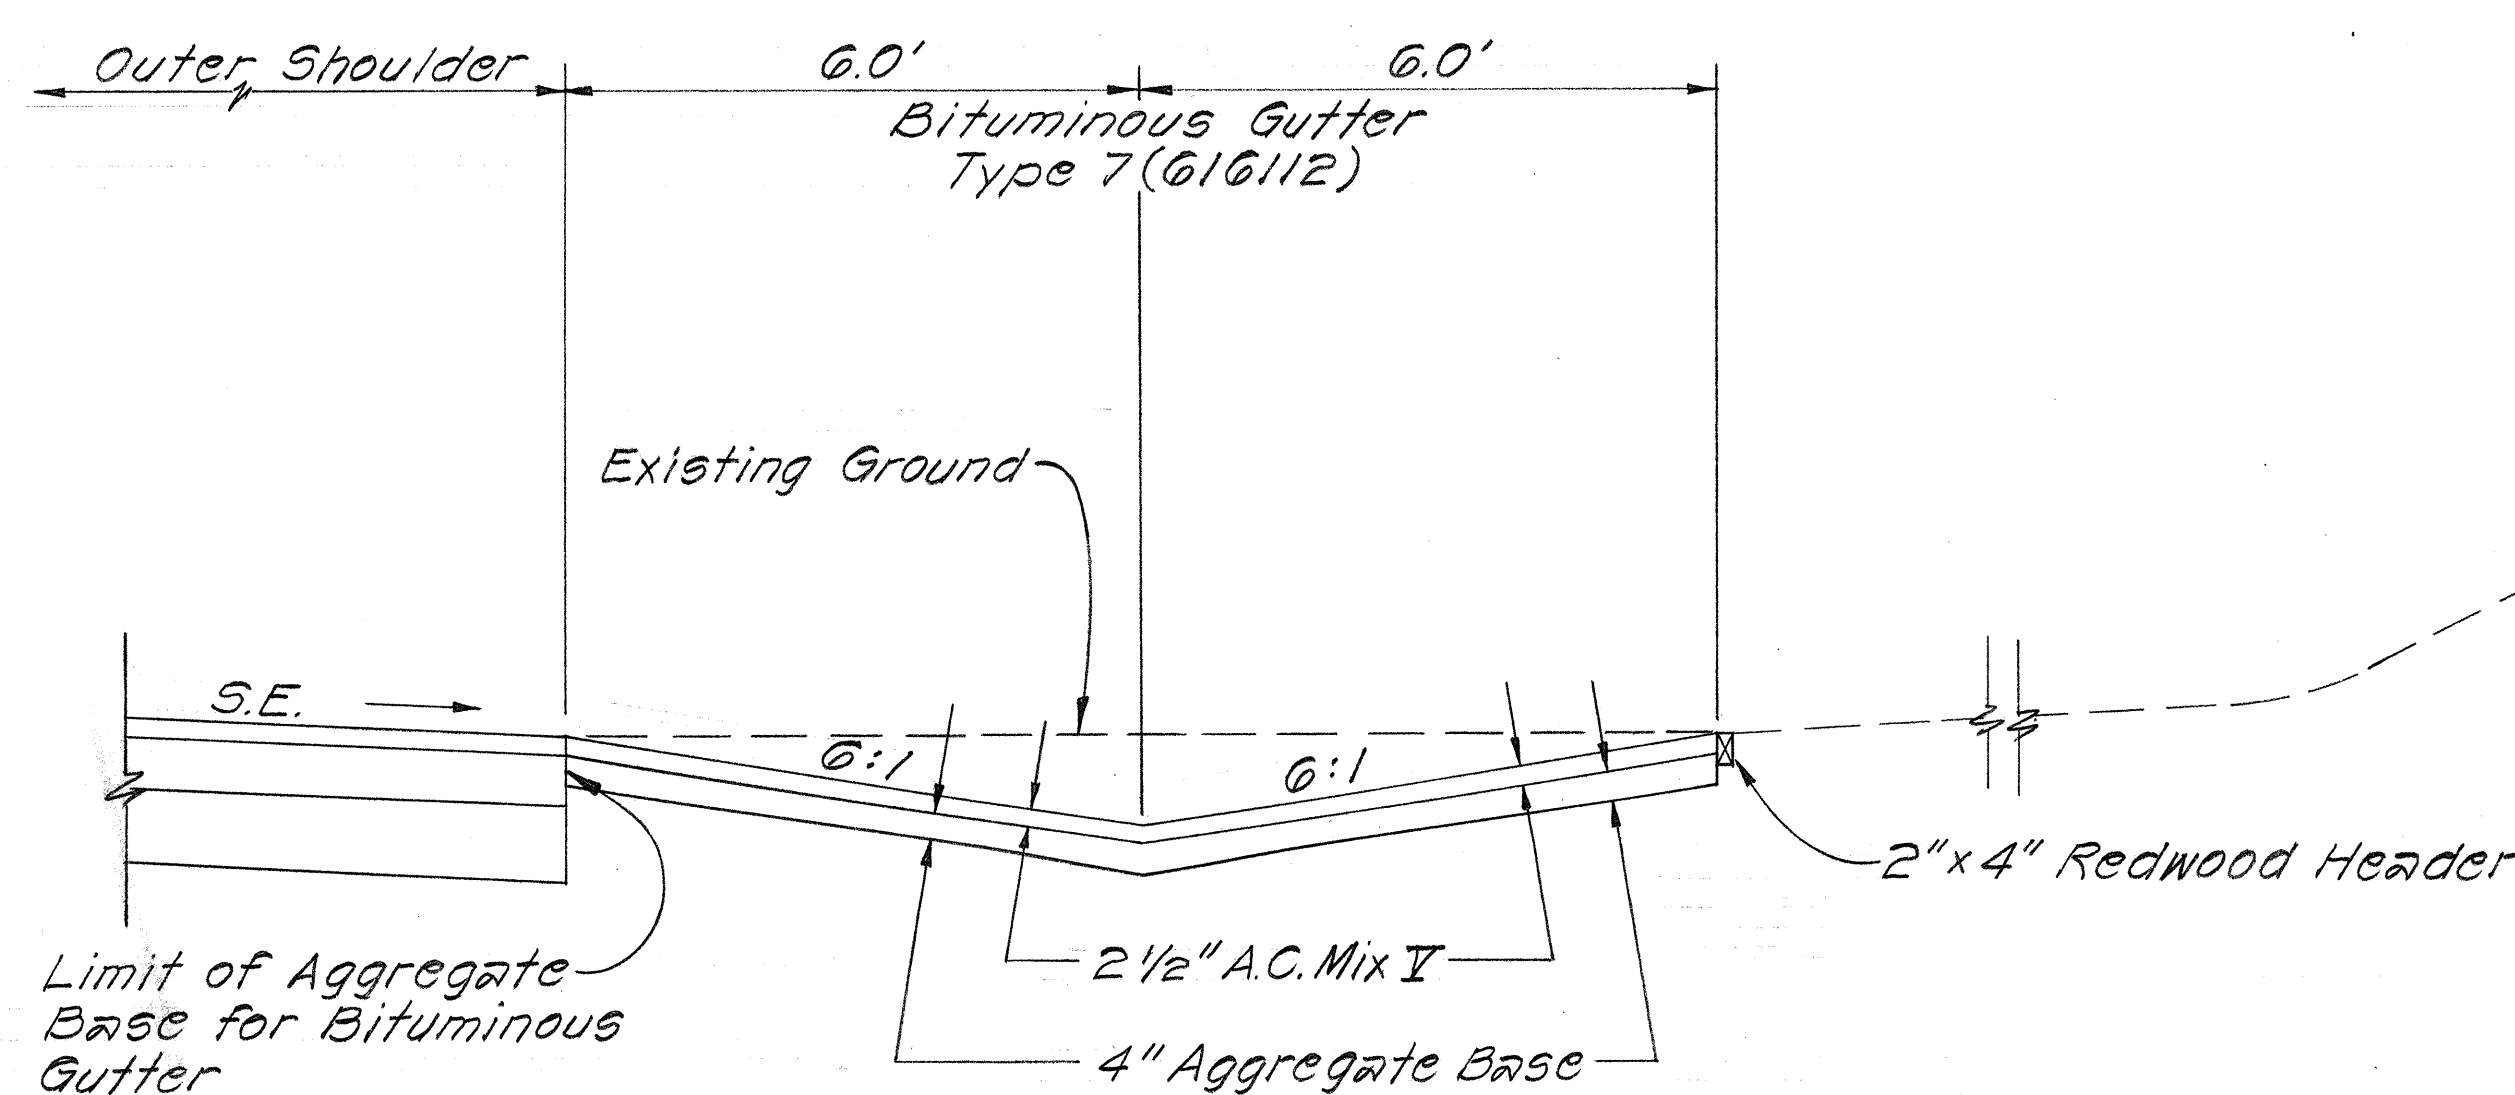


STATE OF HAWAII
 DEPARTMENT OF TRANSPORTATION
 HIGHWAYS DIVISION
TYPICAL SECTIONS
 INB. $\pm$ STA. 223+00 to 225+21.72
 INTERSTATE ROUTE H-2
 KIPAPA STREAM BRIDGE
 F.A.I. Proj. No. I-H2-1(2):4
 Scale: As Shown Date: May, 1973
 SHEET No. 1 OF 3 SHEETS


FED. ROAD DIST. NO.	STATE	FED. AID PROJ. NO.	FISCAL YEAR	SHEET NO.	TOTAL SHEETS
HAWAII	HAW.	I-H2-1(10):4	1973	3	122

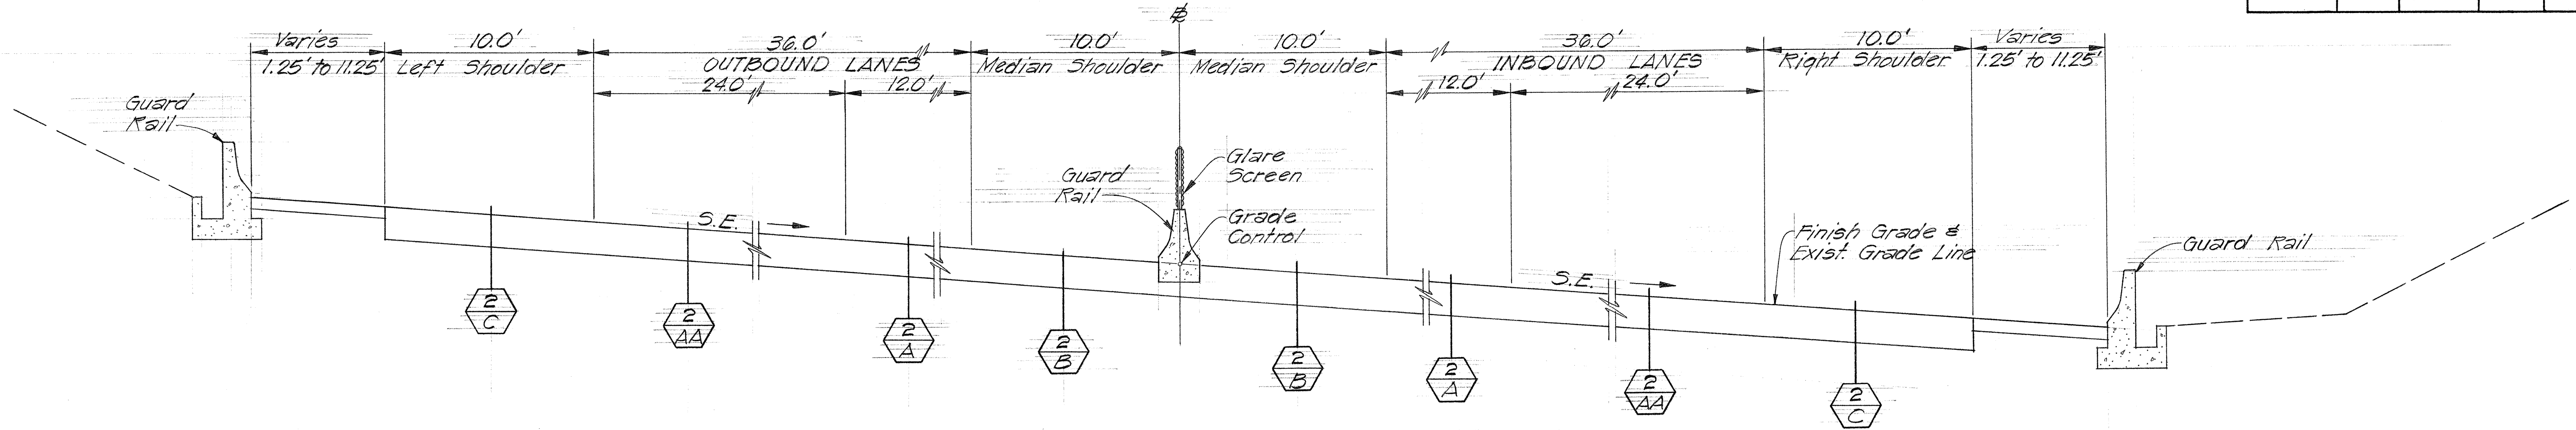


ROADWAY SUPERELEVATED SECTION
 STA. 246+10 to STA. 248+00
 Scale: 1/4" = 1'-0"

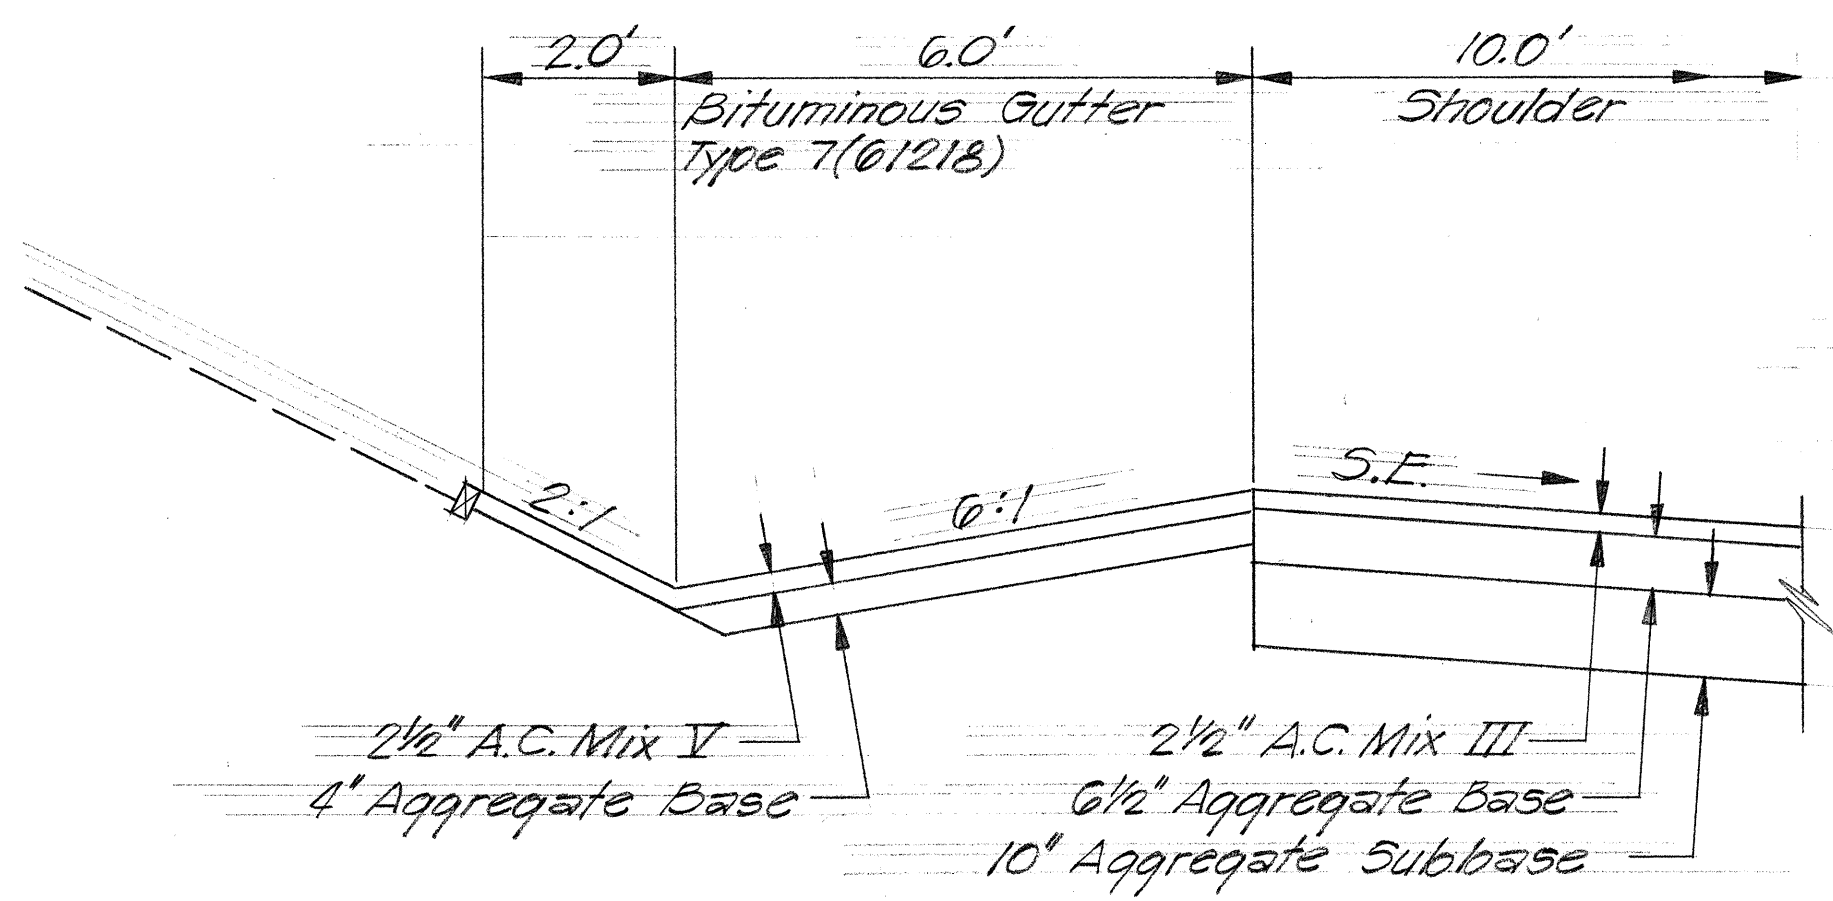


GUTTER SECTION DETAIL #3
 Scale: 1/2" = 1'-0"

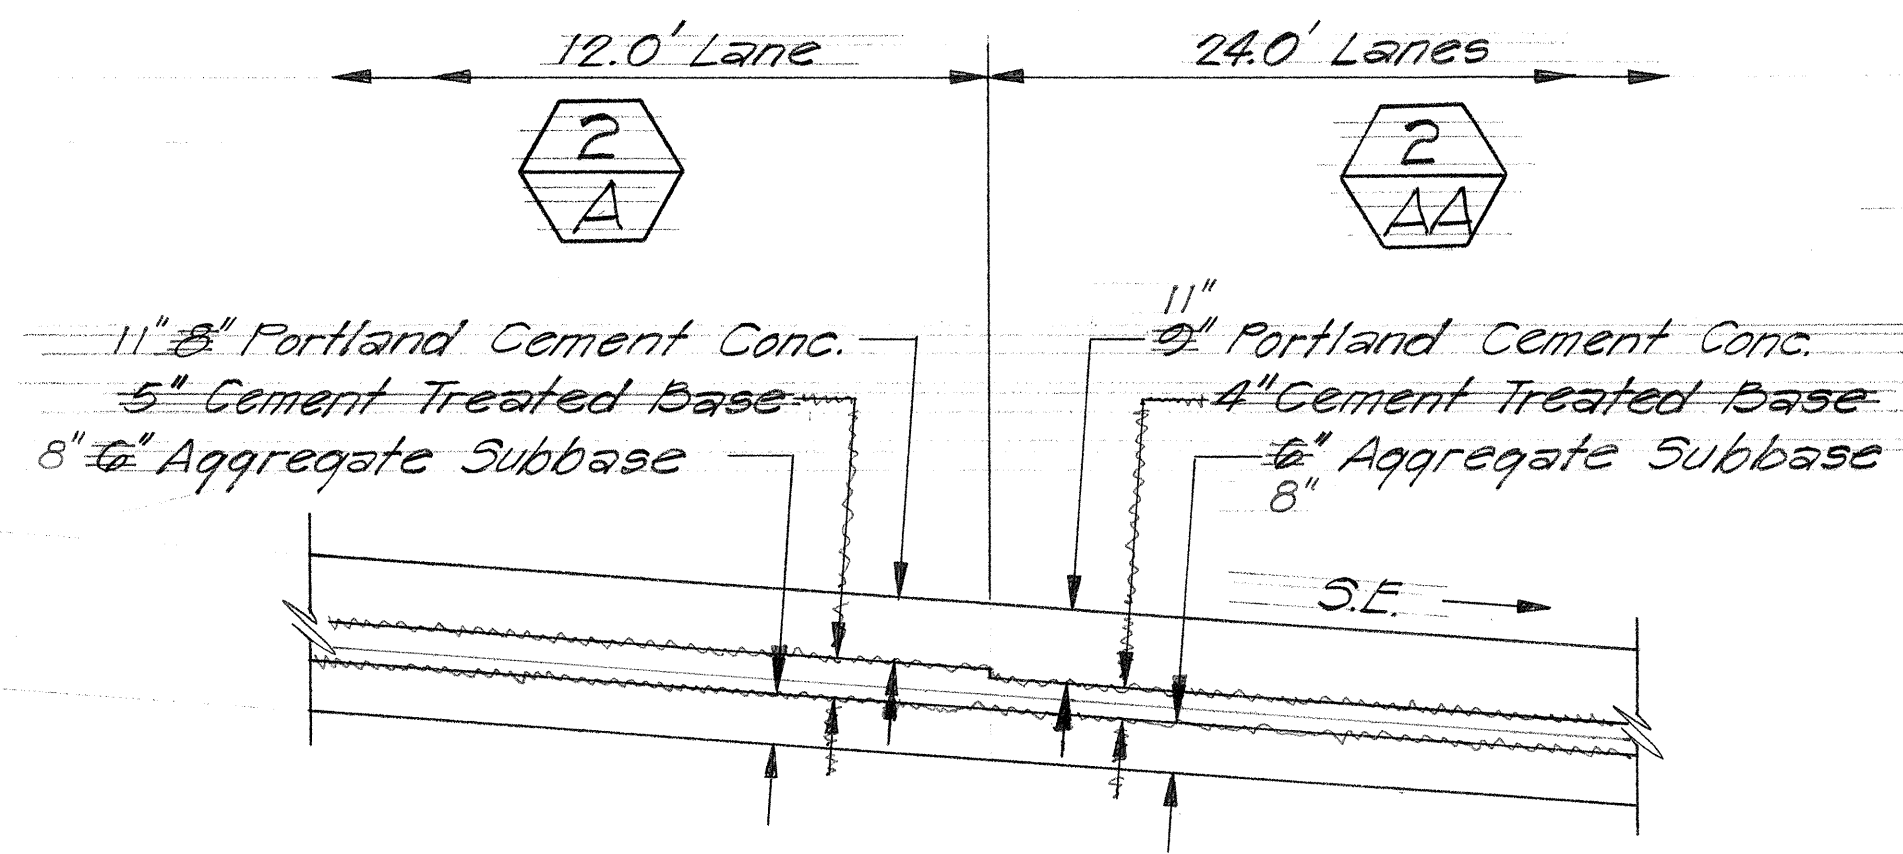


PAVEMENT DETAIL
 Scale: 1/2" = 1'-0"

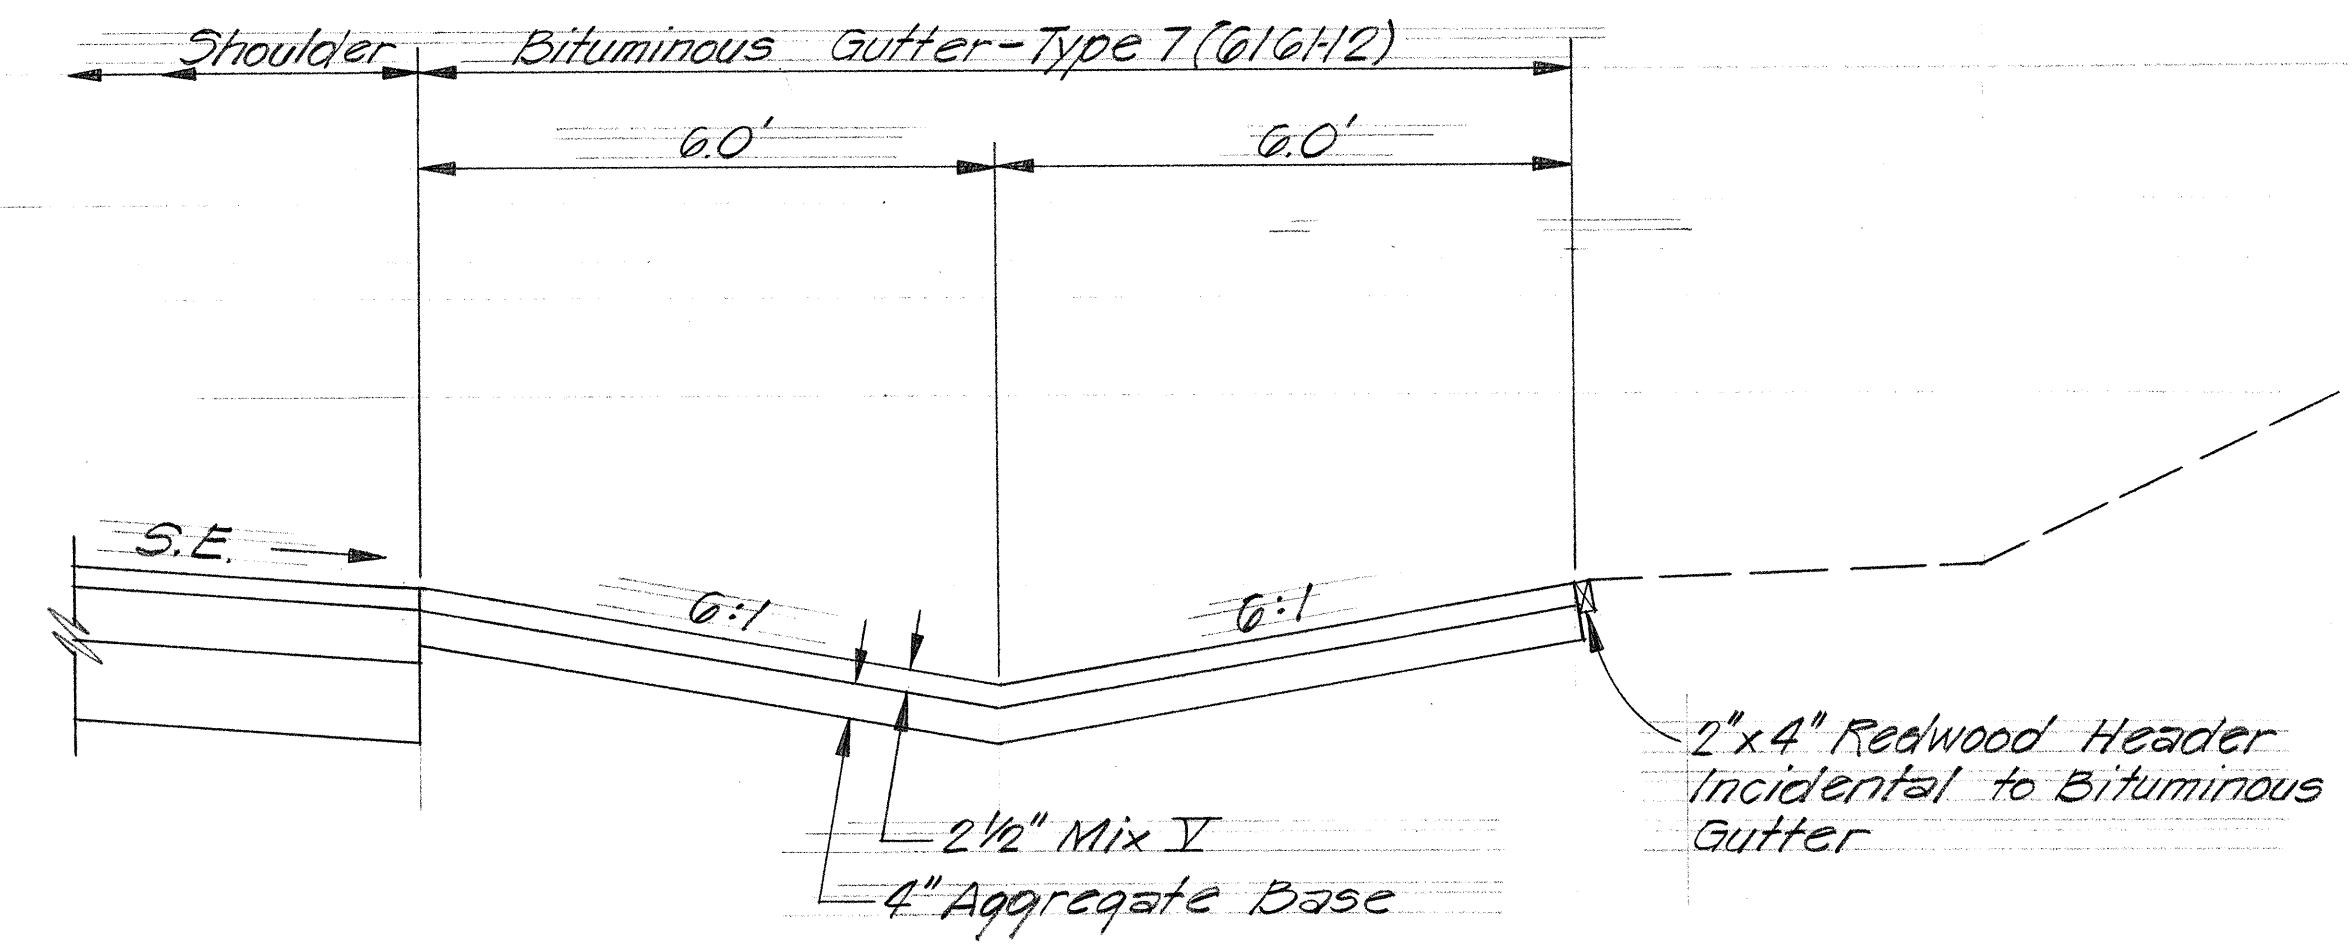

GUTTER SECTION DETAIL #4
 Scale: 1/2" = 1'-0"

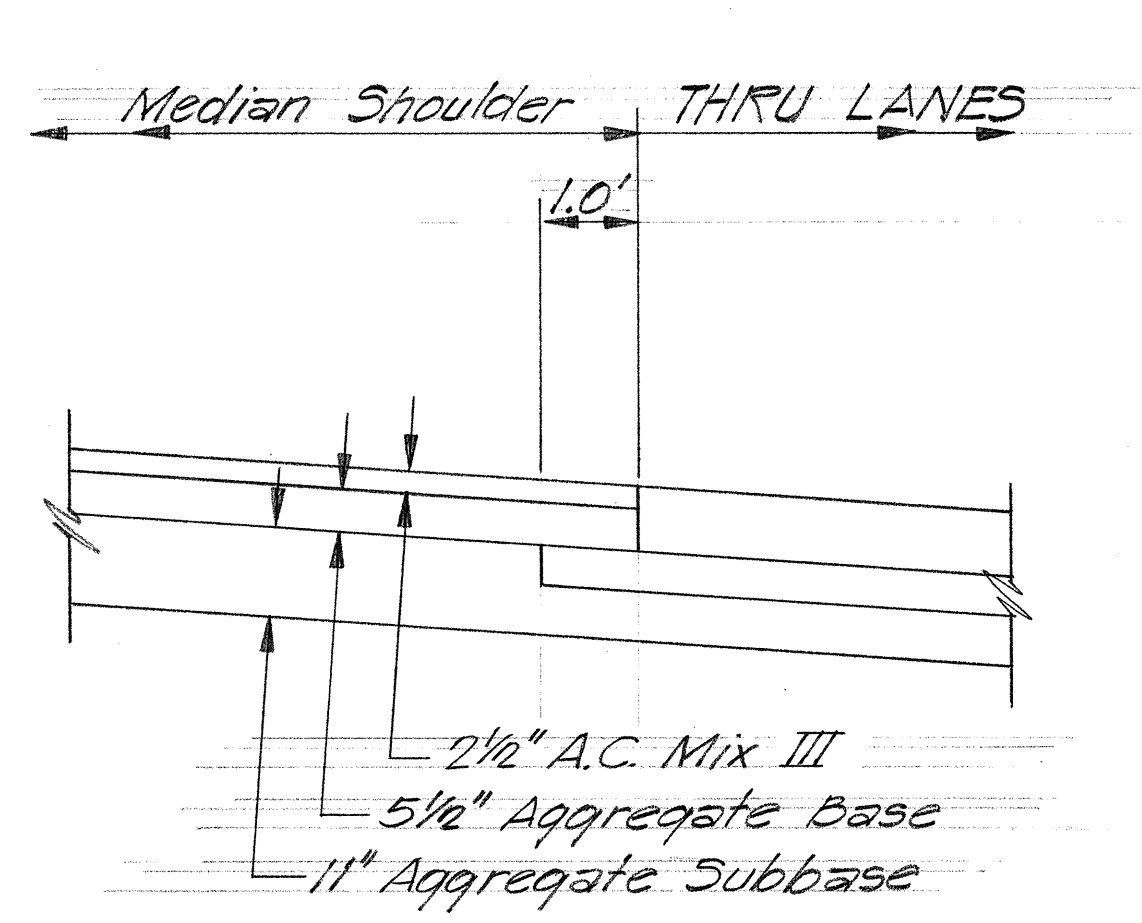

2 B

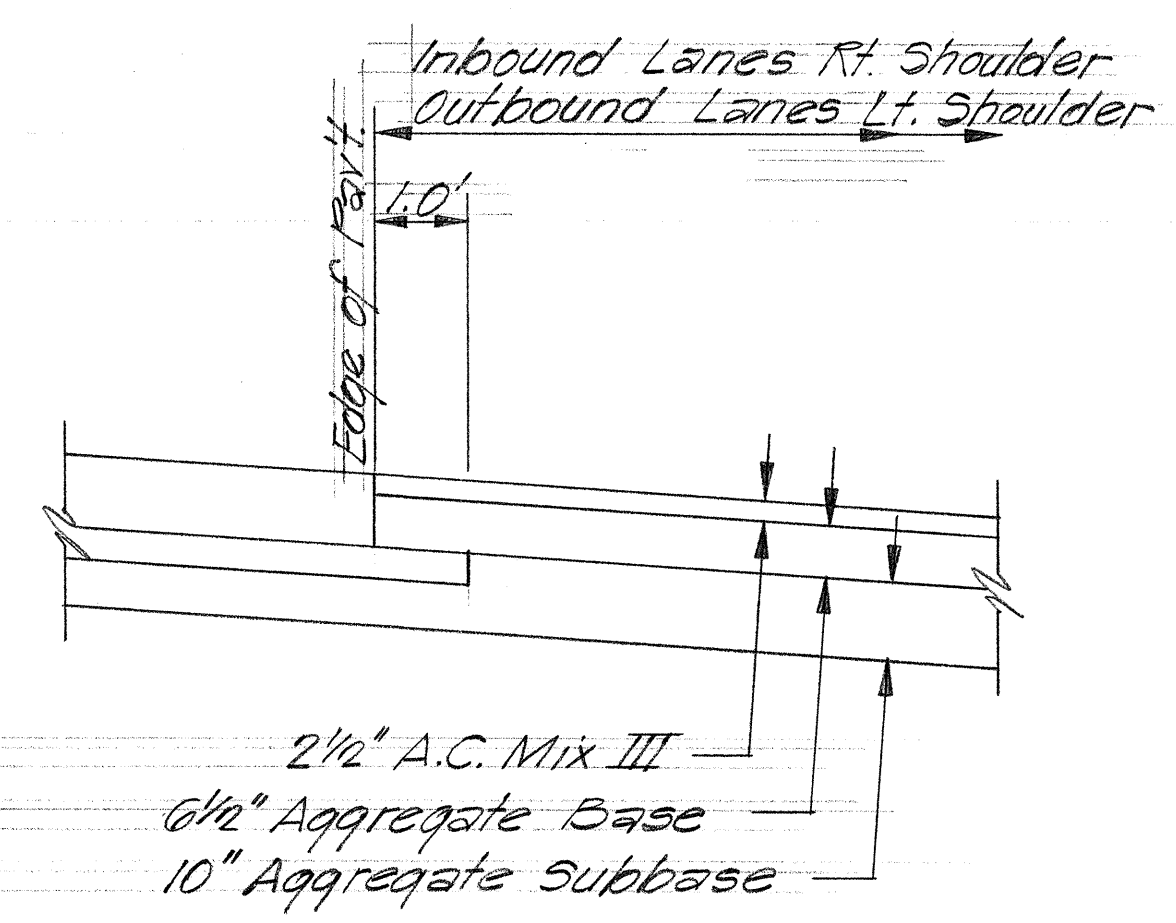

2 C

STATE OF HAWAII
 DEPARTMENT OF TRANSPORTATION
 HIGHWAYS DIVISION


TYPICAL SECTIONS
 STA. 246+10 to STA. 248+00

INTERSTATE ROUTE H-2
 KIPAPA STREAM BRIDGE
 FAI PROJ. NO. I-H2-1(10):4


Scale: As Shown Date: May 1973

SHEET No. 2 OF 3 SHEETS


FED. ROAD DIST. NO.	STATE	FED. AID PROJ. NO.	FISCAL YEAR	SHEET NO.	TOTAL SHEETS
HAWAII	HAW.	I-H2-1(0)4	1973	4	122

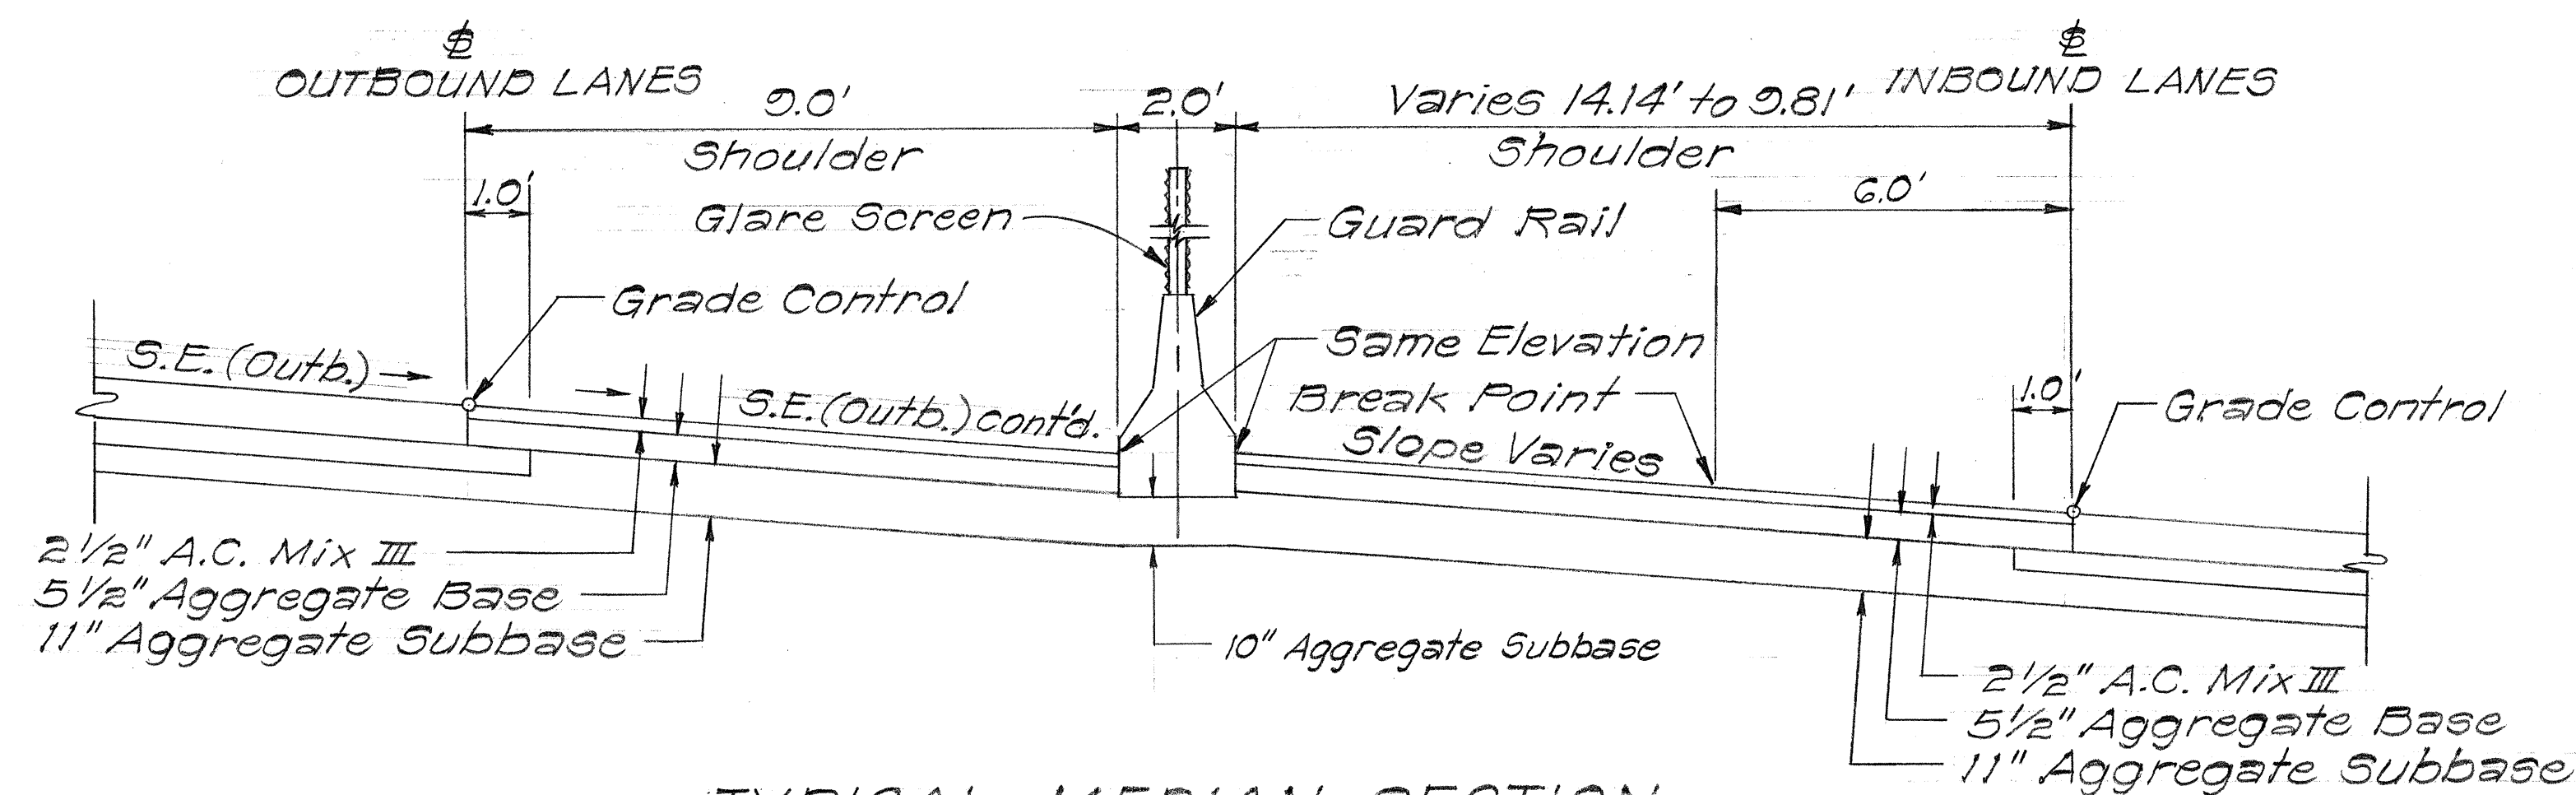

TYPICAL MEDIAN SECTION
 INBOUND $\pm$ STA. 223+00 to INBOUND $\pm$ STA. 225+21.72
 Scale: $\frac{3}{8}$ " = 1'-0"

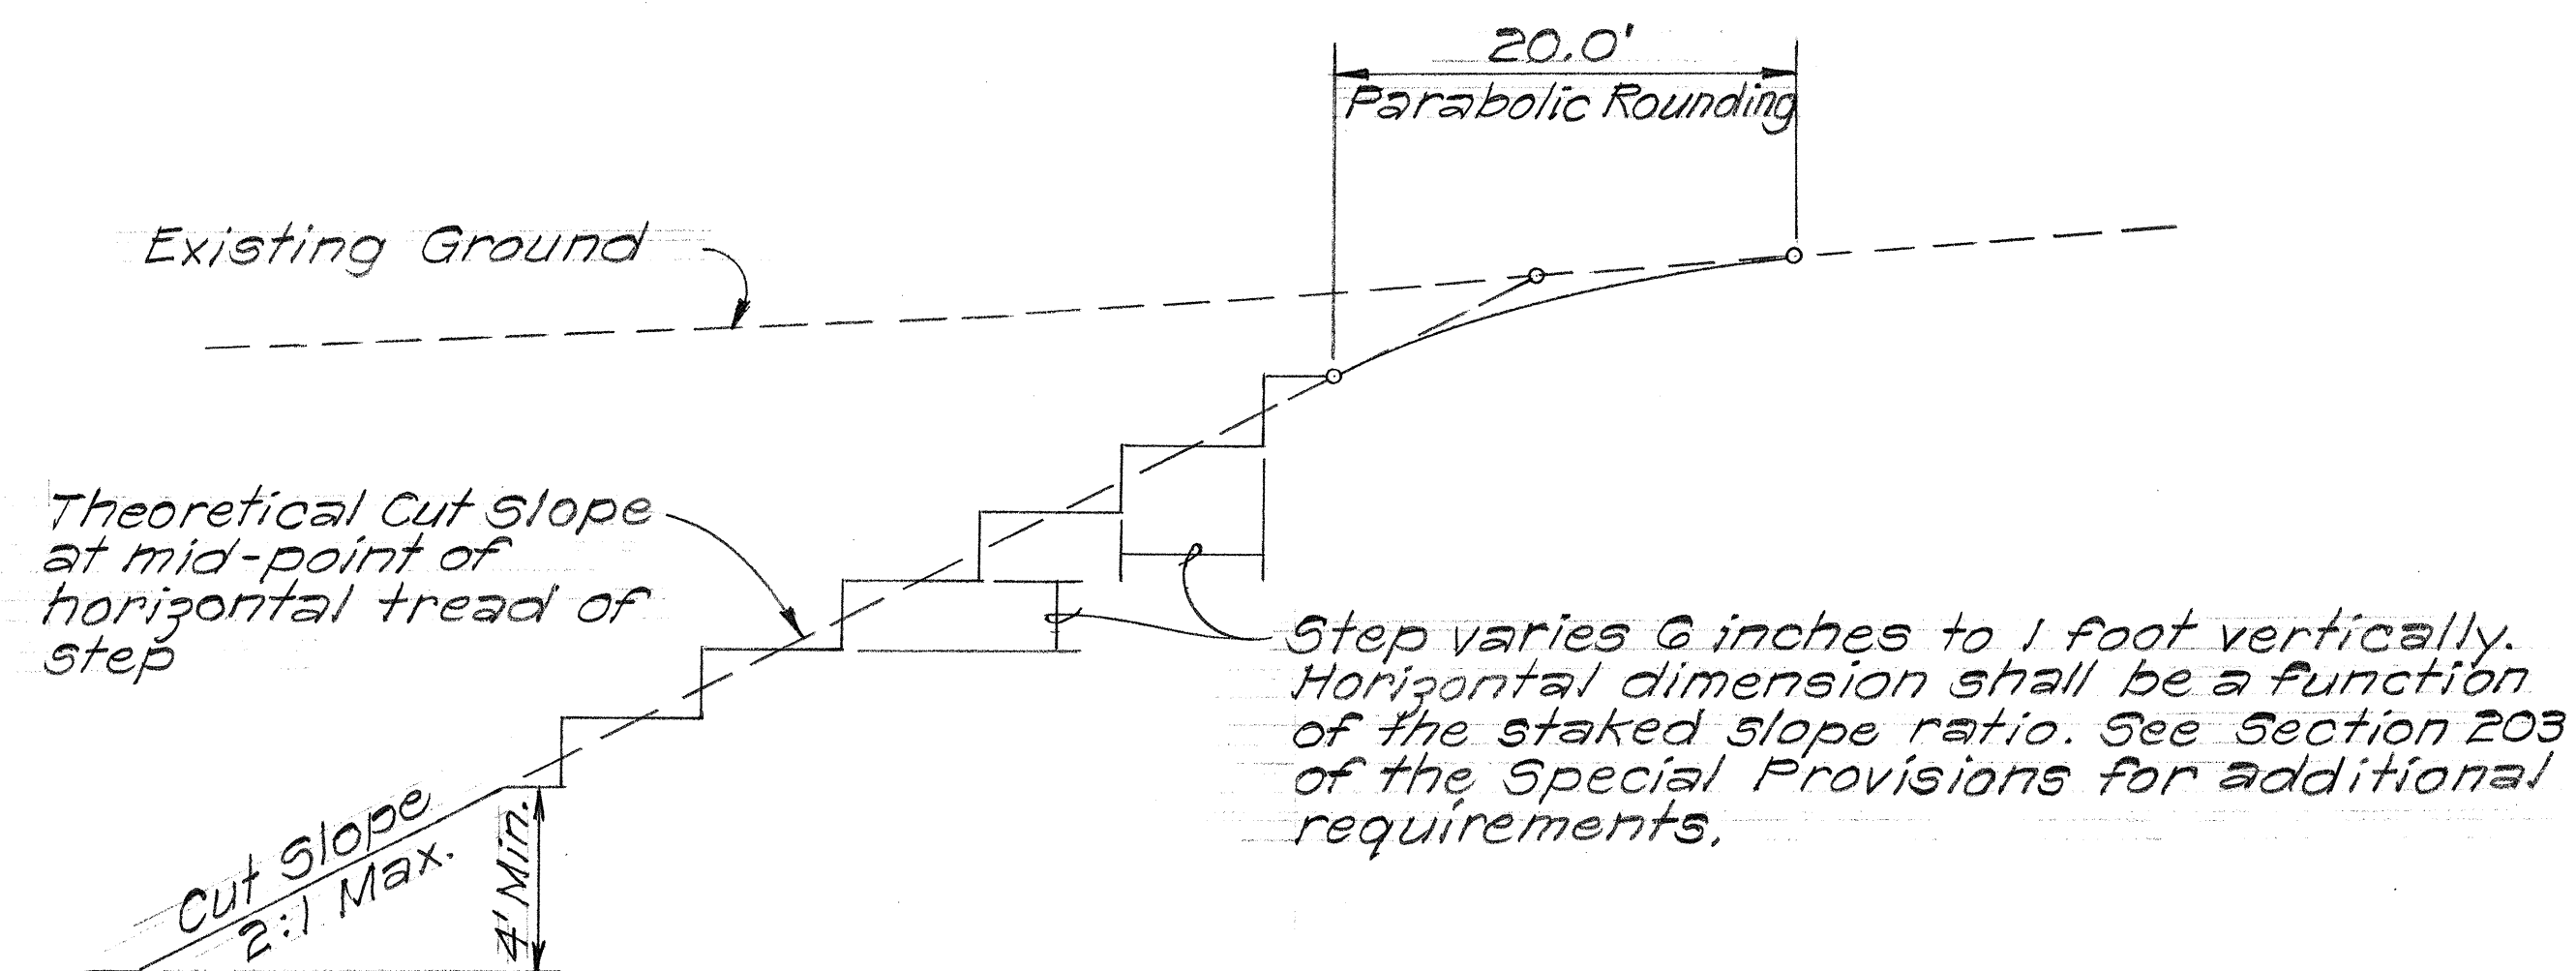

SERRATED CUT SLOPE DETAIL
 Scale: $\frac{1}{8}$ " = 1'-0"

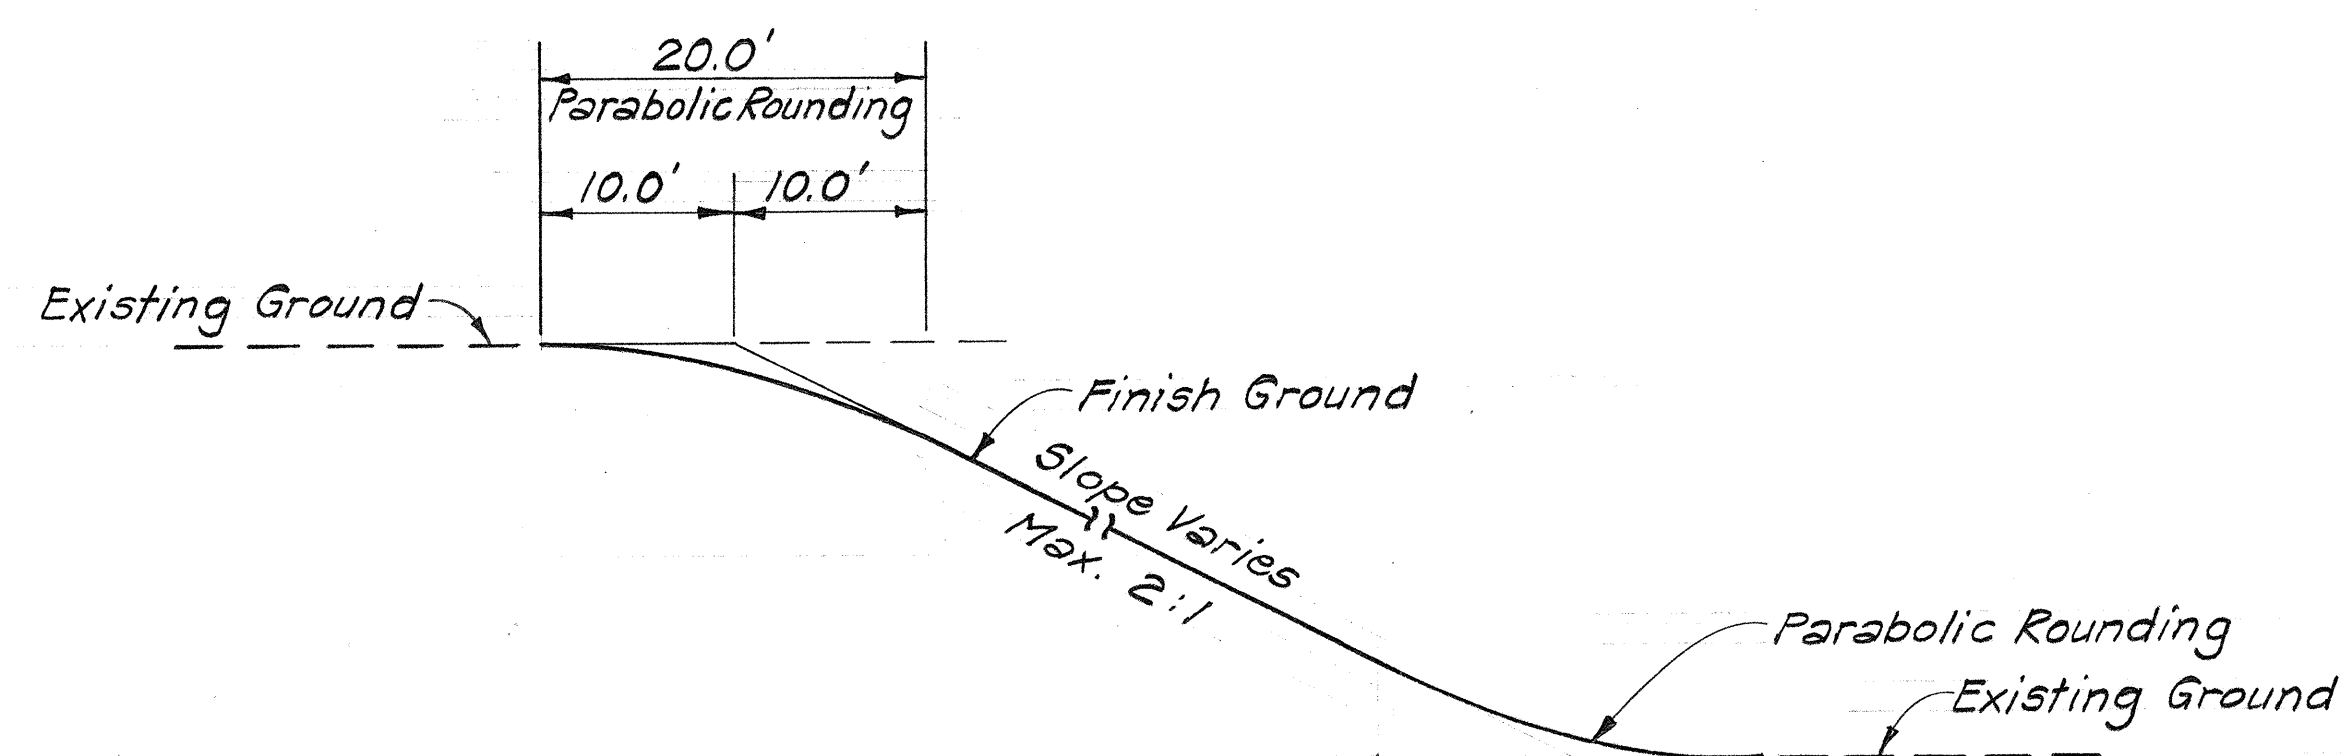

PARABOLIC ROUNDING DETAIL
 Not to Scale

STATE OF HAWAII
 DEPARTMENT OF TRANSPORTATION
 HIGHWAYS DIVISION

TYPICAL SECTIONS

INTERSTATE ROUTE H-2
 KIPAPA STREAM BRIDGE
 F.A.I. Proj. No. I-H2-1(0)4
 Scale: As Shown Date: June, 1973

SHEET No. 3 OF 3 SHEETS