


FED. ROAD DIST. NO.	STATE	PROJ. NO.	FISCAL YEAR	SHEET NO.	TOTAL SHEETS
HAWAII	HAW.	H2A-01-B1	1982	3	4

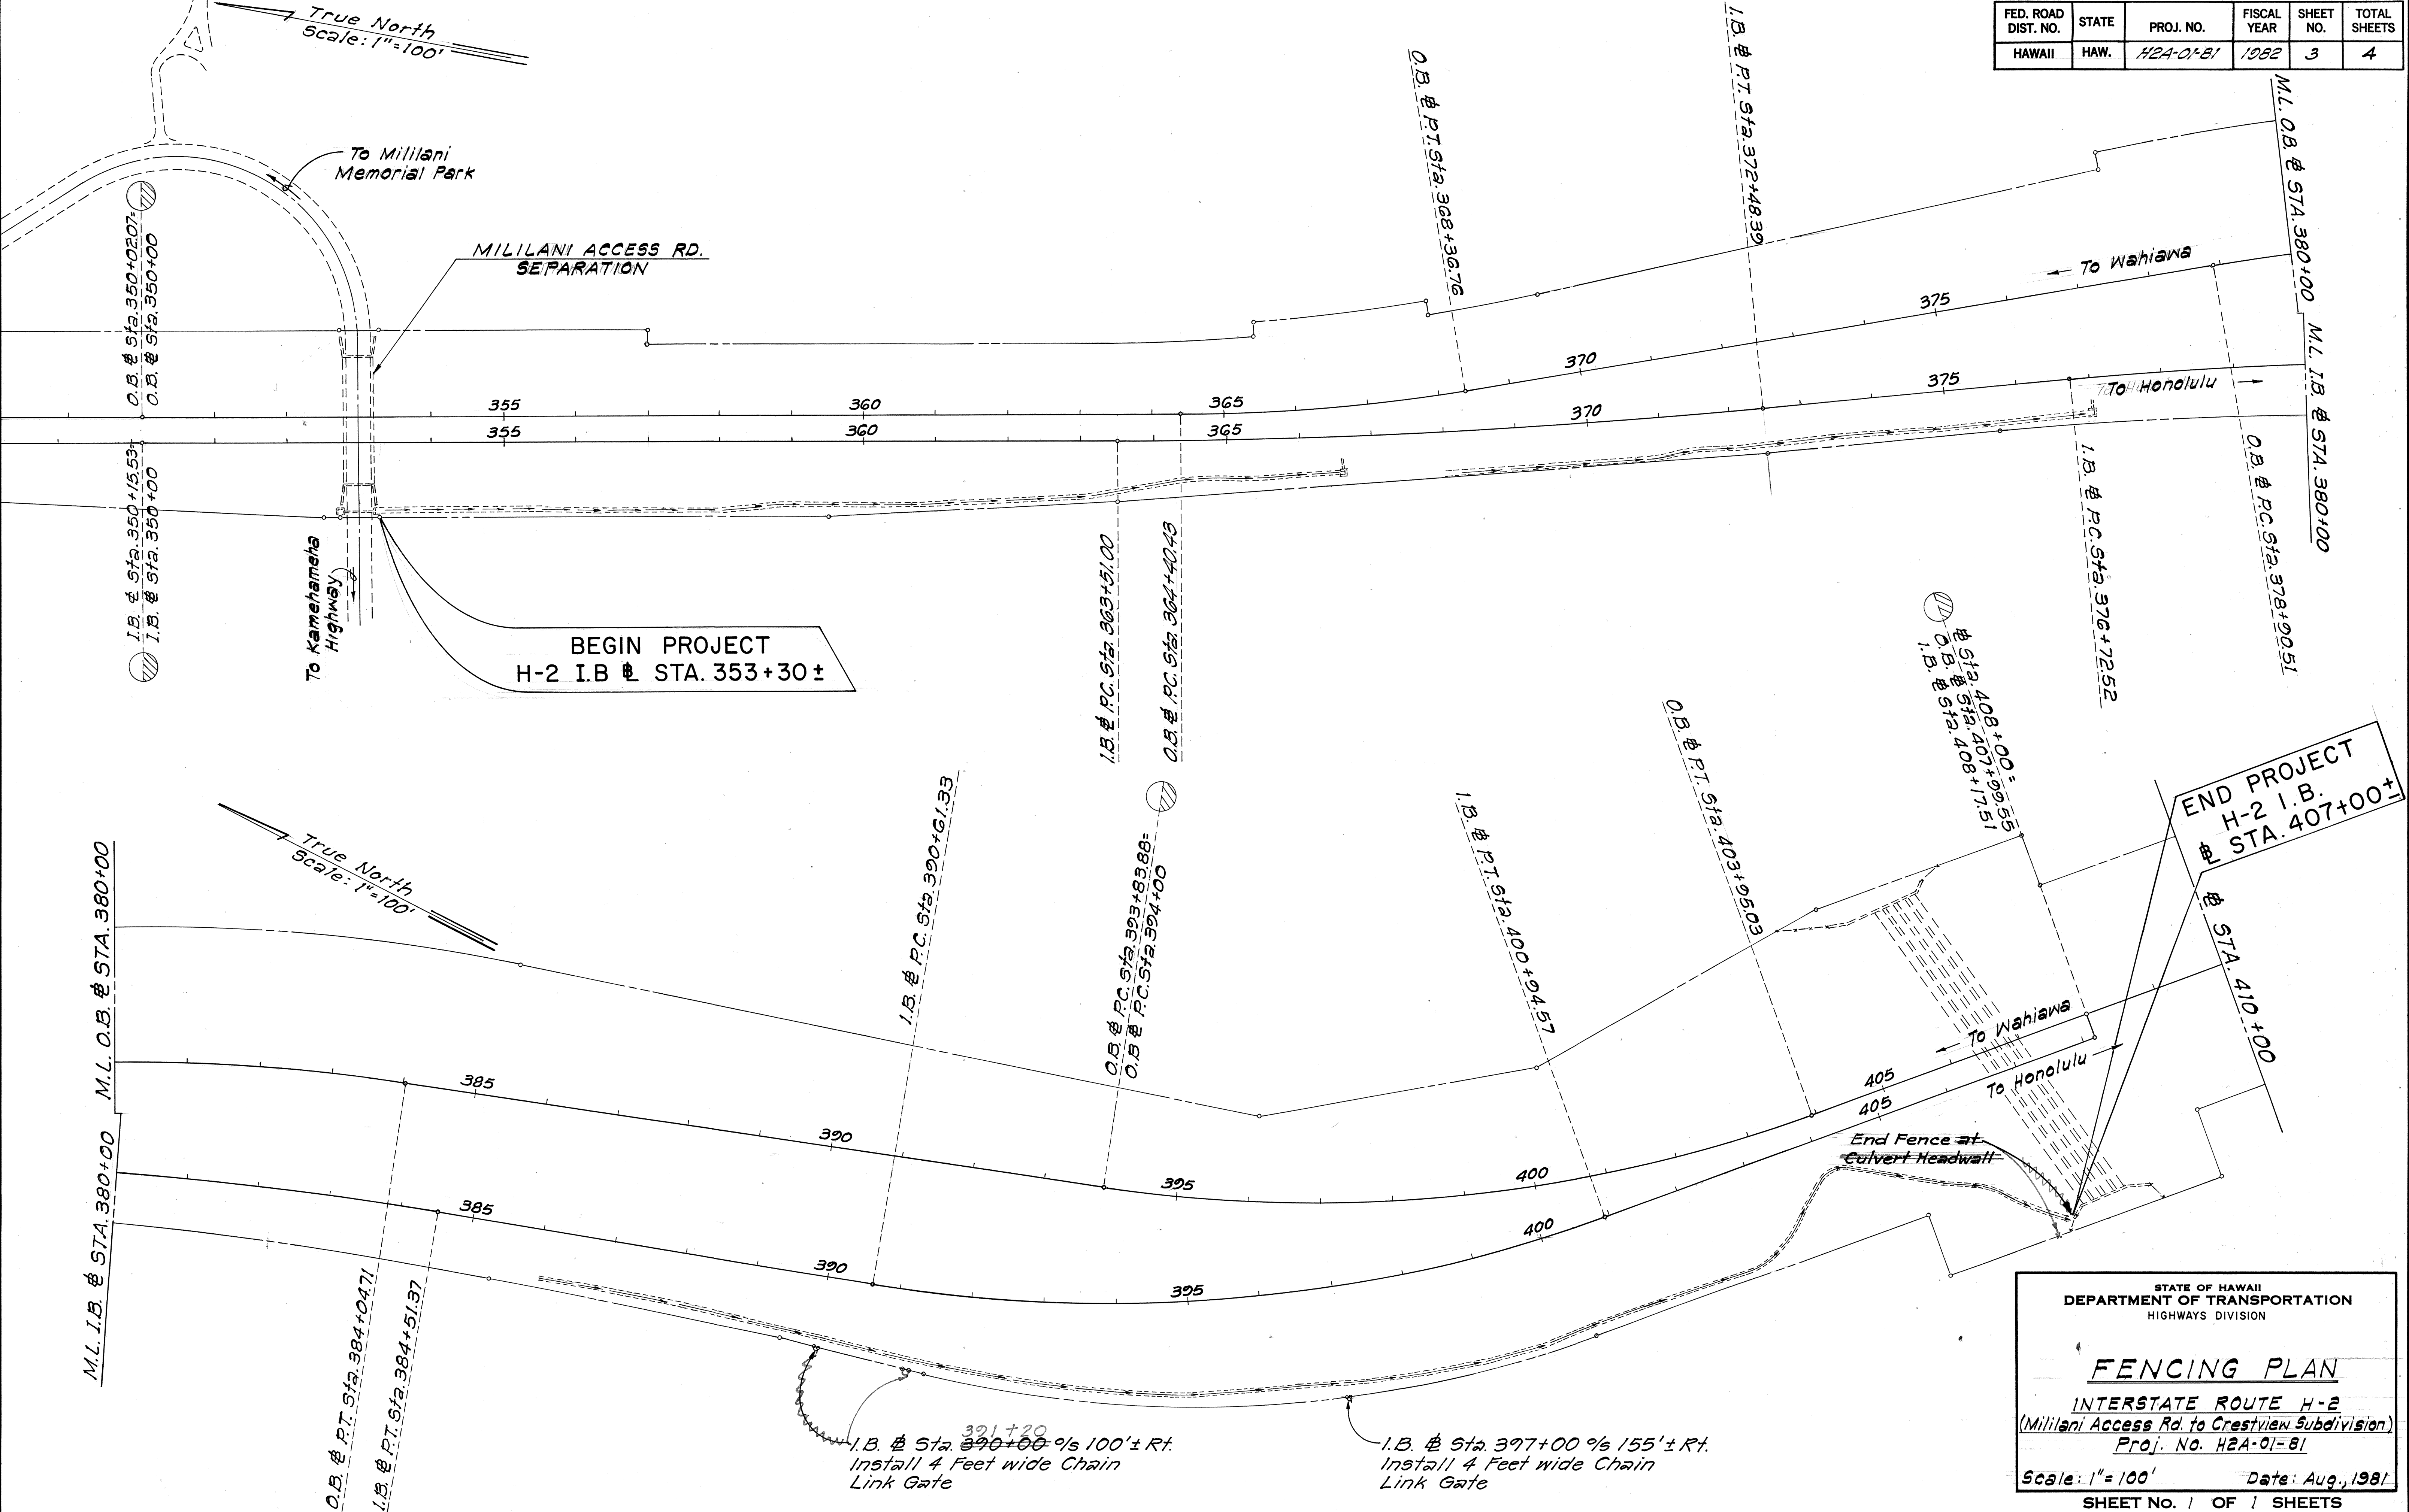

STATE OF HAWAII
DEPARTMENT OF TRANSPORTATION
HIGHWAYS DIVISION

FENCING PLAN
INTERSTATE ROUTE H-2
(Mililani Access Rd. to Crestview Subdivision)
Proj. No. H2A-01-B1

Scale: 1" = 100' Date: Aug., 1981

SHEET NO. 1 OF 1 SHEETS

ORIGINAL PLAN	SURVEY PLOTTED BY	DATE
NOTE BOOK	DRAWN BY	"
	DESIGNED BY	"
	CHECKED BY	"

2355A-2/12