

F.A.I. PROJECT NO. : IR-H2-1(27)

<i>DATE</i>	<i>REVISION</i>
-------------	-----------------

SHEET No. *H01* OF 42 SHEETS

ORIGINAL PLAN	SURVEY PLOTTED BY _____ DATE _____
NOTE BOOK	DRAWN BY _____ *
	TRACED BY _____ *
	DESIGNED BY _____ *
	QUANTITIES BY _____ *
N. _____	CHECKED BY _____

DRAINAGE SUMMARY

PROJECT: INTERSTATE ROUTE H-2 HOV LANES, PH. II
Mililani Interchange to Waipio Interchange

F.A.I. PROJECT NO. : IR-H2-1(27)

FED. ROAD DIST. NO.	STATE	FED. AID PROJ. NO.	FISCAL YEAR	SHEET NO.	TOTAL SHEETS
HAWAII	HAW.	IR-H2-1(27)	1992	93	223

01/19/93	Pipe size changed.
----------	--------------------

DATE	REVISION
------	----------

[illegible]

SHEET No. *H02* OF 42 SHEETS

C.O. 93

ORIGINAL PLAN	SURVEY PLOTTED BY _____	DATE _____
NOTE BOOK	DRAWN BY _____	*
	TRACED BY _____	*
	DESIGNED BY _____	*
	QUANTITIES BY _____	*
N _o _____	CHECKED BY _____	N _o _____

PROJECT: INTERSTATE ROUTE H-2 HOV LANES, PH. II
Mililani Interchange to Waipio Interchange

IR-H2-1(27)

SHEET No. *H03* OF 42 SHEETS

C.O. 94

		DRAINAGE SUMMARY																																FED. ROAD DIST. NO.	STATE	FED. AID PROJ. NO.	FISCAL YEAR	SHEET NO.	TOTAL SHEET		
07/22/94 01/19/93		Type 6 MDI added. Pipe size changed, depth of GDI changed.		PROJECT: INTERSTATE ROUTE H-2 HOV LANES, PH. II Mililani Interchange to Waipio Interchange																																HAWAII	HAW.	IR-H2-1(27)	1992	94	223
DATE		REVISION		F.A.I. PROJECT NO.: IR-H2-1(27)																																					
ITEM NO.				206. 1000	207. 0100	503. 0000	602. 1020	603. 2085	603. 2087	603. 2089	604. 4810	604. 4820	604. 5000	604. 5004	604. 5005	604. 5006	604. 5007	604. 5010	604. 5104	604. 5105	604. 5108	604. 5201	604. 5203	604. 5205	604. 5206	604. 5207	604. 5304	604. 5305	604. 5306	604. 5400	604. 5500	604. 5600	604. 5700	604. 5800	604. 5904	640. 2100	640. 2105				
UNIT USED				C.Y.	C.Y.	C.Y.	LB.	L.F.	L.F.	L.F.	EA.	EA.	EA.	EA.	EA.	EA.	EA.	EA.	EA.	EA.	EA.	EA.	EA.	EA.	EA.	EA.	EA.	EA.	EA.	EA.	EA.	EA.	EA.	EA.	EA.	L.F.	L.F.				
STRUCTURE	STATION	STRUCTURE EXCAVATION OTHER THAN AT BRIDGES	DITCH AND CHANNEL EXCAVATION	CLASS "A" CONCRETE OTHER THAN IN BRIDGES	REINFORCING STEEL FOR DRAINAGE SYSTEM	24-INCH CORRUGATED STEEL PIPE SHT. "+" = 0.109"	30-INCH CORRUGATED STEEL PIPE SHT. "+" = 0.109"	36-INCH CORRUGATED STEEL PIPE SHT. "+" = 0.109"	REMOVING, CLEANING, AND RETURNING MANHOLE CAST IRON FRAMES AND COVERS TO 727 KAKOI ST., HONOLULU, HAWAII	REMOVING, CLEANING, AND RETURNING STEEL FRAMES AND GRATES TO 727 KAKOI ST., HONOLULU, HAWAII	MODIFY EXISTING A-12 STEEL FRAME AND GRATE	TYPE 61614 GDI 4.00 FT. TO 4.99 FT.	TYPE 61614 GDI 5.00 FT. TO 5.99 FT.	TYPE 61614 GDI 6.00 FT. TO 6.99 FT.	TYPE 61614 GDI 7.00 FT. TO 7.99 FT.	TYPE 61614 GDI 10.00 FT. TO 10.99 FT.	TYPE 61616 GDI 4.00 FT. TO 4.99 FT.	TYPE 61616 GDI 5.00 FT. TO 5.99 FT.	TYPE 61616 GDI 8.00 FT. TO 8.99 FT.	TYPE 61614-M GDI 1.00 FT. TO 1.99 FT.	TYPE 61614-M GDI 3.00 FT. TO 3.99 FT.	TYPE 61614-M GDI 5.00 FT. TO 5.99 FT.	TYPE 61614-M GDI 6.00FT TO 6.99 FT.	TYPE 61614-M GDI 7.00FT TO 7.99 FT.	TYPE 61616-M GDI 4.00FT TO 4.99 FT.	TYPE 61616-M GDI 5.00FT TO 5.99 FT.	TYPE 61616-M GDI 6.00FT TO 6.99 FT.	TYPE 61614-N GDI	TYPE 61616-O GDI	TYPE "X" SDMH	TYPE "Y" SDMH	TYPE "K" CDI	TYPE 6 MDI 4.00 FT. TO 4.99 FT.	2' x 1.5' (SS 1:1) LINED TRAPEZOIDAL DRAINAGE DITCH	SPILLWAY						
Type 61614 GDI	⌚ Sta 282+50 RT	7				9						1																													
Type "X" SDMH	⌚ Sta 285+00 o/s 57' RT																														1										
Type 61614 GDI	⌚ Sta 285+00 RT	8				9						1																													
STANDARD CONCRETE HEADWALL	O.B. ⌚ Sta 297+90 o/s 86' LT	5		1	34																																				
Type 61614 GDI	O.B. ⌚ Sta 297+90 LT	12			14								1																												
SPILLWAY	I.B. ⌚ Sta 300+50 RT		7																																		50				
Type 61614 GDI	O.B. ⌚ Sta 303+00 LT											1																													
Type 61614 GDI	O.B. ⌚ Sta 306+50 LT	330			348							1																													
Type 61614 GDI	O.B. ⌚ Sta 309+98 ± LT												1																												
2x1.5 LINED TRAP. DRAINAGE DITCH	O.B. ⌚ Sta 313+00 o/s 35' ±RT		130																																	500					
SPILLWAY	O.B. ⌚ Sta 316+50 LT		7																																		50				
Type 61614 GDI	I.B. ⌚ Sta 317+75 RT	408			425				1				1																												
Type 61614 GDI	I.B. ⌚ Sta 322+00 RT	16			22								1																												
STANDARD CONCRETE HEADWALL	I.B. ⌚ Sta 322+00 o/s 59' RT	5		1	34																																				
CONCRETE DROP INLET COVER	O.B. ⌚ Sta 323+00 RT			1	97																																				
Type 61614 GDI	O.B. ⌚ Sta 328+00 RT	4			6				1			1																													
CONCRETE DROP INLET COVER	O.B. ⌚ Sta 328+90 o/s 28' ±RT			1	74																																				
Type 61614-M GDI	I.B. ⌚ Sta 329+75 RT																			1																					
Type 61614 GDI	O.B. ⌚ Sta 337+50 RT	231			250								1																												
Type 61614 GDI	I.B. ⌚ Sta 338+00 LT	231			250								1																												
Type 61614 GDI	O.B. ⌚ Sta 340+00 RT	270			265								1																												
Type 61614 GDI	I.B. ⌚ Sta 340+50 LT	224			242								1																												
Type 61616 GDI	O.B. ⌚ Sta 342+65 RT																		1																						
Type 61616 GDI	I.B. ⌚ Sta 342+92 LT	10			10														1																						
Type 6 MDI	O.B. ⌚ Sta 348+50 RT																																		1						
Type 61614-M GDI	I.B. ⌚ Sta 352+25 RT																								1																
Type 61614-M GDI	O.B. ⌚ Sta 355+75 LT																							1																	

DRAINAGE SUMMARY

PROJECT: INTERSTATE ROUTE H-2 HOV LANES, PH. II
Mililani Interchange to Waipio Interchange

F.A.I. PROJECT NO. : IR-H2-1(27)

FED. ROAD DIST. NO.	STATE	FED. AID PROJ. NO.	FISCAL YEAR	SHEET NO.	TOTAL SHEETS
HAWAII	HAW.	IR-H2-1(27)	1992	95	223

01/19/93	Pipe size changed, depth of GDI changed.
----------	--

<i>DATE</i>	<i>REVISION</i>
-------------	-----------------

ITEM NO.		206.	207.	503.	602.	603.	603.	603.	604.	604.	604.	604.	604.	604.	604.	604.	604.	604.	604.	604.	604.	604.	604.	604.	604.	604.	604.	604.	604.	604.	604.	604.	604.	640.	640.		
		1000	0100	0000	1020	2085	2087	2089	4810	4820	5000	5004	5005	5006	5007	5010	5104	5105	5108	5201	5203	5205	5206	5207	5304	5305	5306	5400	5500	5600	5700	5800	2100	2105			
UNIT USED		C.Y.	C.Y.	C.Y.	LB.	L.F.	L.F.	L.F.	EA.	EA.	EA.	EA.	EA.	EA.	EA.	EA.	EA.	EA.	EA.	EA.	EA.	EA.	EA.	EA.	EA.	EA.	EA.	EA.	EA.	EA.	EA.	EA.	L.F.	L.F.			
STRUCTURE	STATION	STRUCTURE EXCAVATION OTHER THAN AT BRIDGES	DITCH AND CHANNEL EXCAVATION	CLASS "A" CONCRETE OTHER THAN IN BRIDGES	REINFORCING STEEL FOR DRAINAGE SYSTEM	24-INCH CORRUGATED STEEL PIPE SHT. "I" - 0.109"	30-INCH CORRUGATED STEEL PIPE SHT. "I" - 0.109"	36-INCH CORRUGATED STEEL PIPE SHT. "I" - 0.109"	REMOVING, CLEANING, AND RETURNING MANHOLE CAST IRON FRAMES AND COVERS TO 727 KAKOI ST., HONOLULU, HAWAII	REMOVING, CLEANING, AND RETURNING STEEL FRAMES AND GRATES TO 727 KAKOI ST., HONOLULU, HAWAII	MODIFY EXISTING A-12 STEEL FRAME AND GRATE	TYPE 61614 GDI 4.00 FT. TO 4.99 FT.	TYPE 61614 GDI 5.00 FT. TO 5.99 FT.	TYPE 61614 GDI 6.00 FT. TO 6.99 FT.	TYPE 61614 GDI 7.00 FT. TO 7.99 FT.	TYPE 61614 GDI 10.00 FT. TO 10.99 FT.	TYPE 61616 GDI 4.00 FT. TO 4.99 FT.	TYPE 61616 GDI 5.00 FT. TO 5.99 FT.	TYPE 61616 GDI 6.00 FT. TO 6.99 FT.	TYPE 61616 GDI 8.00 FT. TO 8.99 FT.	TYPE 61614-M GDI 1.00 FT. TO 1.99 FT.	TYPE 61614-M GDI 3.00 FT. TO 3.99 FT.	TYPE 61614-M GDI 5.00 FT. TO 5.99 FT.	TYPE 61614-M GDI 6.00FT TO 6.99 FT.	TYPE 61614-M GDI 7.00FT TO 7.99 FT.	TYPE 61616-M GDI 4.00FT TO 4.99 FT.	TYPE 61616-M GDI 5.00FT TO 5.99 FT.	TYPE 61616-M GDI 6.00FT TO 6.99 FT.	TYPE 61614-N GDI	TYPE 61616-O GDI	TYPE "X" SDMH	TYPE "Y" SDMH	TYPE "K" CDI	2' x 1.5' (SS 1:1) LINED TRAPEZOIDAL DRAINAGE DITCH	SPILLWAY		
Type 61614-M GDI	I.B. ⚡ Sta 355+75 RT																						1														
A-12 FRAME AND GRATE	O.B. ⚡ Sta 365+00 RT										4																										
A-12 FRAME AND GRATE	O.B. ⚡ Sta 366+50 RT										4																										
CONCRET DROP INLET COVER	O.B. ⚡ Sta 377+00 o/s 20' ±RT			1	97																																
Type 61614-M GDI	O.B. ⚡ Sta 380+00 RT								1													1															
Type 61614-M GDI	O.B. ⚡ Sta 383+00 RT								1												1																
2x1.5 LINED TRAP. DRAINAGE DITCH	O.B. ⚡ Sta 383+00 o/s 66' RT																																	400			
Type "X" SDMH	O.B. ⚡ Sta 386+00																												1								
Type 61614 GDI	O.B. ⚡ Sta 386+00 RT	5						4					1																								
Type "K" CDI	O.B. ⚡ Sta 386+00 o/s 68' RT					57																											1				
Type 61614 GDI	I.B. ⚡ Sta 387+00 LT	8						6							1																						
Type "X" SDMH	I.B. ⚡ Sta 387+00 o/s 36' LT								1																				1								
Type 61614 GDI	I.B. ⚡ Sta 390+00 LT	6						6				1																									
Type "X" SDMH	I.B. ⚡ Sta 390+00 o/s 36' LT								1																												
Type 61614 GDI	I.B. ⚡ Sta 393+00 LT	6						5				1																									
Type "X" SDMH	I.B. ⚡ Sta 393+00 o/s 36' LT								1																				1								
Type 61614 GDI	O.B. ⚡ Sta 394+00 RT	10				11						1																									
Type 61614-M GDI	I.B. ⚡ Sta 396+00 LT								1													1															
Type 61616 GDI	O.B. ⚡ Sta 399+70 RT																		1																		

SHEET No. *H04* OF 42 SHEETS

C.O. 95

ORIGINAL PLAN	SURVEY PLOTTED BY _____	DATE _____
NOTE BOOK	DRAWN BY _____	_____
	TRACED BY _____	_____
	DESIGNED BY _____	_____
	QUANTITIES BY _____	_____
N. _____	CHECKED BY _____	_____
N. _____		

ORIGINAL PLAN

DATE

SURVEY PLOTTED BY

DESIGNED BY

NOTED BY

QUANTITIES BY

CHECKED BY

N.

DRAINAGE

SUMMARY

PROJECT: INTERSTATE ROUTE H-2 HOV LANES, PH.II

Millilani Interchange to Waipio Interchange

F.A.J. PROJECT NO.: IR-H2-I(27)

FED. ROAD DIST. NO.	STATE	FED. AID PROJ. NO.	FISCAL YEAR	SHEET NO.	TOTAL SHEETS
HAWAII	HAW.	IR-H2-I(27)	1992	96	223

ITEM NO.		609. 2616	609. 2618	609. 2620
UNIT USED		L.F.	L.F.	L.F.
GUTTERS				
FROM TO		GUTTER, TYPE 2(61616)	GUTTER, TYPE 2(61618)	MEDIAN GUTTER
INBOUND STATION				
Sta 246+10 RT	Sta 270+50 RT		2440	
Sta 270+50 RT	Sta 287+95 RT	1745		
Sta 287+95 RT	Sta 300+50 RT		1255	
I.B. Sta 309+52 LT	I.B. Sta 316+65 LT		713	
I.B. Sta 313+50 RT	I.B. Sta 329+75 RT	1625		
I.B. Sta 330+00 LT	I.B. Sta 342+92 LT		1292	
I.B. Sta 348+95 RT	I.B. Sta 357+20 RT		825	
I.B. Sta 370+50 LT	I.B. Sta 373+55 LT		305	
I.B. Sta 380+00 LT	I.B. Sta 400+92 LT		2092	
OUTBOUND STATION				
O.B. Sta 208+68.95 LT	O.B. Sta 222+40 LT		1371	
Sta 246+10 LT	Sta 252+75 LT		665	
Sta 259+20 LT	Sta 269+75 LT		1055	
Sta 269+75 LT	Sta 278+02 LT	827		
Sta 291+50 LT	O.B. Sta 316+50 LT	2500		
O.B. Sta 310+00 RT	O.B. Sta 342+65 RT		3265	
O.B. Sta 347+38 LT	O.B. Sta 357+20 LT		982	
O.B. Sta 378+70 RT	O.B. Sta 399+70 RT		2100	
MEDIAN GUTTER				
Sta 190+90	I.B. Sta 215+50			2460

ITEM NO.		652. 0020	652. 0022	652. 3050
UNIT USED		L.F.	L.F.	L.F.
EDGEDRAINS				
FROM TO		6-INCH PERFORATED PIPE FOR EDGEDRAIN	6-INCH NONPERFORATED PIPE FOR EDGEDRAIN	EDGEDRAIN
INBOUND STATION				
Sta 190+90	I.B. Sta 206+00 LT	1510	45	1510
Sta 248+00 RT	Sta 270+00 RT	2200	85	2200
Sta 271+00 RT	Sta 287+00 RT	1600	48	1600
I.B. Sta 313+50 RT	I.B. Sta 329+75 RT	1625	15	1625
I.B. Sta 330+00 LT	O.B. Sta 348+50 RT	1850	40	1850
I.B. Sta 348+90 RT	I.B. Sta 355+75 RT	685	20	685
I.B. Sta 363+51 LT	I.B. Sta 366+50 LT	299		299
OUTBOUND STATION				
O.B. Sta 209+00 LT	O.B. Sta 214+98 LT	598	20	598
O.B. Sta 214+00	O.B. Sta 224+80 LT	1080		1080
Sta 246+55	Sta 262+00	1545		1545
Sta 271+00 LT	Sta 278+00 LT	700	15	700
Sta 291+50 LT	O.B. Sta 309+98±LT	1848	93	1848
O.B. Sta 321+60 RT	O.B. Sta 328+00 RT	640	5	640
O.B. Sta 347+38 LT	O.B. Sta 355+75 LT	837	5	837

ITEM NO.		652. 2000
UNIT USED		EA.
CLEANOUTS		CLEANOUTS
INBOUND STATION		
⌀ Sta 270+00 RT	1	
⌀ Sta 271+00 RT	1	
I.B. ⌀ Sta 313+50 RT	1	
I.B. ⌀ Sta 363+51 LT	1	
OUTBOUND STATION		
O.B. ⌀ Sta 214+00	1	
⌀ Sta 255+40	1	
⌀ Sta 271+00 LT	1	
⌀ Sta 291+50 LT	1	
O.B. ⌀ Sta 321+60 RT	1	
O.B. ⌀ Sta 347+38 LT	1	

ITEM NO.		616. 3910
UNIT USED		EA.
IRRIGATION SYSTEM		
Sta 191+40±		1

ITEM NO.		654. 0022	654. 3050
UNIT USED		L.F.	L.F.
TRANSVERSE DRAINS			
DRAIN TYPE		6-INCH NONPERFORATED PIPE FOR TRANSVERSE DRAIN	TRANSVERSE DRAINS
Sta 194+00	A	7	9
Sta 197+00	A	7	9
I.B. Sta 200+00 LT	A	7	9
I.B. Sta 203+00 LT	A	7	9
I.B. Sta 206+00 LT	A	7	9
I.B. Sta 209+00 LT	A	7	9
I.B. Sta 212+40 LT	B	2	18
O.B. Sta 214+98 LT	C	3	19
I.B. Sta 215+25 LT	B	2	18
O.B. Sta 218+00 LT	C	3	16
O.B. Sta 218+00 RT	D	10	18
O.B. Sta 220+50 LT	C	3	12
O.B. Sta 220+50 RT	D	6	17
O.B. Sta 223+00 RT	D	3	15
O.B. Sta 224+80 RT	D	3	12
Sta 246+55	E	2	9
Sta 248+00 LT	F	3	9
Sta 249+00 LT	F	3	9
Sta 249+00	E	2	9
Sta 252+00	E	2	9
Sta 254+25 LT	G	10	33
Sta 254+50	E	2	9
Sta 256+50 LT	G	10	33
Sta 257+00	E	2	9
Sta 259+25 LT	H	3	22
Sta 259+50	E	2	9

ITEM NO.		654. 0022	654. 3050
UNIT USED		L.F.	L.F.
TRANSVERSE DRAINS			
DRAIN TYPE		6-INCH NONPERFORATED PIPE FOR TRANSVERSE DRAIN	TRANSVERSE DRAINS
Sta 262+00 LT	F	3	21
Sta 282+50 LT	I	2	21
Sta 284+50 LT	I	2	21
Sta 286+50 LT	I	2	21
I.B. Sta 303+50 RT	J	14	21
I.B. Sta 305+50 RT	J	16	21
I.B. Sta 307+50 RT	J	15	21
O.B. Sta 322+50 LT	I	2	21
O.B. Sta 325+50 LT	I	2	17
O.B. Sta 328+50 LT	I	2	11
O.B. Sta 337+50 RT	K	3	17
O.B. Sta 340+00 RT	K	3	15
O.B. Sta 342+65 RT	K	3	13
O.B. Sta 344+95 RT	L	9	10
O.B. Sta 348+50 RT	E	2	8

08/14/92

Add Transverse Drains Schedule.

DATE

REVISION

FED. ROAD DIST. NO.	STATE	FED. AID PROJ. NO.	FISCAL YEAR	SHEET NO.	TOTAL SHEETS
HAWAII	HAW.	IR-H2-1(27)	1992	97	223

NOTES:

- Existing drainage systems will be functional at all times during construction. The Contractor is to furnish materials, equipment, labor, tools and Incidentals necessary to maintain flow. The cost for this work shall be incidental to the various Contract Items.
- The Contractor shall verify the locations of all existing culverts, underdrain and utilities in the field. Any existing culverts, underdrains and utilities damaged during construction shall be repaired or replaced by the Contractor at his expense.
- Demolishing and removing a portion or the existing structure shall not be paid for separately, but shall be considered incidental to the various Contract Items.
- Only non-pneumatic type of drill as approved by the Engineer will be permitted for drilling holes in concrete. The approximate diameter of drilled holes for installation of dowels shall be 1 1/4 inches. After installing dowels, the voids shall be filled with epoxy grout as directed by the Engineer. Above work shall be considered incidental to the drainage structure.
- Salvaged Steel Frames and Grates shall be cleaned and returned to 727 Kakaʻi St., Honolulu, Hawaii 96819.
- Salvaged C. I. Frames and Covers shall be cleaned, painted and returned to 727 Kakaʻi St., Honolulu, Hawaii 96819.
- Concrete shall be Class A unless otherwise noted.
- For added reinforcing around existing and new culverts, see Standard Plan H-04.
- Chamfer all exposed concrete edges 1".
- Existing underdrains shall be made functional by connecting it to existing or new drainage structures. The above work shall be considered incidental to the various contract items.
- Project Includes 21 existing Type 61614 Steel Frames and Grates and 29 new Type 61614 Steel Frames and Grates. Location of reinstalled existing Type 61614 Steel Frames and Grates are listed below.

REUSE SALVAGED TYPE 61614 FRAME & GRATE	
FROM	TO
I.B. ⌀ Sta. 206+00 Lt.	I.B. ⌀ Sta. 206+00 Lt.
I.B. ⌀ Sta. 209+00 Lt.	I.B. ⌀ Sta. 209+00 Lt.
I.B. ⌀ Sta. 212+40 Lt.	O.B. ⌀ Sta. 211+75 Lt.
⌀ Sta. 249+00 Rt.	⌀ Sta. 249+00 Rt.
⌀ Sta. 252+00 o/s 62' Rt.	⌀ Sta. 252+00 Rt.
⌀ Sta. 254+50 o/s 62 Rt.	⌀ Sta. 254+50 Rt.
⌀ Sta. 257+00 o/s 62' Rt.	⌀ Sta. 257+00 Rt.
⌀ Sta. 259+50 o/s 62 Rt.	⌀ Sta. 259+50 Rt.
⌀ Sta. 273+00 o/s 58' Lt.	⌀ Sta. 272+96 Lt.
⌀ Sta. 273+00 o/s 58' Rt.	⌀ Sta. 273+00 Rt.
⌀ Sta. 275+50 o/s 58' Lt.	⌀ Sta. 275+50 Lt.
⌀ Sta. 275+50 o/s 58' Rt.	⌀ Sta. 275+50 Rt.
⌀ Sta. 278+00 o/s 58' Lt.	⌀ Sta. 278+00 Lt.
⌀ Sta. 278+00 o/s 58' Rt.	⌀ Sta. 278+00 Rt.
⌀ Sta. 282+00 o/s 58' Rt.	⌀ Sta. 280+00 Rt.
⌀ Sta. 282+50 o/s 58' Rt.	⌀ Sta. 282+50 Rt.
⌀ Sta. 285+00 o/s 57' Rt.	⌀ Sta. 285+00 Rt.
O.B. ⌀ Sta. 303+00 o/s 58' Lt.	O.B. ⌀ Sta. 303+00 Lt.
O.B. ⌀ Sta. 306+50 o/s 58' Lt.	O.B. ⌀ Sta. 306+50 Lt.
O.B. ⌀ Sta. 310+00 o/s 58' ± Lt.	O.B. ⌀ Sta. 309+98± Lt.
I.B. ⌀ Sta. 329+75 Rt.	I.B. ⌀ Sta. 329+75 Rt.

- Project Includes 5 existing Type 61616 Steel Frames and Grates and 5 new Type 61616 Steel Frames and Grates. Location of reinstalled existing Type 61616 Steel Frames and Grates are listed below.

REUSE SALVAGED TYPE 61616 FRAME & GRATE	
FROM	TO
⌀ Sta. 194+00	⌀ Sta. 194+00
I.B. ⌀ Sta. 197+00 Lt.	I.B. ⌀ Sta. 197+00 Lt.
I.B. ⌀ Sta. 200+00 Lt.	I.B. ⌀ Sta. 200+00 Lt.
I.B. ⌀ Sta. 203+00 Lt.	I.B. ⌀ Sta. 203+00 Lt.
I.B. ⌀ Sta. 215+25 Lt.	I.B. ⌀ Sta. 215+25 Lt.

- Reinstall existing Type A C.I. Frame and Cover to new locations as listed below.

CONCRETE DROP INLET COVER

REUSE SALVAGED TYPE A CAST IRON FRAME & COVER	
FROM	TO
O.B. ⌀ Sta. 209+00 Lt.	⌀ Sta. 323 Rt.
O.B. ⌀ Sta. 211+75 o/s 52' Lt.	⌀ Sta. 328+00 o/s 28' Rt.
I.B. ⌀ Sta. 215+00 o/s 52' Lt.	⌀ Sta. 377+00 o/s 20' Rt.

- Lined Drained Ditches shall be sloped to drain as shown on plans or as directed by the Engineer. Contractor shall provide a smooth transition from the existing to the new gutter.
- Cut and plug existing sprinkler lines as shown on plan. Above work shall be considered incidental to the valve box.
- Disconnect control wiring of electric remote control valves at the field controller as shown on plan. Above work shall be considered incidental to the valve box.

SURVEY PLOTTED BY	DATE
DRAWN BY	
DESIGNED BY	
QUANTITIES BY	
CHECKED BY	
ORIGINAL PLAN	
NOTE BOOK	
No.	

STATE OF HAWAII
DEPARTMENT OF TRANSPORTATION
HIGHWAYS DIVISION

DRAINAGE NOTES

INTERSTATE RTE. H-2, HOV LANES, PH. II
Mililani Interchange to Waipio Interchange
F.A.I. PROJECT NO. IR-H2-1(27)


Date: Apr., 1992

SHEET No. H06 OF 42 SHEETS

FED. ROAD DIST. NO.	STATE	FED. AID PROJ. NO.	FISCAL YEAR	SHEET NO.	TOTAL SHEETS
HAWAII	HAW.	IR-H2-1(27)	1992	98	223

08/14/92	"Median Swale" changed to "Median Gutter" Transverse Drain added
DATE	REVISION

TRUE NORTH
SCALE: 1" = 40'

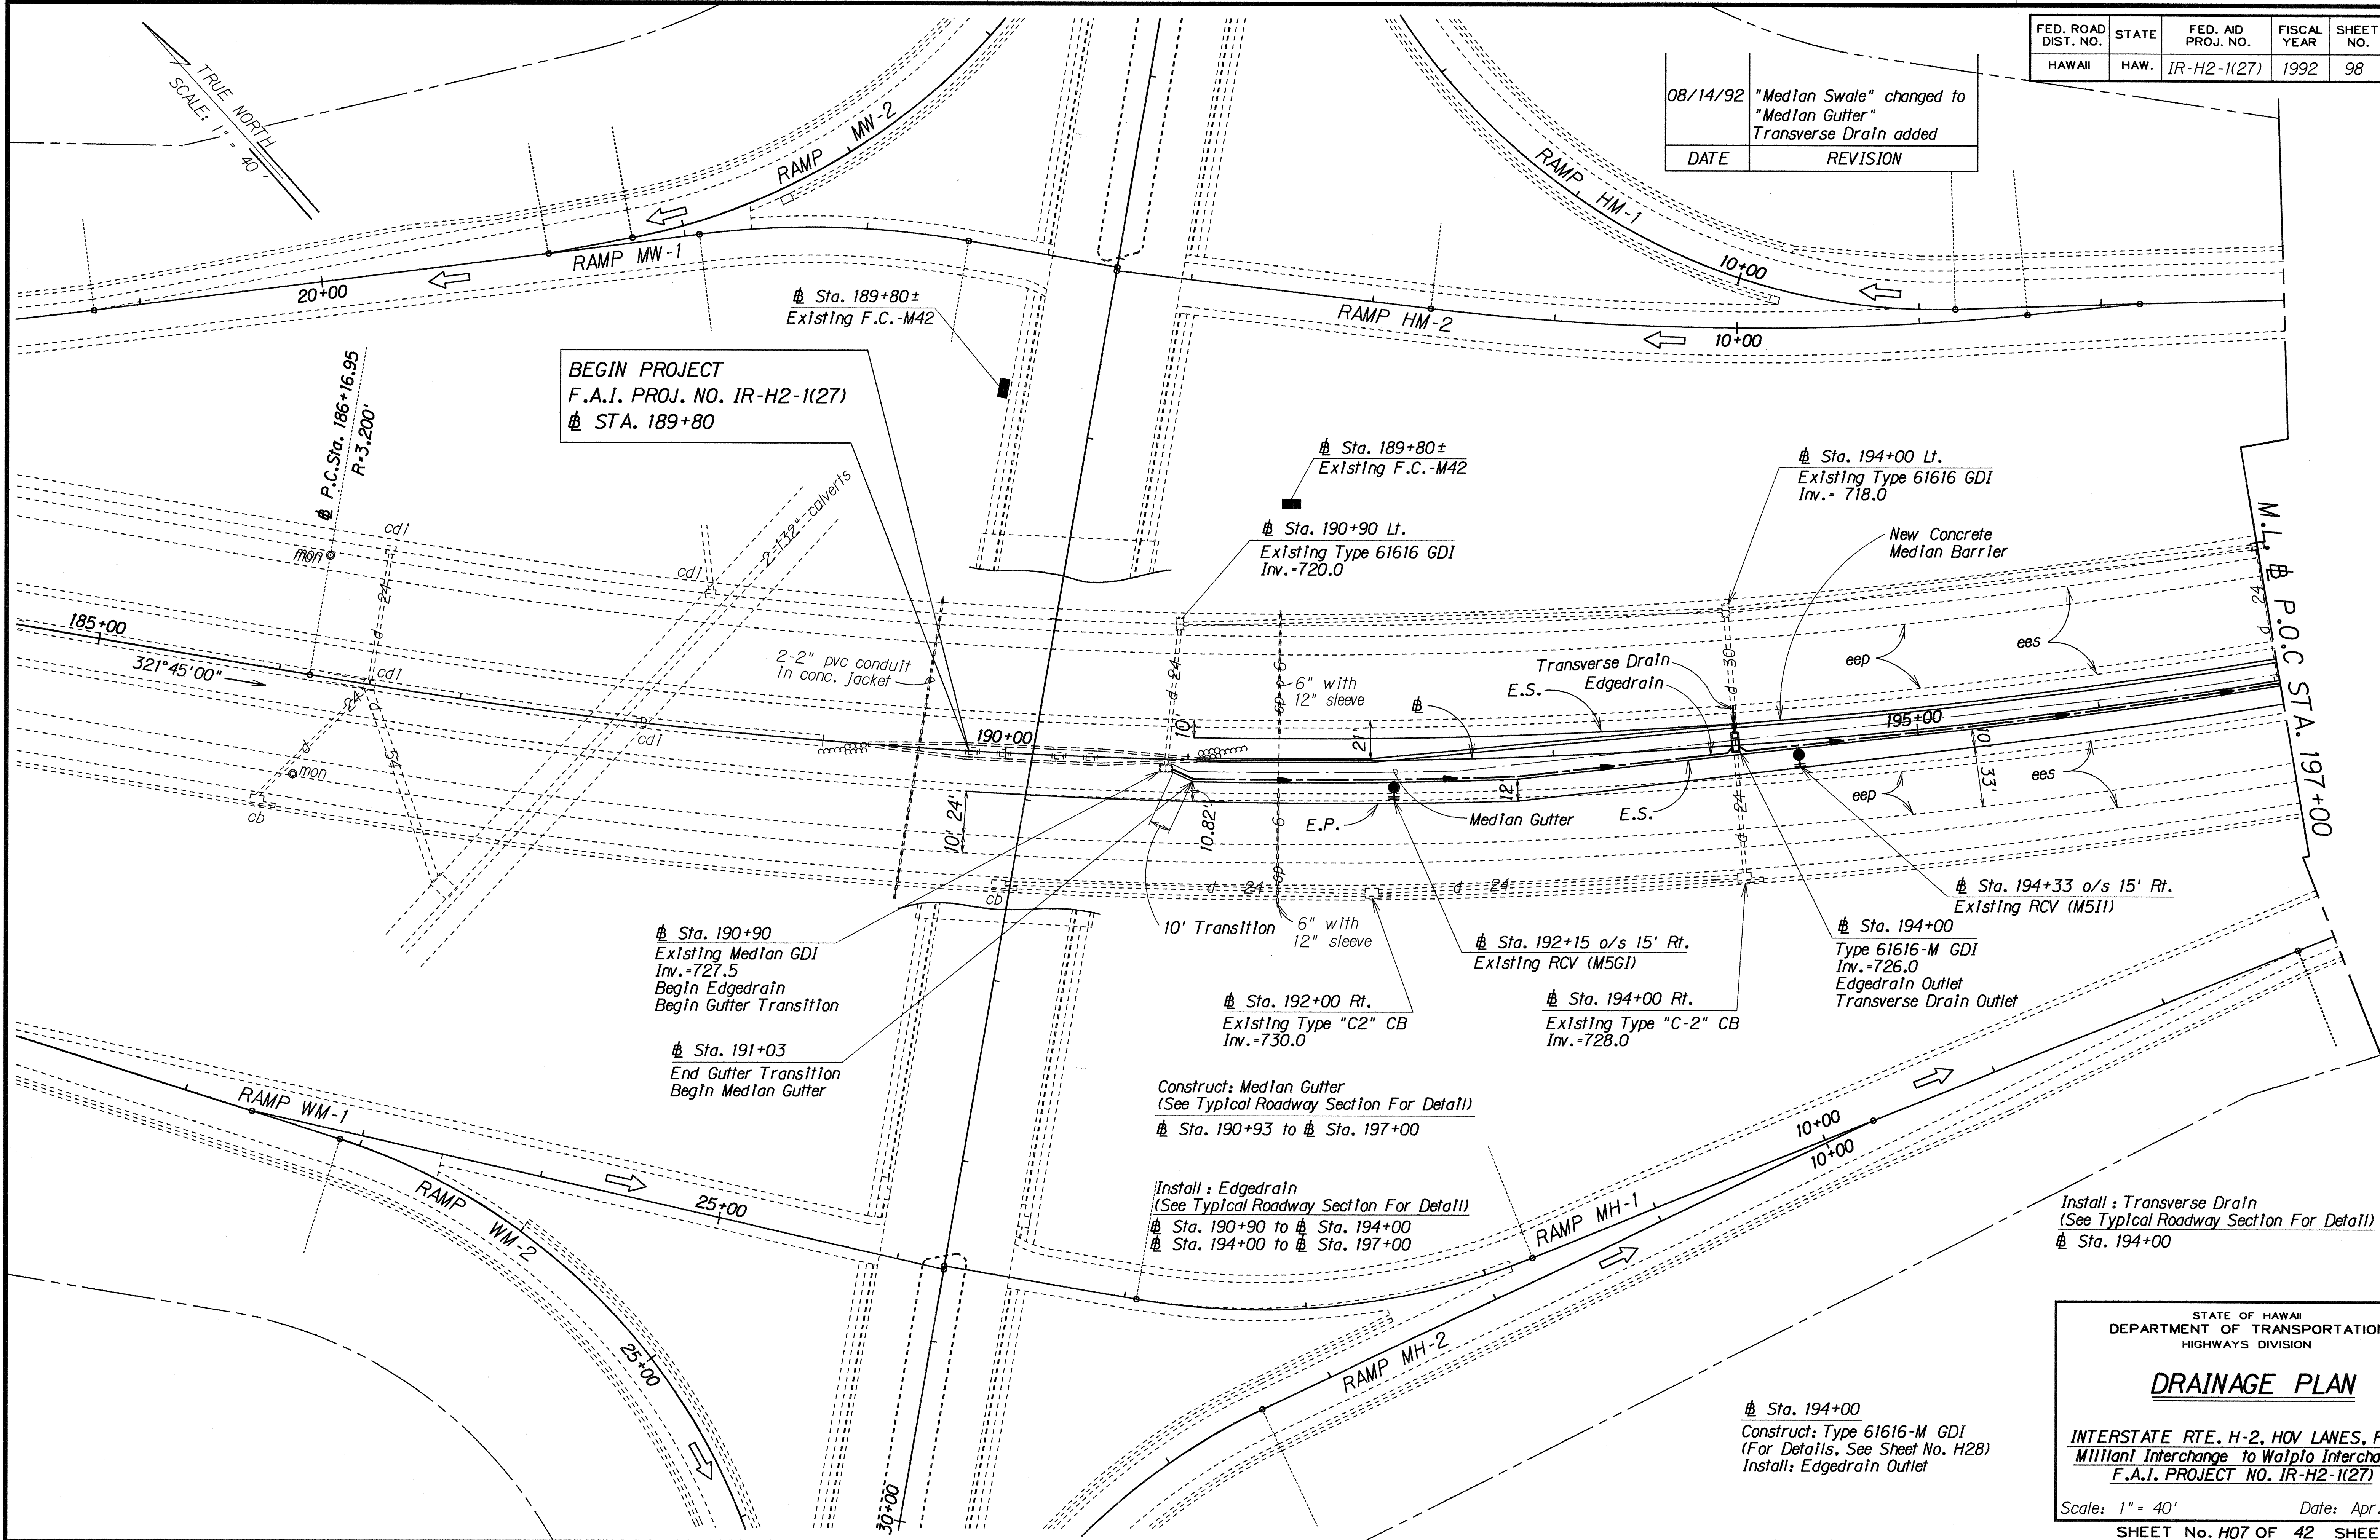

SURVEY PLOTTED BY	DATE
DESIGNED BY	
CHECKED BY	
NOTE BOOK	
QUANTITIES BY	
CHECKED BY	


STATE OF HAWAII
DEPARTMENT OF TRANSPORTATION
HIGHWAYS DIVISION

DRAINAGE PLAN

INTERSTATE RTE. H-2, HOV LANES, PH. II
Millian Interchange to Waipio Interchange
F.A.I. PROJECT NO. IR-H2-1(27)

Scale: 1" = 40' Date: Apr., 1992

SHEET No. 097 OF 42 SHEETS

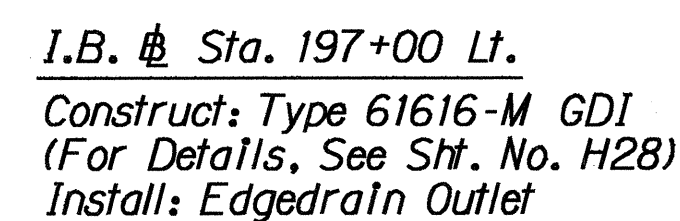

I.B. @ Sta. 200+00 Lt.
Construct: Type 61616-M GDI
(For Details, See Sht. No. H28)
Install: Edgedrain Outlet

Construct: Median Gutter
(See Typical Roadway Section For Detail)
Sta. 197+00 to I.B. Sta. 209+00 Lt.

*Install: Edgedrain
(See Typical Roadway Section For Detail)*

Construct: Gutter Type 2(61618)
(See Typical Roadway Section For Detail)

I.B. @ Sta. 203+00 Lt.
Construct: Type 61616-M GDI
(For Details, See Sht. No. H28)
Install: Edgedrain Outlet

*Install: Transverse Drain
(See Typical Roadway Section For Detail)*

♠ Sta. 197+00
I.B. ♠ Sta. 200+00 Lt.
I.B. ♠ Sta. 203+00 Lt.
I.B. ♠ Sta. 206+00 Lt.
I.B. ♠ Sta. 209+00 Lt.

I.B. Sta. 206+00 Lt.
Construct: Type 61614-M GDI
(For Details, See Sht. No. H25)
Install: Edgedrain Outlet

I.B. @ Sta. 209+00 Lt.
Construct: Type 6164-M GDI
(For Details, See Sht. No. H25)

DRAINAGE PLAN

INTERSTATE RTE. H-2, HOV LANES, PH. II
Mililani Interchange to Waipio Interchange
F.A.I. PROJECT NO. IR-H2-1(27)

Scale: 1" = 40' Date: Apr., 1992

SHEET No. *H08* OF *42* SHEETS

ADD. 99

```
/usr2/lennox/1ih2h08.dgn
```

ORIGINAL PLAN	SURVEY PLOTTED BY _____ DATE _____
NOTE BOOK	DRAWN BY _____ *
	TRACED BY _____ *
	DESIGNED BY _____ *
	QUANTITIES BY _____ *
N _o _____	CHECKED BY _____

08/14/92	"Median Swale" changed to "Median Gutter" Transverse Drains added Edgedrain removed
DATE	REVISION

FED. ROAD DIST. NO.	STATE	FED. AID PROJ. NO.	FISCAL YEAR	SHEET NO.	TOTAL SHEETS
HAWAII	HAW.	IR-H2-1(27)	1992	100	223

Install: Edgedrain
(See Typical Roadway Section For Detail)

O.B. Sta. 209+00 Lt. to O.B. Sta. 211+75 Lt.
O.B. Sta. 211+75 Lt. to O.B. Sta. 214+98 Lt.
O.B. Sta. 214+00 to O.B. Sta. 218+00 Rt.
O.B. Sta. 218+00 to O.B. Sta. 220+50 Rt.
O.B. Sta. 220+50 Rt. to O.B. Sta. 221+00 Rt.

O.B. Sta. 209+00 Lt.
Construct: Type 61614-N GDI
(For Details, See Plan Sheet No. H26)

Construct: Gutter Type 2(61618)
(See Typical Roadway Section For Detail)

O.B. Sta. 209+00 Lt. to O.B. Sta. 221+00 Lt.

O.B. Sta. 211+75 Lt.
Construct: Type 61614 GDI
Install: 36" CSP, Sht. "I" = 0.109"
Edgedrain Outlet


O.B. Sta. 211+75 o/s 52' Lt.
Construct: Type "Y" SDMH
(For Details, See Sht. No. H32)

O.B. Sta. 214+98 Lt.
Construct: Type 61614 GDI
Install: 24" CSP, Sht. "I" = 0.109"
Edgedrain Outlet
O.B. Sta. 214+00
Install: Cleanout
(For Details, See Sht. No. H37)

O.B. Sta. 218+00 Lt.
Construct: Type 61614 GDI
Install: 24" CSP, Sht. "I" = 0.109"
O.B. Sta. 220+50 Lt.
Construct: Type 61614 GDI
Install: 24" CSP, Sht. "I" = 0.109"

Install: Transverse Drain
(See Typical Roadway Section For Detail)

I.B. Sta. 212+40 Lt. O.B. Sta. 218+00 Rt.
O.B. Sta. 214+98 Lt. O.B. Sta. 220+50 Lt.
I.B. Sta. 215+25 Lt. O.B. Sta. 220+50 Rt.
O.B. Sta. 218+00 Lt.

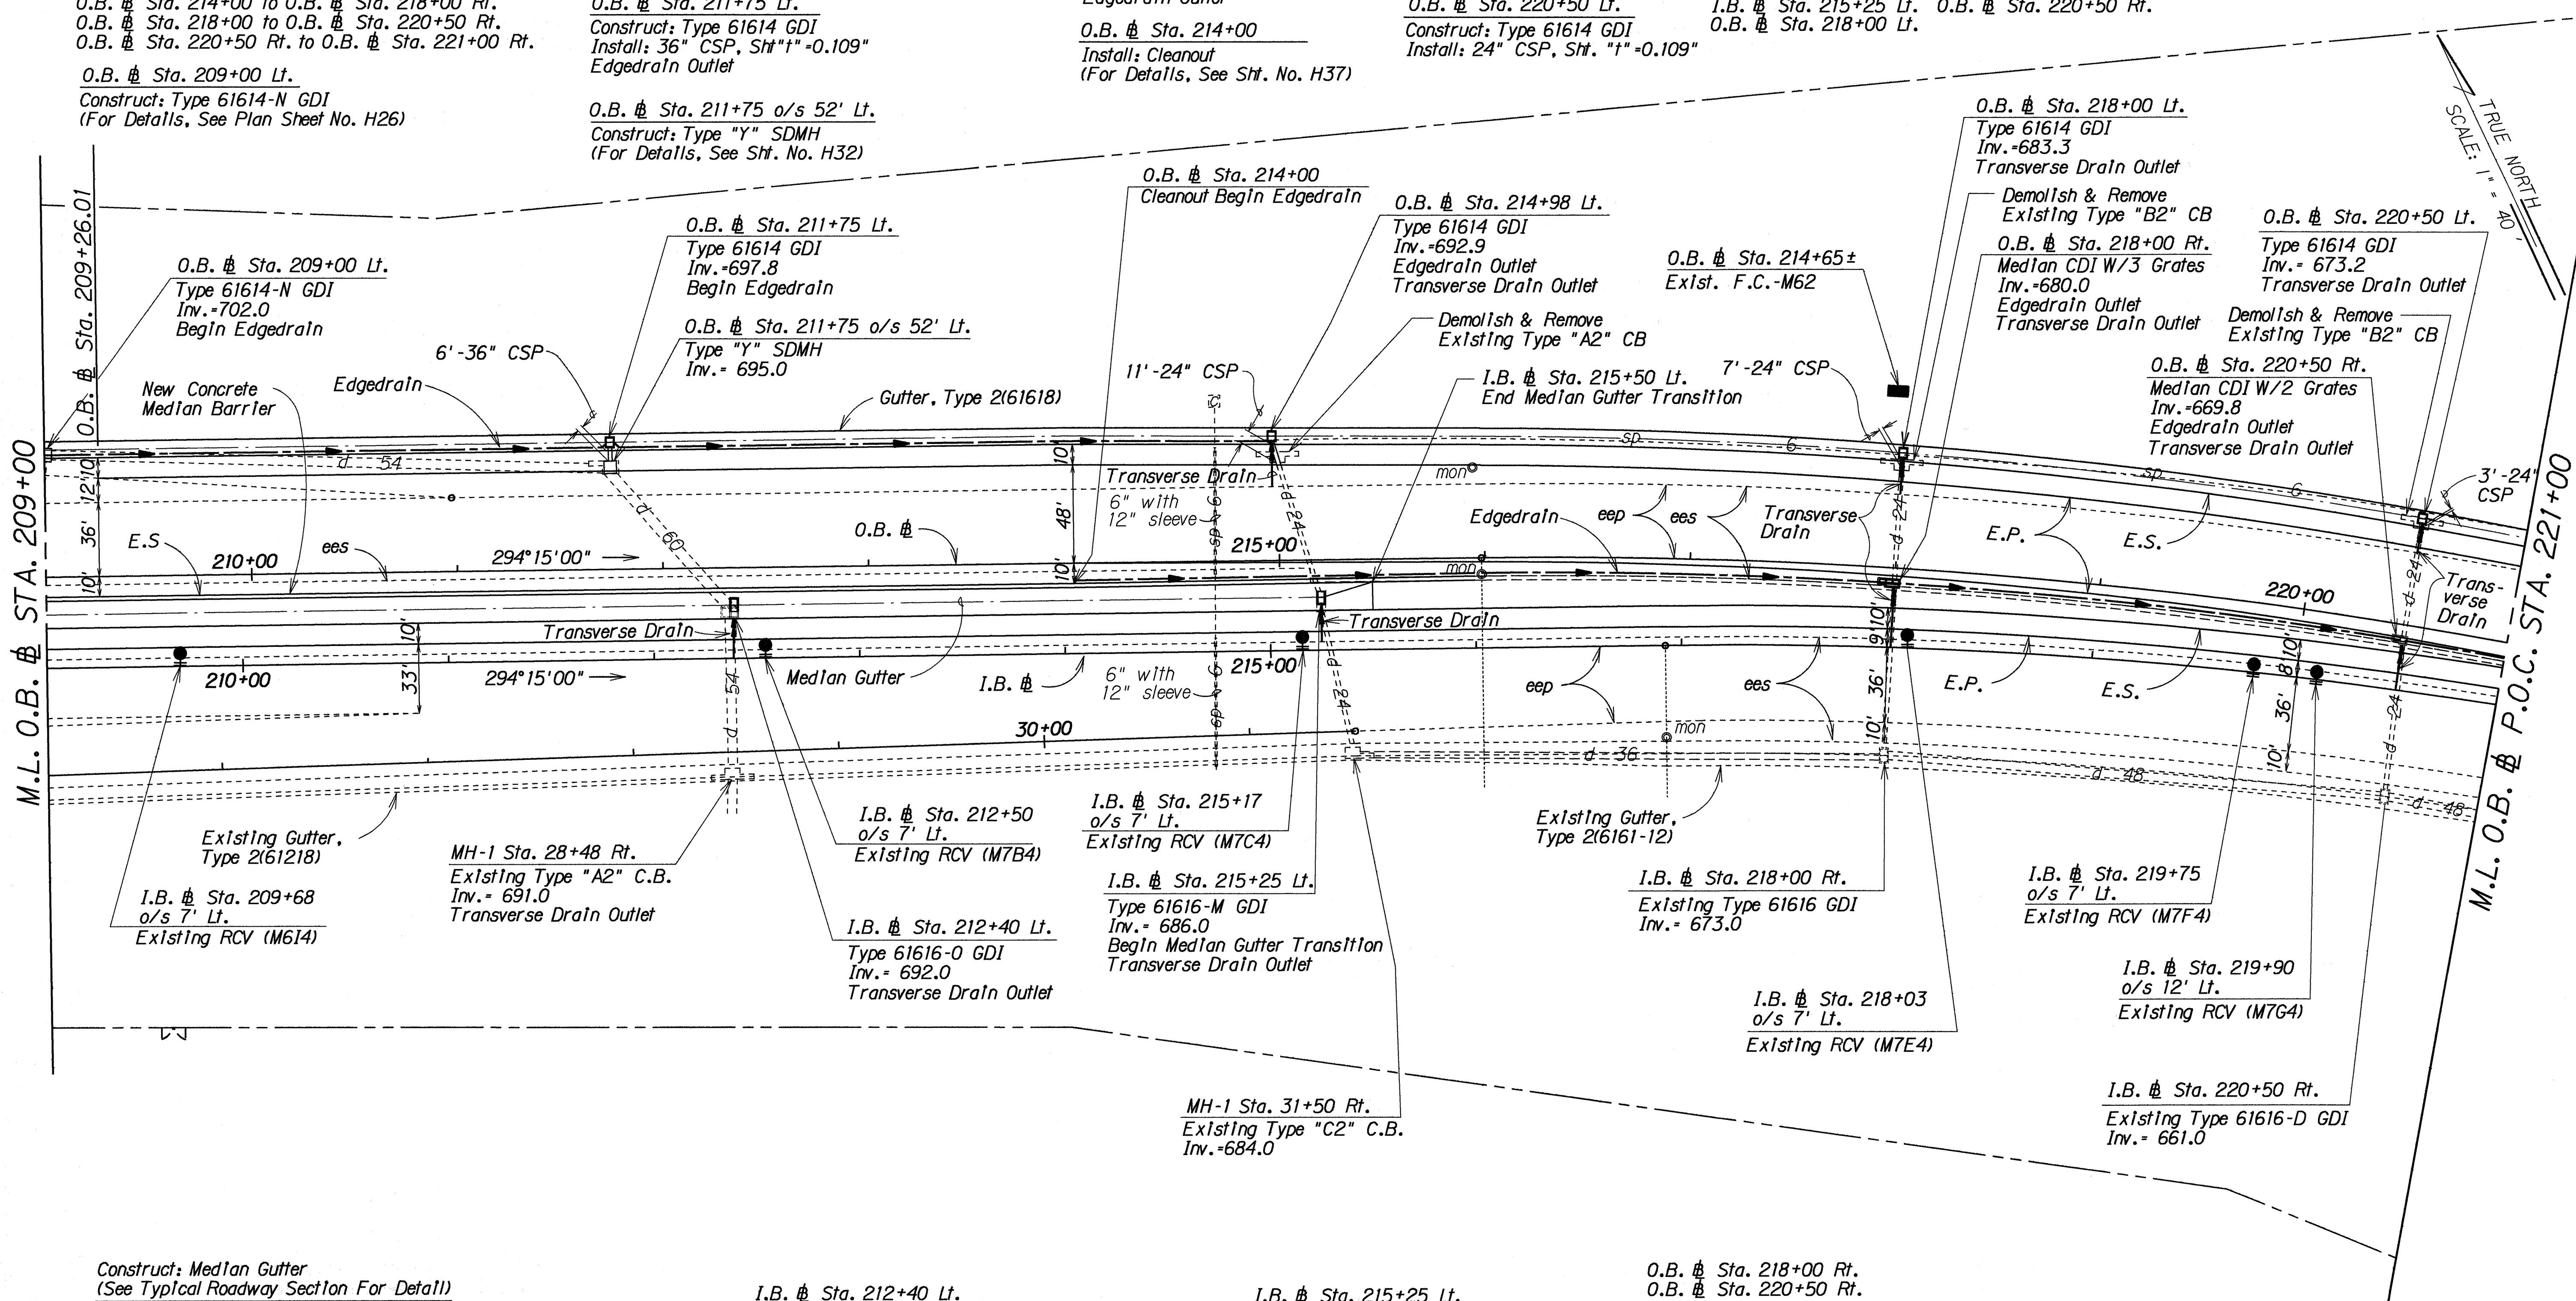

Construct: Median Gutter
(See Typical Roadway Section For Detail)

I.B. Sta. 209+00 Lt. to I.B. Sta. 215+50 Lt.

I.B. Sta. 212+40 Lt.
Construct: Type 61616-0 GDI
(For Details, See Sht. No. H29 & H30)

I.B. Sta. 215+25 Lt.
Construct: Type 61616-M GDI
(For Details, See Sht. No. H28)

O.B. Sta. 218+00 Rt.
O.B. Sta. 220+50 Rt.
Construct: Modify Existing Type A-12 Frame & Grates
(For Details, See Sht. No. H39)
Install: Edgedrain Outlet

SURVEY PLOTTED BY	DATE
DRAWN BY	
DESIGNED BY	
NOTED BY	
CHECKED BY	

08/14/92	"Median Swale" changed to "Median Gutter" Transverse Drains added
DATE	REVISION

STATE OF HAWAII
DEPARTMENT OF TRANSPORTATION
HIGHWAYS DIVISION

DRAINAGE PLAN


INTERSTATE RTE. H-2, HOV LANES, PH. II
Miliiani Interchange to Waipio Interchange
F.A.I. PROJECT NO. IR-H2-1(27)

Scale: 1" = 40' Date: Apr., 1992

SHEET NO. H09 OF 42 SHEETS

ADD. 100

FED. ROAD DIST. NO.	STATE	FED. AID PROJ. NO.	FISCAL YEAR	SHEET NO.	TOTAL SHEETS
HAWAII	HAW.	IR-H2-1(27)	1992	101	223

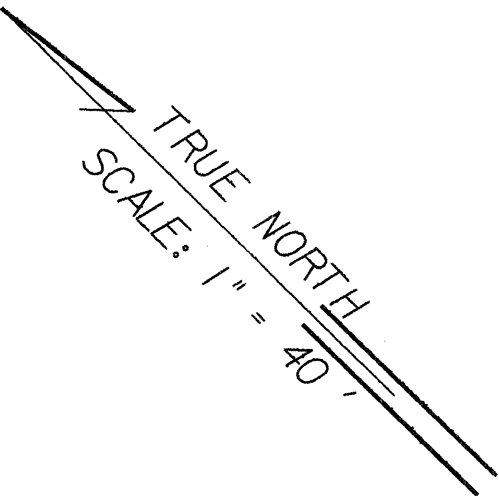

Install: Edgedrain
(See Typical Roadway Section For Detail)

O.B. Sta. 221+00 Rt. to O.B. Sta. 223+00 Rt.
O.B. Sta. 223+00 Rt. to O.B. Sta. 224+80 Rt.

Construct: Gutter, Type 2(61618)
(See Typical Roadway Section For Detail)

O.B. Sta. 221+00 Lt. to O.B. Sta. 222+40 Lt.

O.B. Sta. 223+00 Rt.
O.B. Sta. 224+80 Rt.

Construct: Modify Existing Type A-12 Frame & Grates
(For Details, See Sht. No. H39)
Install: Edgedrain Outlet

Install: Transverse Drain
(See Typical Roadway Section For Detail)

O.B. Sta. 223+00 Rt.
O.B. Sta. 224+00 Rt.

O.B. Sta. 224+80 Lt.
Existing Type "A-1" SDMH
Inv. = 652.0

O.B. Sta. 224+80 Rt.
Existing Median GDI W/3 Grates
Inv. = 646.0
Edgedrain Outlet
Transverse Drain Outlet

O.B. Sta. 222+40 Lt.
End Gutter Transition
Provide Smooth Connection
To Existing Gutter

O.B. Sta. 223+00 Lt.
Existing Type A2 C.B.
Inv. = 662.0

O.B. Sta. 223+00 Rt.
Existing Median CDI W/2 Grates
Inv. = 657.0
Edgedrain Outlet
Transverse Drain Outlet

O.B. Sta. 226+06.39 (Bk.) = (A.)
O.B. Sta. 227+20.37 (A.)

I.B. Sta. 224+75 Rt.
Existing Type "A" Shoulder D.I.
Inv. = 640.0

I.B. Sta. 223+00 Rt.
Existing Type 61616-D CDI
Inv. = 650.0

M.L. O.B. Sta. 221+00
P.O.C. STA. 221+00

M.L. Sta. 234+00

KIPAPA STREAM BRIDGE

315°23'00"

ORIGINAL PLAN	DATE
DESIGNED BY	
NOTED BY	
CHECKED BY	

08/14/92	Transverse Drains added
DATE	REVISION

STATE OF HAWAII
DEPARTMENT OF TRANSPORTATION
HIGHWAYS DIVISION

DRAINAGE PLAN

INTERSTATE RTE. H-2, HOV LANES, PH. II
Miliiani Interchange to Waipio Interchange
F.A.I. PROJECT NO. IR-H2-1(27)

Scale: 1" = 40' Date: Apr., 1992

SHEET No. 110 OF 42 SHEETS

FED. ROAD DIST. NO.	STATE	FED. AID PROJ. NO.	FISCAL YEAR	SHEET NO.	TOTAL SHEETS
HAWAII	HAW.	IR-H2-1(27)	1992	102	223

Sta. 246+55

*Construct: Modify Existing Type A-12 Frame & Grate
(For Details, See Sht. No. H39)
Install: Edgedrain Outlet*

Sta. 246+55 o/s 76' Lt.
Existing Type "A" GDI
Inv.=635.0

Sta. 246+55 Lt.
Existing Type "C" GDI
Inv.=634.0

Sta. 246+10 Lt.
Begin Gutter Transition

Sta. 246+55
Existing Median GDI W/1 Grate
Inv.=629
Edgedrain Outlet
Transverse Drain Outlet

$\text{Sta. } 244 + 91.75 \text{ (Bk.)} = \text{Eq.}$
 $\text{Sta. } 245 + 49.65 \text{ (Ah.)}$

M.L. ~~B~~ STA. 234+00

235+00

 $315^{\circ}23'00'' \longrightarrow$

240+00

KIPAPA STREAM BRIDGE

E.P.

E.P.

Sta. 246+10 Rt.
Begin Gutter Transition

Sta. 246+55 Rt.
Existing Type "C" GDI
Inv.=624.0

Sta. 246+55 o/s 78' Rt.
Existing Type "F" MH
Inv.=623.0

Construct: Gutter, Type 2(61618)
(See Typical Roadway Section For Detail)

Install: Edgedrain
(See Typical Roadway Section For Detail)
± Sta. 246+55 to ± Sta. 247+00

*Install: Transverse Drain
(See Typical Roadway Section For Detail)*
Sta. 246+55

08/14/92	Transverse Drain added
DATE	REVISION

STATE OF HAWAII
DEPARTMENT OF TRANSPORTATION
HIGHWAYS DIVISION

DRAINAGE PLAN

INTERSTATE RTE. H-2, HOV LANES, PH. II
Miliatani Interchange to Waipio Interchange
F.A.I. PROJECT NO. IR-H2-11(27)

Scale: 1" = 40' Date: Apr., 1992

SHEET No. 111 OF 42 SHEETS


ADD. 102

```
/usr2/lennox/11h2h11.dgn
```

ORIGINAL PLAN	SURVEY PLOTTED BY _____ DATE _____
NOTE BOOK	DRAWN BY _____
	TRACED BY _____
	DESIGNED BY _____
	QUANTITIES BY _____
N.	CHECKED BY _____

FED. ROAD DIST. NO.	STATE	FED. AID PROJ. NO.	FISCAL YEAR	SHEET NO.	TOTAL SHEETS
HAWAII	HAW.	IR-H2-1(27)	1992	103	223

TRUE NORTH
SCALE: 1" = 40'

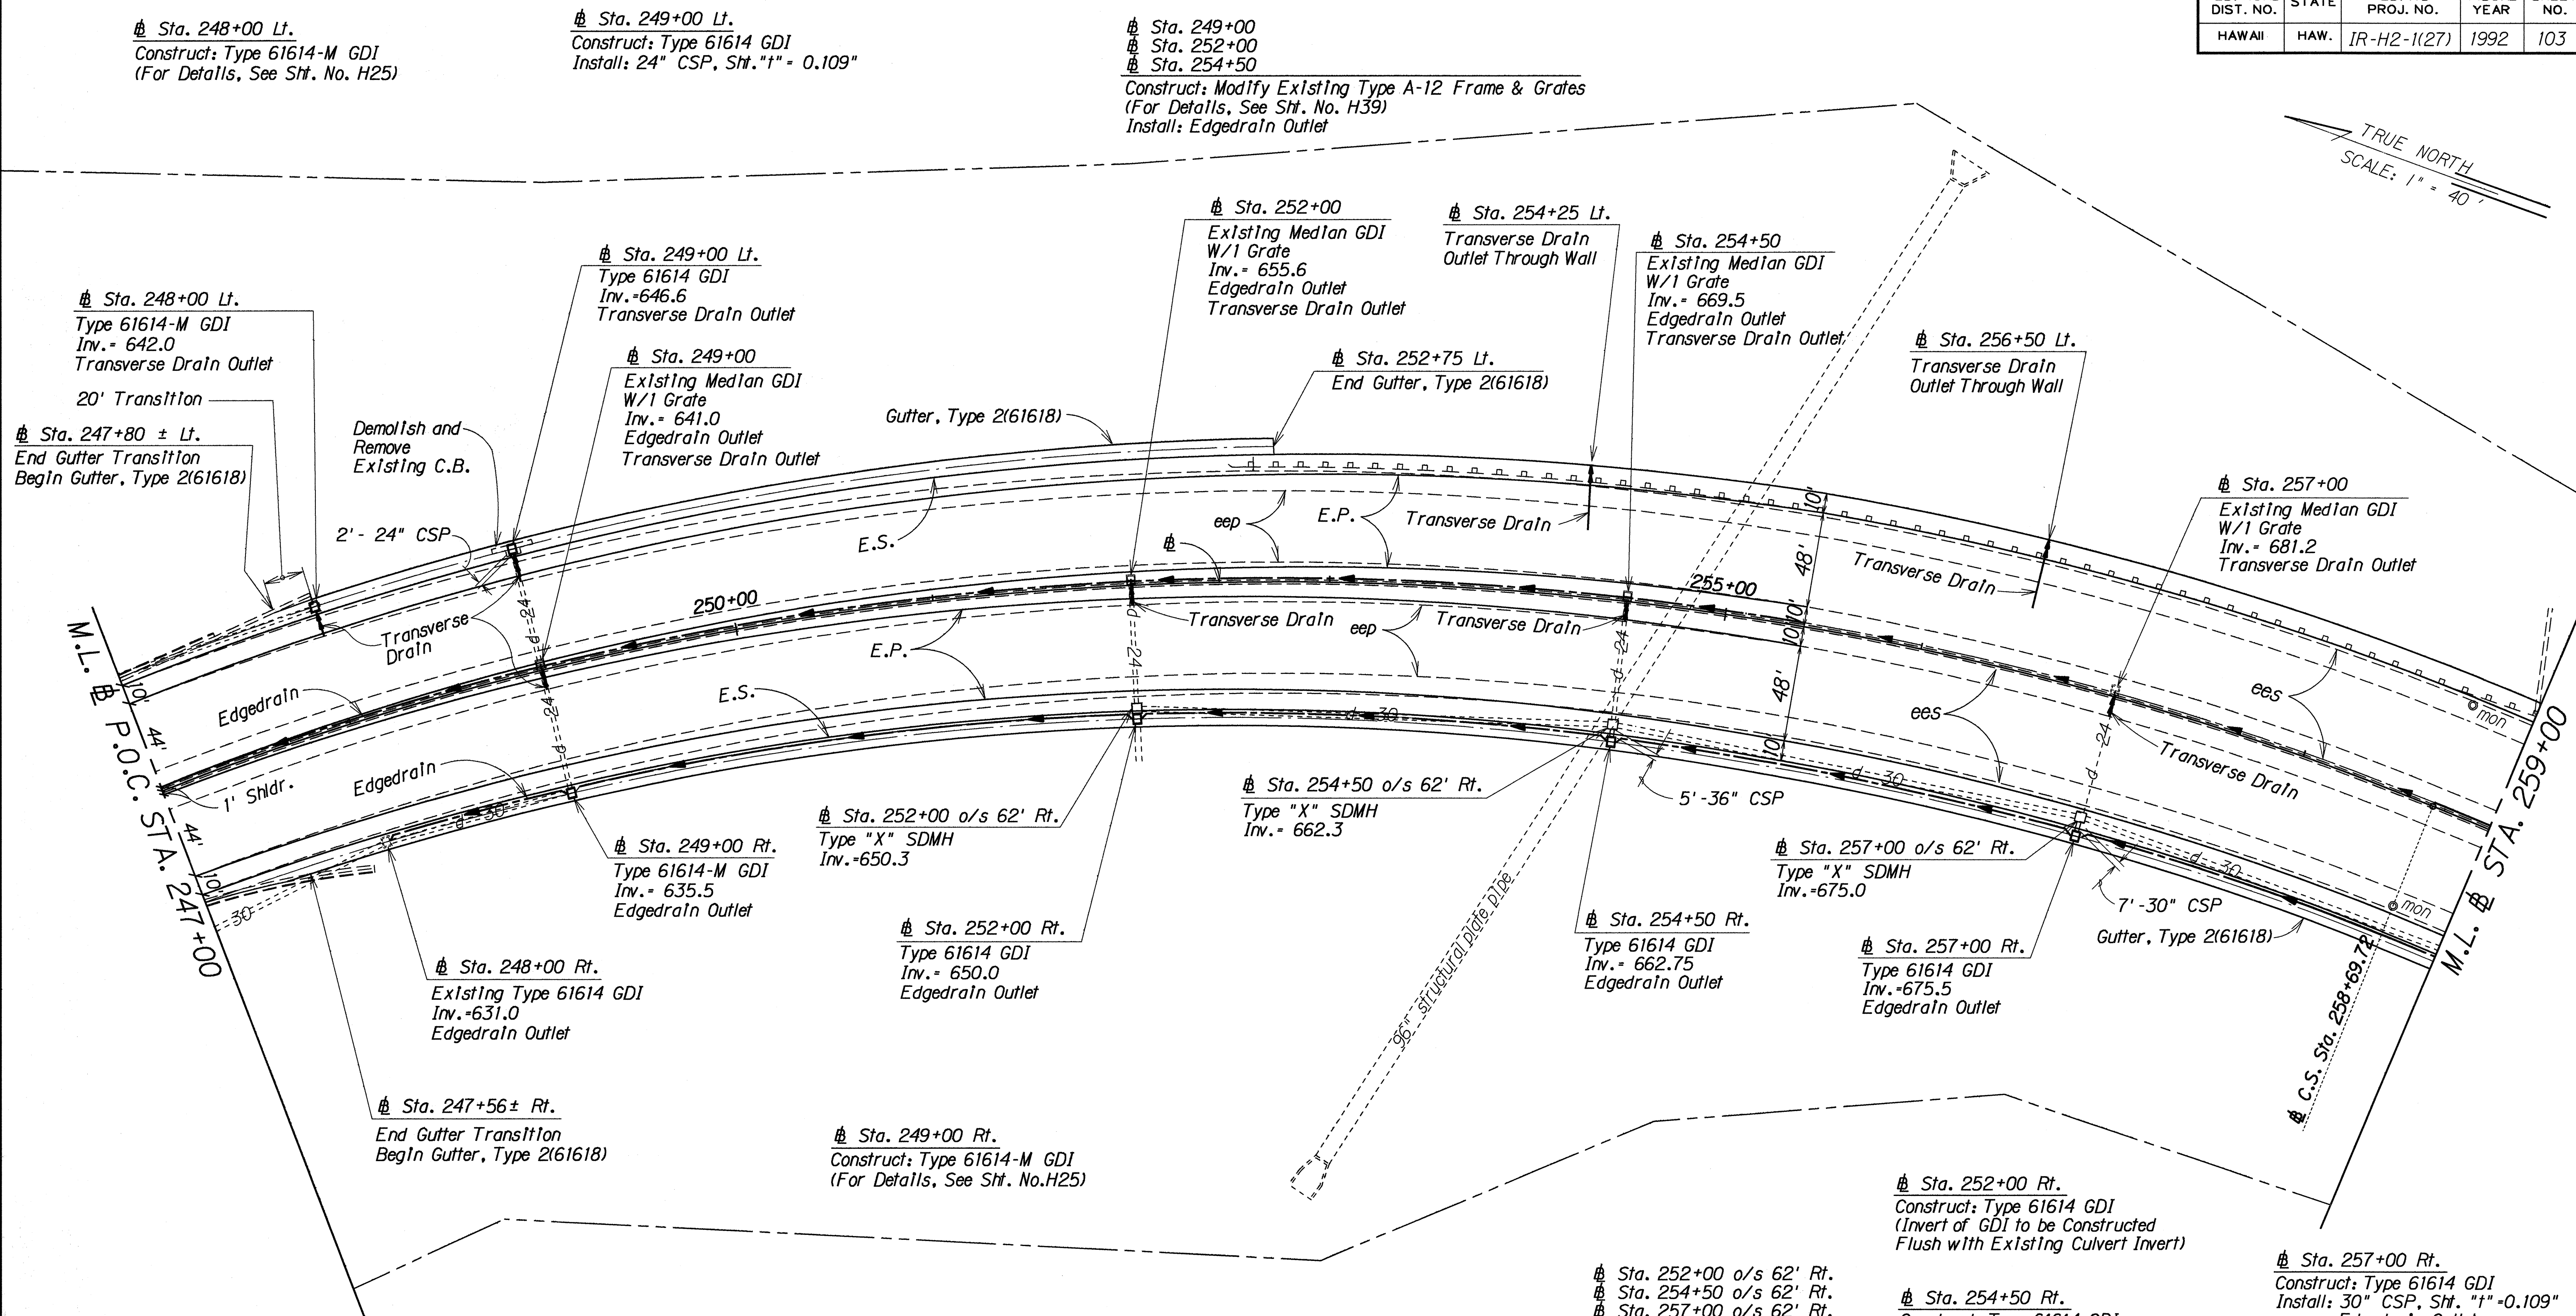

SURVEY PLOTTED BY	DATE
DESIGNED BY	
TRACED BY	
NOTES BOOK	
DESIGNED BY	
QUANTITIES BY	
CHECKED BY	

Construct: Gutter, Type 2(61618)
(See Typical Roadway Section For Detail)
Sta. 247+00 Lt. to Sta. 252+75 Lt.
Sta. 247+00 Rt. to Sta. 259+00 Rt.

Install: Edgedrain
(See Typical Roadway Section For Detail)
Sta. 248+00 Rt. to Sta. 249+00 Rt.
Sta. 249+00 Rt. to Sta. 252+00 Rt.
Sta. 252+00 Rt. to Sta. 254+50 Rt.
Sta. 254+50 Rt. to Sta. 257+00 Rt.
Sta. 257+00 Rt. to Sta. 259+00 Rt.
Sta. 247+00 to Sta. 249+00
Sta. 249+00 to Sta. 252+00
Sta. 252+00 to Sta. 254+50
Sta. 254+50 to Sta. 257+00
Sta. 257+00 to Sta. 259+00

Install: Transverse Drain
(See Typical Roadway Section For Detail)
Sta. 248+00 Lt.
Sta. 249+00 Lt.
Sta. 249+00
Sta. 252+00
Sta. 254+25 Lt.
Sta. 254+50
Sta. 256+50 Lt.
Sta. 257+00

Sta. 252+00 o/s 62' Rt.
Sta. 254+50 o/s 62' Rt.
Sta. 257+00 o/s 62' Rt.
Construct: Type "X" SDMH
(For Details, See Sht. No. H31)

Sta. 252+00 Rt.
Construct: Type 61614 GDI
(Invert of GDI to be Constructed
Flush with Existing Culvert Invert)

Sta. 254+50 Rt.
Construct: Type 61614 GDI
Install: 36" CSP, Sht. "I" = 0.109"
Edgedrain Outlet

Sta. 257+00 Rt.
Construct: Type 61614 GDI
Install: 30" CSP, Sht. "I" = 0.109"
Edgedrain Outlet

01/19/93	Pipe size changed.
08/14/92	Edgedrain Extended Edgedrain Cleanout removed Transverse Drains added
DATE	REVISION

STATE OF HAWAII
DEPARTMENT OF TRANSPORTATION
HIGHWAYS DIVISION

DRAINAGE PLAN

INTERSTATE RTE. H-2, HOV LANES, PH. II
Miliuni Interchange to Waipio Interchange
F.A.I. PROJECT NO. IR-H2-1(27)

Scale: 1" = 40' Date: Apr., 1992

SHEET No. H12 OF 42 SHEETS

FED. ROAD DIST. NO.	STATE	FED. AID PROJ. NO.	FISCAL YEAR	SHEET NO.	TOTAL SHEETS
HAWAII	HAW.	IR-H2-1(27)	1992	104	223


TRUE NORTH
SCALE: 1" = 40'

Construct: Gutter, Type 2(61618)
(See Typical Roadway Section For Detail)
Sta. 259+20 Lt. to Sta. 269+75 Lt.
Sta. 259+00 Rt. to Sta. 270+50 Rt.
Sta. 259+10 o/s 96' Lt.
Construct: Std. Concrete Headwall
Sta. 259+25 Lt.
Construct: Type 61616 GDI
Install: 24" CSP, Sht. "t"=0.109"

Construct: Gutter, Type 2(61616)
(See Typical Roadway Section For Detail)
Sta. 269+75 Lt. to Sta. 271+00 Lt.
Sta. 270+50 Rt. to Sta. 271+00 Rt.
Sta. 262+00 Lt.
Construct: Type 61614 GDI
Install: 24" CSP, Sht. "t"=0.109"

Sta. 262+00
Install: Cleanout
(For Details, See Sht. No. H37)

Install: Edgedrain
(See Typical Roadway Section For Detail)
Sta. 259+00 Rt. to Sta. 259+50 Rt.
Sta. 259+50 Rt. to Sta. 262+00 Rt.
Sta. 262+00 Rt. to Sta. 264+50 Rt.
Sta. 264+50 Rt. to Sta. 267+00 Rt.
Sta. 267+00 Rt. to Sta. 270+00 Rt.
Sta. 259+00 to Sta. 259+50
Sta. 259+50 to Sta. 262+00

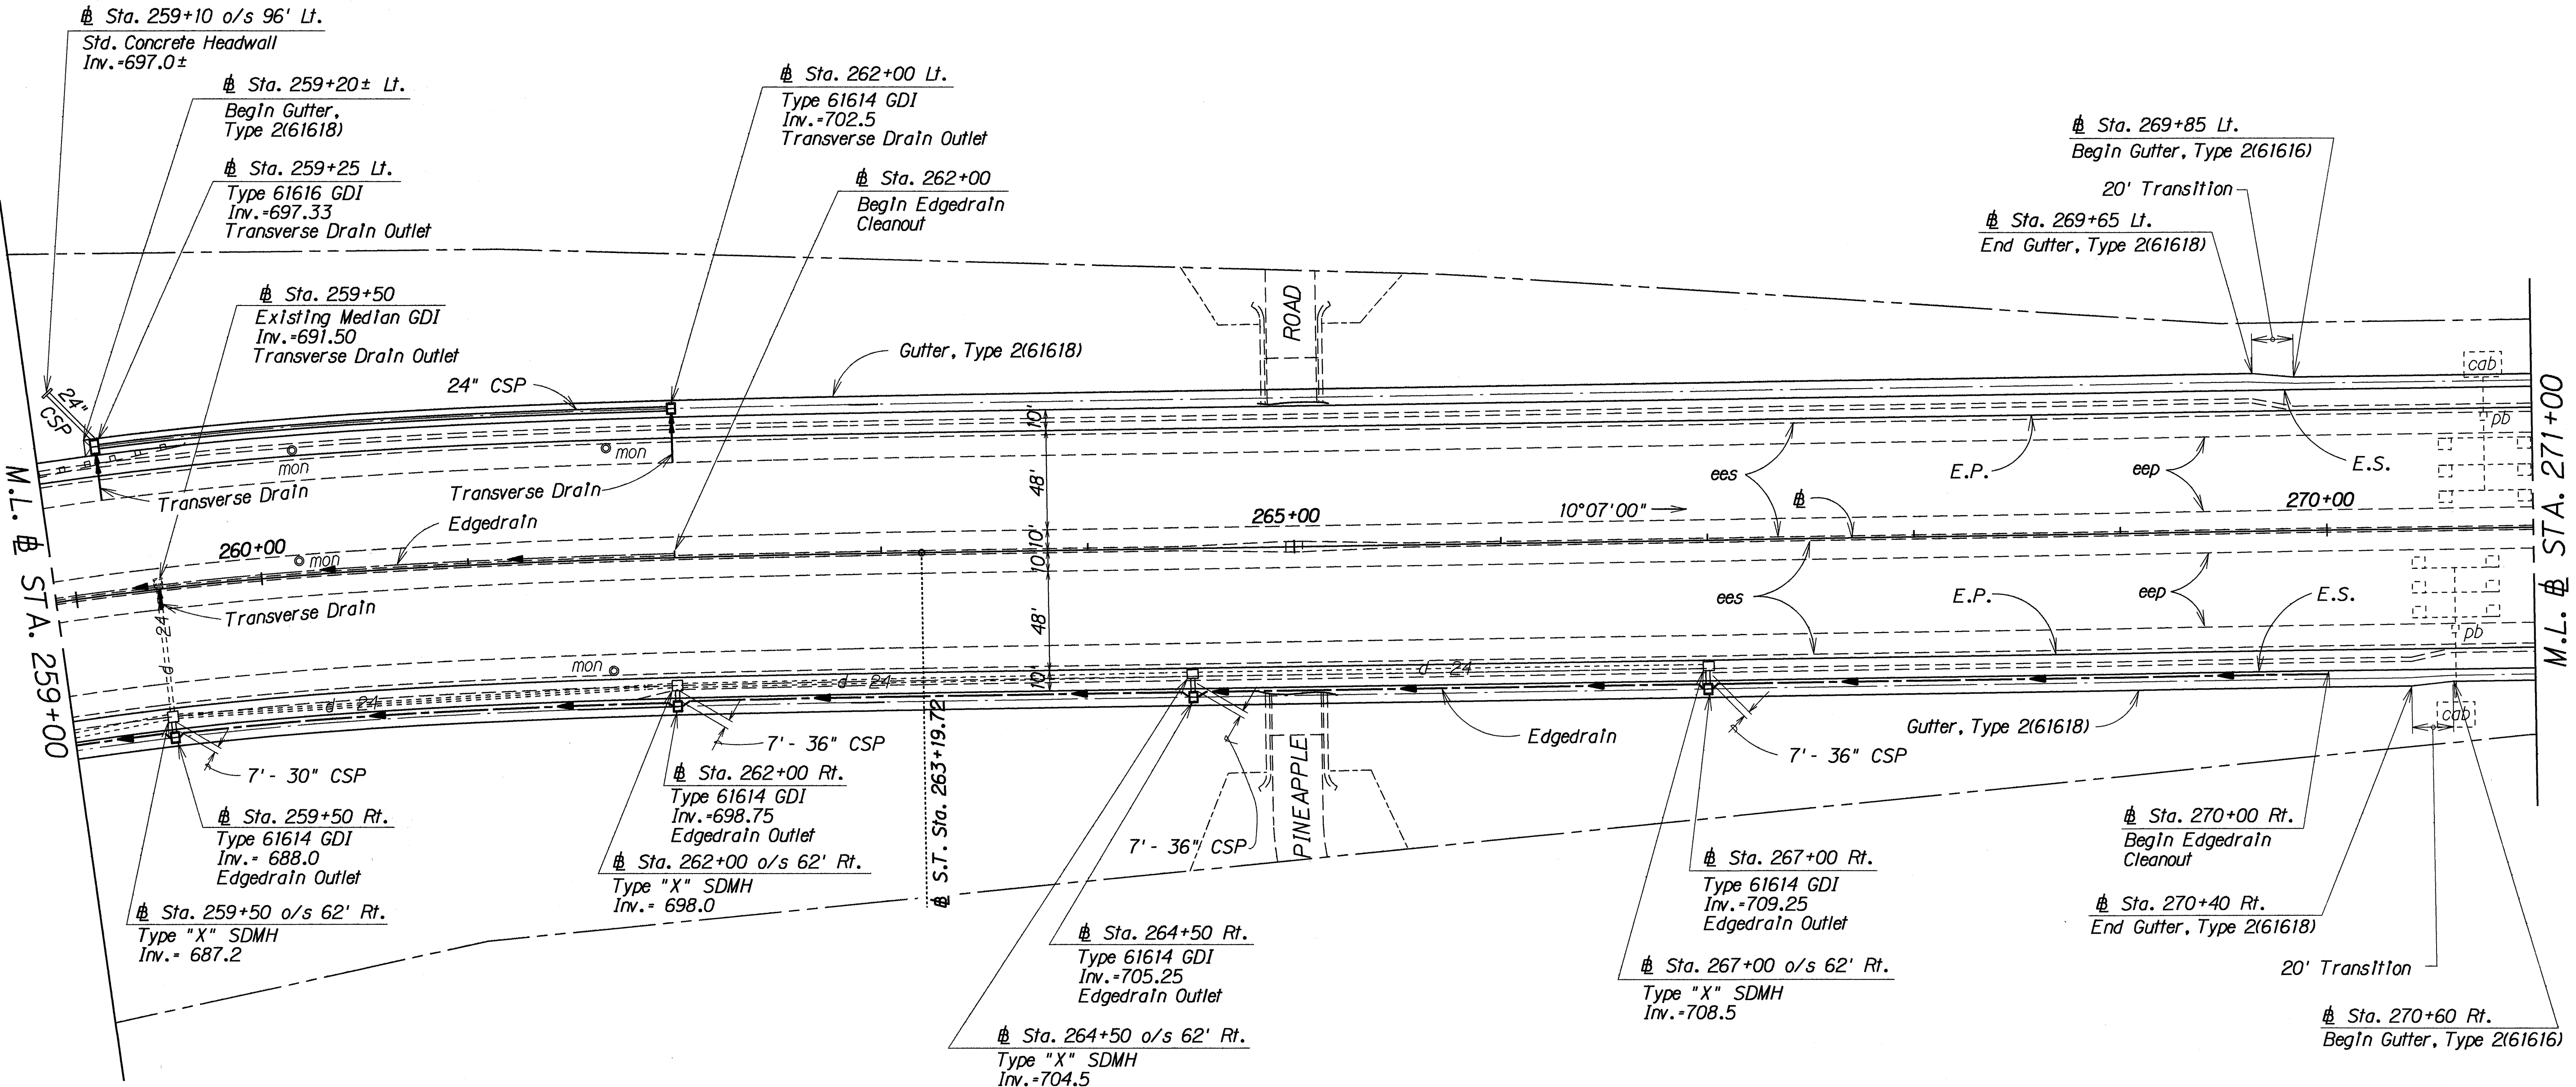

Sta. 259+50 o/s 62' Rt.
Sta. 262+00 o/s 62' Rt.
Sta. 264+50 o/s 62' Rt.
Sta. 267+00 o/s 62' Rt.
Construct: Type "X" SDMH
(For Details, See Sht. No. H31)

Install: Transverse Drain
(See Typical Roadway Section For Detail)
Sta. 259+25 Lt.
Sta. 259+50
Sta. 262+00 Lt.

Sta. 262+00 Rt.
Sta. 264+50 Rt.
Sta. 267+00 Rt.
Construct: Type 61614 GDI
Install: 36" CSP, Sht. "t"=0.109"
Edgedrain Outlet

Sta. 259+50 Rt.
Construct: Type 61614 GDI
Install: 30" CSP, Sht. "t"=0.109"
Edgedrain Outlet

Sta. 270+00 Rt.
Install: Cleanout
(For Details, See Sht. No. H37)

DATE	REVISION
01/19/93	Pipe size changed.
08/14/92	Edgedrain extended Edgedrain Cleanout added Transverse Drains added

STATE OF HAWAII
DEPARTMENT OF TRANSPORTATION
HIGHWAYS DIVISION

DRAINAGE PLAN

INTERSTATE RTE. H-2, HOV LANES, PH. II
Million Interchange to Waipio Interchange
F.A.I. PROJECT NO. IR-H2-1(27)


Scale: 1" = 40' Date: Apr., 1992

SHEET No. H13 OF 42 SHEETS

FED. ROAD DIST. NO.	STATE	FED. AID PROJ. NO.	FISCAL YEAR	SHEET NO.	TOTAL SHEETS
HAWAII	HAW.	IR-H2-1(27)	1992	105	223

Install: Transverse Drain
(See Typical Roadway Section For Detail)
Sta. 282+50 Lt.

TRUE NORTH
SCALE: 1" = 40'

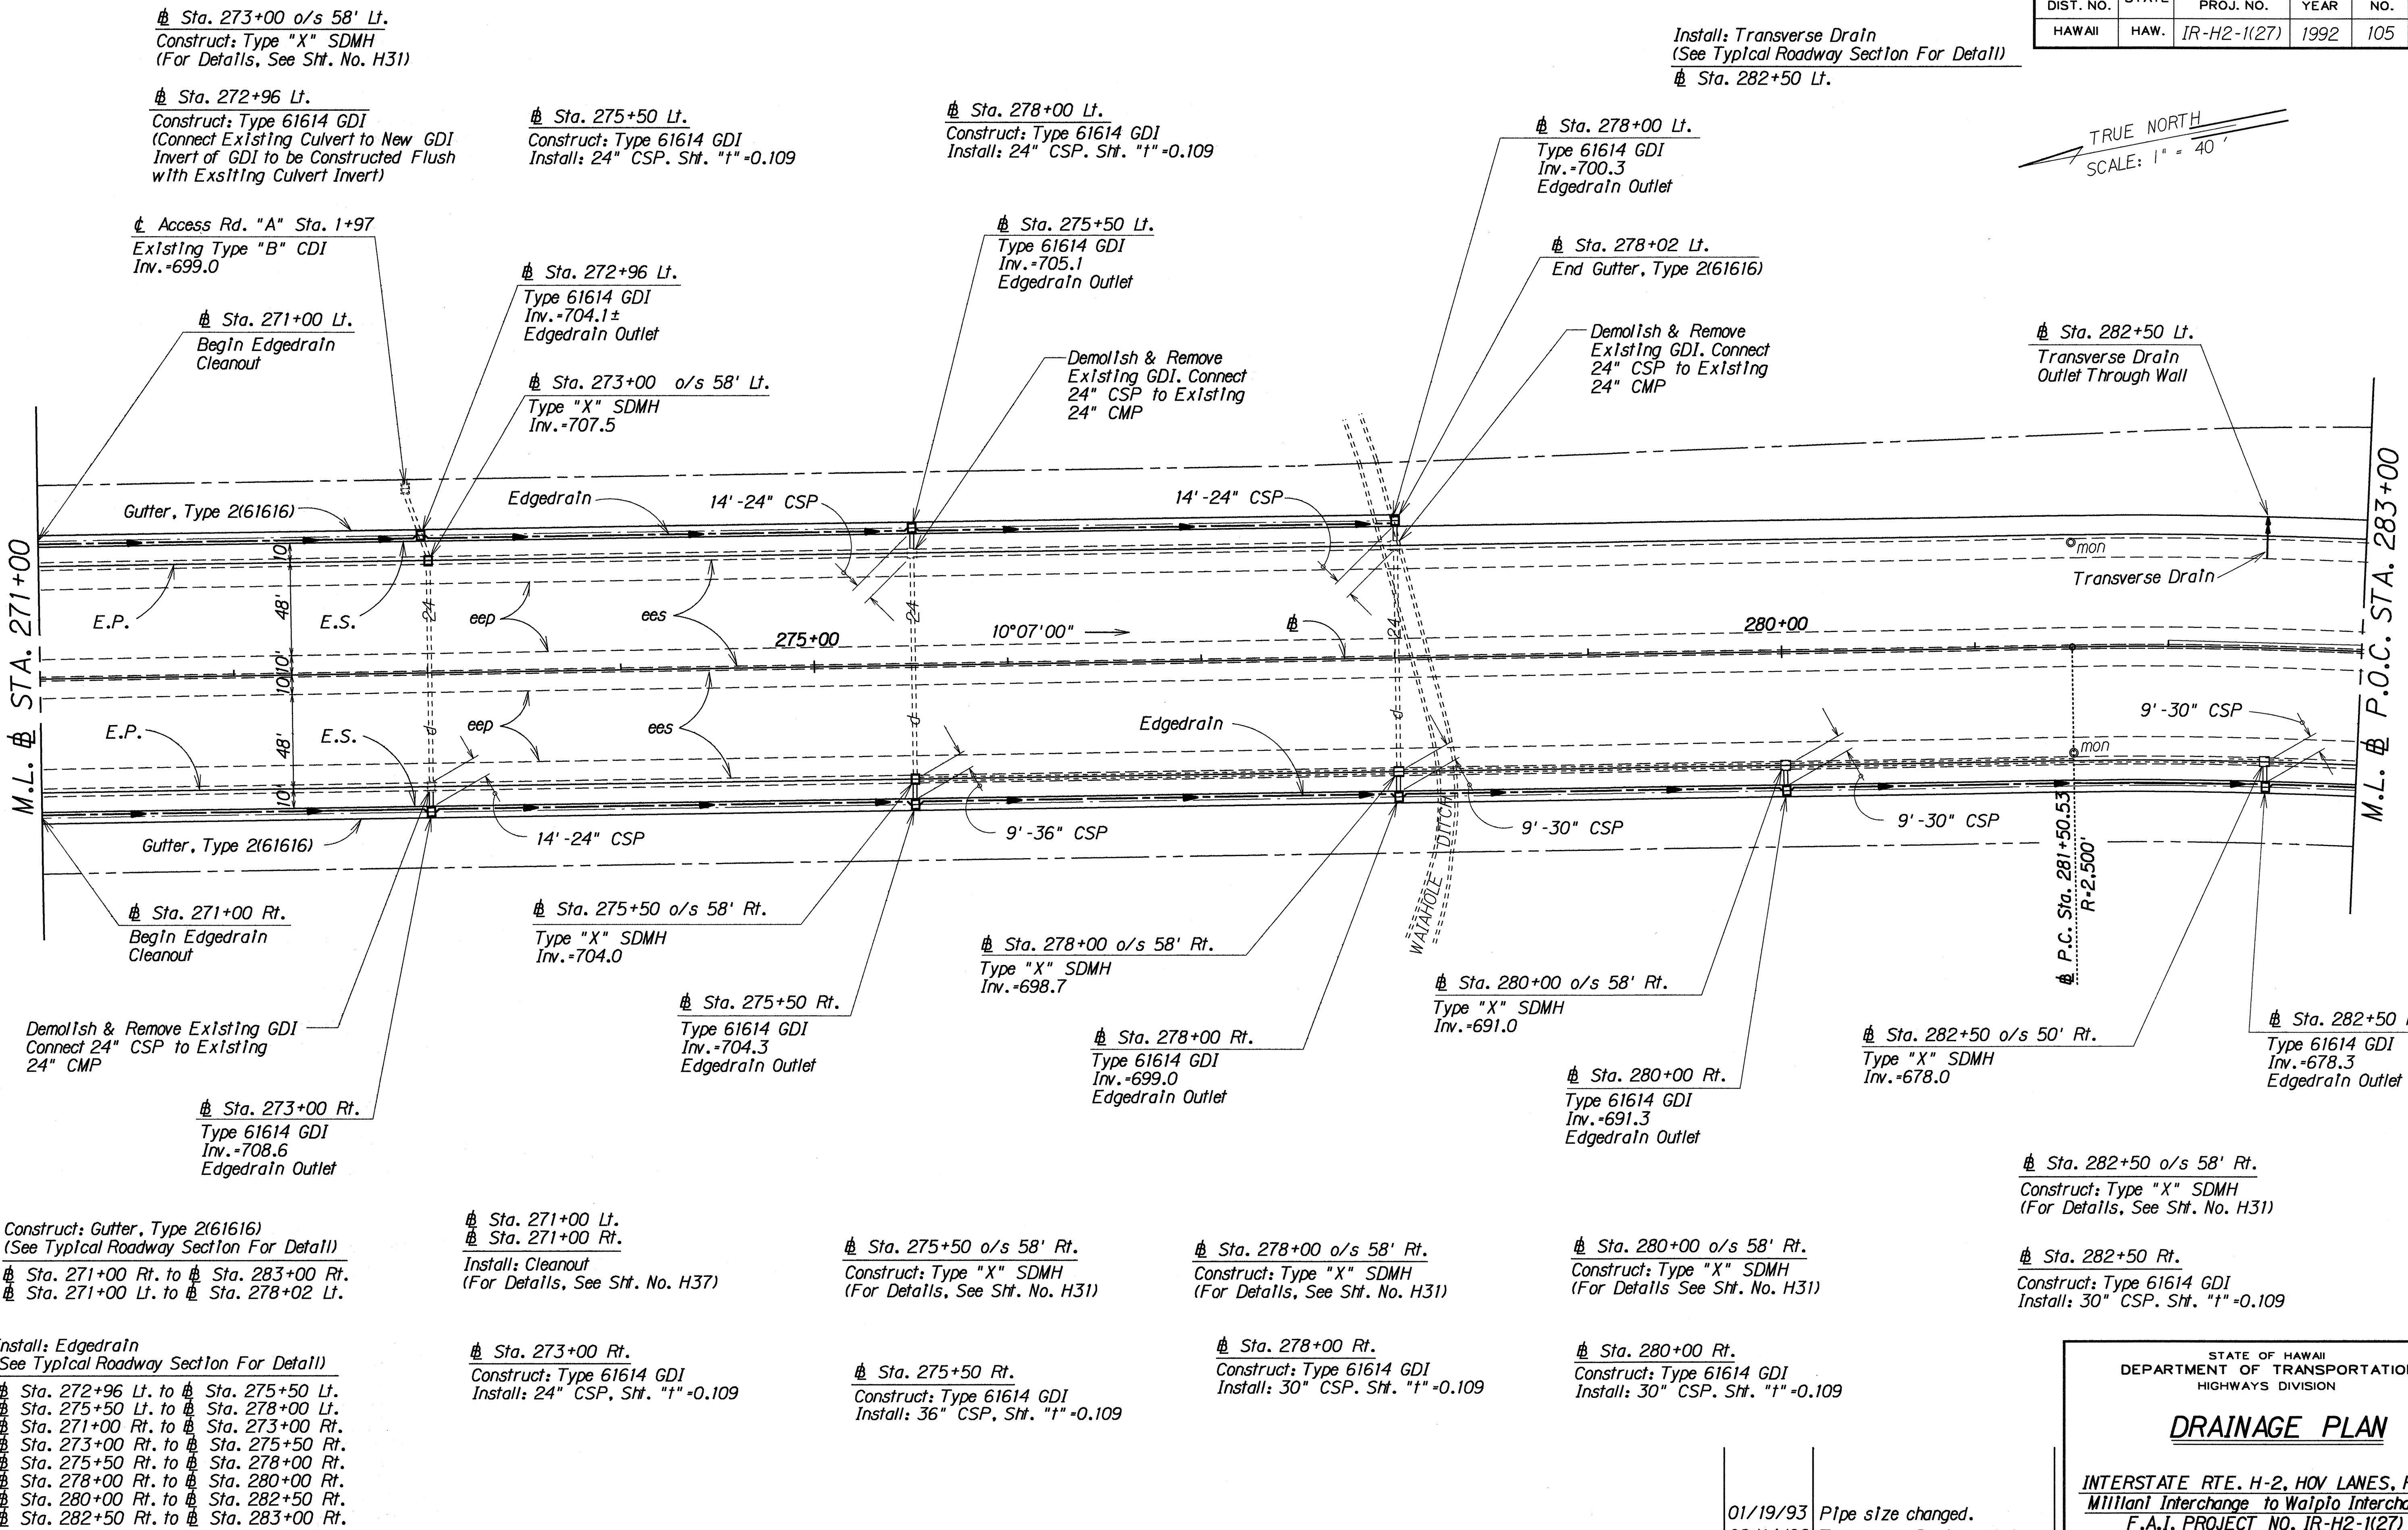

DATE	11/21/93
DESIGNED BY	11h2h14ad
CHECKED BY	11h2h14ad
QUANTITIES BY	11h2h14ad
NOTED BY	11h2h14ad
ORIGINAL PLAN	11h2h14ad

Construct: Gutter, Type 2(61616)
(See Typical Roadway Section For Detail)
Sta. 271+00 Rt. to Sta. 283+00 Rt.
Sta. 271+00 Lt. to Sta. 278+02 Lt.
Install: Edgedrain
(See Typical Roadway Section For Detail)
Sta. 272+96 Lt. to Sta. 275+50 Lt.
Sta. 275+50 Lt. to Sta. 278+00 Lt.
Sta. 271+00 Rt. to Sta. 273+00 Rt.
Sta. 273+00 Rt. to Sta. 275+50 Rt.
Sta. 275+50 Rt. to Sta. 278+00 Rt.
Sta. 278+00 Rt. to Sta. 280+00 Rt.
Sta. 280+00 Rt. to Sta. 282+50 Rt.
Sta. 282+50 Rt. to Sta. 283+00 Rt.

Sta. 271+00 Lt.
Sta. 271+00 Rt.
Install: Cleanout
(For Details, See Sht. No. H37)
Sta. 273+00 Rt.
Construct: Type 61614 GDI
Install: 24" CSP, Sht. "t"=0.109

Sta. 275+50 o/s 58' Rt.
Construct: Type "X" SDMH
(For Details, See Sht. No. H31)
Sta. 275+50 Rt.
Construct: Type 61614 GDI
Install: 36" CSP, Sht. "t"=0.109

Sta. 278+00 o/s 58' Rt.
Construct: Type "X" SDMH
(For Details, See Sht. No. H31)
Sta. 278+00 Rt.
Construct: Type 61614 GDI
Install: 30" CSP, Sht. "t"=0.109

Sta. 280+00 o/s 58' Rt.
Construct: Type "X" SDMH
(For Details See Sht. No. H31)
Sta. 280+00 Rt.
Construct: Type 61614 GDI
Install: 30" CSP, Sht. "t"=0.109



Sta. 282+50 o/s 58' Rt.
Construct: Type "X" SDMH
(For Details, See Sht. No. H31)
Sta. 282+50 Rt.
Construct: Type 61614 GDI
Install: 30" CSP, Sht. "t"=0.109

01/19/93	Pipe size changed.
08/14/92	Transverse Drain added
DATE	REVISION

STATE OF HAWAII
DEPARTMENT OF TRANSPORTATION
HIGHWAYS DIVISION
DRAINAGE PLAN
INTERSTATE RTE. H-2, HOV LANES, PH. II
Maui Interchange to Waipio Interchange
F.A.I. PROJECT NO. IR-H2-1(27)
Scale: 1" = 40' Date: Apr., 1992

FED. ROAD DIST. NO.	STATE	FED. AID PROJ. NO.	FISCAL YEAR	SHEET NO.	TOTAL SHEETS
HAWAII	HAW.	IR-H2-1(27)	1992	106	223

Sta. 291+50 Lt.
Install: Cleanout
(For Details, See Sht. No. H37)

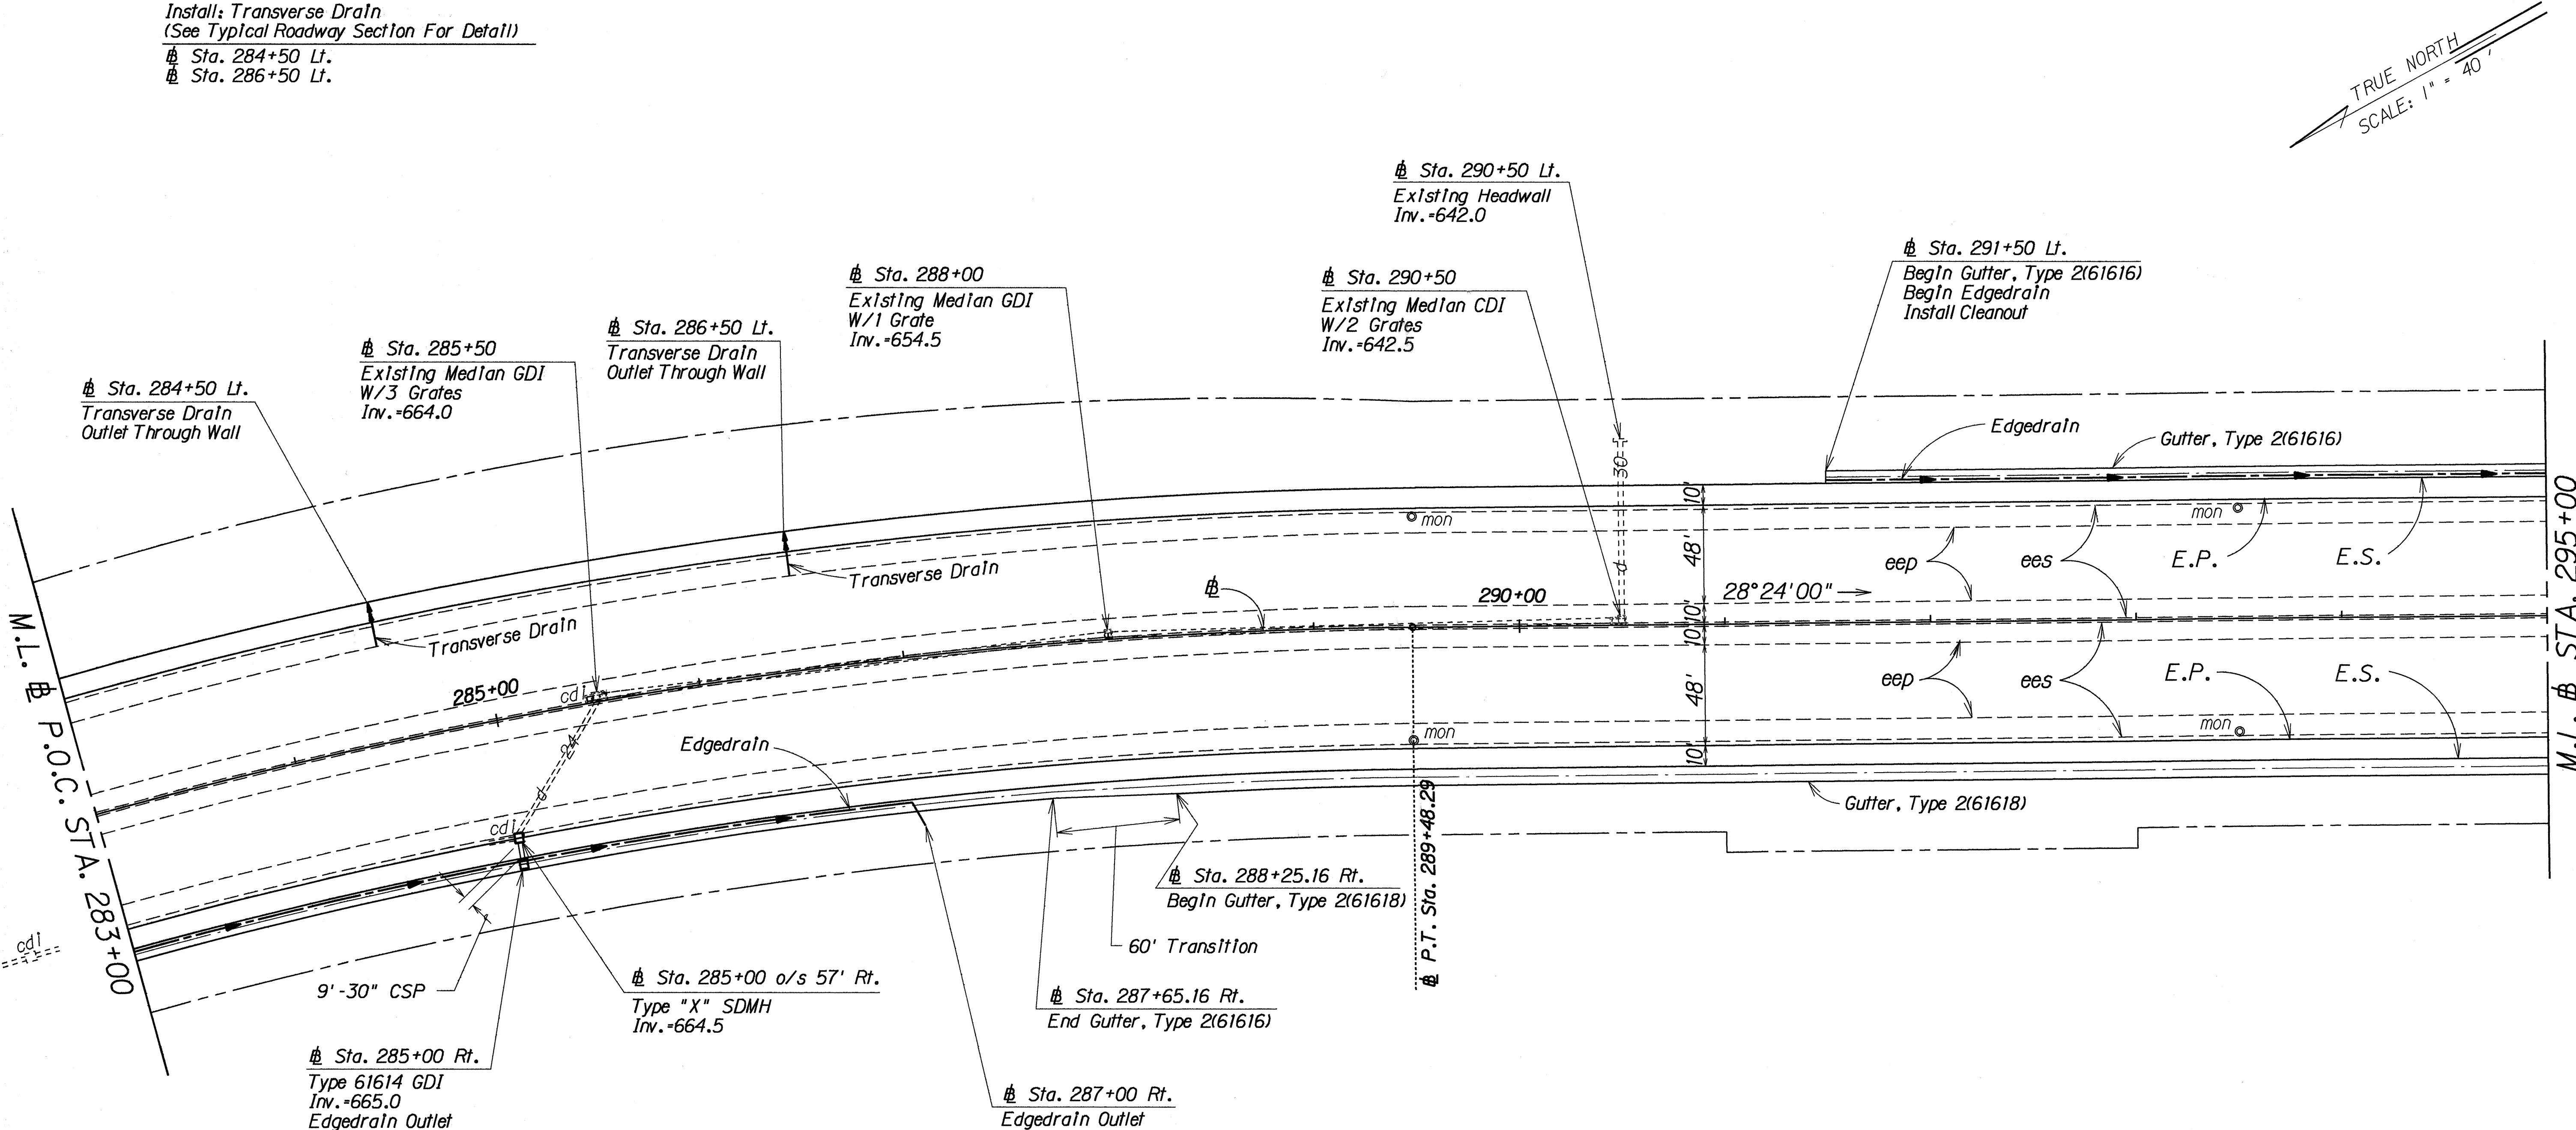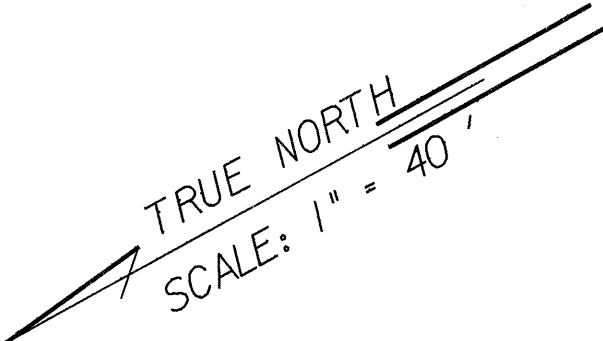

DATE	11/20/92
DESIGNED BY	11h2h15ad.dgn
CHECKED BY	
QUANTITIES BY	
NOTED BY	
ORIGINAL PLAN	

Sta. 285+00 Rt.
Construct: Type 61614 GDI
Install: 30" CSP, Sht "I" = 0.105"

Sta. 285+00 o/s 57' Rt.
Construct: Type "X" SDMH
(For Details, See Sht. No. H31)

Construct: Gutter, Type 2(61616)
(See Typical Roadway Section For Detail)
Sta. 283+00 Rt. to Sta. 287+95.16 Rt.
Sta. 291+50 Lt. to Sta. 295+00 Lt.

Construct: Gutter, Type 2(61618)
(See Typical Roadway Section For Detail)
Sta. 287+95.16 Rt. to Sta. 295+00 Rt.

Install: Edgedrain
(See Typical Roadway Section For Detail)
Sta. 283+00 Rt. to Sta. 285+00 Rt.
Sta. 285+00 Rt. to Sta. 287+00 Rt.
Sta. 291+50 Lt. to Sta. 295+00 Lt.

Sta. 287+00 Rt.
Install: Edgedrain Outlet
(For Details, See Sht. No. H38)

01/19/93	Pipe size changed.
08/14/92	Transverse Drains added
DATE	REVISION

STATE OF HAWAII
DEPARTMENT OF TRANSPORTATION
HIGHWAYS DIVISION

DRAINAGE PLAN

INTERSTATE RTE. H-2, HOV LANES, PH. II
Miliiani Interchange to Waipio Interchange
F.A.I. PROJECT NO. IR-H2-1(27)

Scale: 1" = 40' Date: Apr., 1992

SHEET No. H15 OF 42 SHEETS

FED. ROAD DIST. NO.	STATE	FED. AID PROJ. NO.	FISCAL YEAR	SHEET NO.	TOTAL SHEETS
HAWAII	HAW.	IR-H2-1(27)	1992	107	223

TRUE NORTH
SCALE: 1" = 40'

Construct: Gutter, Type 2(61616)
(See Typical Roadway Section For Detail)
Sta. 295+00 Lt. to O.B. Sta. 307+00 Lt.

O.B. Sta. 297+90 Lt.
Construct: Type 61614 GDI
Standard Concrete Headwall
Install: 24" CSP, Sht. "I" = 0.109"

O.B. Sta. 303+00 Lt.
Construct: Type 61614 GDI
(Invert of GDI to be Constructed
Flush with Existing Culvert Invert)
Install: Underdrain Outlet (For Details,
See Sht. No. H38)

Install: Edgedrain
(See Typical Roadway Section For Detail)
Sta. 295+00 Lt. to O.B. Sta. 297+90 Lt.
O.B. Sta. 297+90 Lt. to O.B. Sta. 303+00 Lt.
O.B. Sta. 303+00 Lt. to O.B. Sta. 306+50 Lt.
O.B. Sta. 306+50 Lt. to O.B. Sta. 307+00 Lt.

O.B. Sta. 303+00 o/s 98' ± Lt.
Construct: 1.25'x0.5' Lined Trapezoidal Ditch
(For Details, see Sht. No. H35)

O.B. Sta. 306+50 Lt.
Construct: Type 61614 GDI
Install: 24" CSP, Sht. "I" = 0.109"
Underdrain Outlet (For Details,
See Sht. No. H38)

O.B. Sta. 306+50 Lt.
Type 61614 GDI
Inv. = 564.5
Edgedrain Outlet
Underdrain Outlet

Demolish & Remove
Existing GDI, Cut &
Plug 24" CMP. Connect
Existing Underdrain to
Type 61614 GDI

O.B. Sta. 303+00 Lt.
Type 61614 GDI
Inv. = 577.5 ±
Edgedrain Outlet
Underdrain Outlet

Demolish & Remove Existing
GDI and 24" CMP. Connect
Existing Underdrain To
Type 61614 GDI

O.B. Sta. 297+90 o/s 86' Lt.
Standard Concrete Headwall
Inv. = 600.0

O.B. Sta. 297+90 Lt.
Type 61614 GDI
Inv. = 601.25
Edgedrain Outlet

1.25'x0.5' Lined Trapezoidal Ditch

6" Nonperforated Underdrain Pipe
Connect to Existing Underdrain

I.B. Sta. 305+00 Lt.
Existing Type 6164 GDI
Inv. = 581.0

6" Nonperforated Underdrain Pipe
Connect to Existing Underdrain

I.B. Sta. 305+50 Rt.
Transverse Drain
Outlet Through Fill

I.B. Sta. 303+50 Rt.
Transverse Drain
Outlet Through Fill

I.B. Sta. 300+50 Rt.
End Gutter, Type 2(61618)
Begin Spillway

I.B. Sta. 299+10 ± Rt.
Begin 10' Transition to
1.5'x2' Lined Trapezoidal Ditch
(Exact location to be determined
by the Engineer in the field)

Install: Transverse Drain
(See Typical Roadway Section For Detail)
I.B. Sta. 303+50 Rt.
I.B. Sta. 305+50 Rt.

I.B. Sta. 300+50 Rt.
Construct: Spillway
(For Detail, See Sht. No. H36)

Construct: Gutter, Type 2(61618)
(See Typical Roadway Section For Detail)
Sta. 295+00 Rt. to I.B. Sta. 300+50 Rt.

Construct: 1.5'x2' Lined Trapezoidal Ditch
(For Details, see Sht. No. H36)
I.B. Sta. 299+10 ± Rt. to I.B. Sta. 307+00 Rt.

SURVEY PLOTTED BY	DATE
DRAWN BY	
DESIGNED BY	
QUANTITIES BY	
CHECKED BY	
ORIGINAL PLAN	
NOTE BOOK	
11/21/92	

12/06/93	1.25'x0.5' Lined Trapezoidal Ditch added
06/09/93	1.5'x2' Lined Trapezoidal Ditch added
08/14/92	Transverse Drains added
DATE	REVISION

STATE OF HAWAII
DEPARTMENT OF TRANSPORTATION
HIGHWAYS DIVISION

DRAINAGE PLAN

INTERSTATE RTE. H-2, HOV LANES, PH. II
Mililani Interchange to Waipio Interchange
F.A.I. PROJECT NO. IR-H2-1(27)

Scale: 1" = 40' Date: Apr., 1992


SHEET No. H16 OF 42 SHEETS

C.O. ADD. 107

11h2h16ad.dgn

FED. ROAD DIST. NO.	STATE	FED. AID PROJ. NO.	FISCAL YEAR	SHEET NO.	TOTAL SHEETS
HAWAII	HAW.	IR-H2-1(27)	1992	108	223

TRUE NORTH
SCALE: 1" = 40'

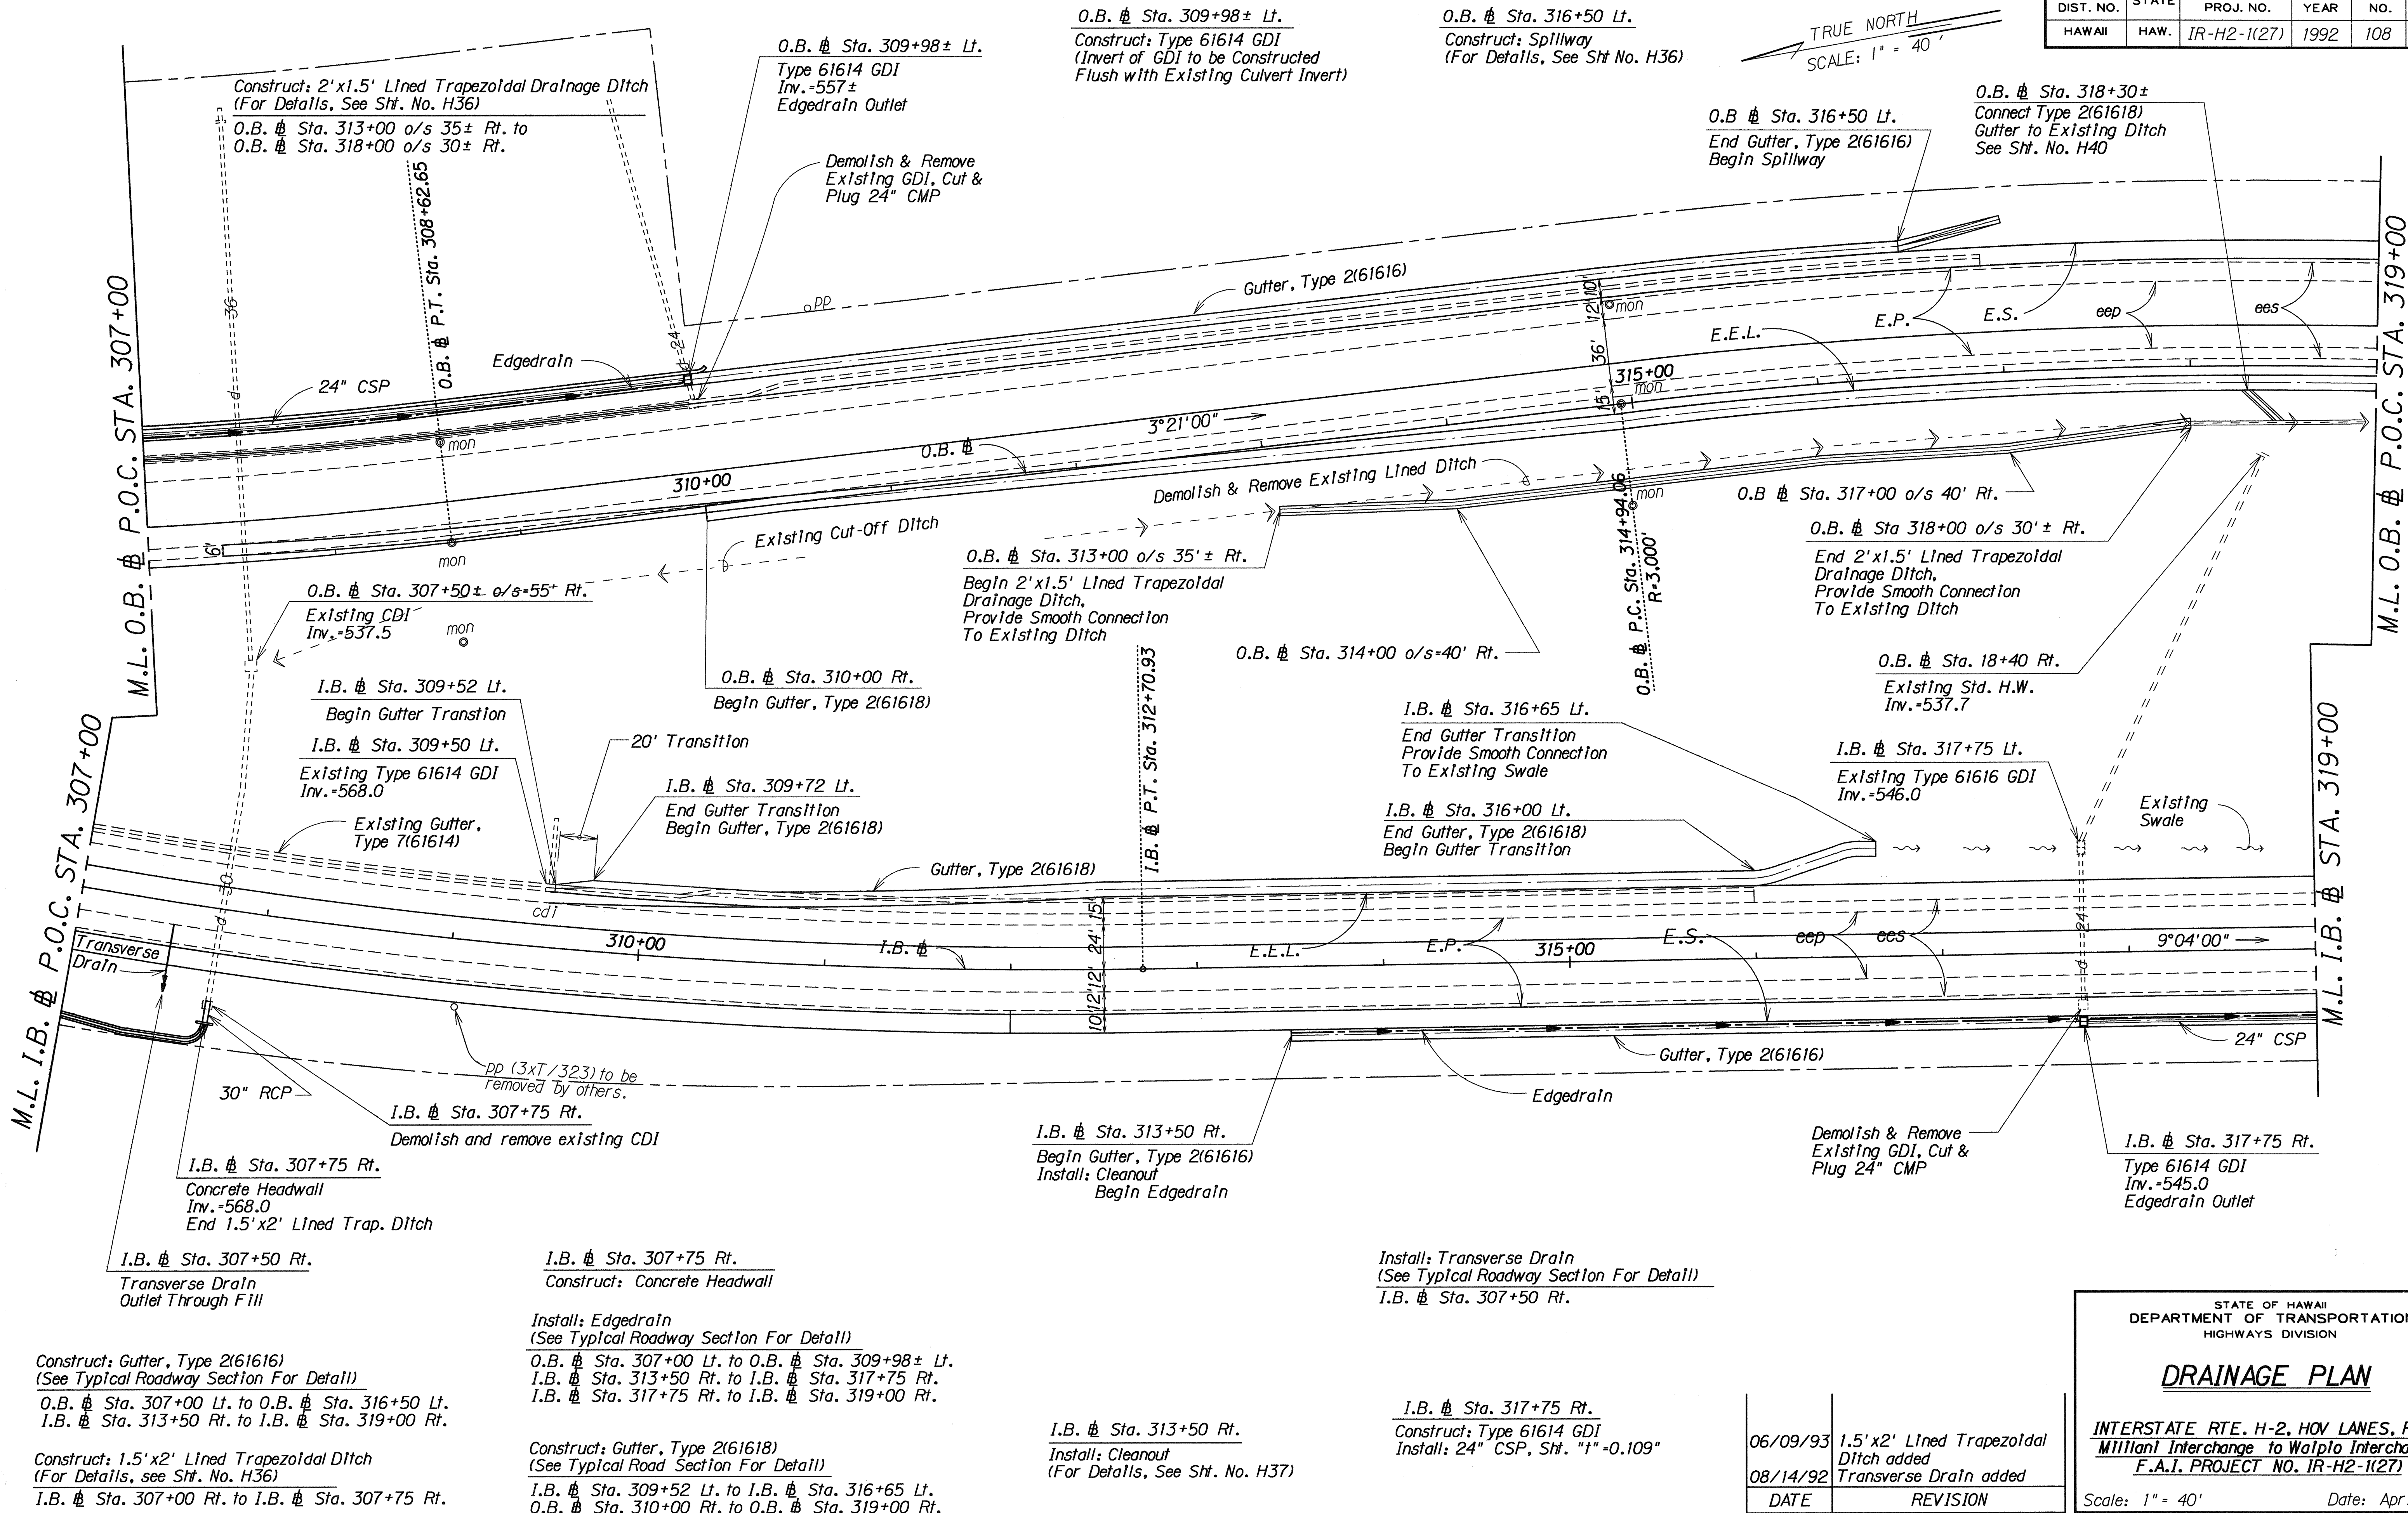

SURVEY PLOTTED BY	DATE
DRAWN BY	
TRACED BY	
NOTED BY	
CHECKED BY	

DATE	REVISION
06/09/93	1.5'x2' Lined Trapezoidal Ditch added
08/14/92	Transverse Drain added

STATE OF HAWAII
DEPARTMENT OF TRANSPORTATION
HIGHWAYS DIVISION

DRAINAGE PLAN


INTERSTATE RTE. H-2, HOV LANES, PH. II
Mililani Interchange to Waipio Interchange
F.A.I. PROJECT NO. IR-H2-1(27)

Scale: 1" = 40' Date: Apr., 1992

SHEET No. H17 OF 42 SHEETS

1ih2h18.dqn

FED. ROAD DIST. NO.	STATE	FED. AID PROJ. NO.	FISCAL YEAR	SHEET NO.	TOTAL SHEETS
HAWAII	HAW.	IR-H2-1(27)	1992	110	223

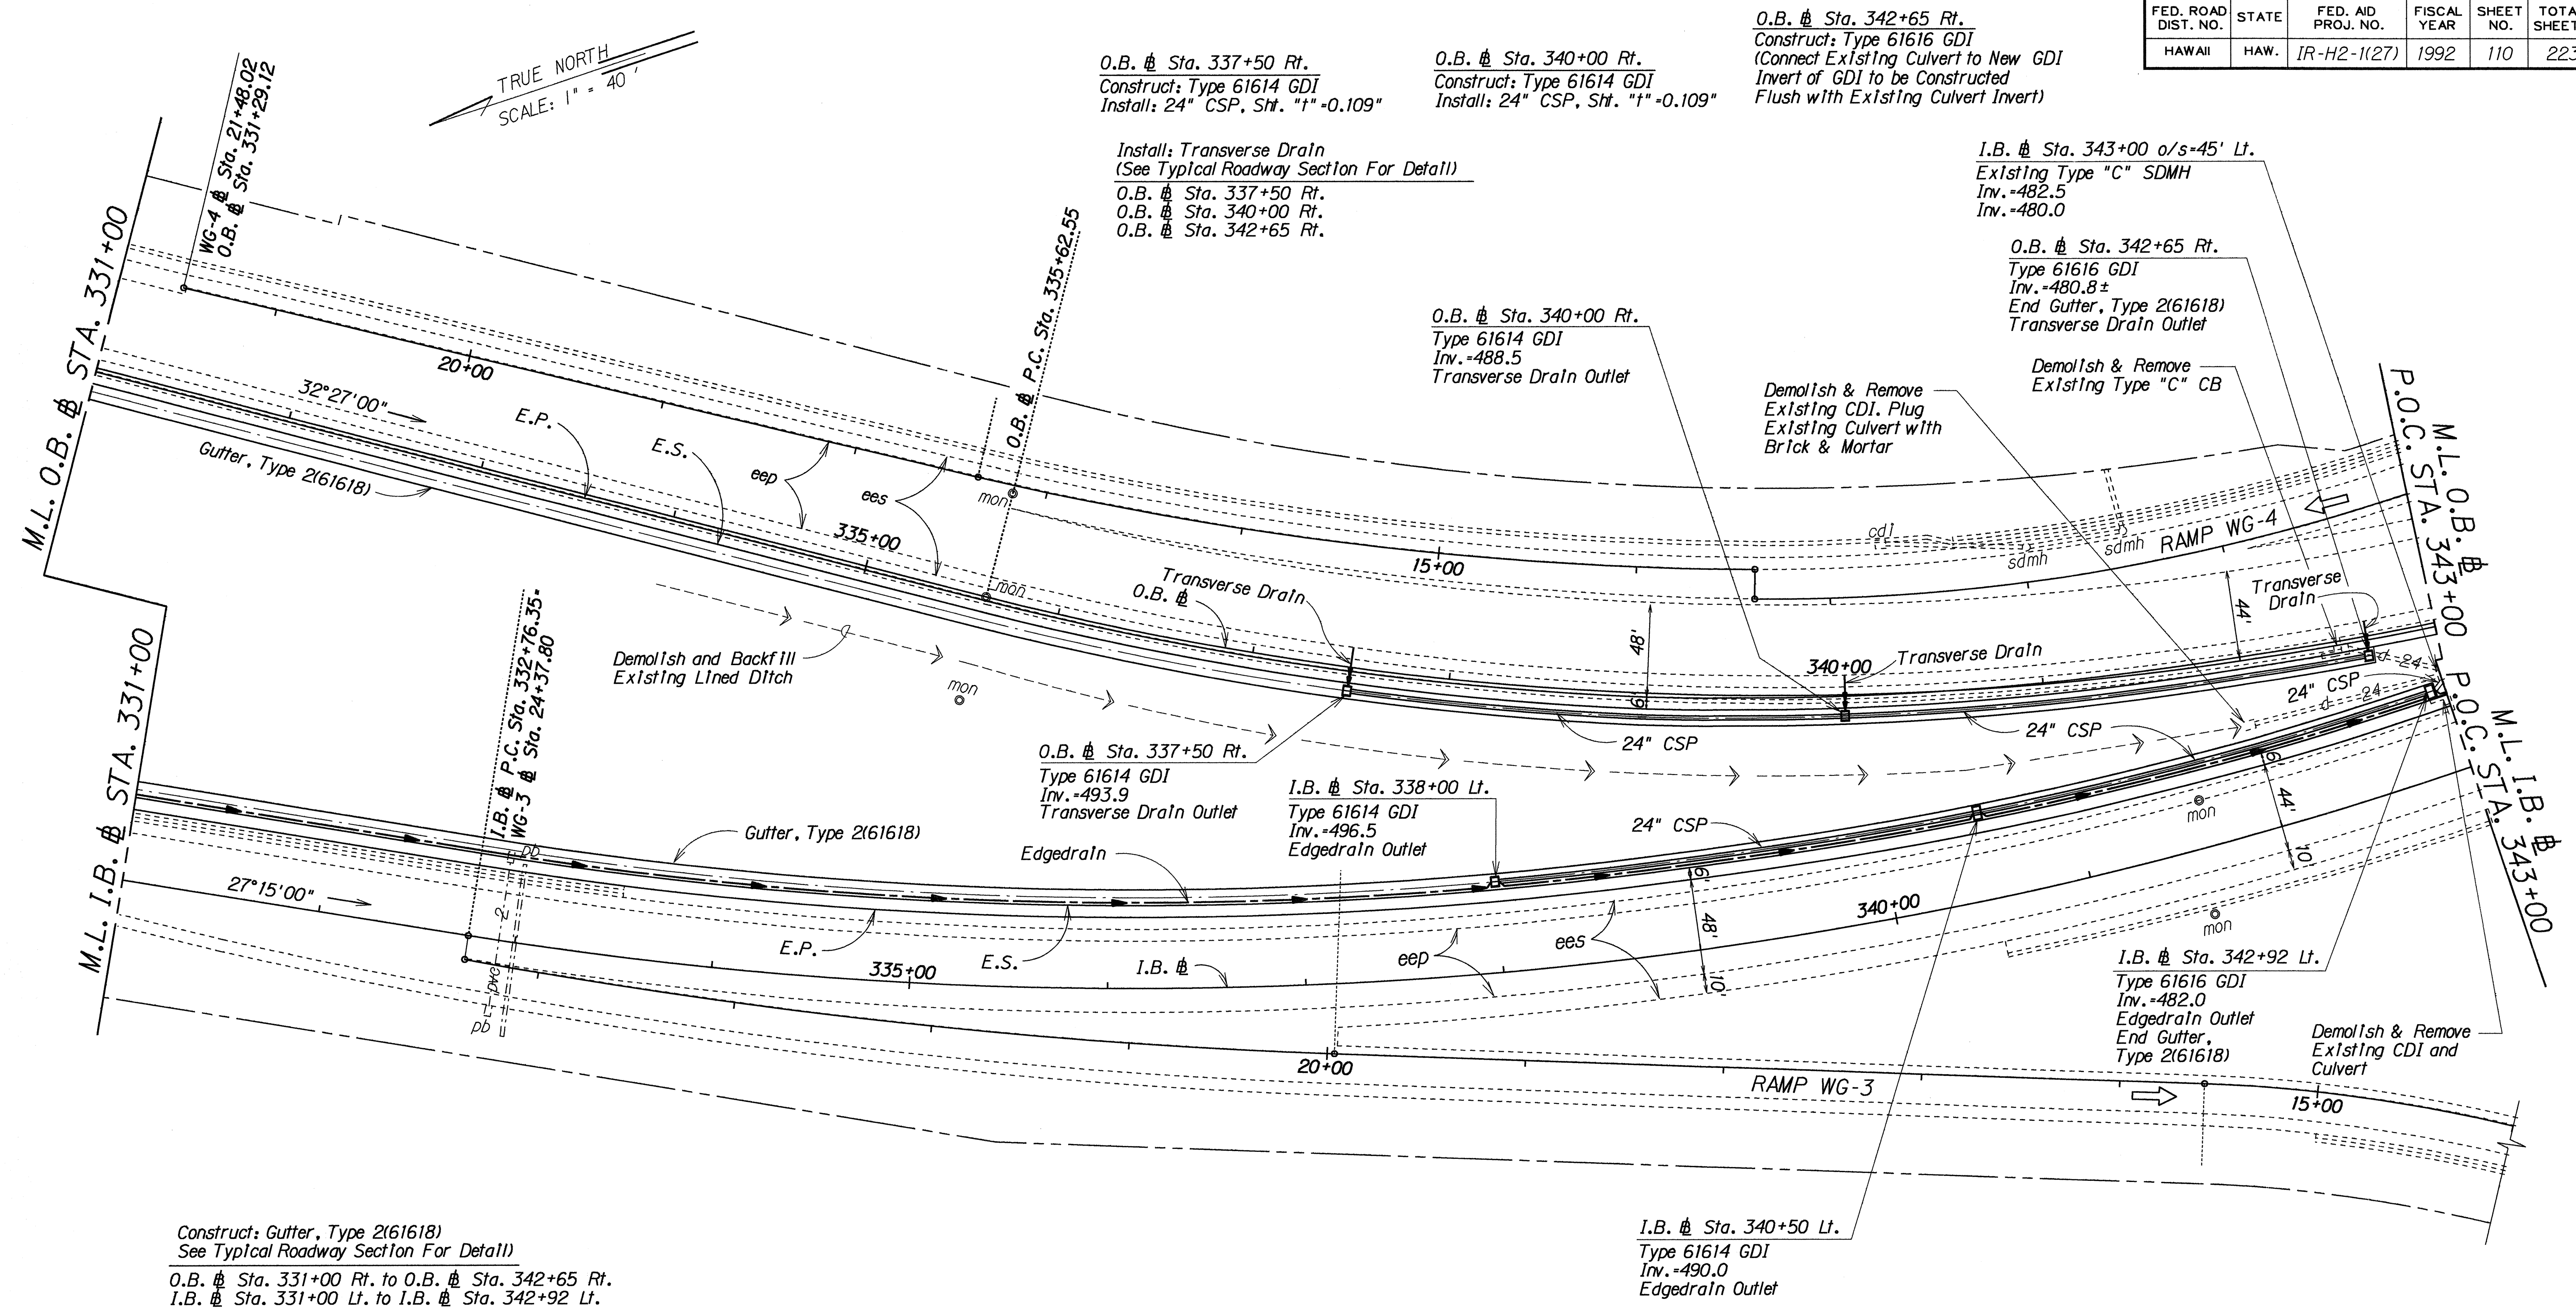

ORIGINAL PLAN	SURVEY PLOTTED BY _____ DATE _____
NOTE BOOK	DRAWN BY _____
	TRACED BY _____
	DESIGNED BY _____
	QUANTITIES BY _____
No. _____	CHECKED BY _____

Construct: Gutter, Type 2(61618)
See Typical Roadway Section For Detail)

O.B. @ Sta. 331+00 Rt. to O.B. @ Sta. 342+65 Rt.
I.B. @ Sta. 331+00 Lt. to I.B. @ Sta. 342+92 Lt.

*Install: Edgedrain
(See Typical Roadway Section For Details)*

<i>I.B. @ Sta. 331+00 Lt. to I.B. @ Sta. 338+00 Lt.</i>
<i>I.B. @ Sta. 338+00 Lt. to I.B. @ Sta. 340+50 Lt.</i>
<i>I.B. @ Sta. 340+50 Lt. to I.B. @ Sta. 342+92 Lt.</i>
<i>I.B. @ Sta. 342+92 Lt. to I.B. @ Sta. 343+00 Lt.</i>

I.B. @ Sta. 338+00 Lt.
Construct: Type 6164 GDI
Install: 24" CSP, Sht. "t"=0.109"

I.B. # Sta. 340+50 Lt.
Construct: Type 6164 GDI
Install: 24" CSP, Sht. "t" = 0.109"

I.B. @ Sta. 342+92 Lt.
Construct: Type 61616 GDI
Install: 24" CSP, Sht. "t" = 0.109"

08/14/92	Transverse Drain added Edgedrain extended
DATE	REVISION

STATE OF HAWAII
DEPARTMENT OF TRANSPORTATION
HIGHWAYS DIVISION

DRAINAGE PLAN

INTERSTATE RTE. H-2, HOV LANES, PH. II
Million Interchange to Waipio Interchange
F.A.I. PROJECT NO. IR-H2-1(27)

Scale: 1" = 40' Date: Apr., 1992

SHEET No. H19 OF 42 SHEETS

FED. ROAD DIST. NO.	STATE	FED. AID PROJ. NO.	FISCAL YEAR	SHEET NO.	TOTAL SHEETS
HAWAII	HAW.	IR-H2-1(27)	1992	111	223

SURVEY PLOTTED BY	DATE
DRAWN BY	
DESIGNED BY	
QUANTITIES BY	
CHECKED BY	
ORIGINAL PLAN	
NOTE BOOK	
11h2h20ad.dgn	
N	

Construct: Gutter, Type 2(61618)
(See Typical Roadway Section For Detail)
O.B. Sta. 347+38 Lt. to O.B. Sta. 355+00 Rt.
I.B. Sta. 348+90 Rt. to I.B. Sta. 355+00 Rt.

Install: Edgedrain
(See Typical Roadway Section For Detail)
I.B. Sta. 343+00 Lt. to I.B. Sta. 345+05 Lt.
I.B. Sta. 345+05 Lt. to O.B. Sta. 348+50 Rt.
O.B. Sta. 347+38 Lt. to O.B. Sta. 355+00
I.B. Sta. 348+90 Rt. to I.B. Sta. 355+00 Rt.

I.B. Sta. 345+05 Lt.
Existing Type 61616 GDI
Inv. -471.0
Edgedrain Outlet
Transverse Drain Outlet

O.B. Sta. 348+50 Rt.
Type 6 MDI
Inv. -466.0
Edgedrain Outlet
Transverse Drain Outlet

I.B. Sta. 348+88 Rt.
Existing Type 61214 GDI
Inv. -465.5

I.B. Sta. 348+90 Rt.
Begin Gutter Transition
Begin Edgedrain

I.B. Sta. 349+10 Rt.
End Gutter Transition
Begin Gutter, Type 2(61618)

I.B. Sta. 352+25 Rt.
Construct: Type 61614-M GDI
(For Detail, See Sht. No. H25)

07/22/94	Type 6 MDI added
08/14/92	Transverse Drains added Edgedrains added
DATE	REVISION

STATE OF HAWAII
DEPARTMENT OF TRANSPORTATION
HIGHWAYS DIVISION

DRAINAGE PLAN


INTERSTATE RTE. H-2, HOV LANES, PH. II
Miliiani Interchange to Waipio Interchange
F.A.I. PROJECT NO. IR-H2-1(27)

Scale: 1" = 40' Date: Apr., 1992

SHEET No. H20 OF 42 SHEETS


C.O. ADD. 111

11h2h20ad.dgn

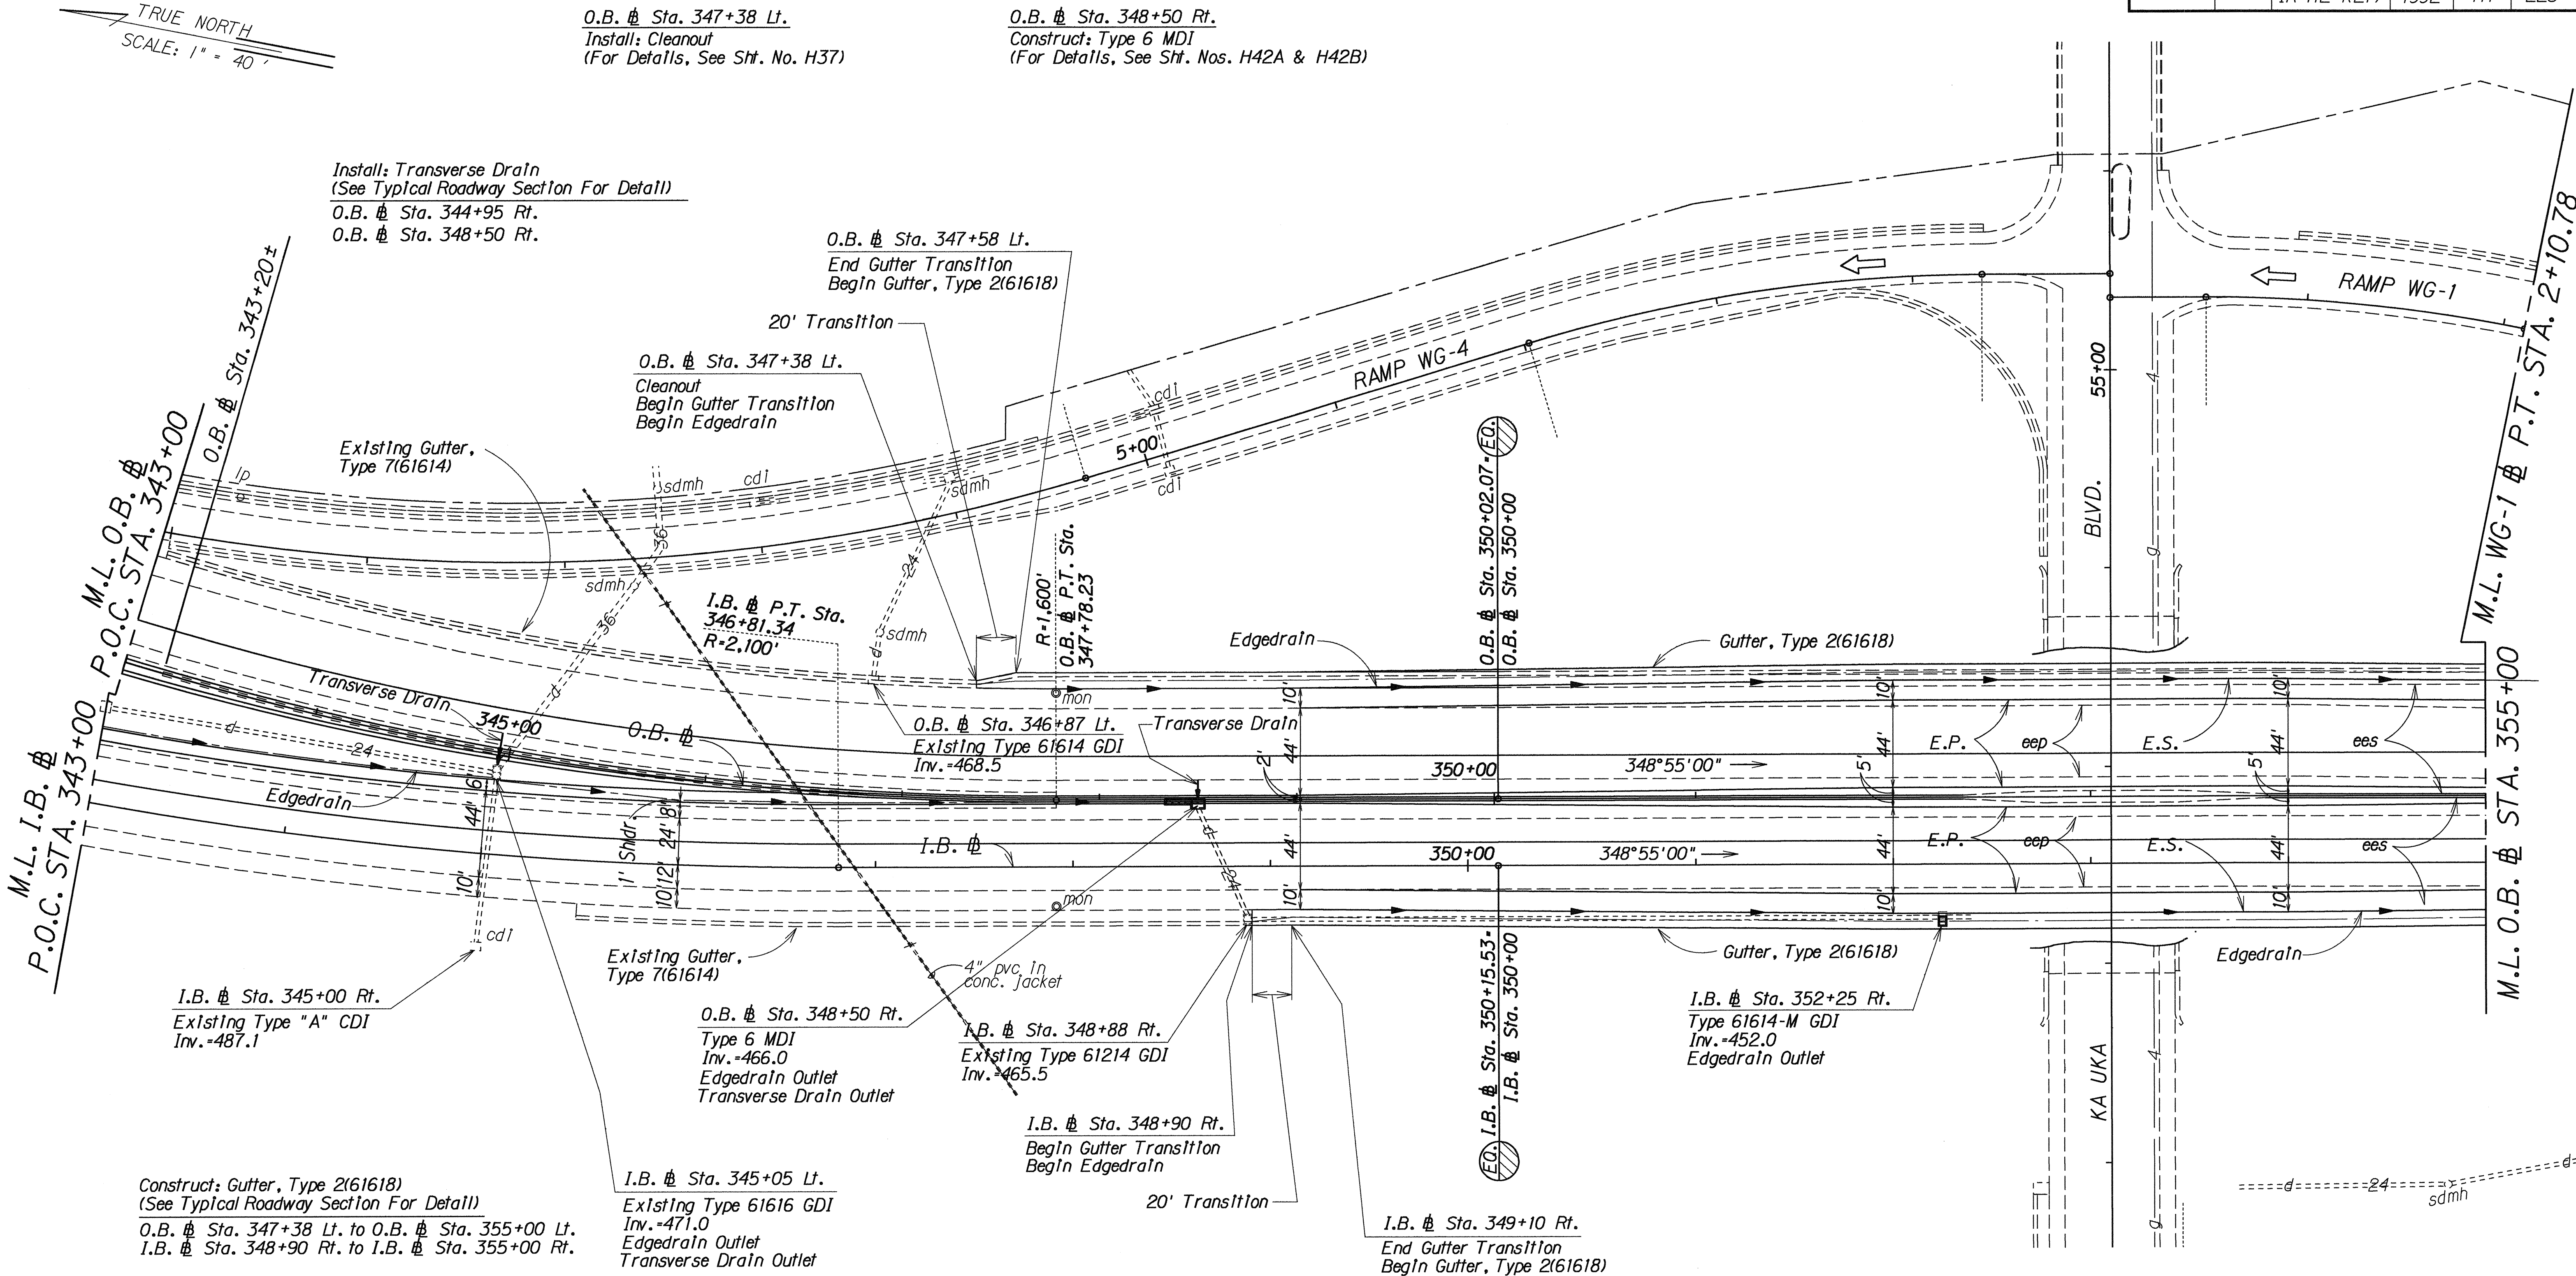

FED. ROAD DIST. NO.	STATE	FED. AID PROJ. NO.	FISCAL YEAR	SHEET NO.	TOTAL SHEETS
HAWAII	HAW.	IR-H2-1(27)	1992	112	223

TRUE NORTH
SCALE: 1" = 40'

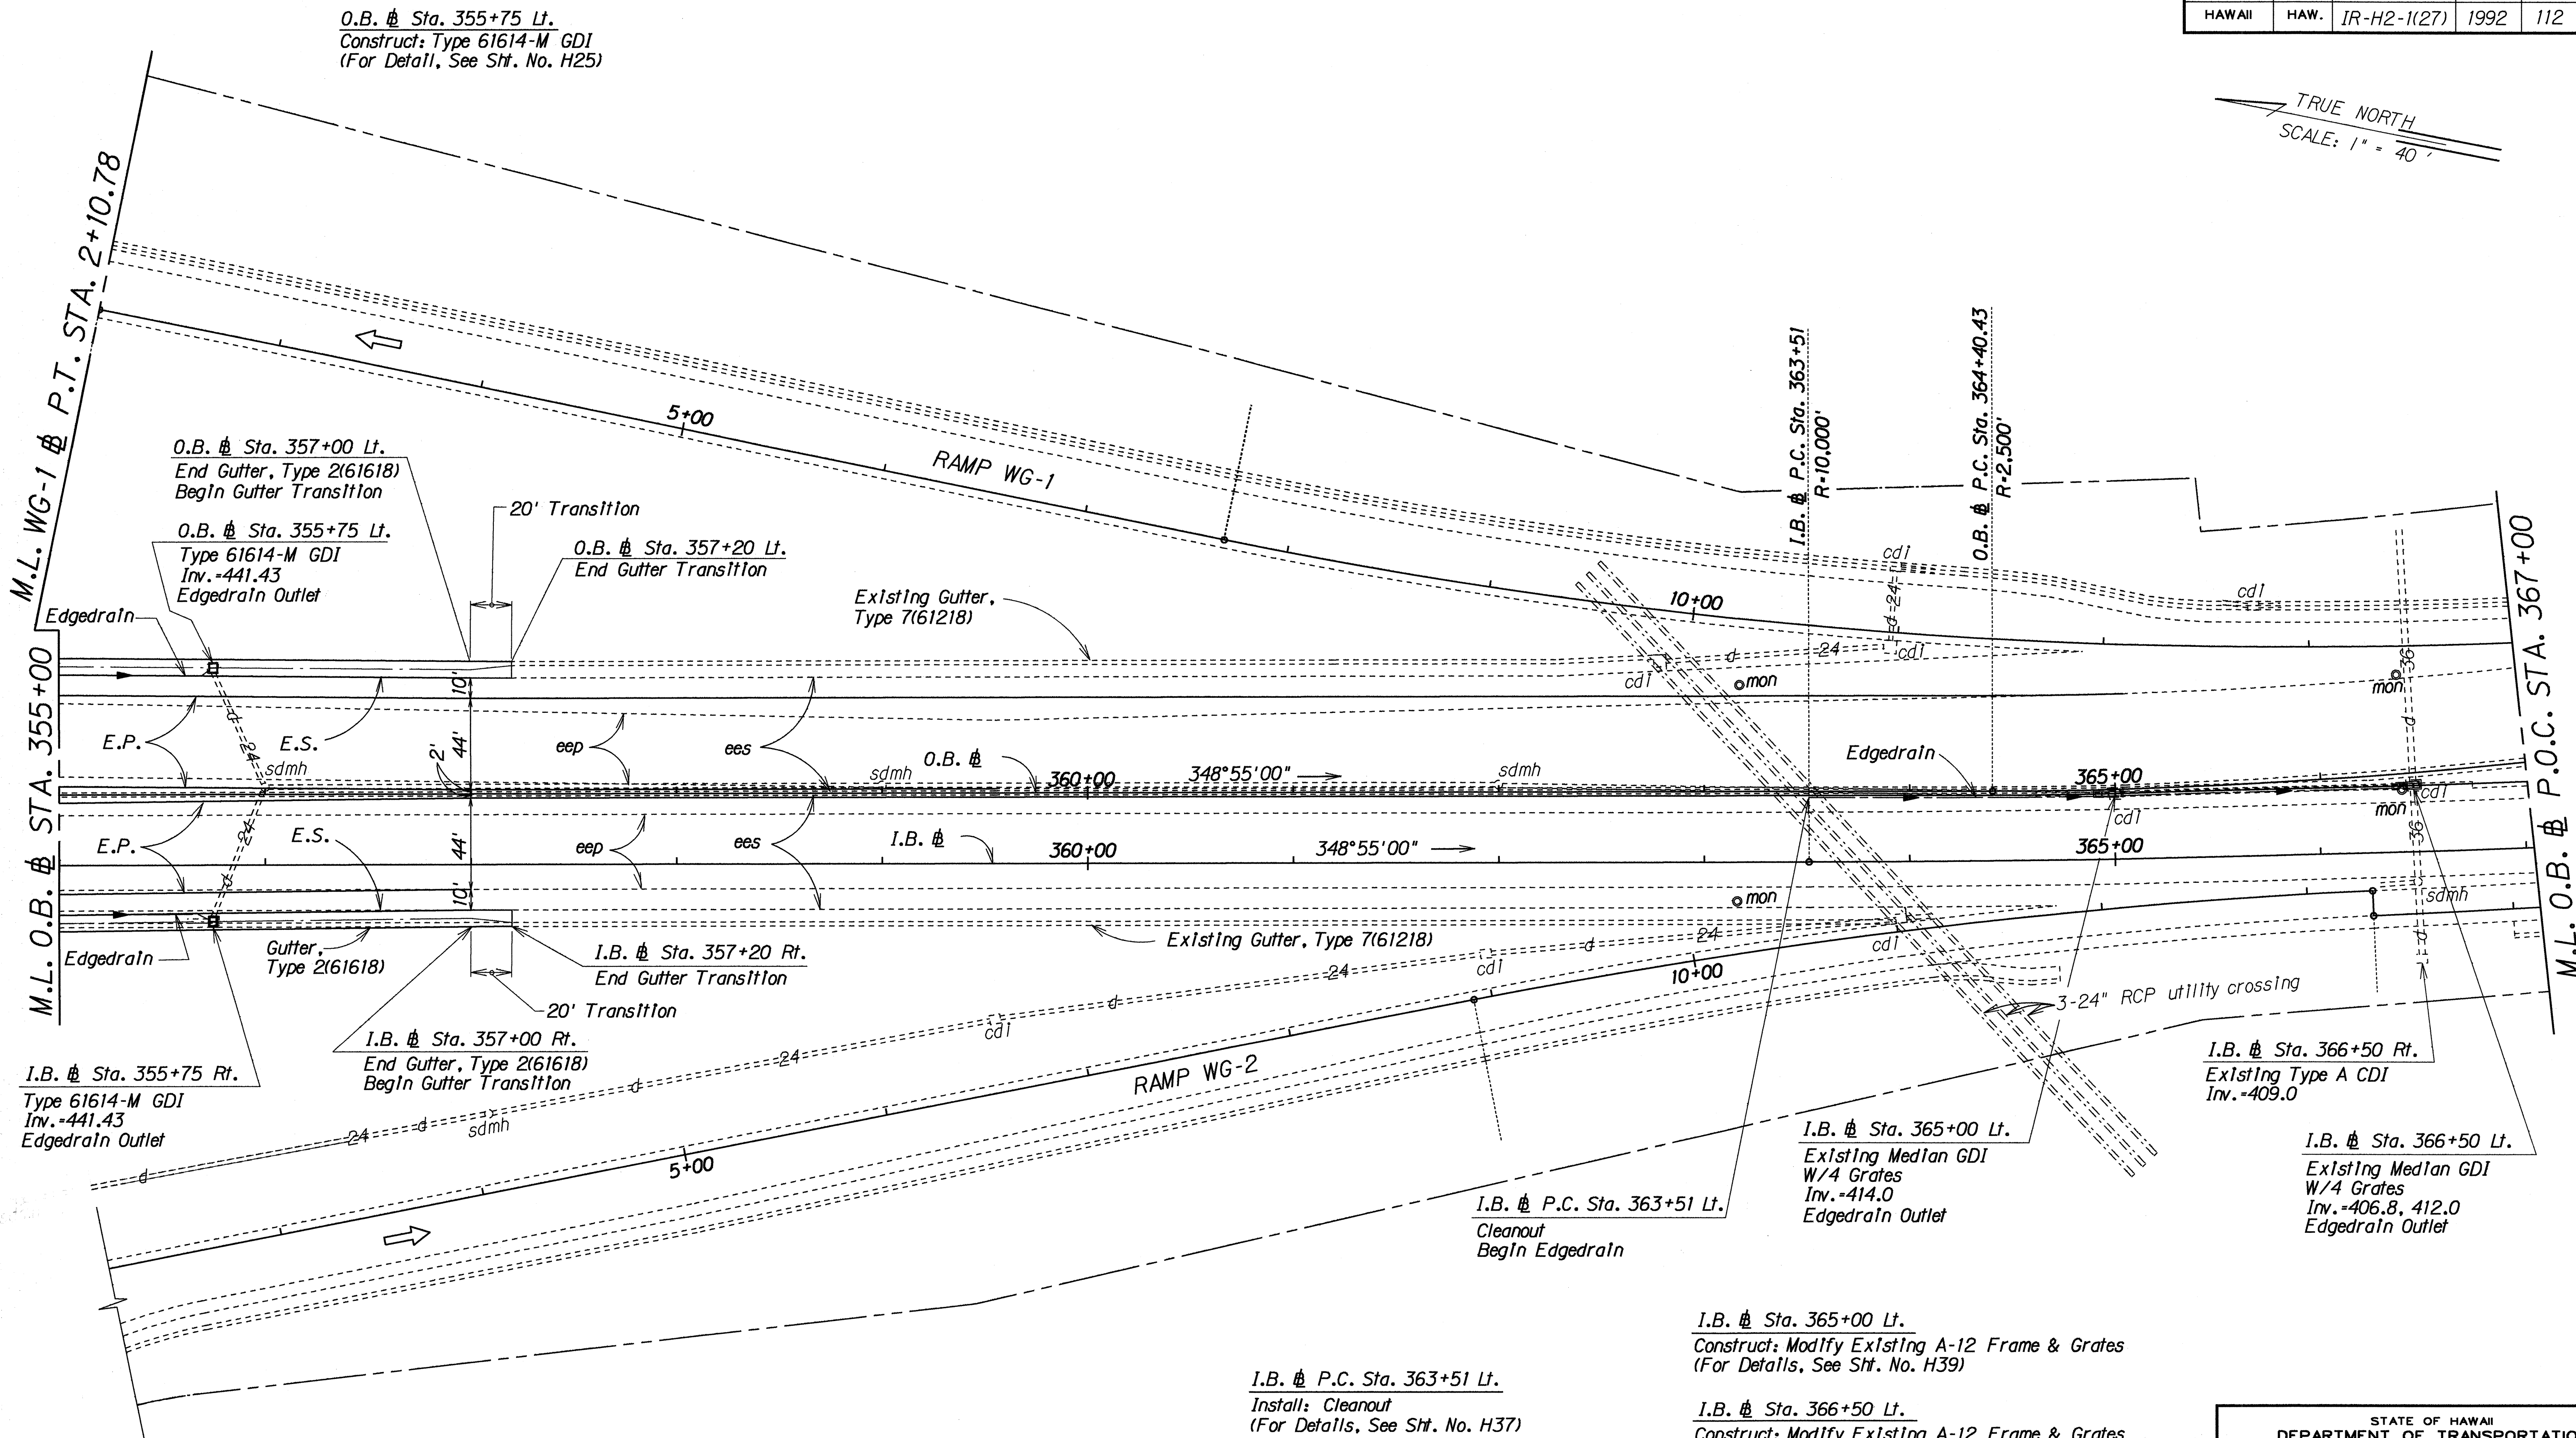

SURVEY PLOTTED BY	DATE
DESIGNED BY	
TRACED BY	
NOTE BOOK	
QUANTITIES BY	
CHECKED BY	

I.B. Sta. 355+75 Rt.
Construct: Type 61614-M GDI
(For Detail, See Sht. No. H25)

Construct: Gutter, Type 2(61618)
(See Typical Roadway Section For Detail)
O.B. Sta. 355+00 Lt. to O.B. Sta. 357+20 Lt.
I.B. Sta. 355+00 Rt. to O.B. Sta. 357+20 Rt.

I.B. P.C. Sta. 363+51 Lt.
Install: Cleanout
(For Details, See Sht. No. H37)

Install: Edgedrain
(See Typical Roadway Section For Detail)
O.B. Sta. 355+00 Lt. to O.B. Sta. 355+75 Lt.
I.B. Sta. 355+00 Rt. to I.B. Sta. 355+75 Lt.
I.B. P.C. Sta. 363+51 Lt. to I.B. Sta. 365+00 Lt.
I.B. Sta. 365+00 Lt. to I.B. Sta. 366+50 Lt.

I.B. Sta. 365+00 Lt.
Construct: Modify Existing A-12 Frame & Grates
(For Details, See Sht. No. H39)

I.B. Sta. 366+50 Lt.
Construct: Modify Existing A-12 Frame & Grates
(For Details, See Sht. No. H39)

DATE	REVISION
08/14/92	Edgedrains added Edgedrain Cleanout added

STATE OF HAWAII
DEPARTMENT OF TRANSPORTATION
HIGHWAYS DIVISION

DRAINAGE PLAN

INTERSTATE RTE. H-2, HOV LANES, PH. II
Millian Interchange to Waipio Interchange
F.A.I. PROJECT NO. IR-H2-1(27)

Scale: 1" = 40' Date: Apr., 1992

SHEET No. H21 OF 42 SHEETS

FED. ROAD DIST. NO.	STATE	FED. AID PROJ. NO.	FISCAL YEAR	SHEET NO.	TOTAL SHEETS
HAWAII	HAW.	IR-H2-1(27)	1992	113	223

TRUE NORTH
SCALE: 1" = 40'

O.B. @ Sta. 377+00 o/s 20' Rt.
Construct: Concrete Drop Inlet Cover
(For Details, See Sht. No. H35)

O.B. @ Sta. 378+70 Rt.
Begin Gutter, Type 2(61618)
Provide Smooth Connection to
Existing Gutter Type 2(61618)

O.B. # Sta. 369+50 Lt.
Existing Type 61614 GDI
Inv.=406.0

I.B. @ Sta. 368+80 Lt.
Begin Gutter, Type 2(61618)

O.B. Sta. 376+50 Lt.
Existing Type 61614 GDI
Inv.=394.5

Existing Concrete Retaining Wall

Existing Gutter, Type 2(61616)

O.B. @ Sta. 377+00 Rt.
Existing Type 61614 GDI
Inv. = 392.0

O.B. @ Sta. 377+00 o/s 20' Rt.
Modified Type "B" CDI
Inv. = 399.0

I.B. # Sta. 377+00 Rt.
Existing Type 61614 GDI
Inv.=399.8

I.B. Sta. 377+00 Rt.
Existing CDI
Inv.=400.0

I.B. ~~4~~ Sta. 373+55 Lt.
End Gutter, Type 2(61618)
Connect to Existing Swale

Construct: Gutter, Type 2(61618)
(See Typical Roadway Section For Detail)

I.B. $\frac{1}{2}$ Sta. 368+80 Lt. to I.B. $\frac{1}{2}$ Sta. 373+55 Lt.
O.B. $\frac{1}{2}$ Sta. 378+70 Rt. to O.B. $\frac{1}{2}$ Sta. 378+90.50 Rt.

Begin Taper

Existing Concrete Retaining Wall

M.L. O.B. ~~£~~ P.O.C. STA. 367+00

M.L. I.B. $\notin$ P.O.C. STA. 379+00 M.L. O.B. $\notin$ P.C. S/A. 378+30.33

ORIGINAL PLAN	SURVEY PLOTTED BY _____ DATE _____
NOTE BOOK	DRAWN BY _____ *
	TRACED BY _____ *
	DESIGNED BY _____ *
	QUANTITIES BY _____ *
N. _____	CHECKED BY _____

STATE OF HAWAII
DEPARTMENT OF TRANSPORTATION
HIGHWAYS DIVISION

DRAINAGE PLAN

INTERSTATE RTE. H-2, HOV LANES, PH. II
Millioni Interchange to Walpole Interchange
F.A.I. PROJECT NO. IR-H2-1(27)

Scale: 1" = 40'

Date: Apr., 1992

SHEET No. H22OF 42 SHEETS


10/25/93 Extend gutter Type 2(61618)

DATE _____

REVISION

FED. ROAD DIST. NO.	STATE	FED. AID PROJ. NO.	FISCAL YEAR	SHEET NO.	TOTAL SHEETS
HAWAII	HAW.	IR-H2-1(27)	1992	114	223

TRUE NORTH
SCALE: 1" = 40'

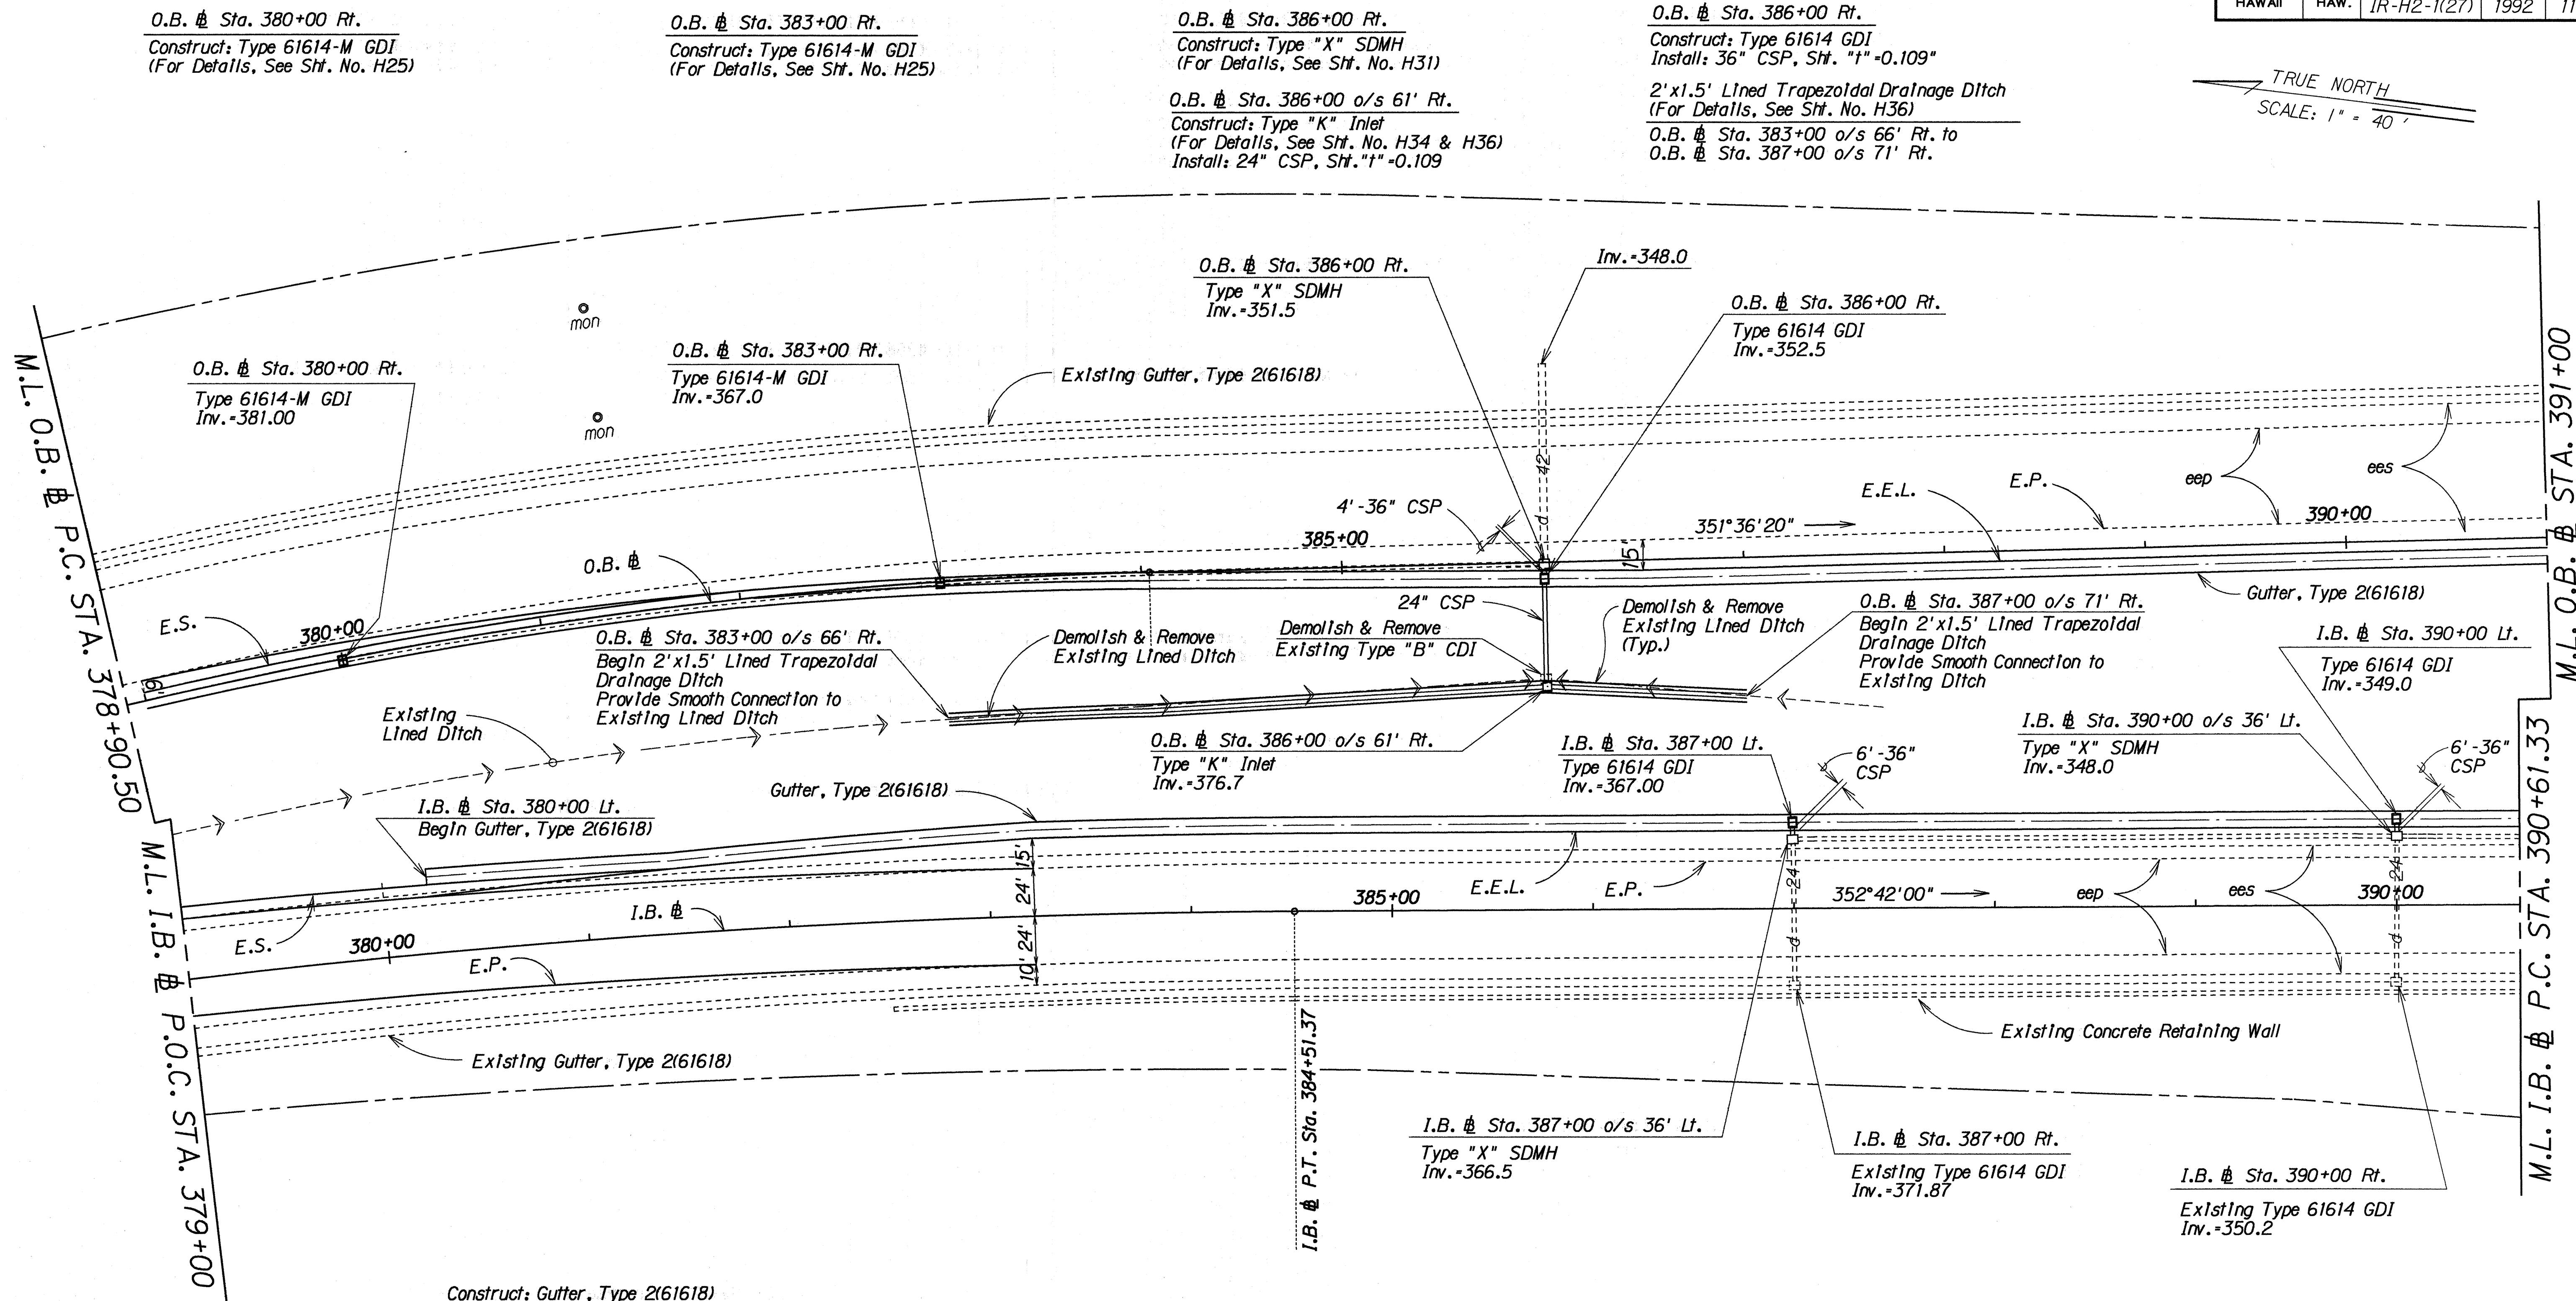

O.B. Sta. 380+00 Rt.
Construct: Type 61614-M GDI
(For Details, See Sht. No. H25)

O.B. Sta. 383+00 Rt.
Construct: Type 61614-M GDI
(For Details, See Sht. No. H25)

O.B. Sta. 386+00 Rt.
Construct: Type "X" SDMH
(For Details, See Sht. No. H31)

O.B. Sta. 386+00 Rt.
Construct: Type 61614 GDI
Install: 36" CSP, Sht. "t"=0.109"

O.B. Sta. 386+00 o/s 61' Rt.
Construct: Type "K" Inlet
(For Details, See Sht. No. H34 & H36)
Install: 24" CSP, Sht. "t"=0.109

2'x1.5' Lined Trapezoidal Drainage Ditch
(For Details, See Sht. No. H36)
O.B. Sta. 383+00 o/s 66' Rt. to
O.B. Sta. 387+00 o/s 71' Rt.

Construct: Gutter, Type 2(61618)
(See Typical Roadway Section For Detail)
I.B. Sta. 380+00 Lt. to I.B. Sta. 390+61.33 Lt.
O.B. Sta. 378+90.50 Rt. to I.B. Sta. 391+00 Rt.

I.B. Sta. 387+00 Lt.
Construct: Type 61614 GDI
Install: 36" CSP, Sht. "t"=0.109"

I.B. Sta. 390+00 Lt.
Construct: Type 61614 GDI
Install: 36" CSP, Sht. "t"=0.019"

I.B. Sta. 387+00 o/s=36' Lt.
Construct: Type "X" SDMH
(For Details, See Sht. No. H31)

I.B. Sta. 390+00 o/s=36' Lt.
Construct: Type "X" SDMH
(For Details, See Sht. No. H31)

STATE OF HAWAII
DEPARTMENT OF TRANSPORTATION
HIGHWAYS DIVISION

DRAINAGE PLAN

INTERSTATE RTE. H-2, HOV LANES, PH. II
Millian Interchange to Waipio Interchange
F.A.I. PROJECT NO. IR-H2-1(27)


Scale: 1" = 40' Date: Apr., 1992

SHEET No. H23 OF 42 SHEETS

SURVEY PLOTTED BY	DATE
DESIGNED BY	
NOTED BY	
CHECKED BY	

FED. ROAD DIST. NO.	STATE	FED. AID PROJ. NO.	FISCAL YEAR	SHEET NO.	TOTAL SHEETS
HAWAII	HAW.	IR-H2-1(27)	1992	115	223

TRUE NORTH
SCALE: 1" = 40'

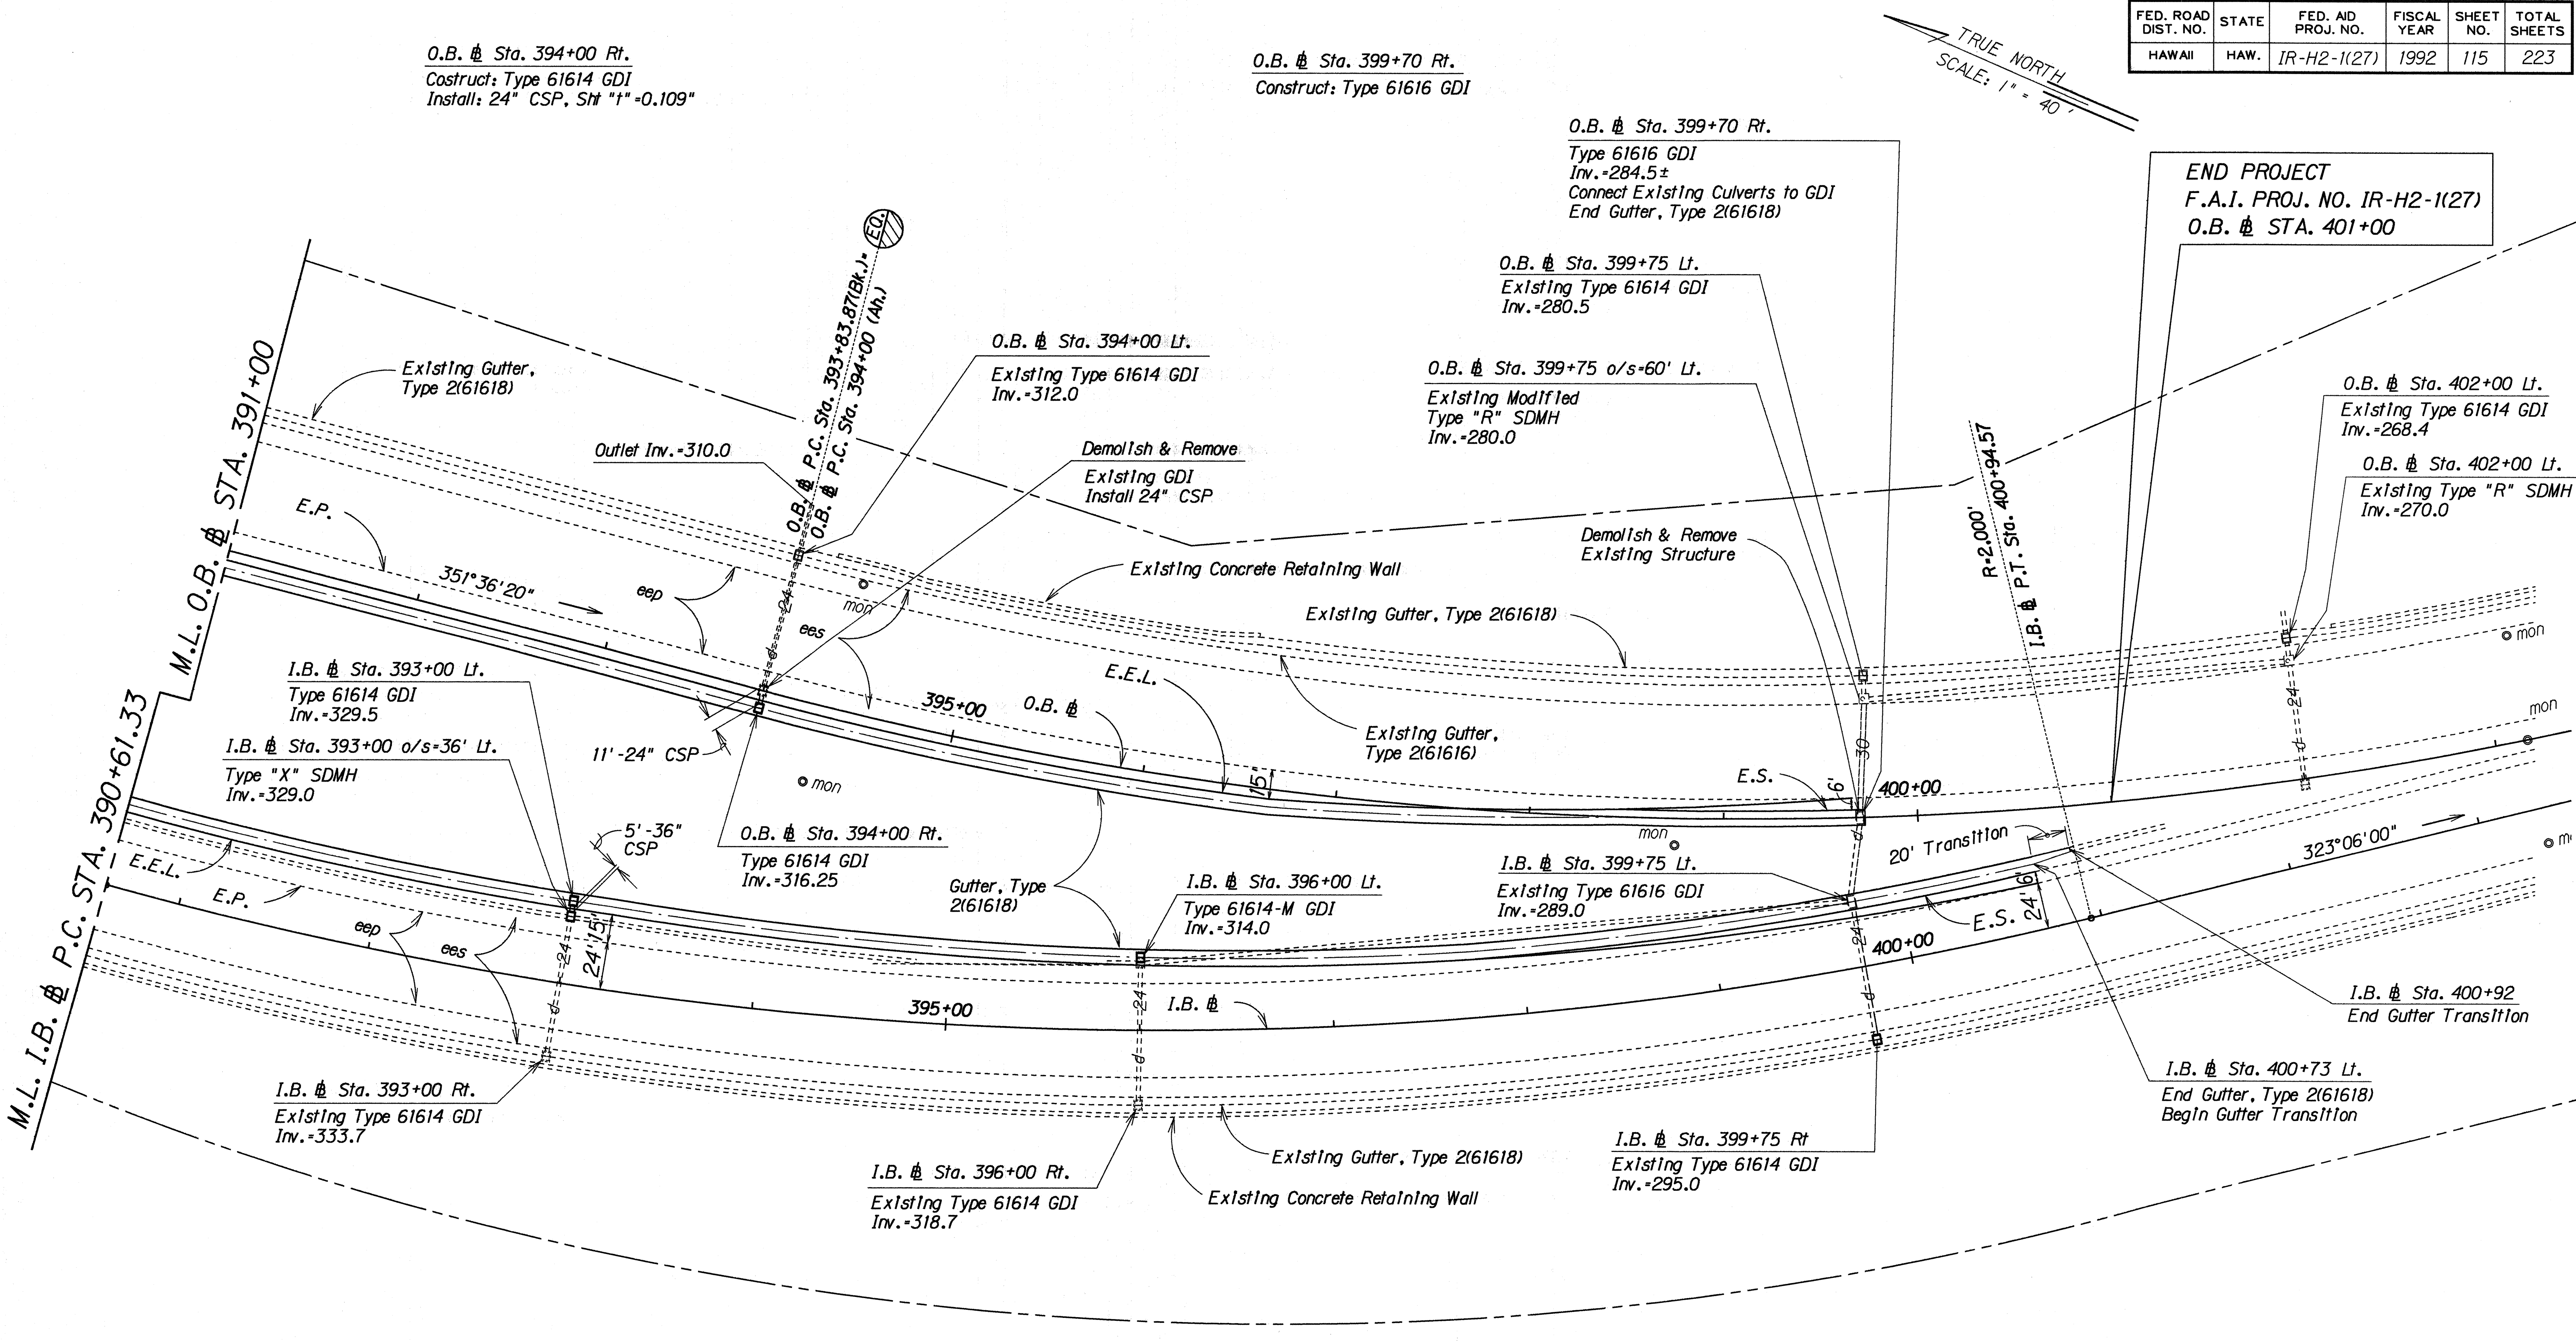

ORIGINAL PLAN	DATE
DESIGNED BY	
TRACED BY	
NOTE BOOK	
QUANTITIES BY	
CHECKED BY	

Construct: Gutter, Type 2(61618)
(See Typical Roadway Section For Detail)

I.B. Sta. 390+61.33 Lt. to I.B. Sta. 400+92 Lt.
O.B. Sta. 391+00 Rt. to O.B. Sta. 399+70 Rt.

I.B. Sta. 393+00 Lt.
Construct: Type 61614 GDI
Install: 36" CSP, Sht. "I" -0.109"

I.B. Sta. 393+00 o/s=36' Lt.
Construct: Type "X" SDMH
(For Details, See Sht. No. H31)

I.B. Sta. 396+00 Lt.
Construct: Type 61614-M GDI
(For Details, See Sht. No. H25)

STATE OF HAWAII
DEPARTMENT OF TRANSPORTATION
HIGHWAYS DIVISION


DRAINAGE PLAN

INTERSTATE RTE. H-2, HOV LANES, PH. II
Mililani Interchange to Waipio Interchange
F.A.I. PROJECT NO. IR-H2-1(27)

Scale: 1" = 40' Date: Apr., 1992
SHEET No. H24 OF 42 SHEETS

ORIGINAL PLAN	SURVEY PLOTTED BY _____ DATE _____
NOTE BOOK	DRAWN BY _____
	TRACED BY _____
	DESIGNED BY _____
	QUANTITIES BY _____
N. _____	CHECKED BY _____

ORIGINAL PLAN	SURVEY PLOTTED BY _____	DATE _____
NOTE BOOK	DRAWN BY _____	" _____
	TRACED BY _____	" _____
	DESIGNED BY _____	" _____
	QUANTITIES BY _____	" _____
N _o _____	CHECKED BY _____	" _____

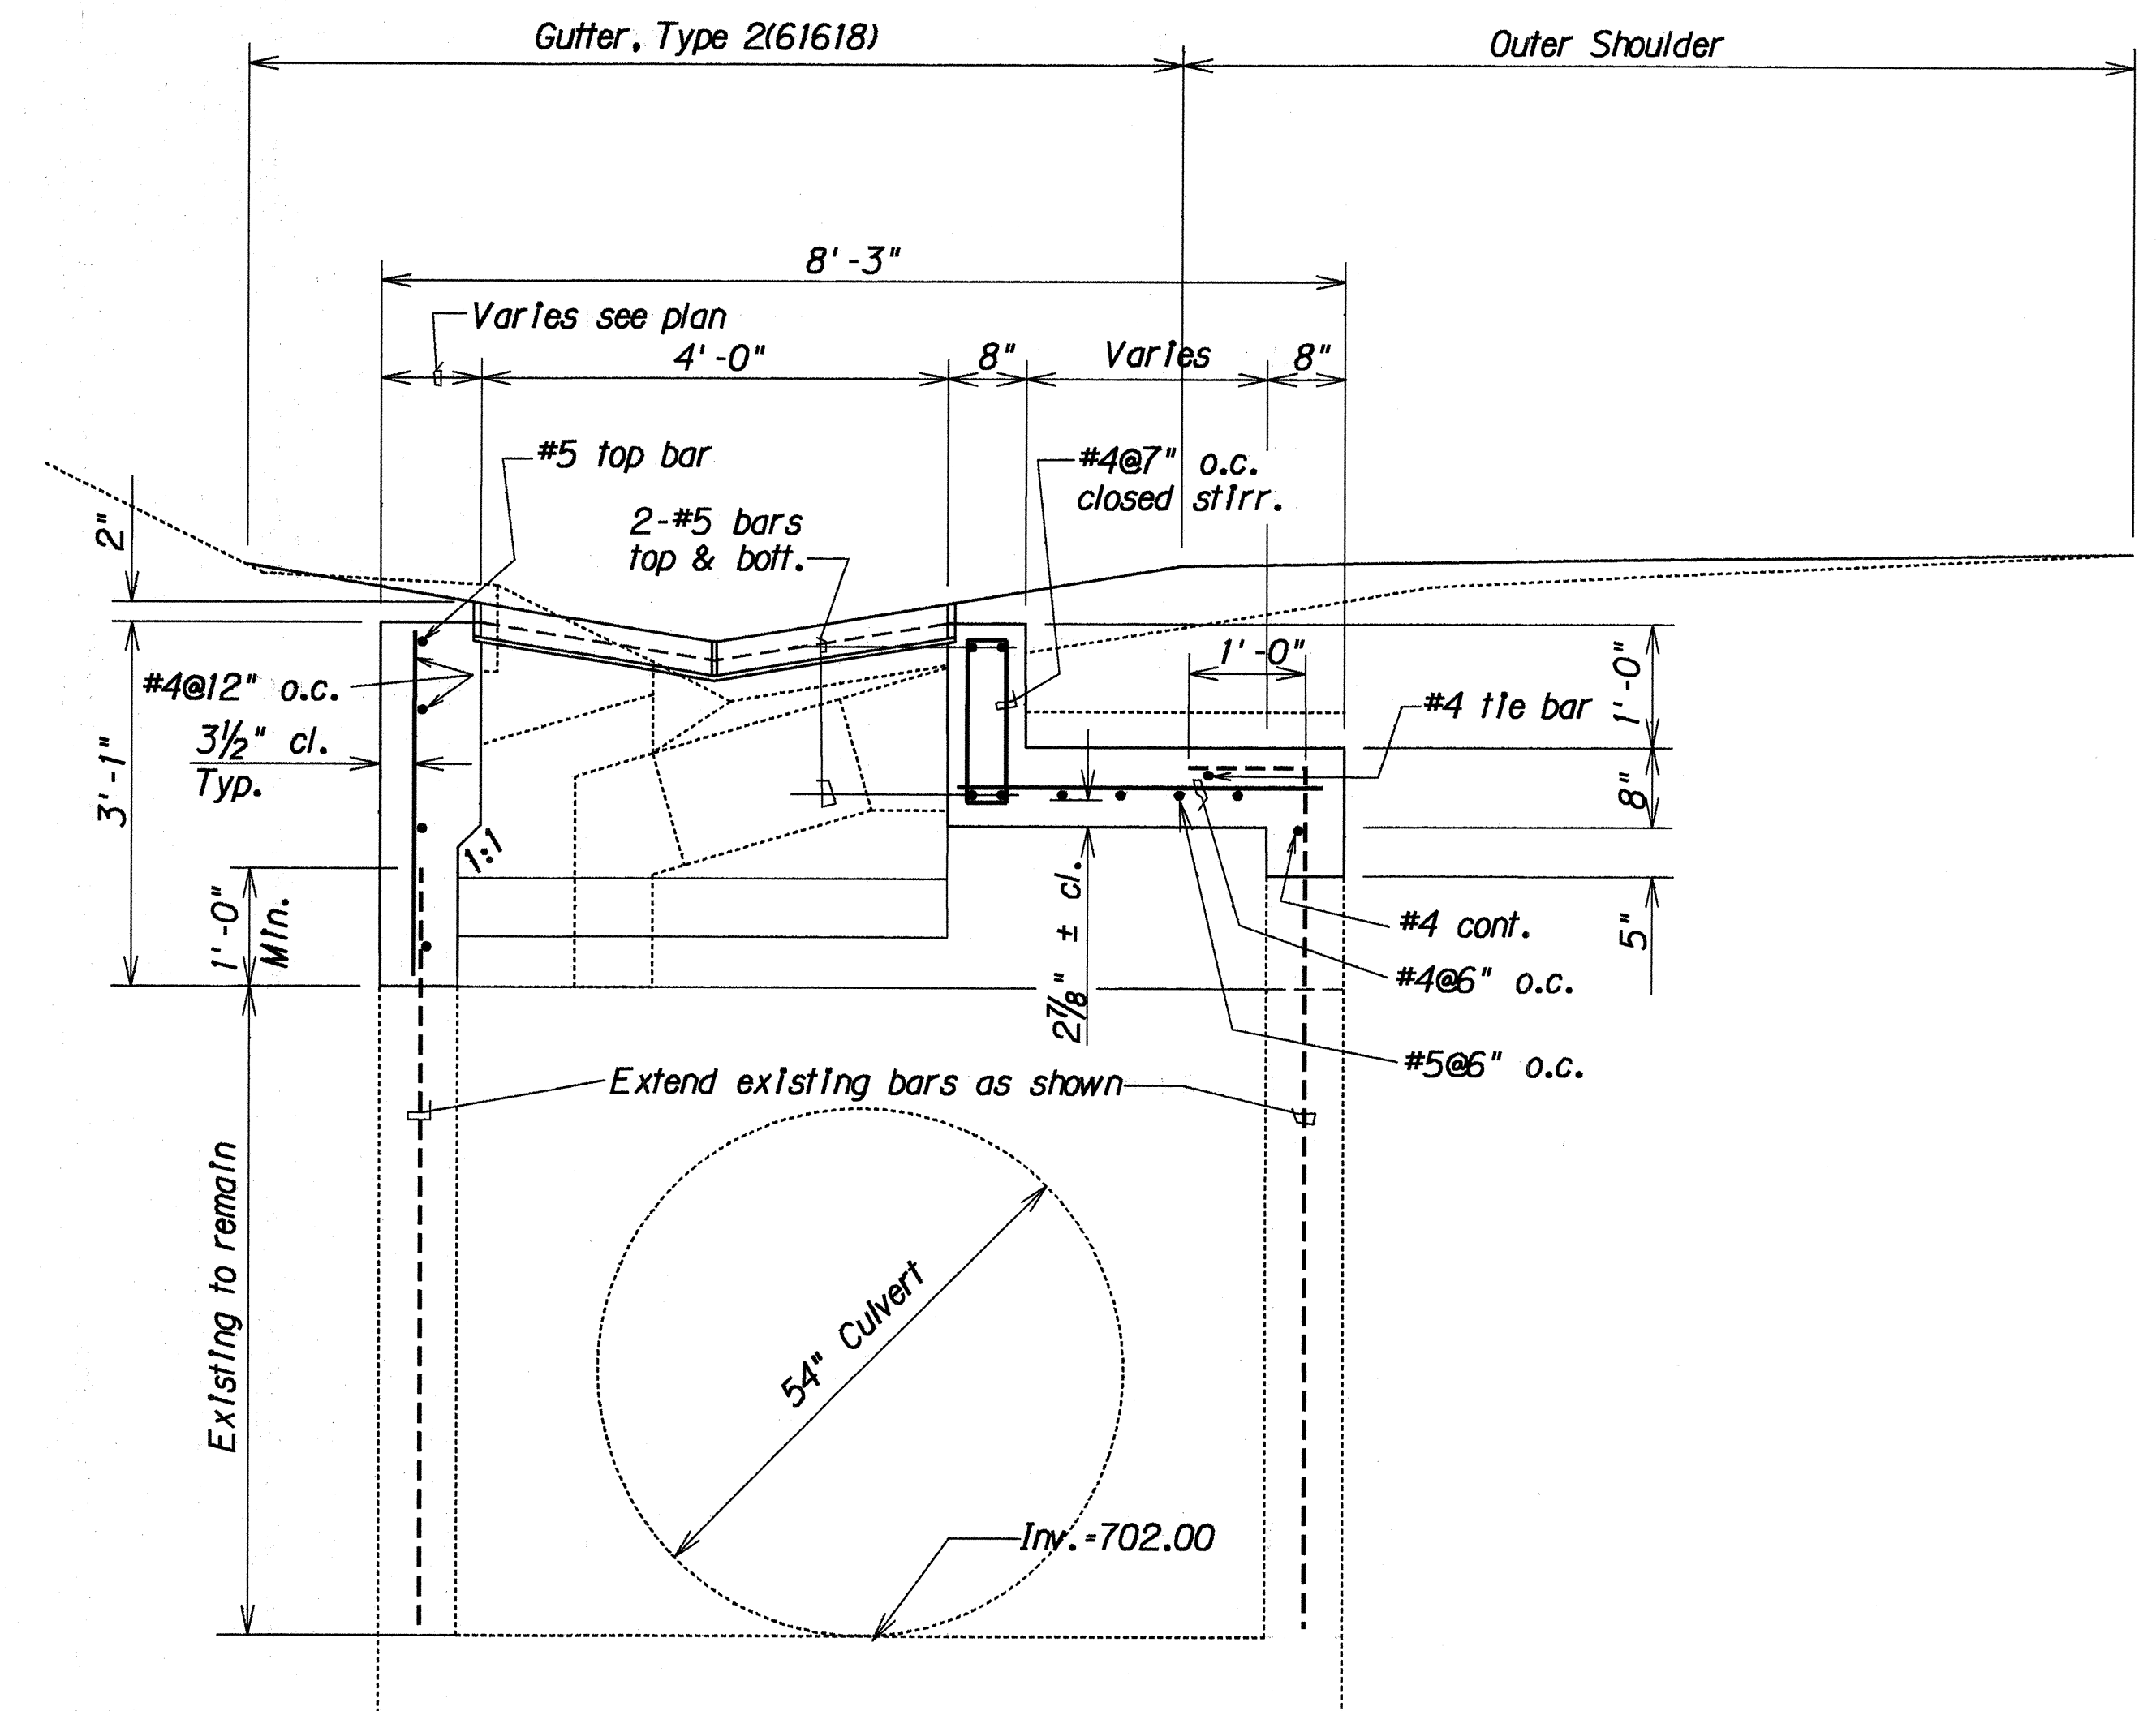

SECTION A

STATE OF HAWAII
DEPARTMENT OF TRANSPORTATION
HIGHWAYS DIVISION


DRAINAGE DETAILS

INTERSTATE RTE. H-2, HOV LANES, PH. II
Miliant Interchange to Waipio Interchange
F.A.I. PROJECT NO. IR-H2-1(27)


Scale: $\frac{3}{4}" = 1' - 0"$ Date: Apr., 1992

SHEET No. H26 OF 42 SHEETS


FED. ROAD DIST. NO.	STATE	FED. AID PROJ. NO.	FISCAL YEAR	SHEET NO.	TOTAL SHEETS
HAWAII	HAW.	IR-H2-1(27)	1992	118	223

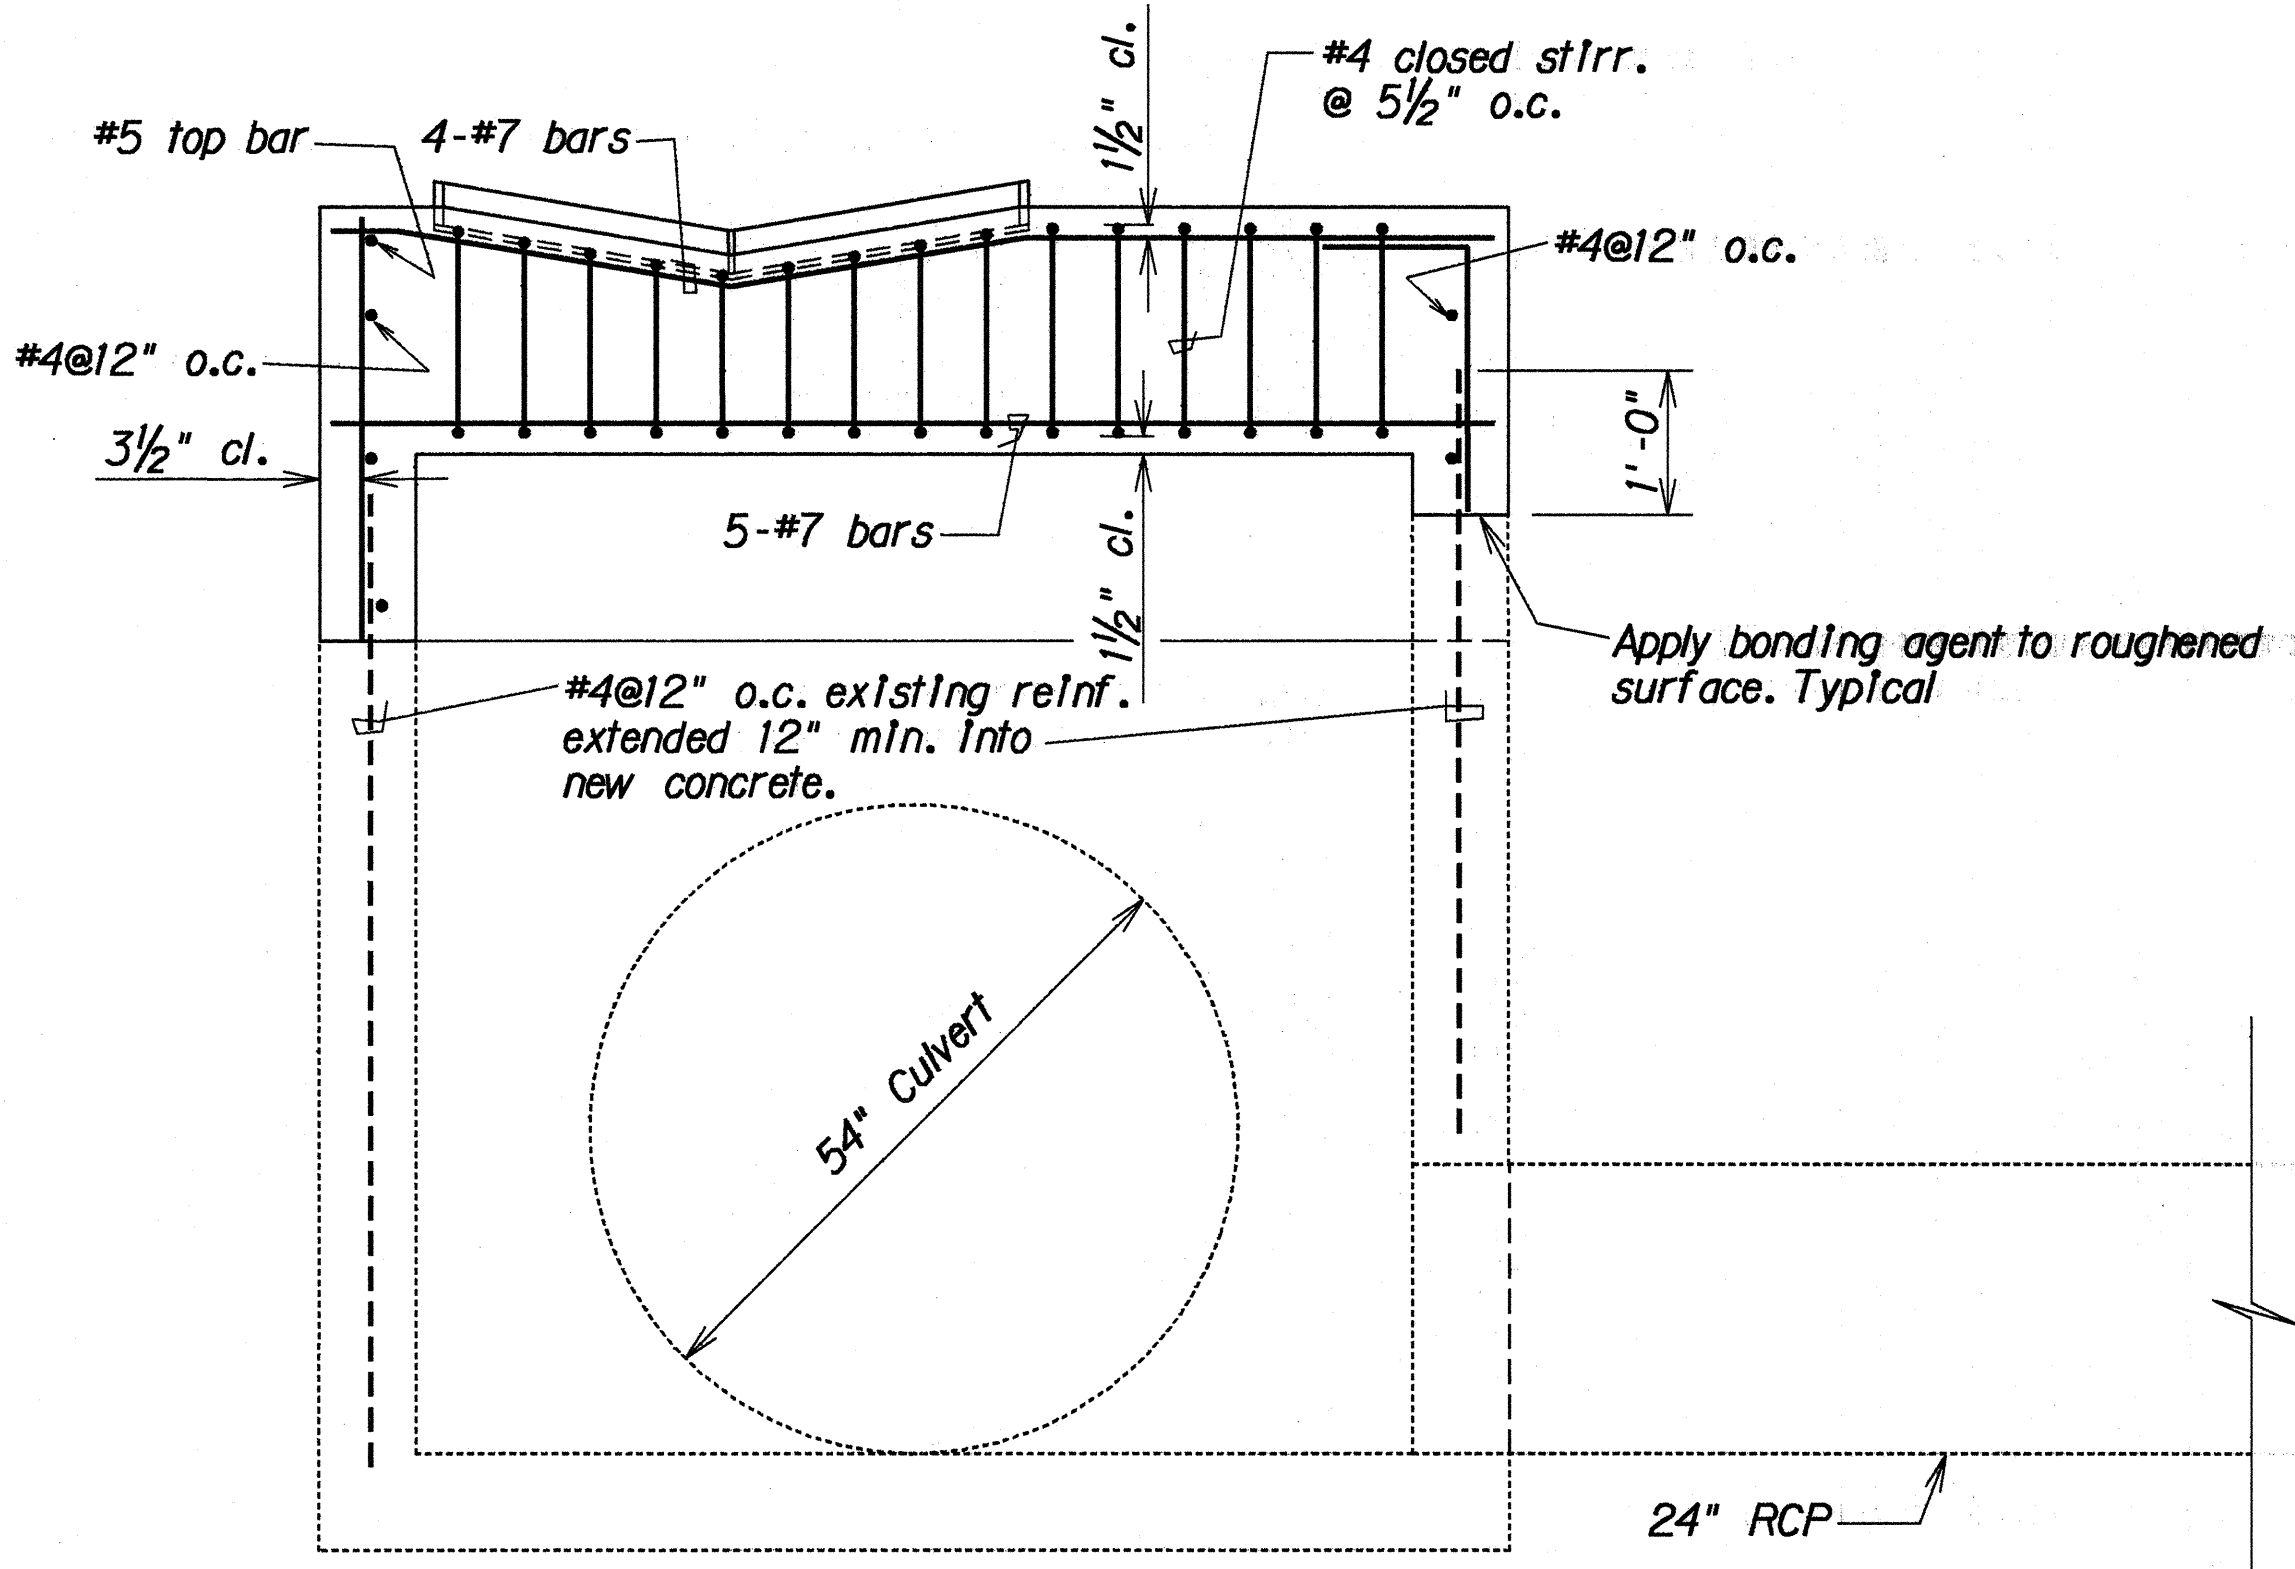

SECTION B
H26 H27

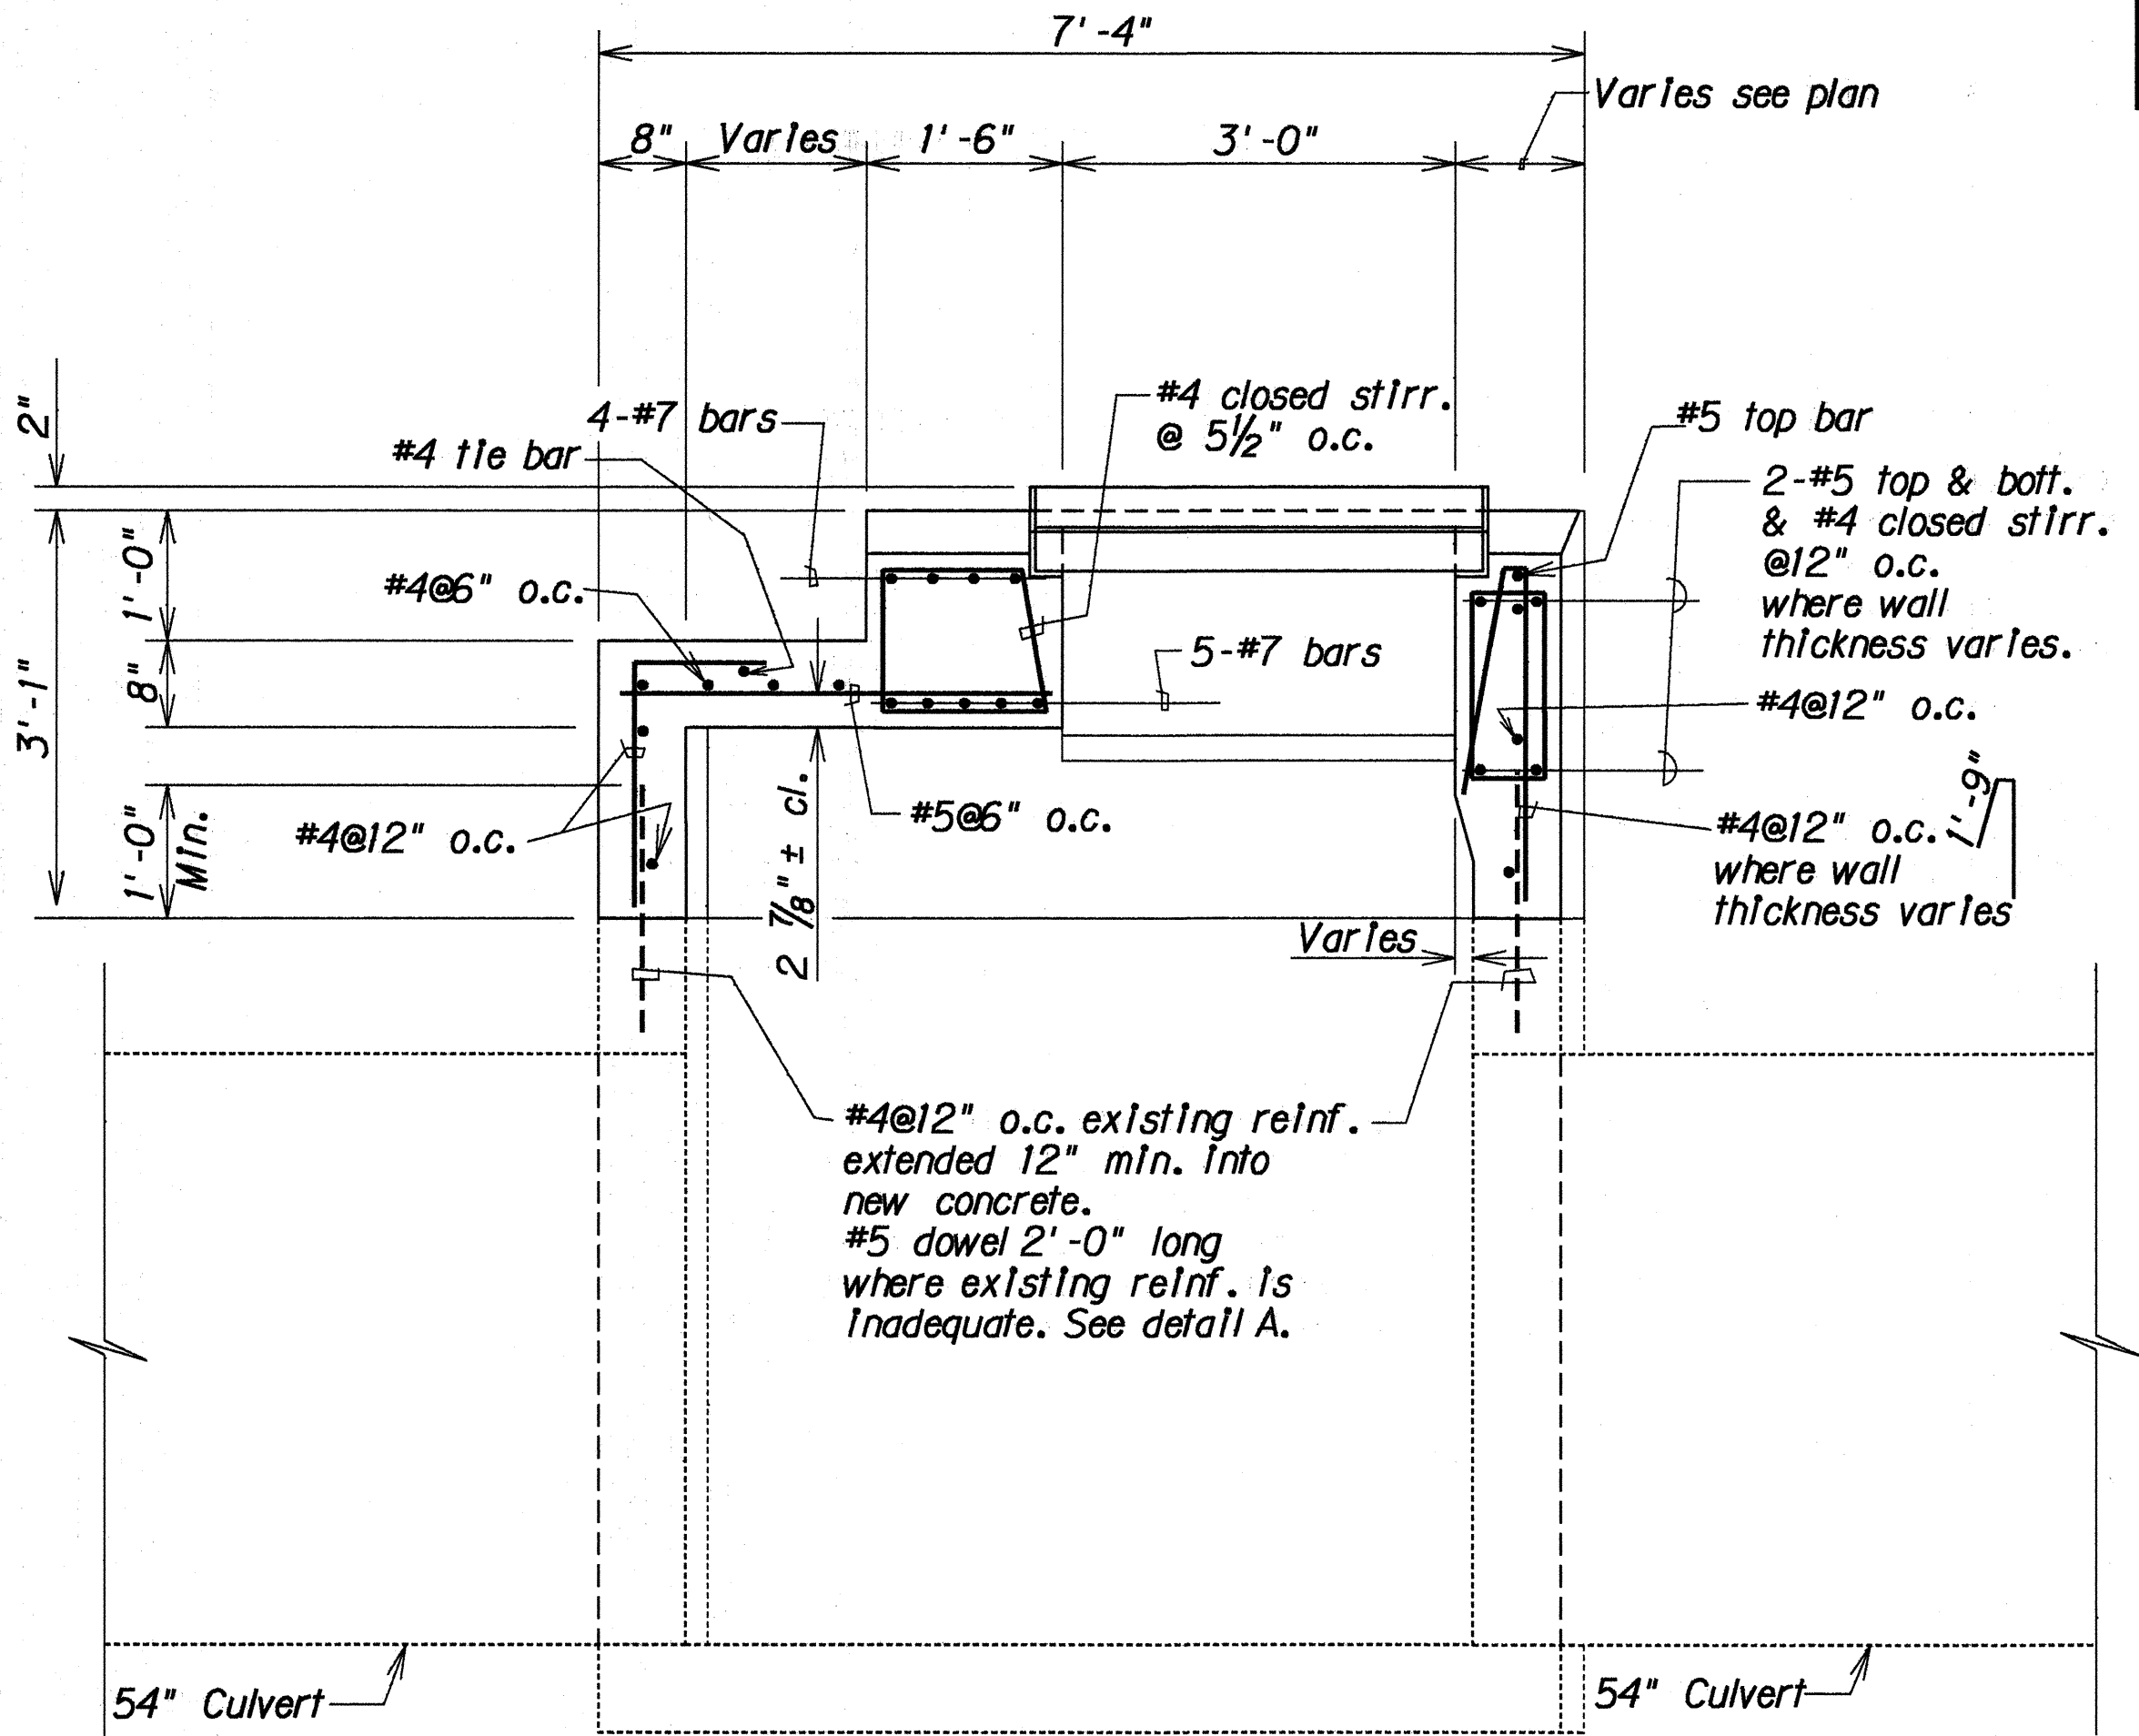

SECTION C
H26 H27

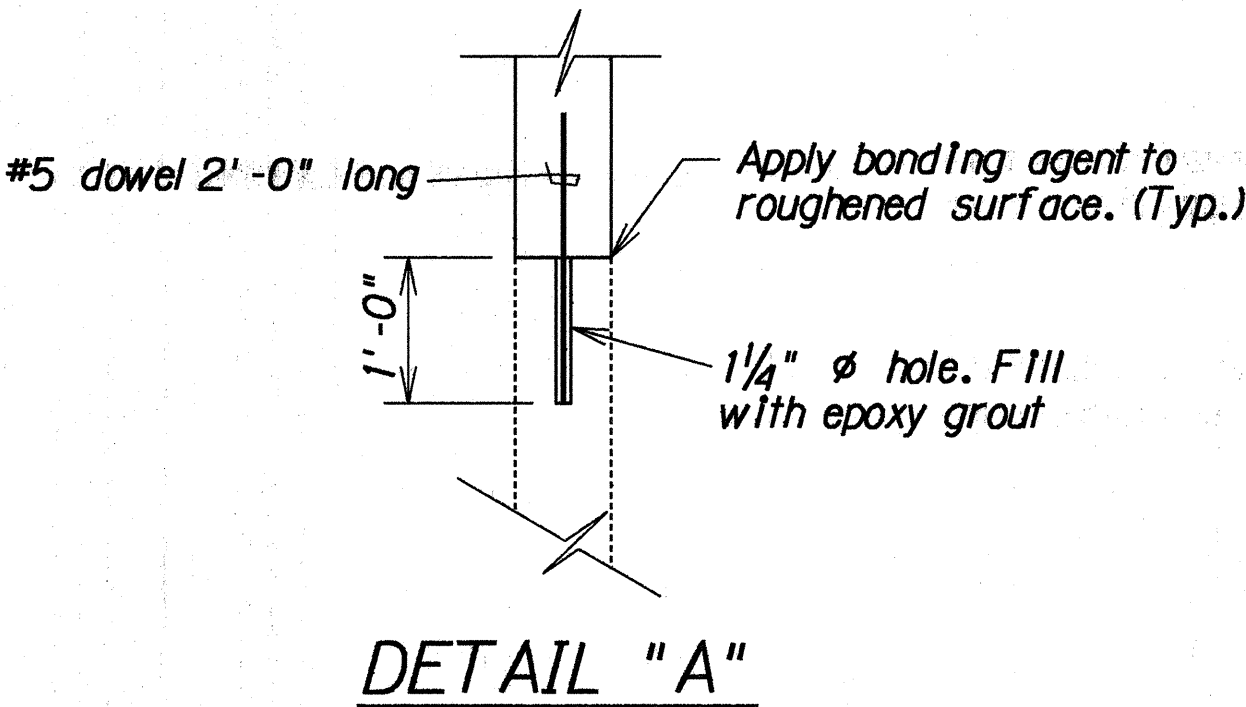


DETAILS OF TYPE 61614-N GDI AT O.B. @ STA. 209+00 LT.

ORIGINAL	SURVEY PLOTTED BY	DATE
PLAN	DRAWN BY	
NOTE BOOK	DESIGNED BY	
	QUANTITIES BY	
	CHECKED BY	


STATE OF HAWAII
DEPARTMENT OF TRANSPORTATION
HIGHWAYS DIVISION
DRAINAGE DETAILS
INTERSTATE RTE. H-2, HOV LANES, PH. II
Mililani Interchange to Waipio Interchange
F.A.I. PROJECT NO. IR-H2-1(27)

Scale: 3/4" = 1'-0" Date: Apr., 1992
SHEET No. H27 OF 42 SHEETS


FED. ROAD DIST. NO.	STATE	FED. AID PROJ. NO.	FISCAL YEAR	SHEET NO.	TOTAL SHEETS
HAWAII	HAW.	IR-H2-1(27)	1992	119	223

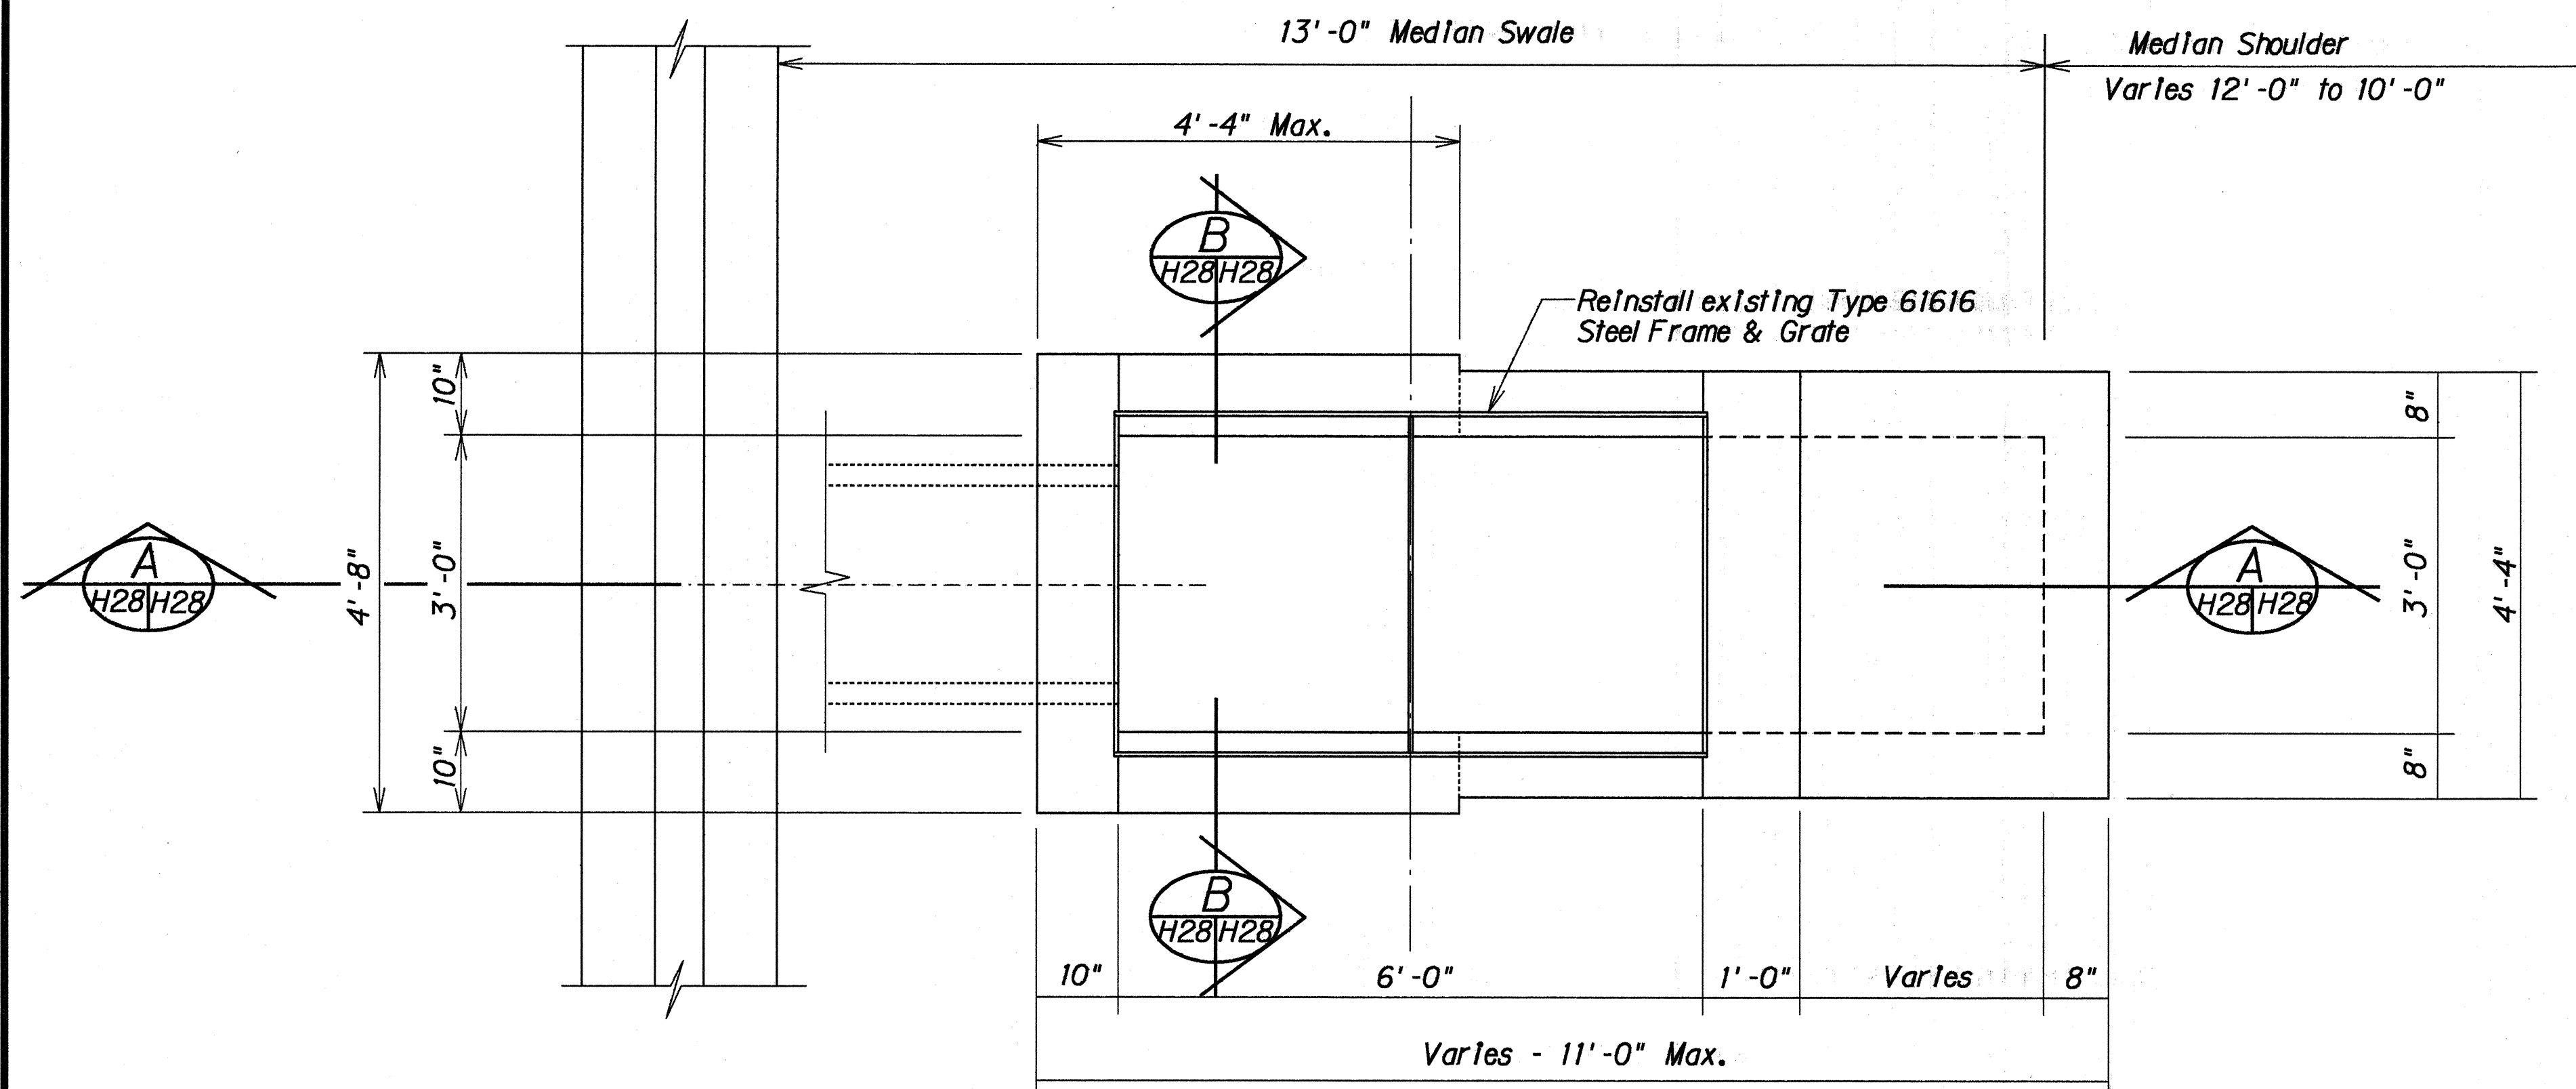


PLAN

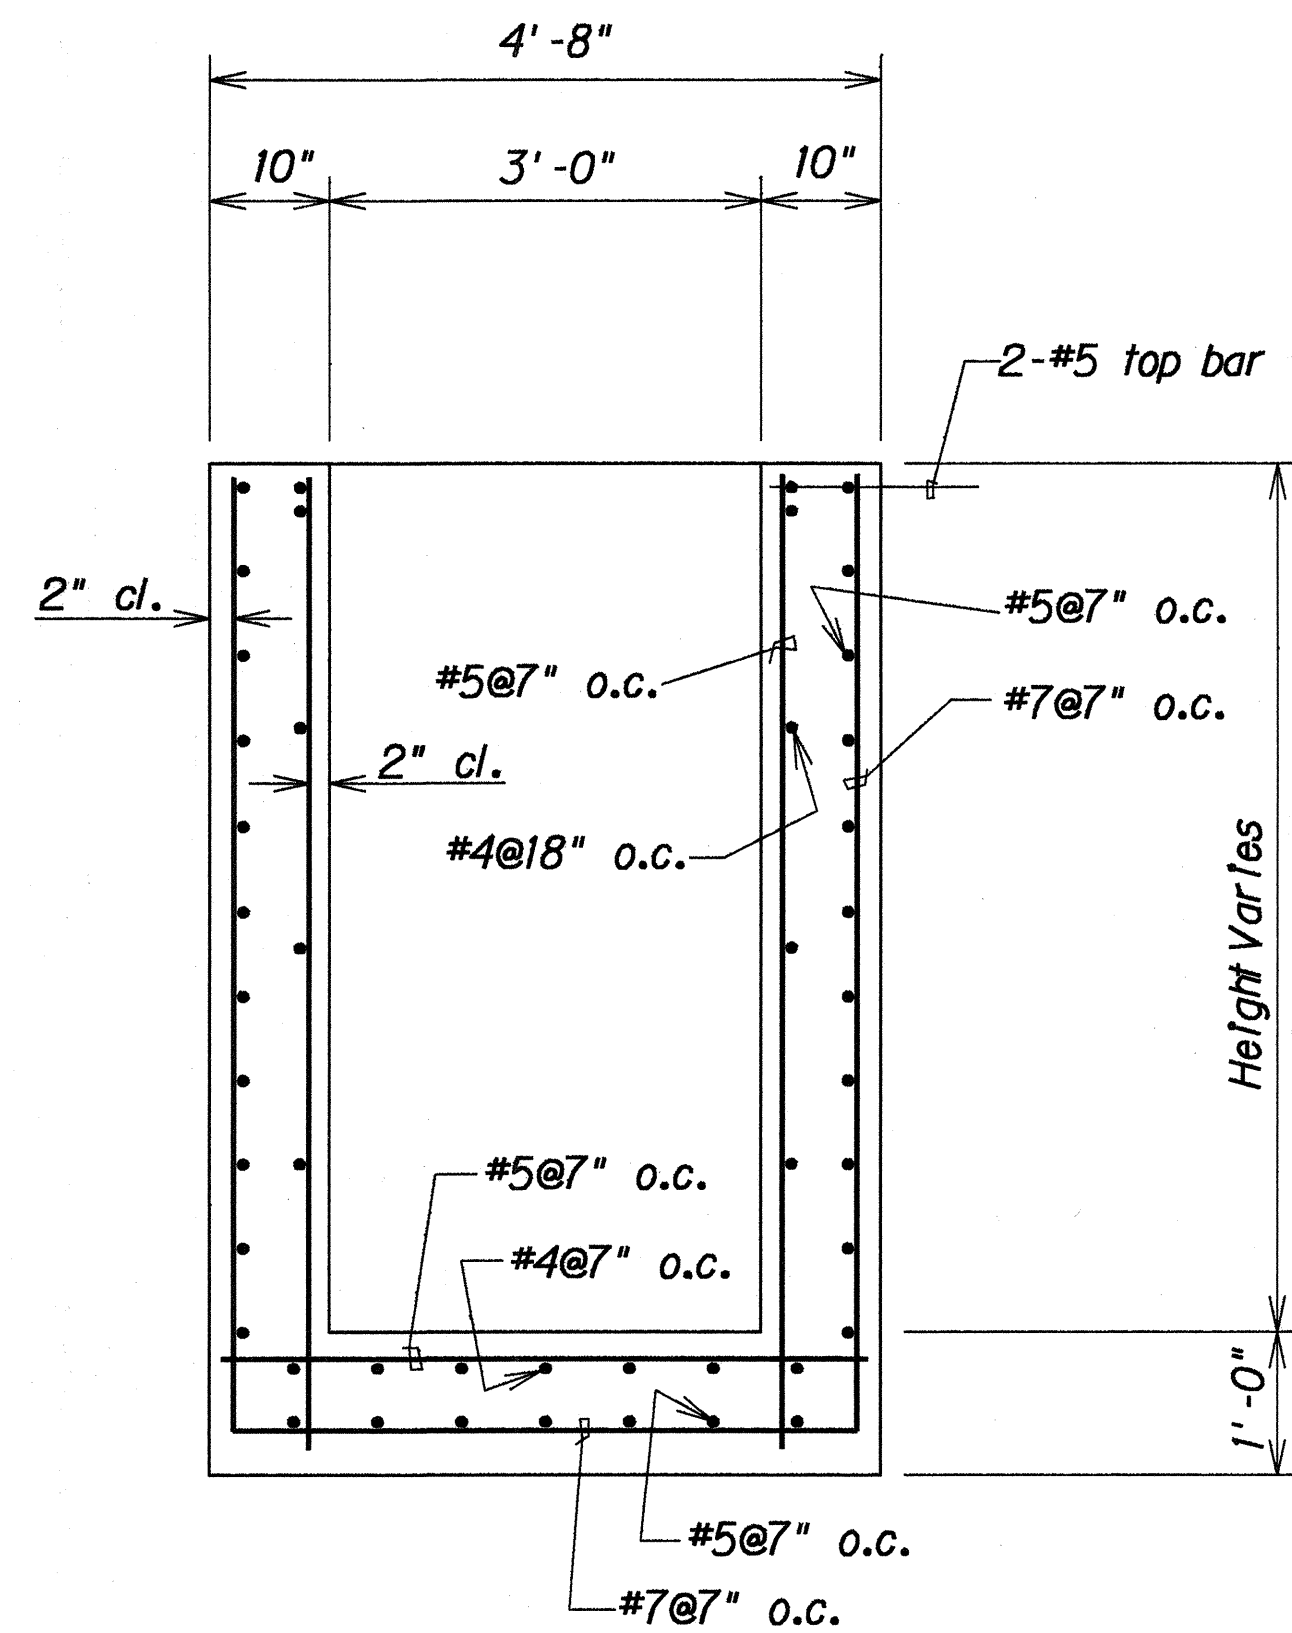


SECTION B
H28/H28

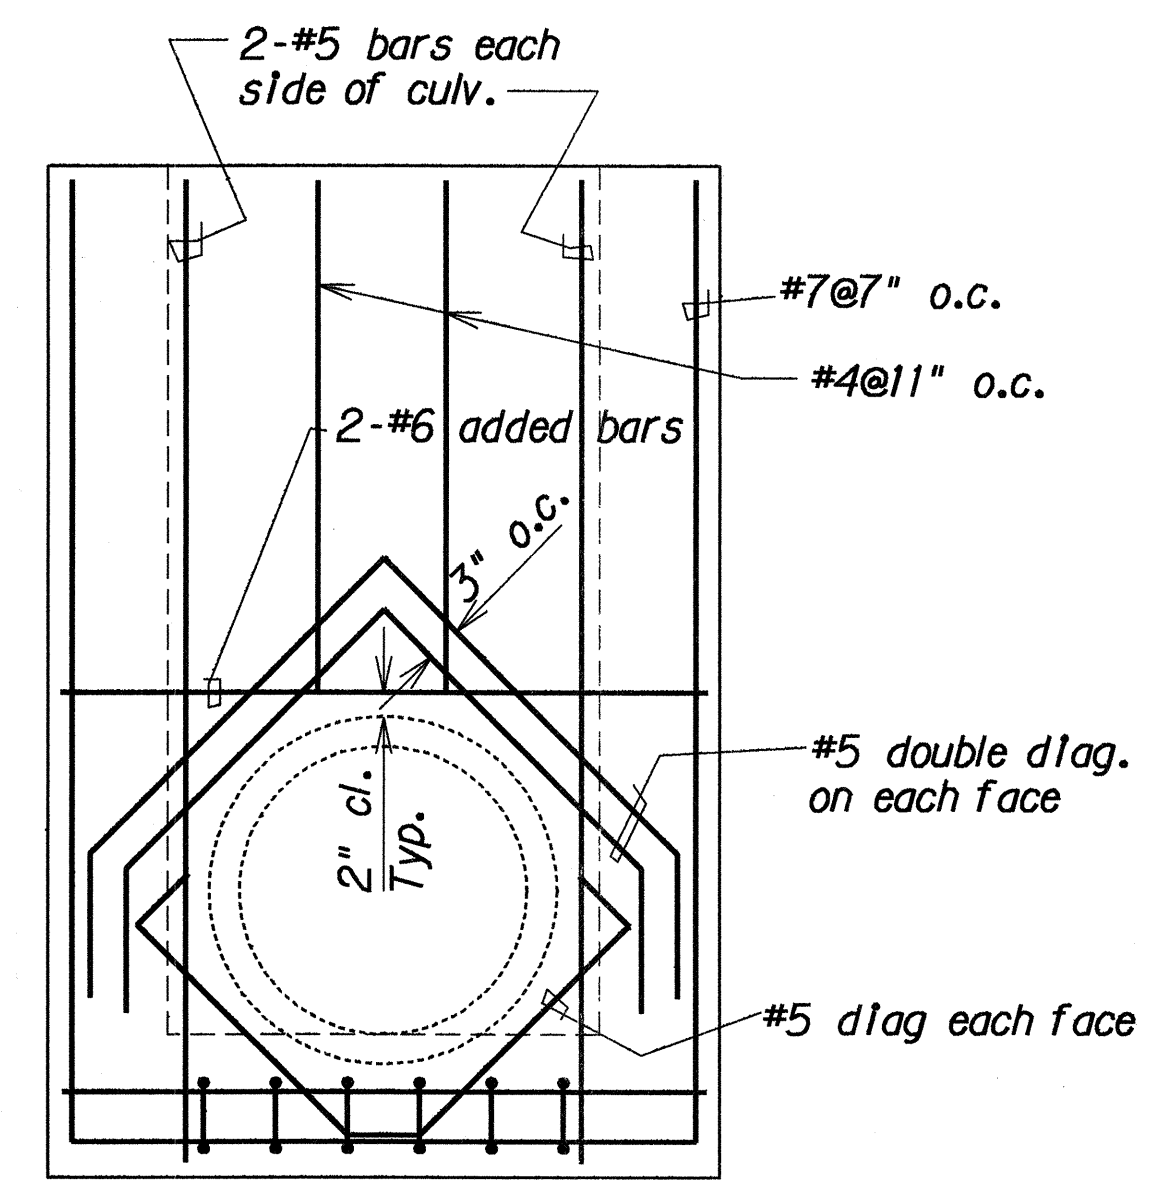

ADDED REINFORCING
AROUND CULVERT

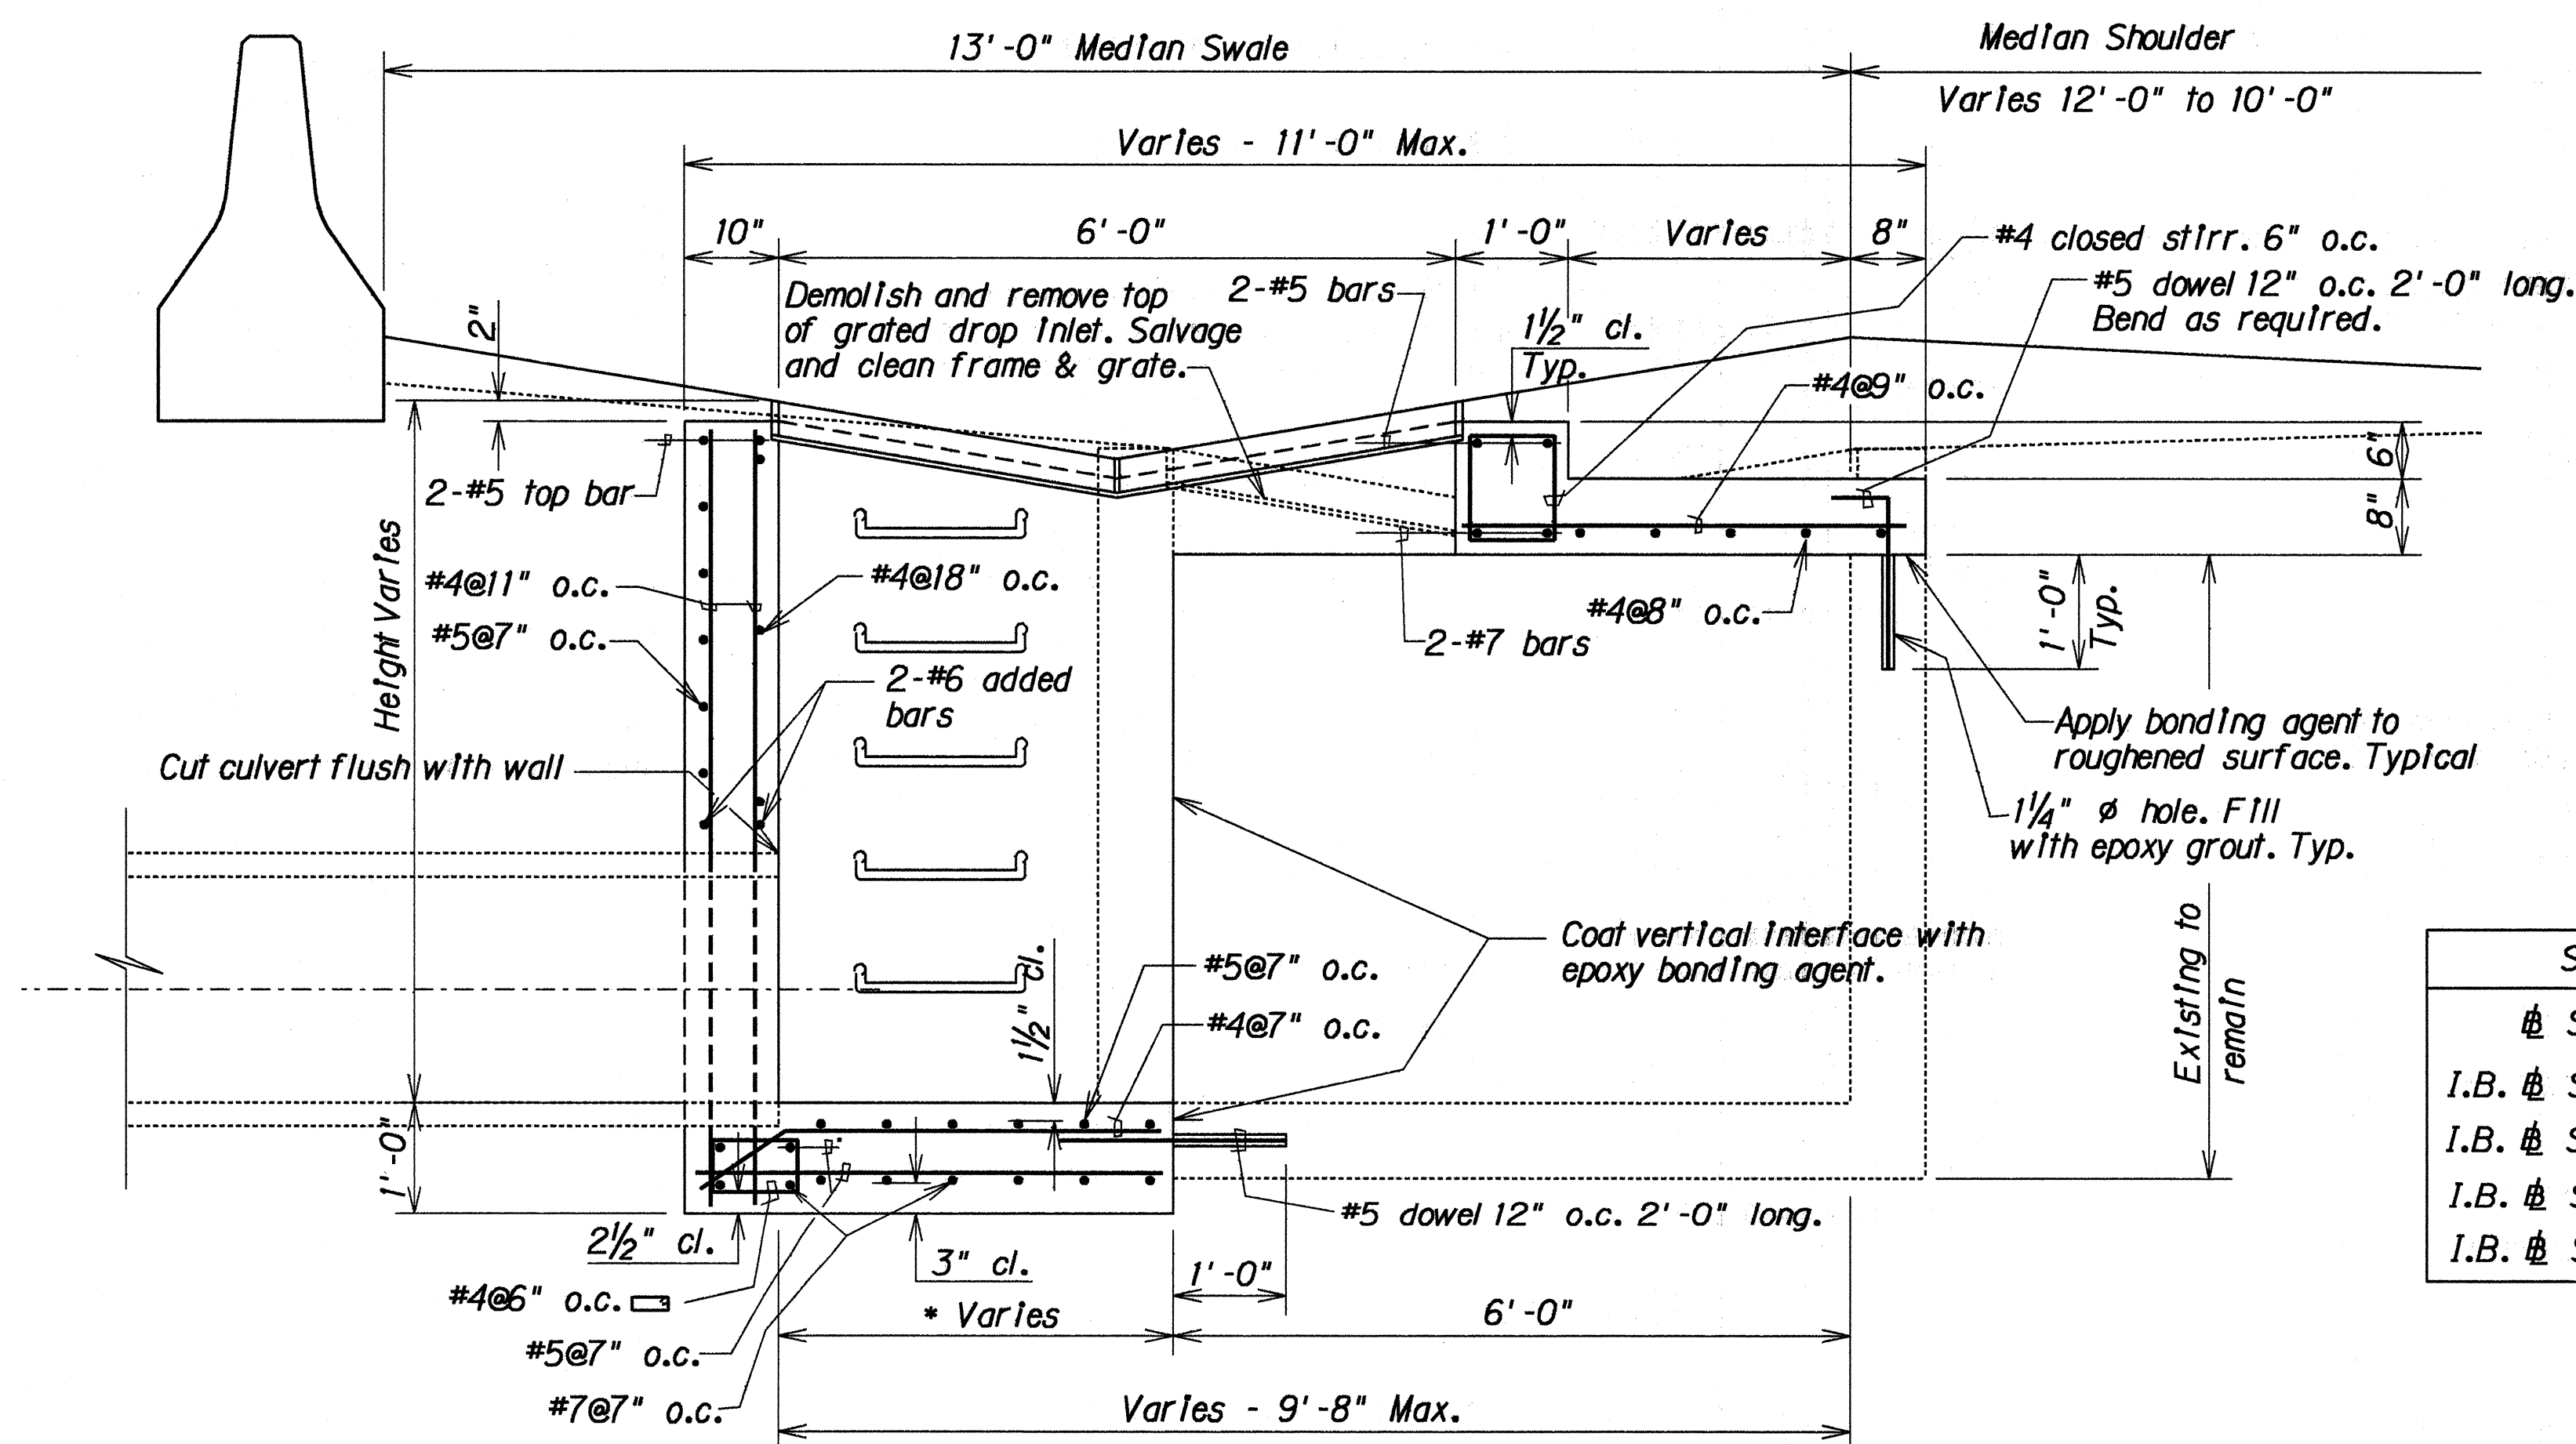

SECTION A
H28/H28

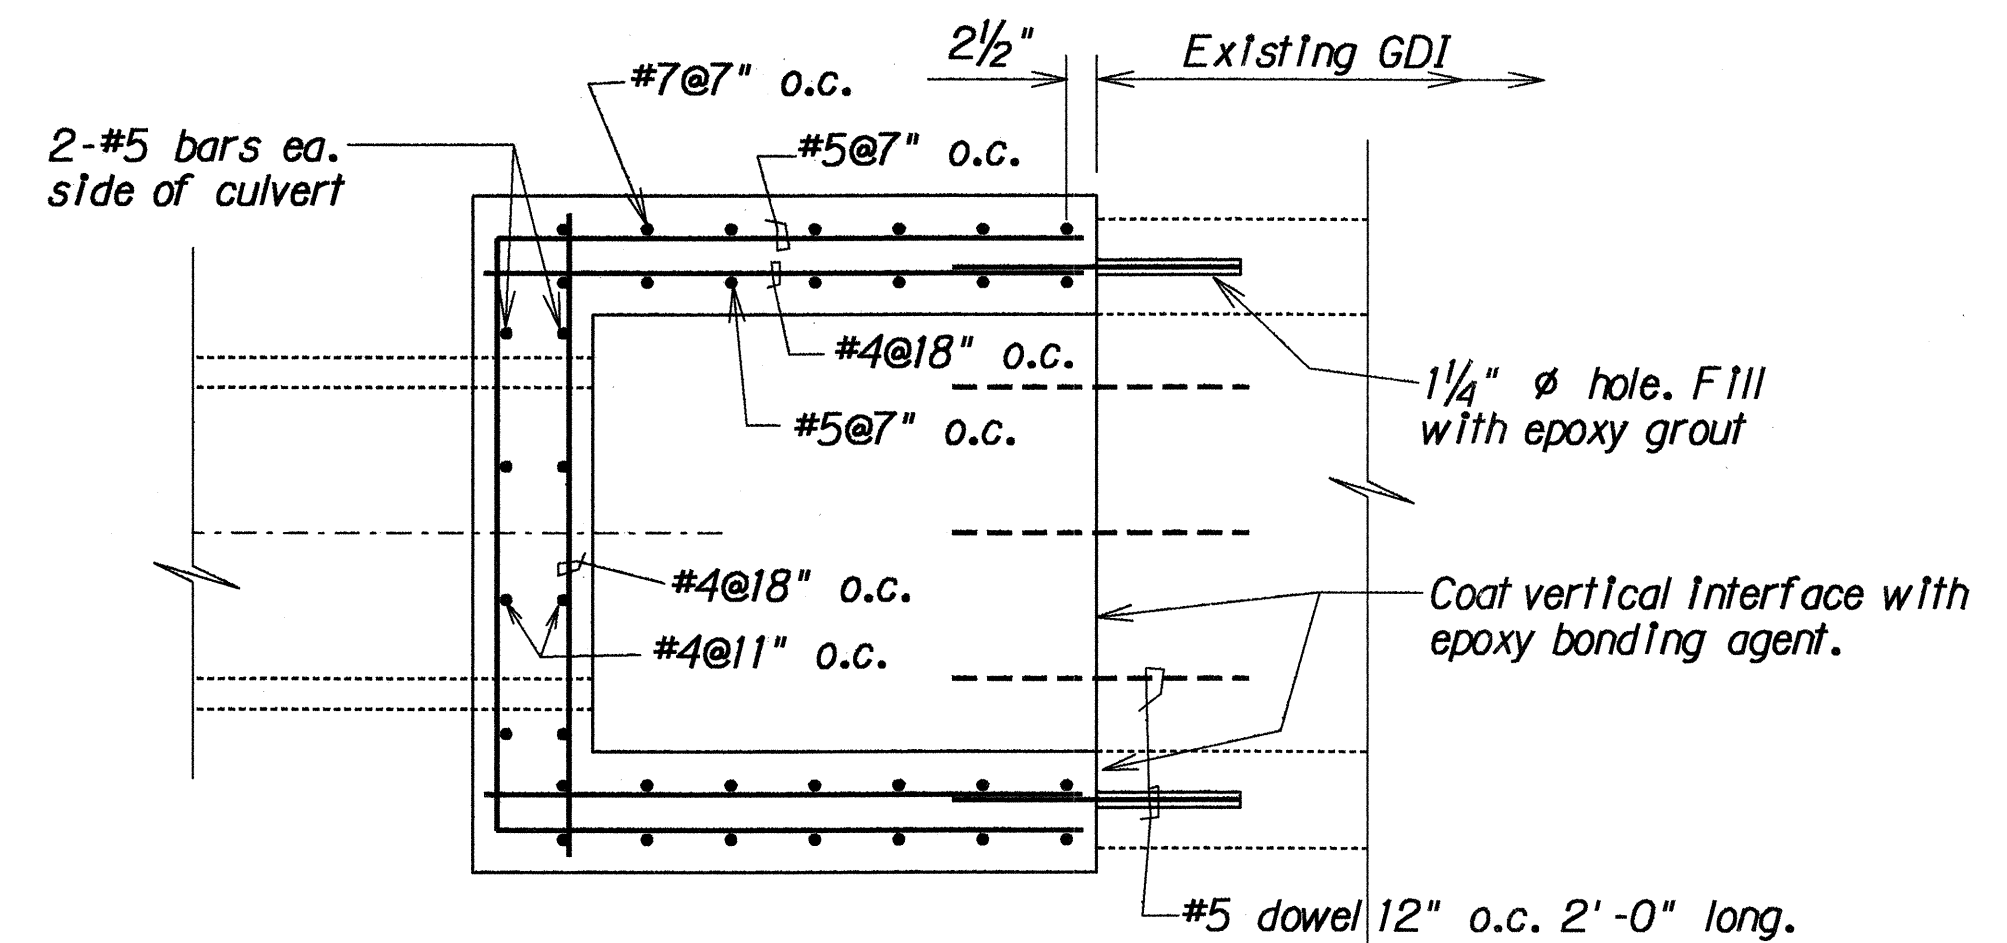

PLAN VIEW OF
WALL REINFORCING

TABLE

STA.	* Width
Sta. 194+00	3'-2"
I.B. Sta. 197+00 Lt.	3'-8"
I.B. Sta. 200+00 Lt.	3'-8"
I.B. Sta. 203+00 Lt.	3'-8"
I.B. Sta. 215+25 Lt.	3'-8"

DETAILS OF TYPE 61616-M GRATED DROP INLET


STATE OF HAWAII
DEPARTMENT OF TRANSPORTATION
HIGHWAYS DIVISION

DRAINAGE DETAILS


INTERSTATE RTE. H-2, HOV LANES, PH. II
Miliiani Interchange to Waipio Interchange
F.A.I. PROJECT NO. IR-H2-1(27)

Scale: 3/4" = 1'-0" Date: Apr., 1992
SHEET No. H28 OF 42 SHEETS


FED. ROAD DIST. NO.	STATE	FED. AID PROJ. NO.	FISCAL YEAR	SHEET NO.	TOTAL SHEETS
HAWAII	HAW.	IR-H2-1(27)	1992	121	223

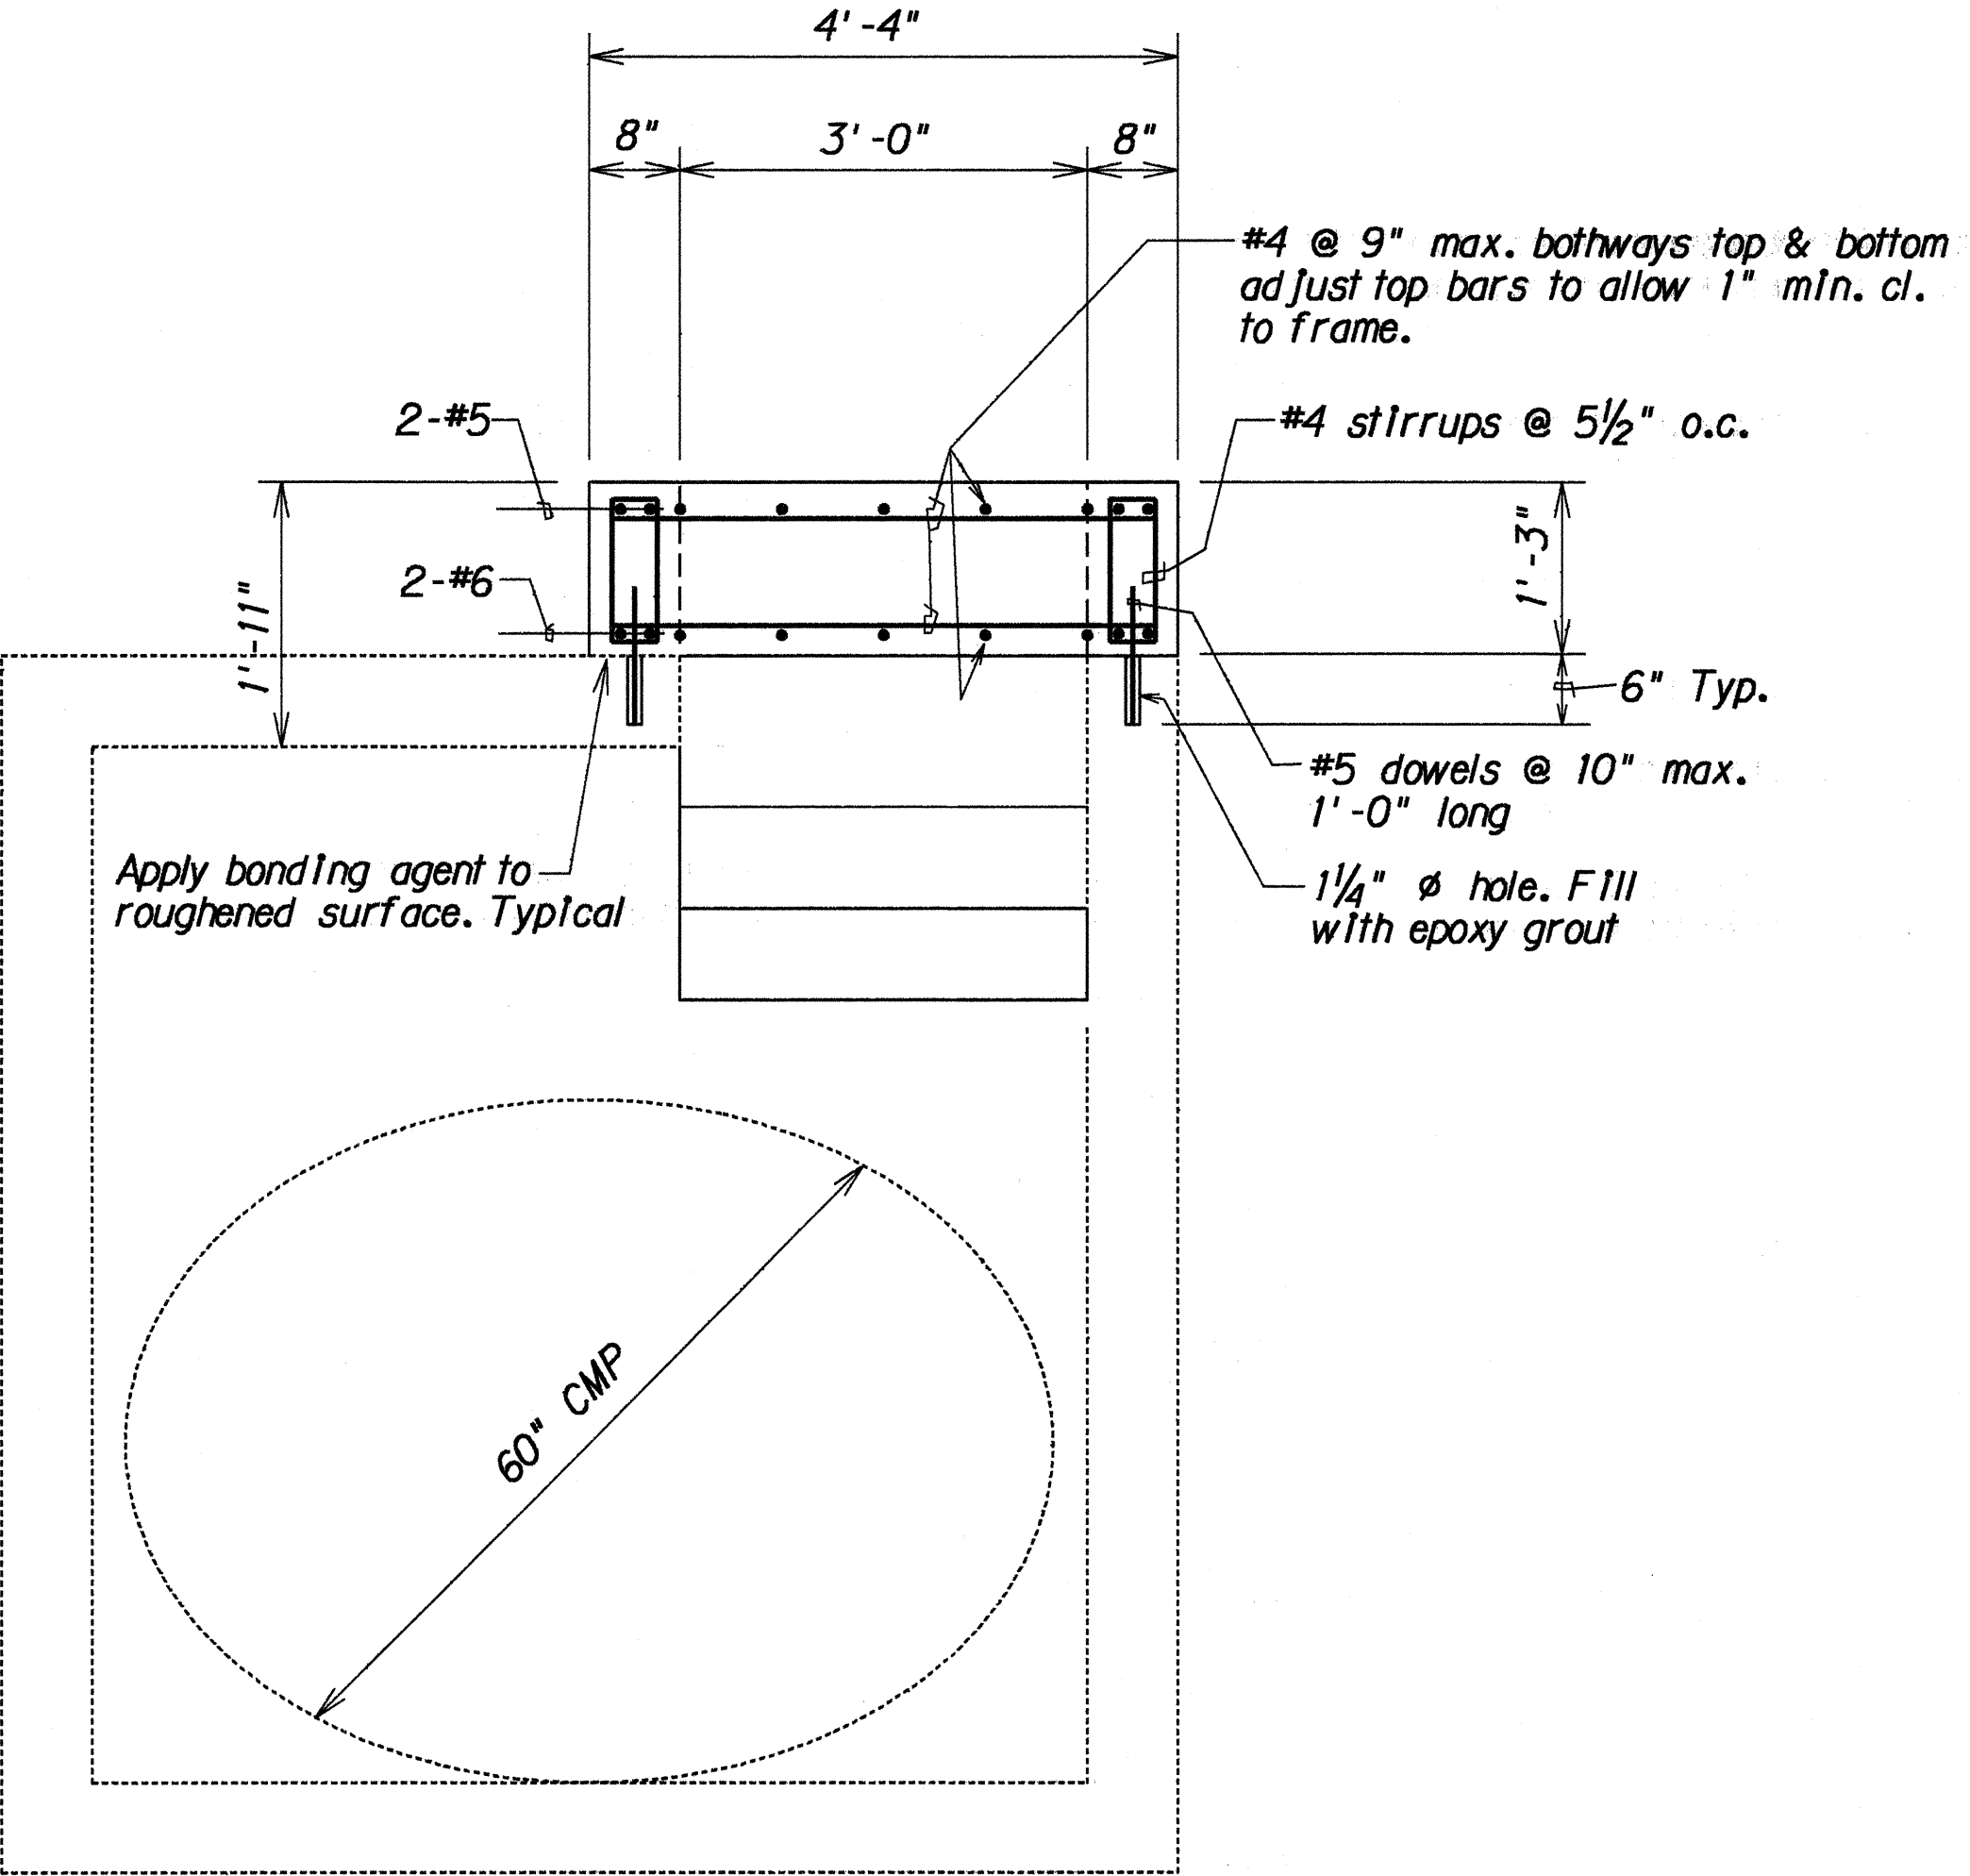


SECTION C
H29/H30

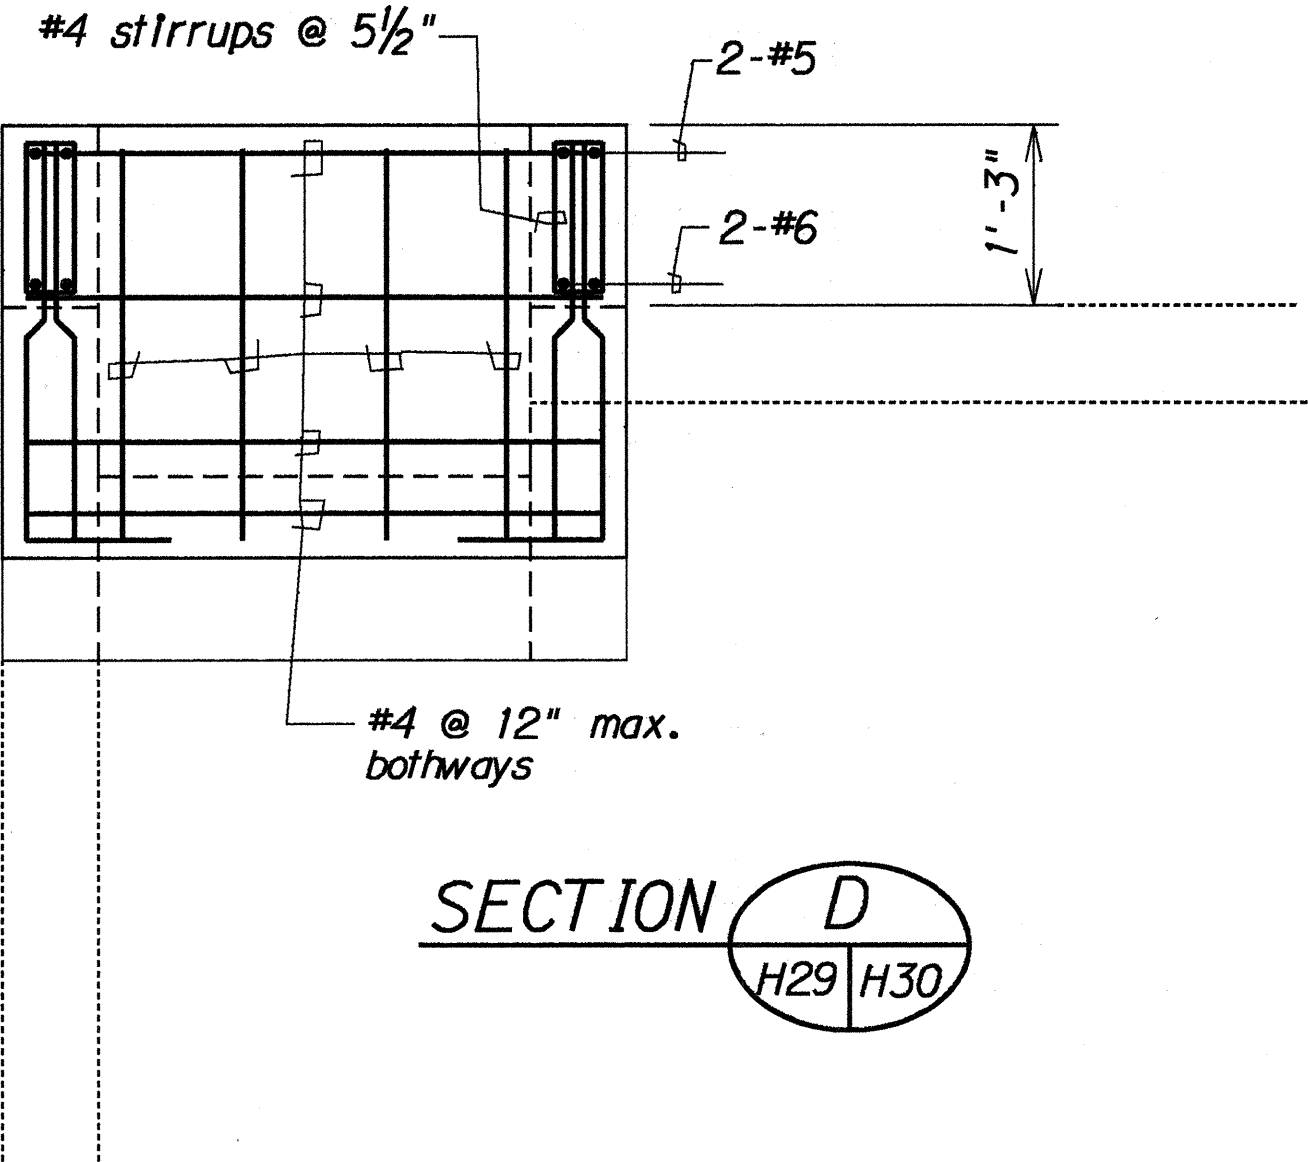


SECTION D
H29/H30

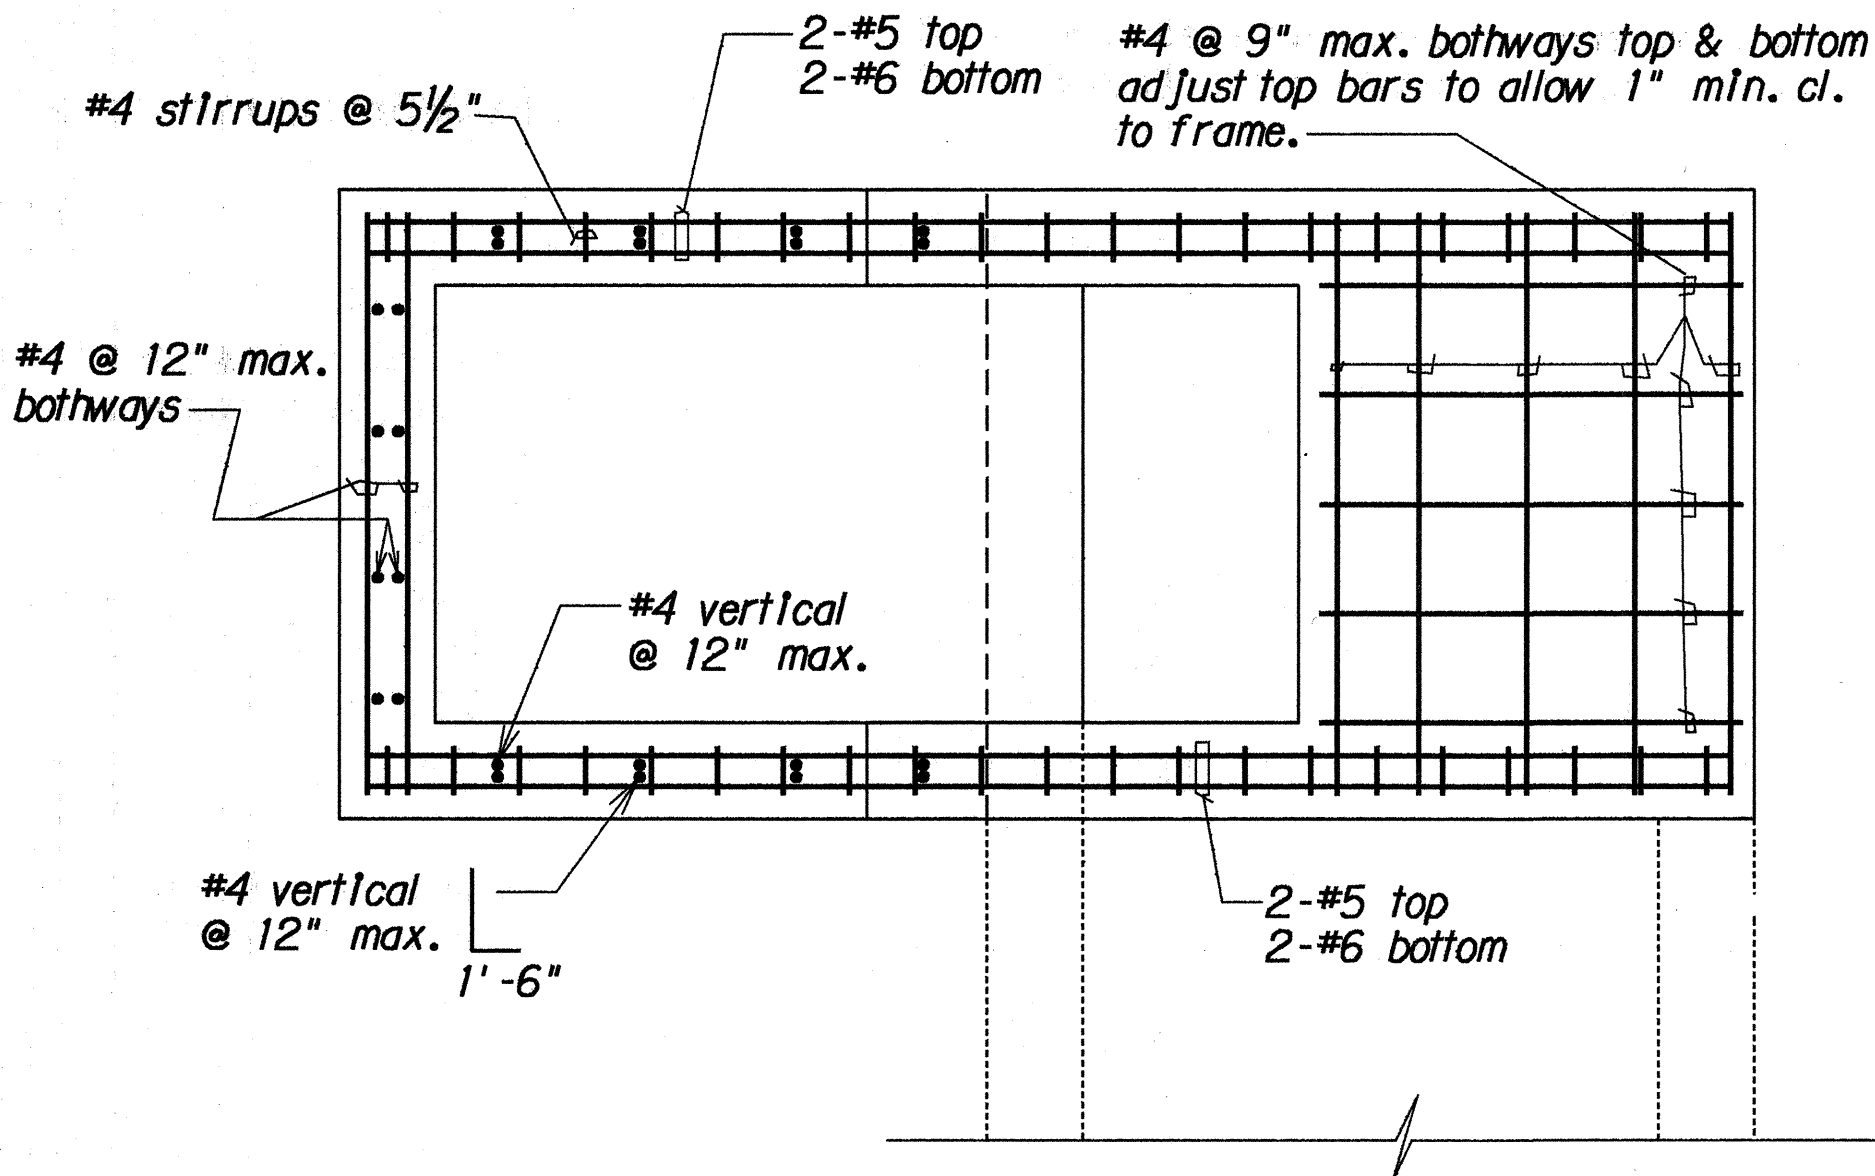

PLAN VIEW OF WALL & TOP SLAB REINFORCING

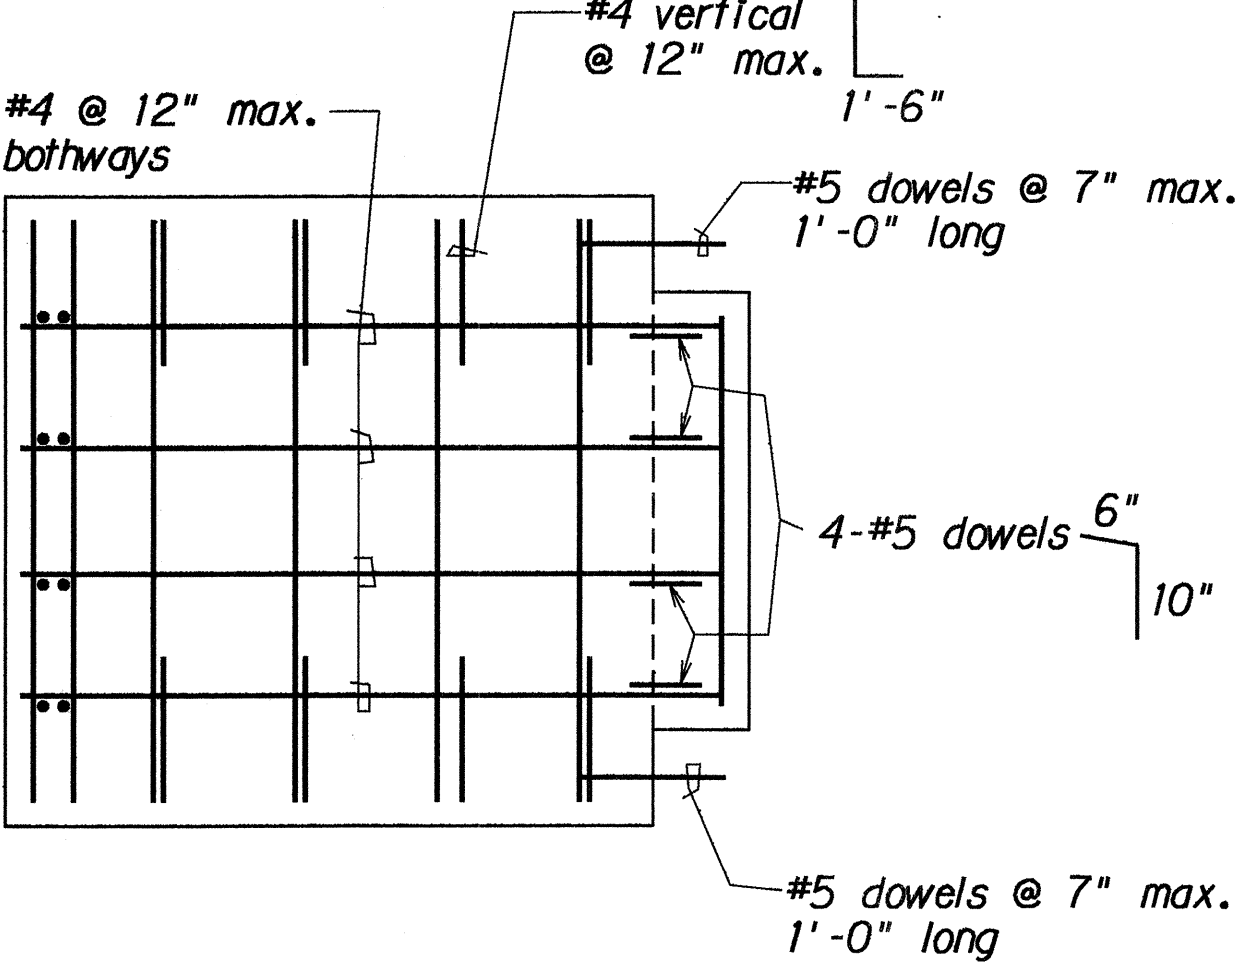

PLAN VIEW OF BOTTOM SLAB REINFORCING

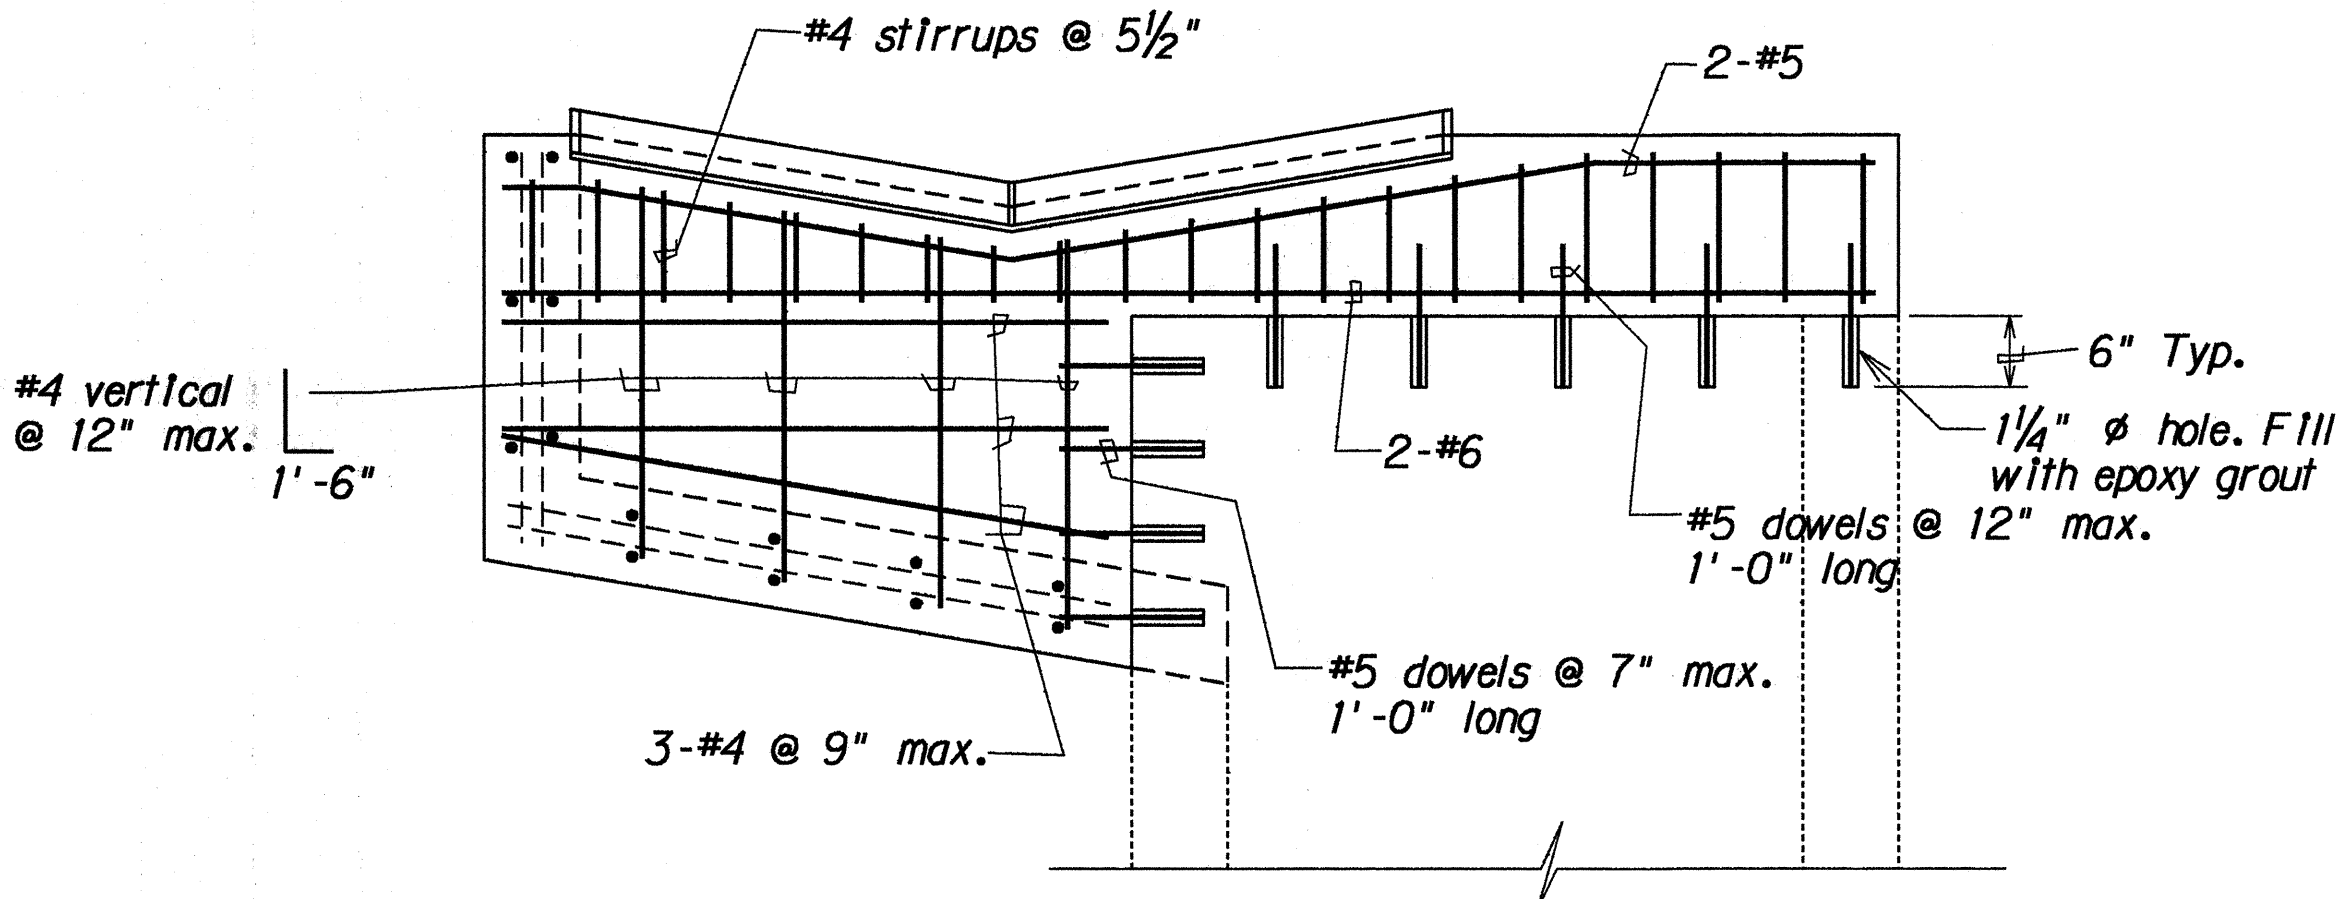

ELEVATION VIEW OF WALL & BEAM REINFORCING



DETAILS OF TYPE 61616-0 GDI AT I.B. @ STA. 212+40 RT.

STATE OF HAWAII
DEPARTMENT OF TRANSPORTATION
HIGHWAYS DIVISION

DRAINAGE DETAILS
INTERSTATE RTE. H-2, HOV LANES, PH. II
Miliam Interchange to Waipio Interchange
F.A.I. PROJECT NO. IR-H2-1(27)

Scale: 3/4" = 1'-0" Date: Apr., 1992
SHEET No. H30 OF 42 SHEETS


FED. ROAD DIST. NO.	STATE	FED. AID PROJ. NO.	FISCAL YEAR	SHEET NO.	TOTAL SHEETS
HAWAII	HAW.	IR-H2-1(27)	1992	122	223

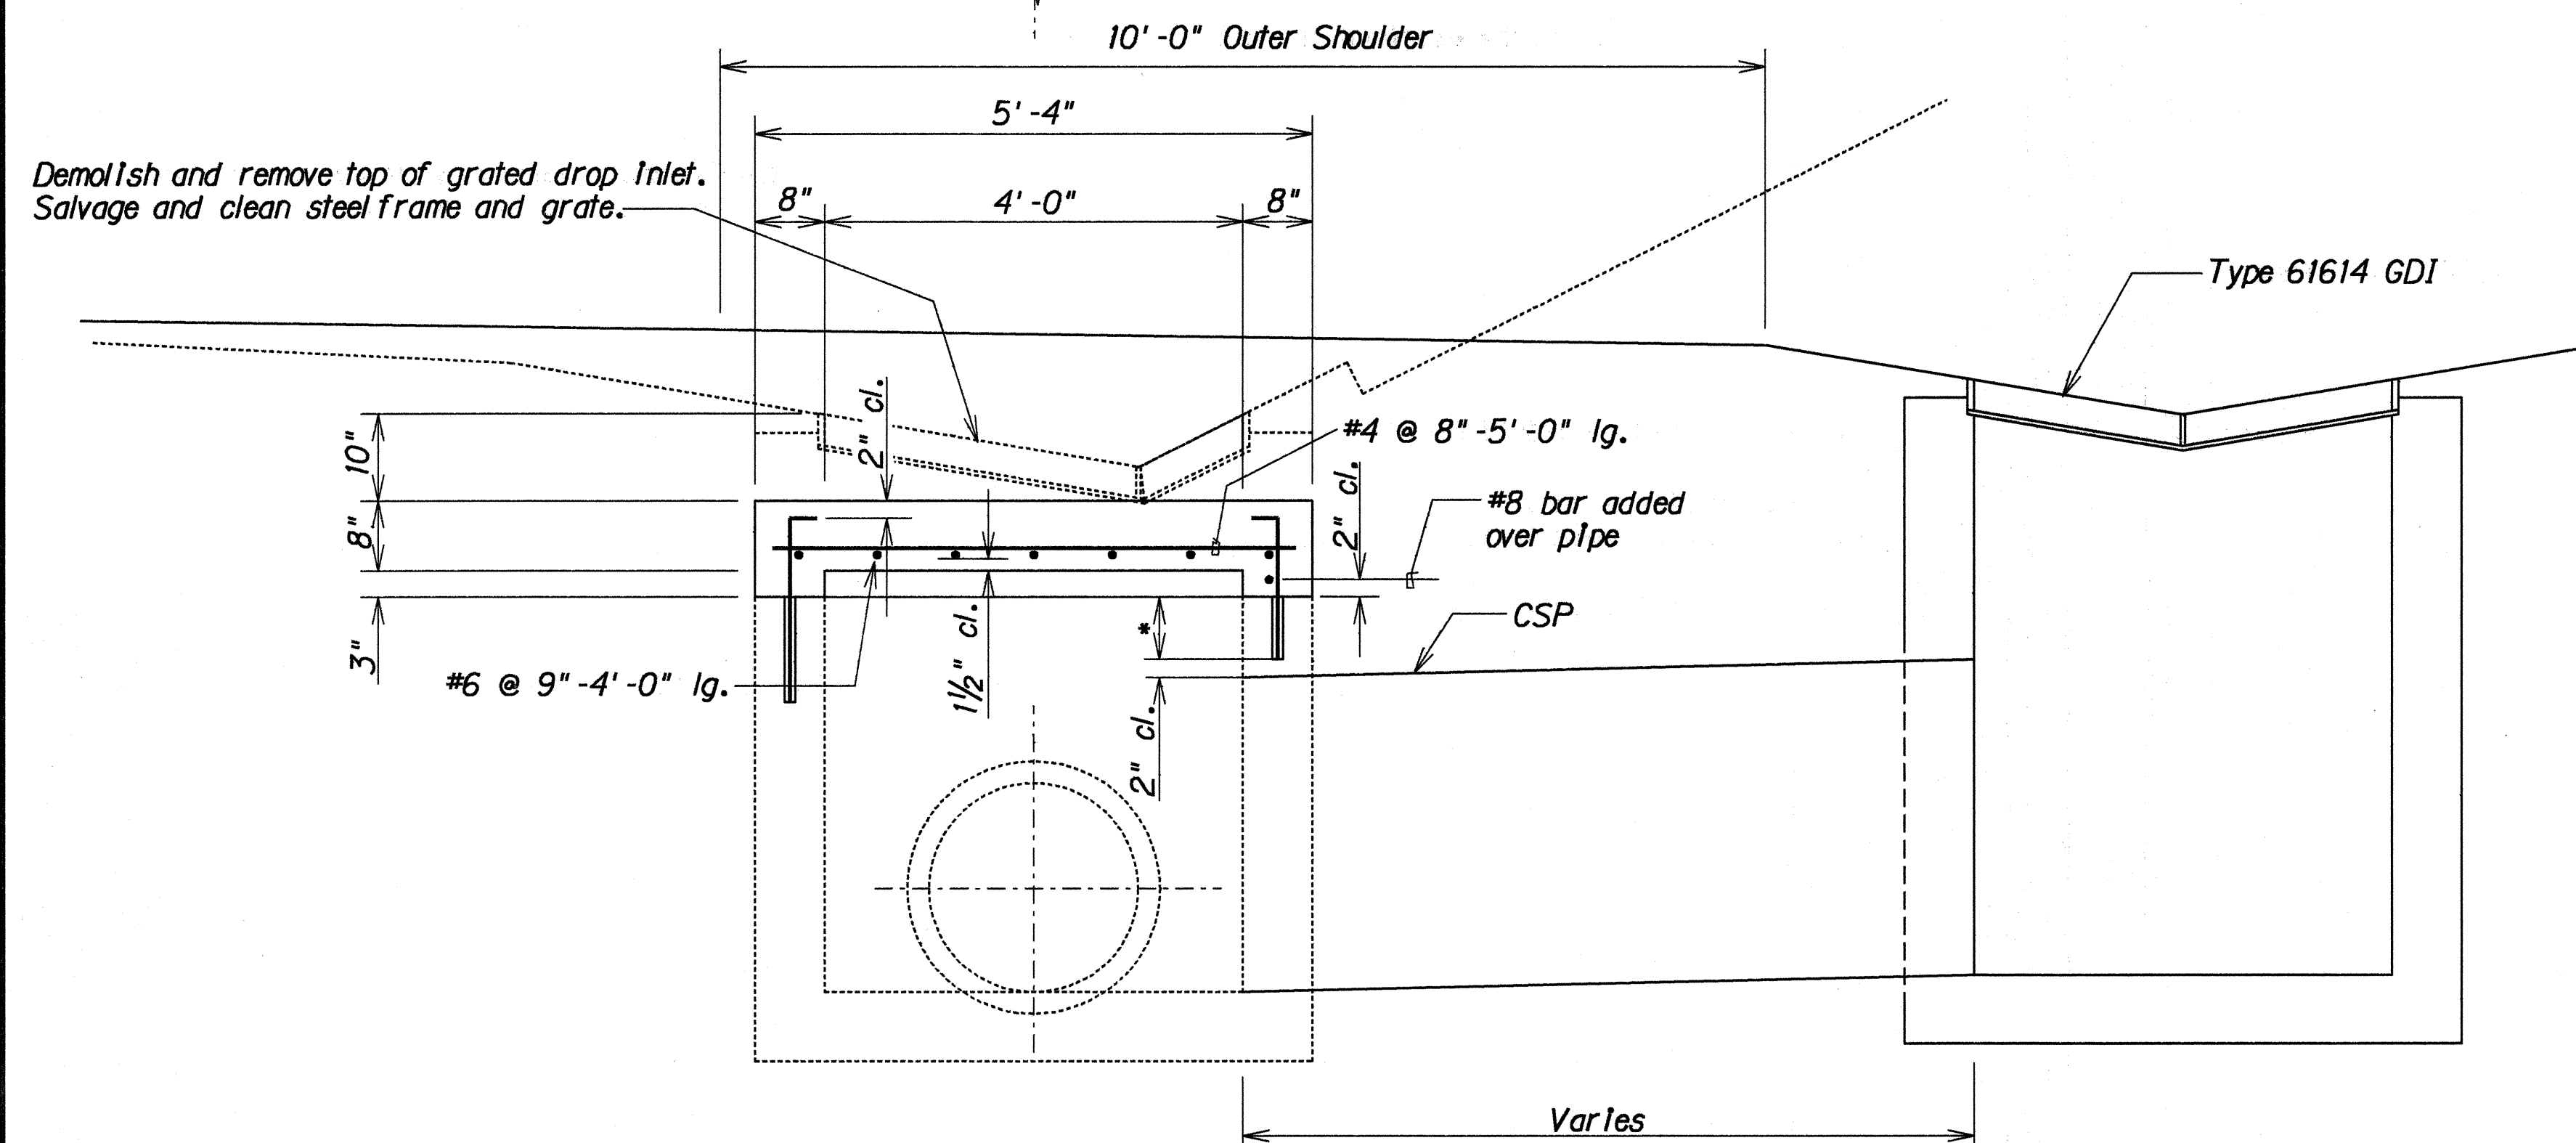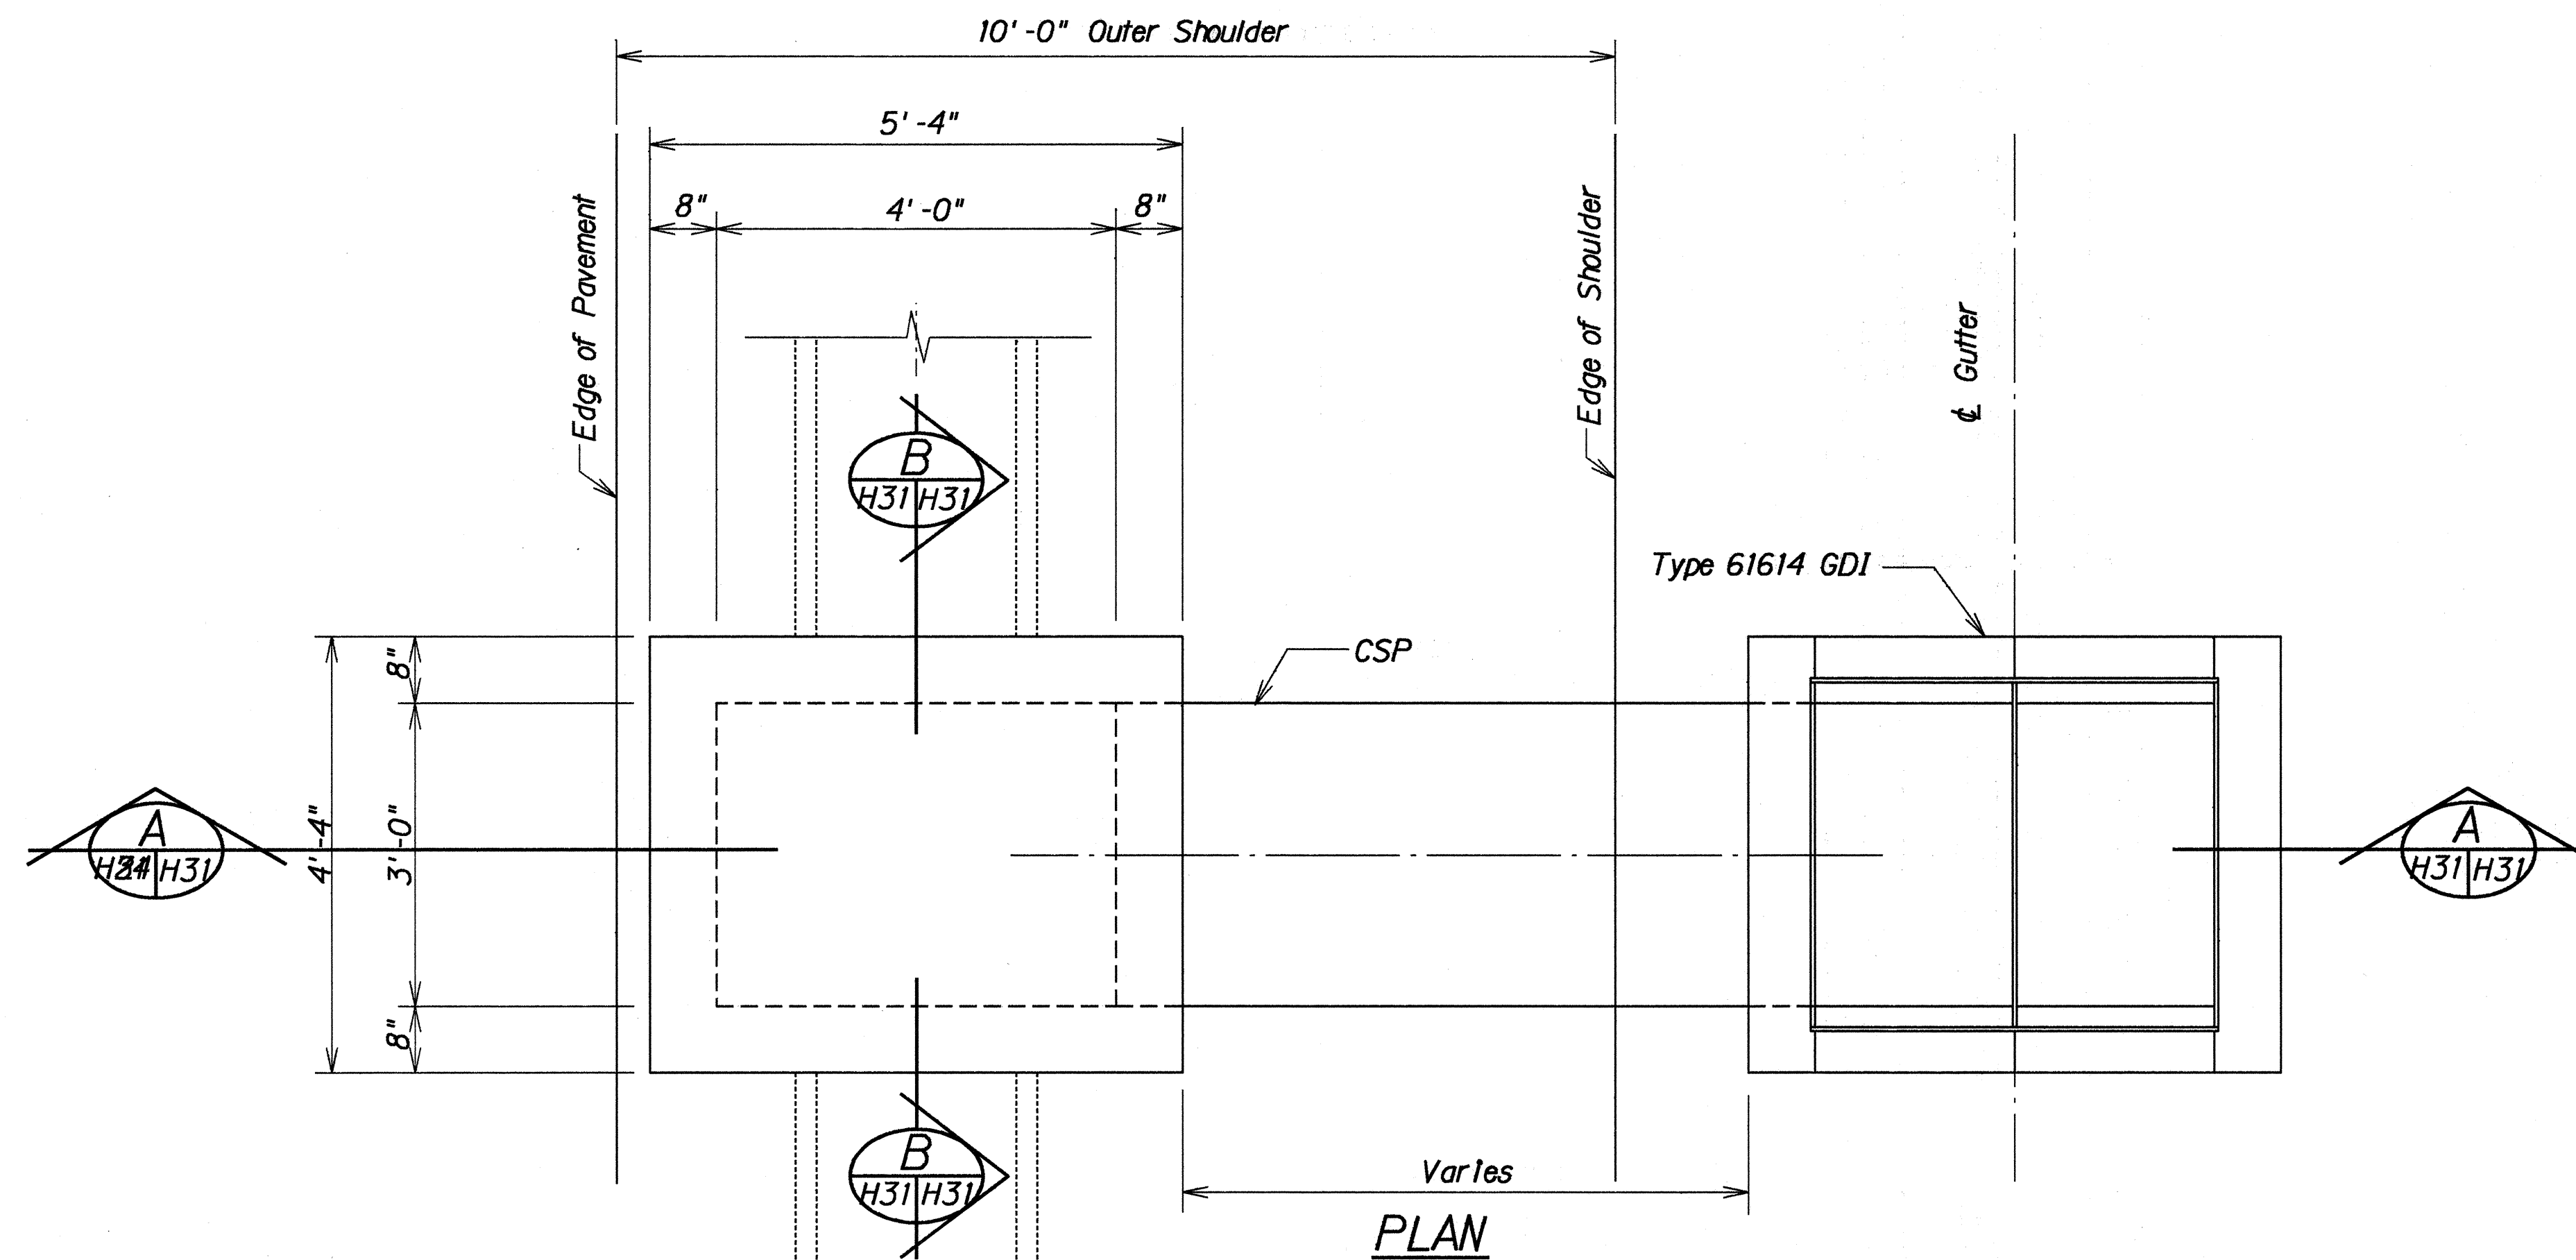


* Reduce 12" embedment over pipe to get 2" of clearance.

SECTION A
H31 | H31

DETAILS OF TYPE "X" STORM DRAIN MANHOLE

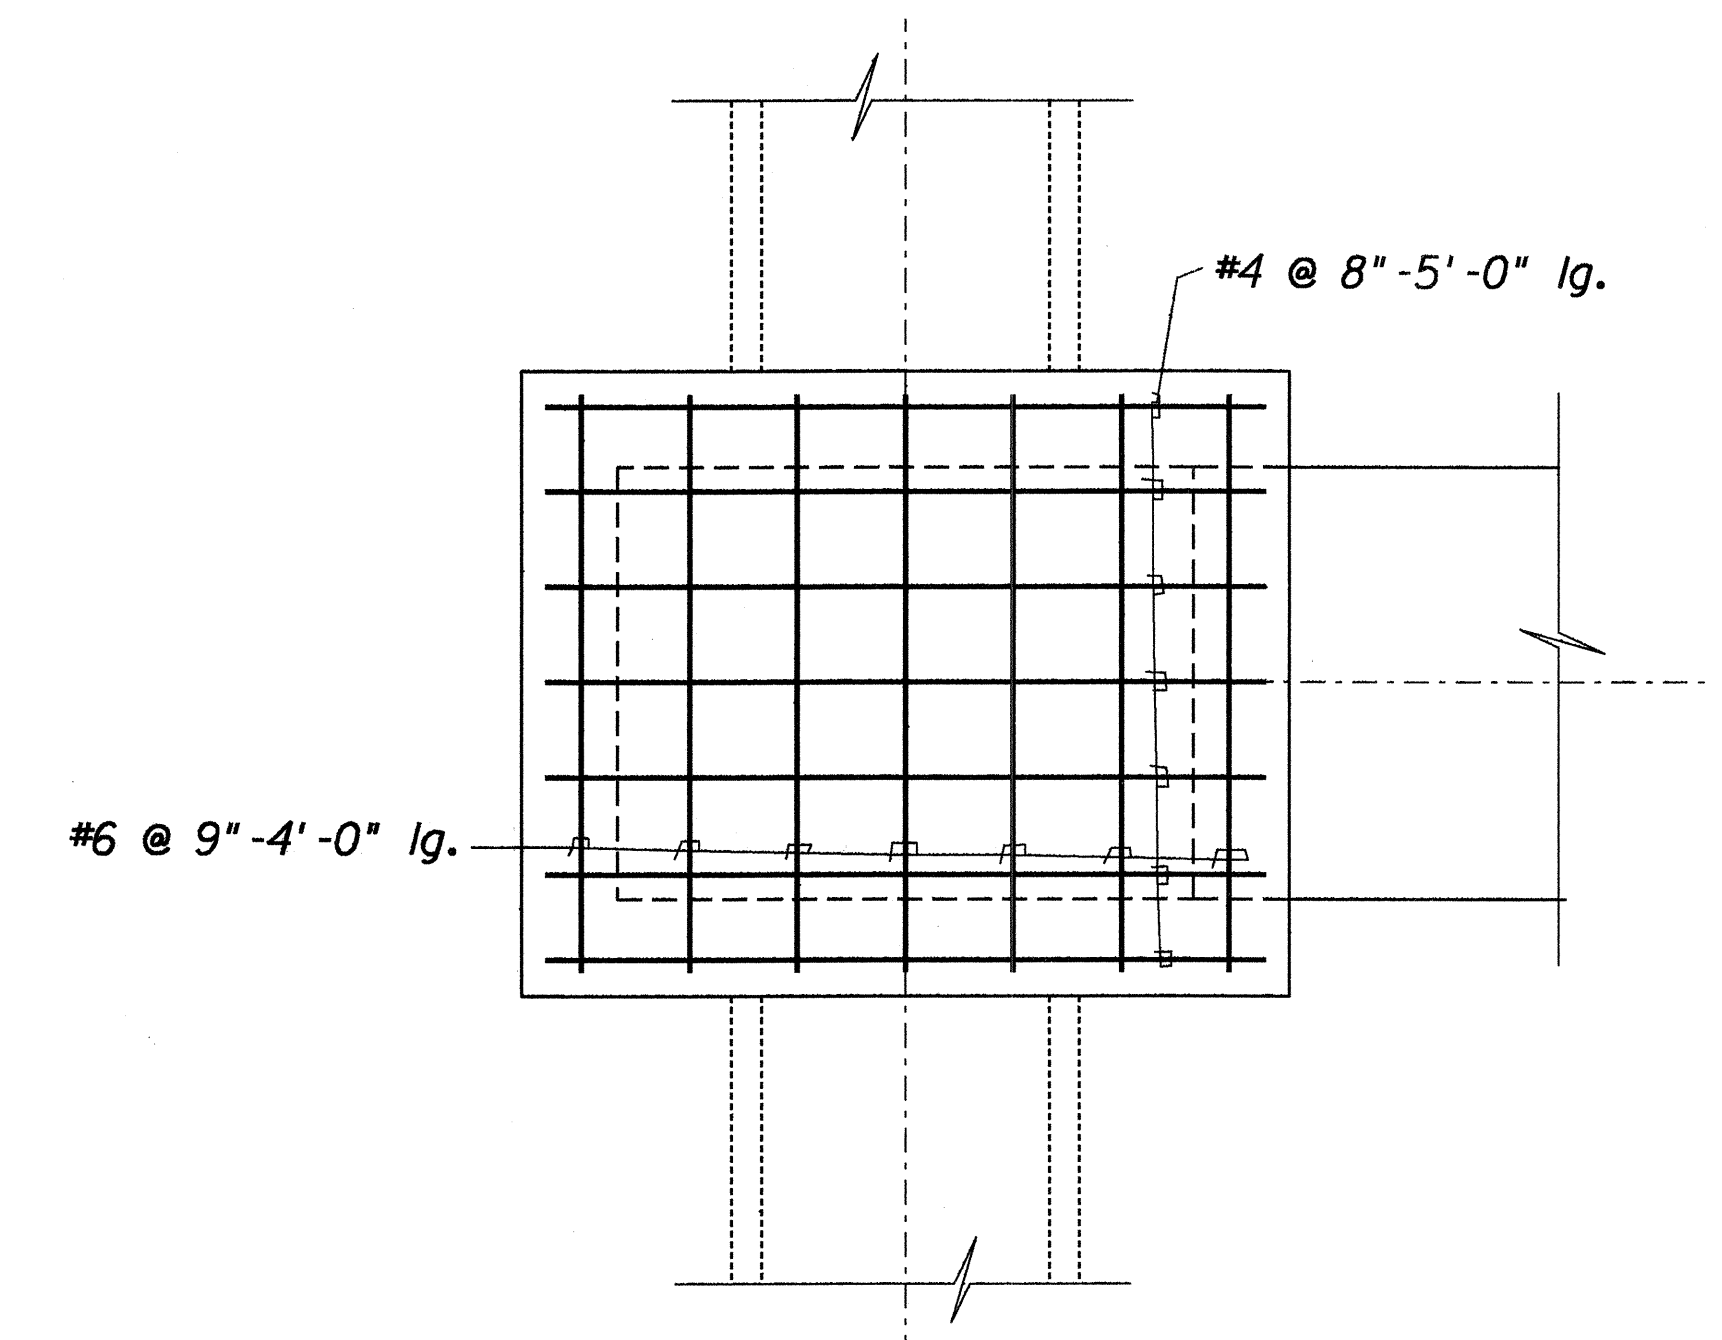

PLAN VIEW OF TOP SLAB REINFORCING

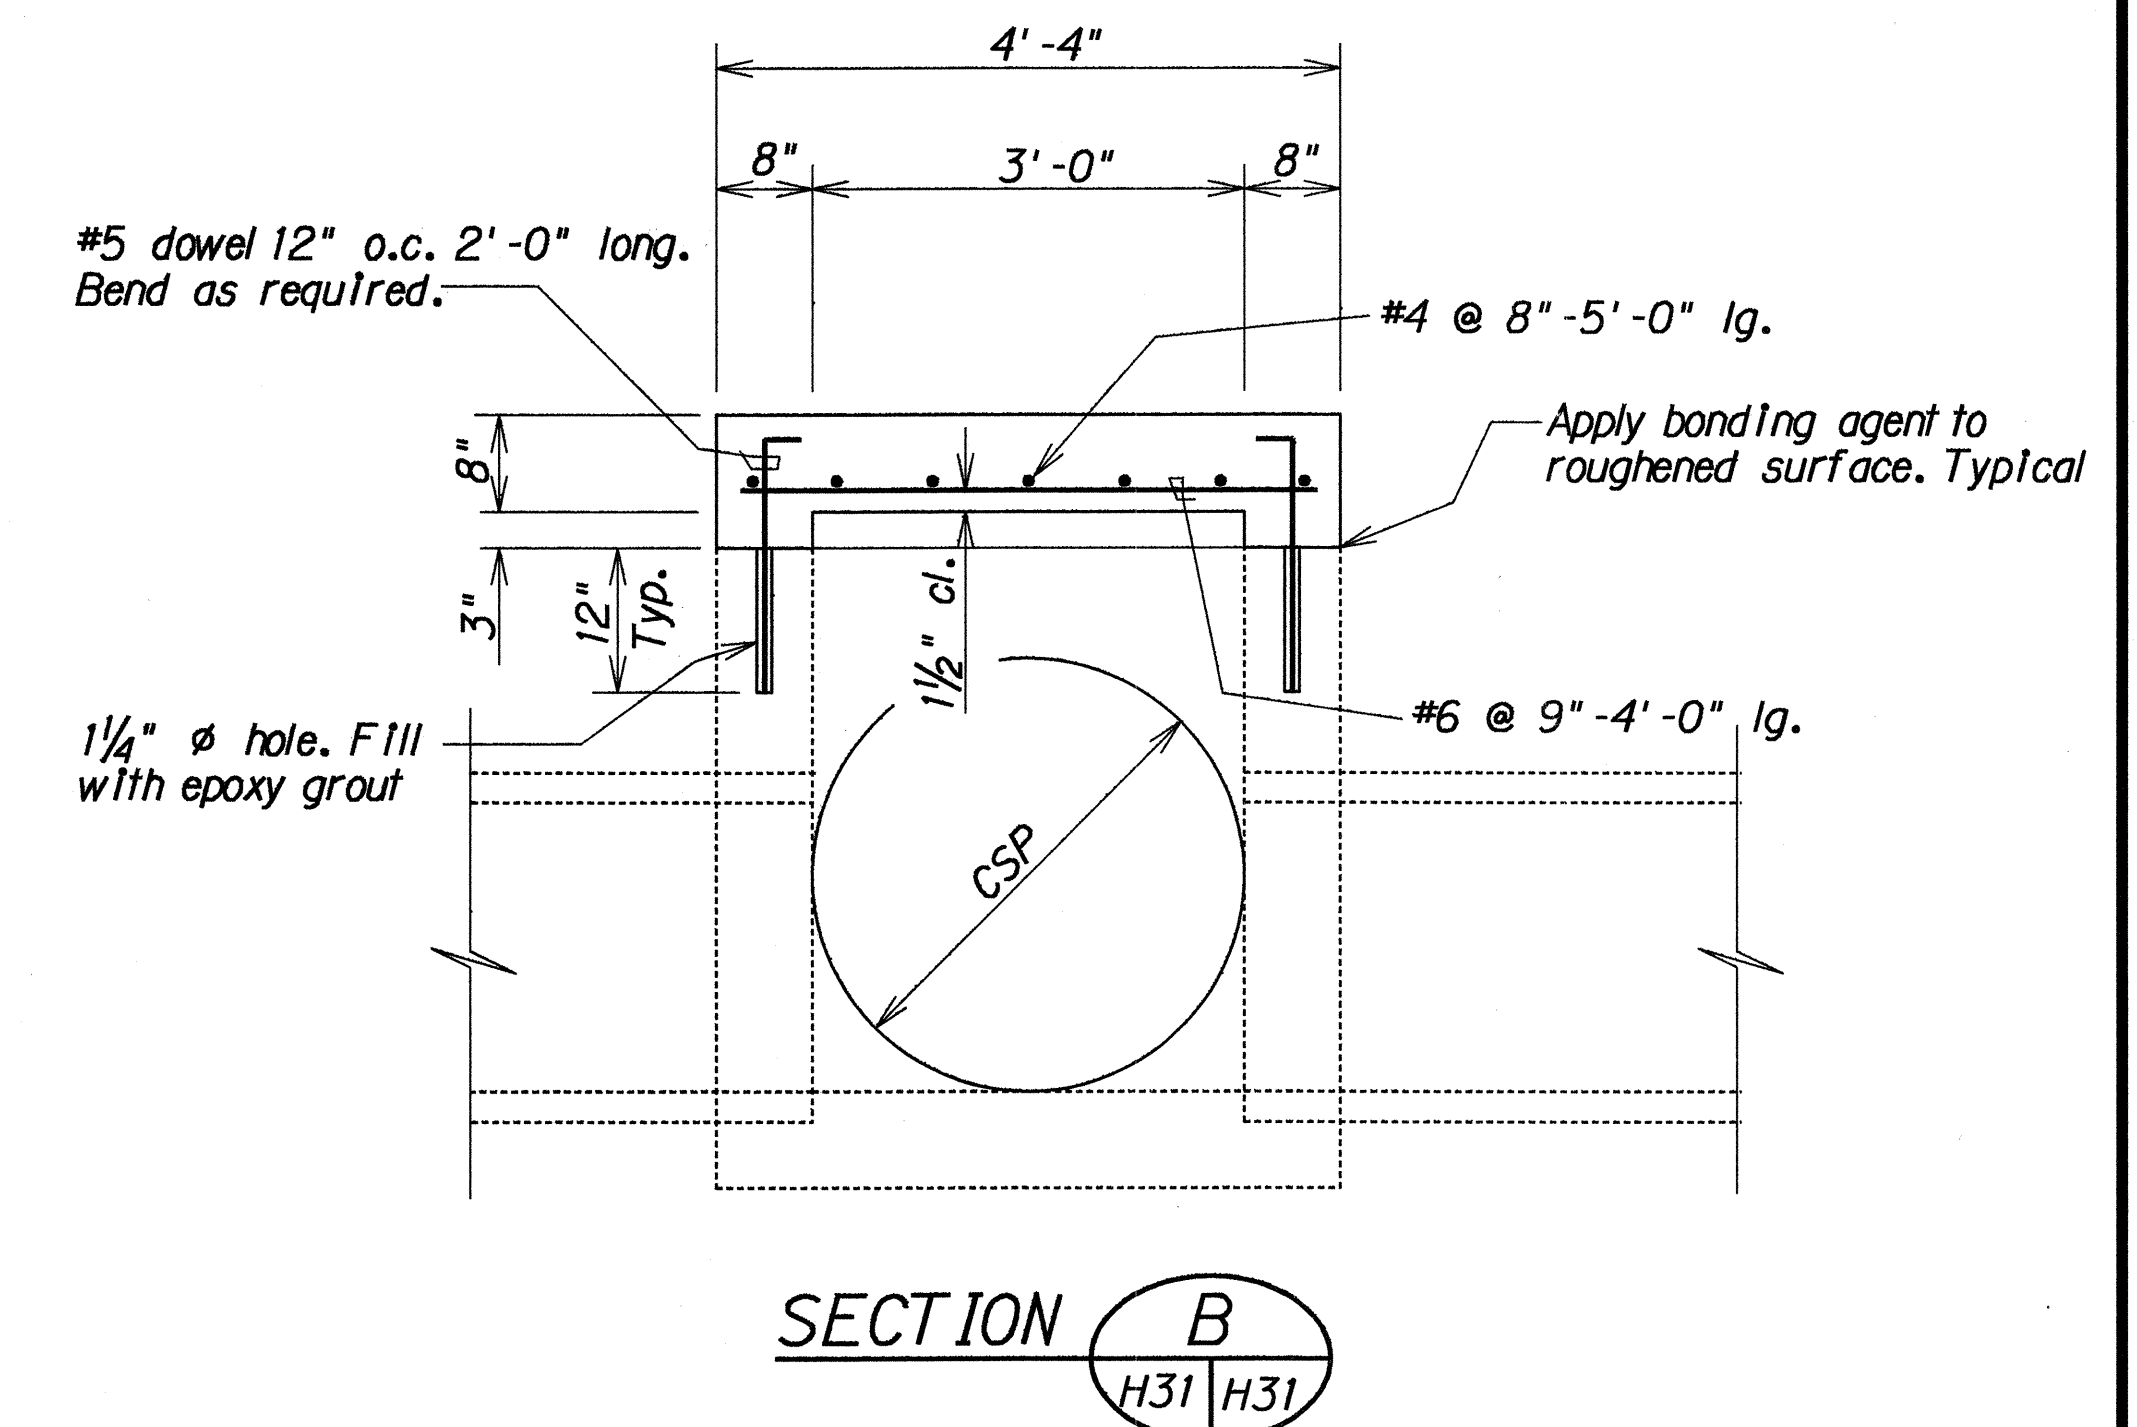

ORIGINAL PLAN	SURVEY PLOTTED BY _____	DATE _____
NOTE BOOK	DRAWN BY _____	_____
	TRACED BY _____	_____
	DESIGNED BY _____	_____
	QUANTITIES BY _____	_____
N _o _____	CHECKED BY _____	_____

STATE OF HAWAII
DEPARTMENT OF TRANSPORTATION
HIGHWAYS DIVISION


DRAINAGE DETAILS

INTERSTATE RTE. H-2, HOV LANES, PH. II
Mililani Interchange to Waipio Interchange
F.A.I. PROJECT NO. IR-H2-1(27)

Scale: $\frac{3}{4}" = 1'-0"$ Date: Apr., 1992

SHEET No. *H31* OF 42 SHEETS

FED. ROAD DIST. NO.	STATE	FED. AID PROJ. NO.	FISCAL YEAR	SHEET NO.	TOTAL SHEETS
HAWAII	HAW.	IR-H2-1(27)	1992	123	223

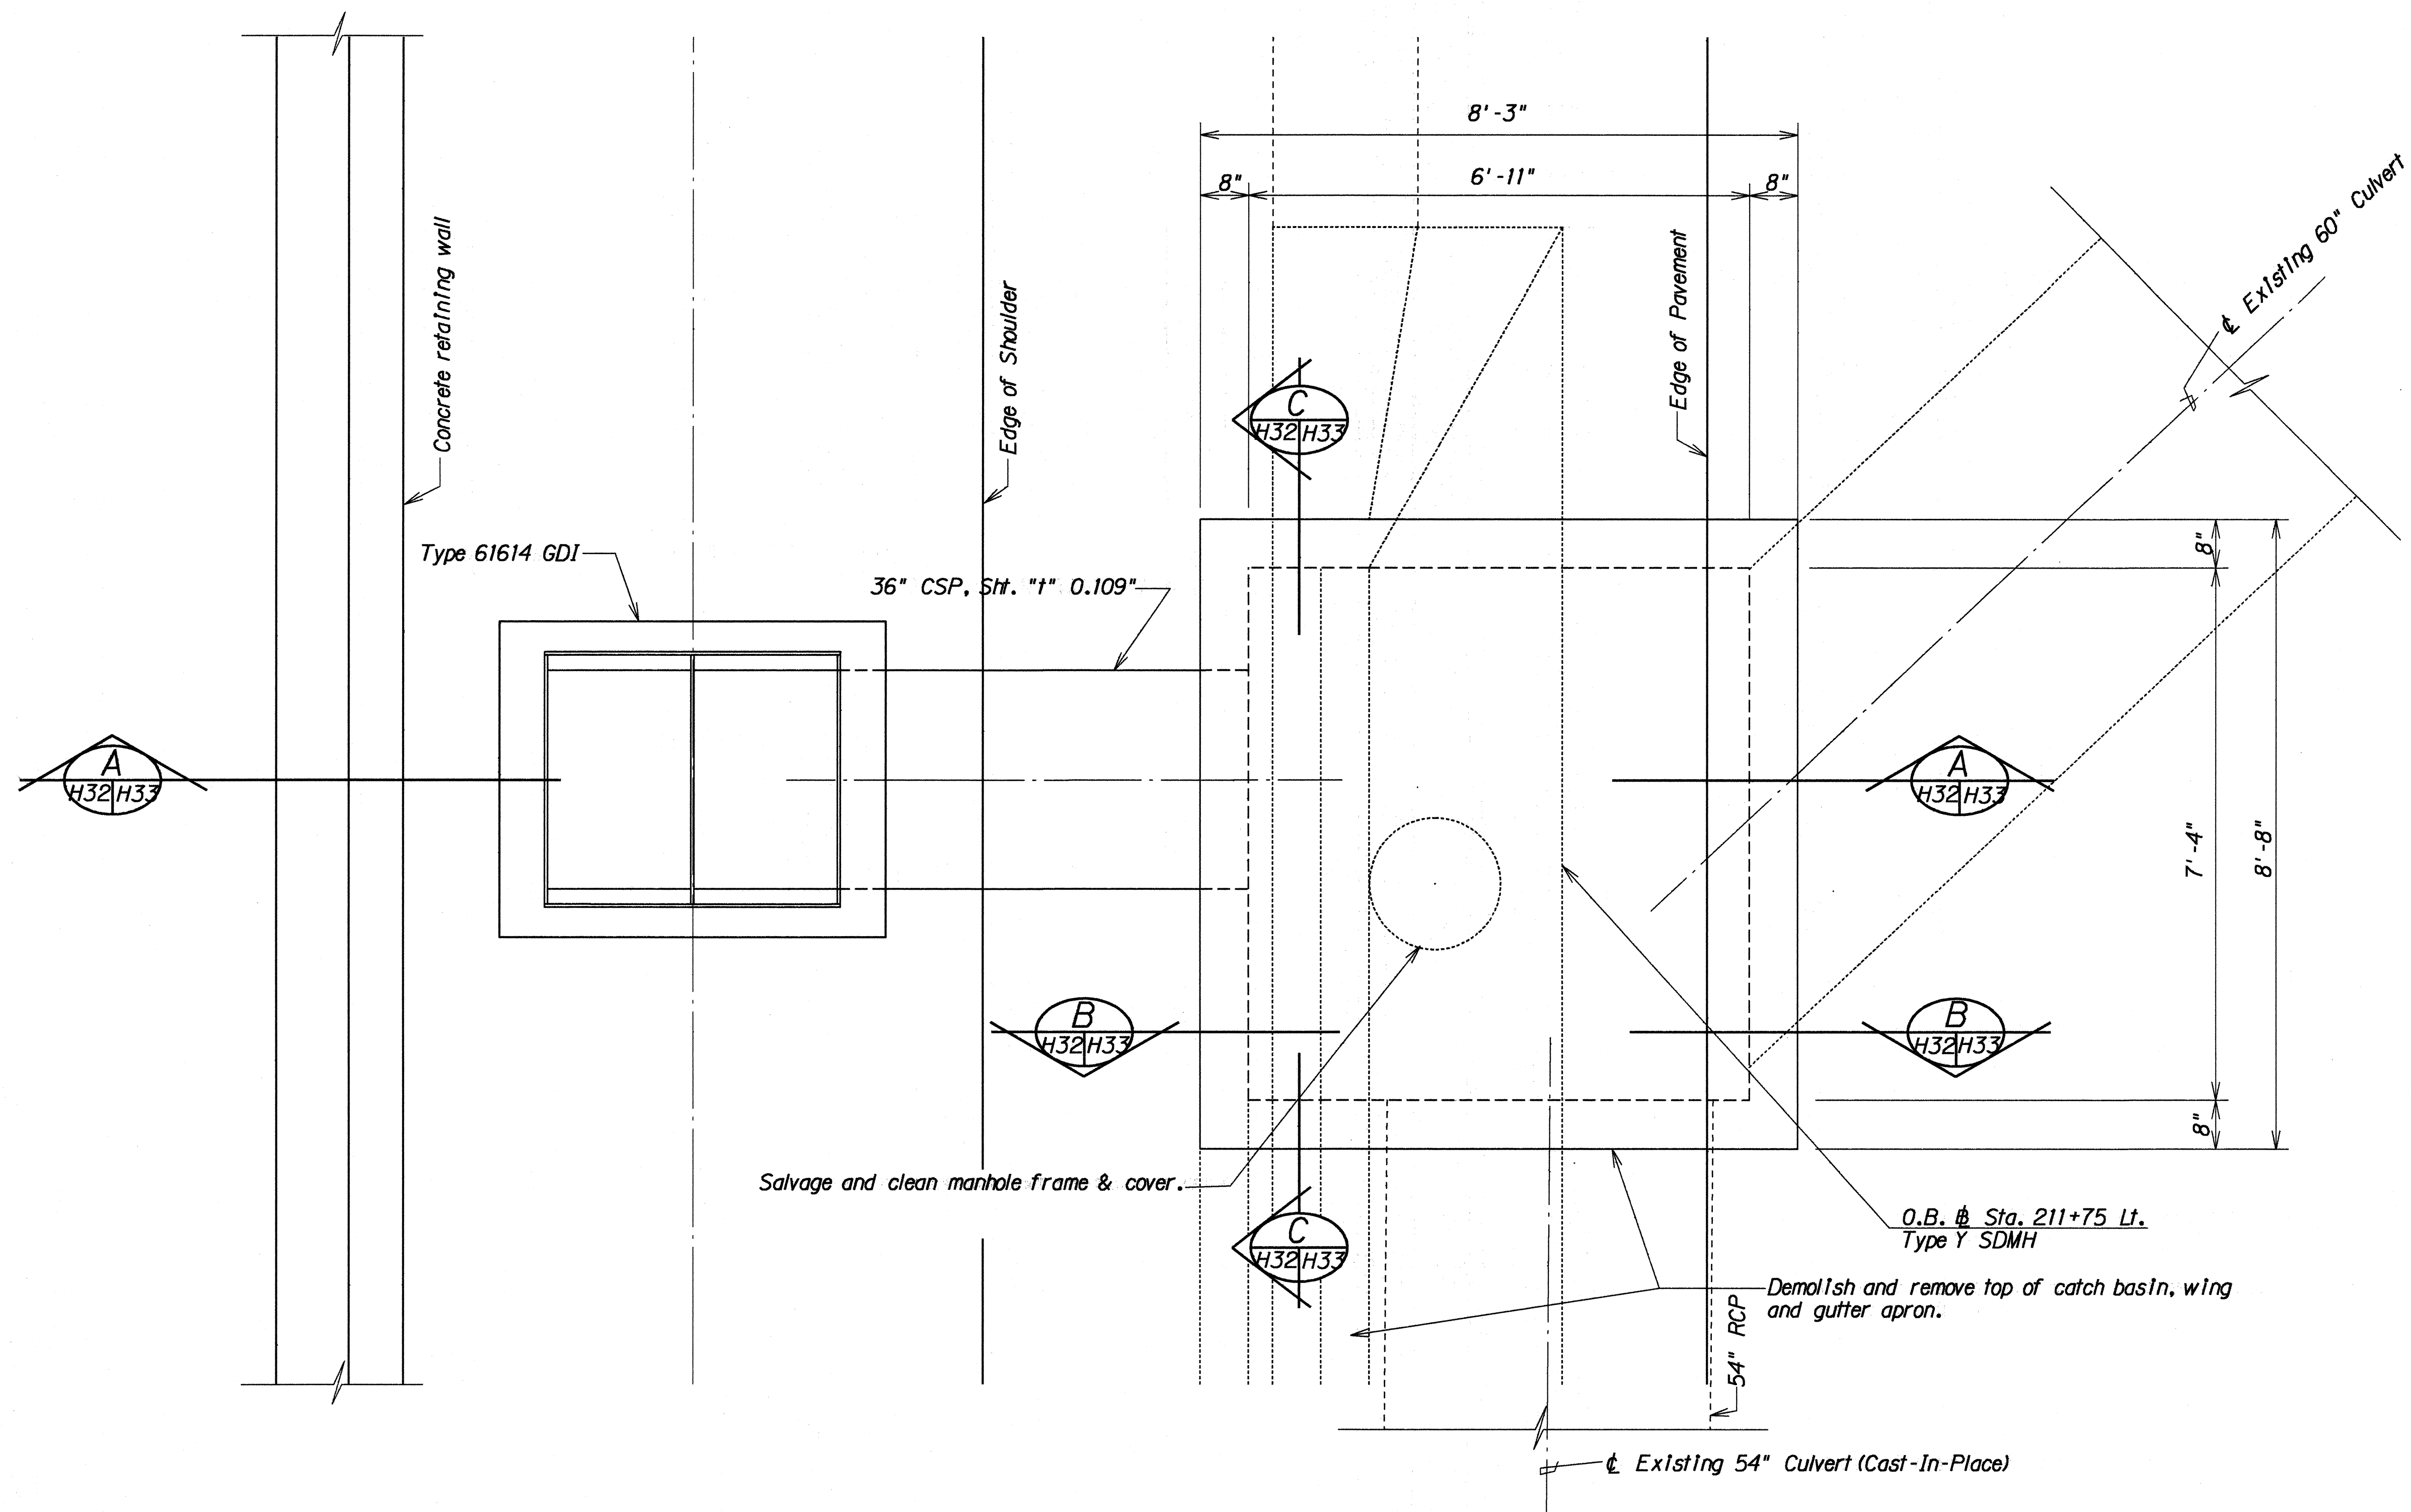

PLAN

DETAILS OF TYPE "Y" STORM DRAIN MANHOLE AT O.B. STA. 211+75 O/S 52' LT.

ORIGINAL PLAN	DATE
DESIGNED BY	
TRACED BY	
NOTED BY	
CHECKED BY	

STATE OF HAWAII
DEPARTMENT OF TRANSPORTATION
HIGHWAYS DIVISION






DRAINAGE DETAILS

INTERSTATE RTE. H-2, HOV LANES, PH. II
Miliiani Interchange to Waipio Interchange
F.A.I. PROJECT NO. IR-H2-1(27)

Scale: 3/4" = 1'-0" Date: Apr., 1992

SHEET No. H32 OF 42 SHEETS

FED. ROAD DIST. NO.	STATE	FED. AID PROJ. NO.	FISCAL YEAR	SHEET NO.	TOTAL SHEETS
HAWAII	HAW.	IR-H2-1(27)	1992	124	223

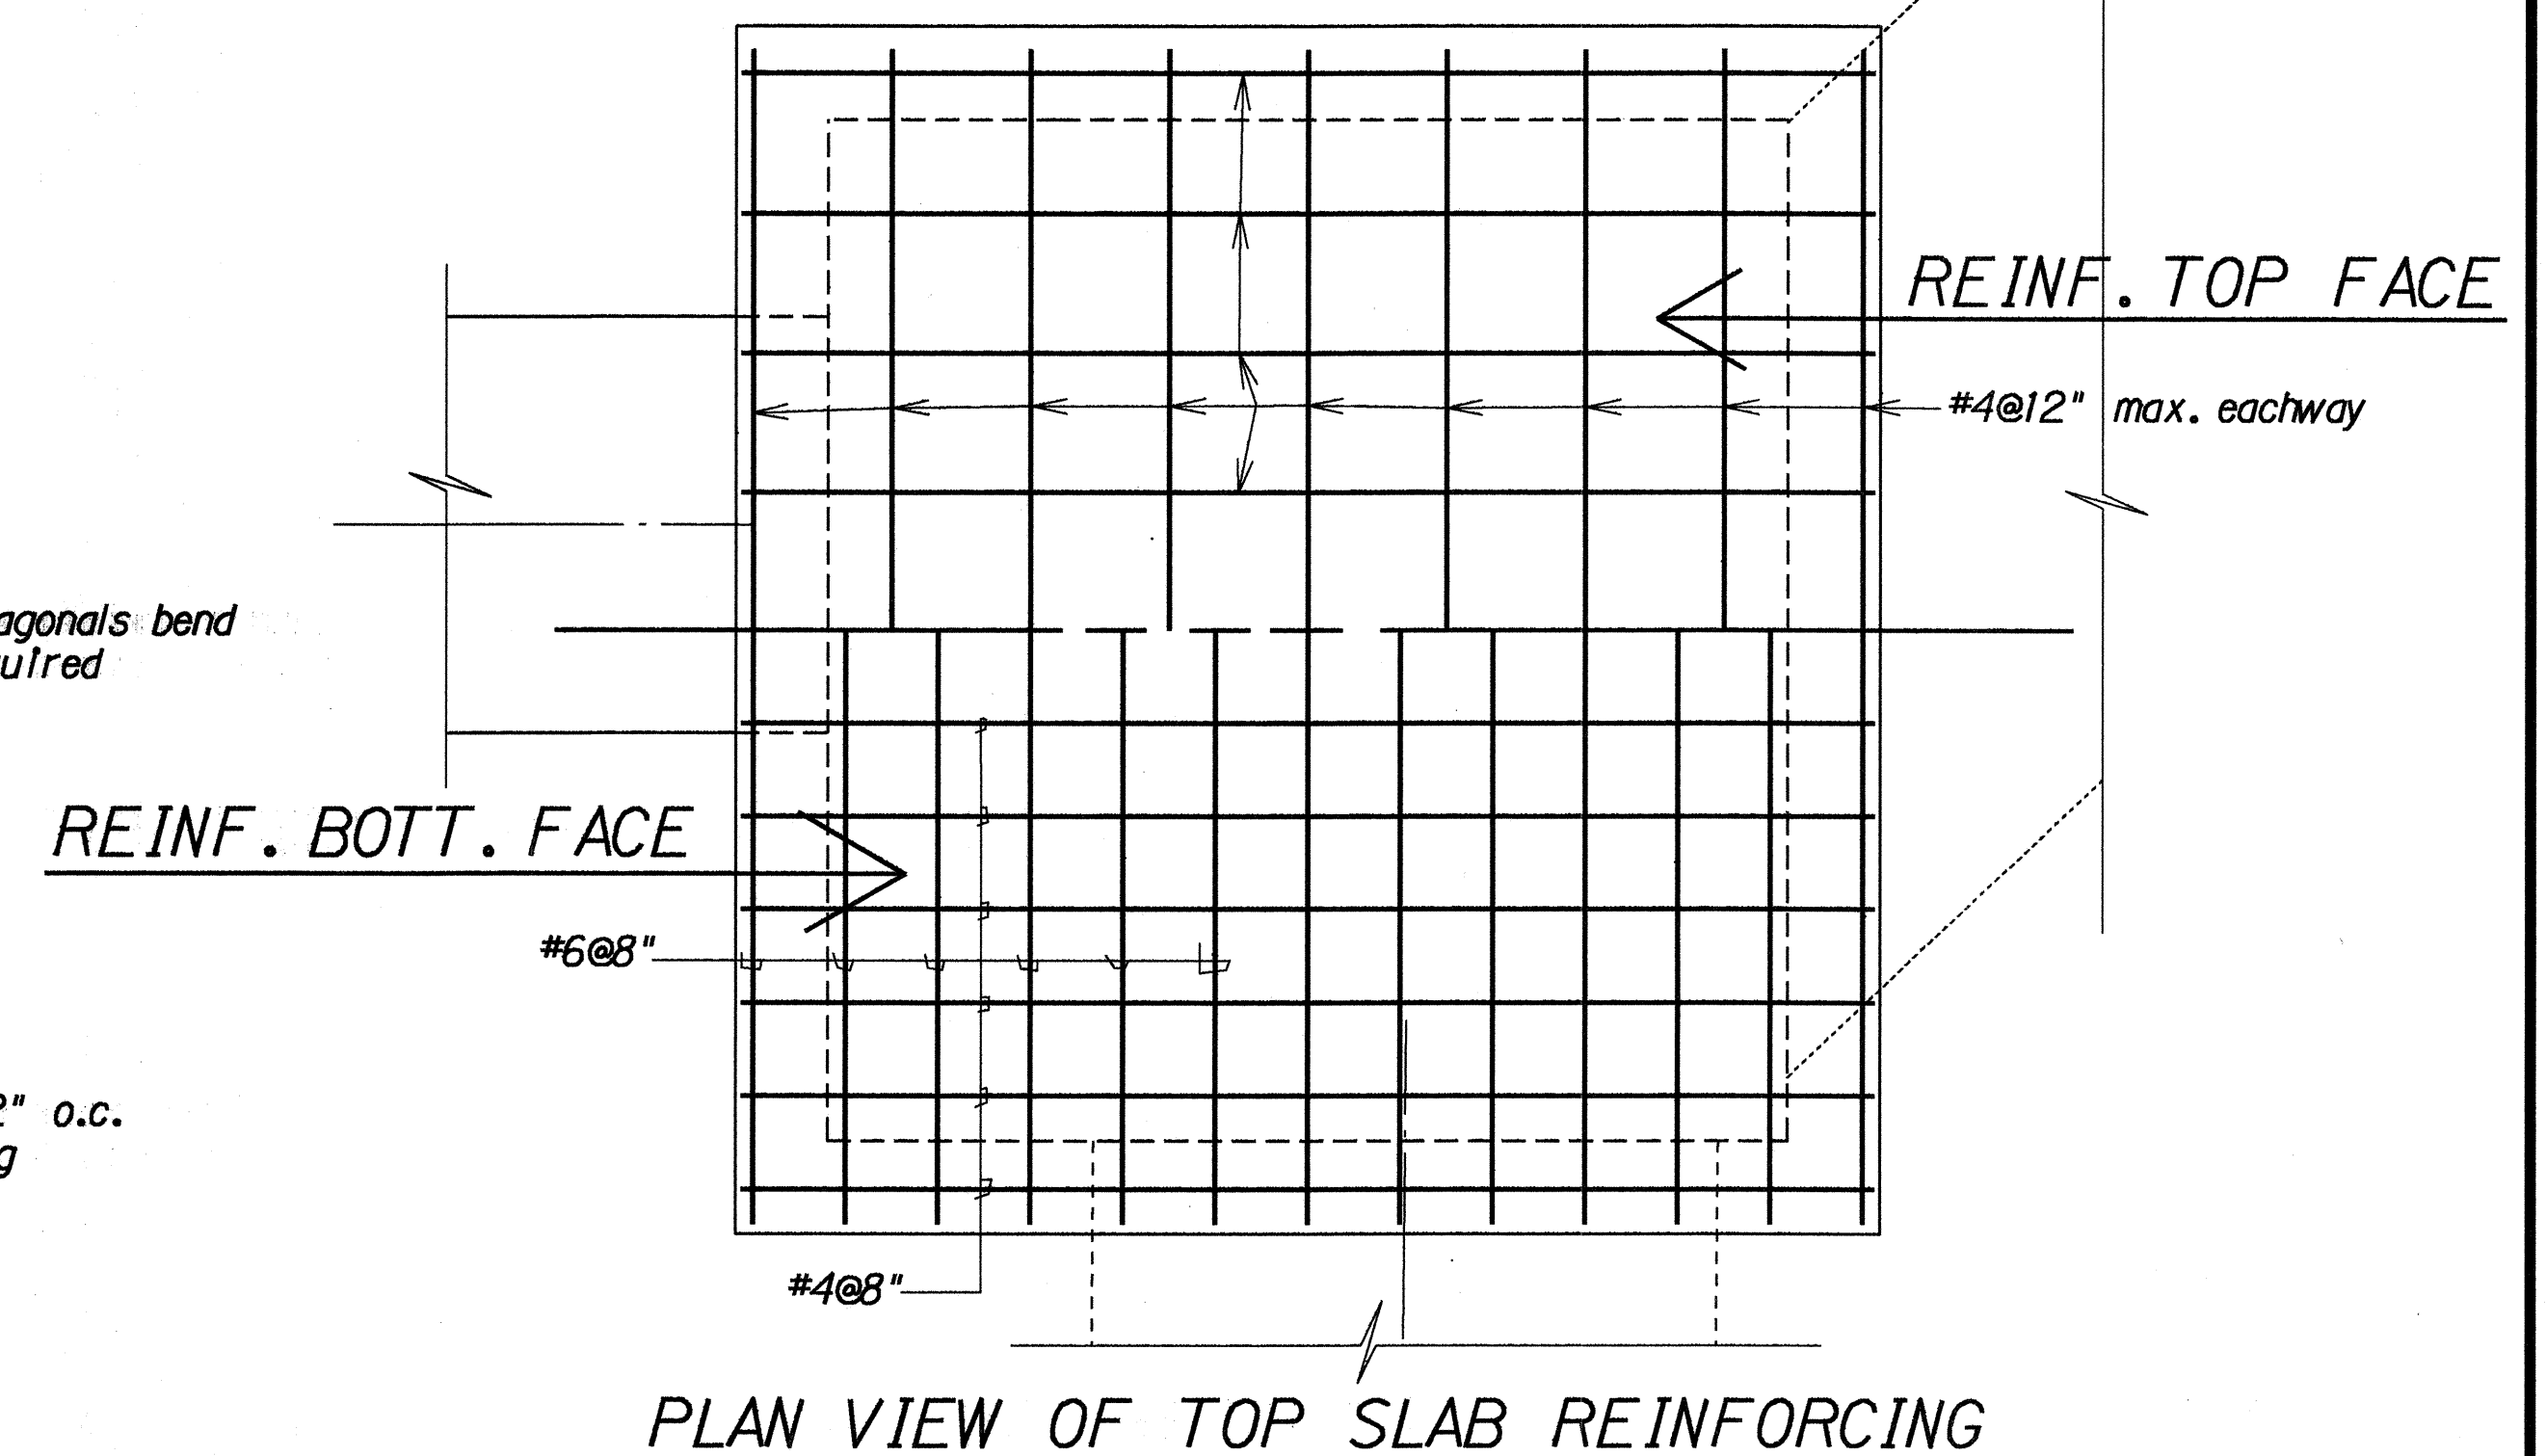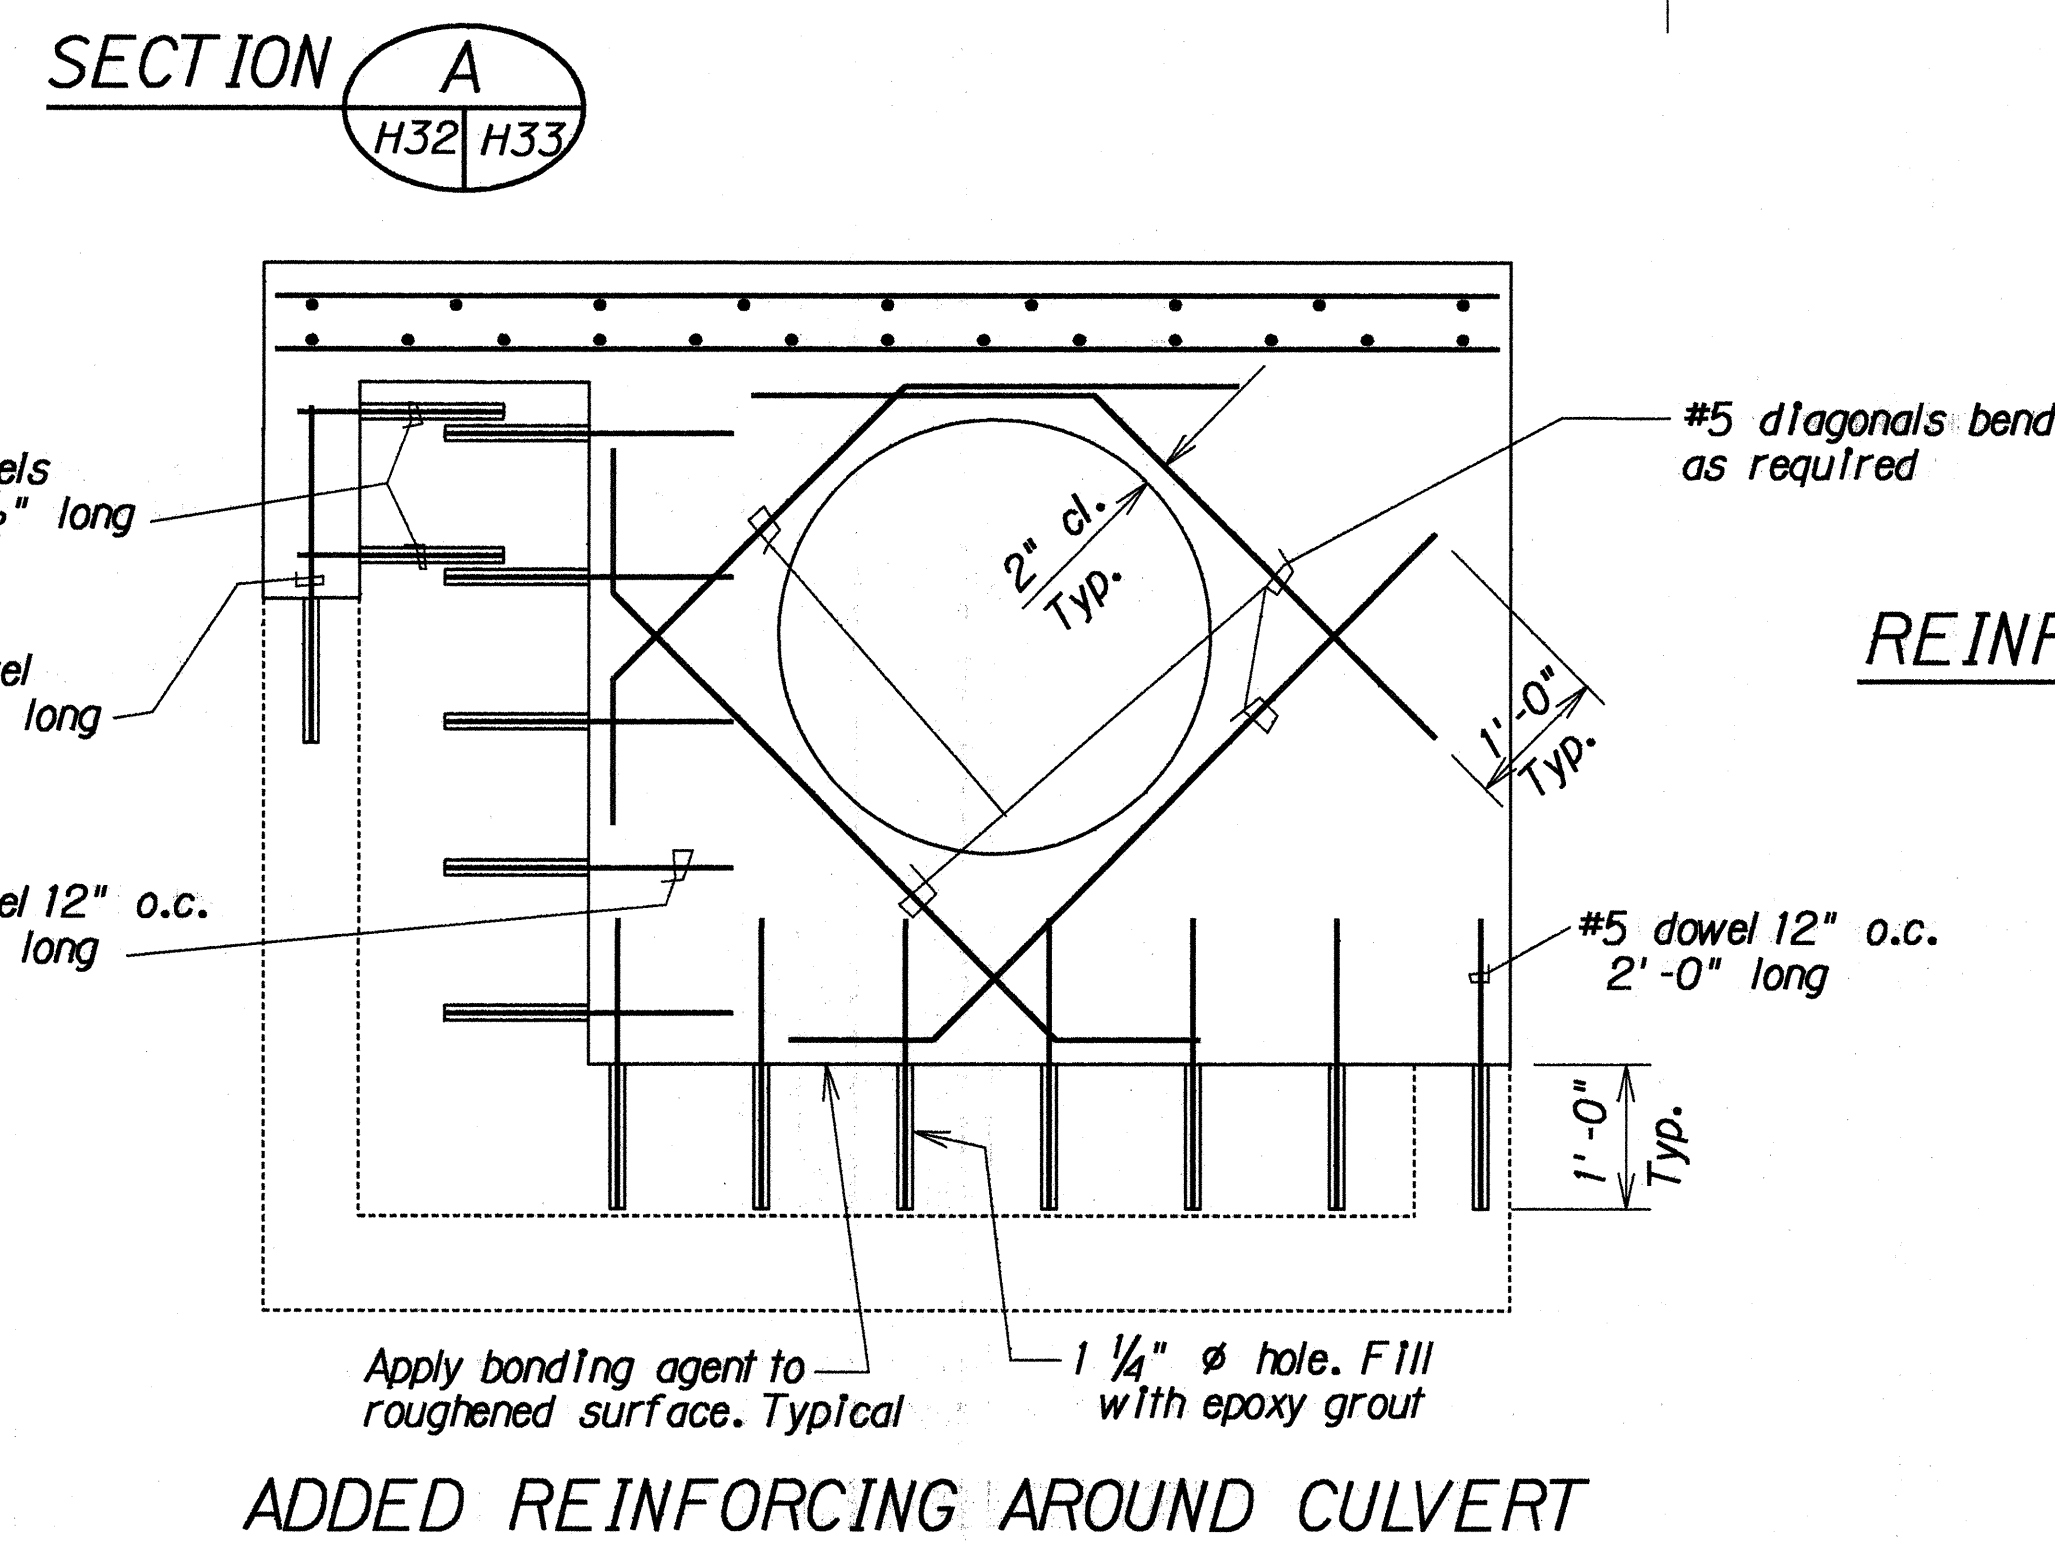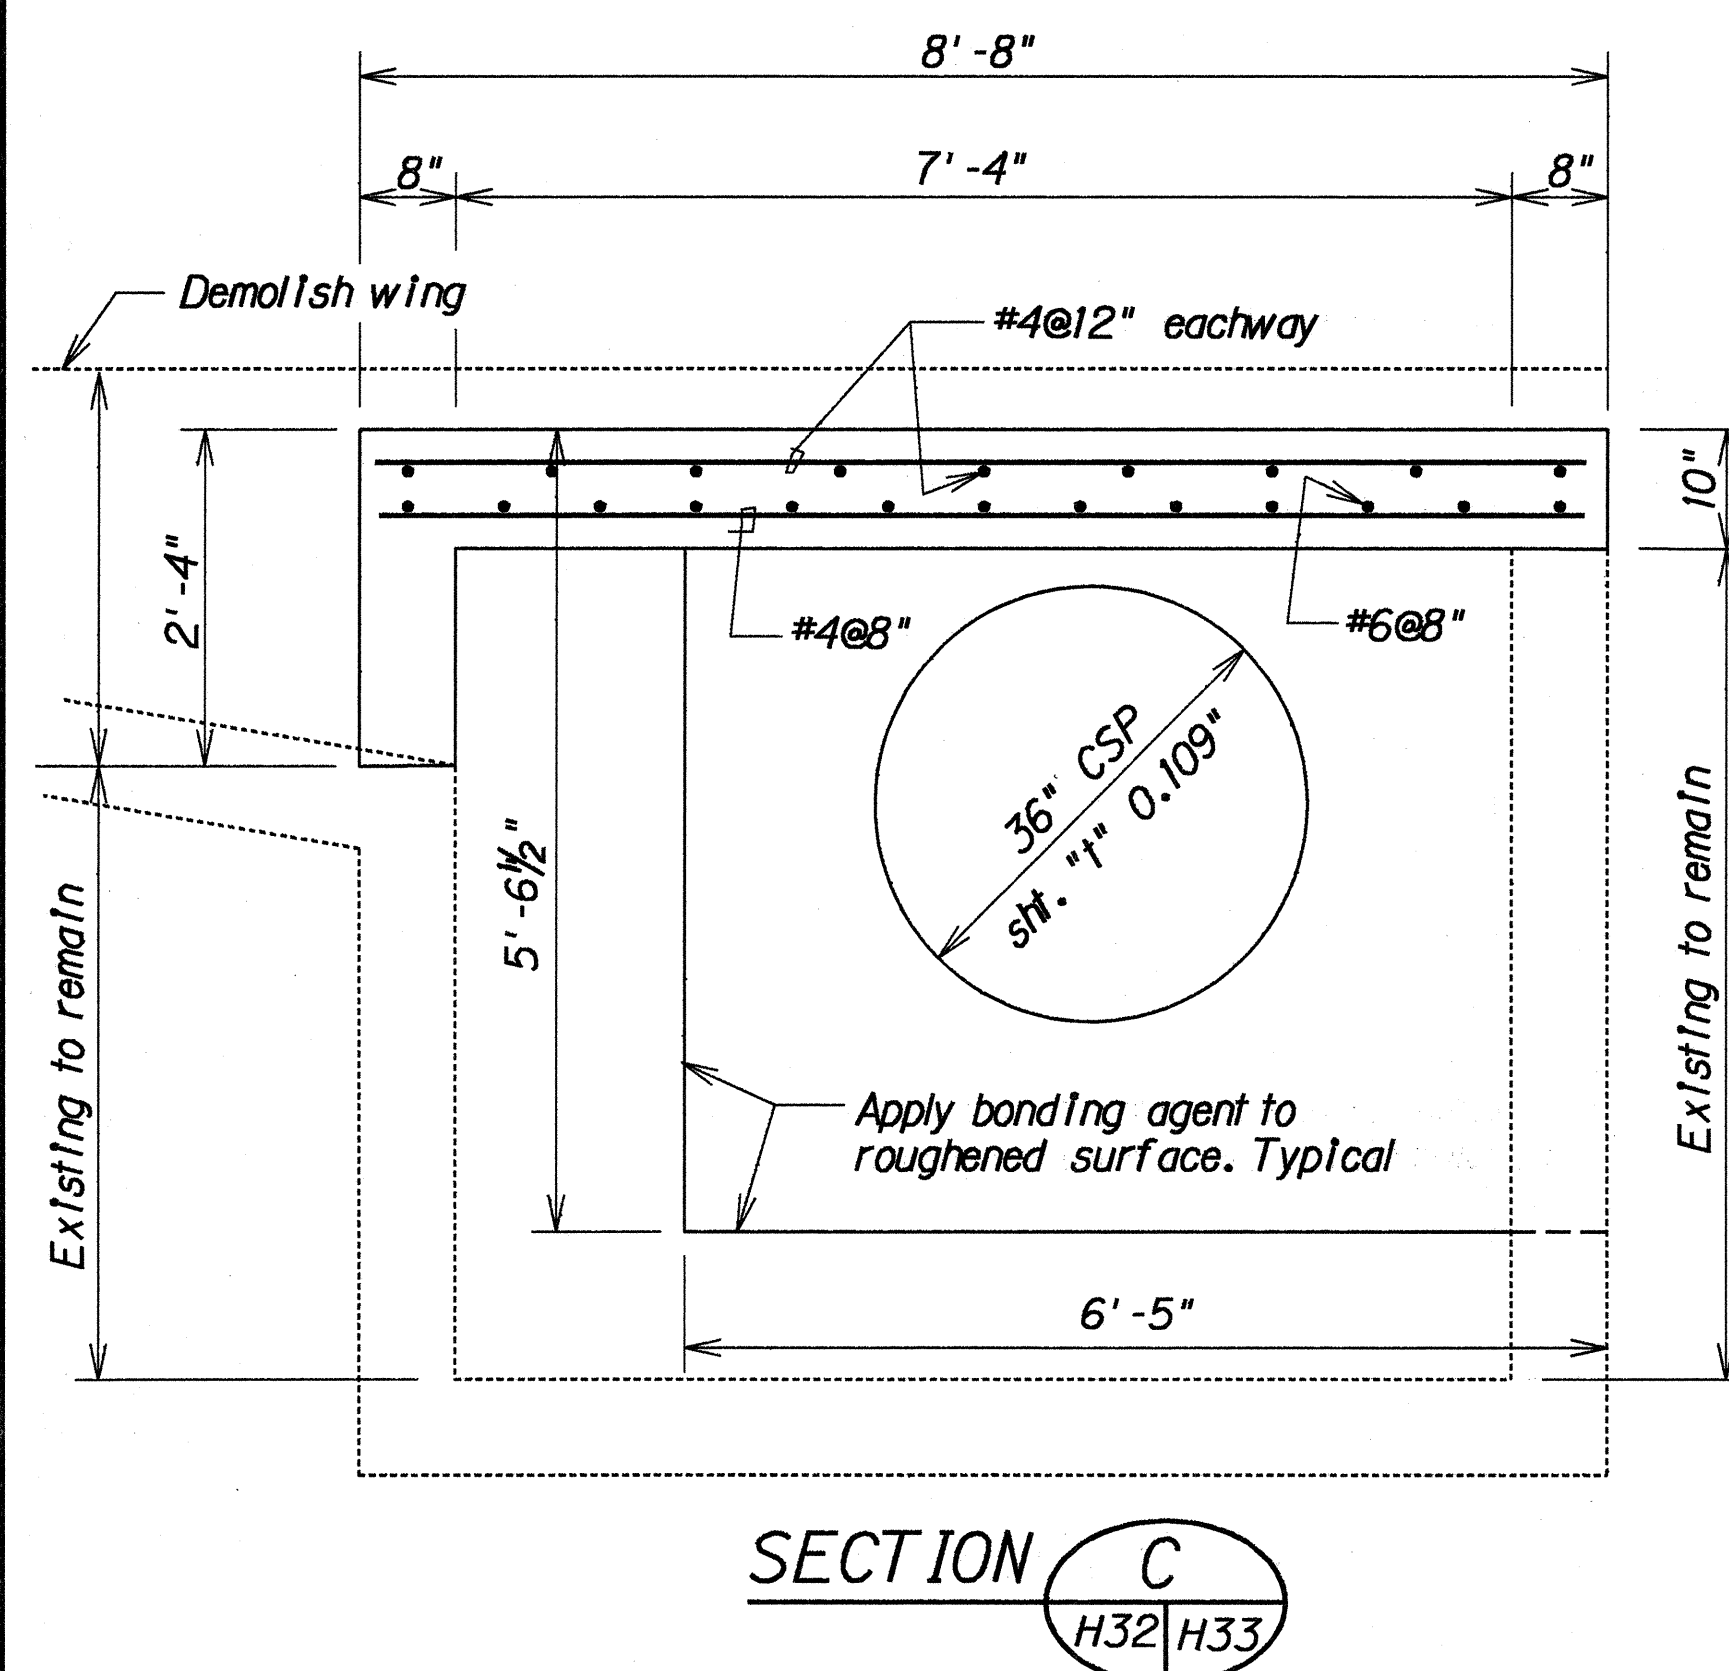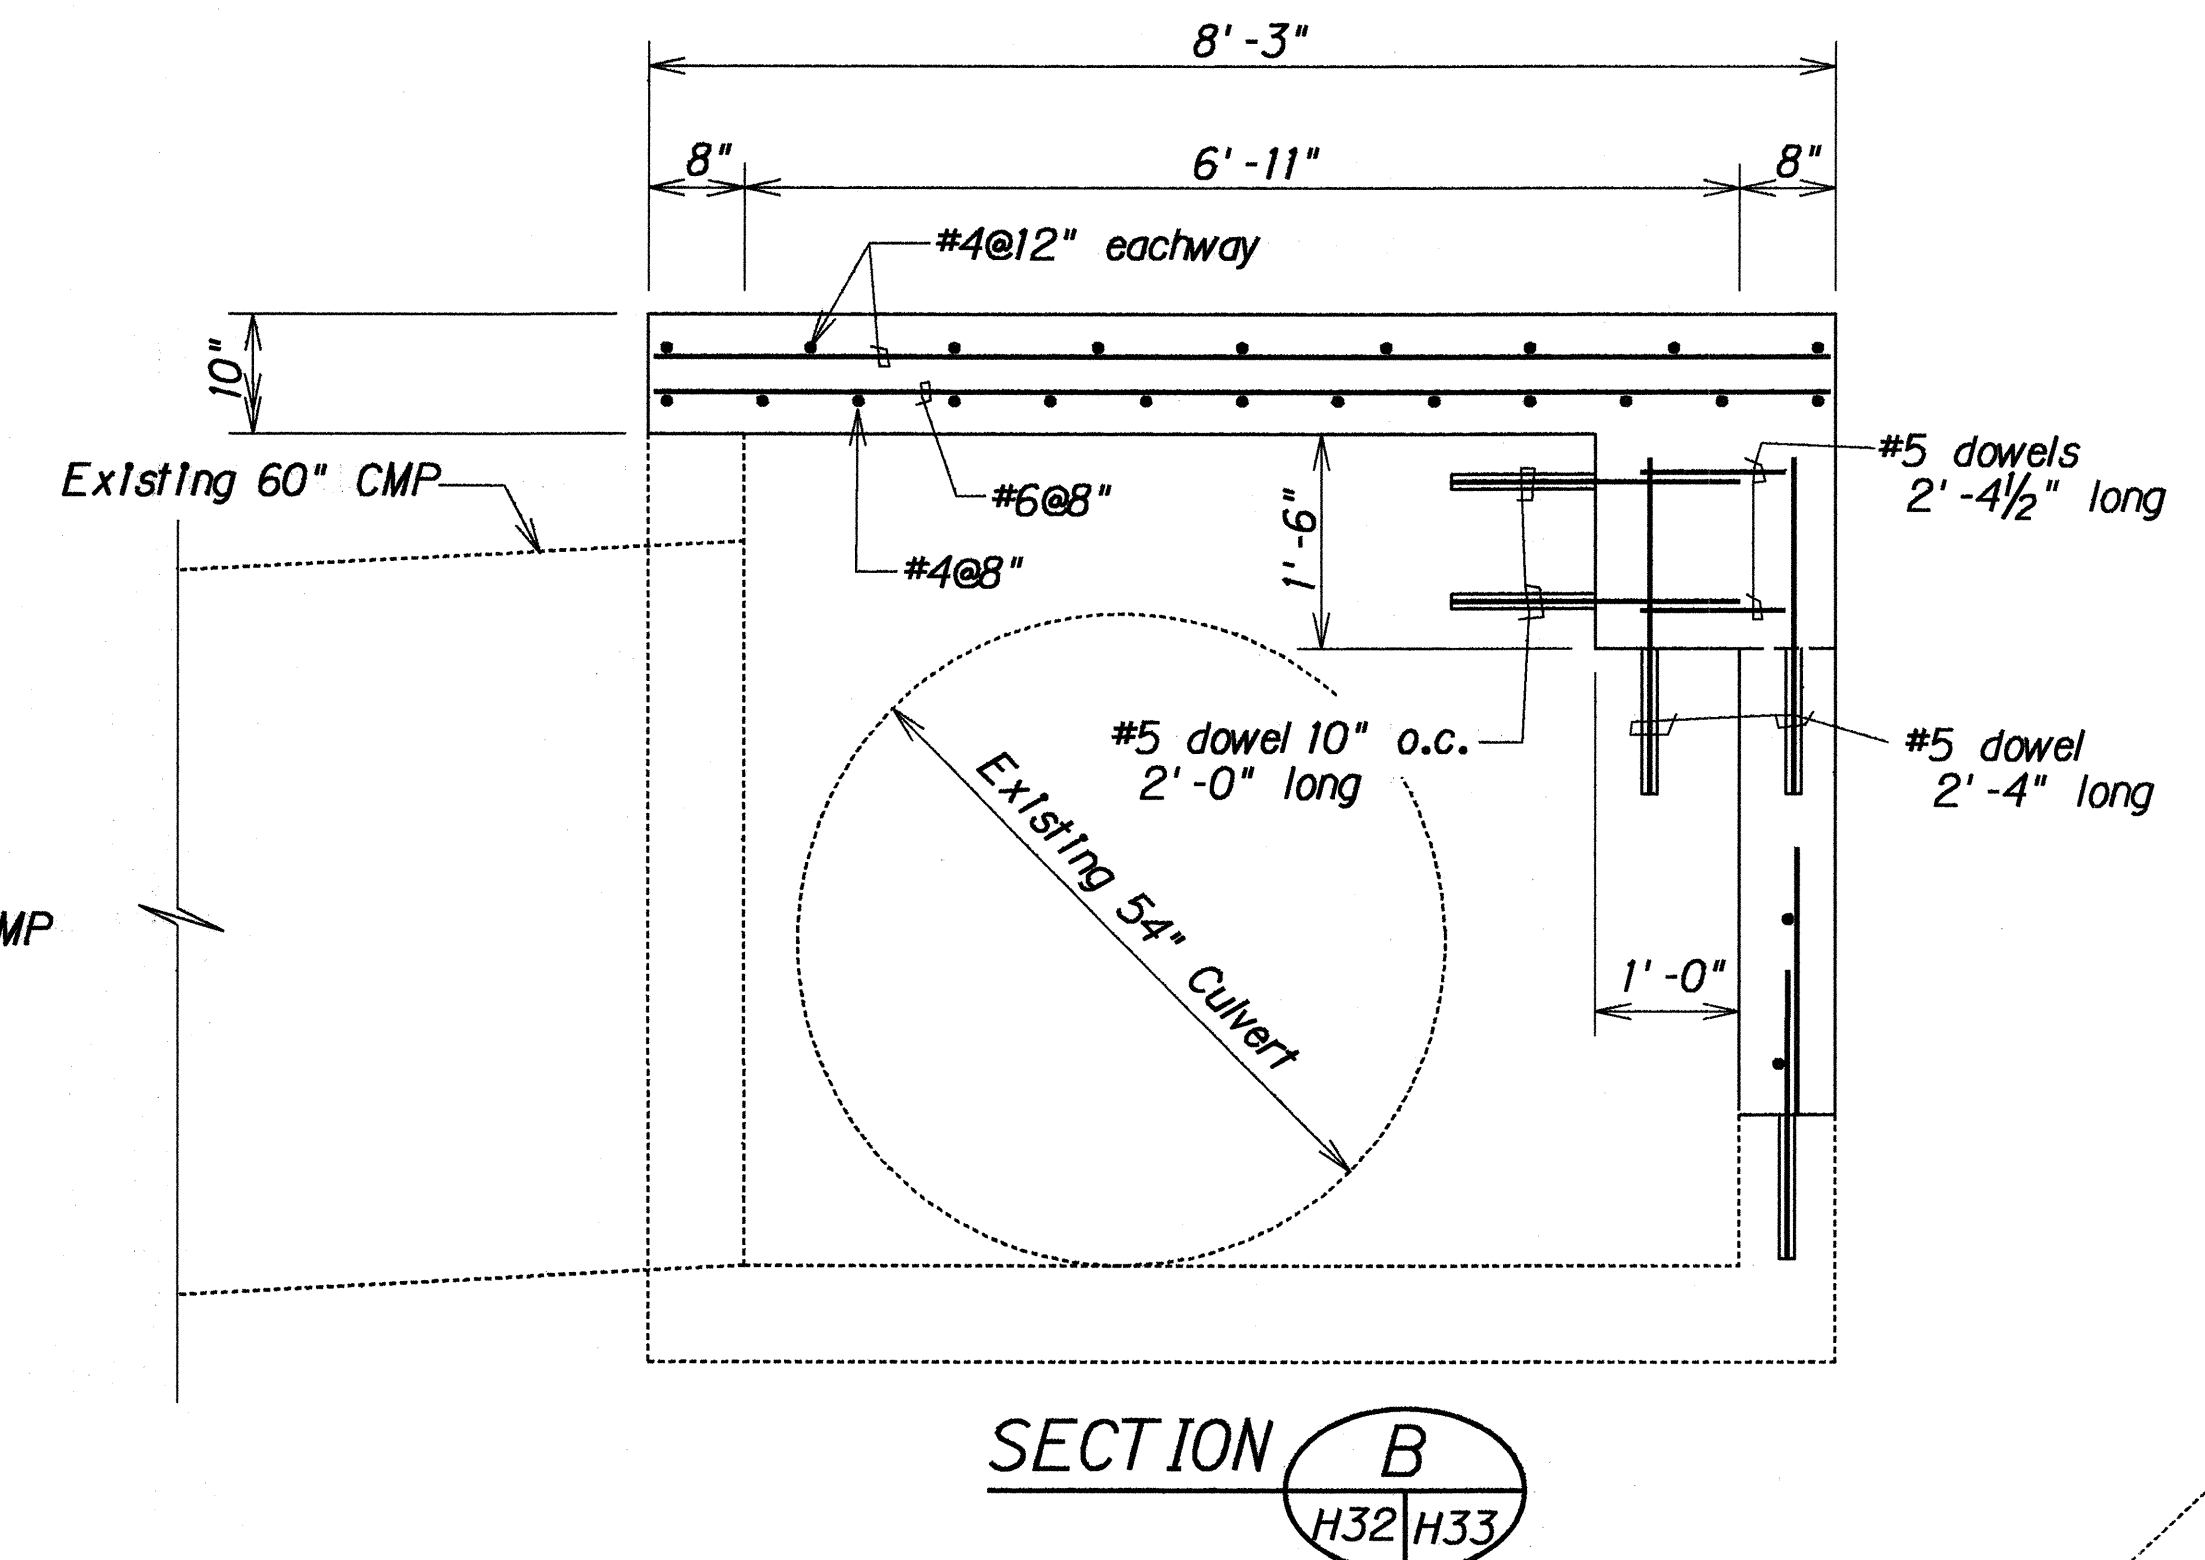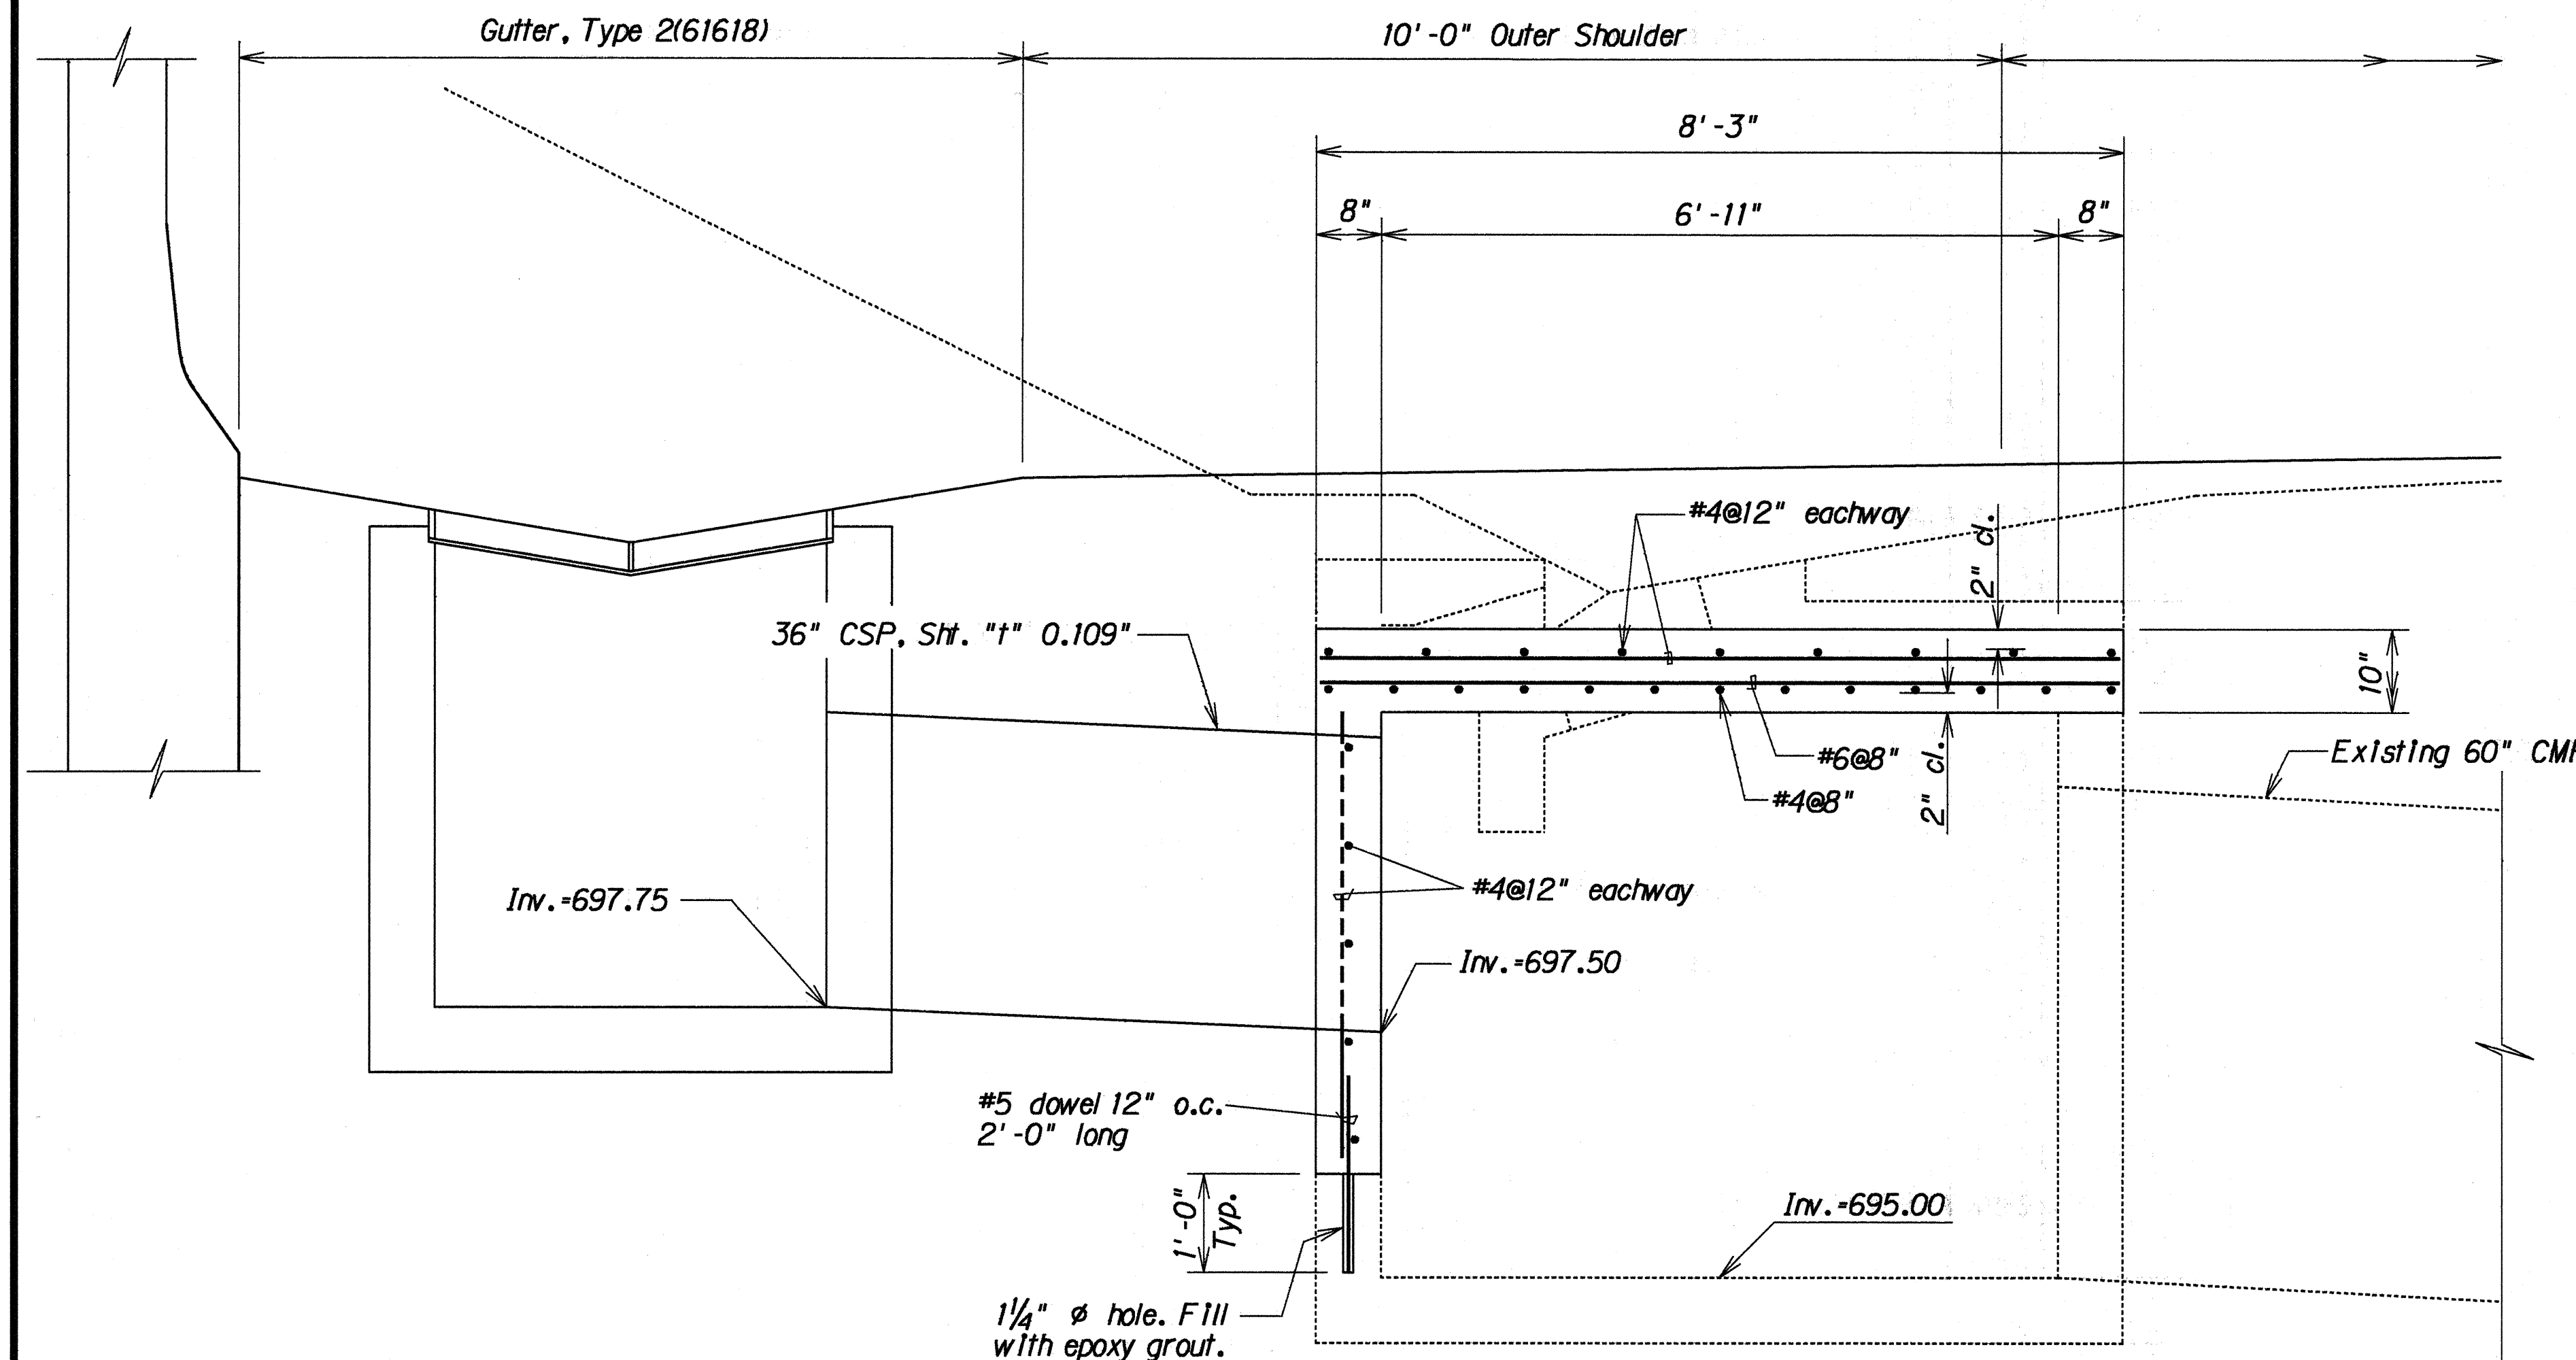

SECTION C
H32 H33

DETAILS OF TYPE "Y" STORM DRAIN MANHOLE AT O.B. $\pm$ STA. 211+75 O/S 52' LT.

STATE OF HAWAII
DEPARTMENT OF TRANSPORTATION
HIGHWAYS DIVISION


DRAINAGE DETAILS

INTERSTATE RTE. H-2, HOV LANES, PH. II
Miliiani Interchange to Waipio Interchange
F.A.I. PROJECT NO. IR-H2-1(27)


Scale: $\frac{3}{4}$ " = 1'-0" Date: Apr., 1992

SHEET No. H33 OF 42 SHEETS


FED. ROAD DIST. NO.	STATE	FED. AID PROJ. NO.	FISCAL YEAR	SHEET NO.	TOTAL SHEETS
HAWAII	HAW.	IR-H2-1(27)	1992	125	223

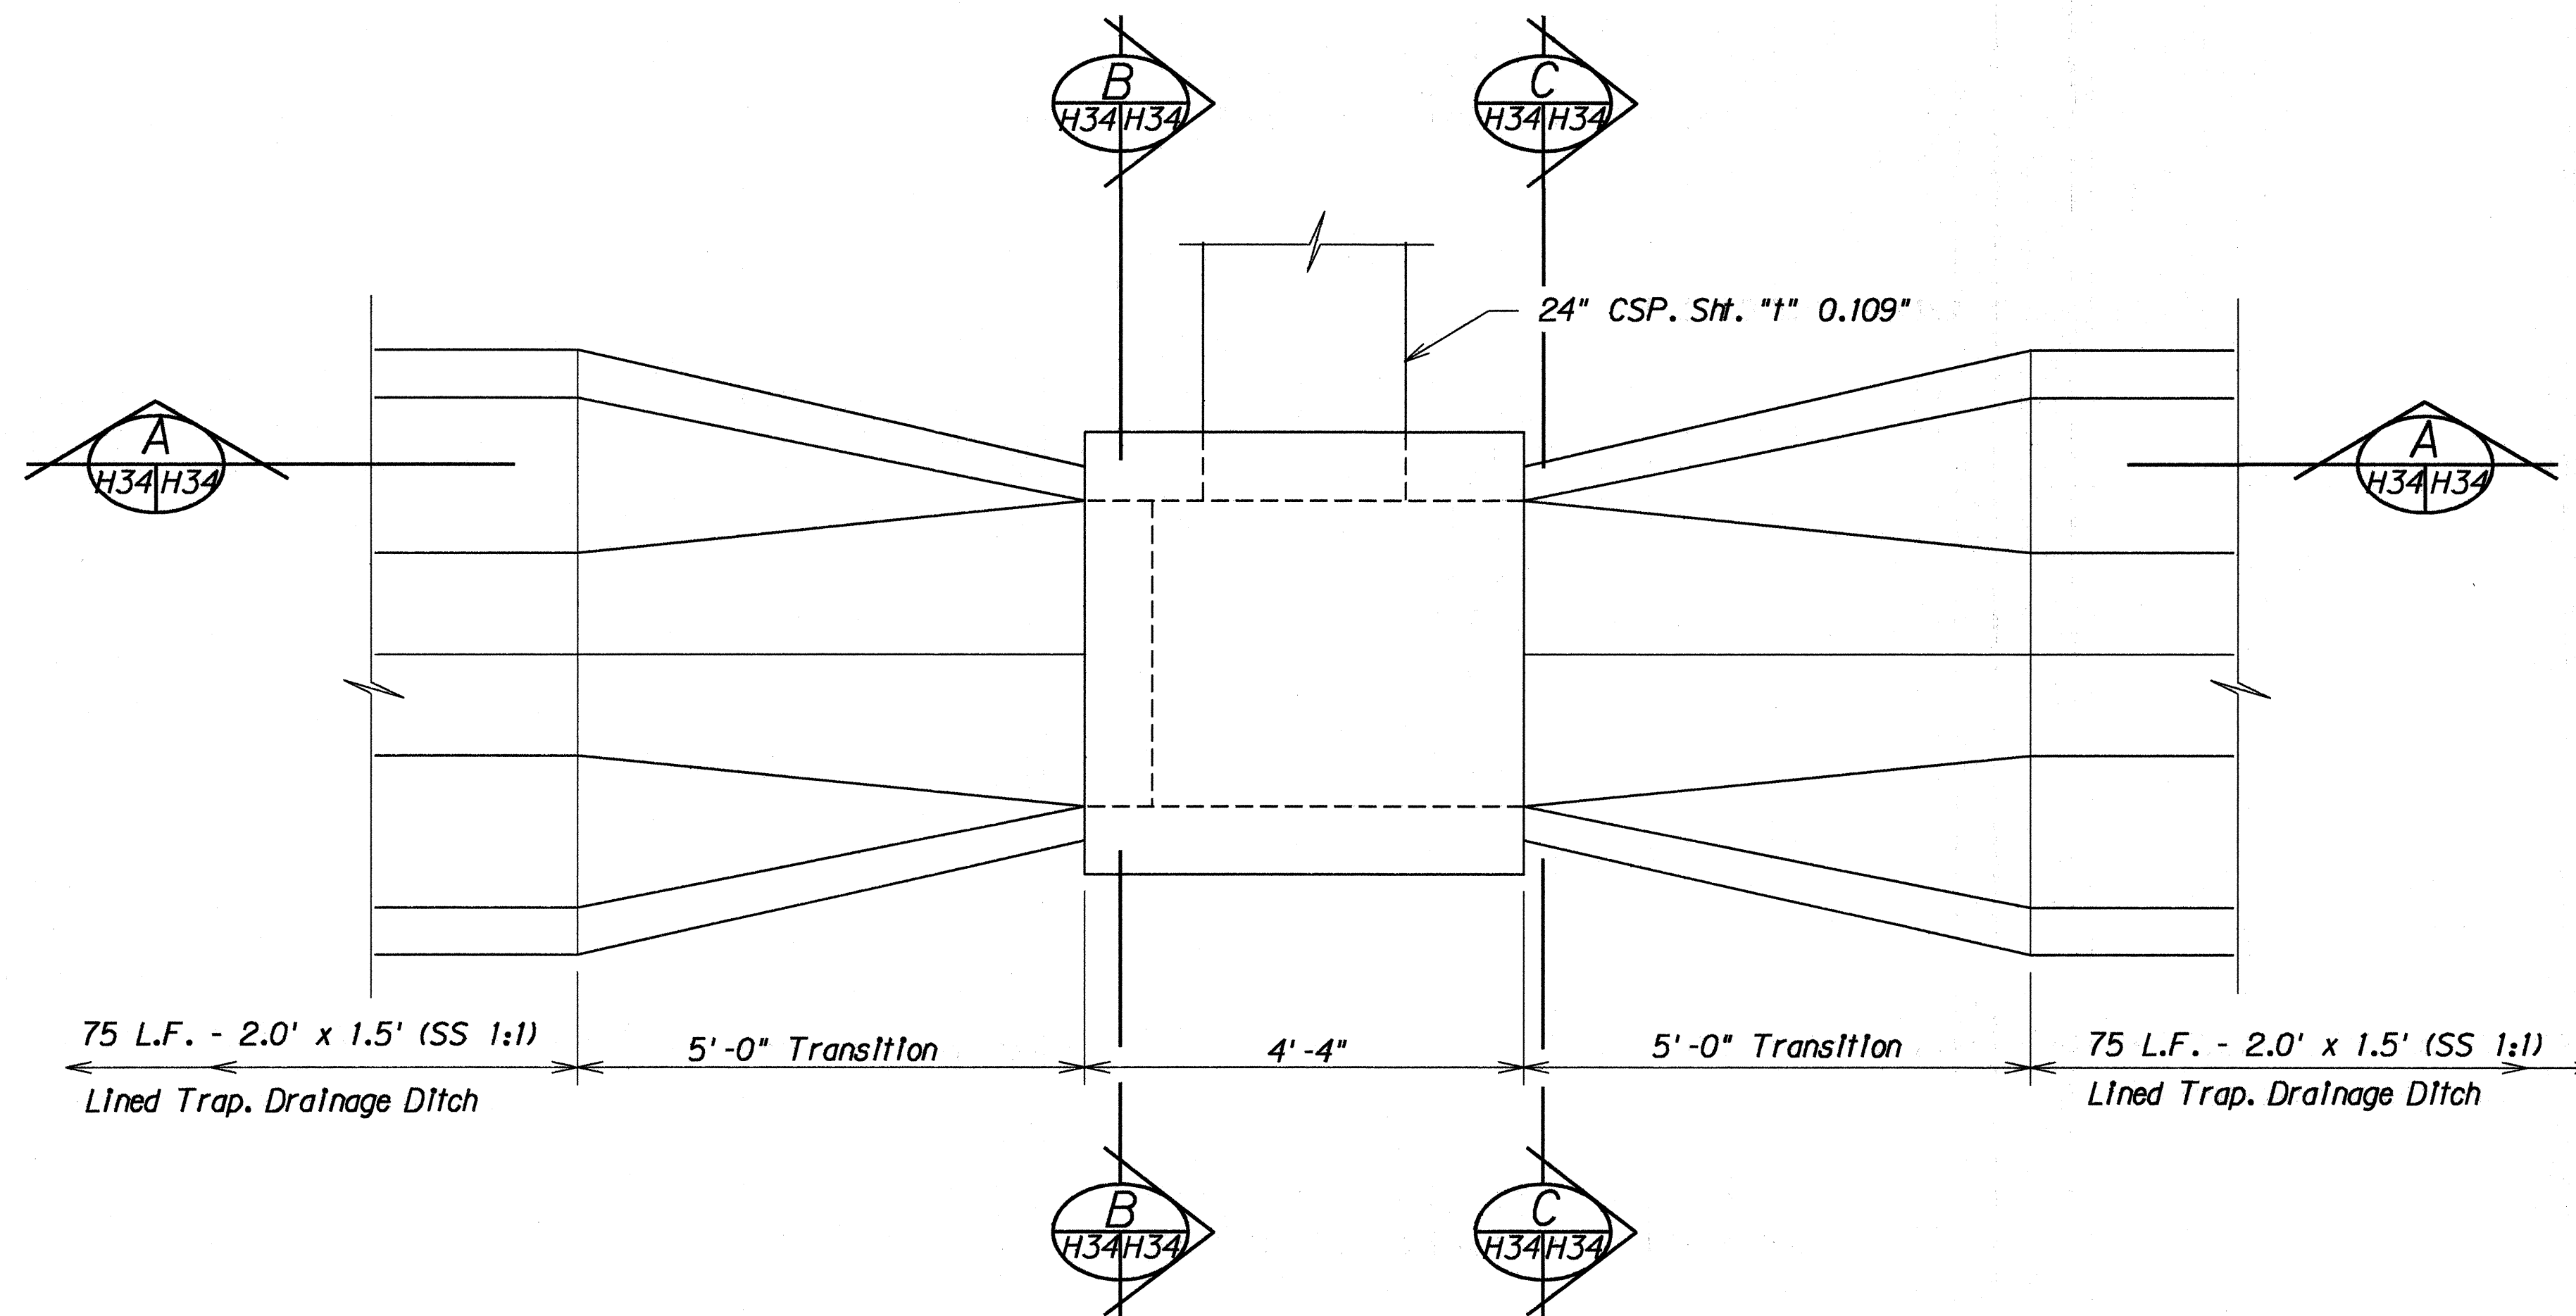


PLAN

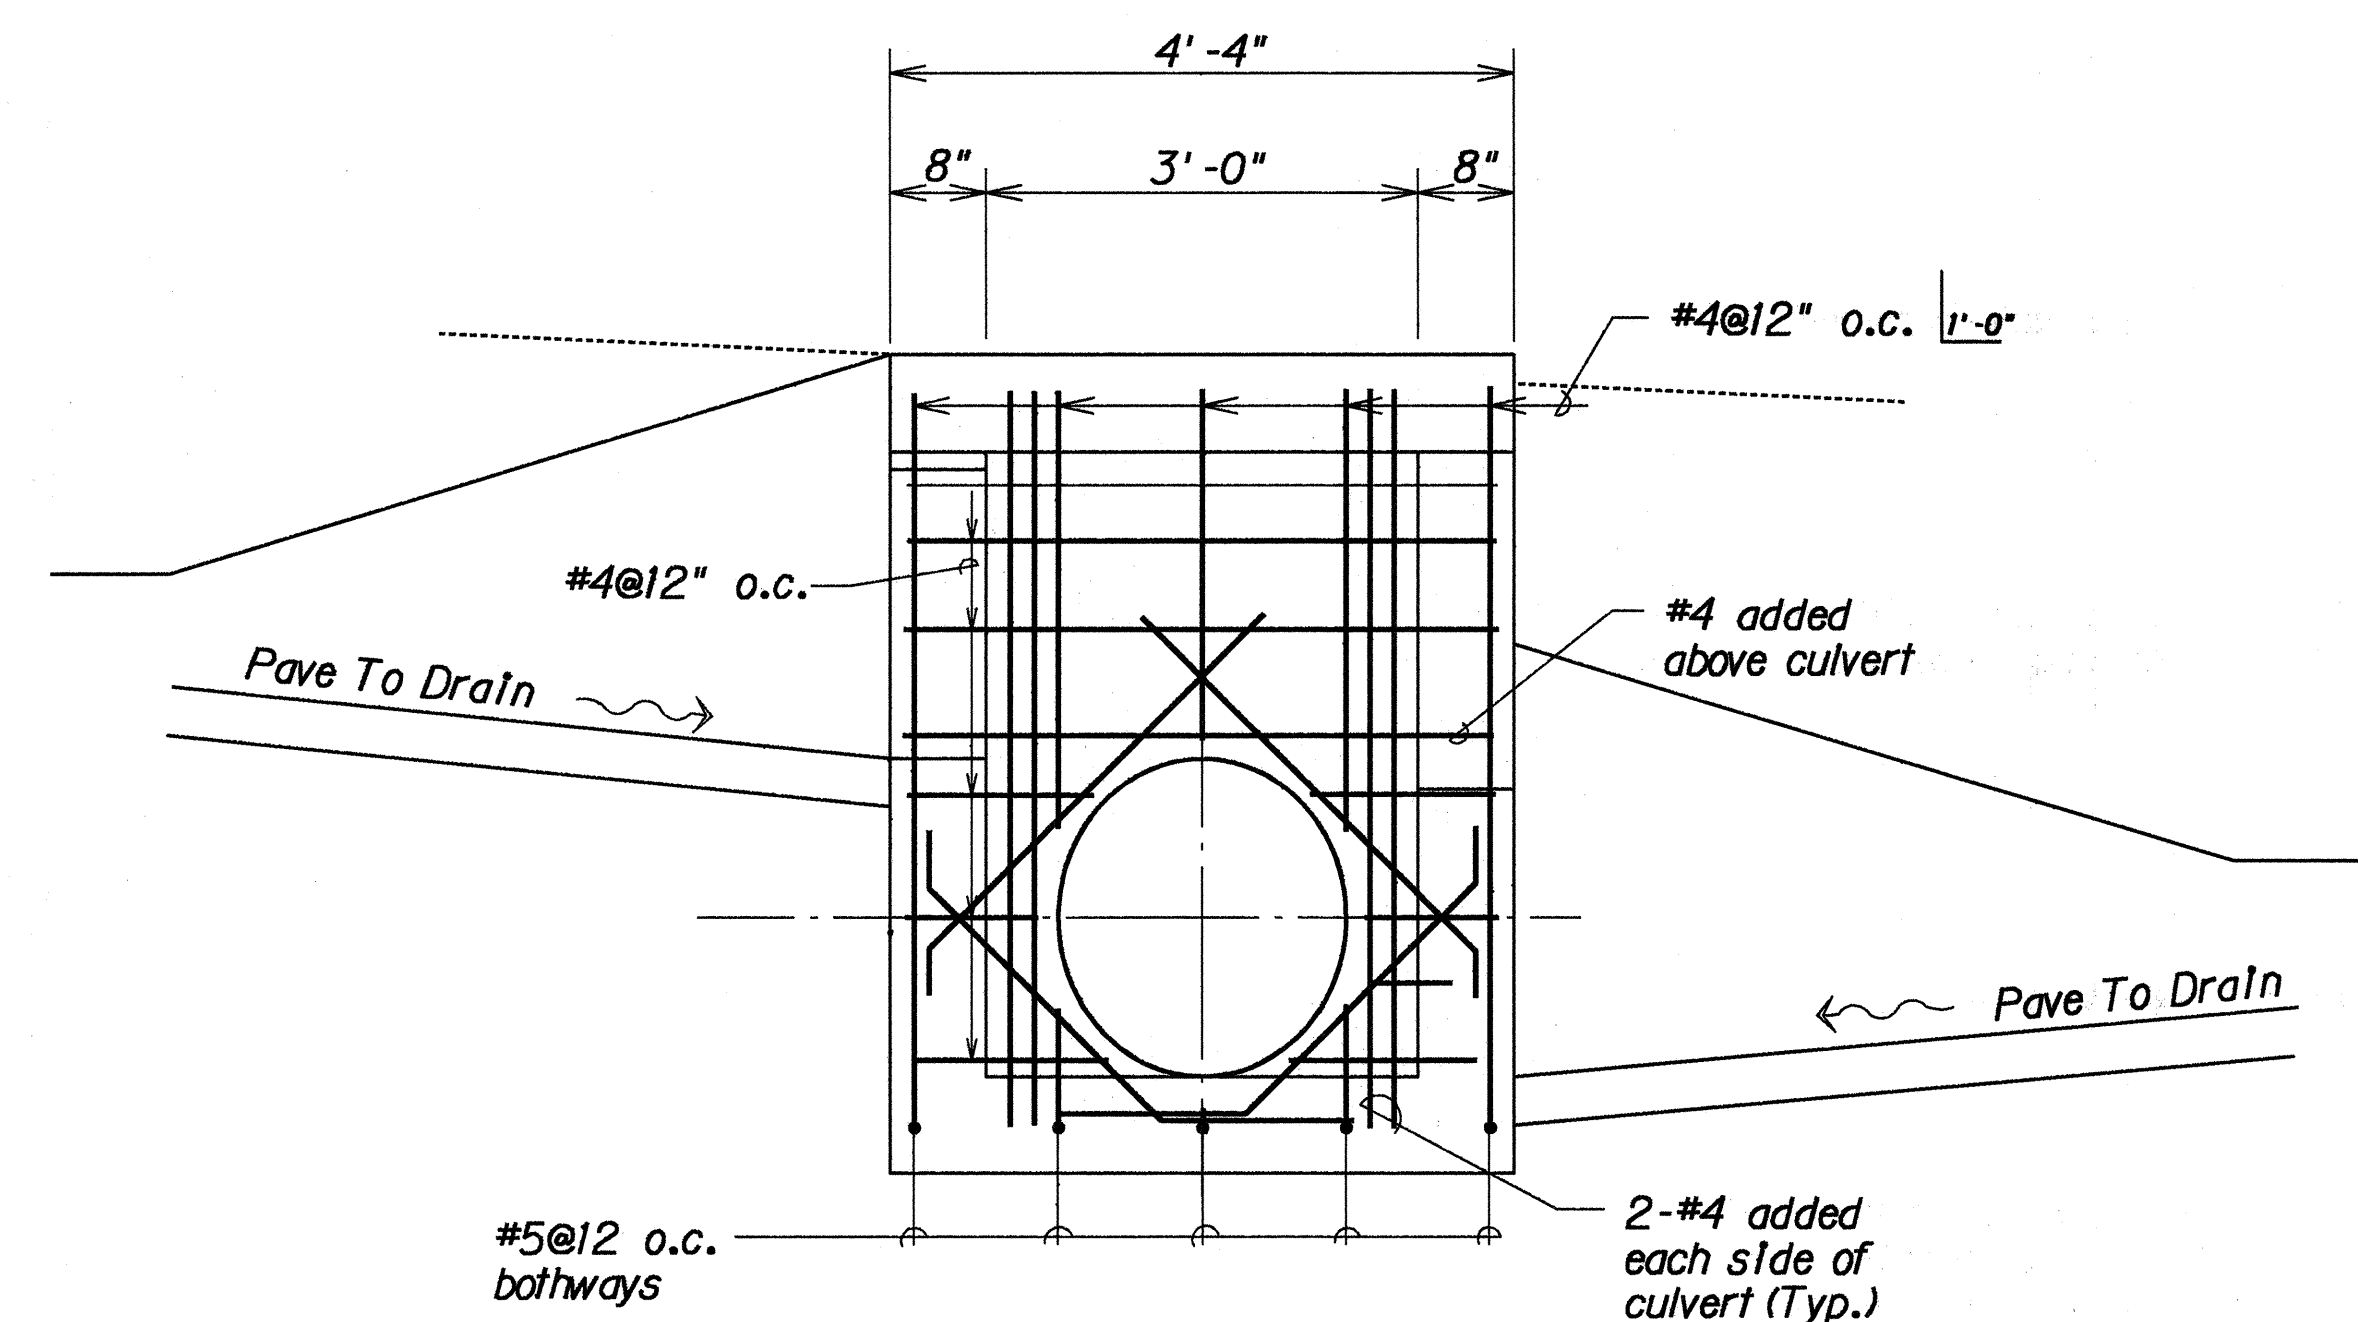


SECTION A
H34 | H34

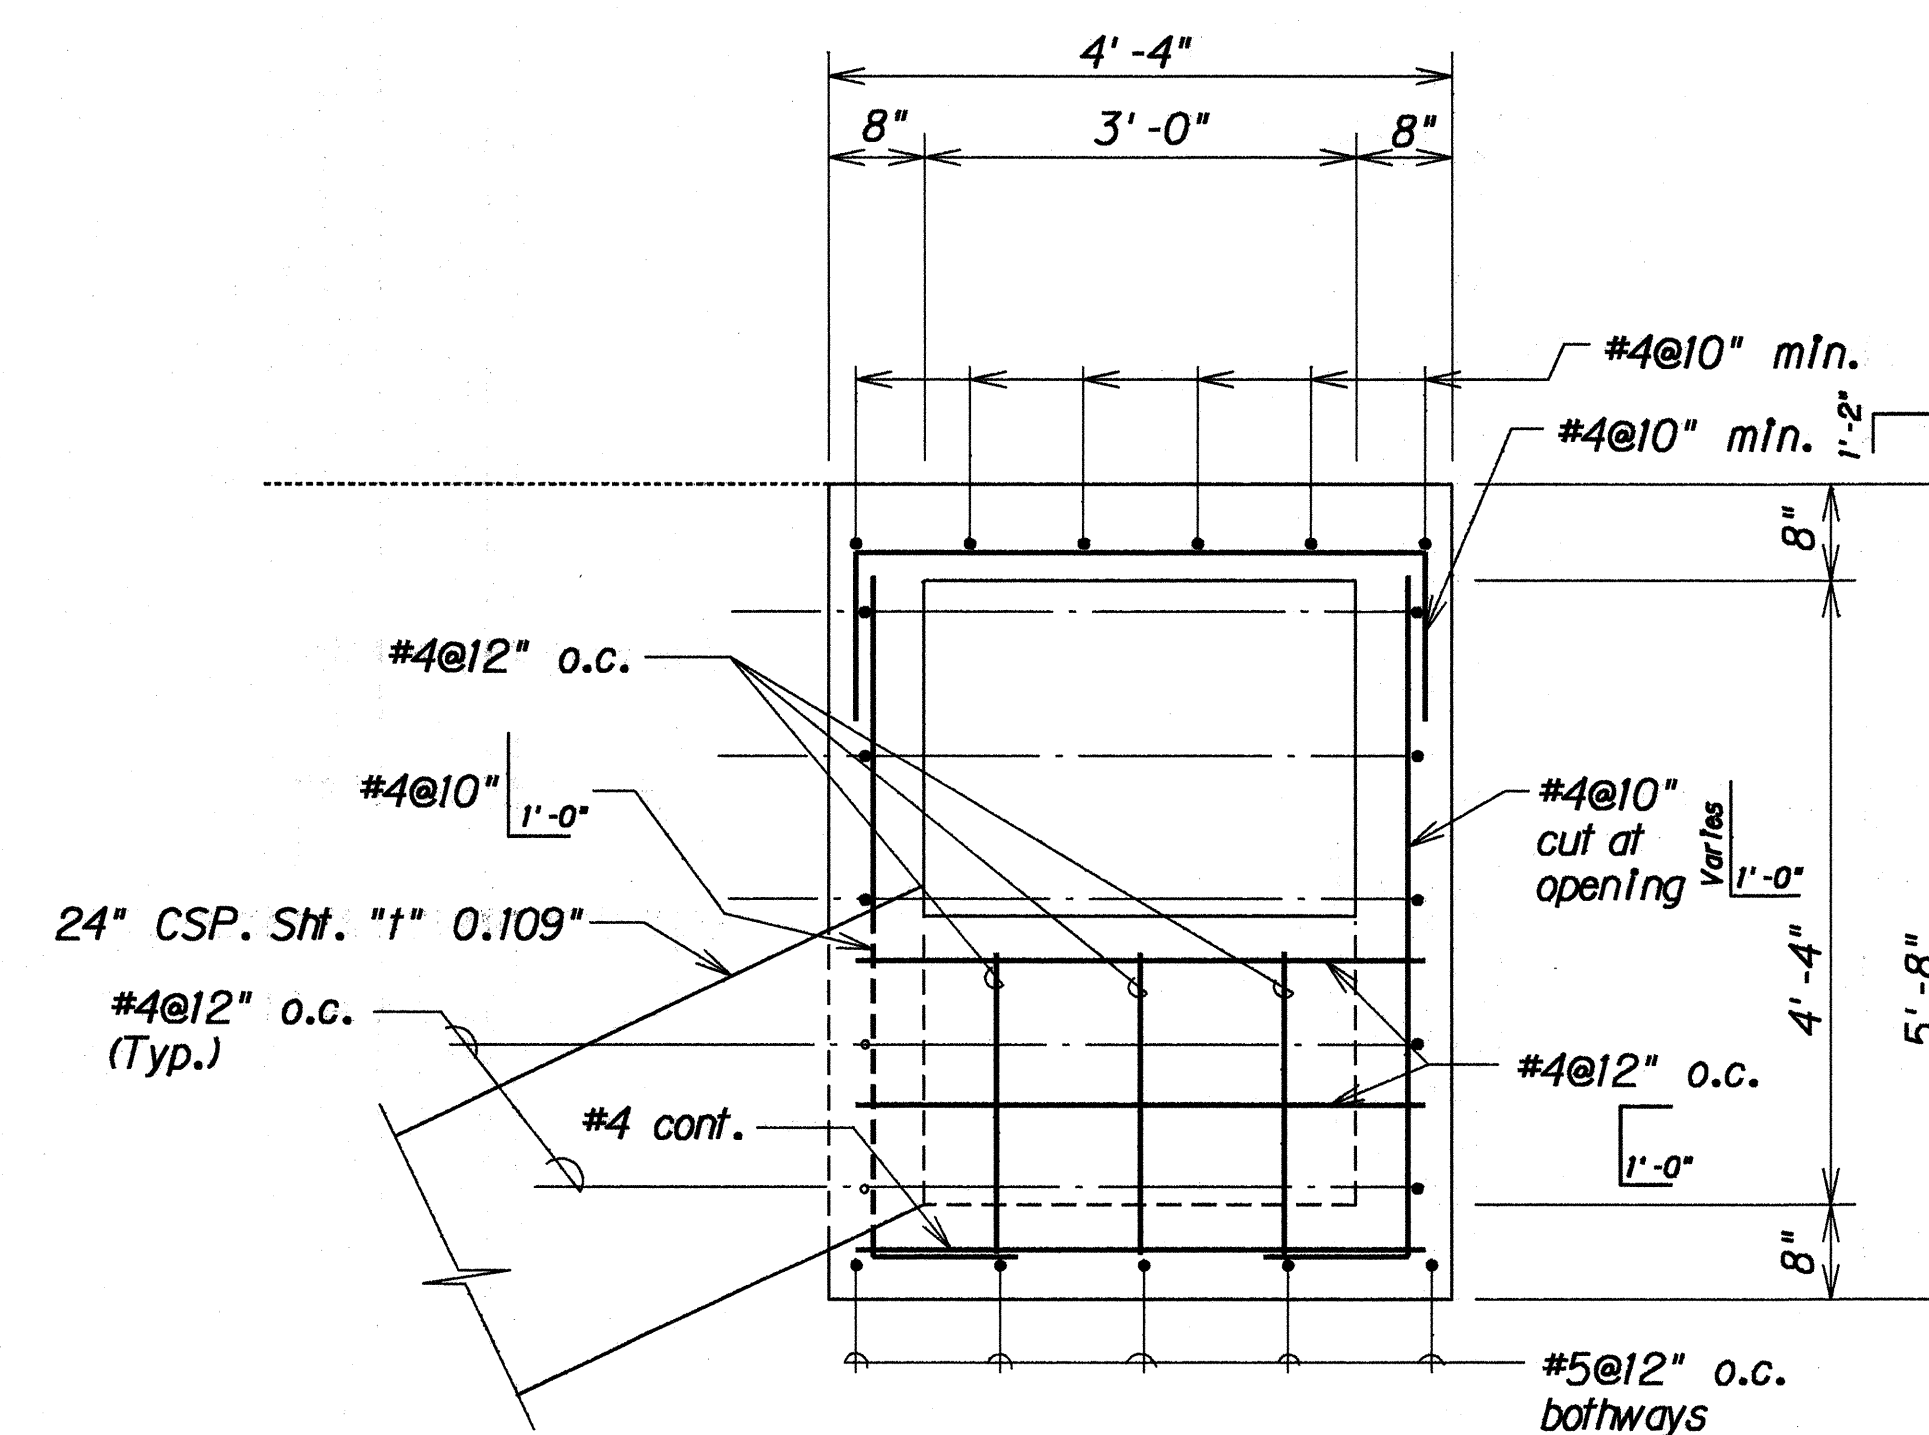

SECTION B

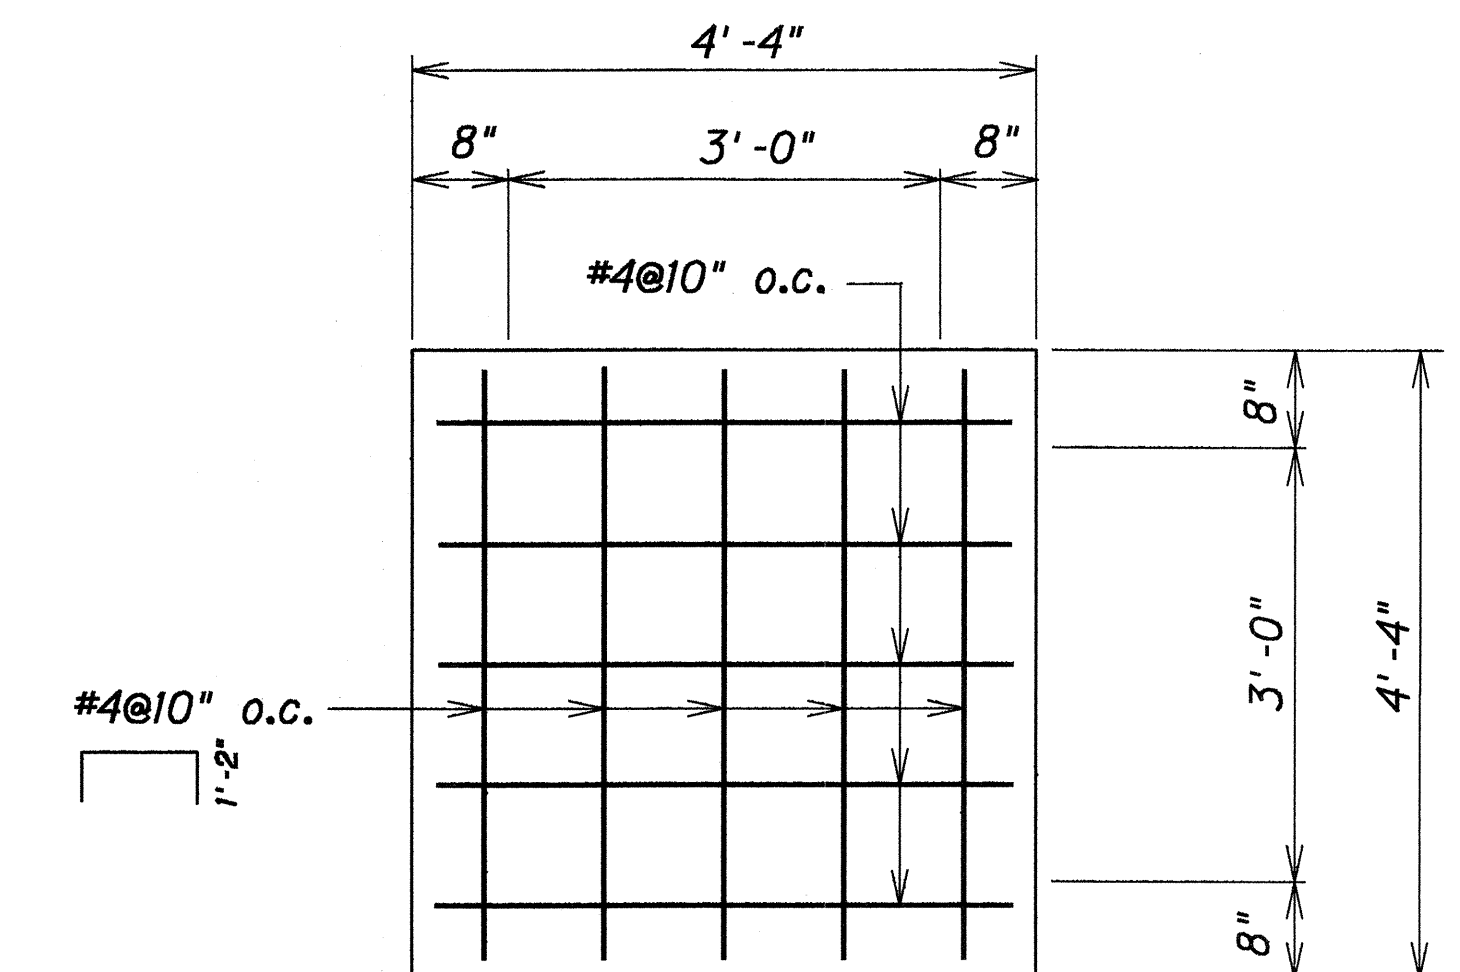

PLAN VIEW OF TOP SLAB REINFORCING

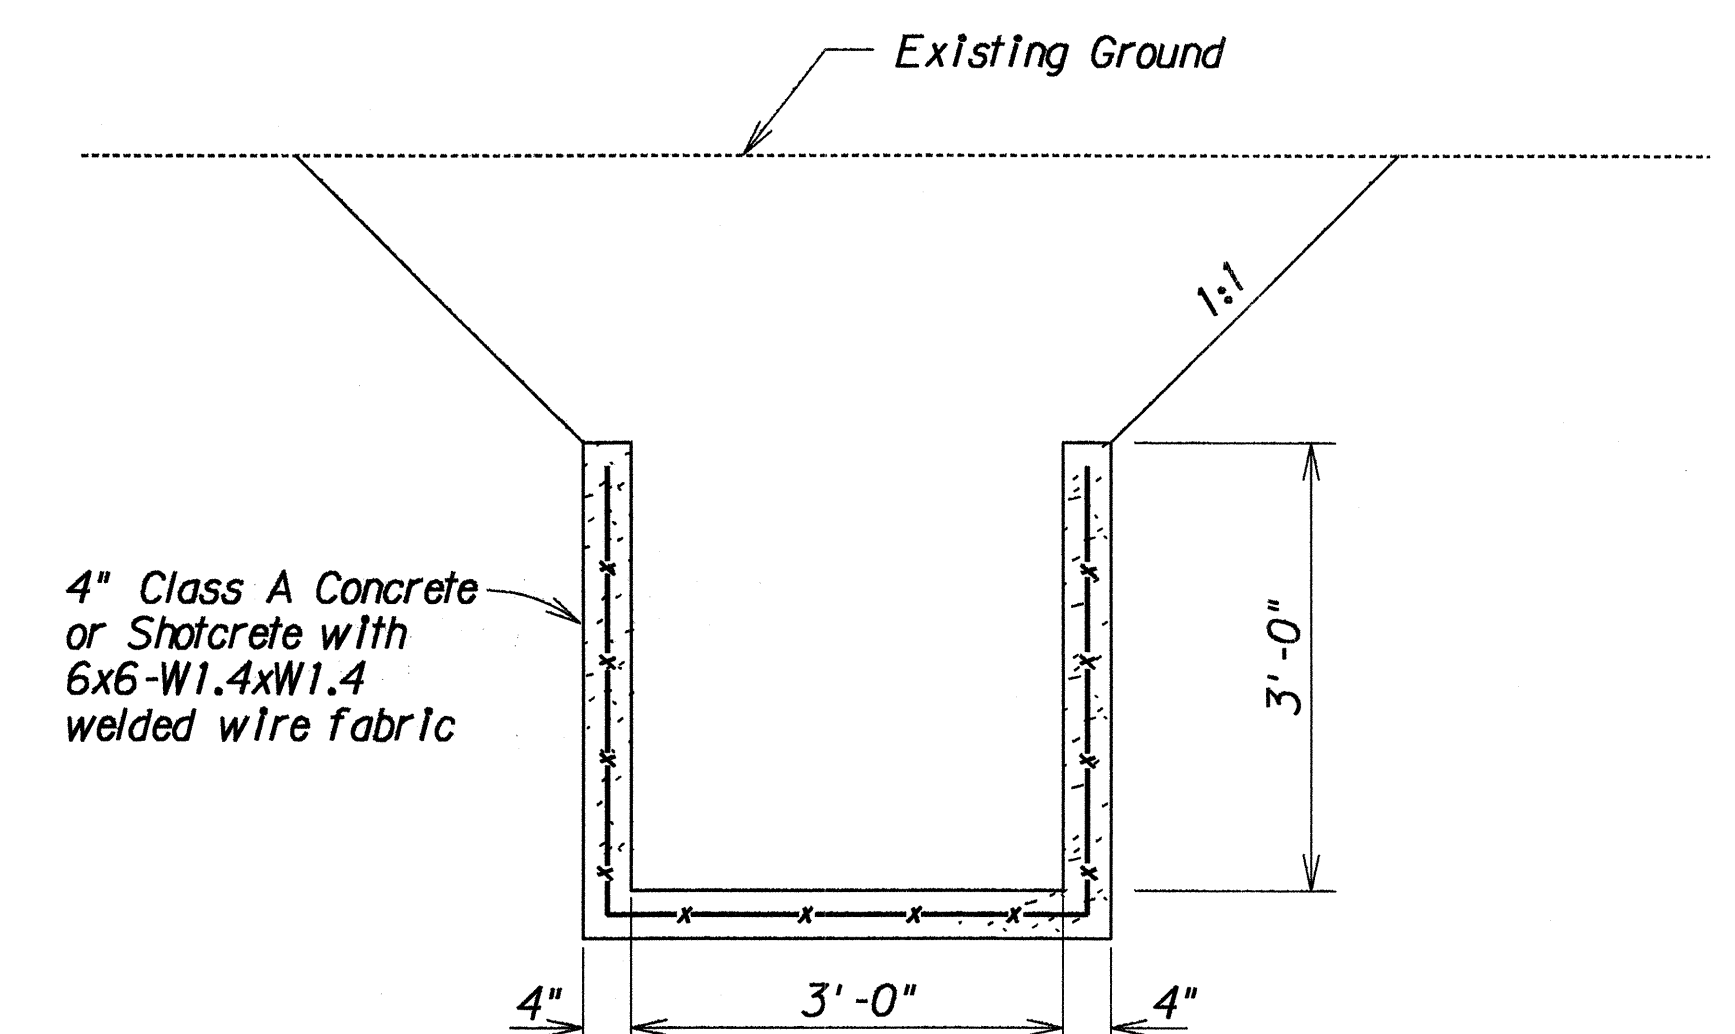

SECTION 

STATE OF HAWAII
DEPARTMENT OF TRANSPORTATION
HIGHWAYS DIVISION

DRAINAGE DETAILS




INTERSTATE RTE. H-2, HOV LANES, PH. II
Mililani Interchange to Waipio Interchange
F.A.I. PROJECT NO. IR-H2-1(27)

Scale: $\frac{3}{4}" = 1' - 0"$ Date: Apr., 1992

SHEET No. *H34* OF 42 SHEETS

ORIGINAL PLAN	SURVEY PLOTTED BY _____ DATE _____
NOTE BOOK	DRAWN BY _____
	TRACED BY _____
	DESIGNED BY _____
	QUANTITIES BY _____
	CHECKED BY _____
	N. _____

FED. ROAD DIST. NO.	STATE	FED. AID PROJ. NO.	FISCAL YEAR	SHEET NO.	TOTAL SHEETS
HAWAII	HAW.	IR-H2-1(27)	1992	126	223

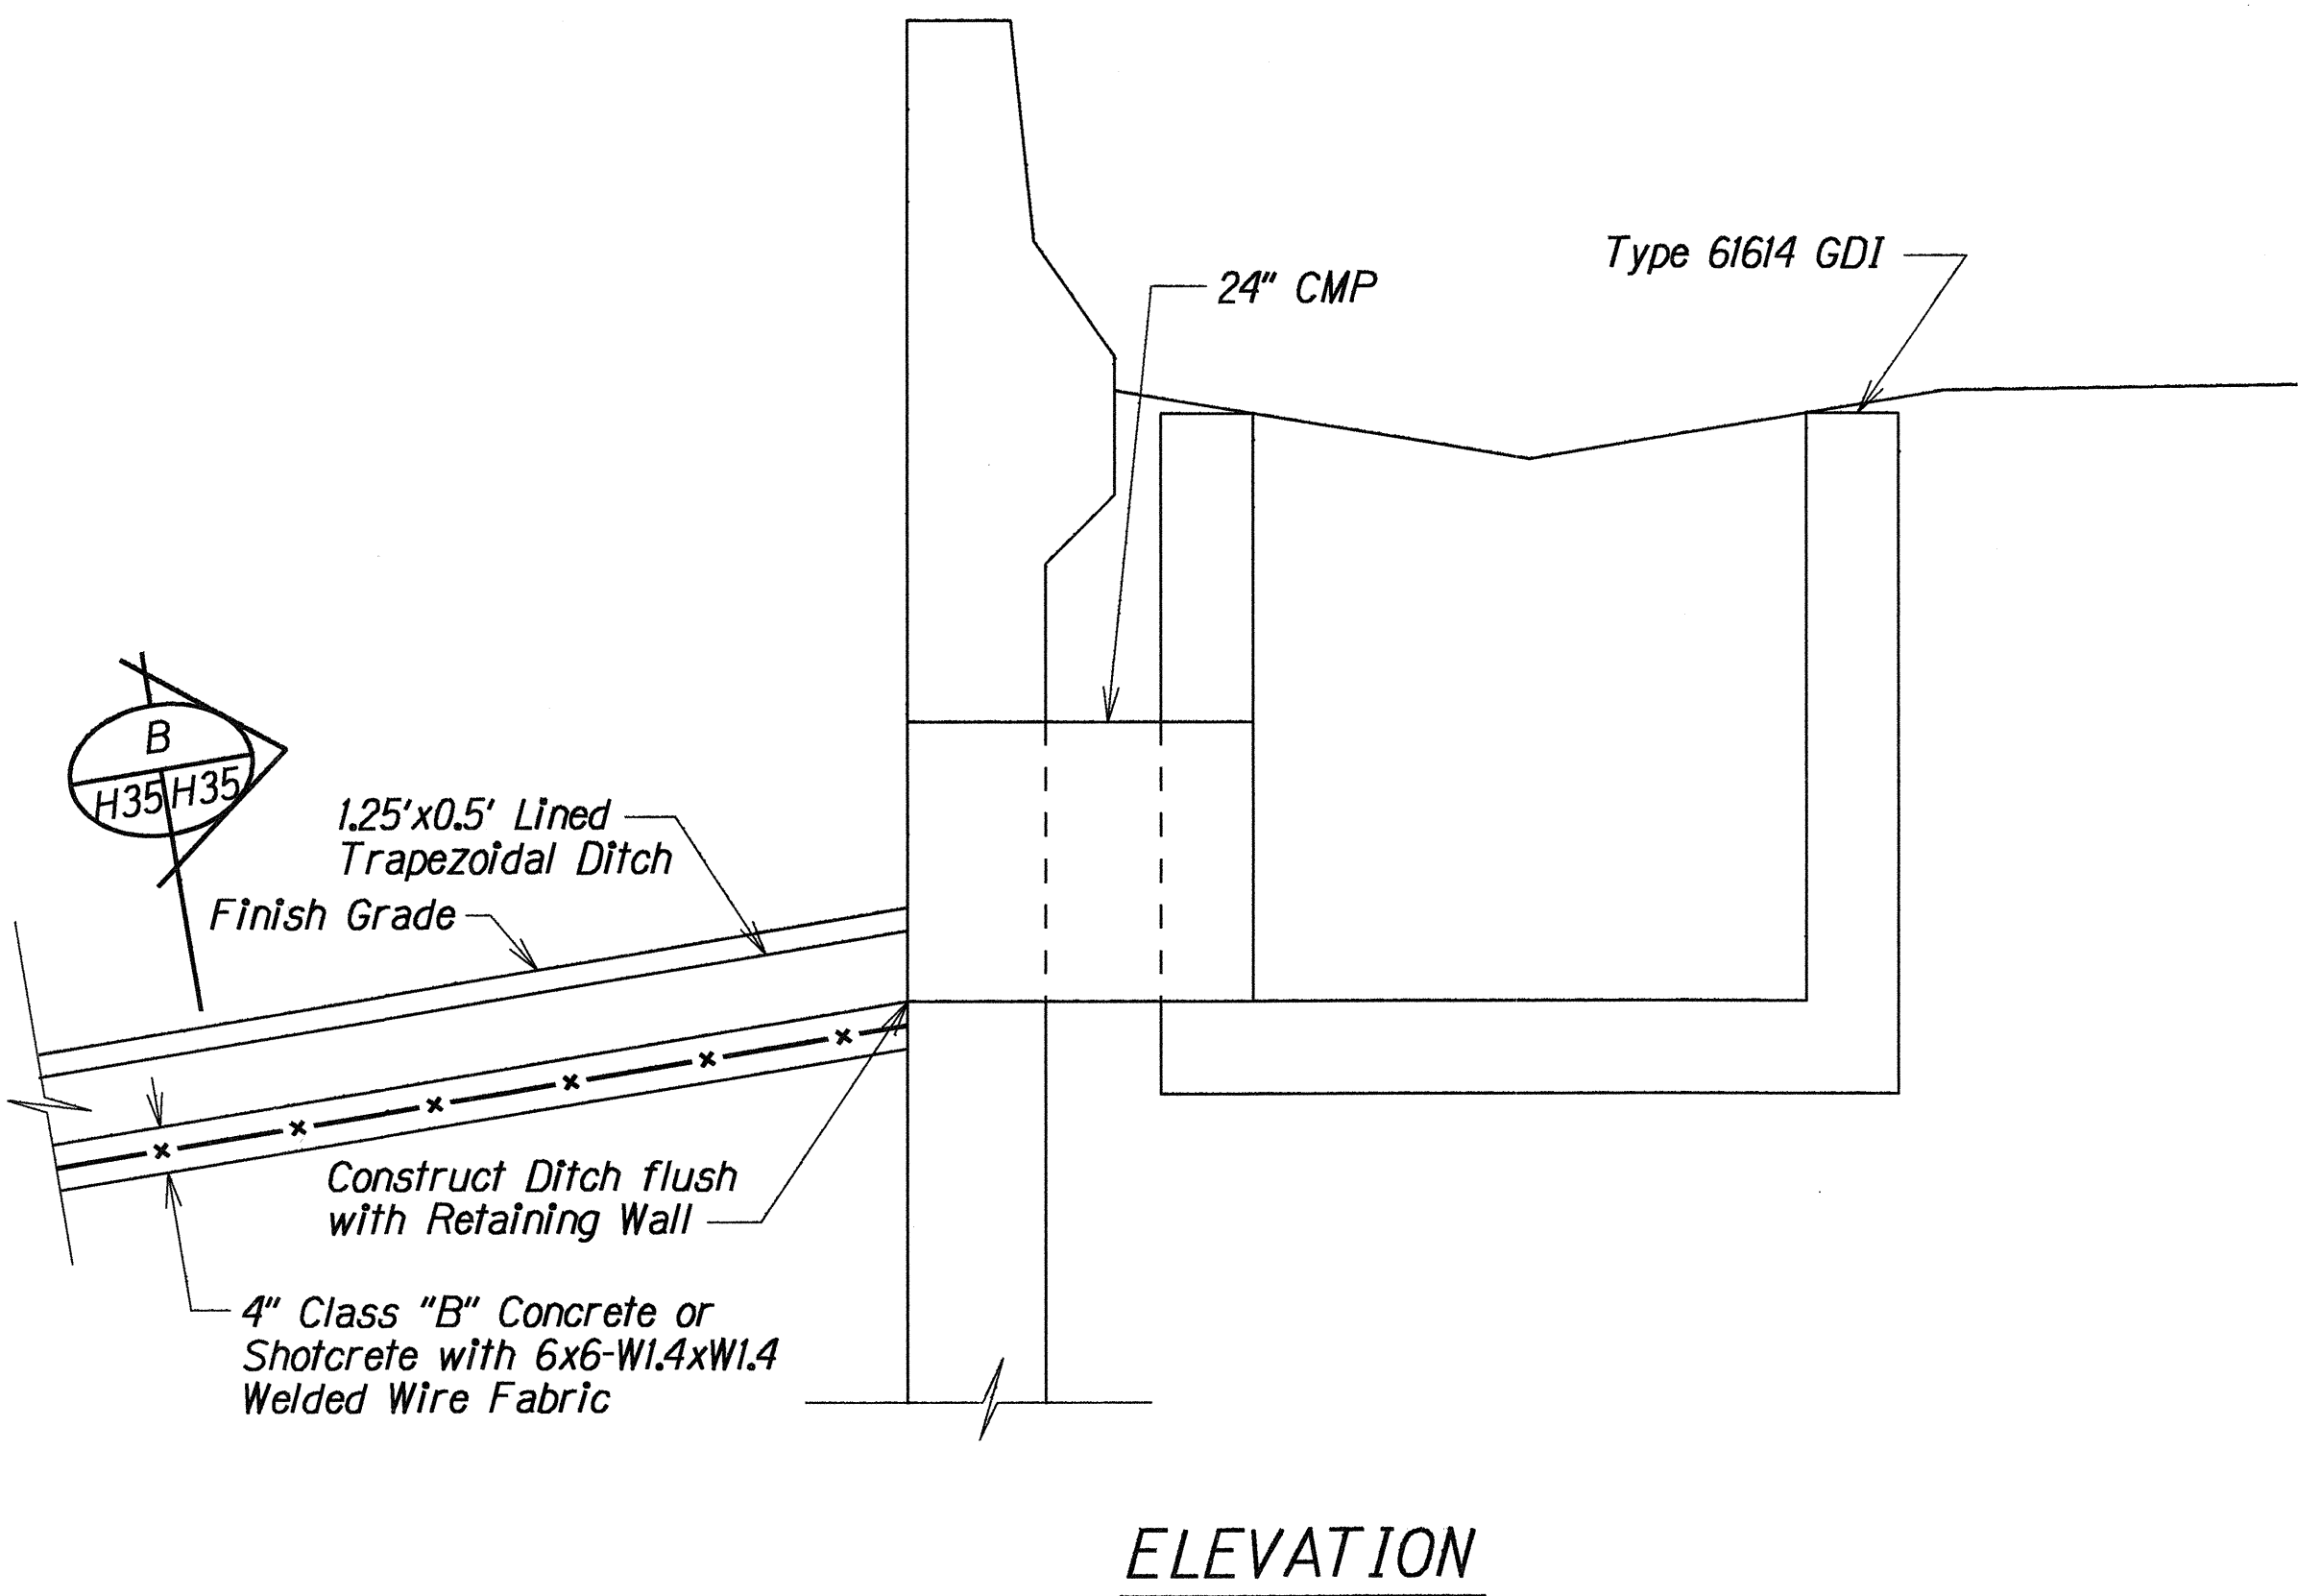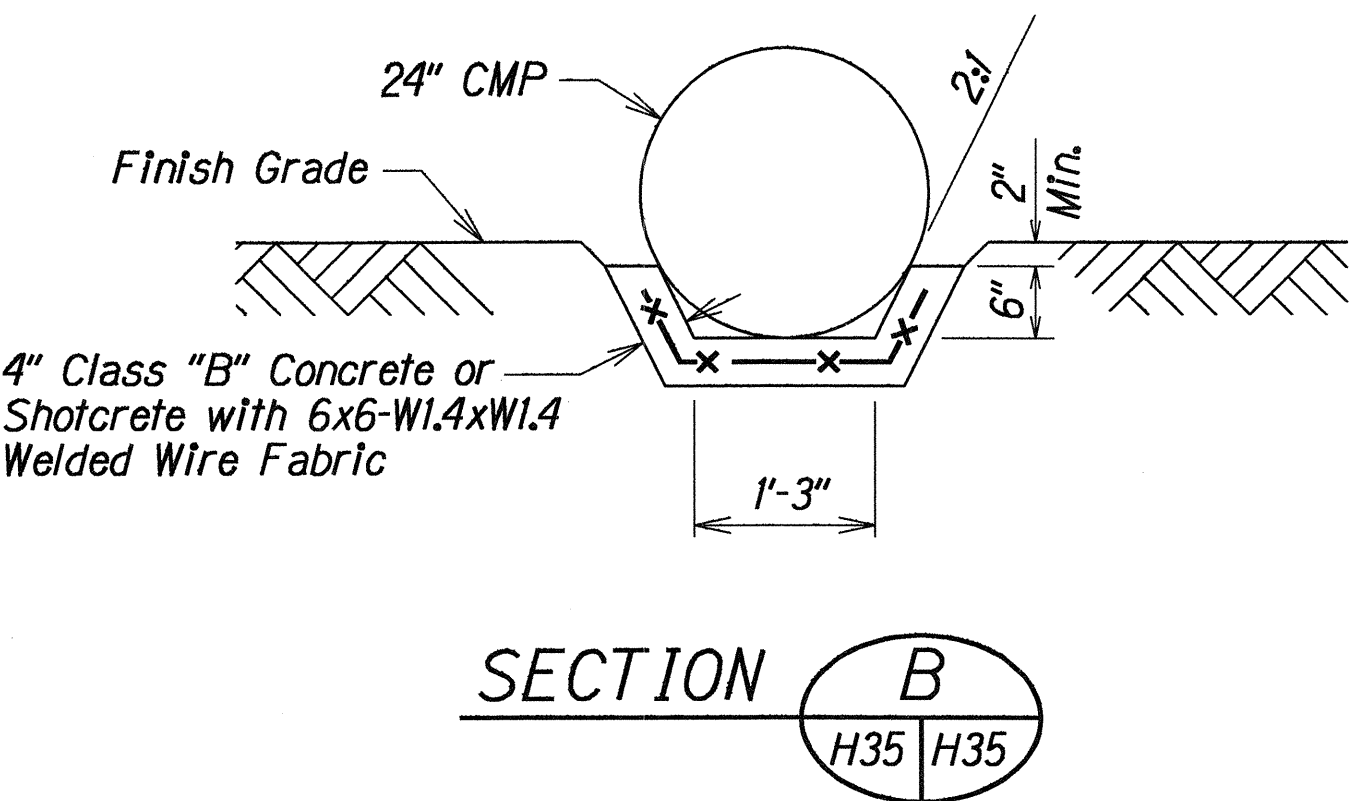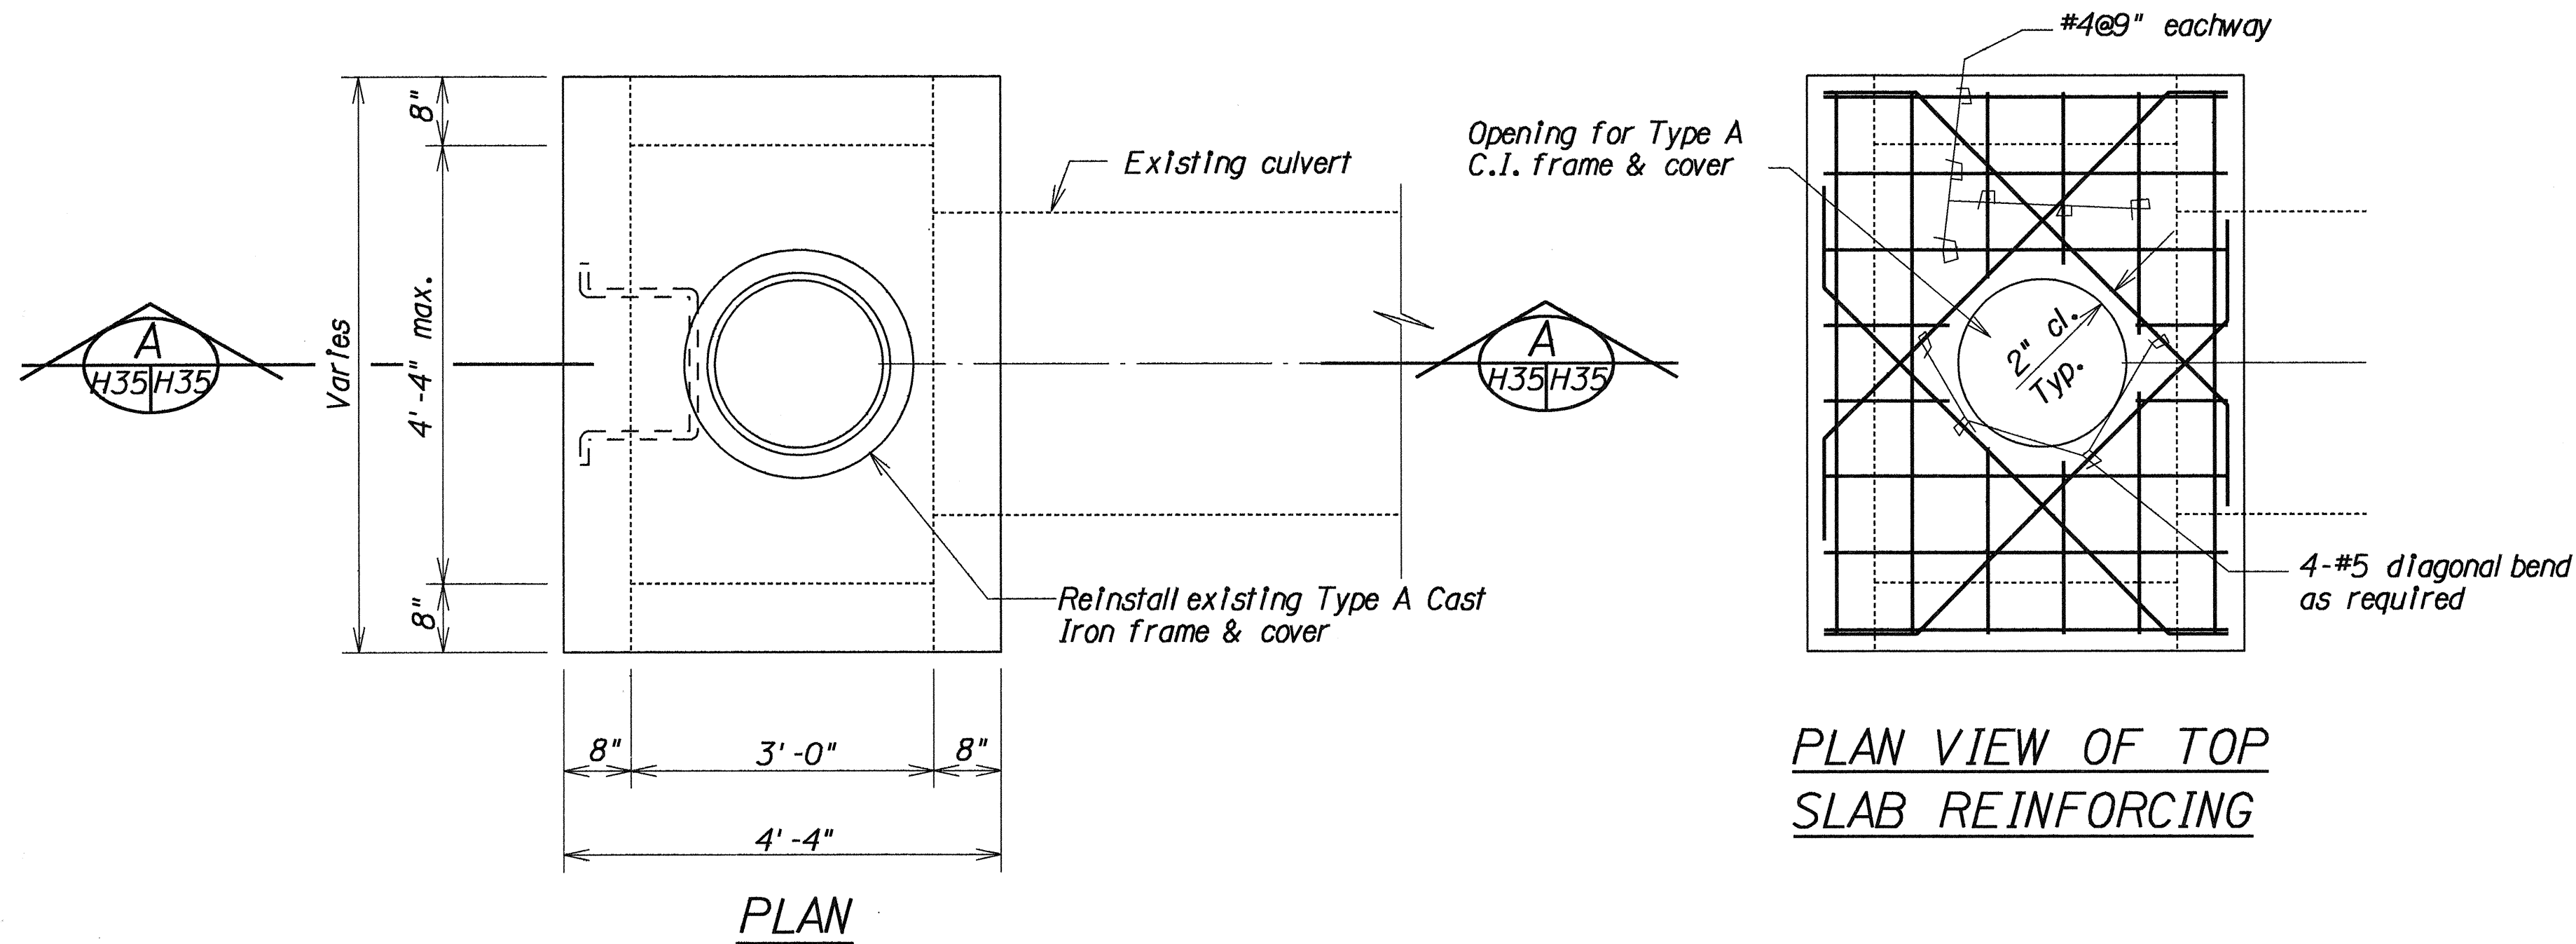

DETAILS OF 1.25'X0.5' LINED TRAPEZOIDAL DITCH
AT O.B. # STA. 303+00 o/s 98'± LT.

SECTION A
DETAILS OF CONCRETE DROP INLET COVER

DESIGNED BY	DATE
NOTED BY	
CHECKED BY	
ORIGINAL PLAN	
NOTE BOOK	
N.	

12/06/93	Details of 1.25'x0.5' Lined Trapezoidal Ditch added
DATE	REVISION


STATE OF HAWAII
DEPARTMENT OF TRANSPORTATION
HIGHWAYS DIVISION

DRAINAGE DETAILS
INTERSTATE RTE. H-2, HOV LANES, PH. II
Miliiani Interchange to Waipio Interchange
F.A.I. PROJECT NO. IR-H2-1(27)




Scale: 3/4" = 1'-0"
Date: Apr., 1992

SHEET No. H35 OF 42 SHEETS

FED. ROAD DIST. NO.	STATE	FED. AID PROJ. NO.	FISCAL YEAR	SHEET NO.	TOTAL SHEETS
HAWAII	HAW.	IR-H2-1(27)	1992	127	223

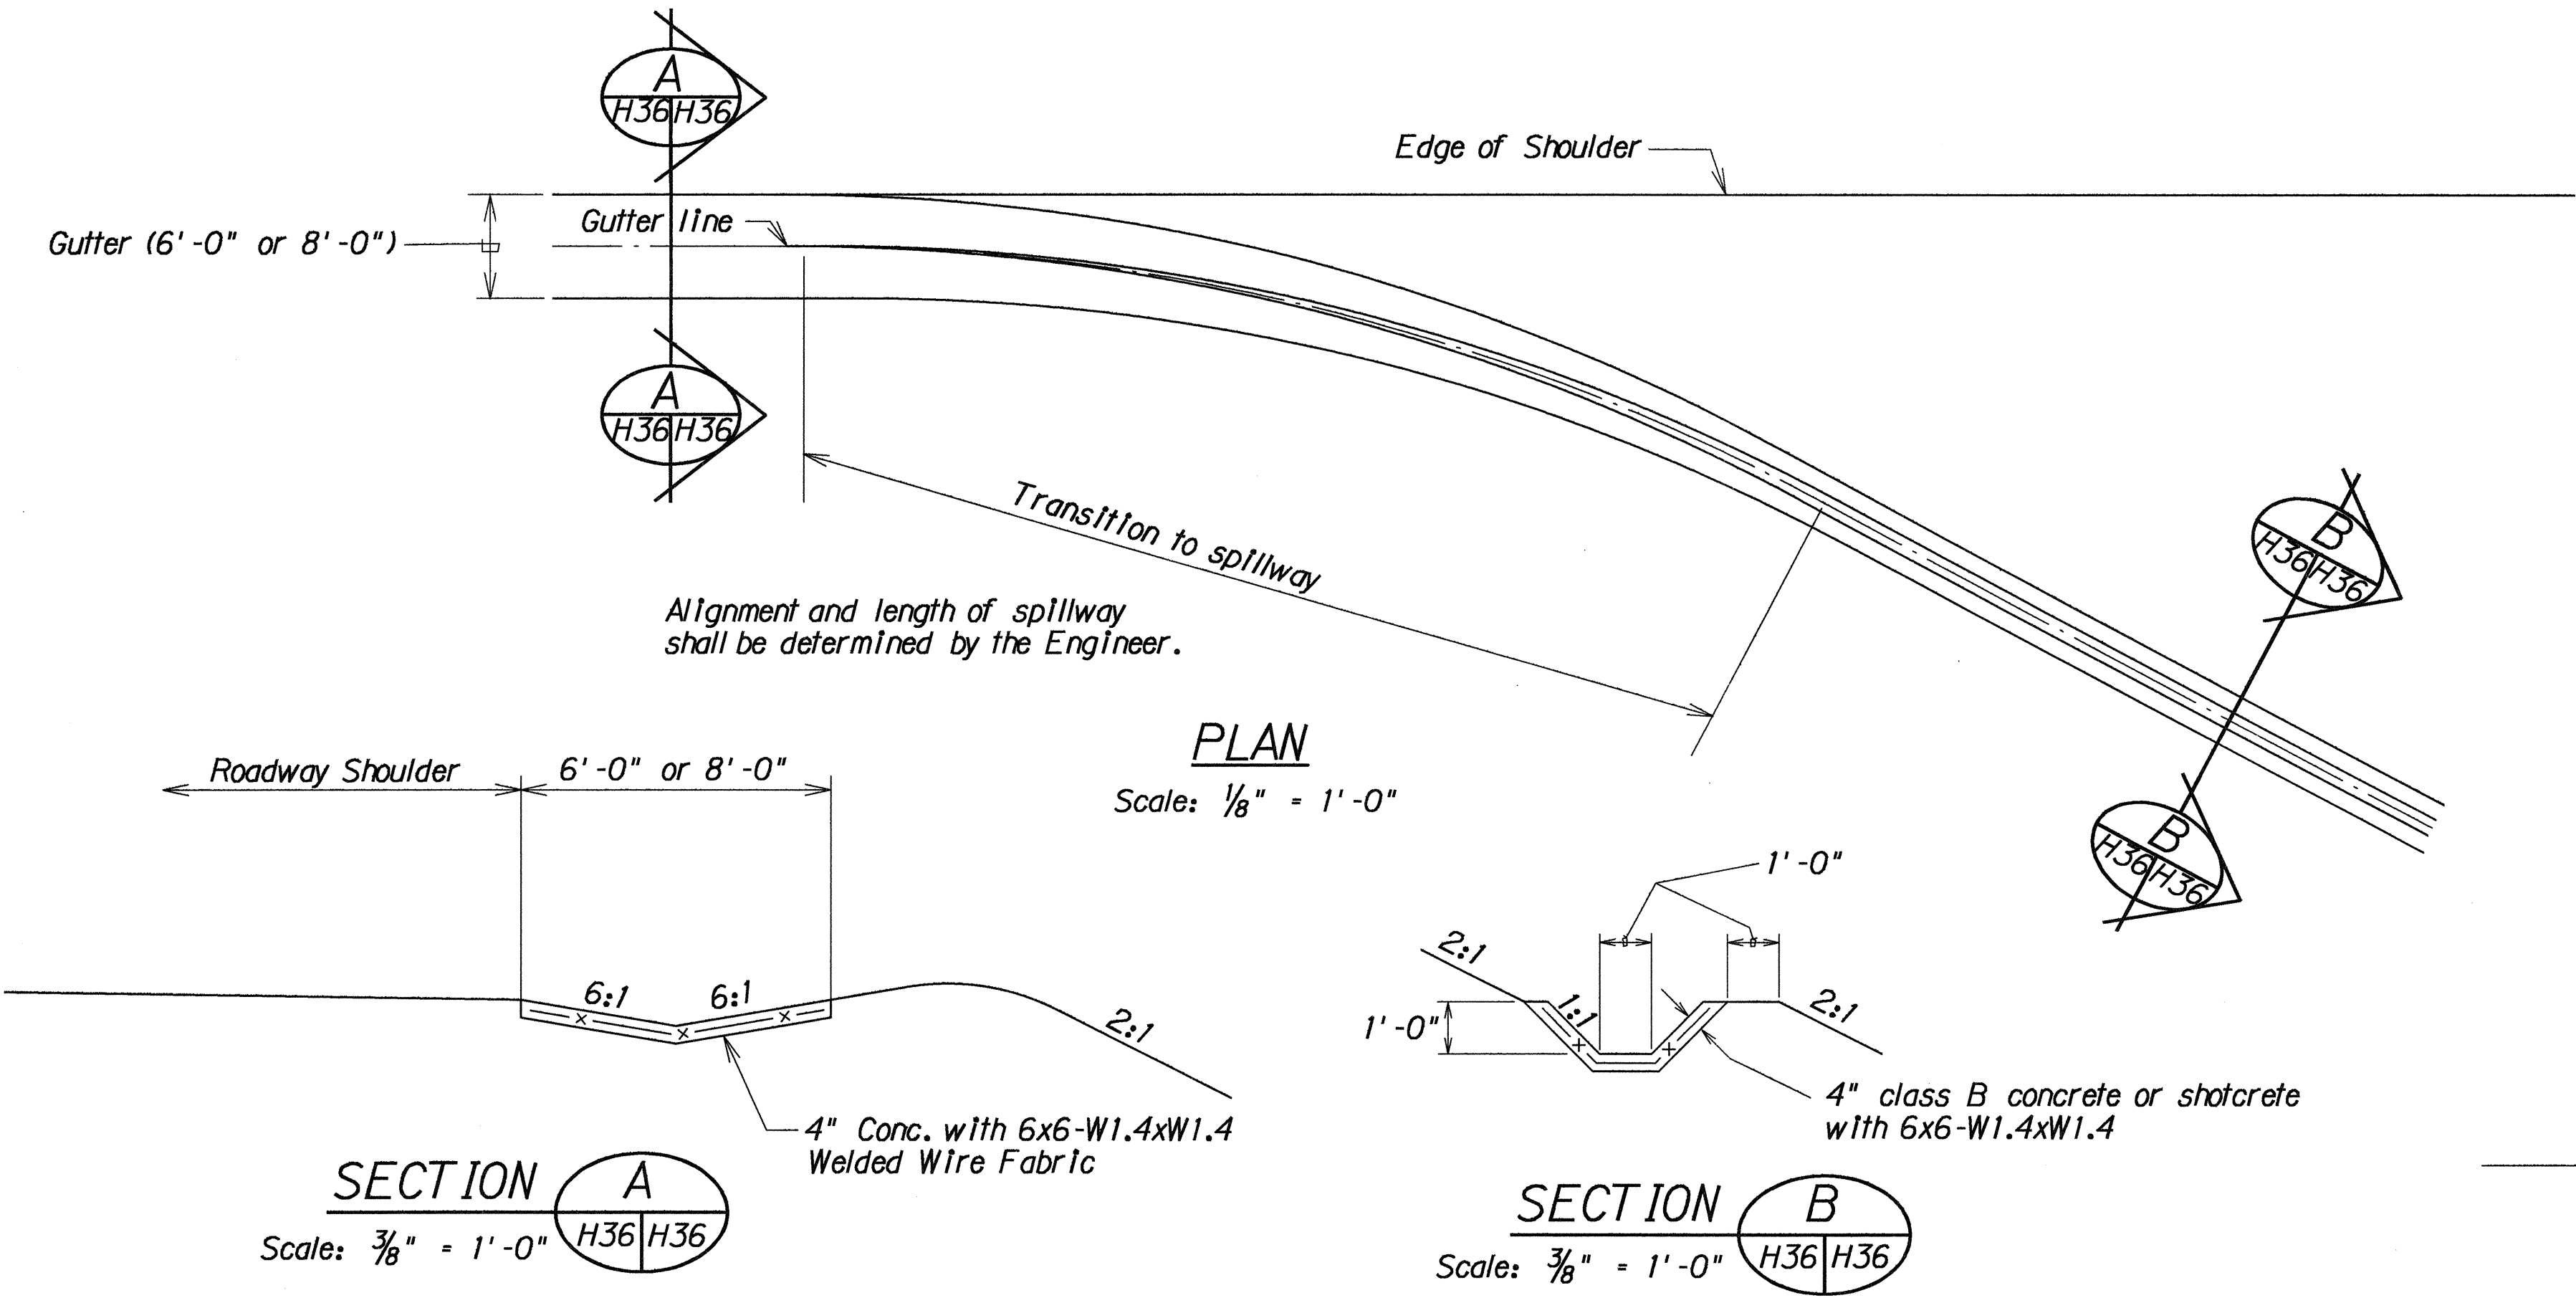

CONCRETE SPILLWAY INLET

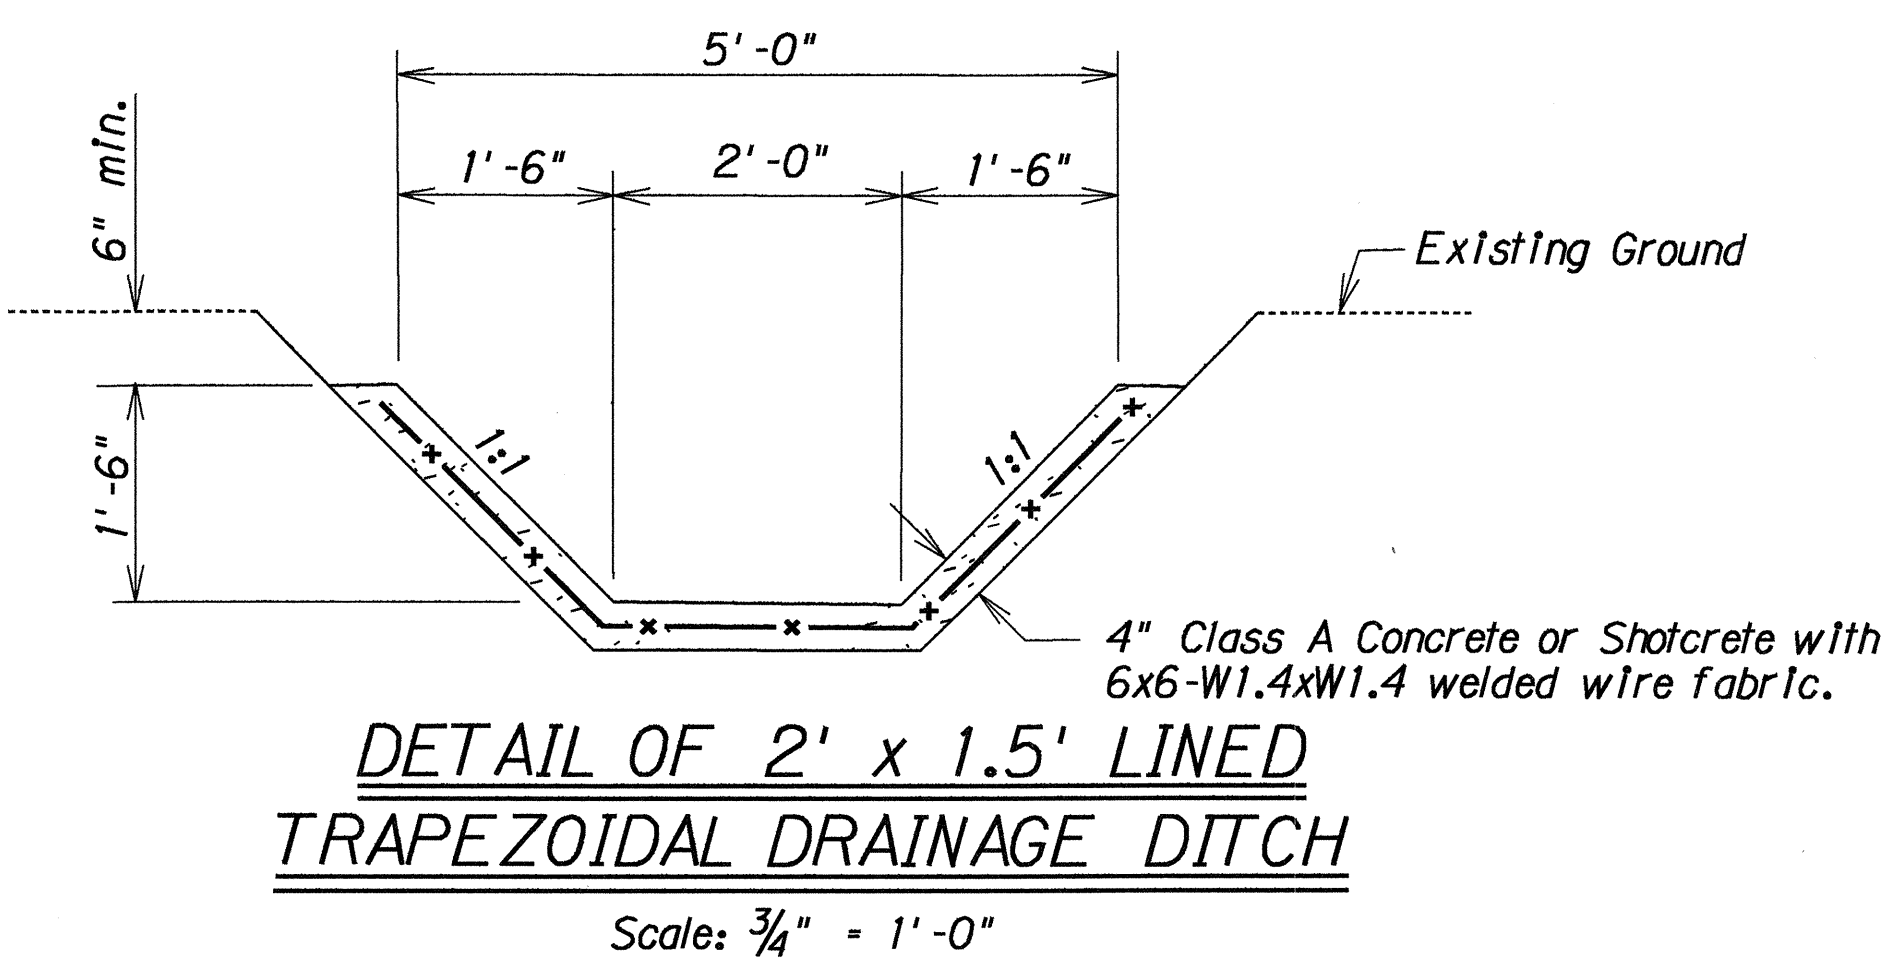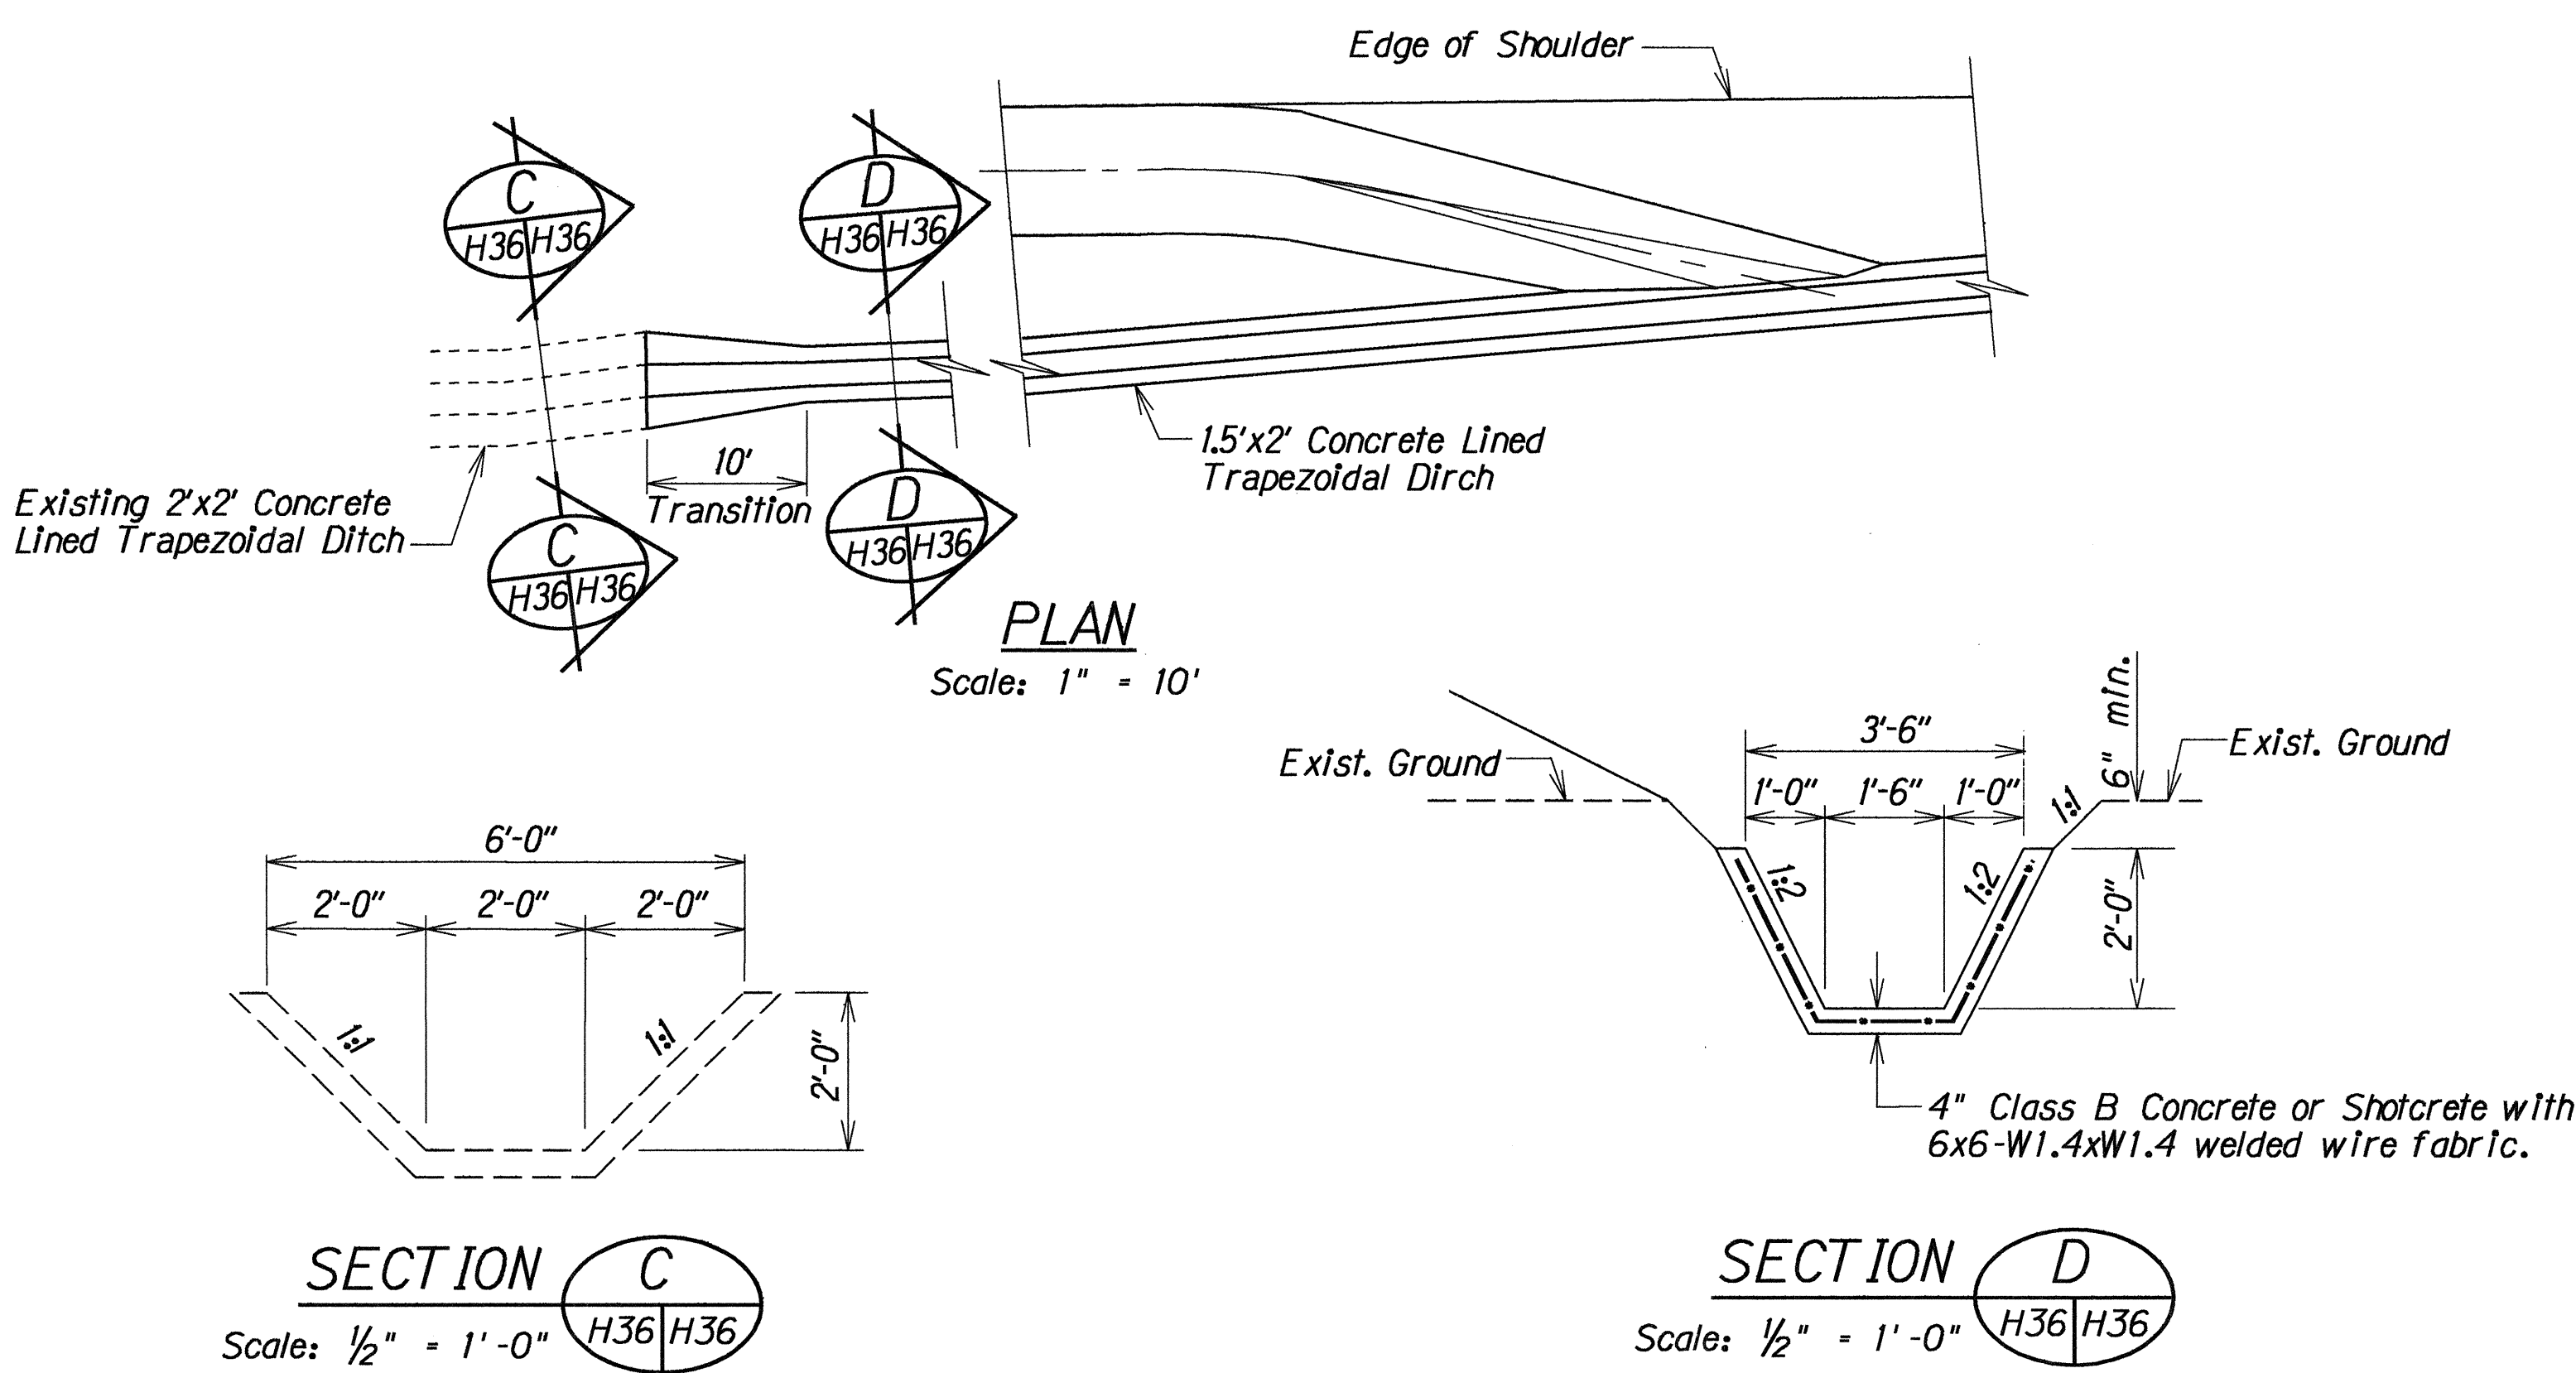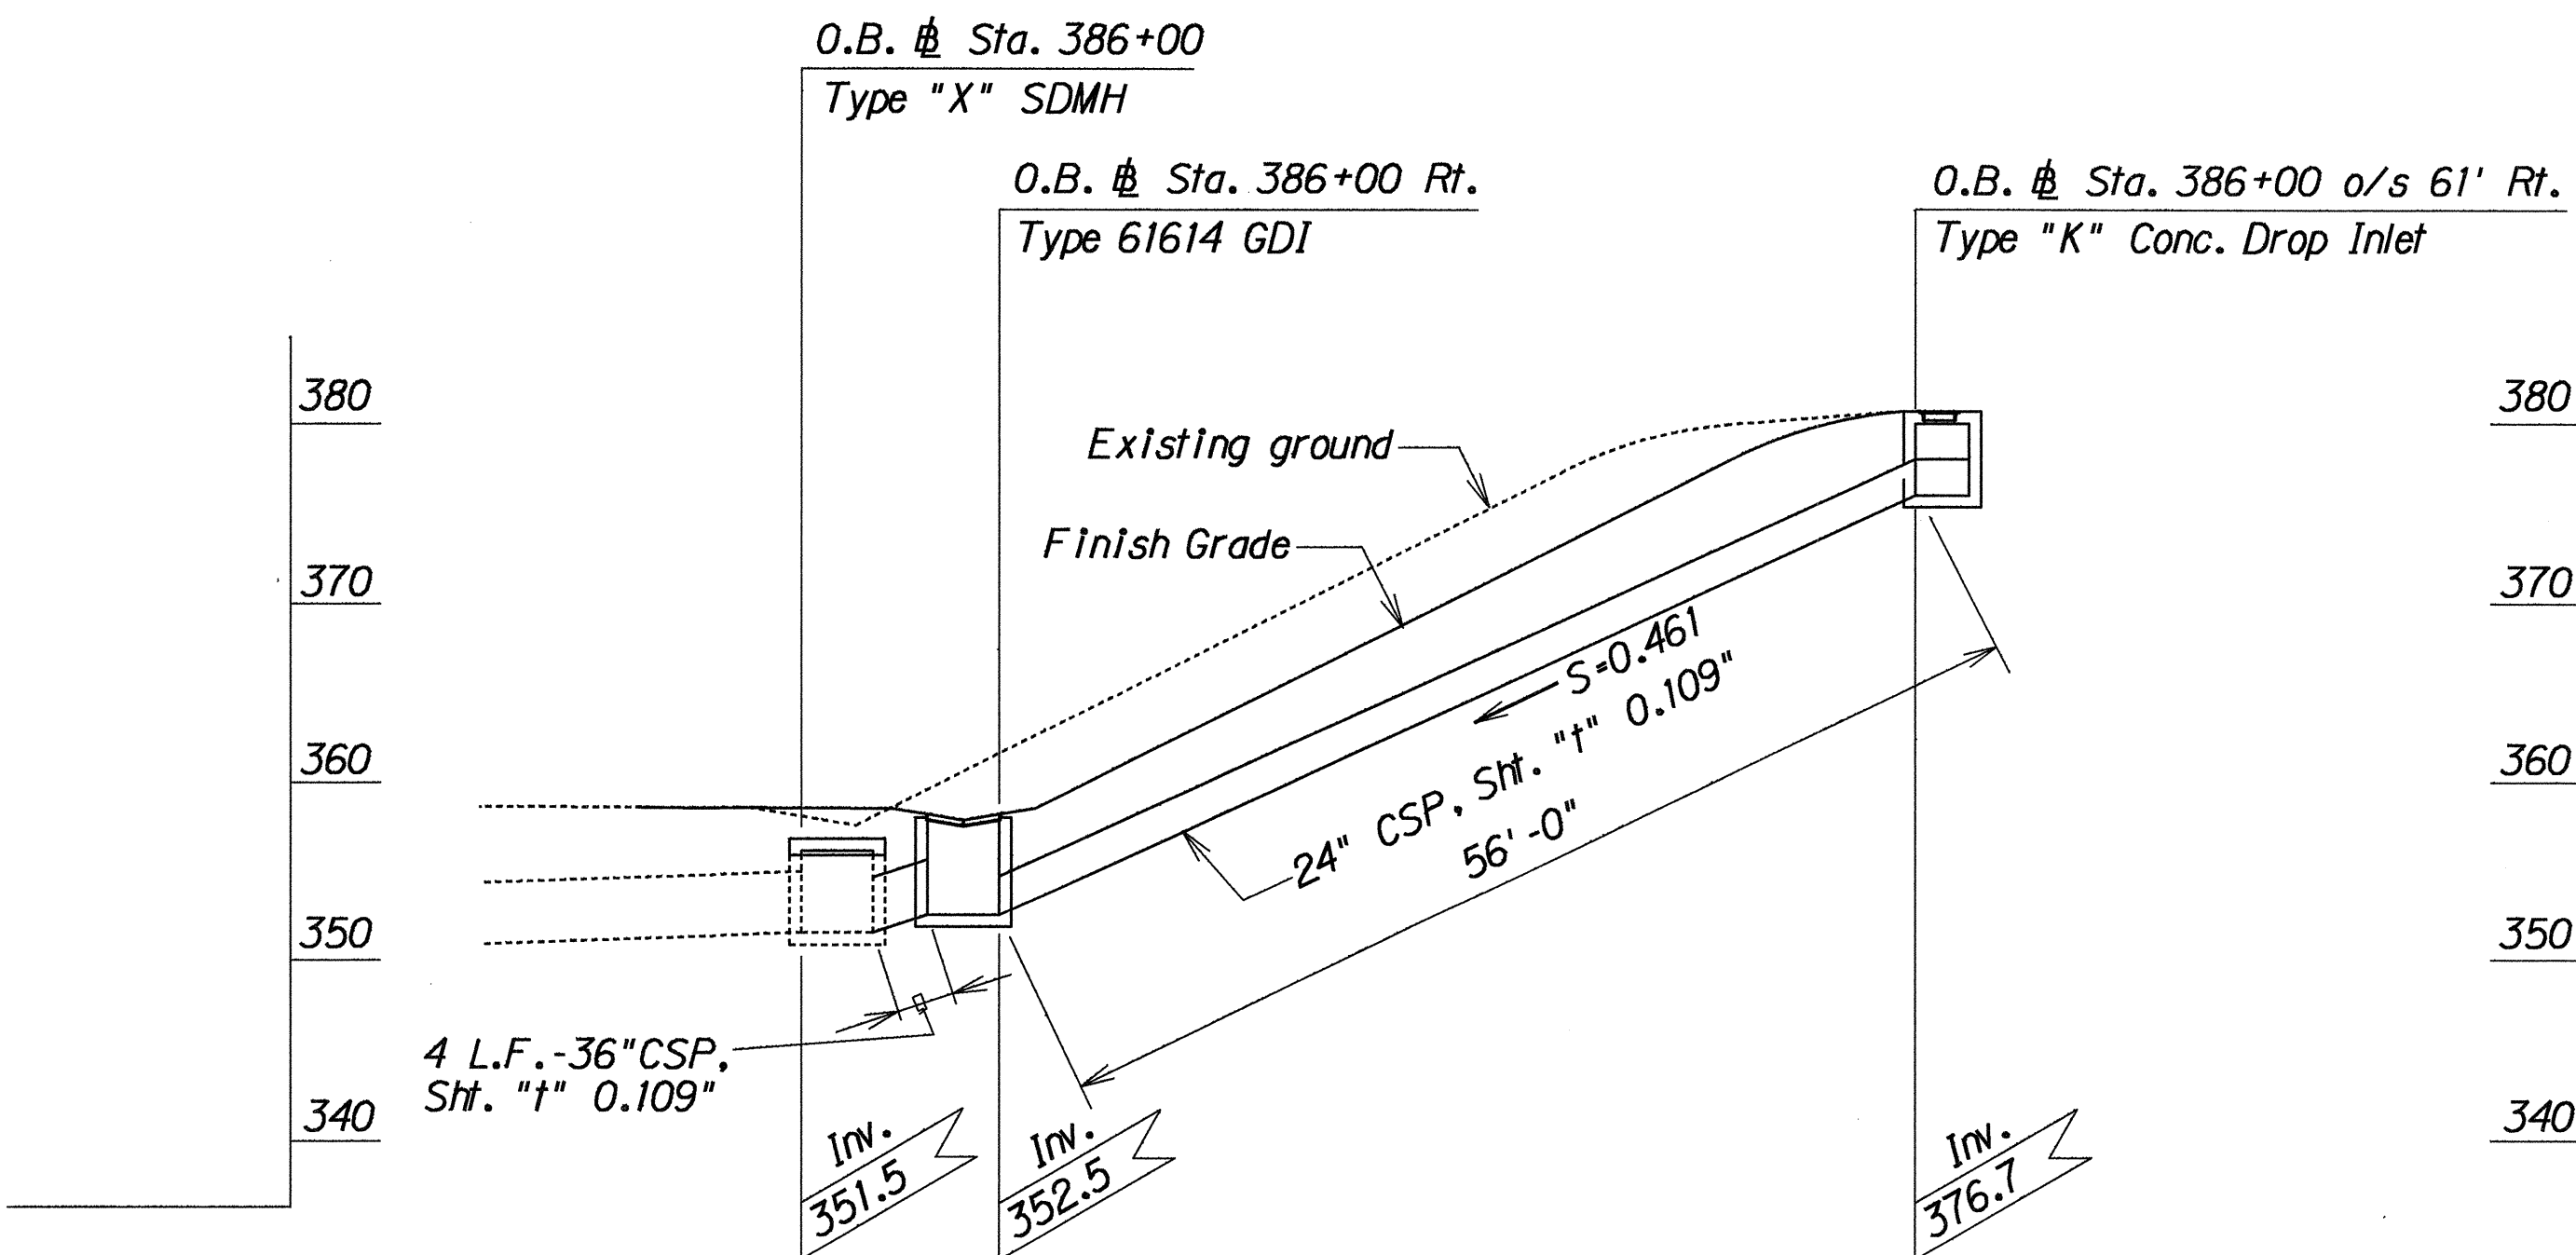

TRAPEZOIDAL DITCH BETWEEN I.B. STA. 299+10± RT. AND I.B. STA. 307+75 RT.

06/09/93	Added Detail of 1.5'x2' Lined Trapezoidal Ditch
DATE	REVISION

STATE OF HAWAII
DEPARTMENT OF TRANSPORTATION
HIGHWAYS DIVISION

DRAINAGE DETAILS





INTERSTATE RTE. H-2, HOV LANES, PH. II
Miliuli Interchange to Waipio Interchange
F.A.I. PROJECT NO. IR-H2-1(27)

Scale: As Noted
Date: Apr., 1992

SHEET No. H36 OF 42 SHEETS

SURVEY PLOTTED BY	DATE
DRAWN BY	
DESIGNED BY	
QUANTITIES BY	
CHECKED BY	
IN CHARGE	

FED. ROAD DIST. NO.	STATE	FED. AID PROJ. NO.	FISCAL YEAR	SHEET NO.	TOTAL SHEETS
HAWAII	HAW.	IR-H2-1(27)	1992	128	223

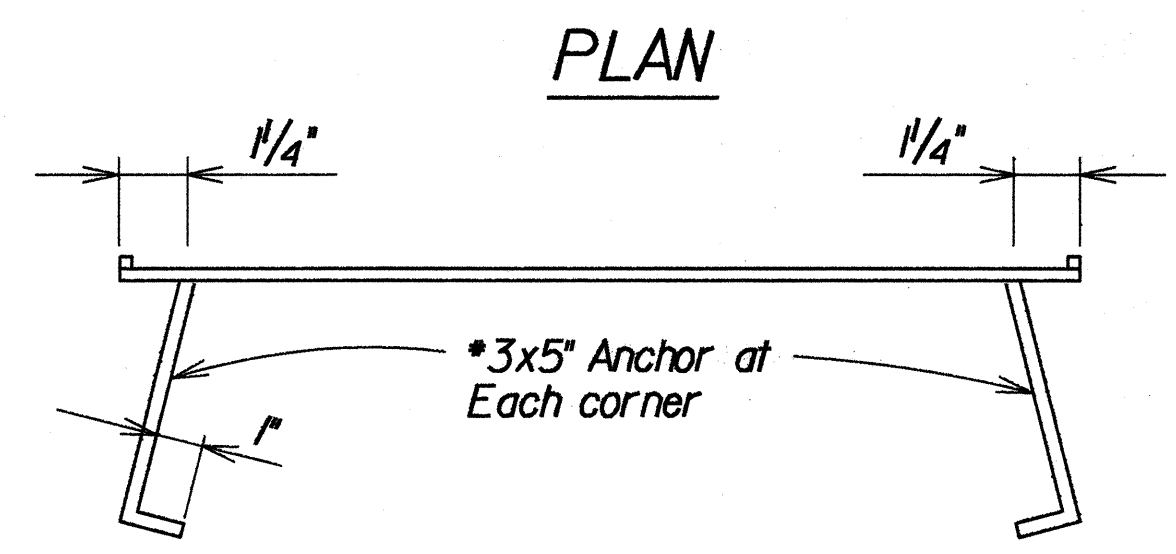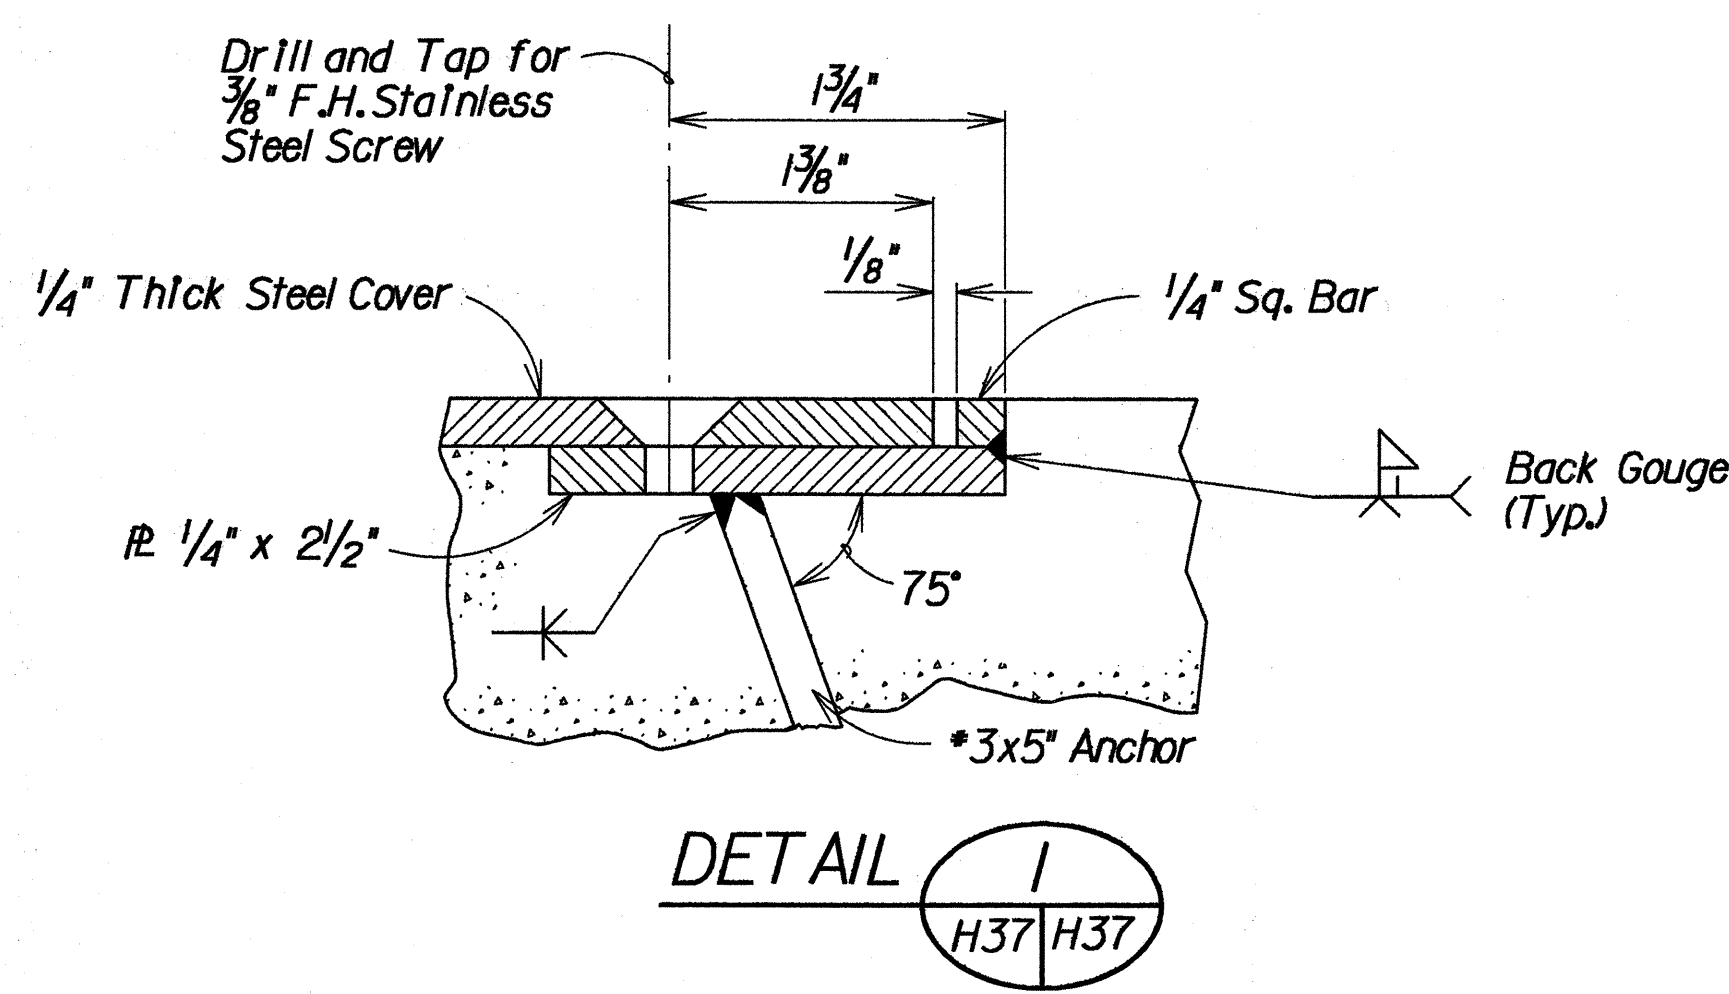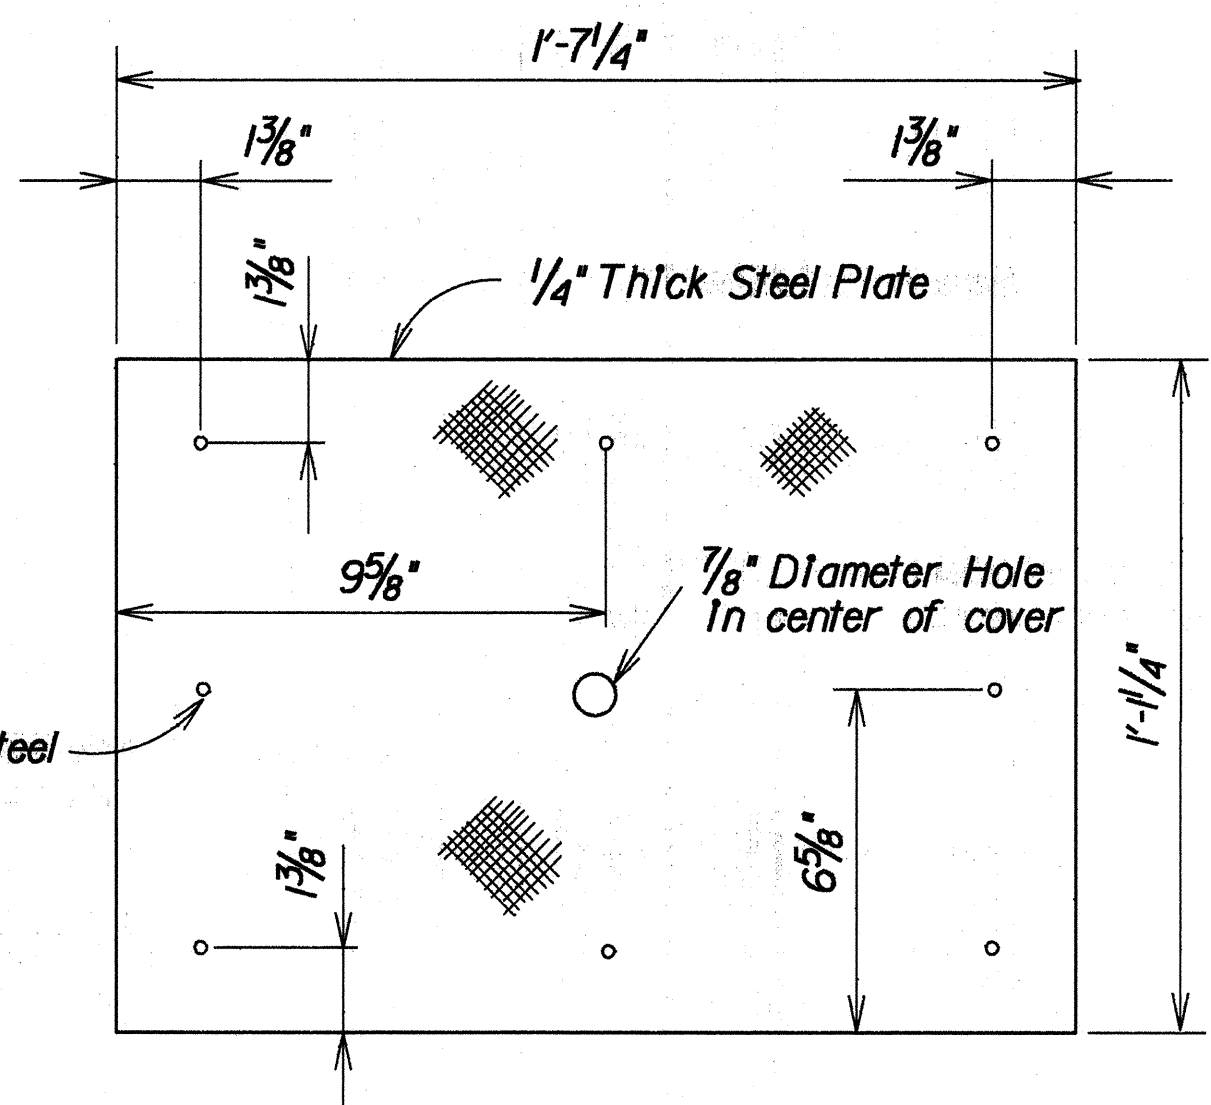
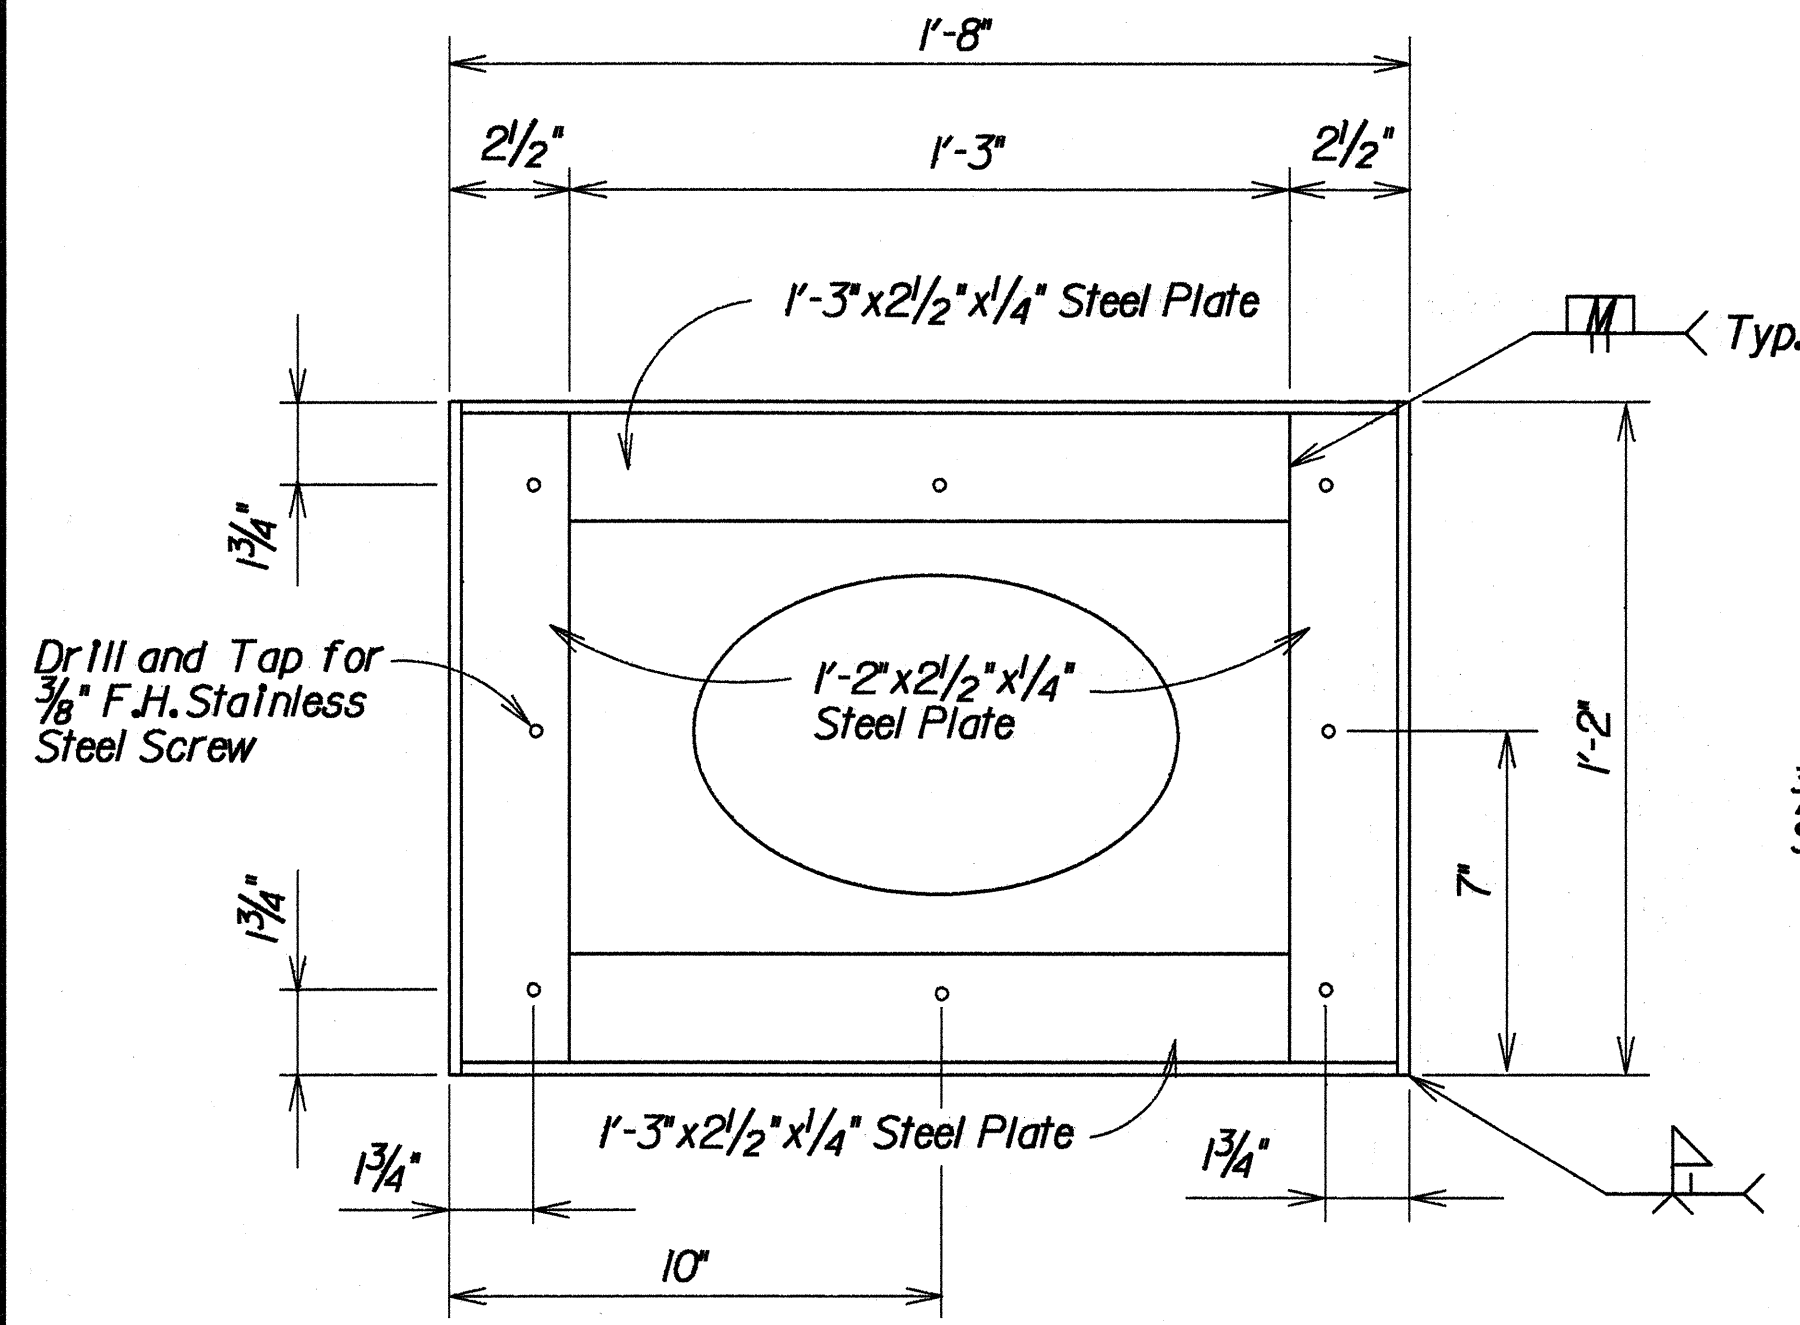


NOTE:
All Steel Parts Shall Be Galvanized
In Accordance with the Requirements
of ASTM A123.

DETAIL OF STEEL FRAME

DETAILS OF STEEL FRAME AND COVER FOR EDGEDRAIN

Scale: 3" = 1'-0"

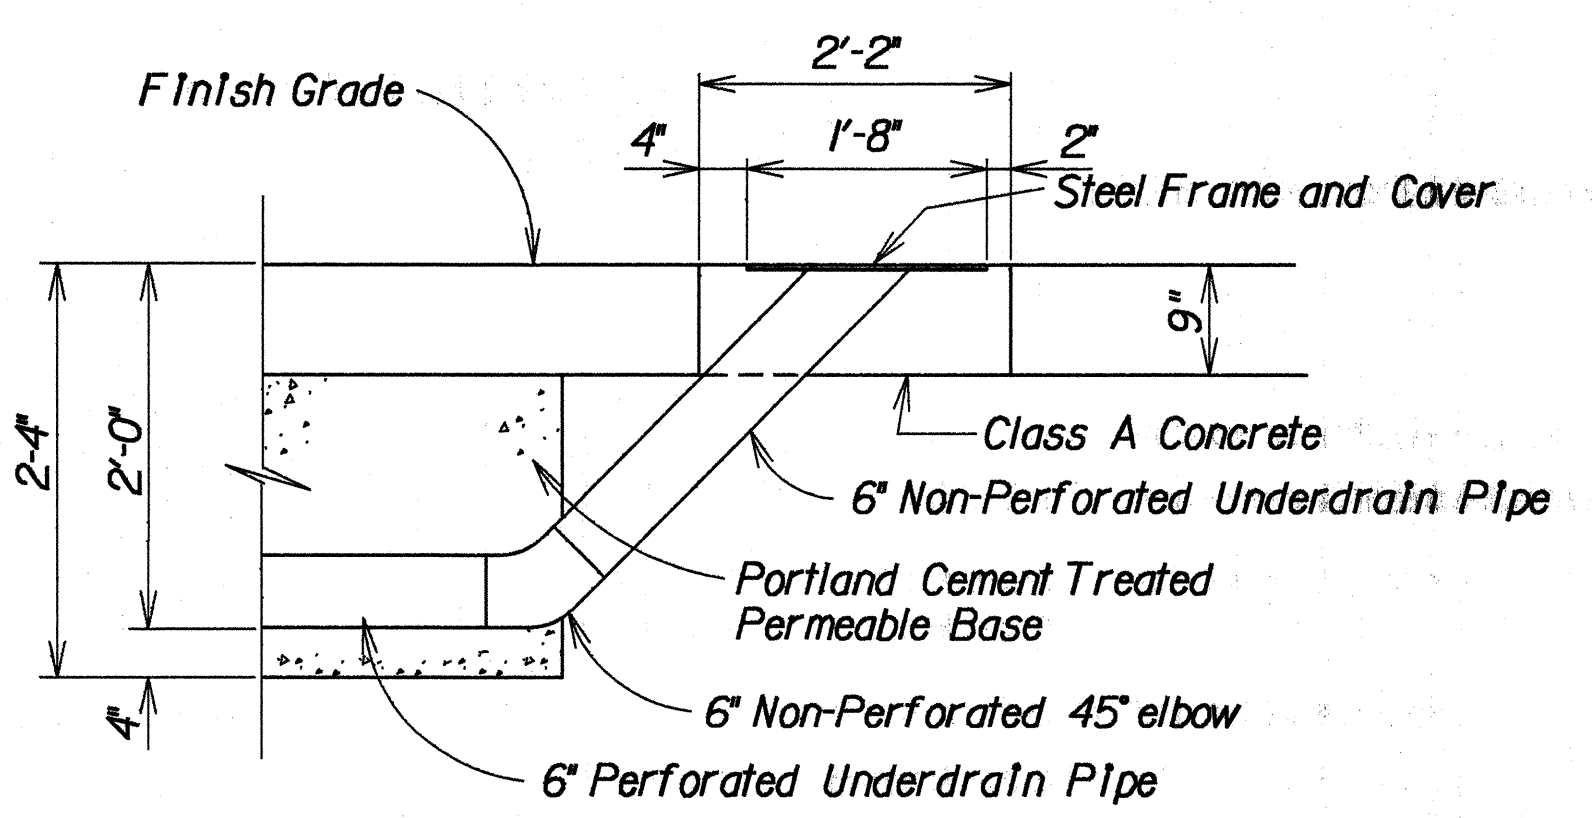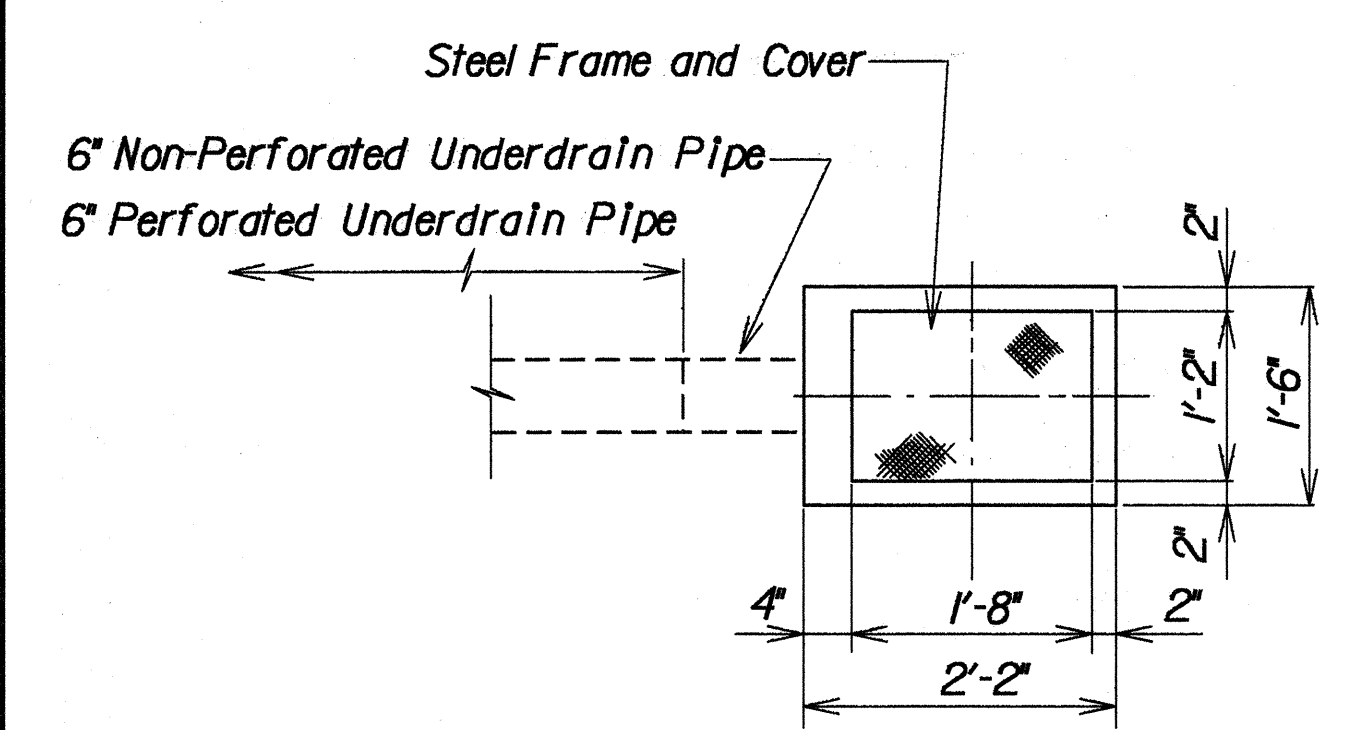

DETAILS OF CLEANOUT FOR EDGEDRAIN


Scale: 3/4" = 1'-0"

STATE OF HAWAII
DEPARTMENT OF TRANSPORTATION
HIGHWAYS DIVISION


DRAINAGE DETAILS
INTERSTATE RTE. H-2, HOV LANES, PH. II
Million Interchange to Waipio Interchange
F.A.I. PROJECT NO. IR-H2-1(27)

Scale: As Noted Date: Apr., 1992
SHEET No. H37 OF 42 SHEETS


FED. ROAD DIST. NO.	STATE	FED. AID PROJ. NO.	FISCAL YEAR	SHEET NO.	TOTAL SHEETS
HAWAII	HAW.	IR-H2-1(27)	1992	129	223

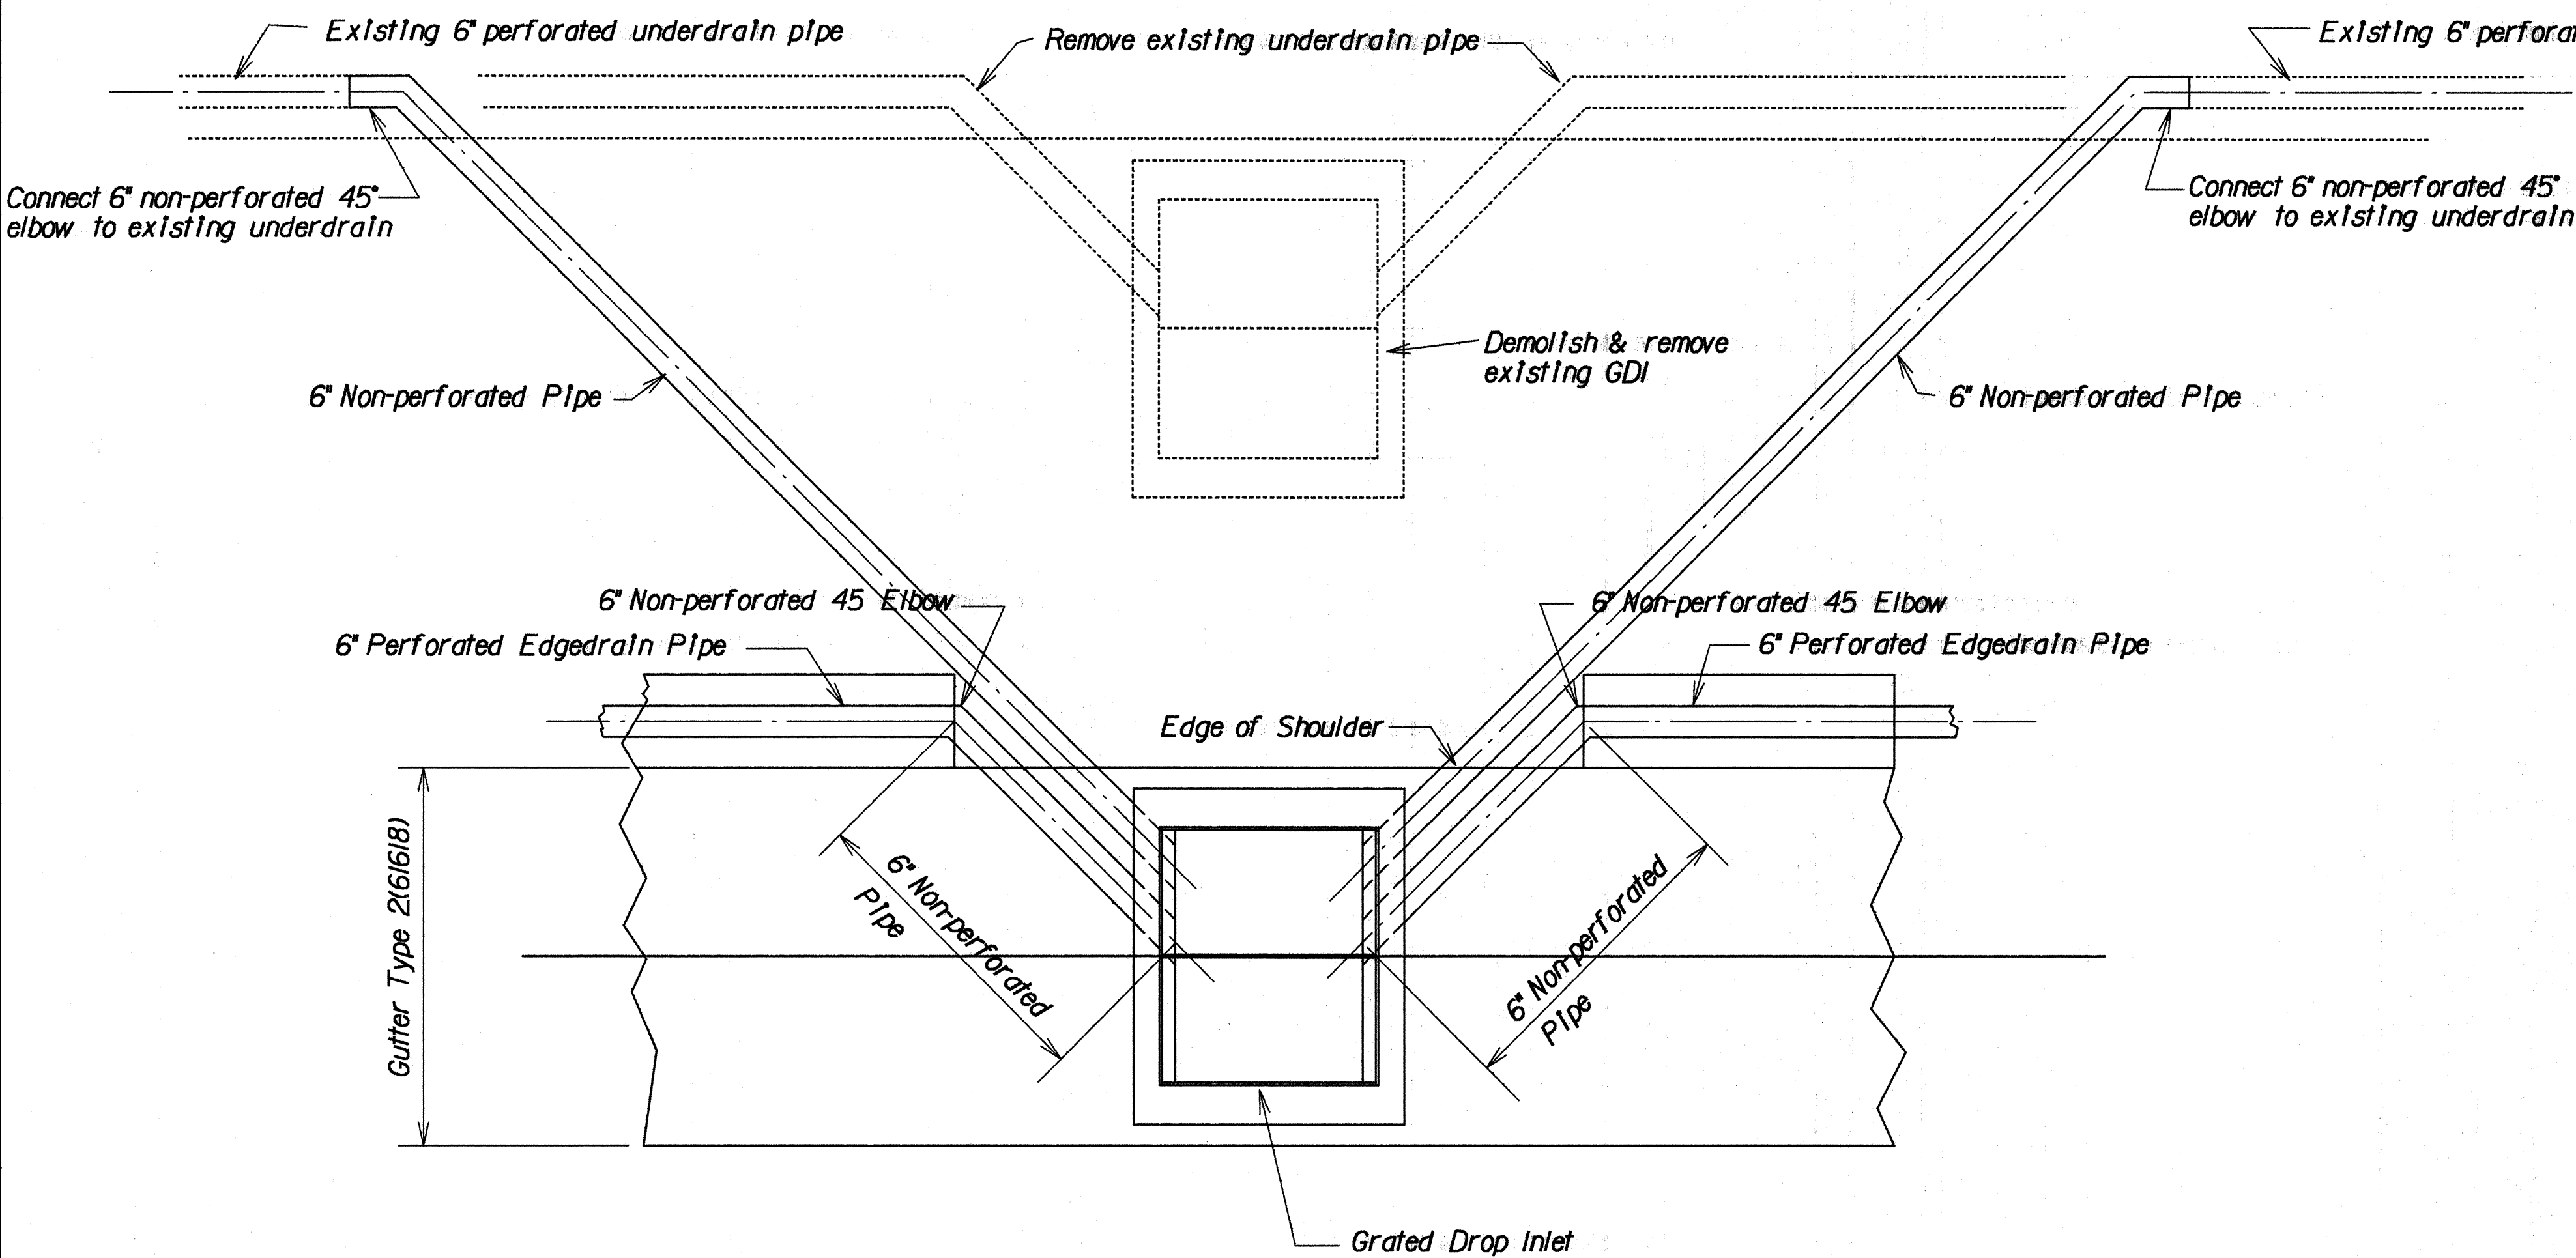


PLAN

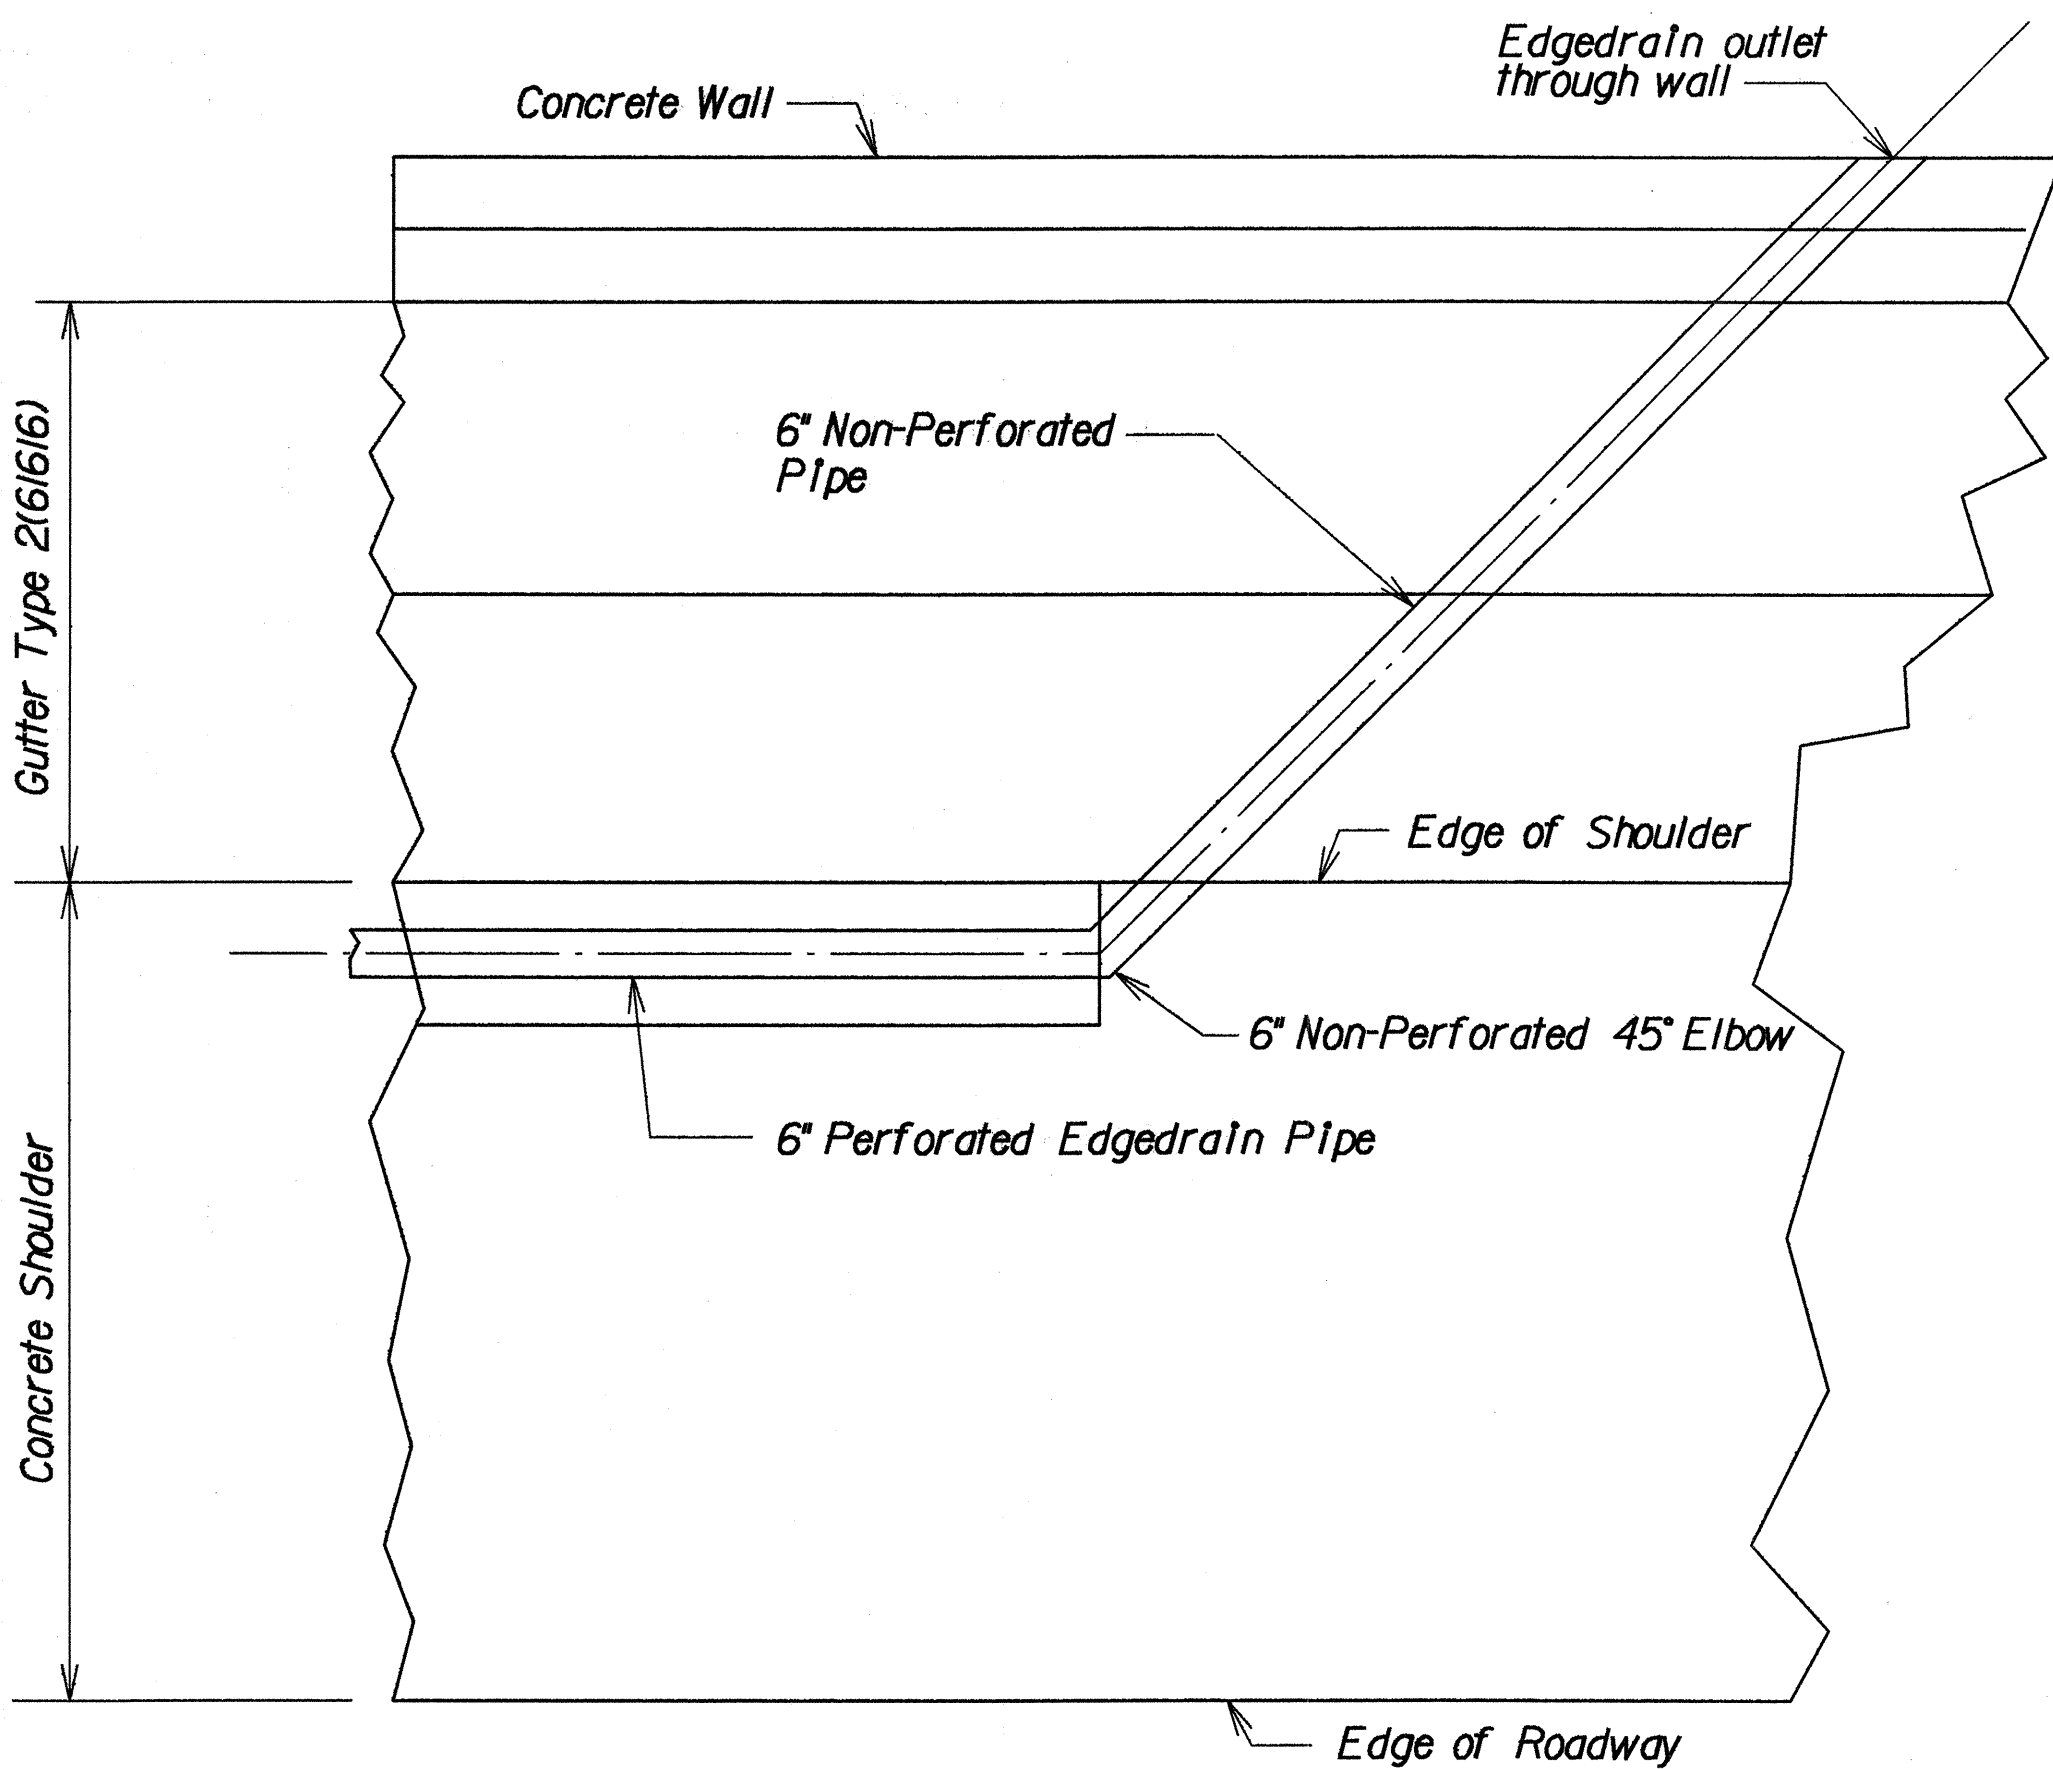

PLAN

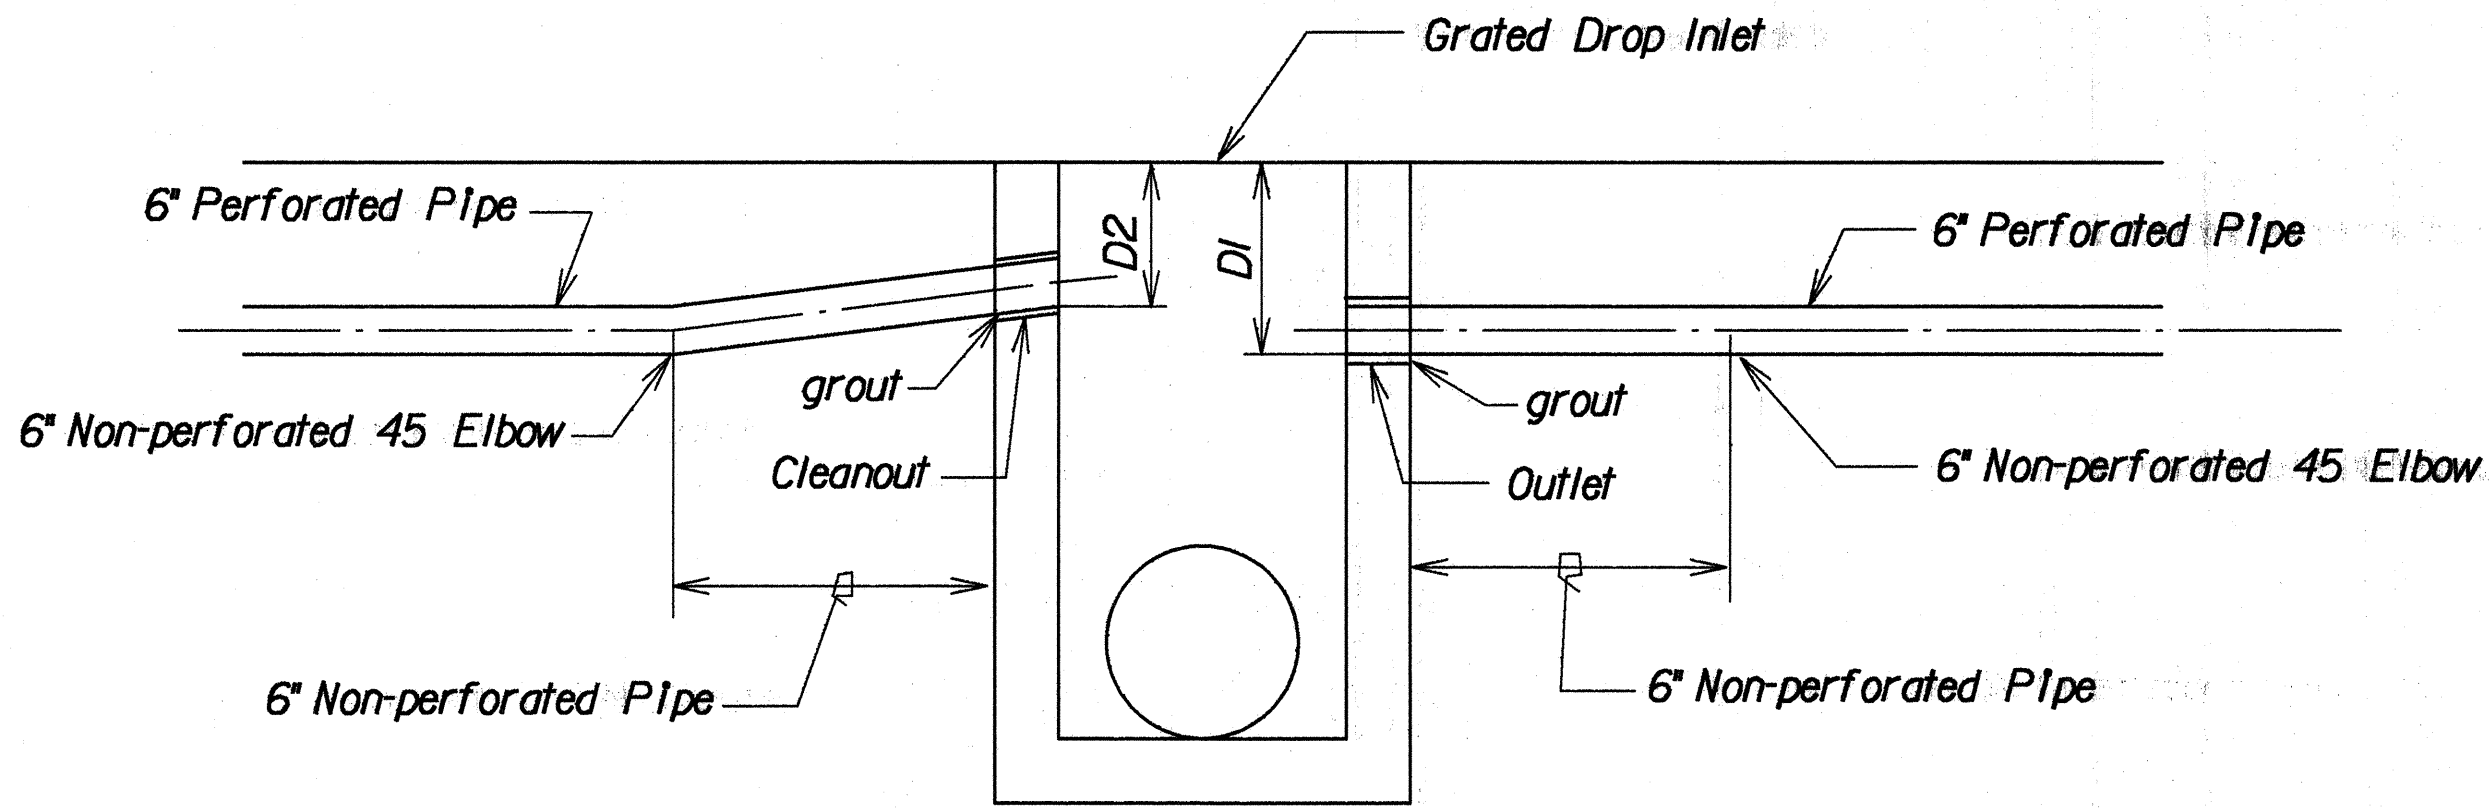

ELEVATION

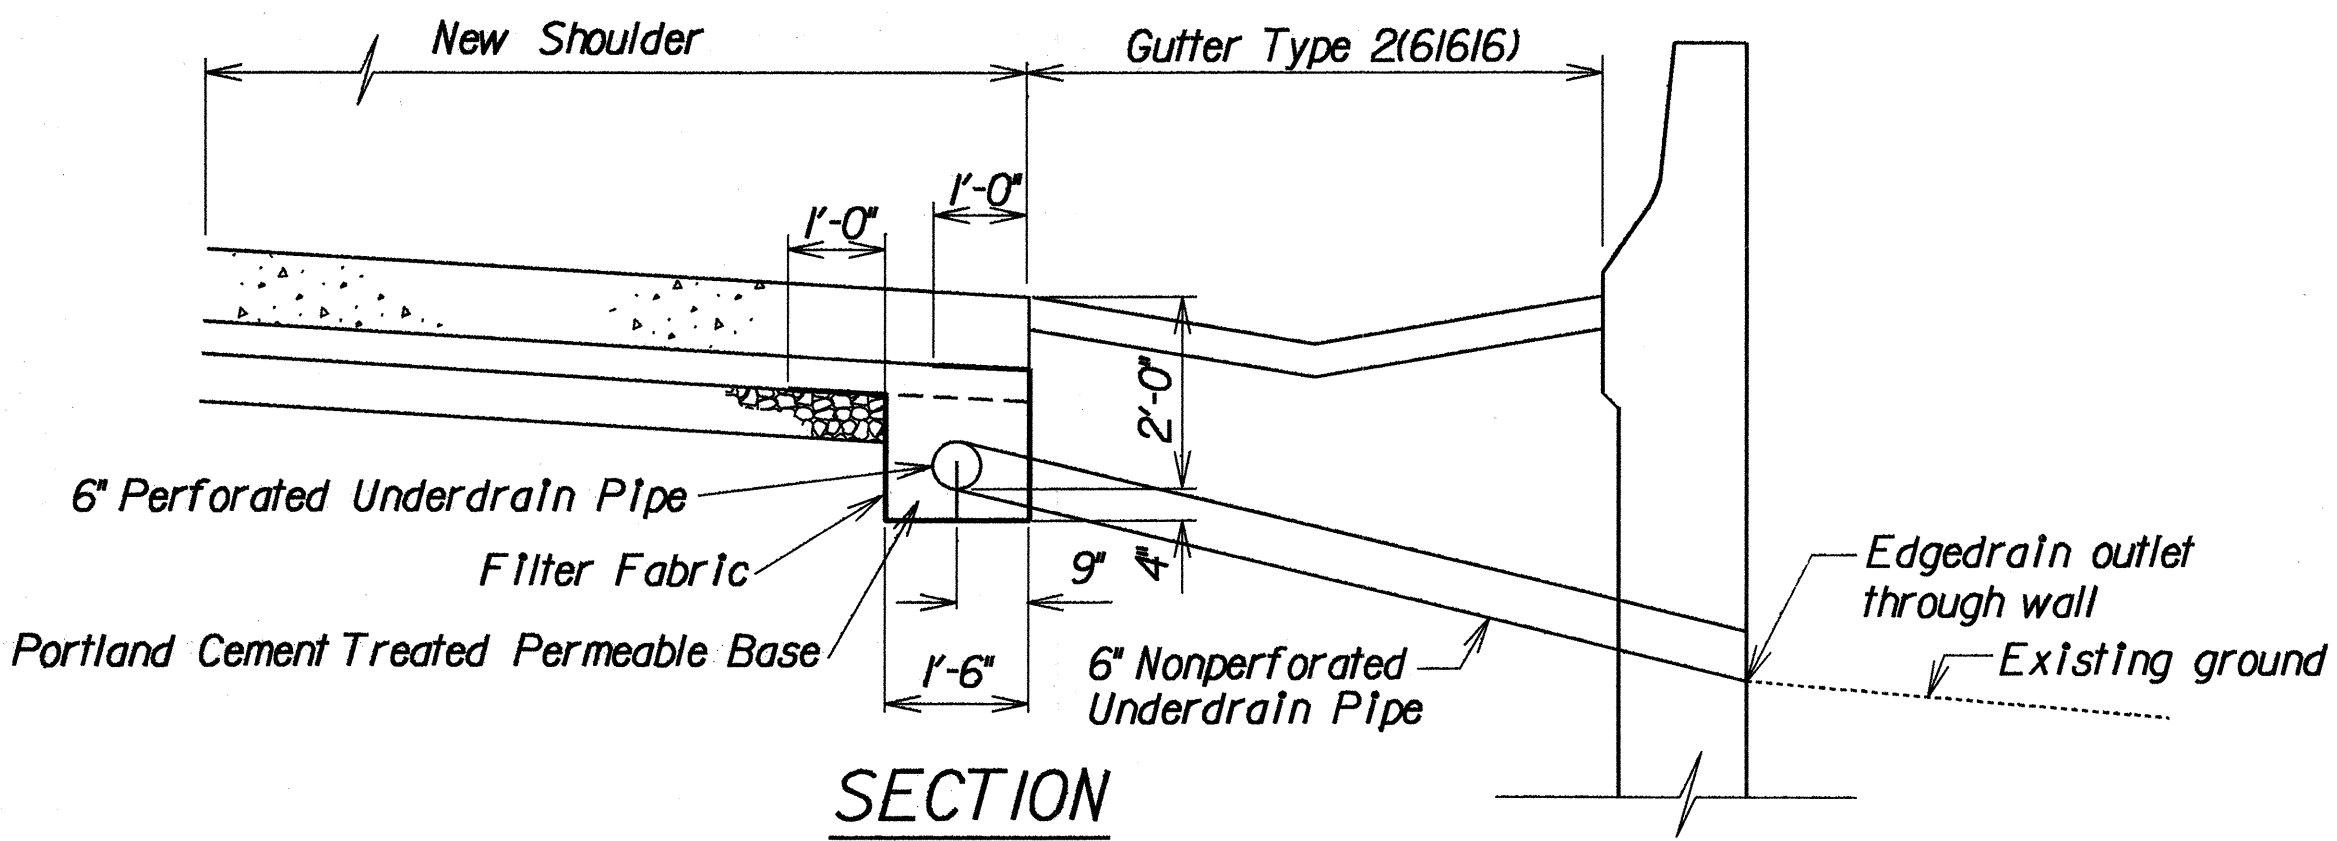

SECTION

DETAILS OF EDGEDRAIN OUTLET AT STA. 287+00 RT.

Scale: 1/2" = 1'-0"

EDGEDRAIN & UNDERDRAIN CLEANOUT & OUTLET AT GRATED DROP INLET

Scale: 1/2" = 1'-0"


ORIGINAL PLAN	DATE
DRAWN BY	
CHECKED BY	
NOTES BOOK	
QUANTITIES BY	
CHECKED BY	
N.	

STATE OF HAWAII
DEPARTMENT OF TRANSPORTATION
HIGHWAYS DIVISION

DRAINAGE DETAILS

INTERSTATE RTE. H-2, HOV LANES, PH. II
Maui Interchange to Waipio Interchange
F.A.I. PROJECT NO. IR-H2-1(27)

FED. ROAD DIST. NO.	STATE	FED. AID PROJ. NO.	FISCAL YEAR	SHEET NO.	TOTAL SHEETS
HAWAII	HAW.	IR-H2-1(27)	1992	130	223

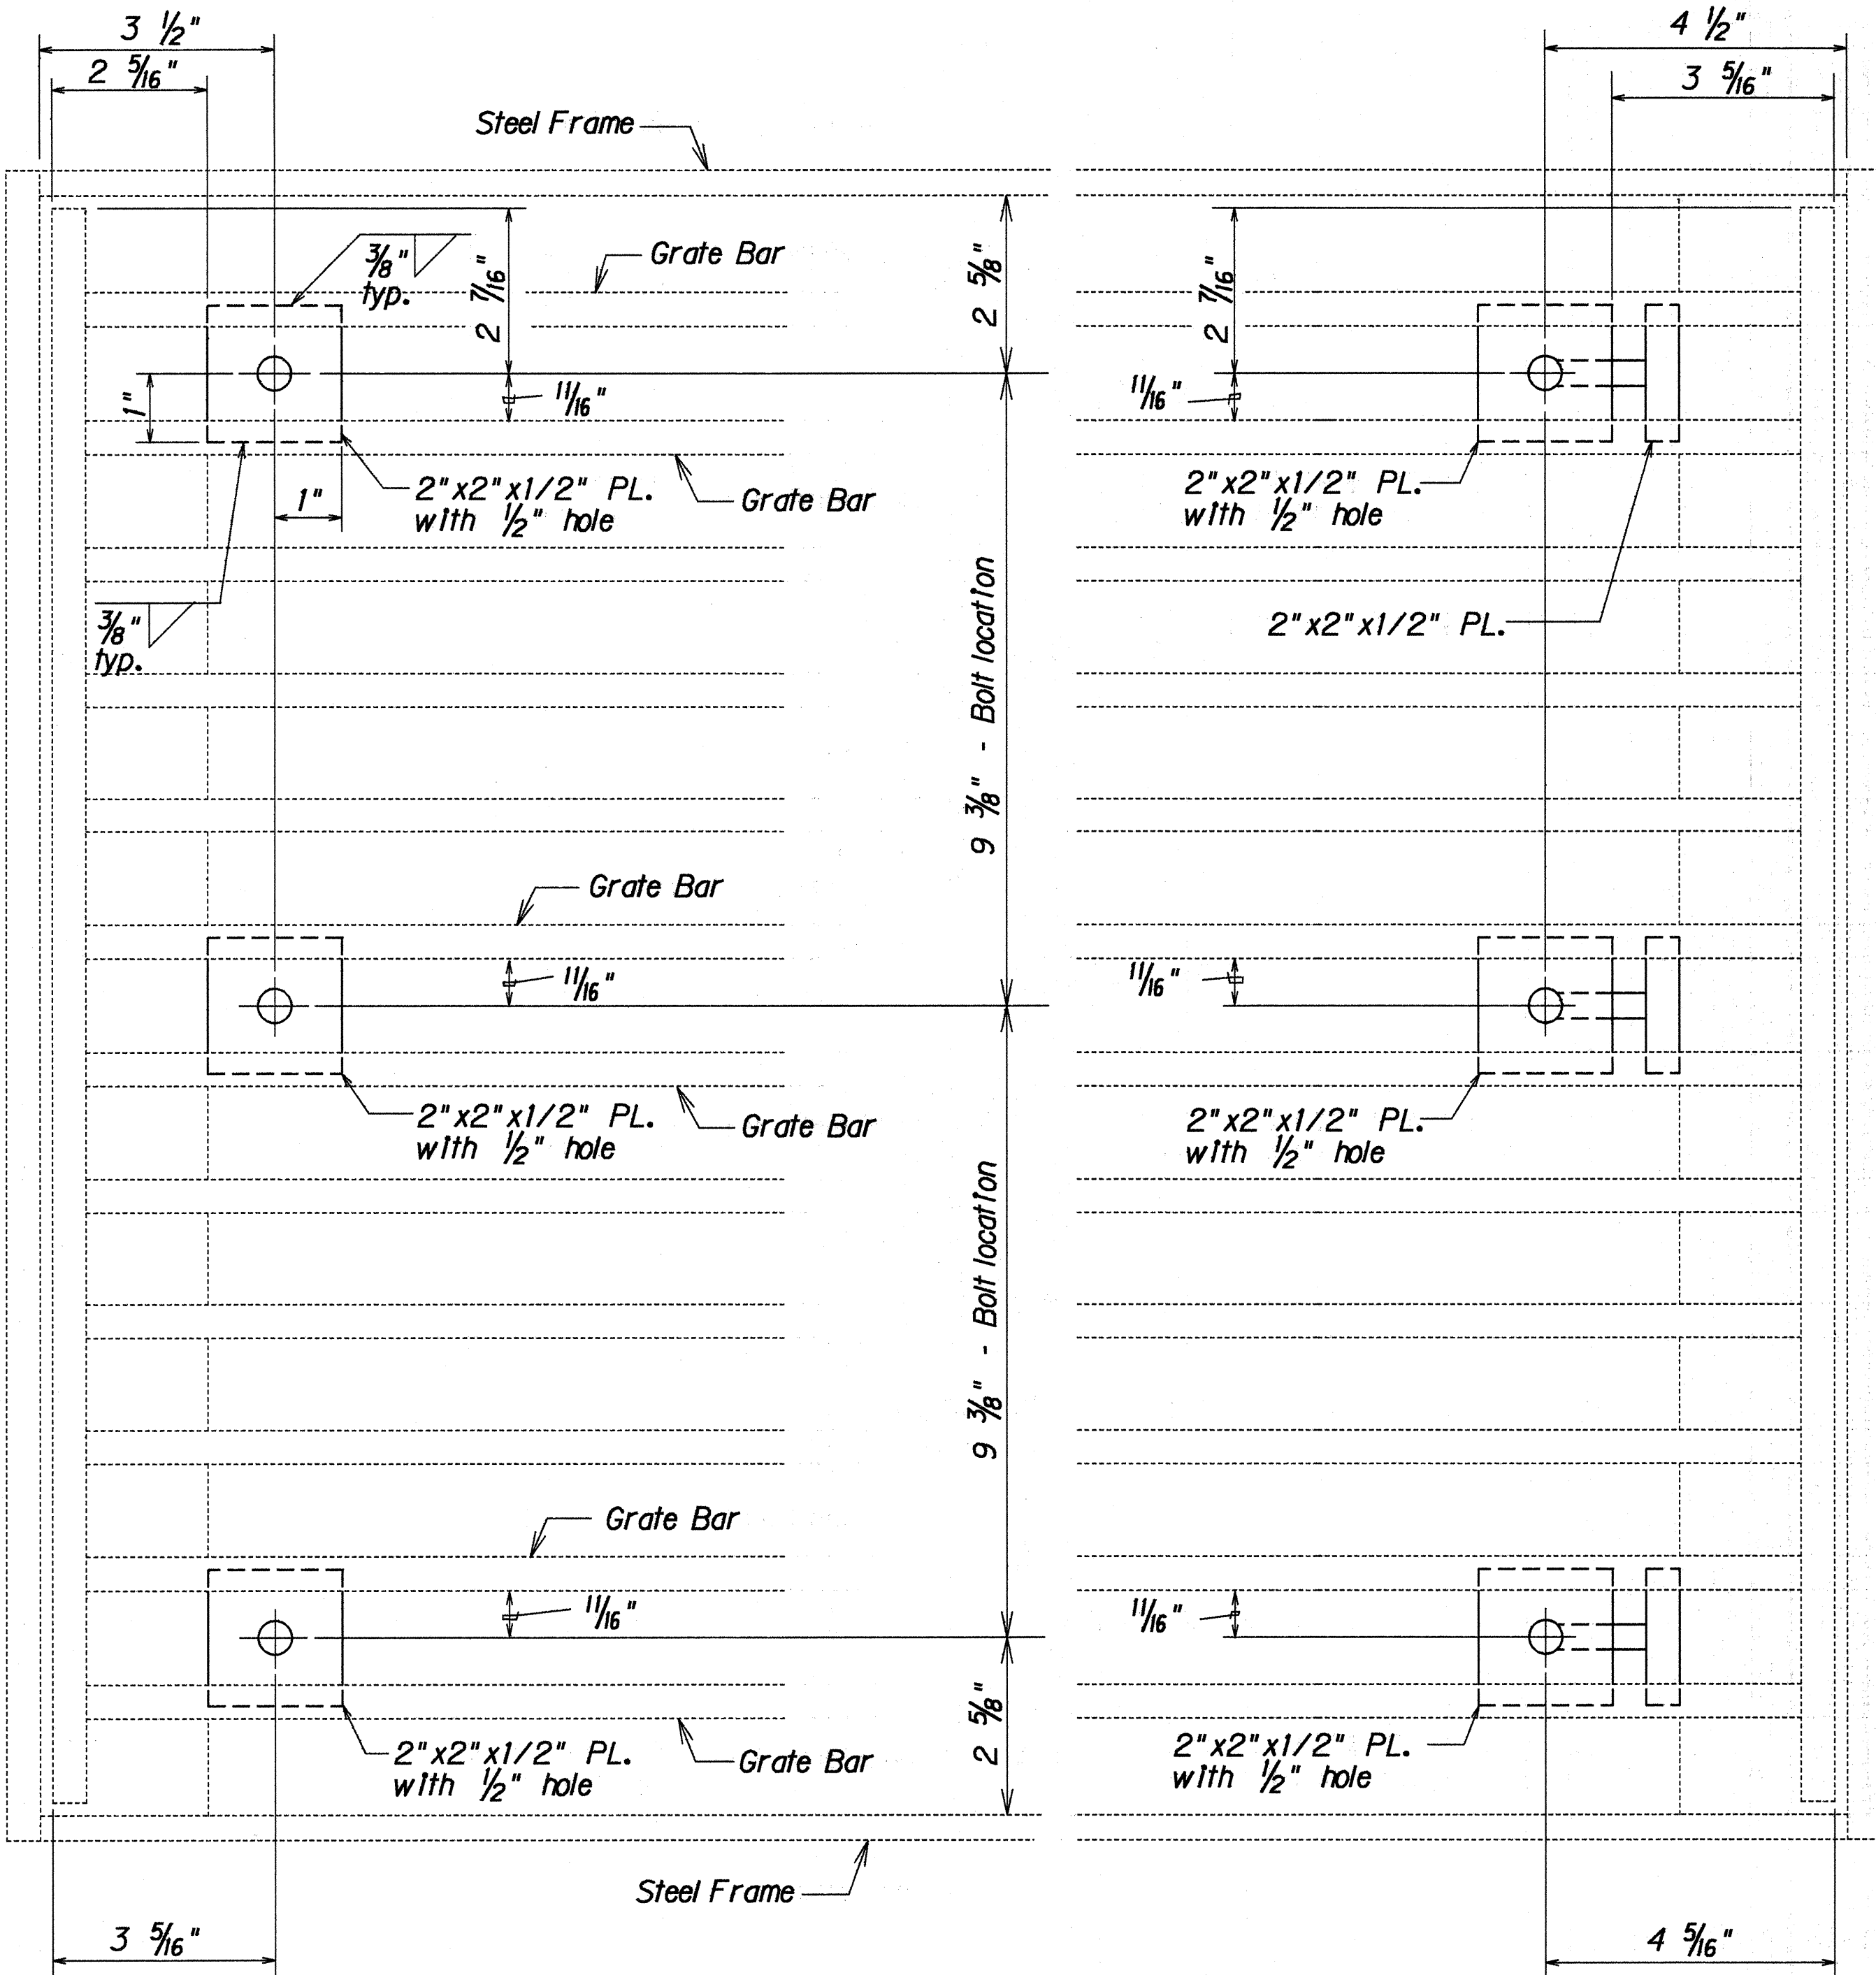


BEAM CONNECTION


ANGLE IRON CONNECTION

PLAN OF A-12 GRATE AND 2" X 2" X 1/2" PLATE
Scale: 6" = 1'-0"

DETAILS OF MODIFICATION TO A-12 STEEL FRAME & GRATES

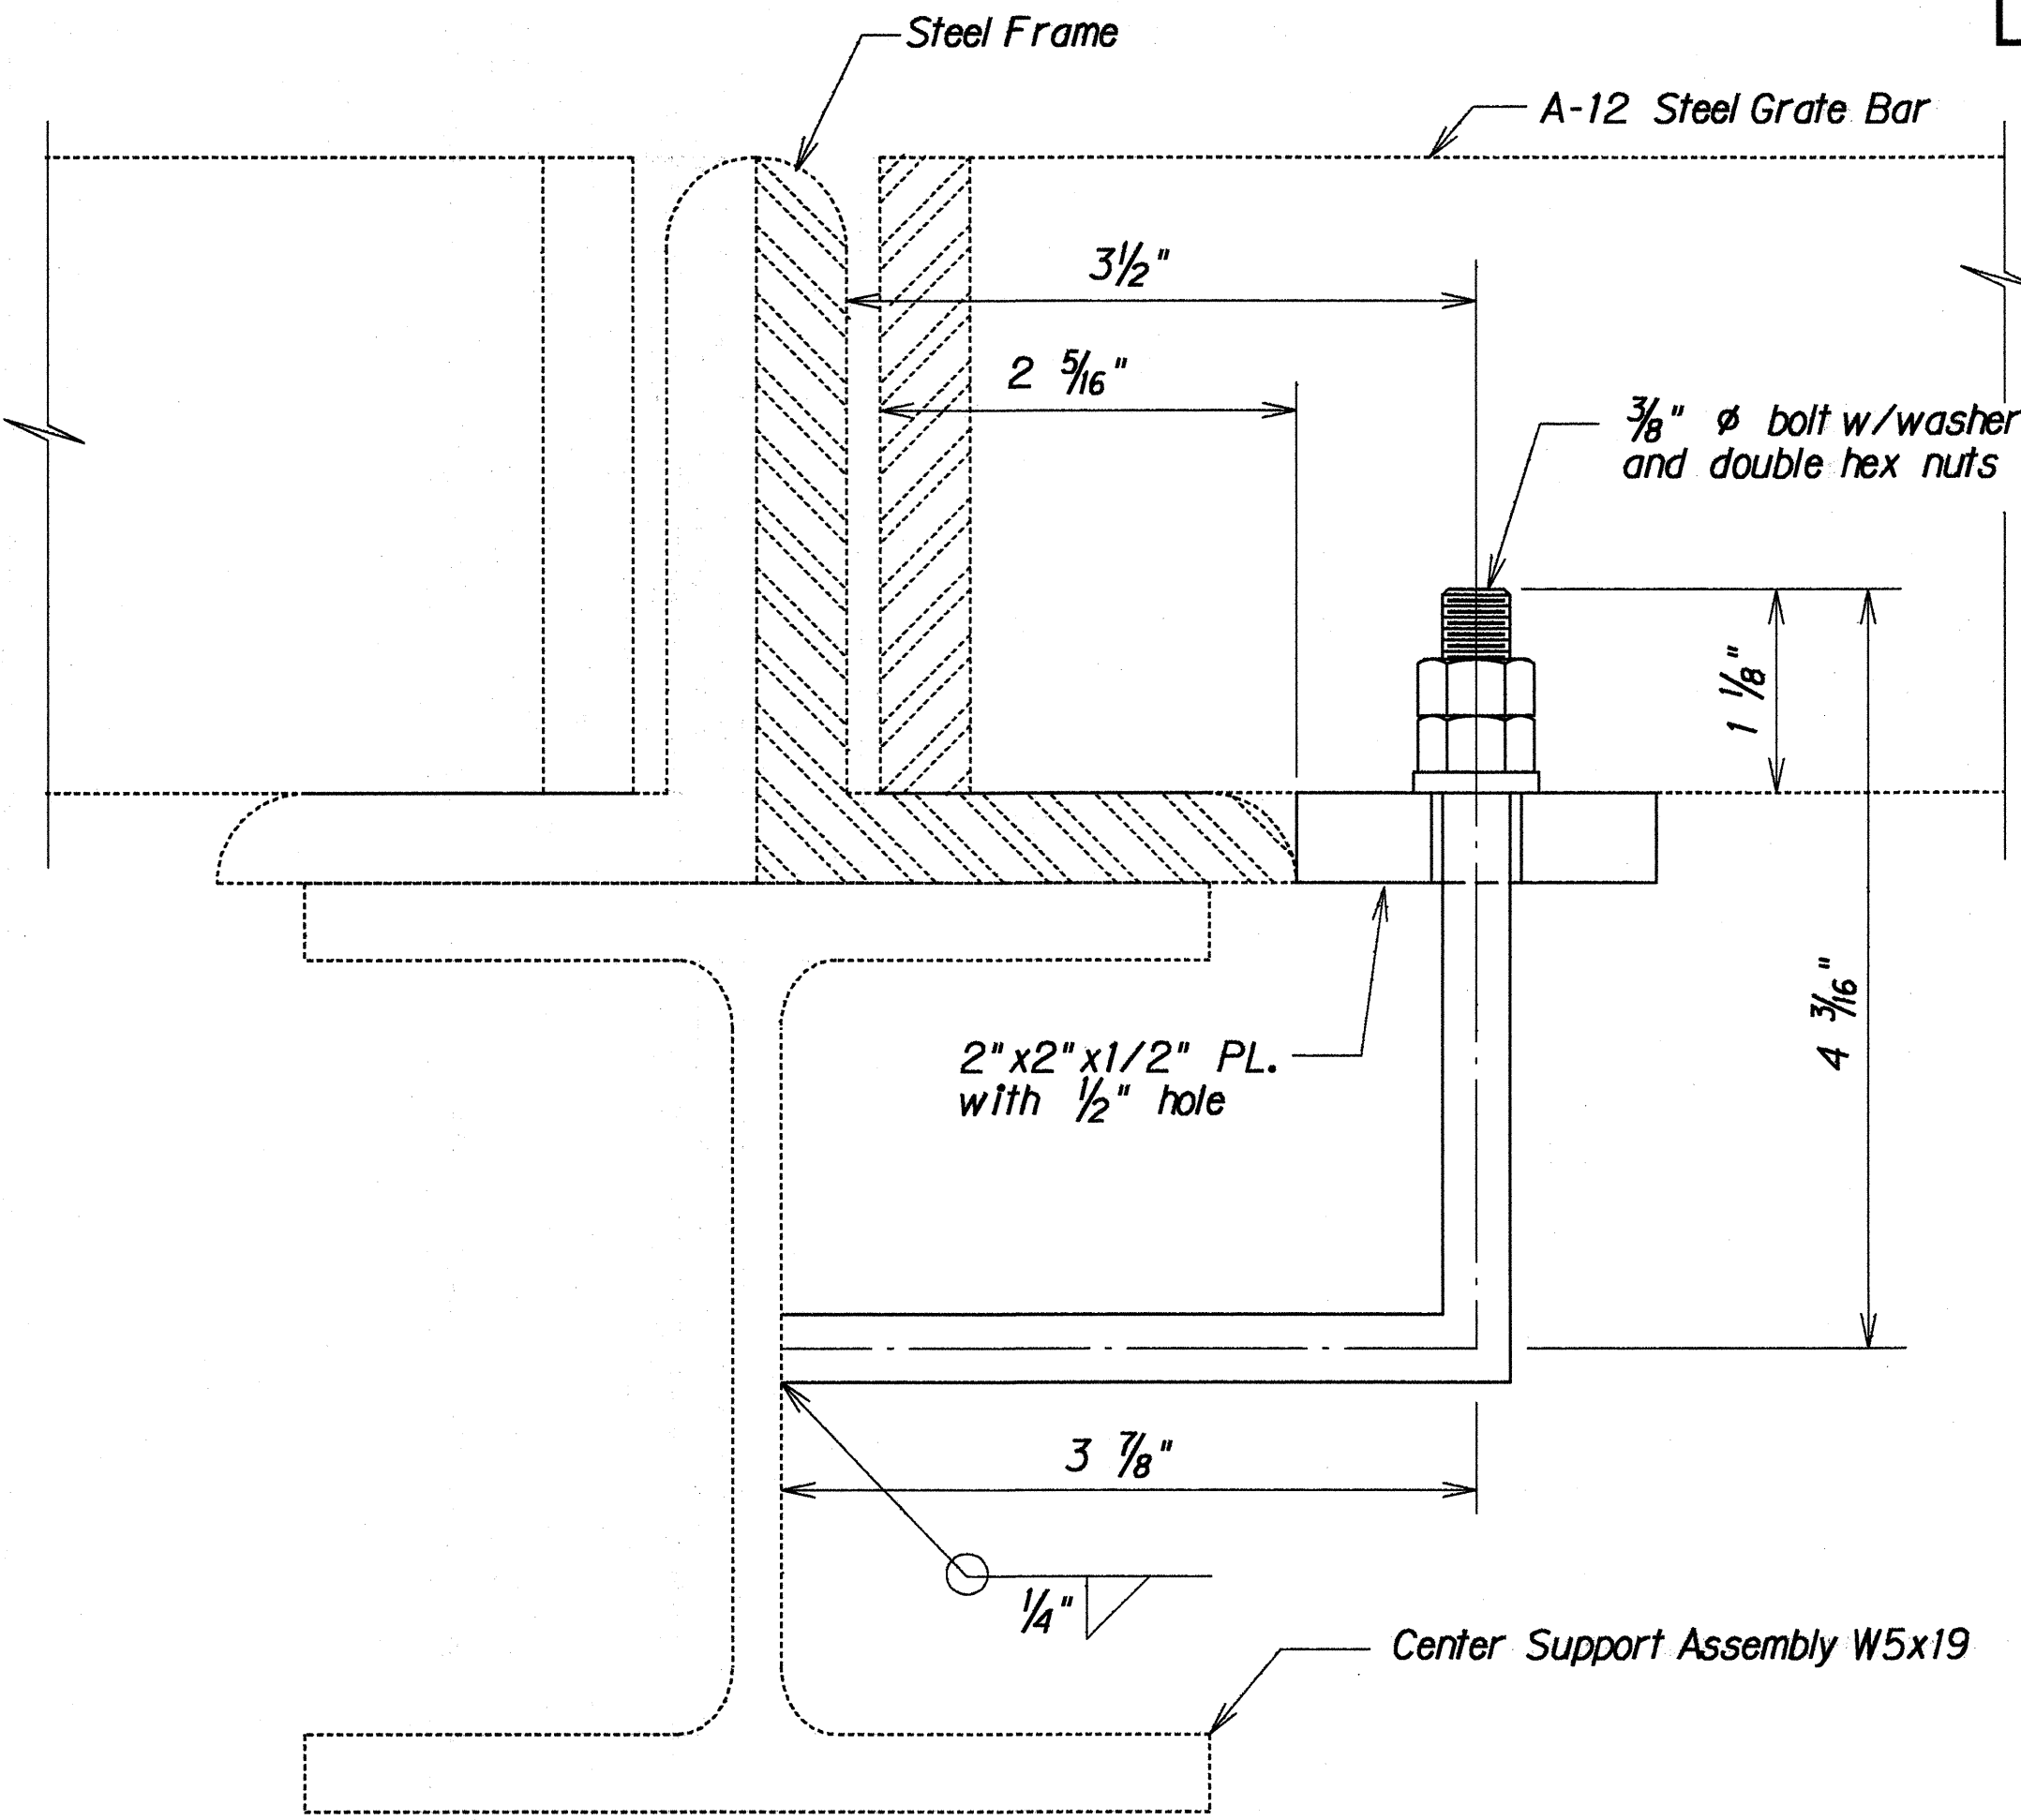

ELEVATION OF BEAM CONNECTION
Full Size

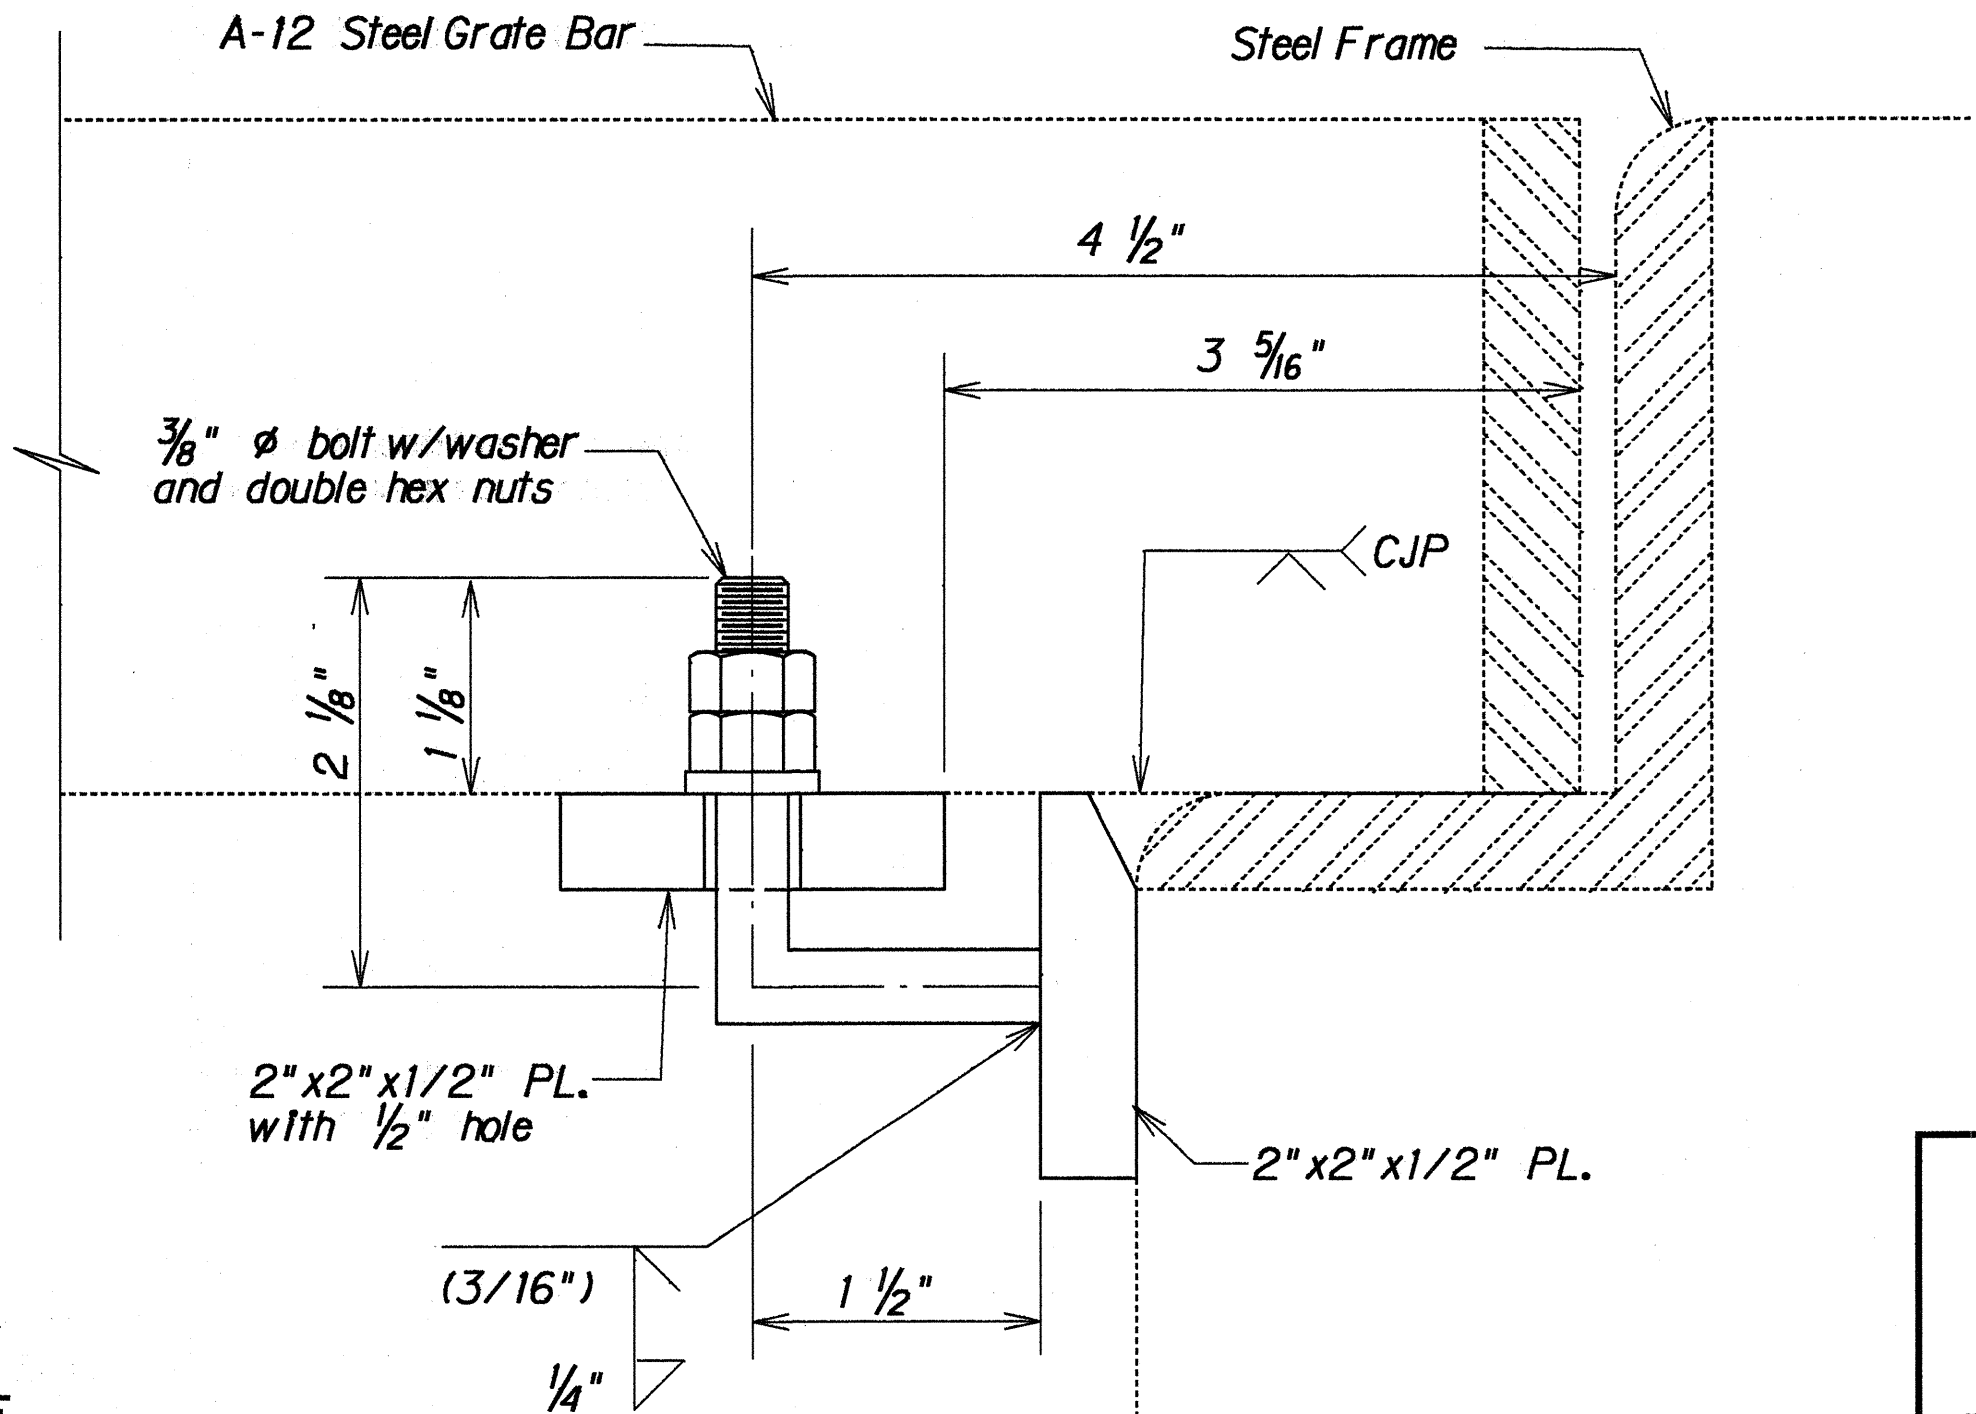

ELEVATION OF ANGLE IRON CONNECTION
Full Size

GENERAL NOTES:


- The various materials shall conform to the specifications of ASTM as listed in the following tabulation and the Standard Specification.
- All structural steel plates shall be hot dipped galvanized. All damage to galvanized coating shall be repaired by a field galvanizing method conforming to Annex A1 of ASTM A 780. Repair shall be by the application of a repair material conforming to the requirements of Federal Specification 0-G-93, stick form.
- Lower nut shall be used as a leveling nut to align members.

Structural Steel	ASTM A 36
BOLTS, NUTS & WASHERS	ASTM A 307


STATE OF HAWAII
DEPARTMENT OF TRANSPORTATION
HIGHWAYS DIVISION

DRAINAGE DETAILS
INTERSTATE RTE. H-2, HOV LANES, PH. II
Miliian Interchange to Waipio Interchange
F.A.I. PROJECT NO. IR-H2-1(27)

FED. ROAD DIST. NO.	STATE	FED. AID PROJ. NO.	FISCAL YEAR	SHEET NO.	TOTAL SHEETS
HAWAII	HAW.	IR-H2-1(27)	1992	131	223

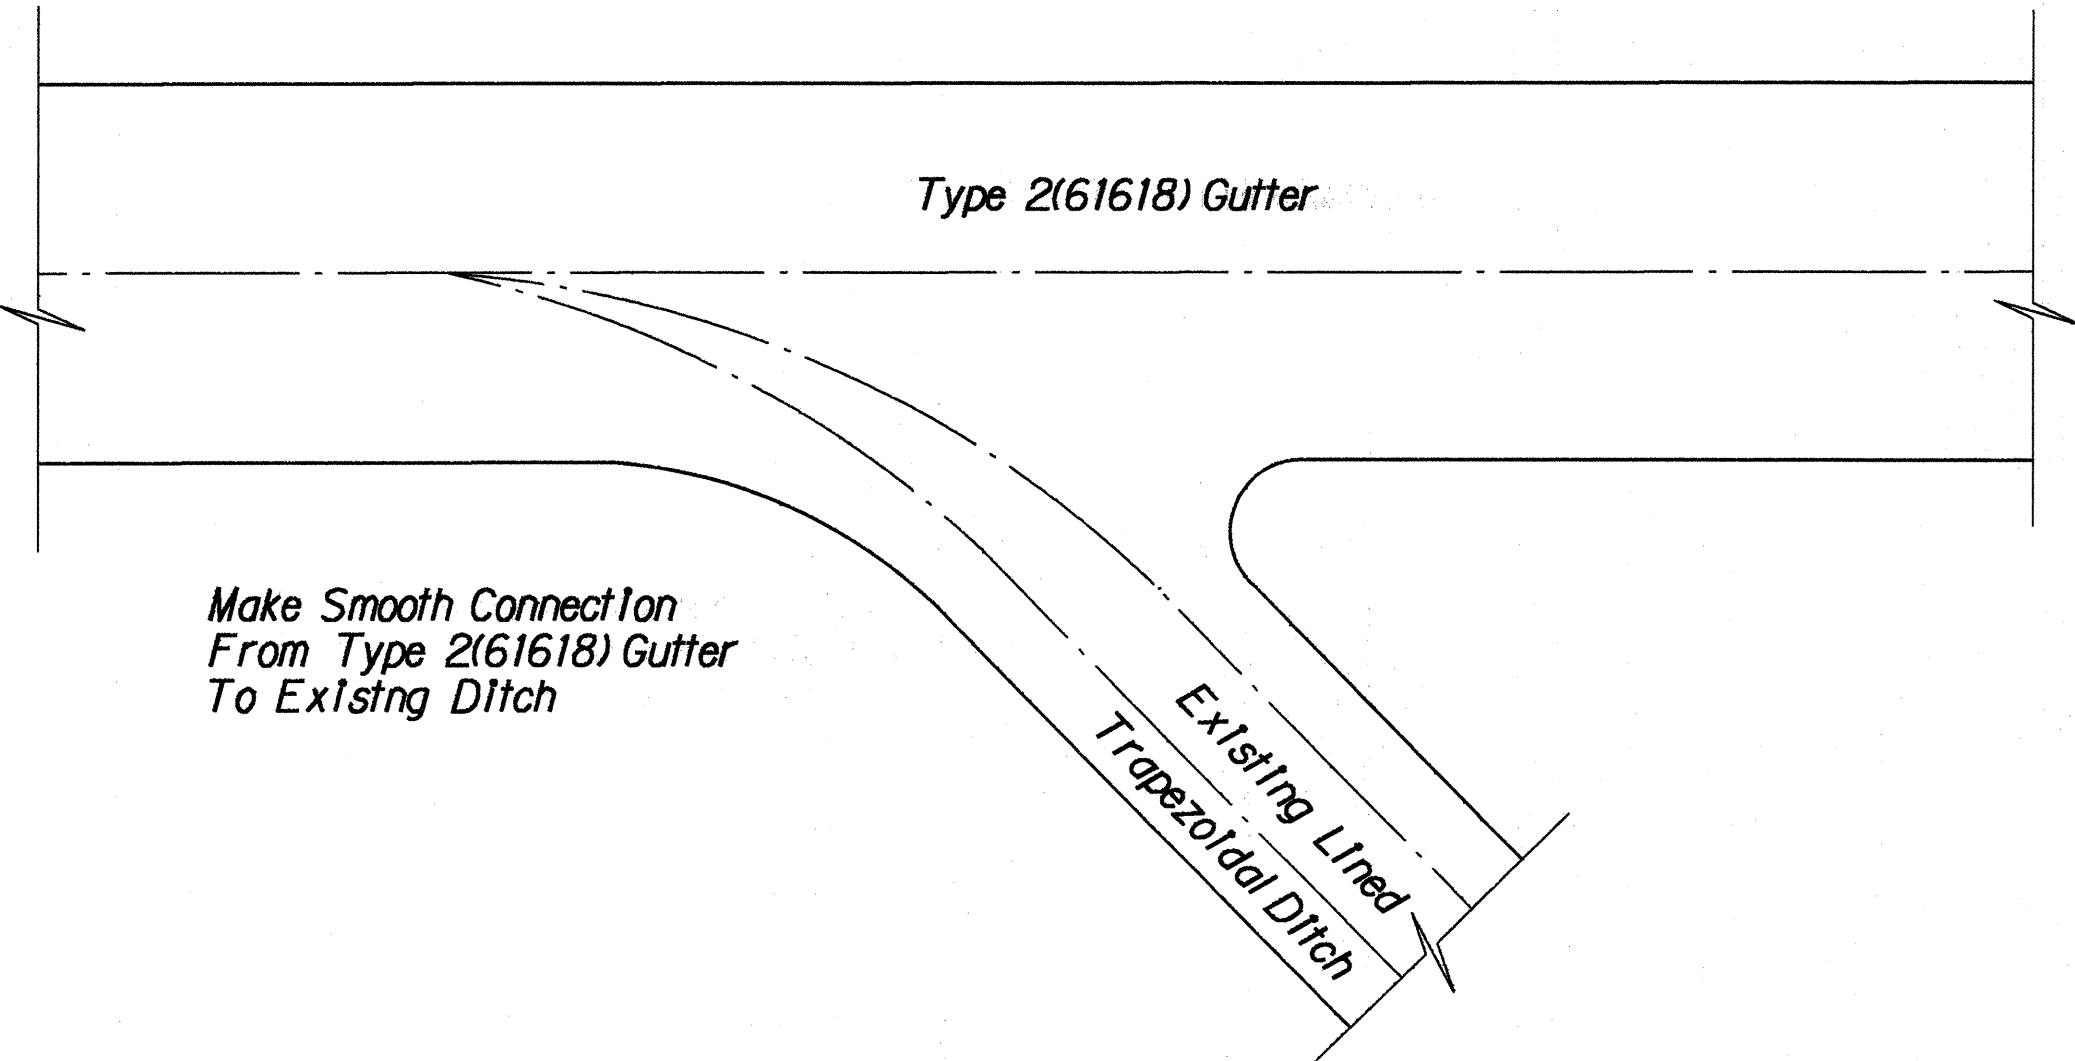


CONNECTION FROM TYPE 2(61618)
GUTTER TO EXISTING DITCH
AT O.B. $\pm$ STA. 318+30 $\pm$
Scale: $\frac{1}{4}$ " = 1'-0"

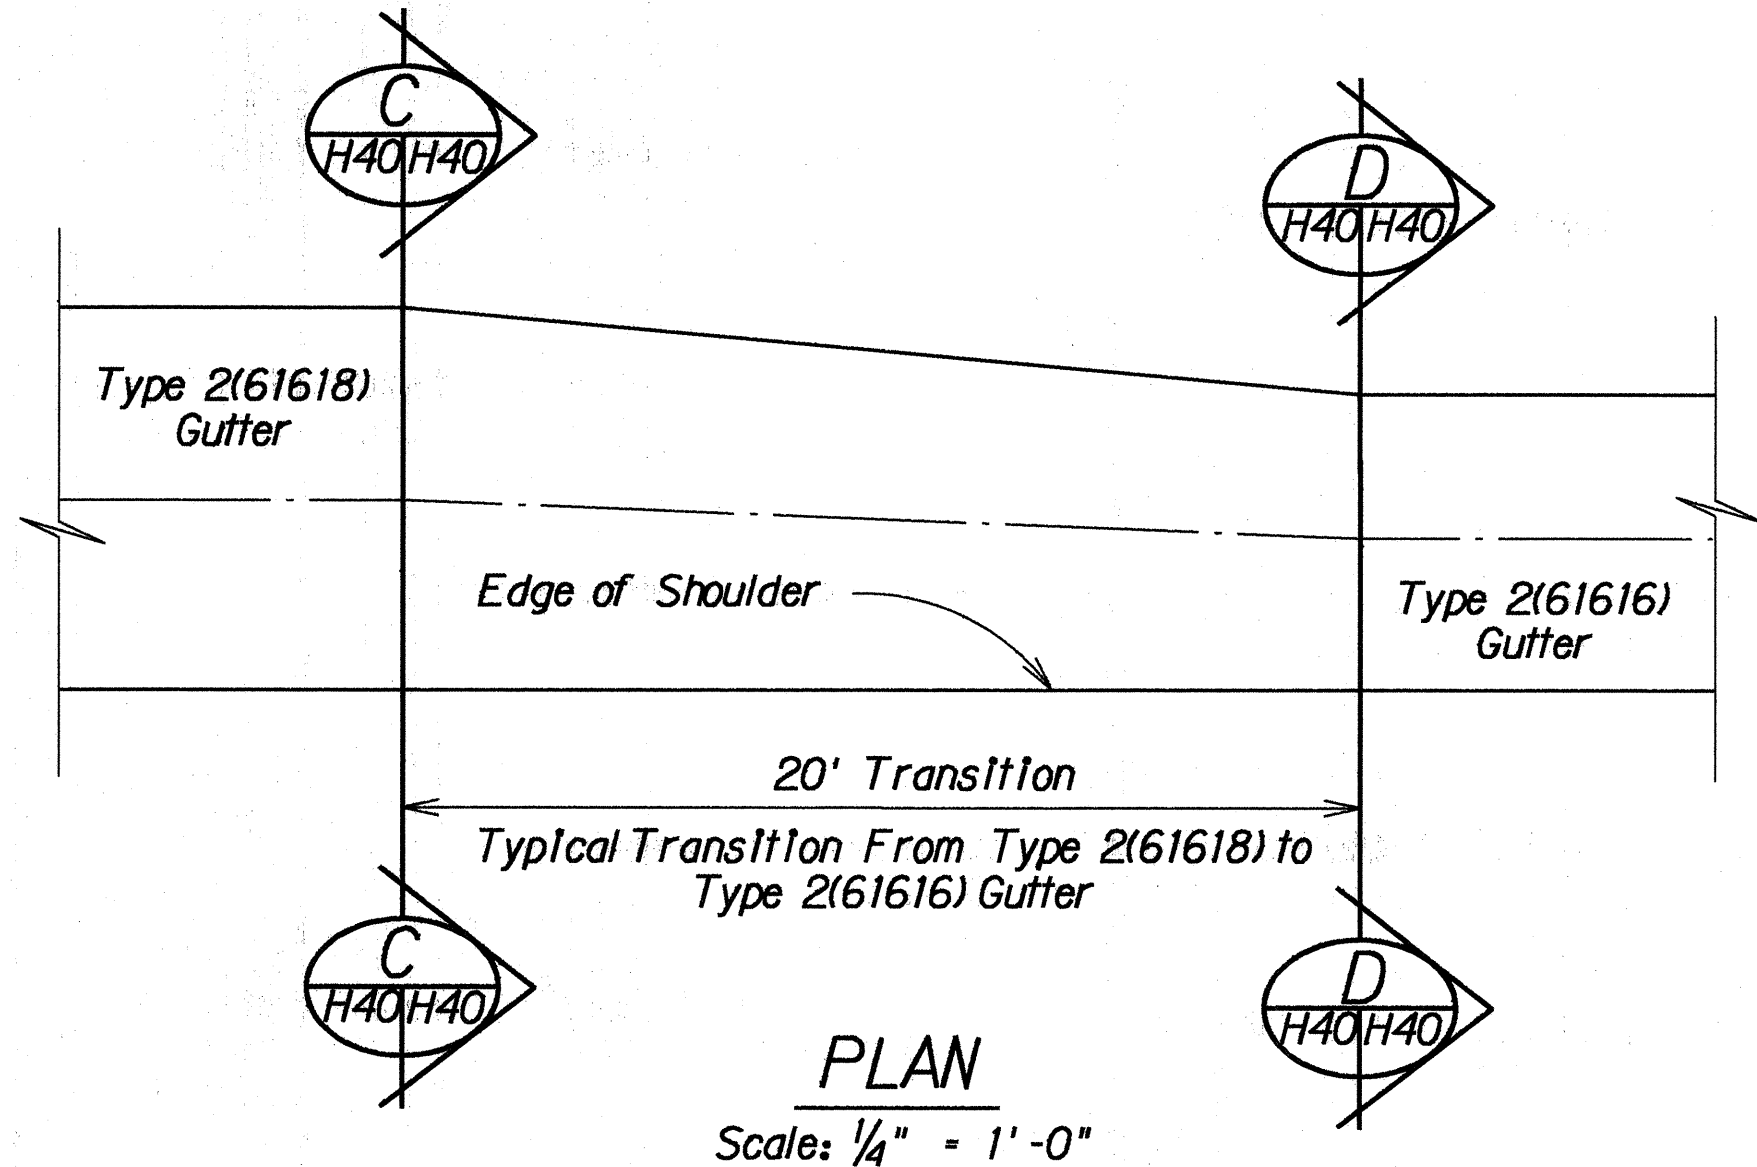


PLAN
Scale: $\frac{1}{4}$ " = 1'-0"


TYPICAL TRANSITION FROM TYPE 2(61618) TO TYPE 2(61616) GUTTER

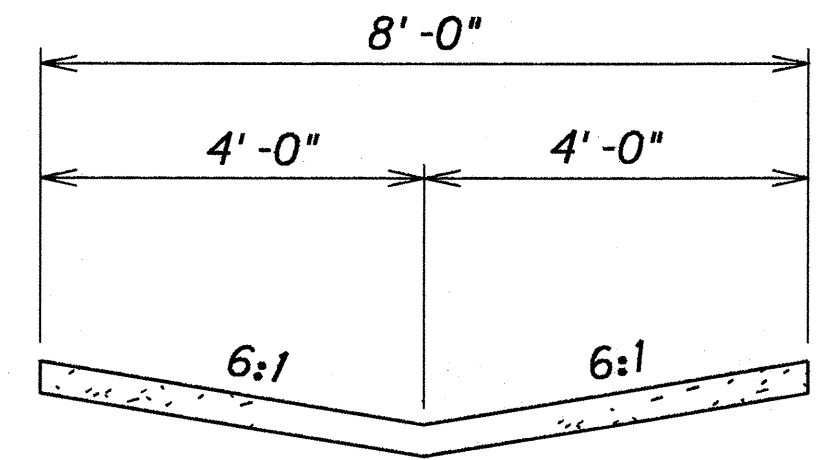

TYPE 2(61618) GUTTER
SECTION C
Scale: $\frac{1}{2}$ " = 1'-0"

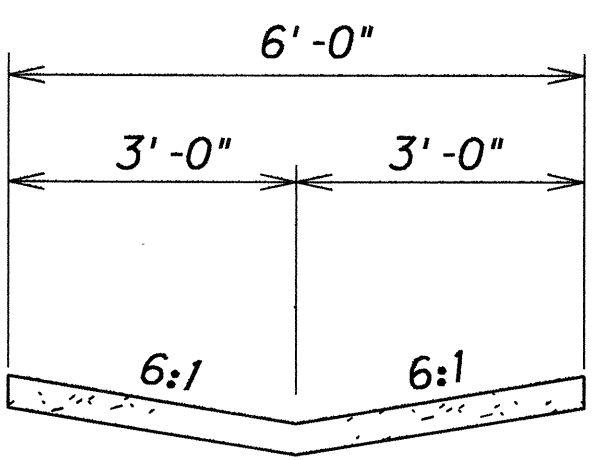


TYPE 2(61616) GUTTER
SECTION D
Scale: $\frac{1}{2}$ " = 1'-0"

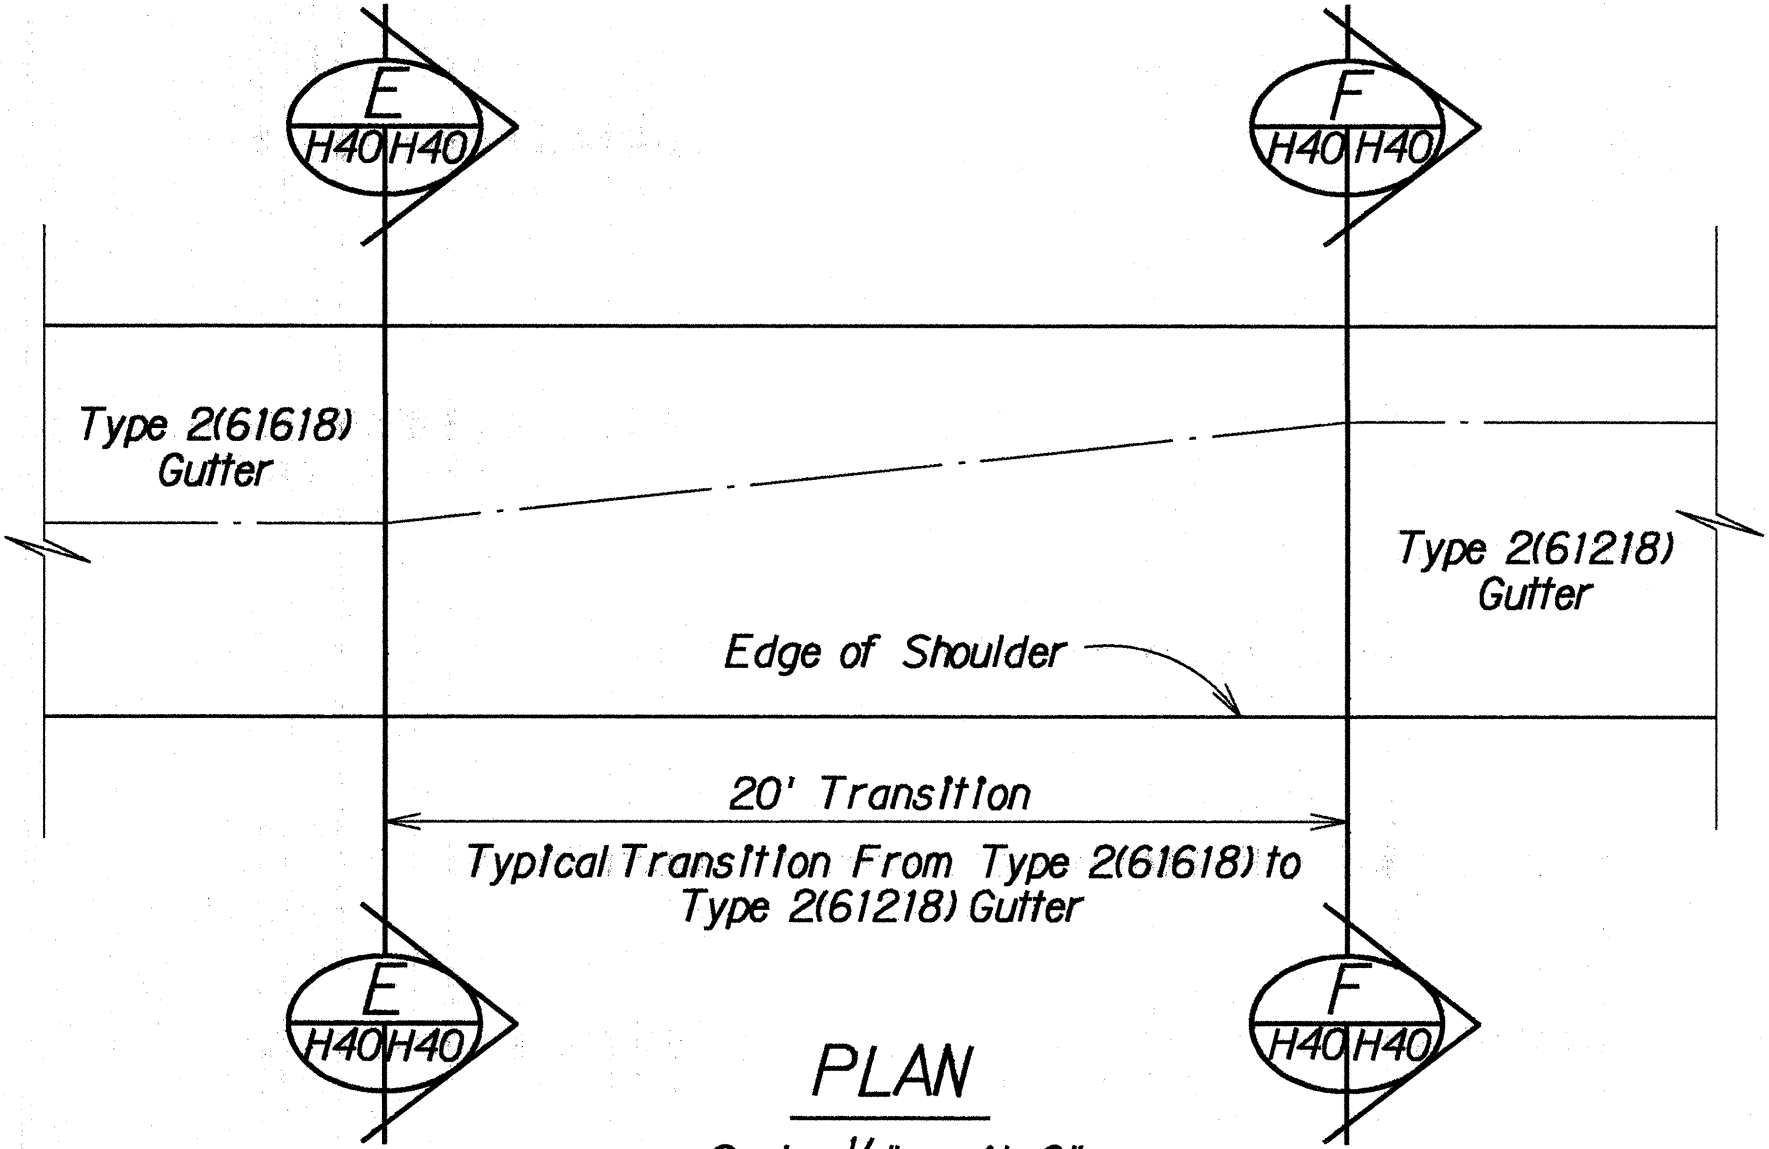


PLAN
Scale: $\frac{1}{4}$ " = 1'-0"


TYPICAL TRANSITION FROM TYPE 2(61618) TO TYPE 2(61218) GUTTER

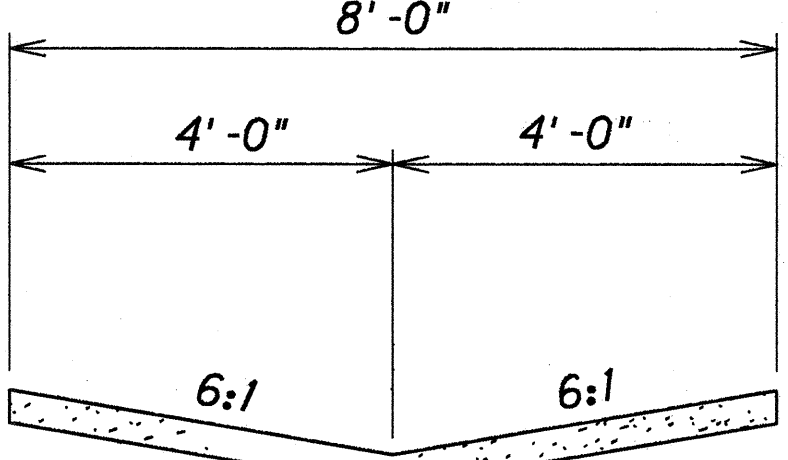

TYPE 2(61618) GUTTER
SECTION E
Scale: $\frac{1}{2}$ " = 1'-0"

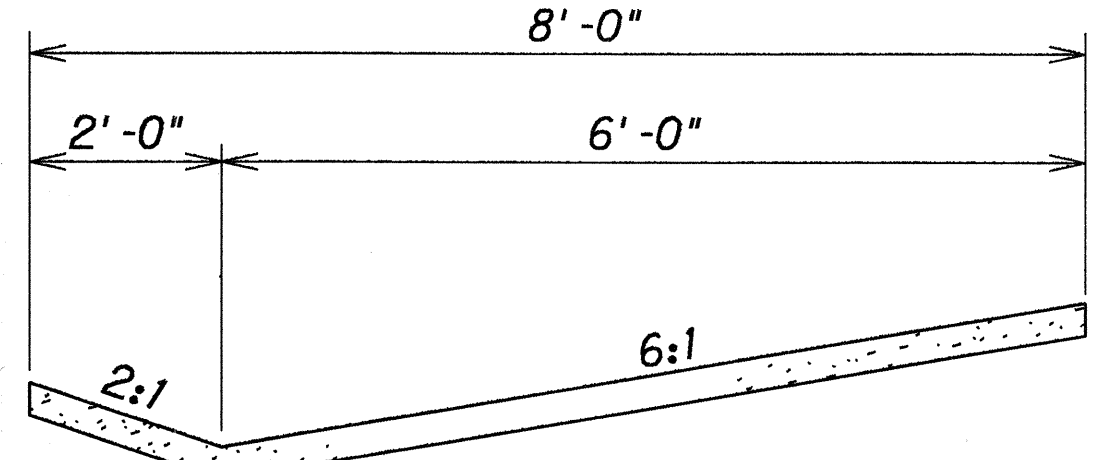


TYPE 2(61218) GUTTER
SECTION F
Scale: $\frac{1}{2}$ " = 1'-0"

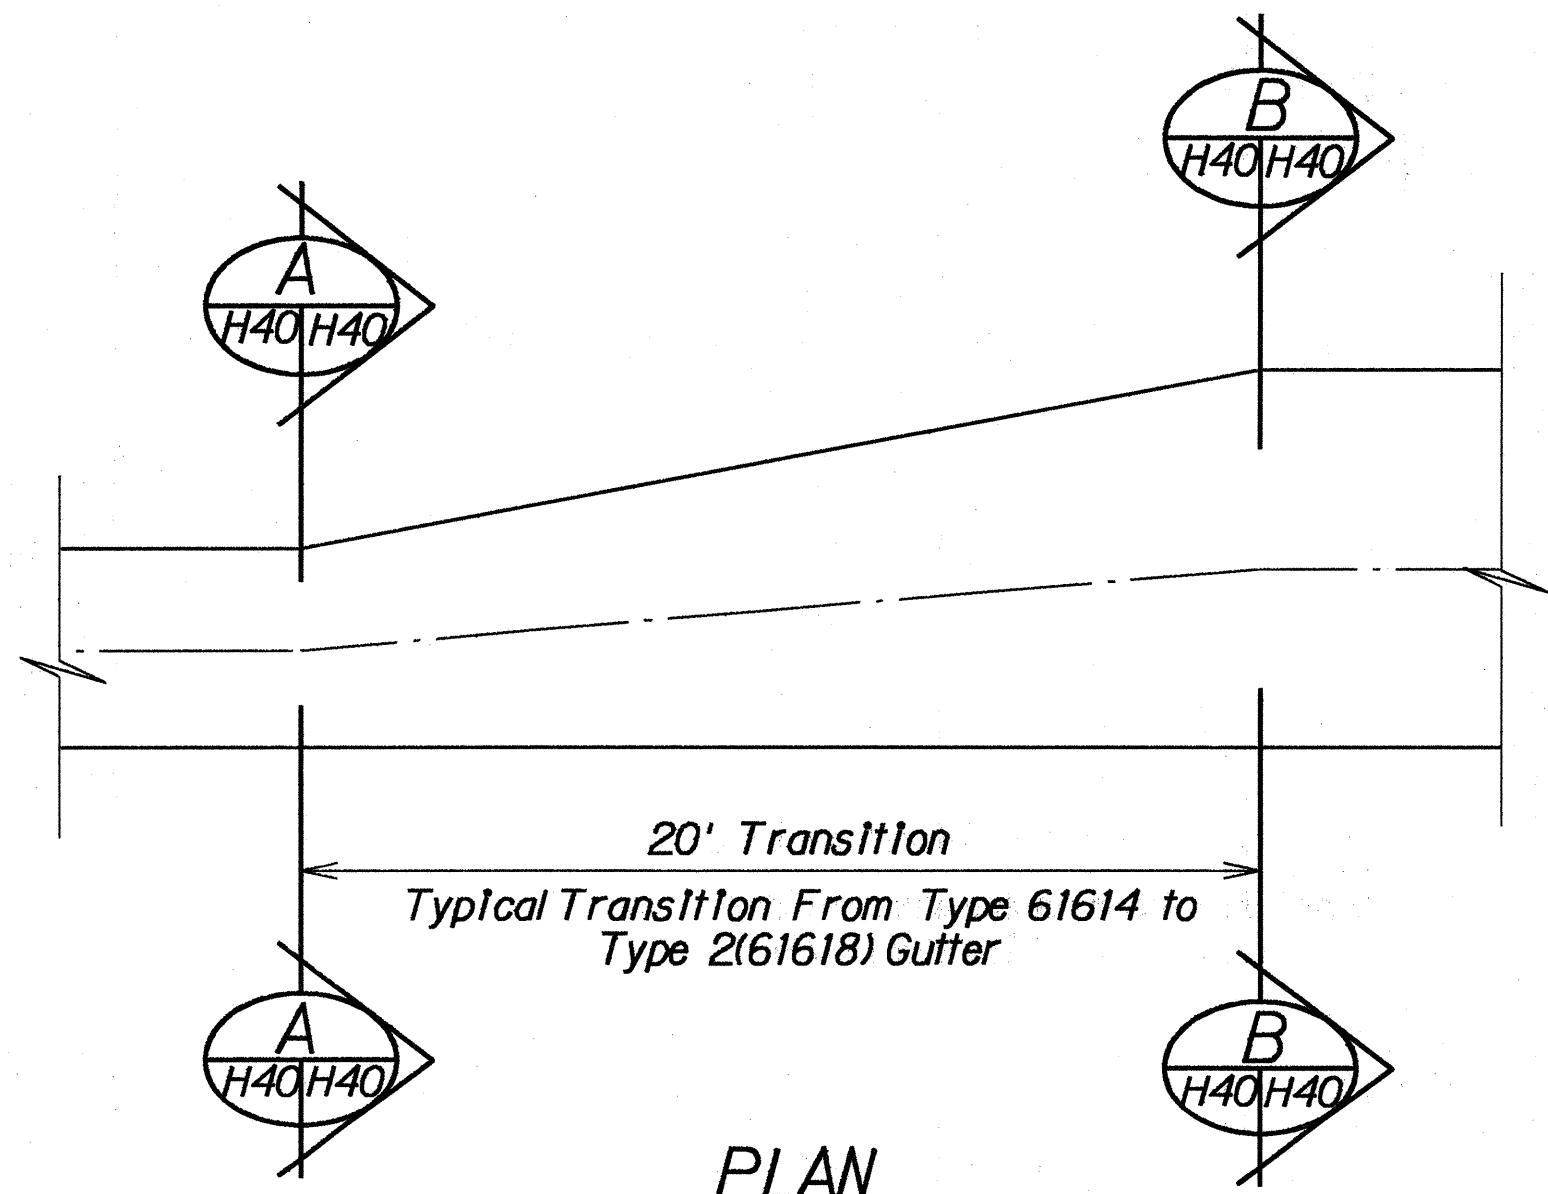


PLAN
Scale: $\frac{1}{4}$ " = 1'-0"

TYPICAL TRANSITION FROM TYPE 61614 TO TYPE 2(61618) GUTTER

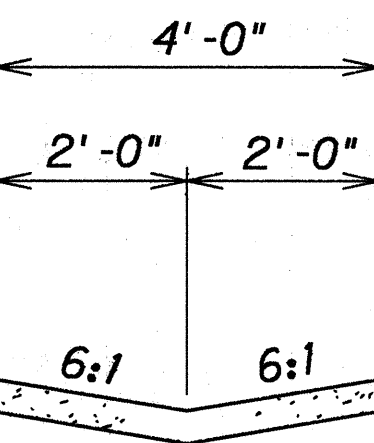

EXISTING TYPE 61614 GUTTER

SECTION A
Scale: $\frac{1}{2}$ " = 1'-0"

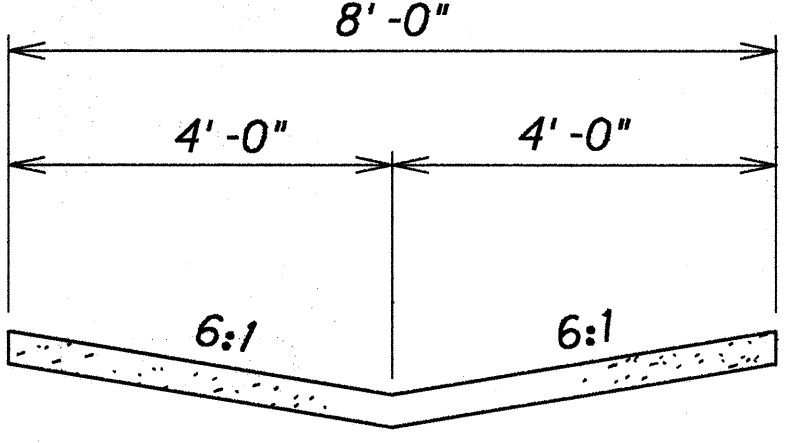

TYPE 2(61618) GUTTER

SECTION B
Scale: $\frac{1}{2}$ " = 1'-0"

STATE OF HAWAII
DEPARTMENT OF TRANSPORTATION
HIGHWAYS DIVISION



DRAINAGE DETAILS

INTERSTATE RTE. H-2, HOV LANES, PH. II
Millian Interchange to Waipio Interchange
F.A.I. PROJECT NO. IR-H2-1(27)

Scale: As Shown Date: Apr., 1992


SHEET No. H40 OF 42 SHEETS

FED. ROAD DIST. NO.	STATE	FED. AID PROJ. NO.	FISCAL YEAR	SHEET NO.	TOTAL SHEETS
HAWAII	HAW.	IR-H2-1(27)	1992	132	223

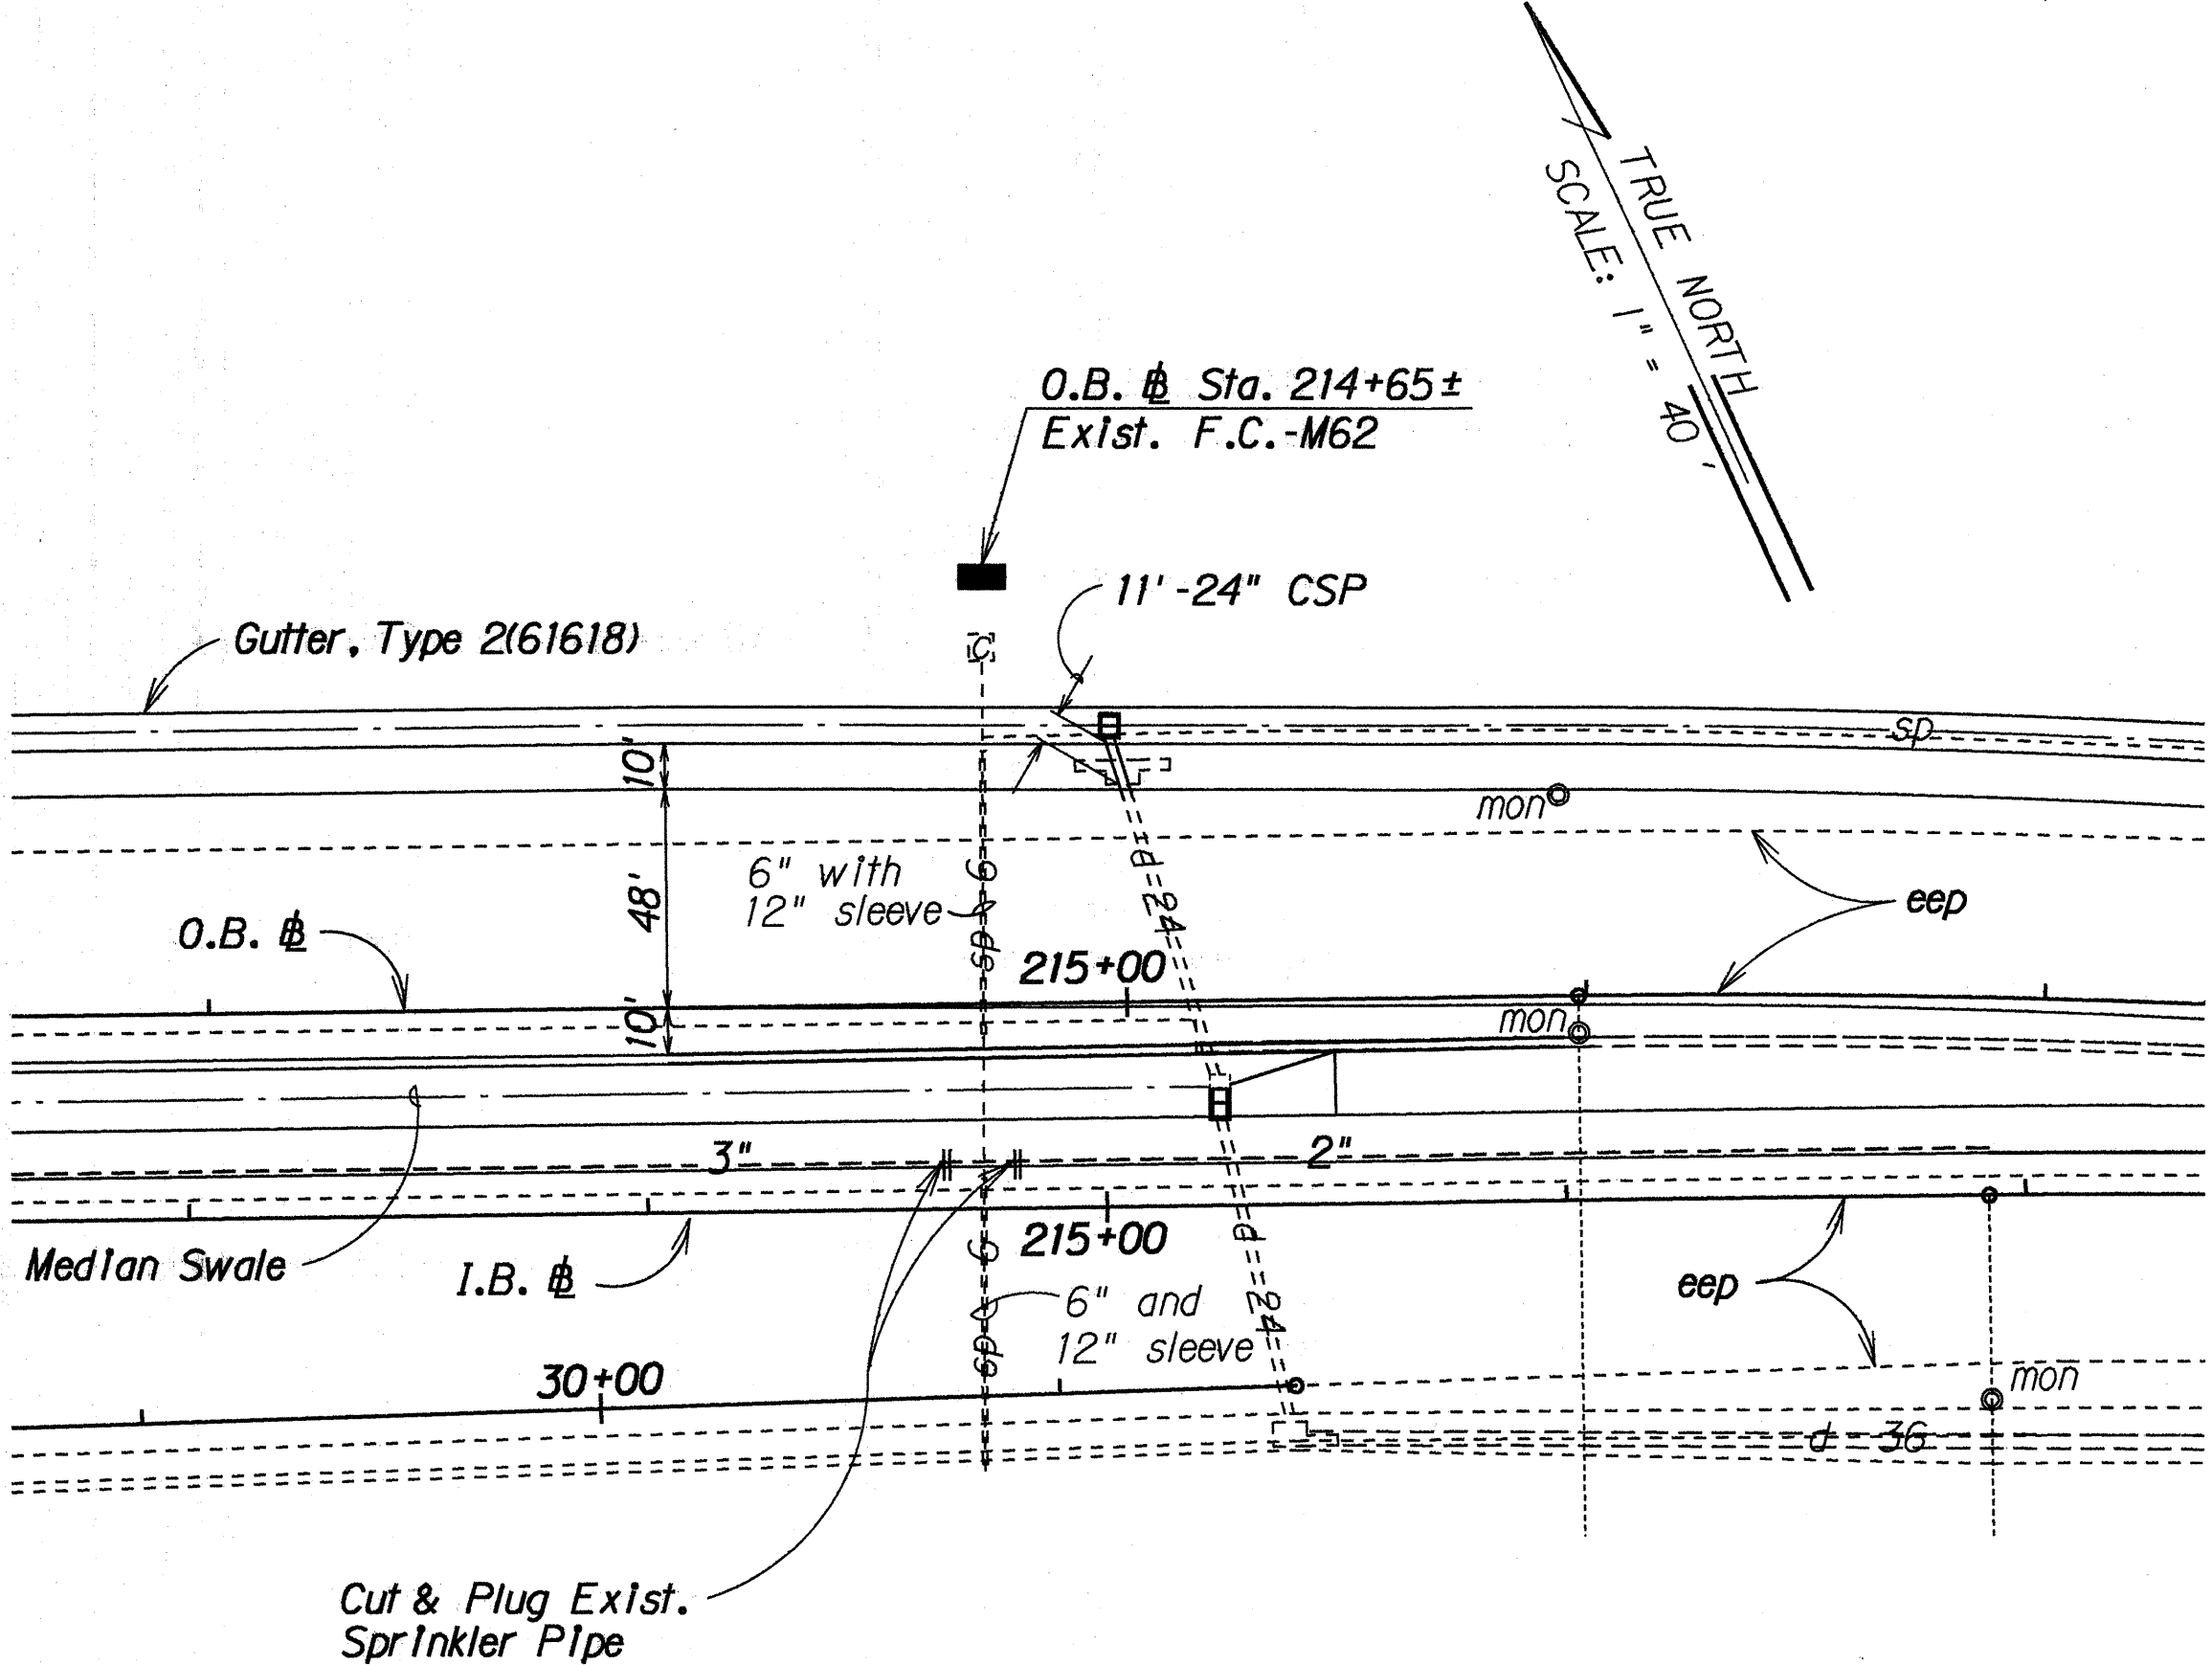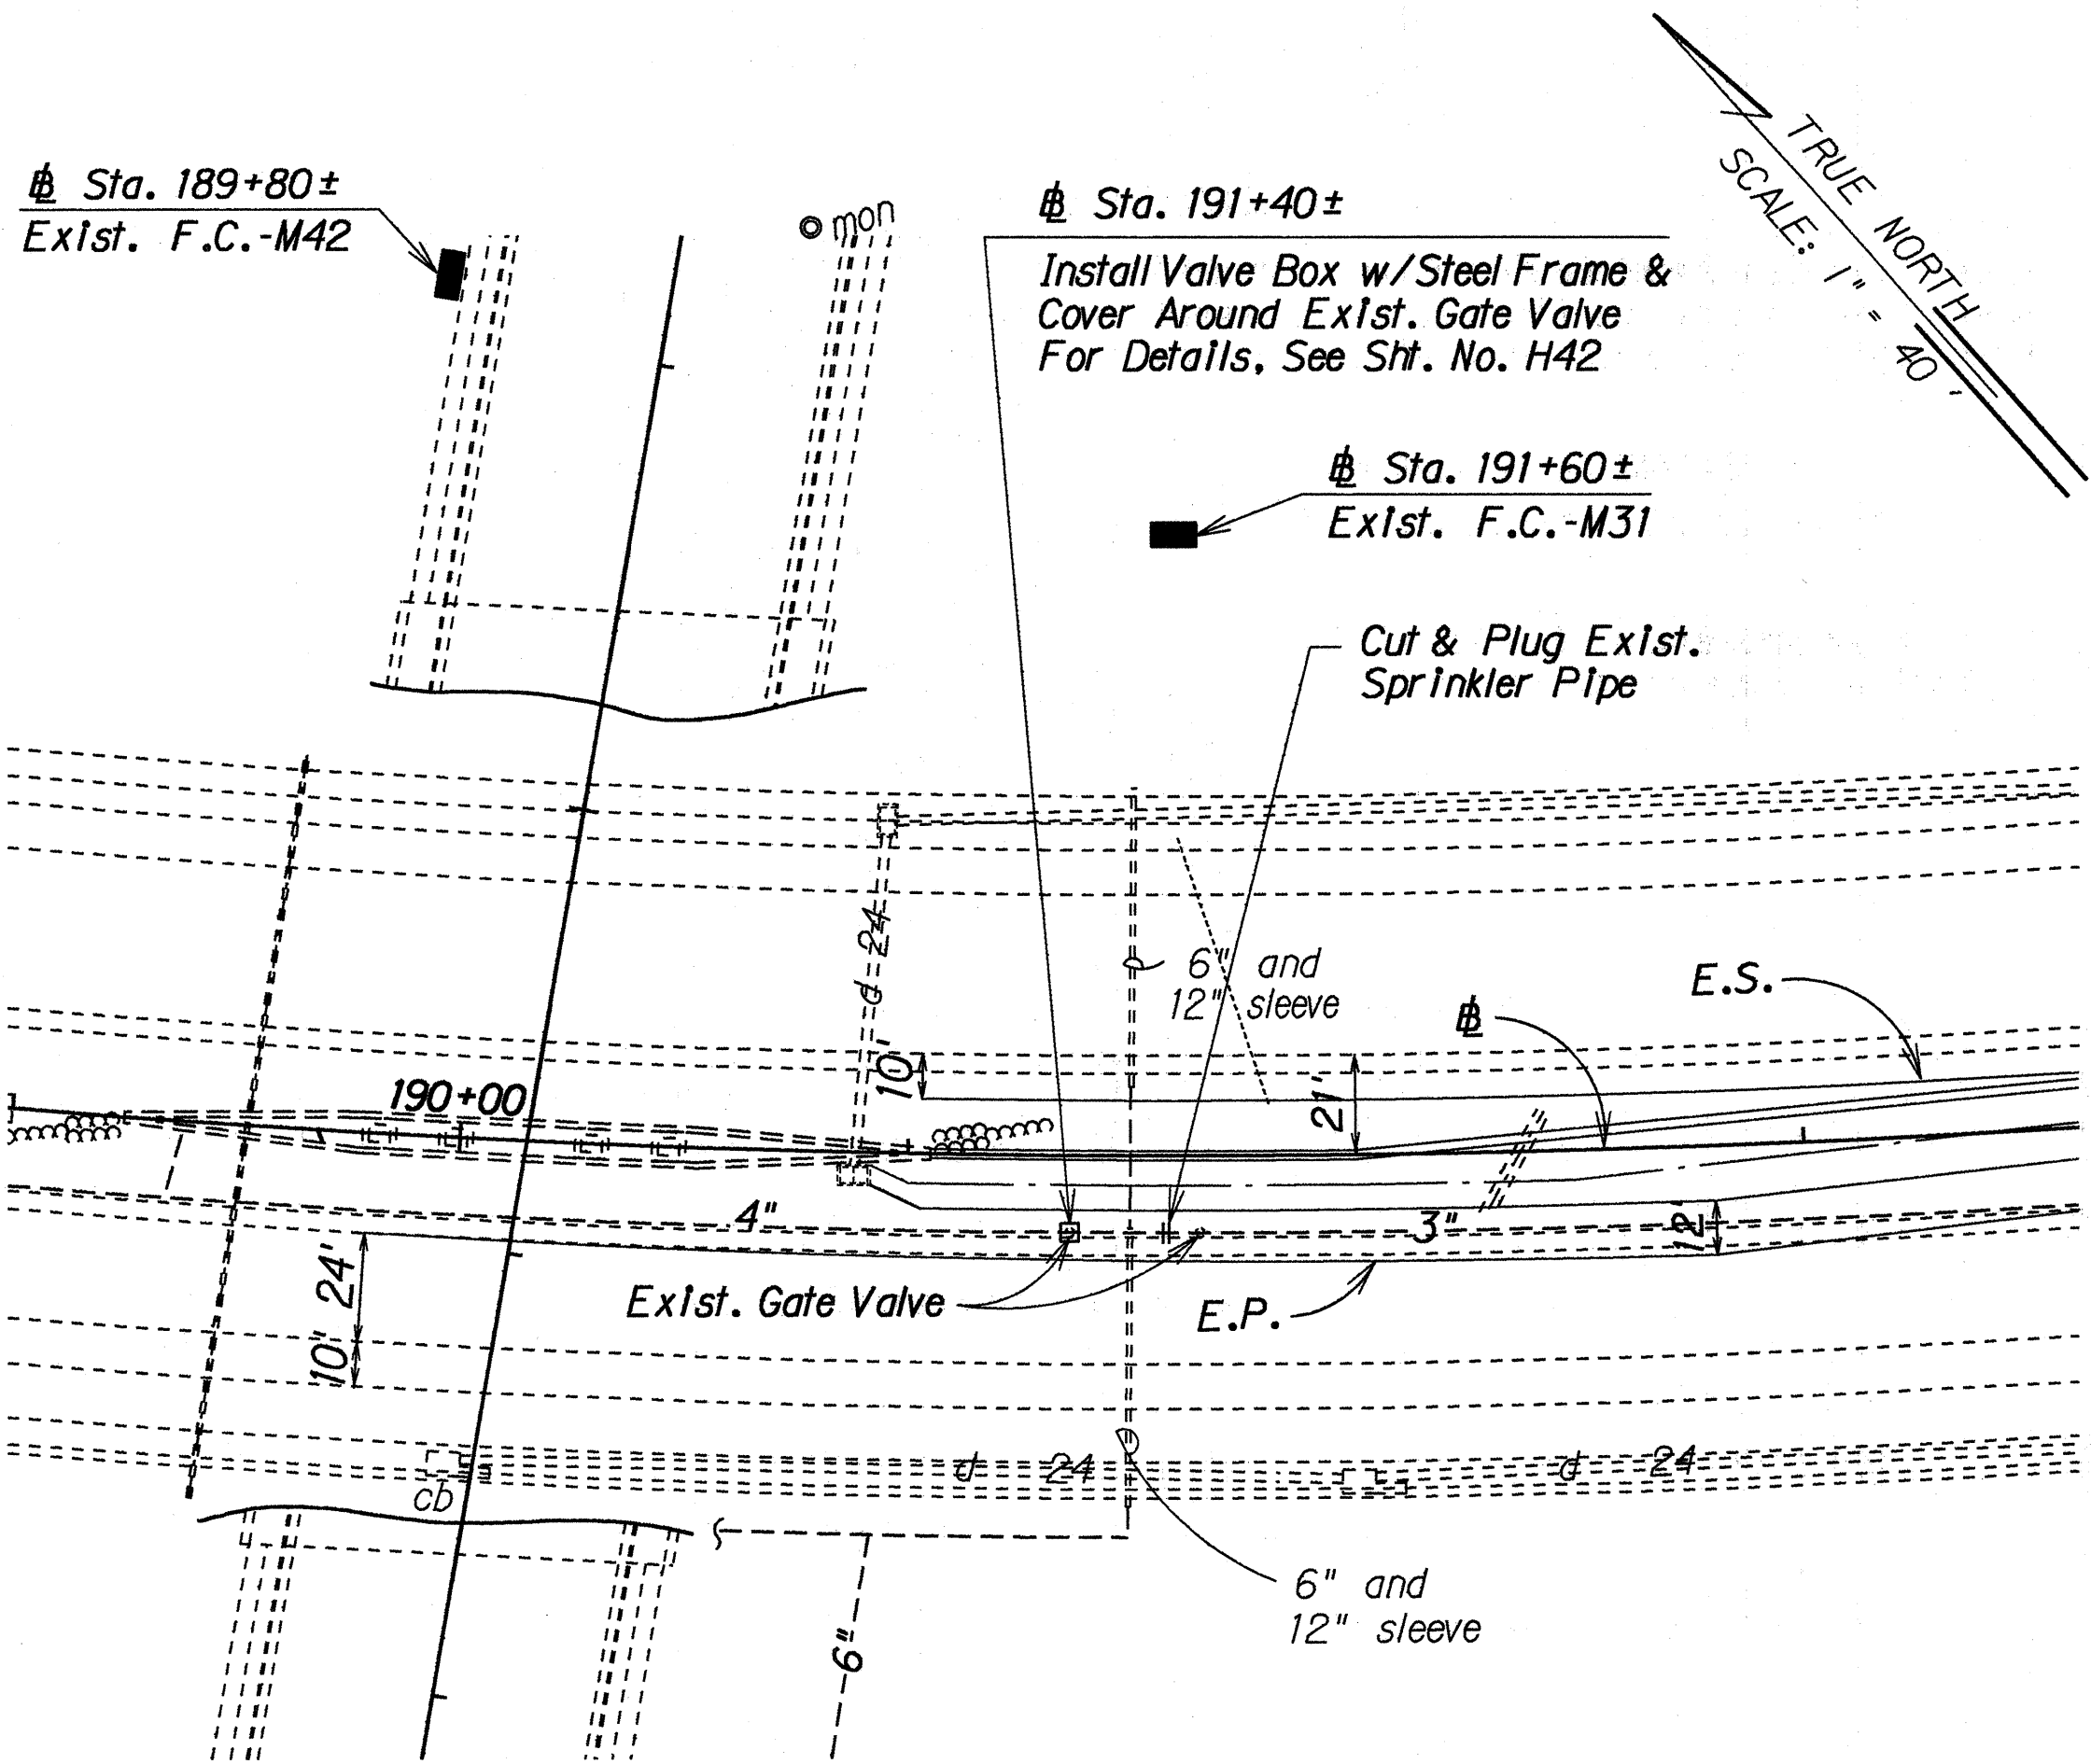

- Disconnect the following stations from their respective field controllers:
- F.C. - M31
Disconnect station 10
 - F.C. - M42
Disconnect station 9 & 10
 - F.C. - M62
Disconnect station 1 - 10
- Remote Control Valves Locations are:

Field Controller	Bank No.	Location
F.C. - M31 (Sta. 10)	M5G1	Sta. 192+15 o/s 15' Rt.
F.C. - M42 (Sta. 9)	M5I1	Sta. 194+33 o/s 15' Rt.
F.C. - M42 (Sta. 10)	M6B5	Sta. 197+20 o/s 15' Rt.
F.C. - M62 (Sta. 1)	M6C5	I.B. Sta. 199+40 o/s 7' Lt.
F.C. - M62 (Sta. 2)	M6D5	I.B. Sta. 201+82 o/s 7' Rt.
F.C. - M62 (Sta. 3)	M6F5	I.B. Sta. 204+00 o/s 7' Lt.
F.C. - M62 (Sta. 4)	M6G5	I.B. Sta. 206+70 o/s 7' Lt.
F.C. - M62 (Sta. 5)	M6I4	I.B. Sta. 209+68 o/s 7' Lt.
F.C. - M62 (Sta. 7)	M7B4	I.B. Sta. 212+50 o/s 7' Lt.
F.C. - M62 (Sta. 6)	M7C4	I.B. Sta. 215+17 o/s 7' Lt.
F.C. - M62 (Sta. 8)	M7E4	I.B. Sta. 218+03 o/s 7' Lt.
F.C. - M62 (Sta. 9)	M7F4	I.B. Sta. 219+75 o/s 7' Lt.
F.C. - M62 (Sta. 10)	M7G4	I.B. Sta. 219+90 o/s 12' Lt.

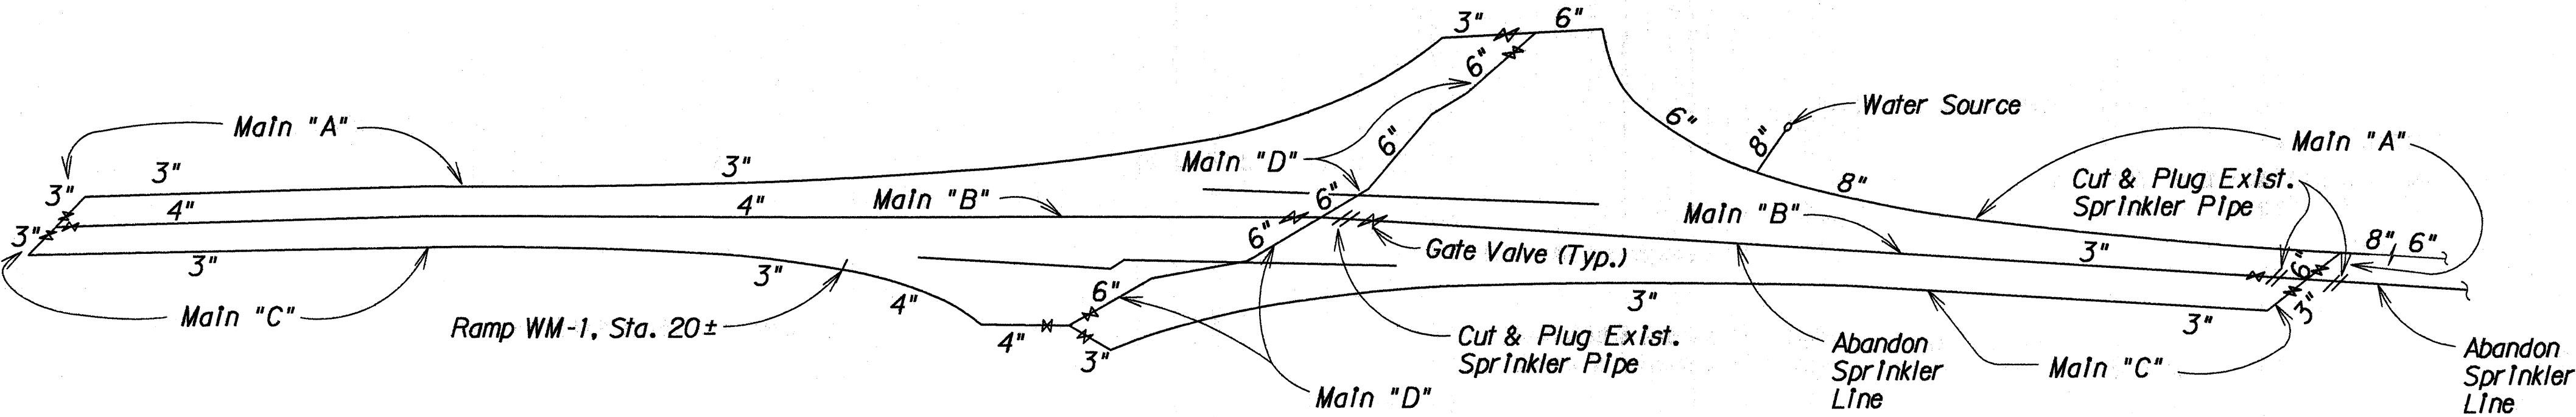

ISOMETRIC DISTRIBUTION SYSTEM
MILILANI INTERCHANGE
Not to Scale

STATE OF HAWAII
DEPARTMENT OF TRANSPORTATION
HIGHWAYS DIVISION


DRAINAGE PLAN

INTERSTATE RTE. H-2, HOV LANES, PH. II
Mililani Interchange to Waipio Interchange
F.A.I. PROJECT NO. IR-H2-1(27)


Scale: 1" = 40' Date: Apr., 1992

SHEET No. H41 OF 42 SHEETS

FED. ROAD DIST. NO.	STATE	FED. AID PROJ. NO.	FISCAL YEAR	SHEET NO.	TOTAL SHEETS
HAWAII	HAW.	IR-H2-1(27)	1992	133	230

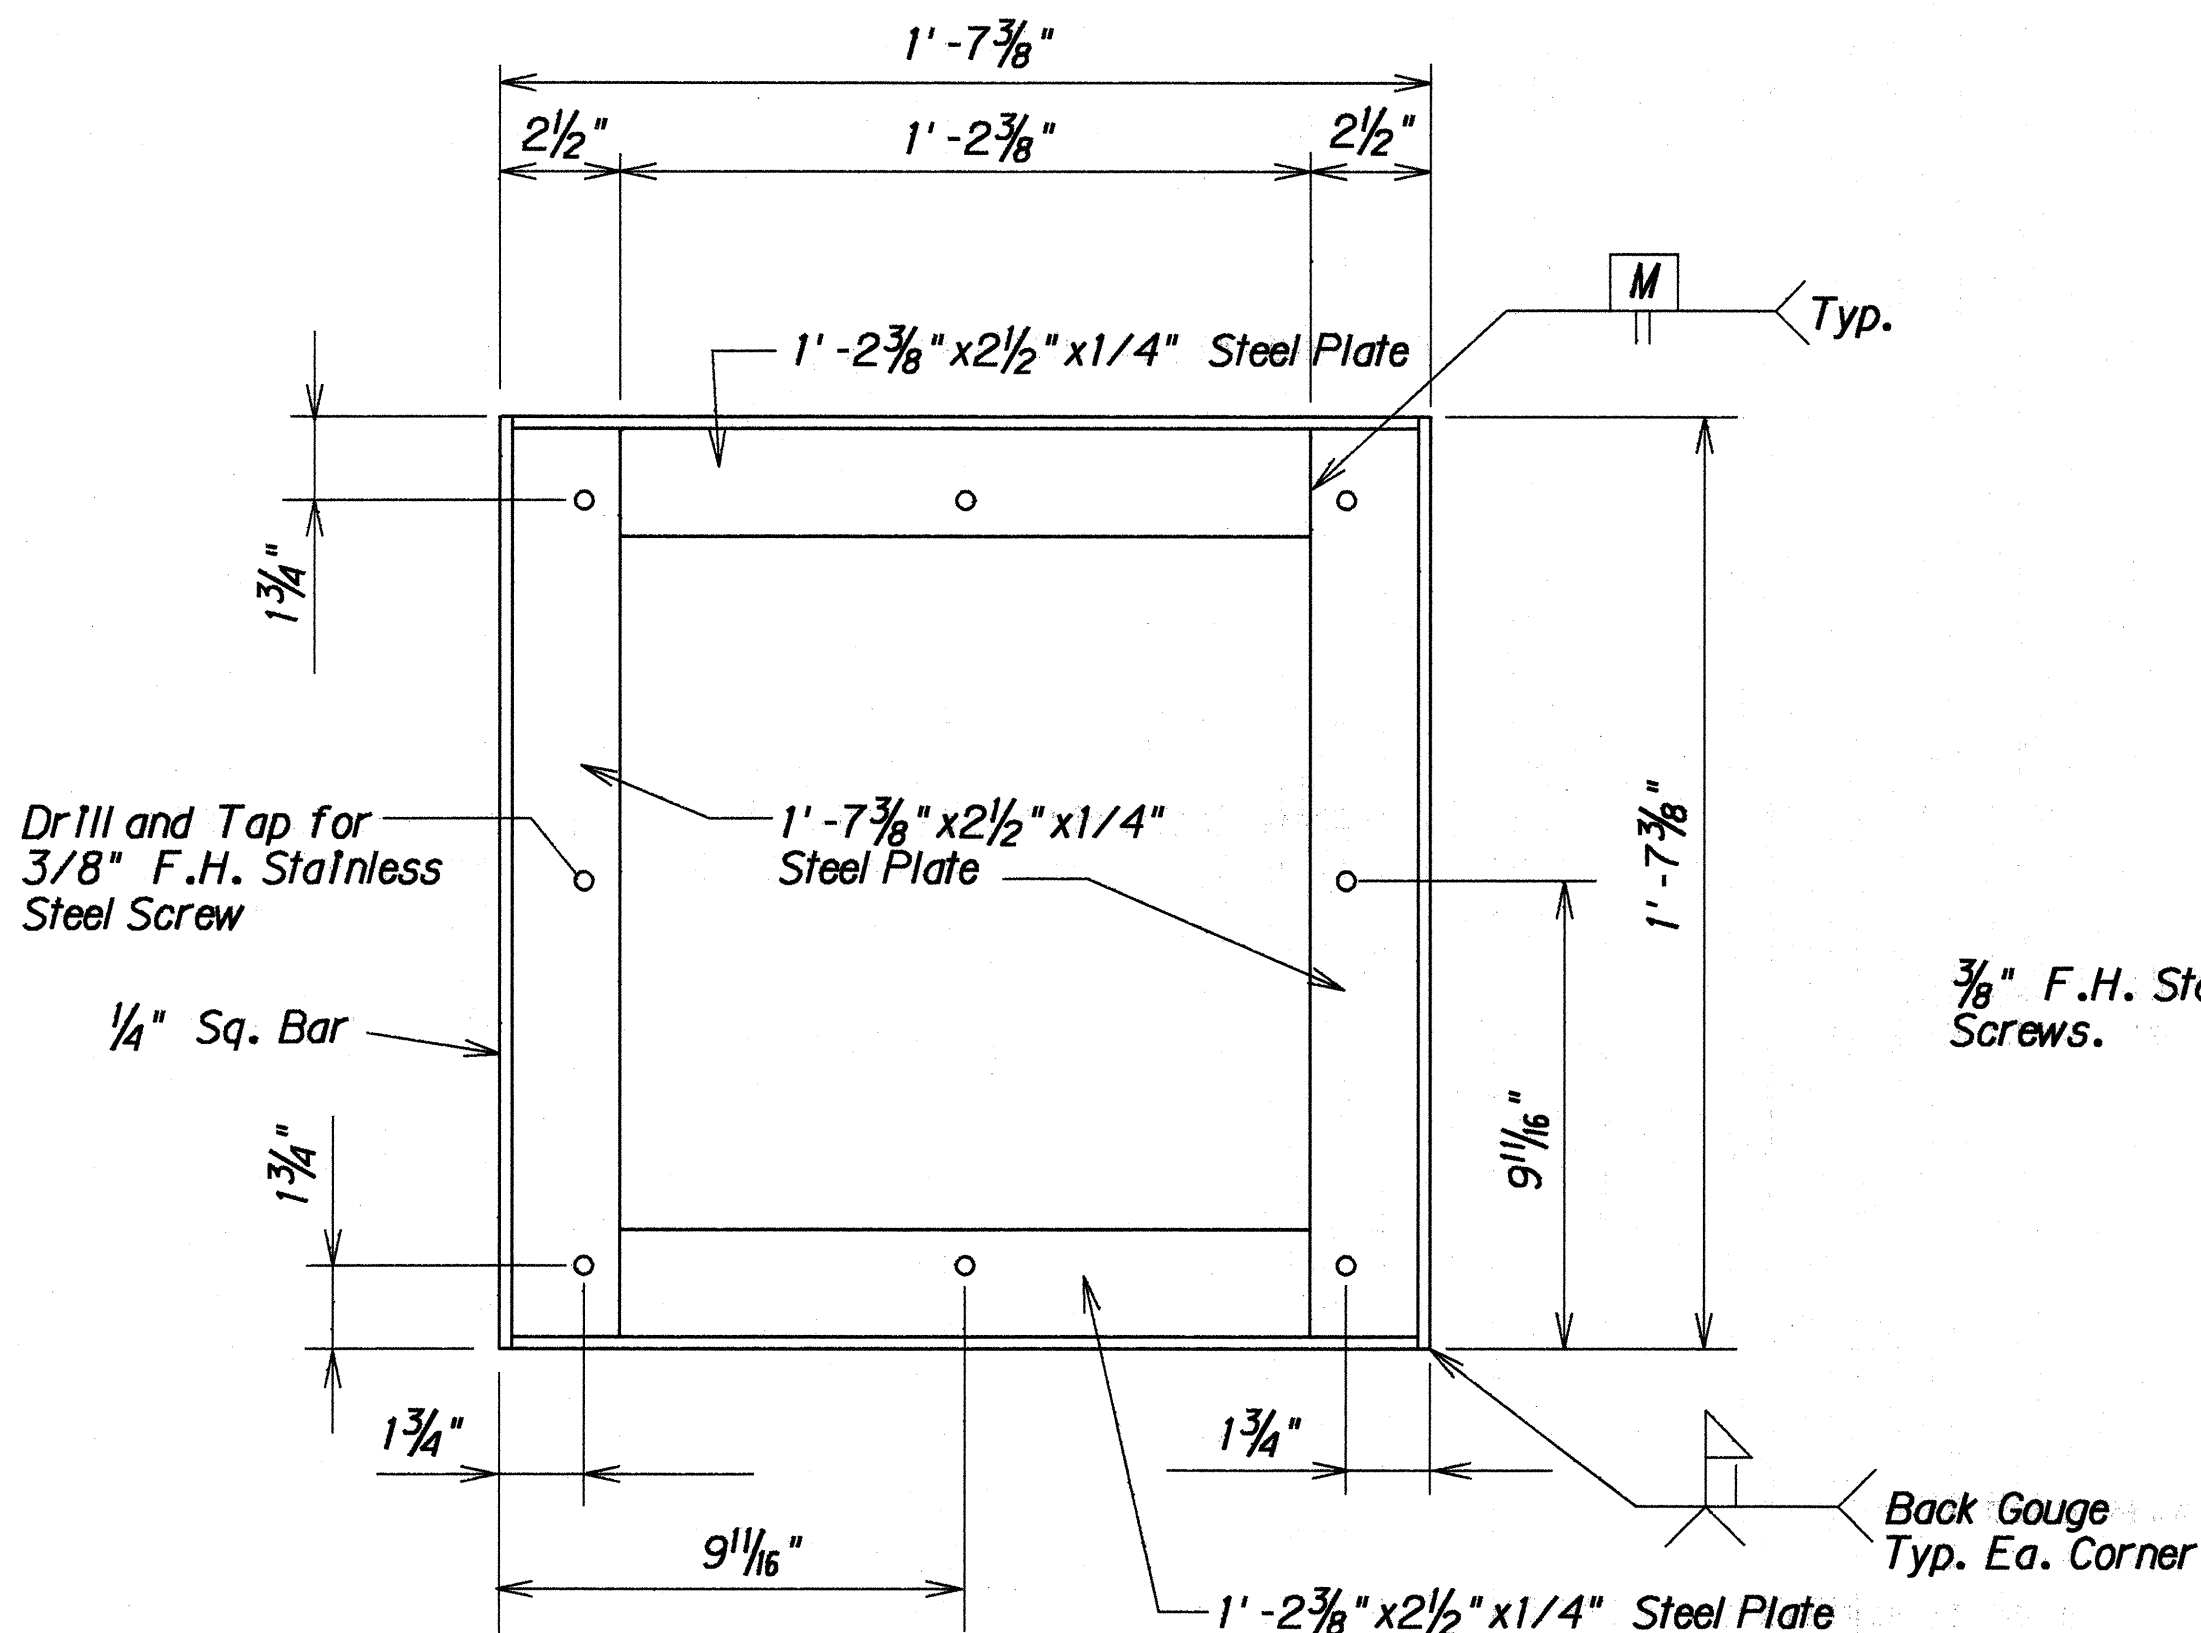


PLAN VIEW OF FRAME

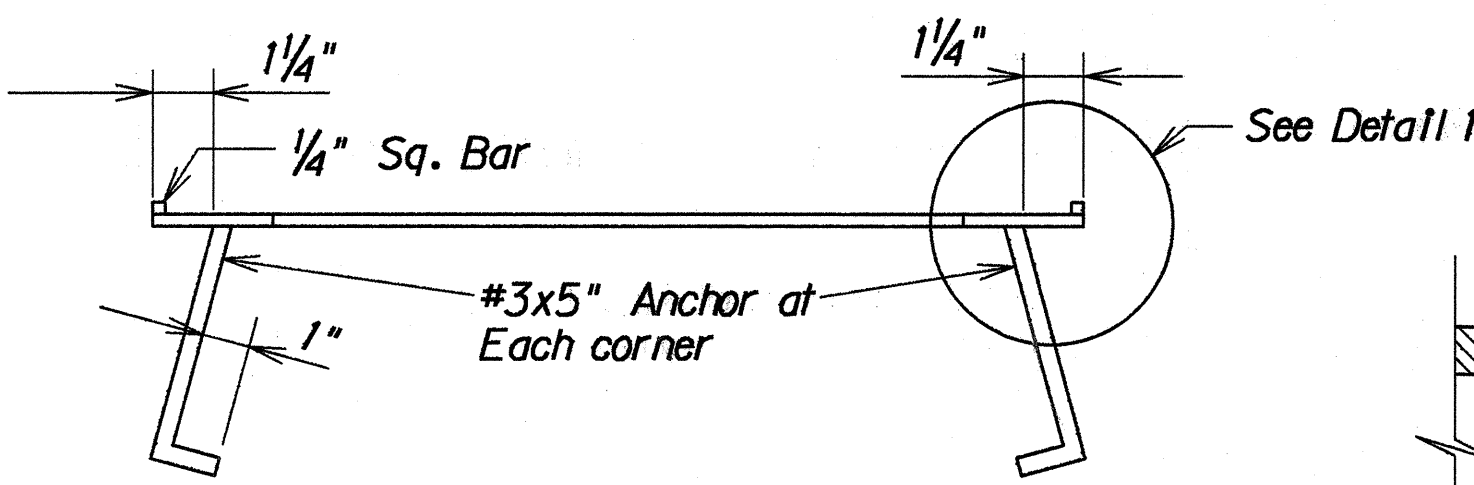


SECTION VIEW OF FRAME

DETAIL OF STEEL FRAME

NOTE:
All steel parts shall be galvanized
in accordance with the requirements
of ASTM A123.

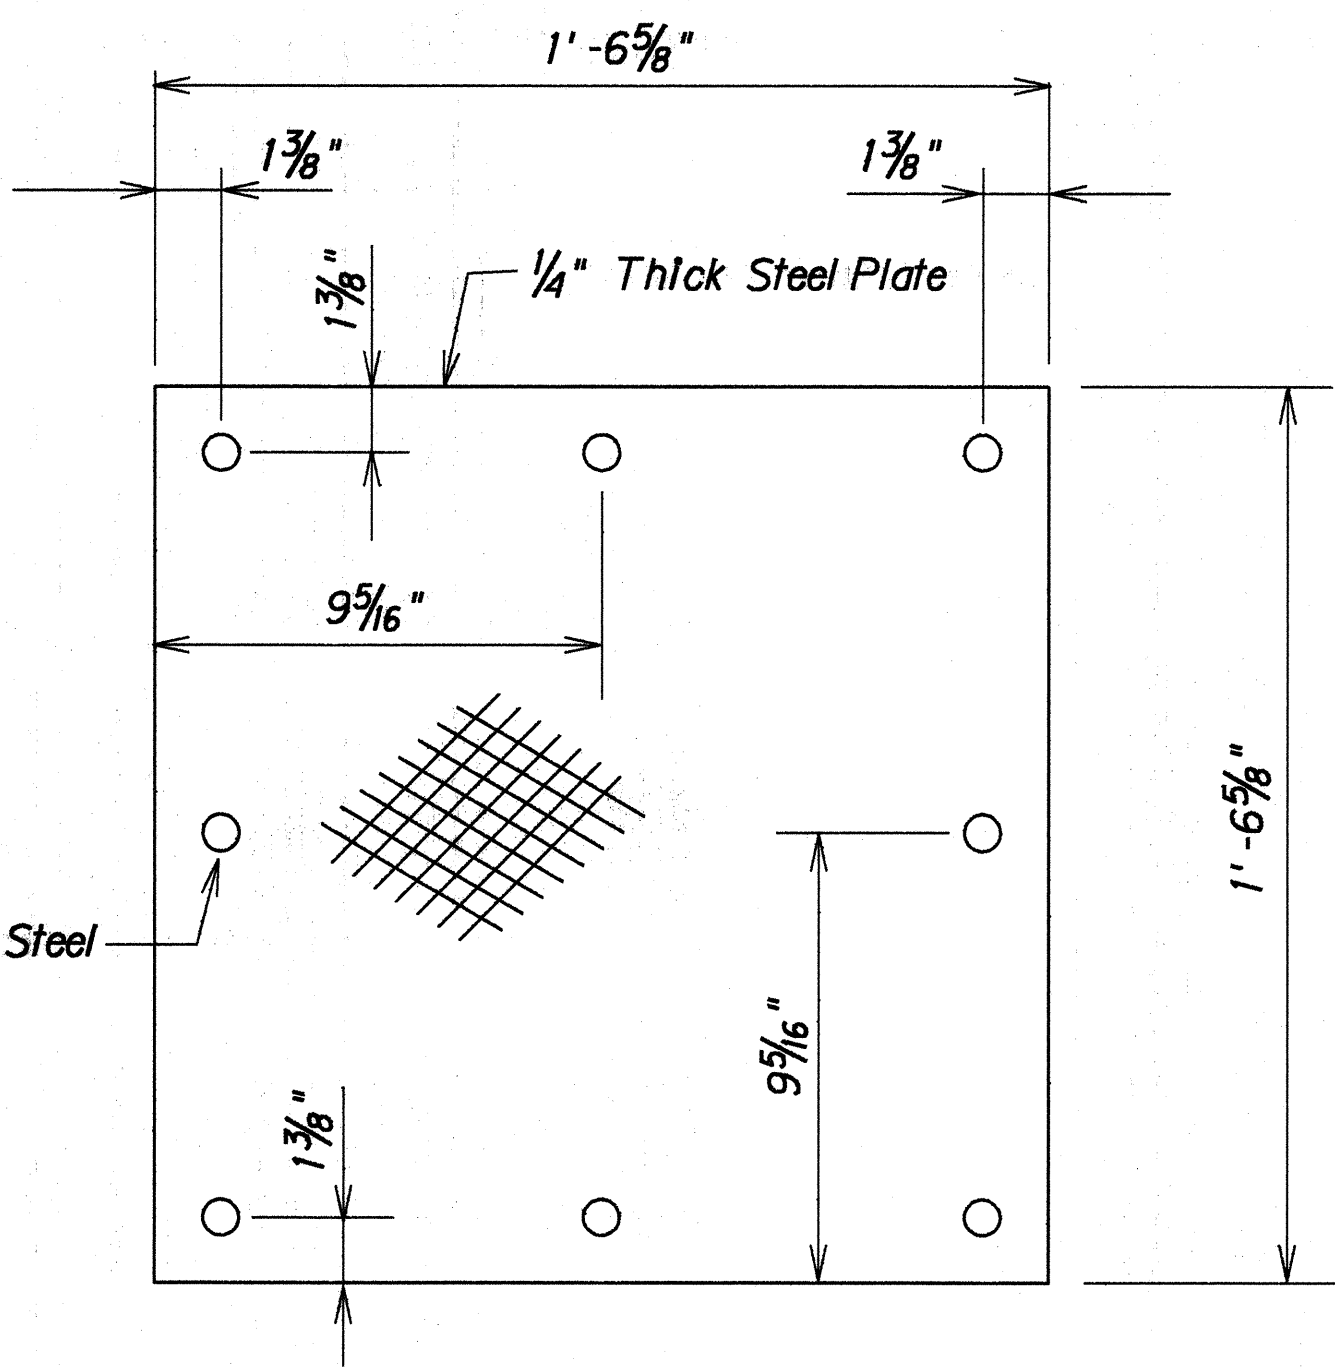

DETAIL OF STEEL COVER

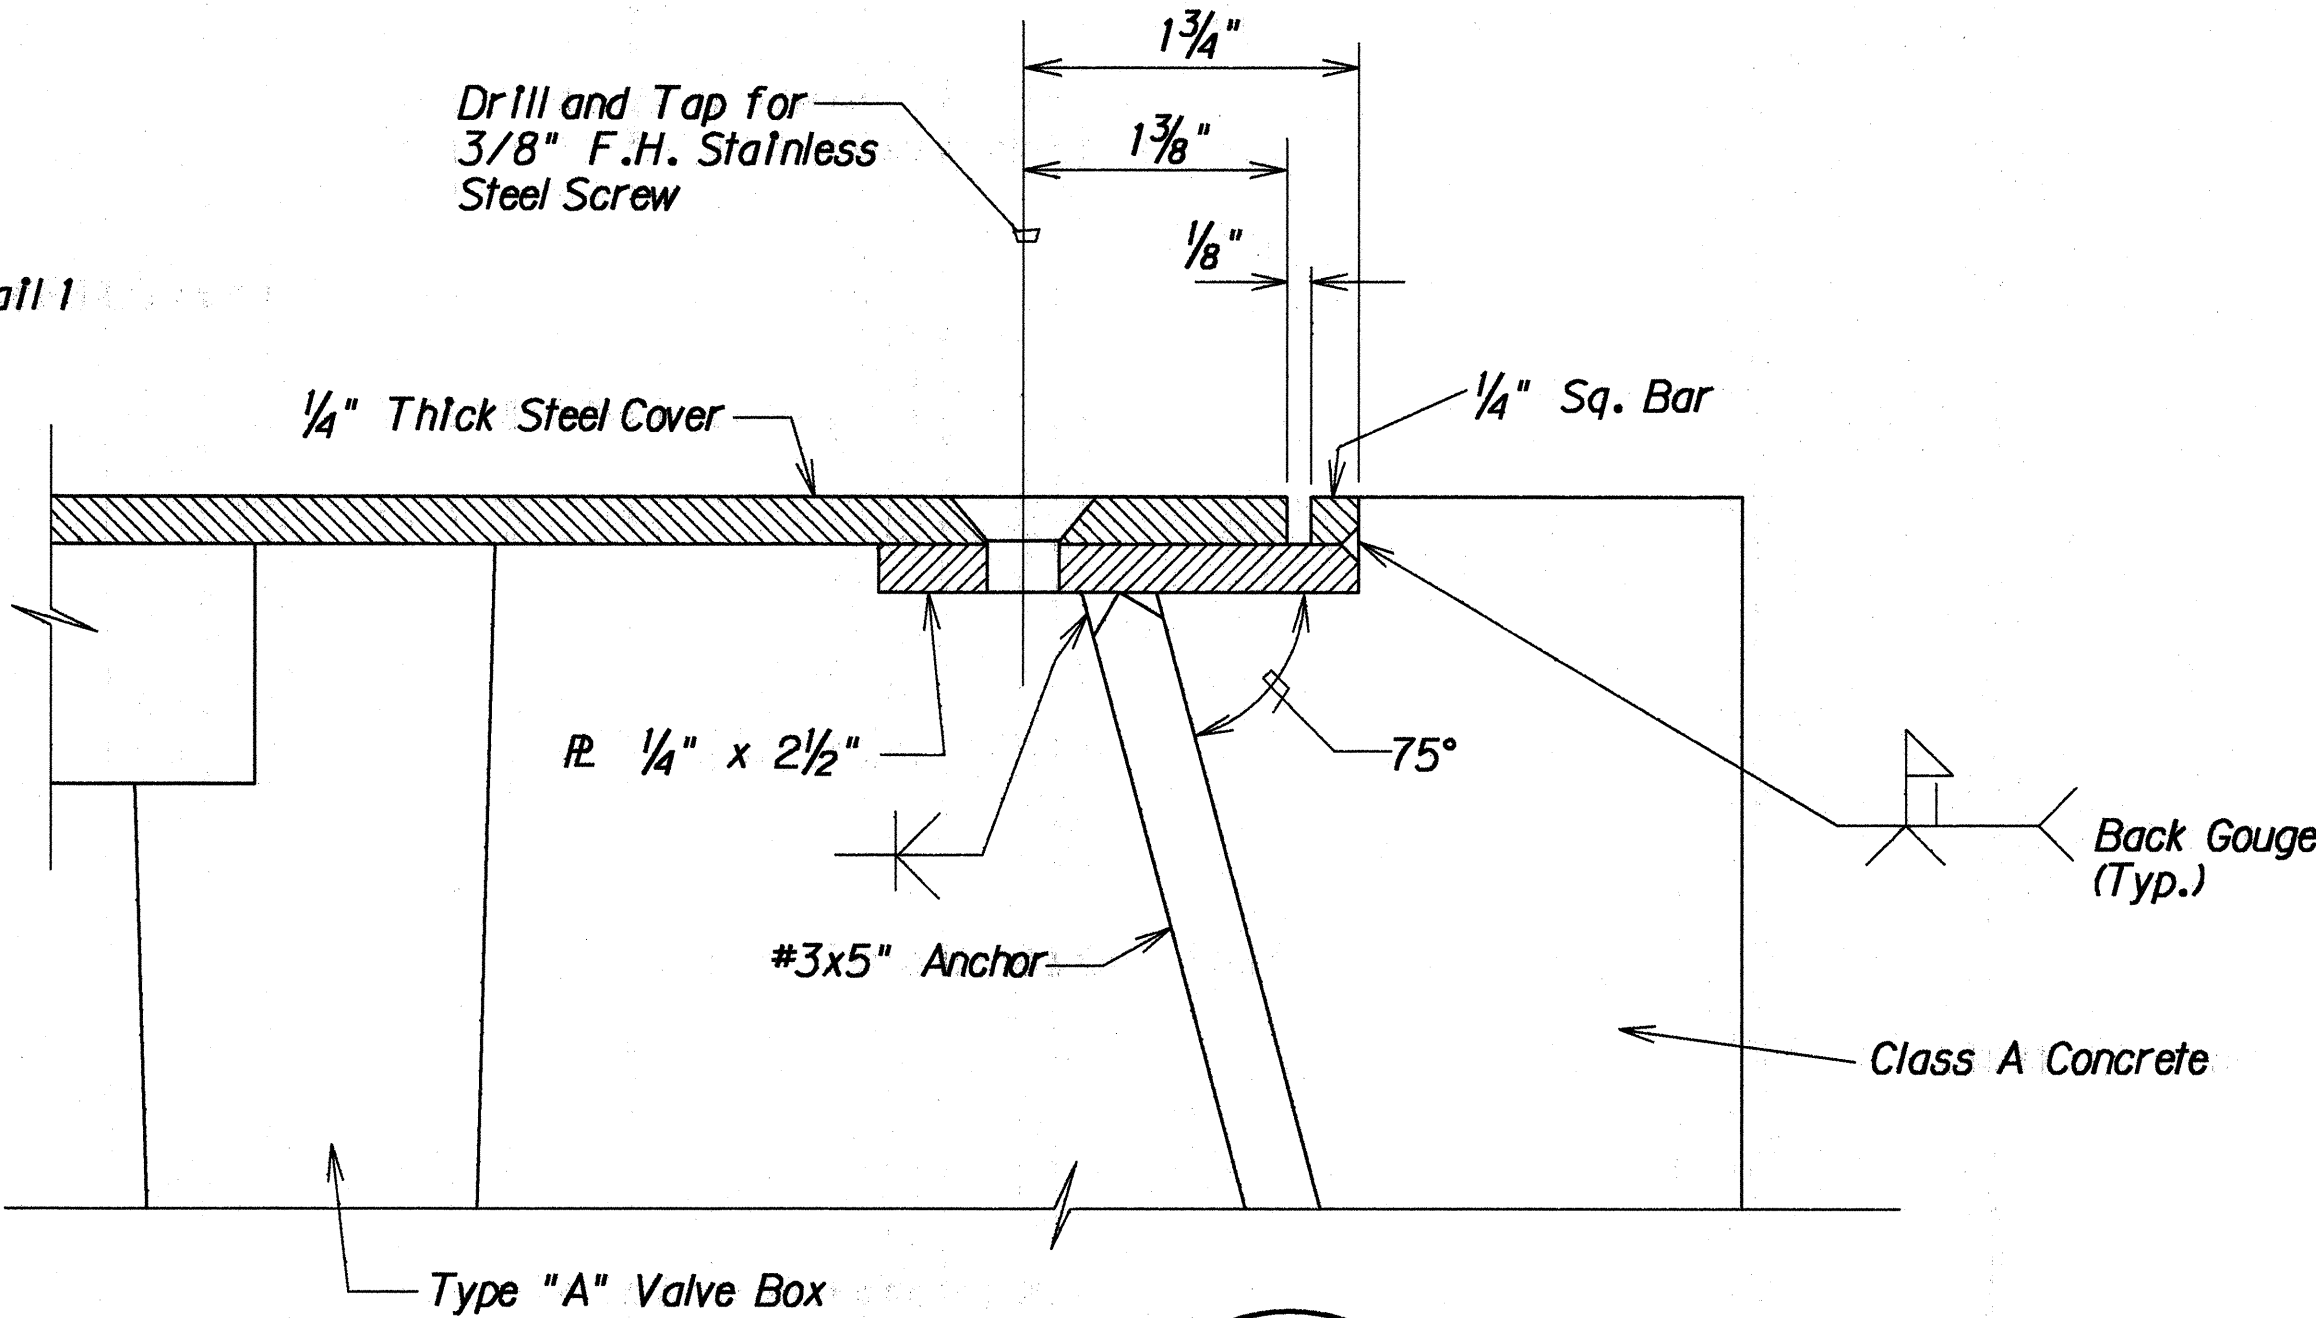


DETAIL 1
Full Size


STEEL FRAME AND COVER FOR TYPE "A" VALVE BOX

DETAIL OF VALVE BOX WITH STEEL FRAME & COVER AT STA. 191 + 40 ±

Scale: 3" = 1'-0"

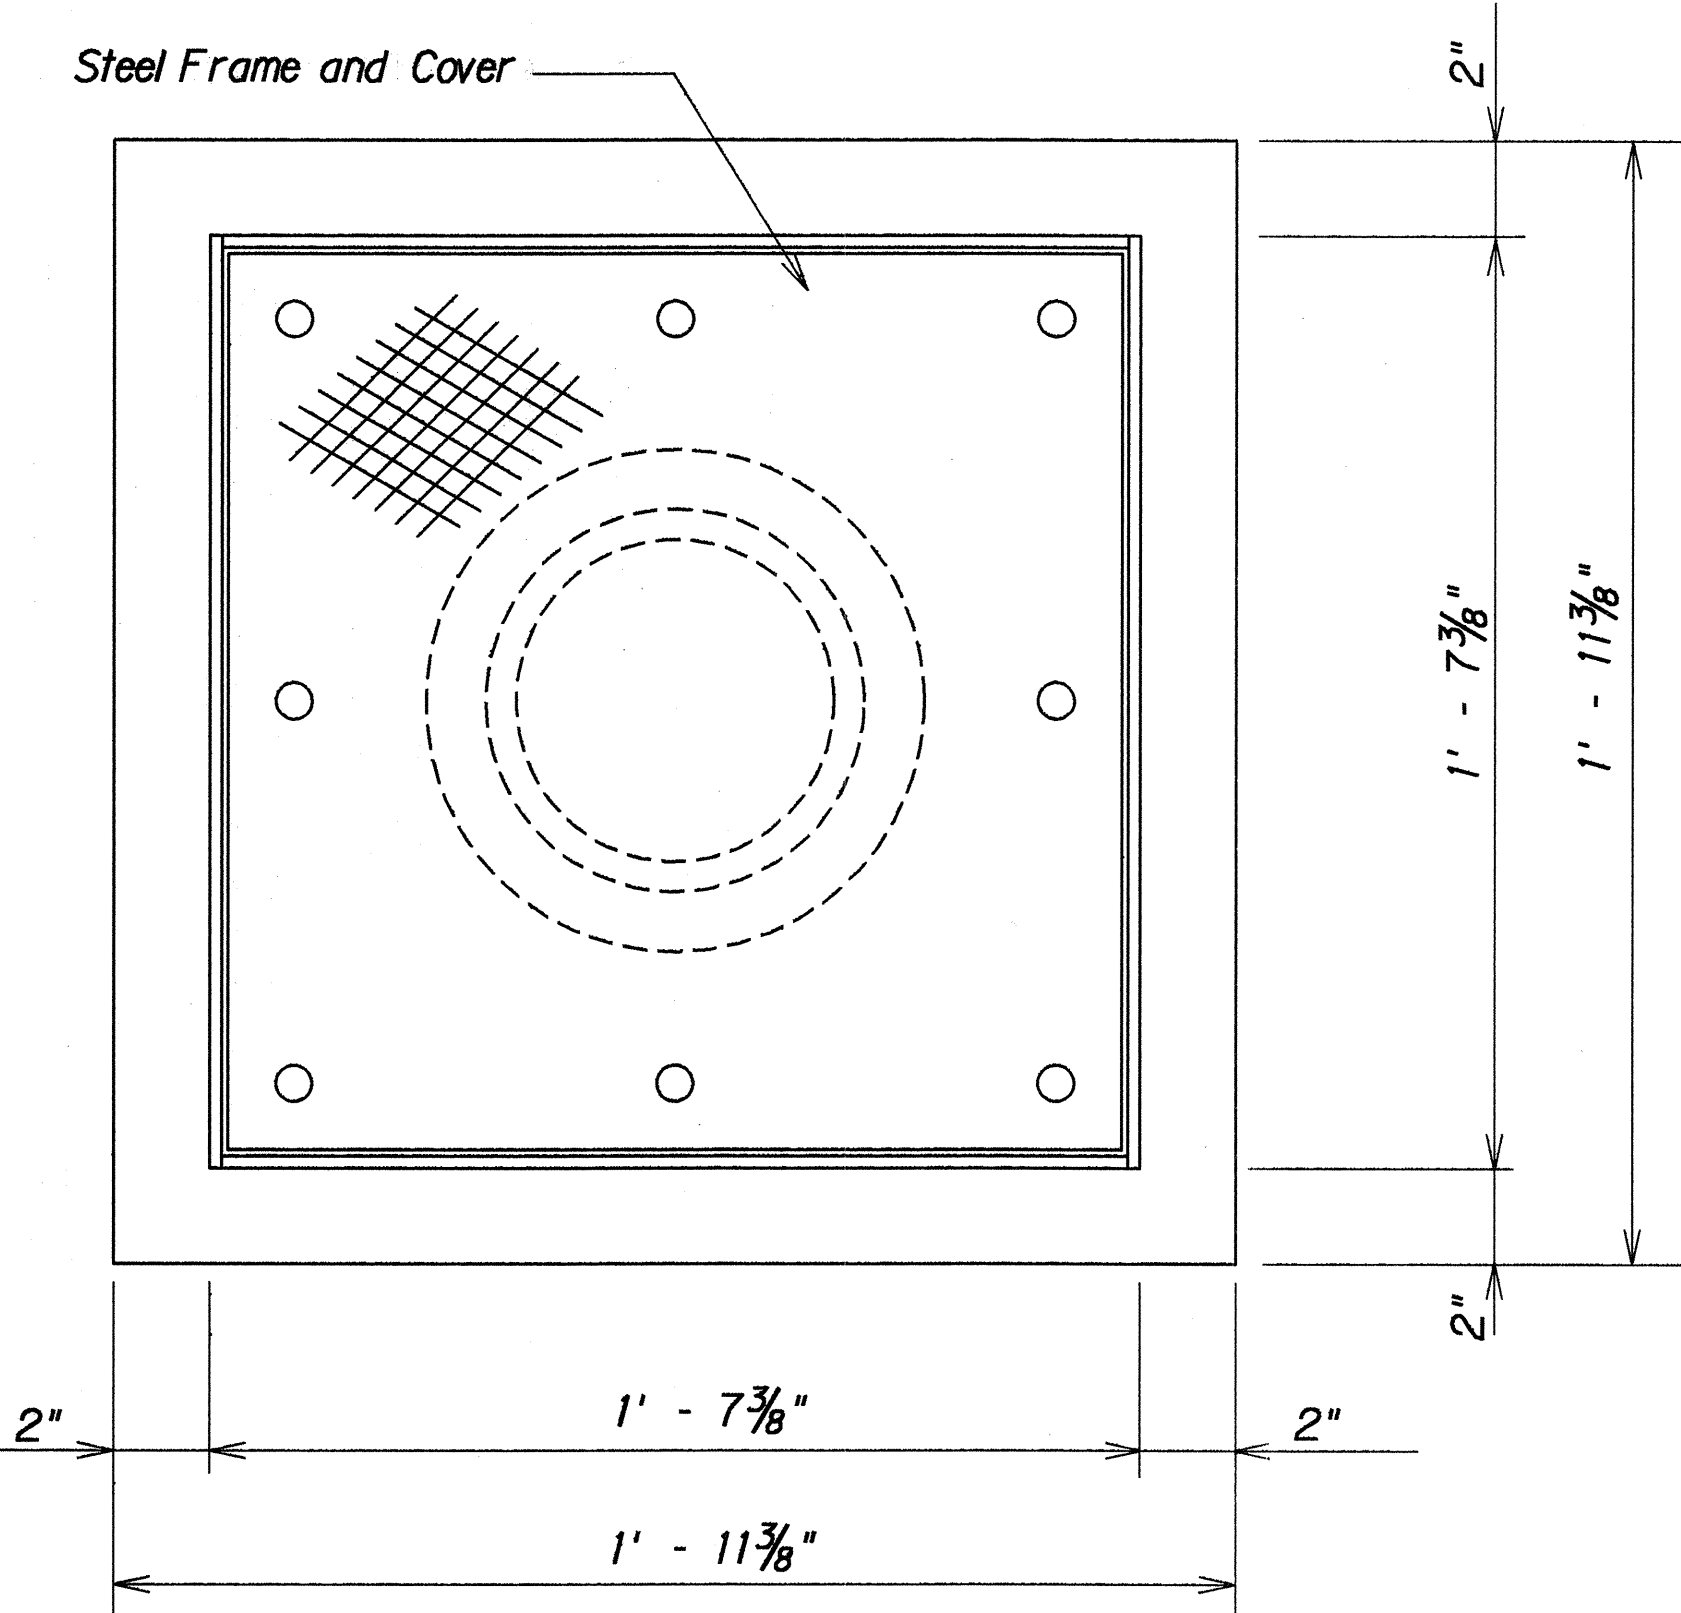

PLAN

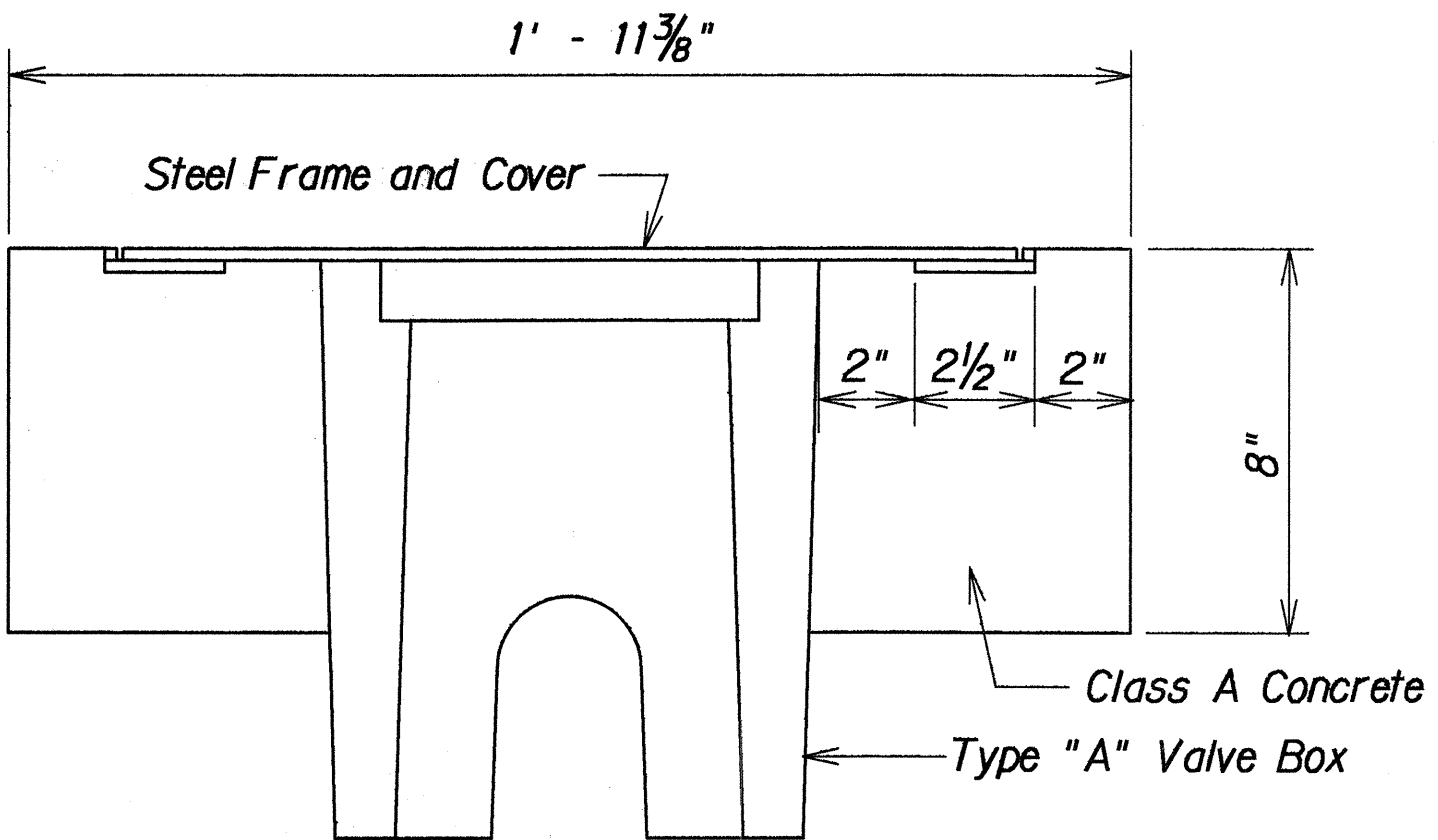

SECTION

STATE OF HAWAII
DEPARTMENT OF TRANSPORTATION
HIGHWAYS DIVISION


DRAINAGE DETAILS
INTERSTATE RTE. H-2, HOV LANES, PH. II
Miliiani Interchange to Waipio Interchange
F.A.I. PROJECT NO. IR-H2-1(27)

Scale: As Noted
Date: Apr., 1992


SHEET No. H42 OF 42 SHEETS

ORIGINAL PLAN	DATE
DESIGNED BY	
NOTED BY	
CHECKED BY	
IN CHARGE	


FED. ROAD DIST. NO.	STATE	FED. AID PROJ. NO.	FISCAL YEAR	SHEET NO.	TOTAL SHEETS
HAWAII	HAW.	IR-H2-1(27)	1995	133S-1	223

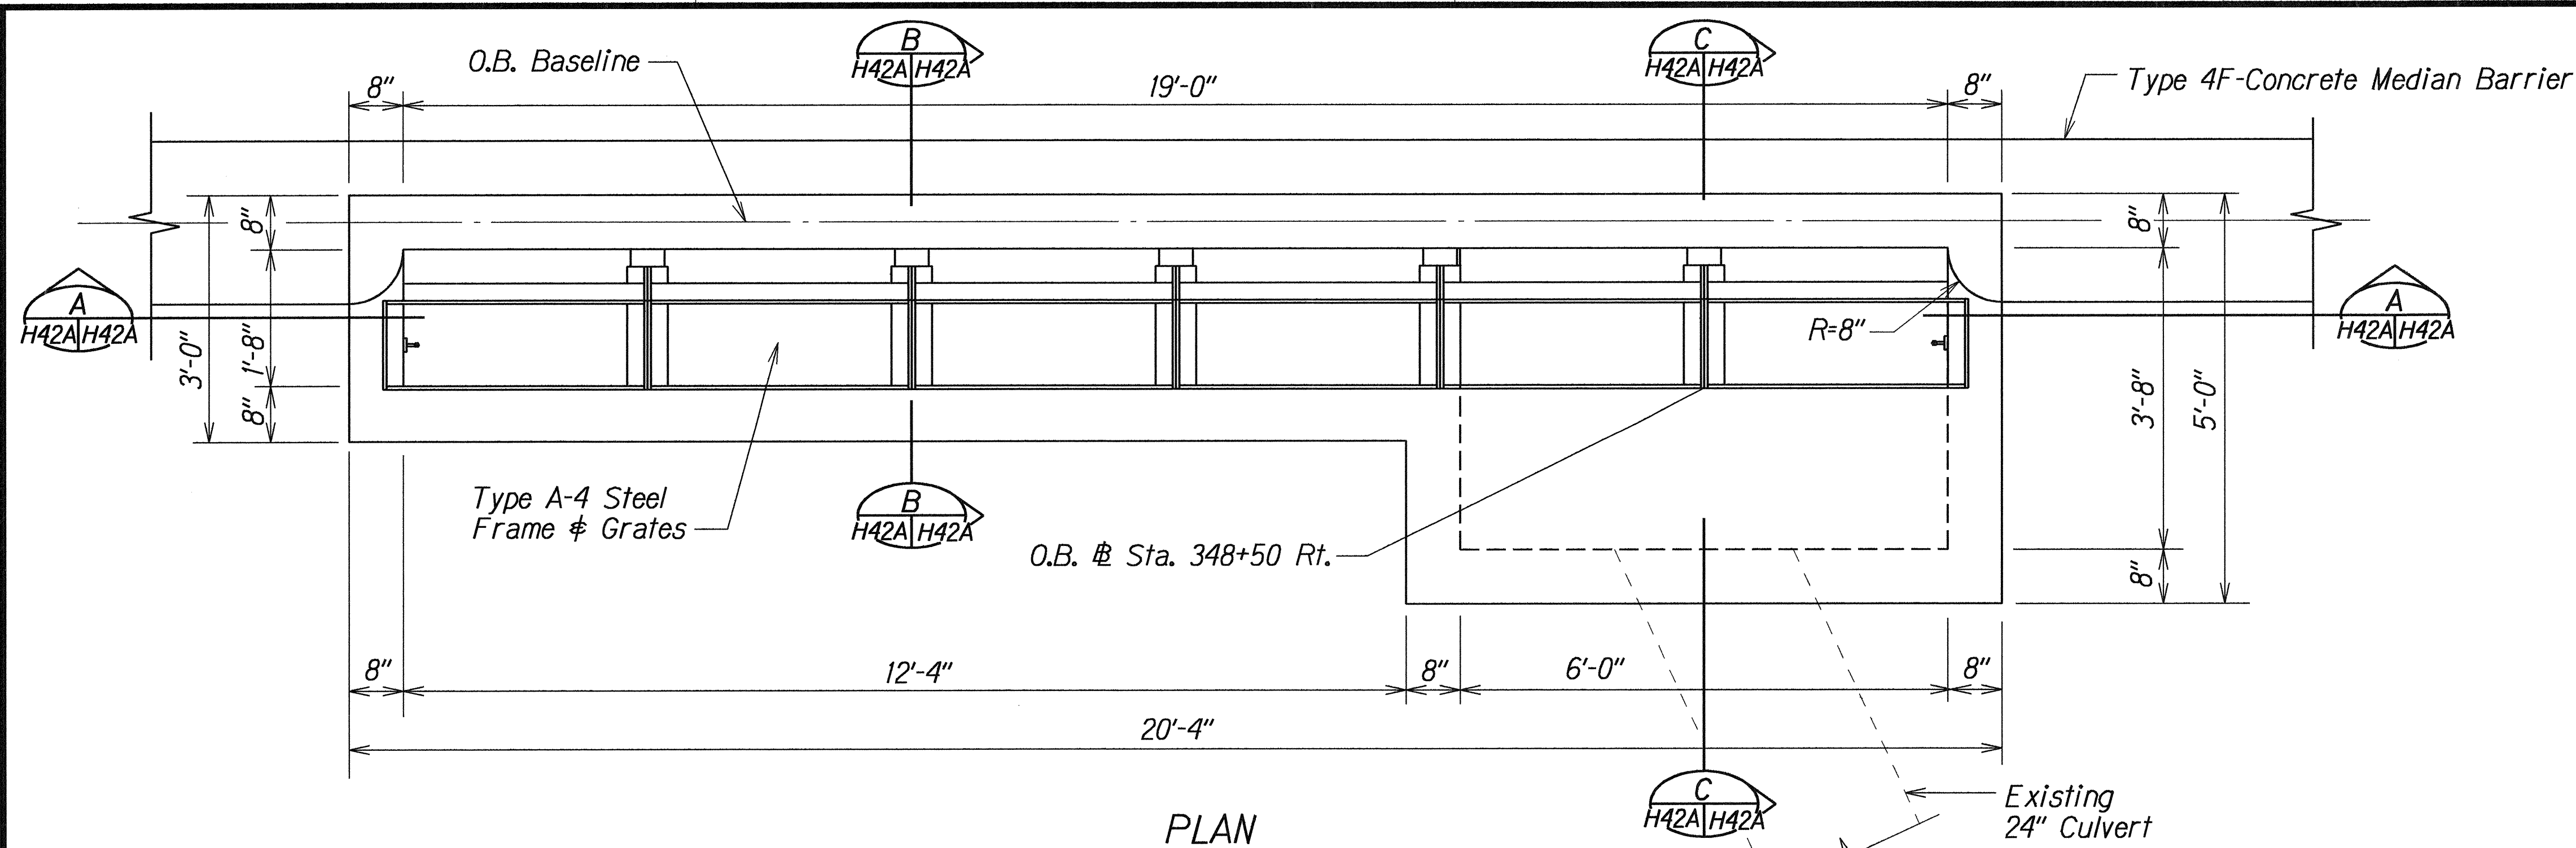


PLAN

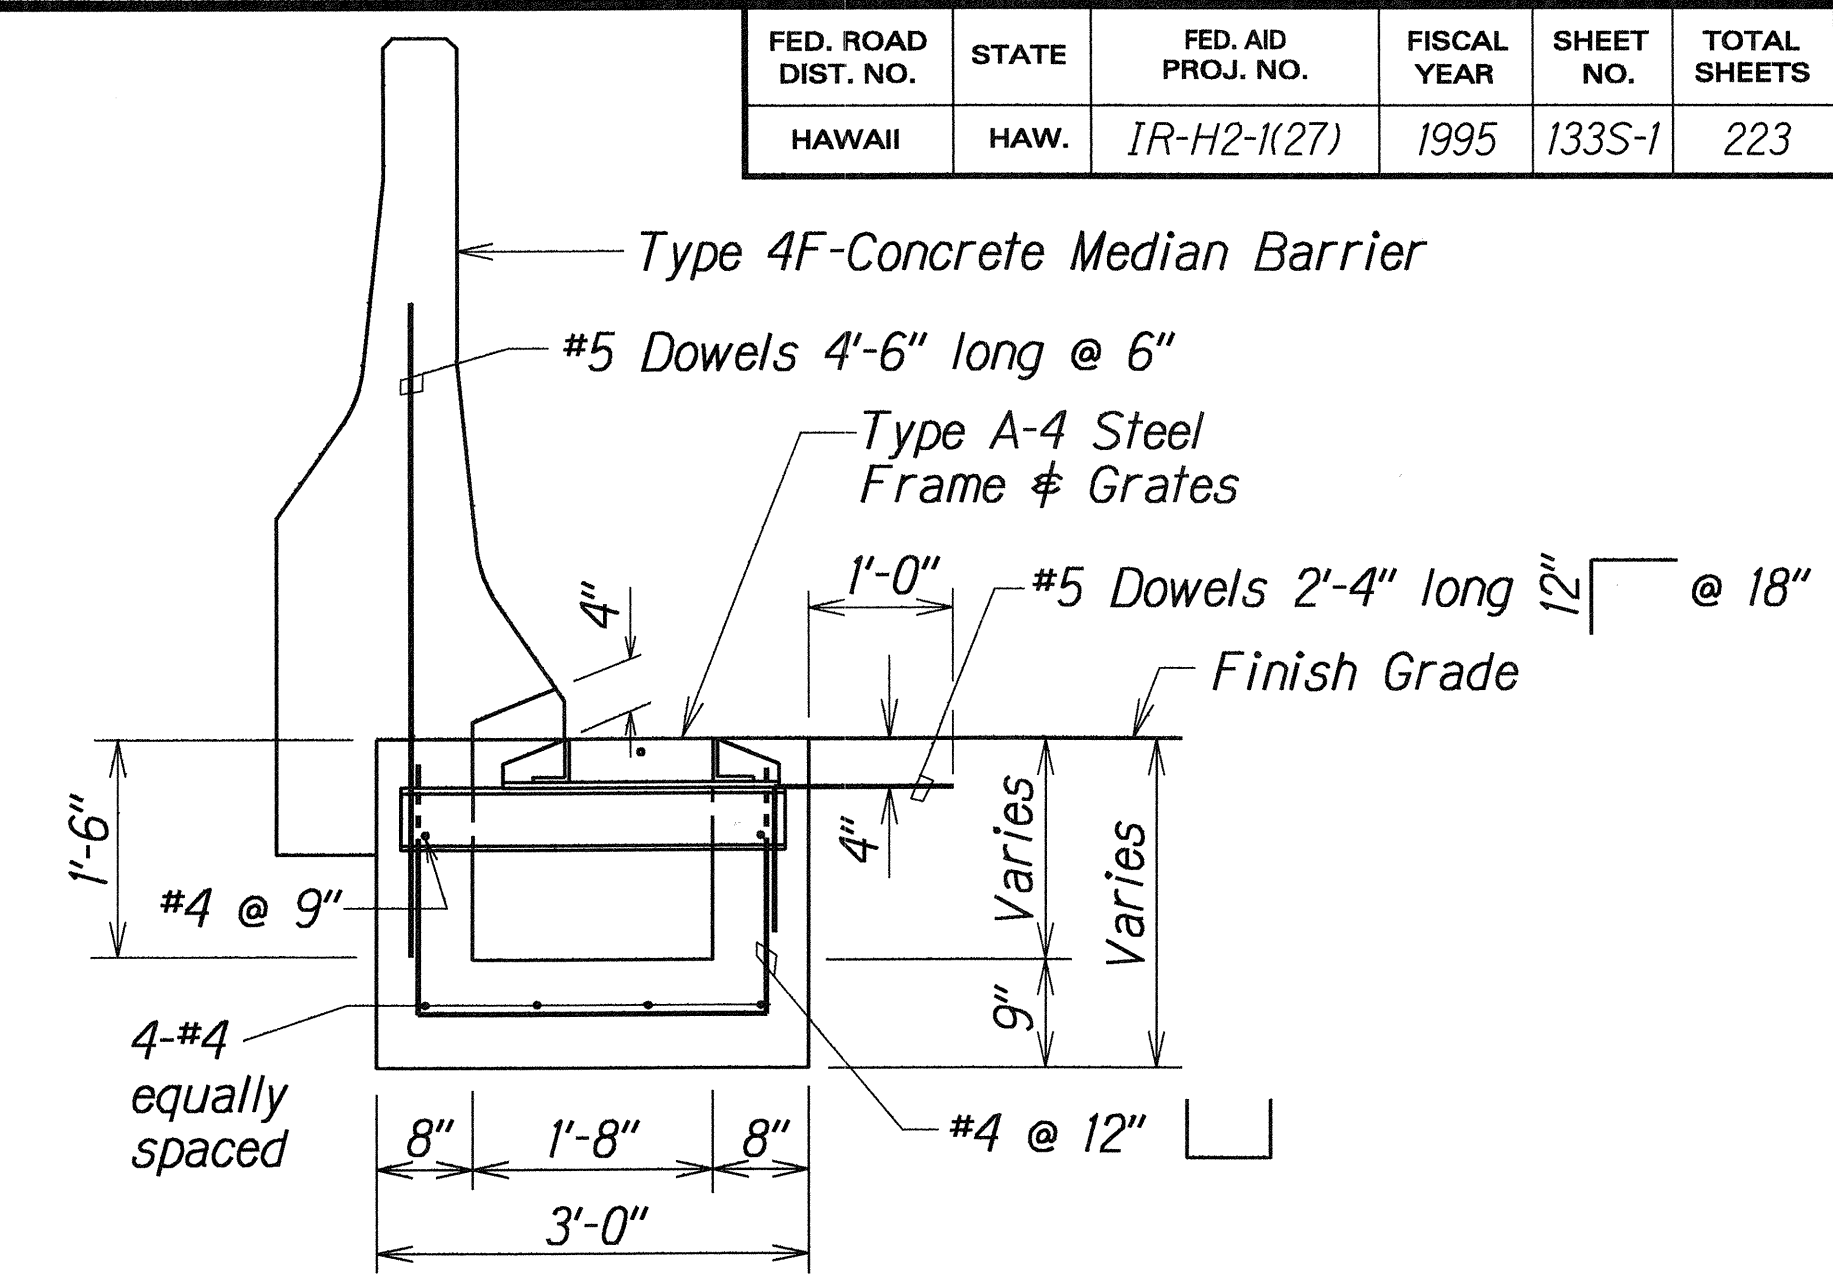

SECTION B
H42A/H42A

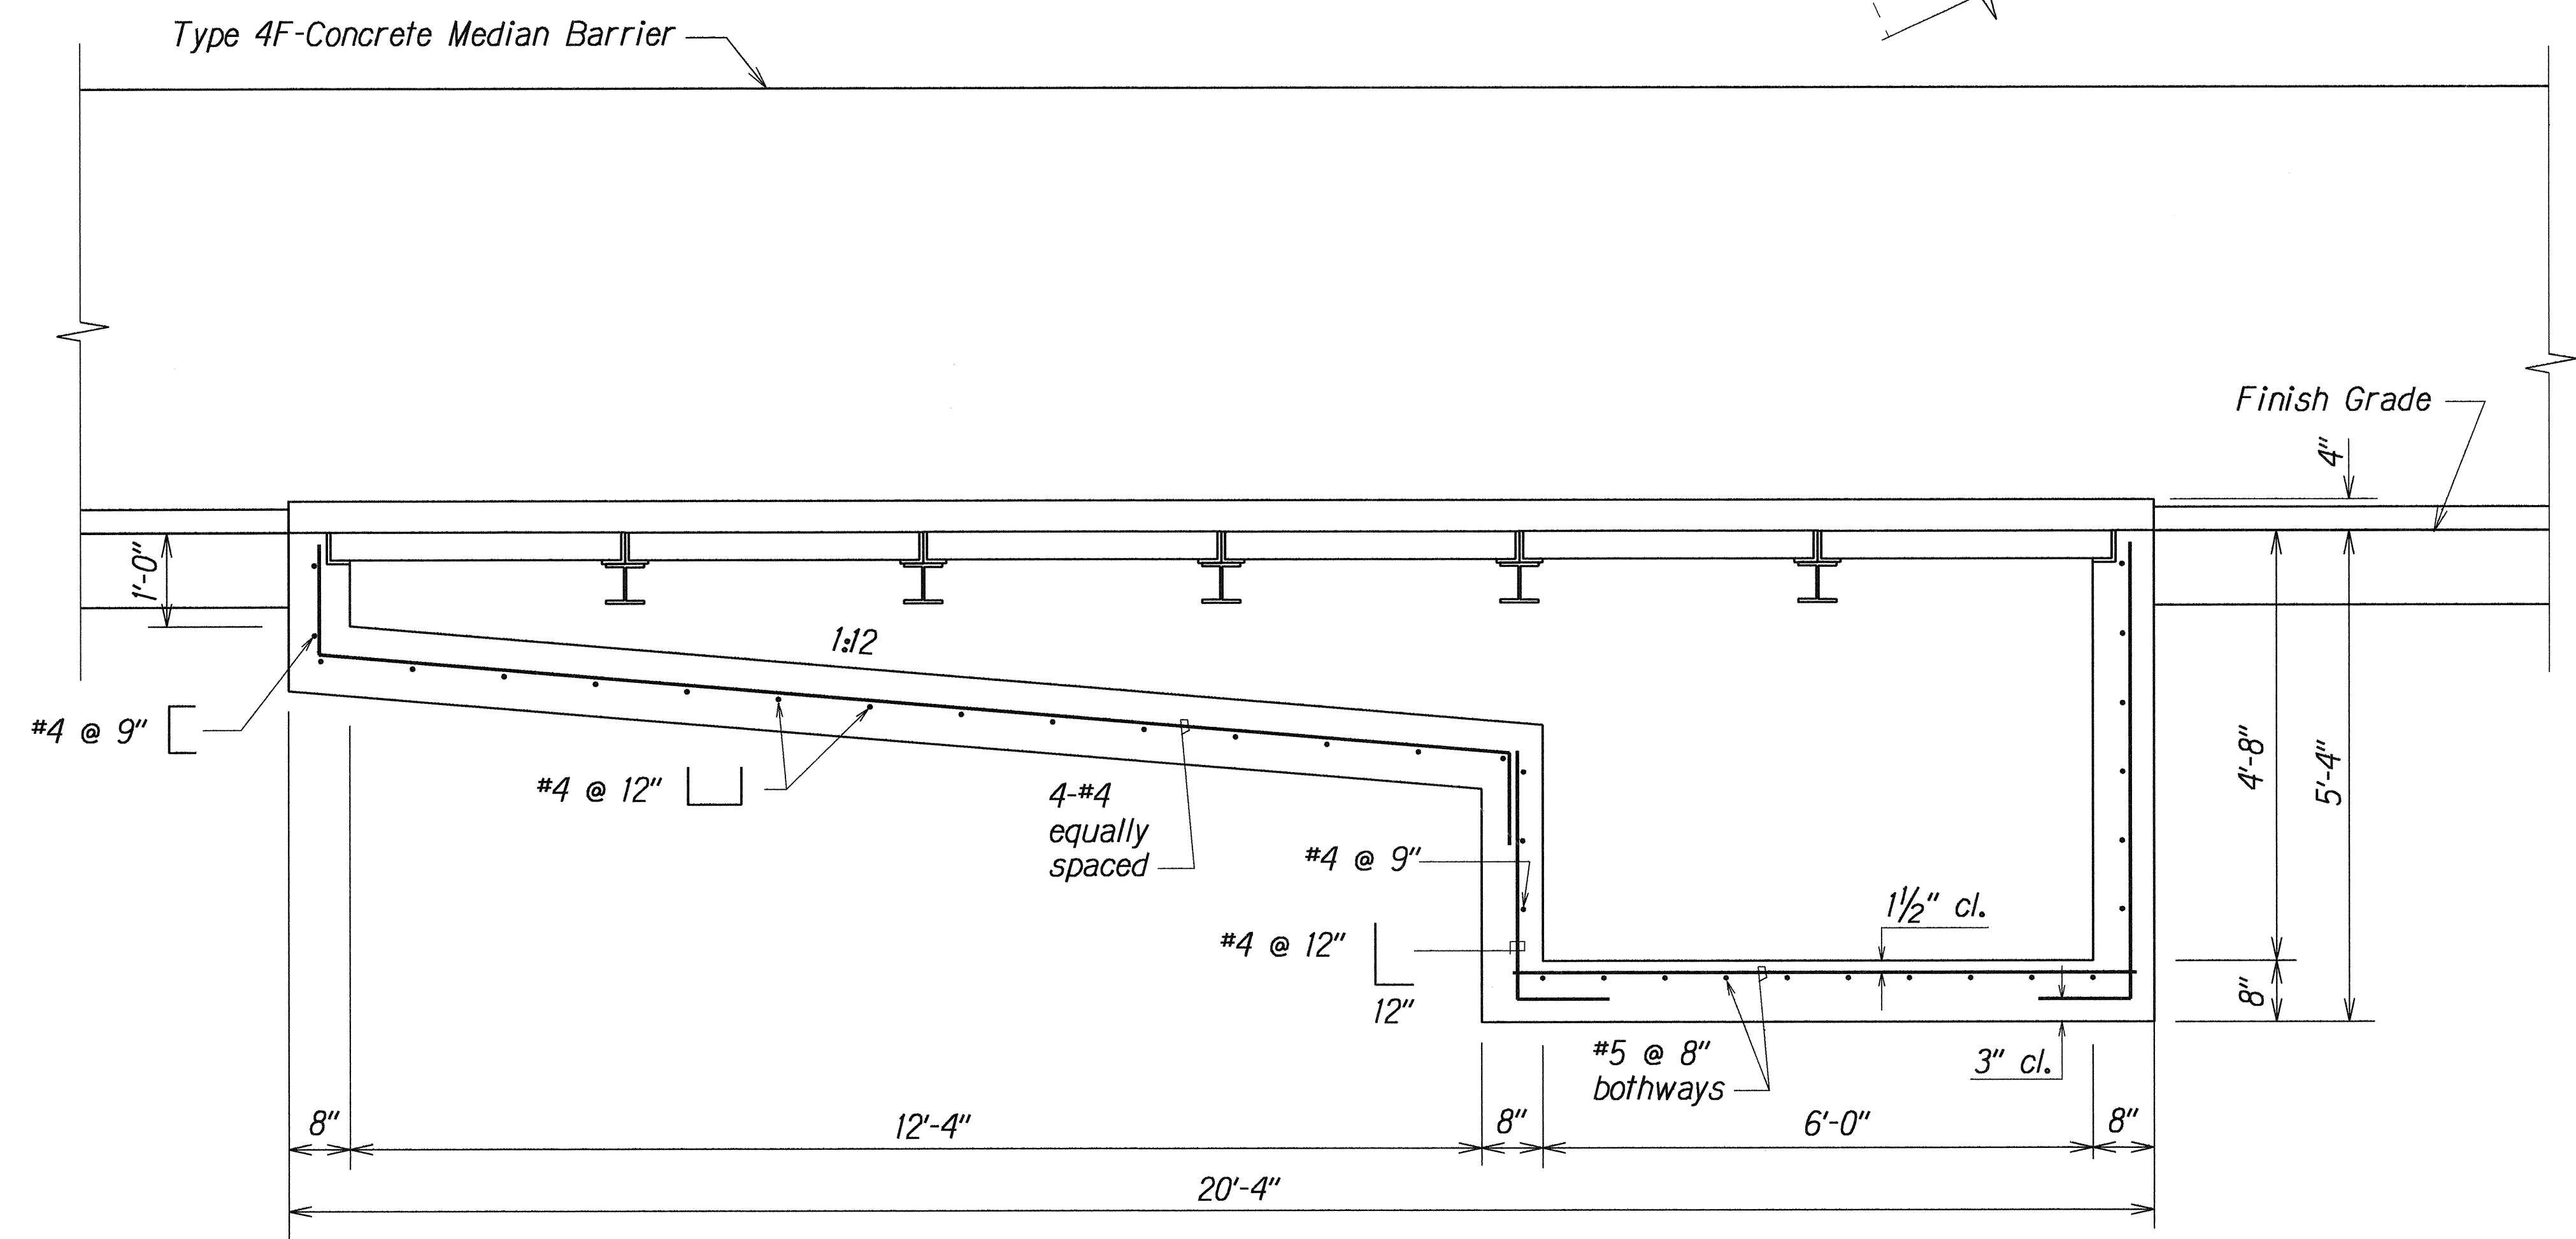

SECTION A
H42A/H42A

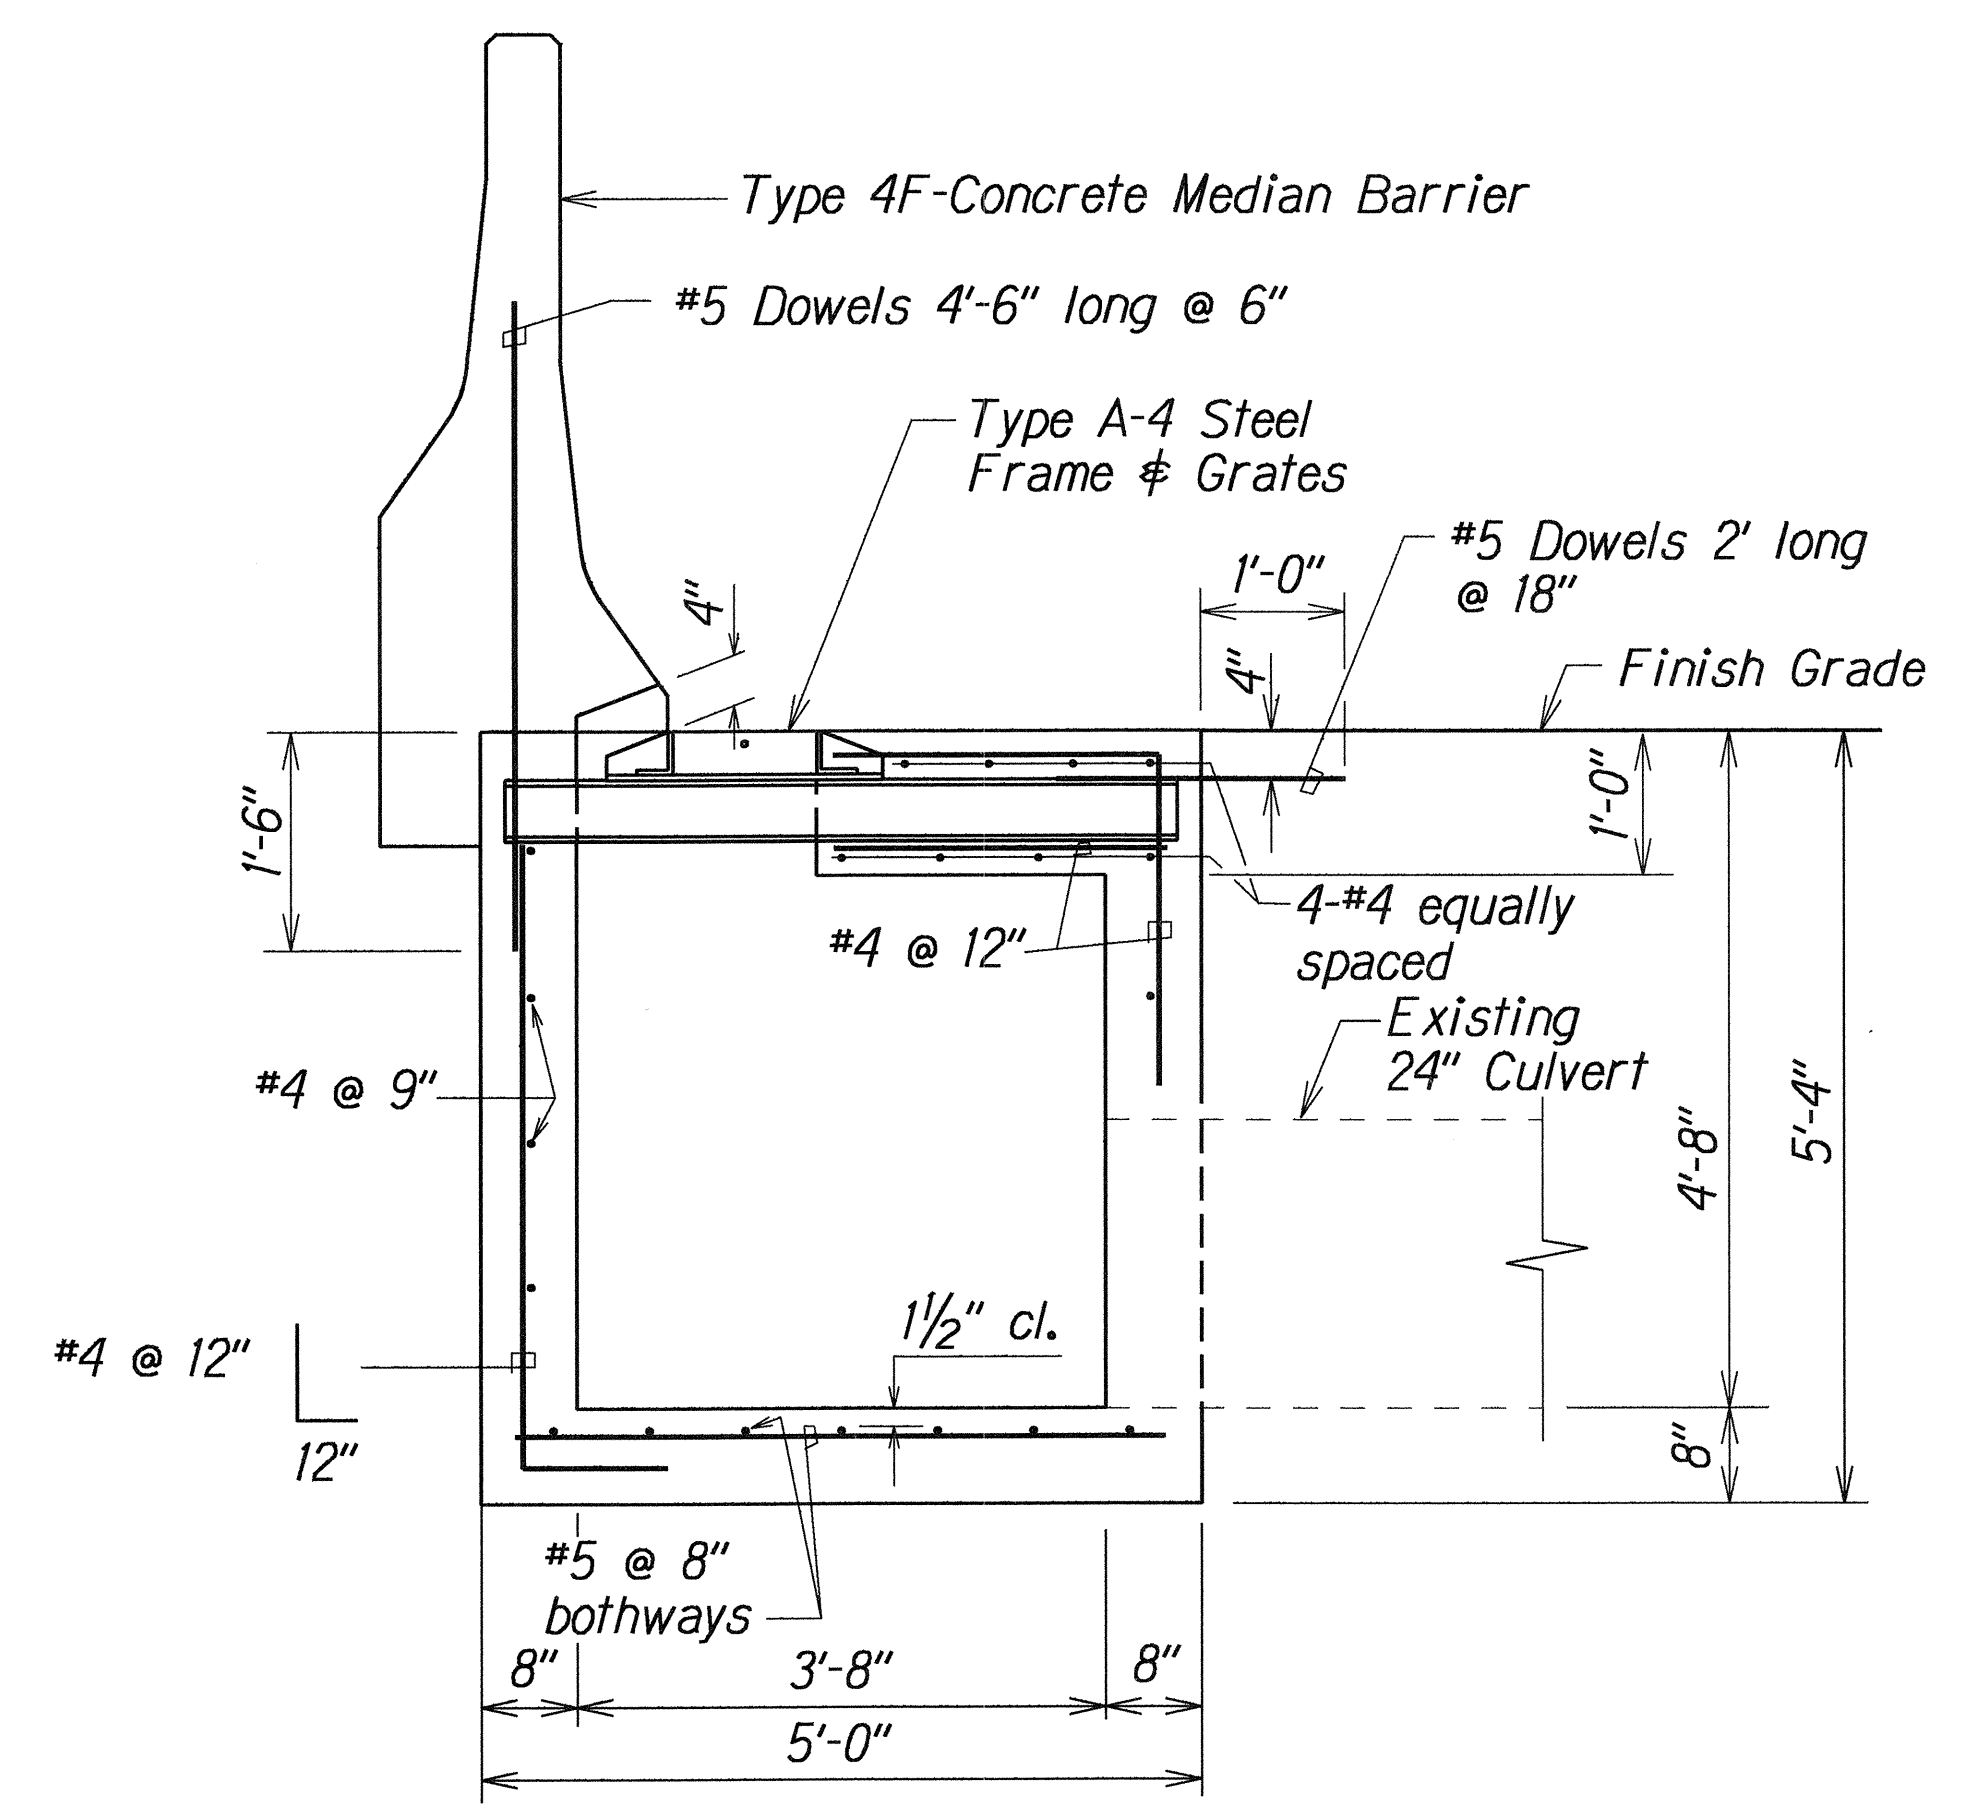

SECTION C
H42A/H42A

DETAILS OF TYPE 6 MEDIAN DROP INLET AT O.B. STA. 348+50 RT.

ORIGINAL PLAN	DATE	7/15/94
SURVEY PLOTTED BY		
DRAWN BY	L. Cockett, A. Namura	
TRACED BY		
CHECKED BY	Bob Sakamoto	
QUANTITIES BY		
DESIGNED BY		

7/22/94	Sheet added to Contract Plan to show Details of Type 6 MDI	Scale: 3/4" = 1'-0"	Date: Jul, 1994
DATE	REVISION	SHEET No. H42A OF 42 SHEETS	


STATE OF HAWAII
DEPARTMENT OF TRANSPORTATION
HIGHWAYS DIVISION

DRAINAGE DETAILS

INTERSTATE RTE. H-2, HOV LANES, PH II
Mililani Interchange to Waipio Interchange
F.A.I. PROJECT NO. IR-H2-1(27)


C.O. 133 S-1

FED. ROAD DIST. NO.	STATE	FED. AID PROJ. NO.	FISCAL YEAR	SHEET NO.	TOTAL SHEETS
HAWAII	HAW.	IR-H2-1(27)	1995	1335-2	223

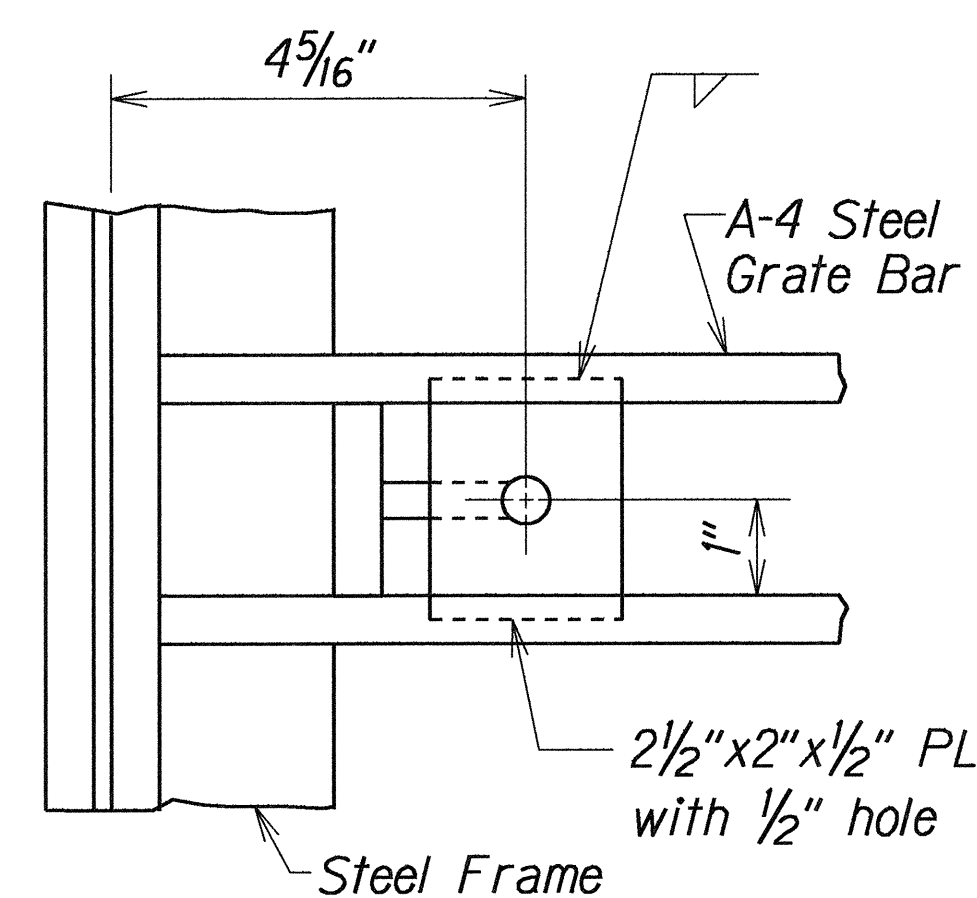


DETAIL OF PLATE FOR
ANGLE IRON CONNECTION

Half Size

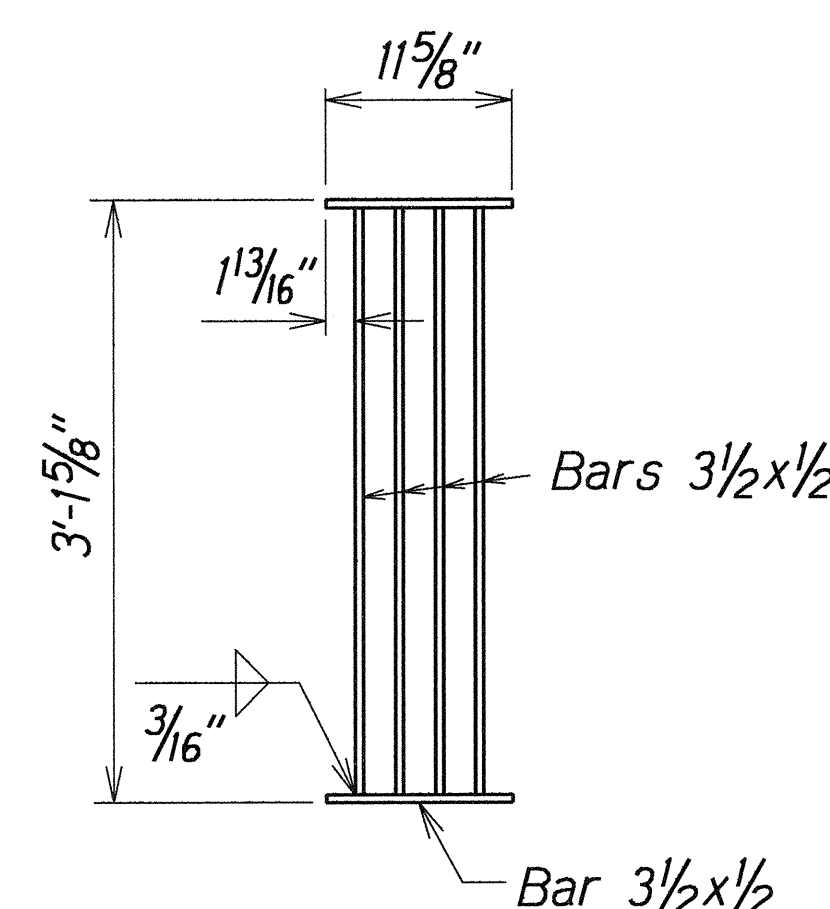


PLAN

Scale: 1"=1'-0"

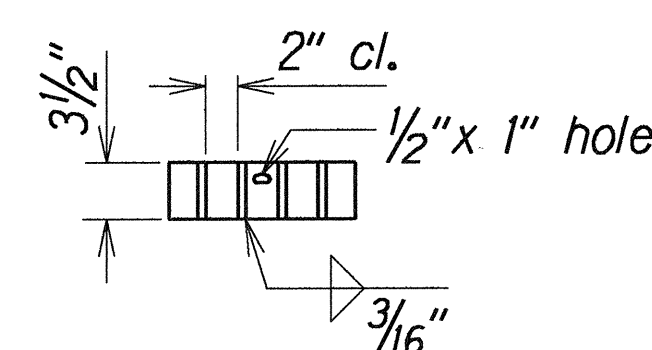


SECTION

Scale: 1"=1'-0"

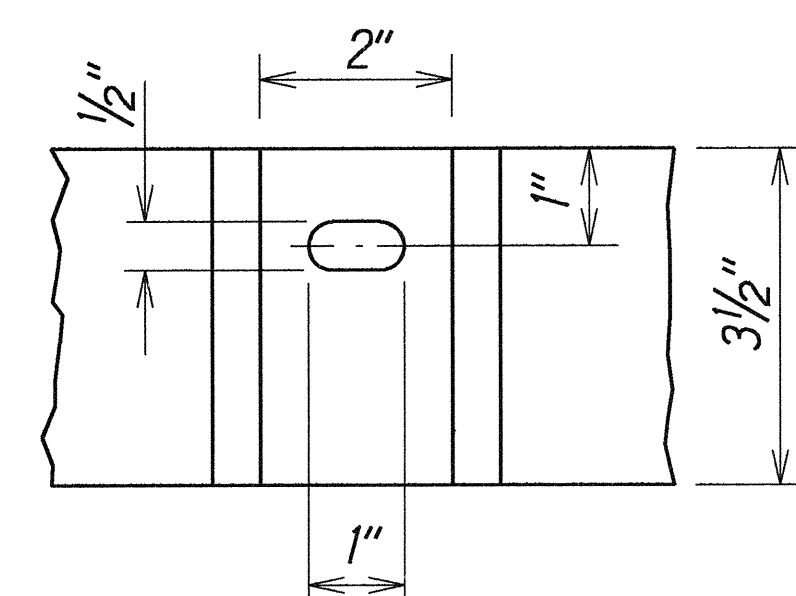


DETAIL OF HOLE LOCATION
IN GRATE

Half Size

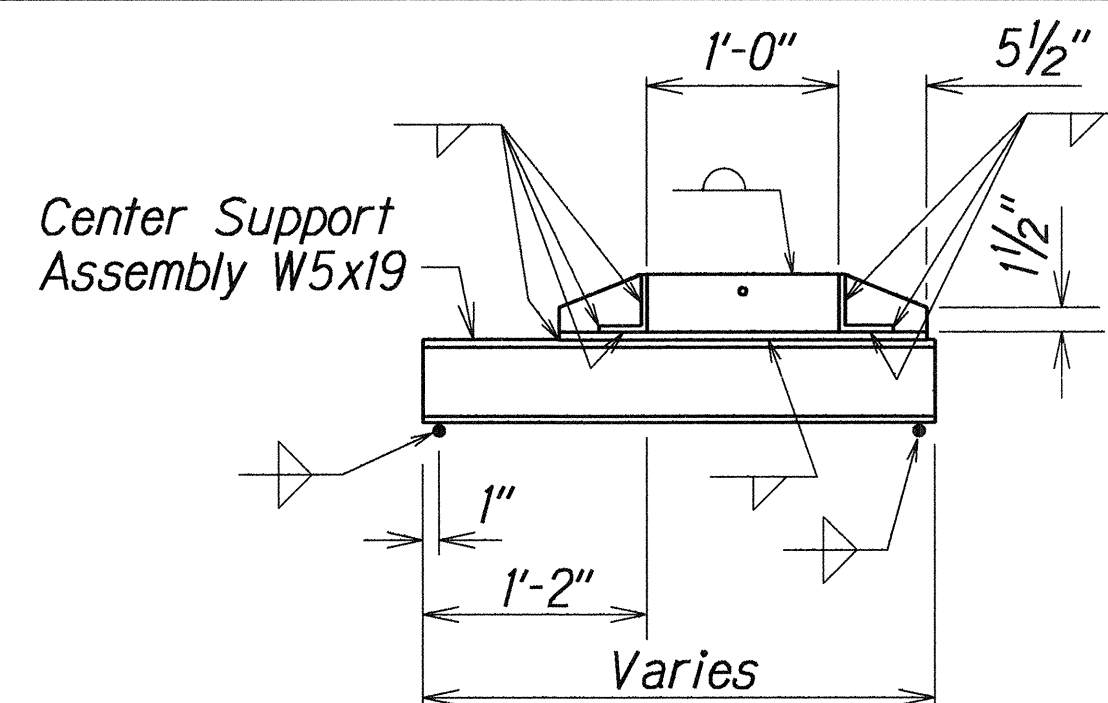


CROSS SECTION

Scale: 1"=1'-0"

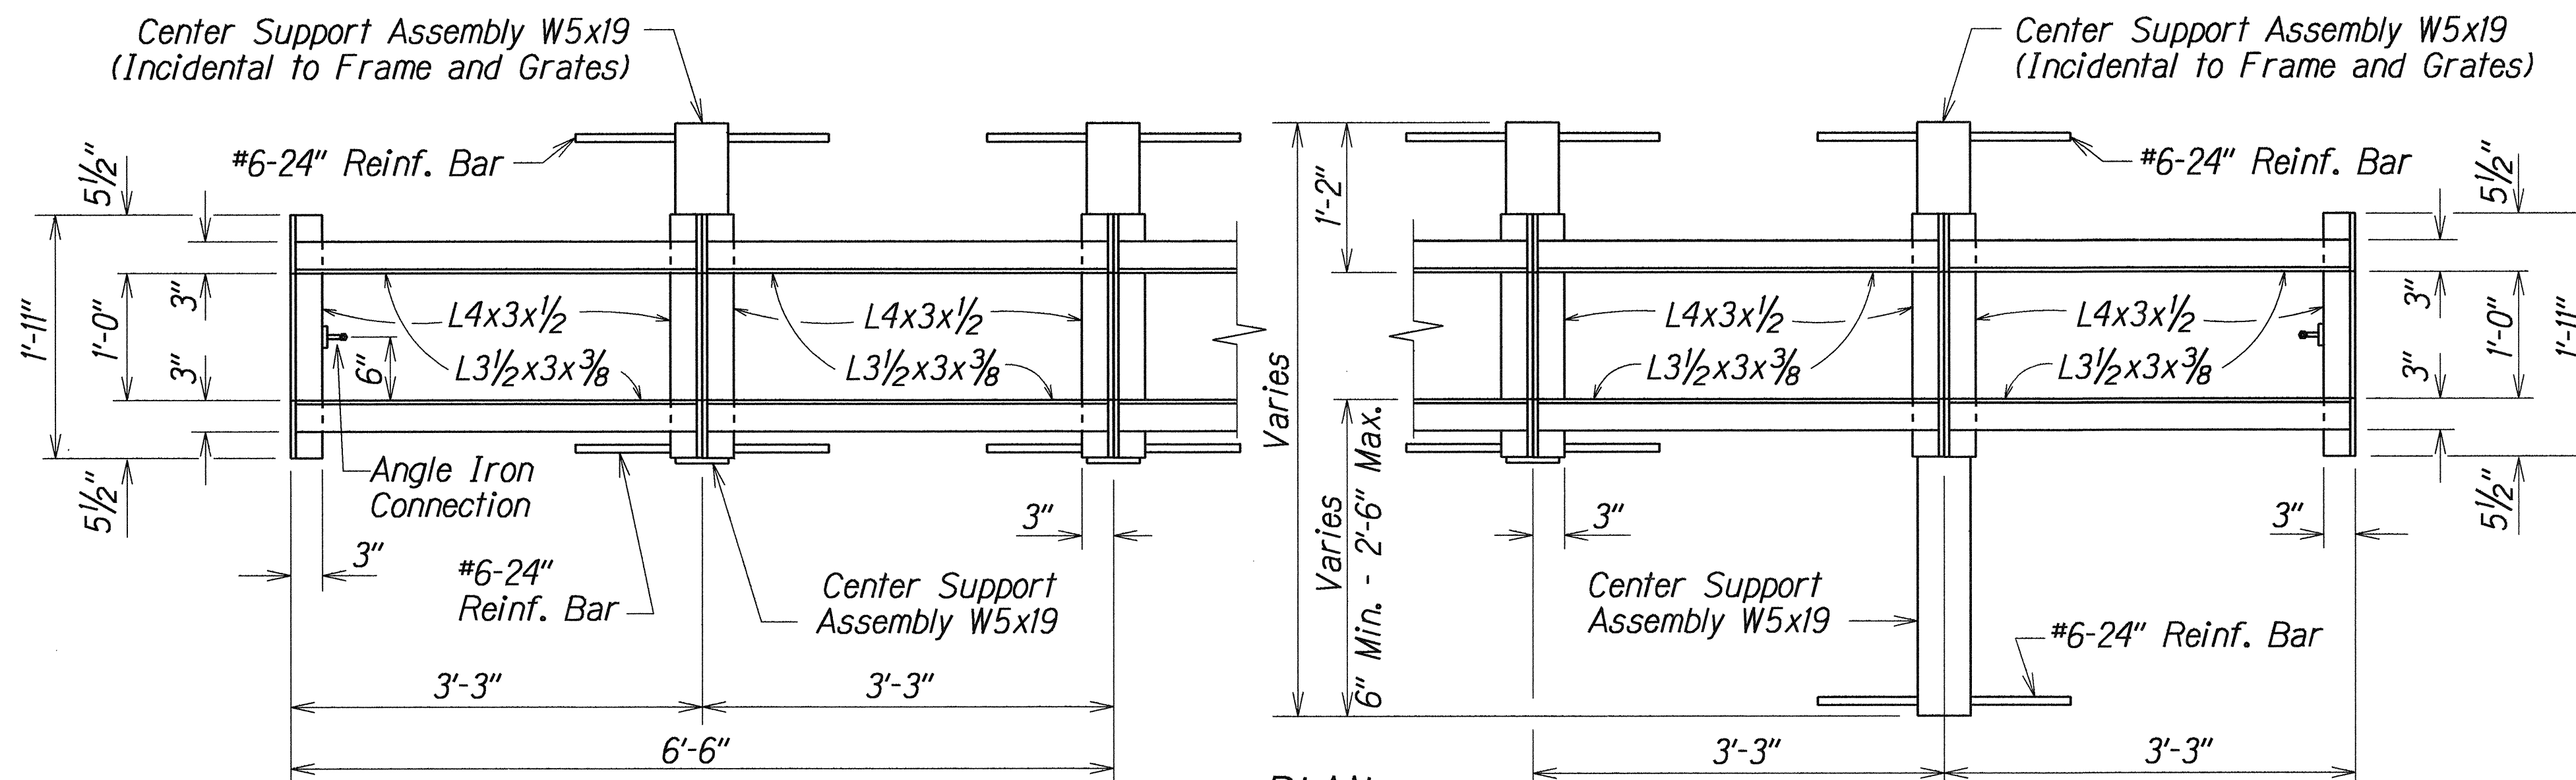

PLAN

Scale: 1"=1'-0"

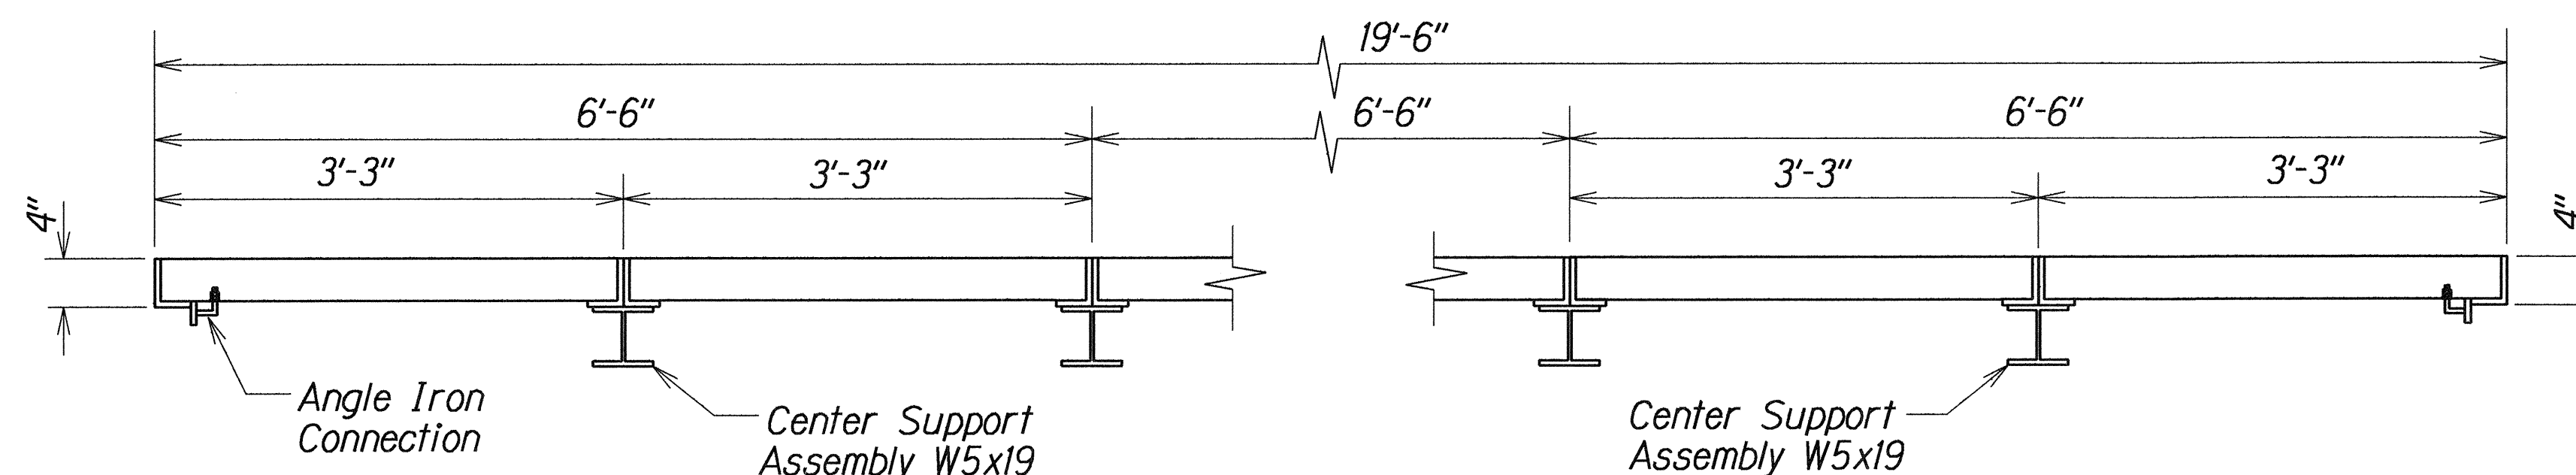

LONGITUDINAL SECTION

Scale: 1"=1'-0"


FRAME DETAILS

NOTES

1. The various materials shall conform to the specifications of ASTM as listed in the following tabulation and the Standard Specification.


Structural Steel	ASTM A 36
BOLTS, NUTS & WASHERS	ASTM A 307
2. All structural steel plates shall be hot dipped galvanized. All damage to galvanized coating shall be repaired by a field galvanizing method conforming to Annex A1 of ASTM A 780. Repair shall be by the application of a repair material conforming to the requirements of Federal Specification 0-G-93, stick form.
3. Lower nut shall be used as a leveling nut to align members.
4. All welds $\frac{3}{8}$ " unless otherwise noted.
5. Grate shall be parallel to the direction of flow.
6. Angle iron connection to be located at each end of Type A-4 Steel Frame, corresponding grates shall have welded connector plates.

TYPE A-4 STEEL FRAME AND GRATES FOR
TYPE 6 MEDIAN DROP INLET AT O.B. # STA. 348+50 RT.

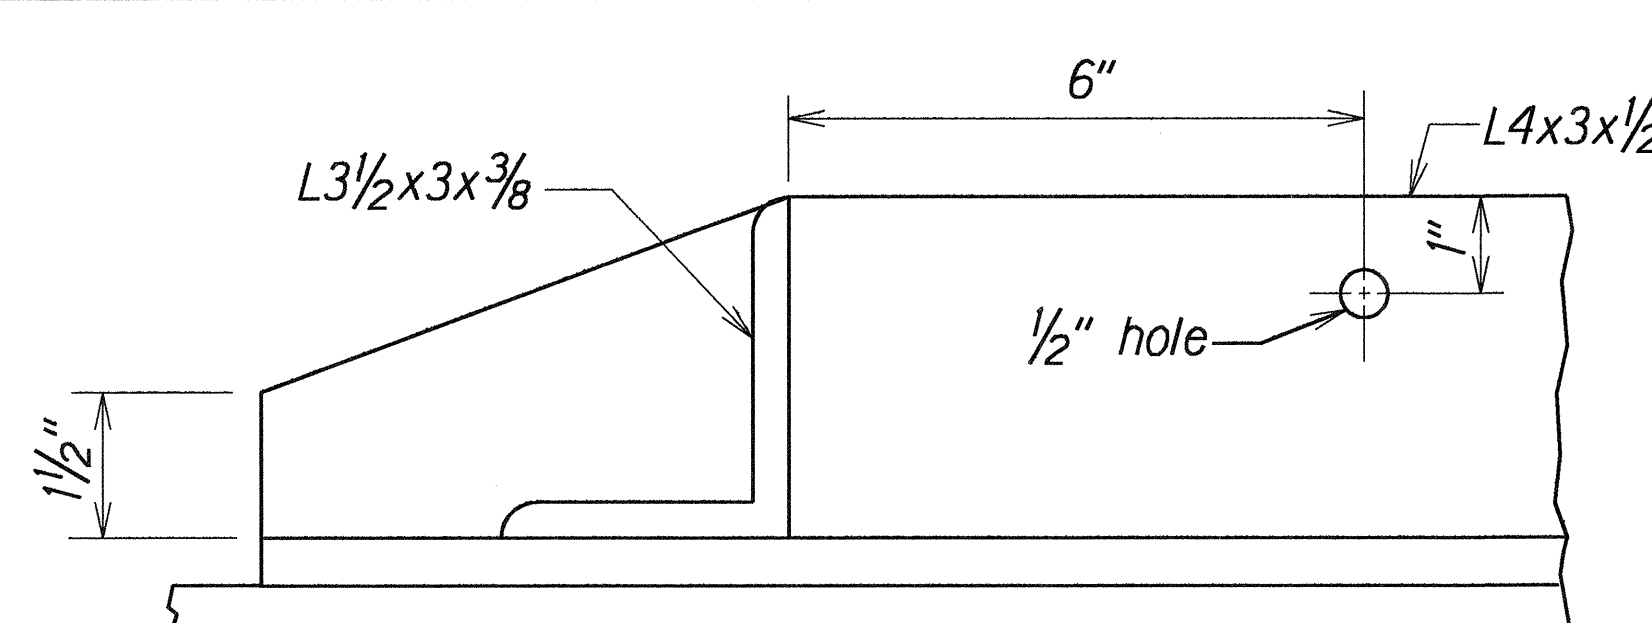


DETAIL OF HOLE LOCATION
IN FRAME FOR BEAM CONNECTION

Half Size

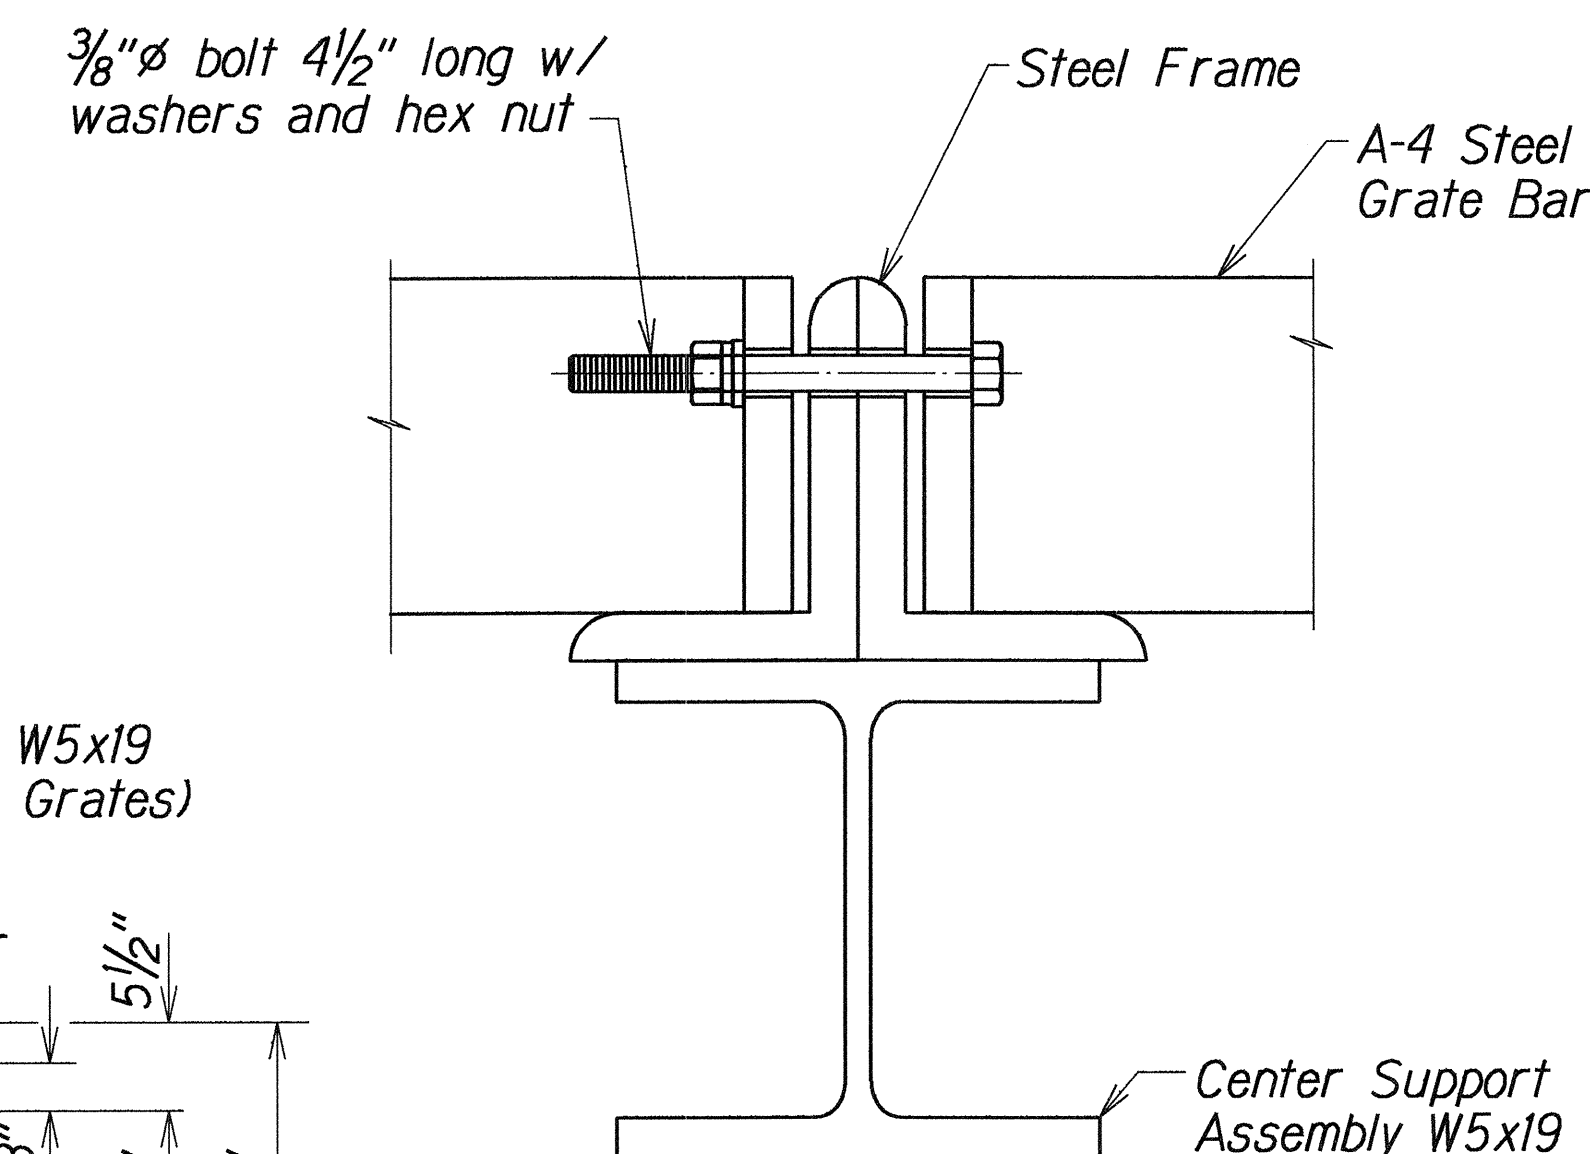

ELEVATION OF BEAM CONNECTION

Half Size

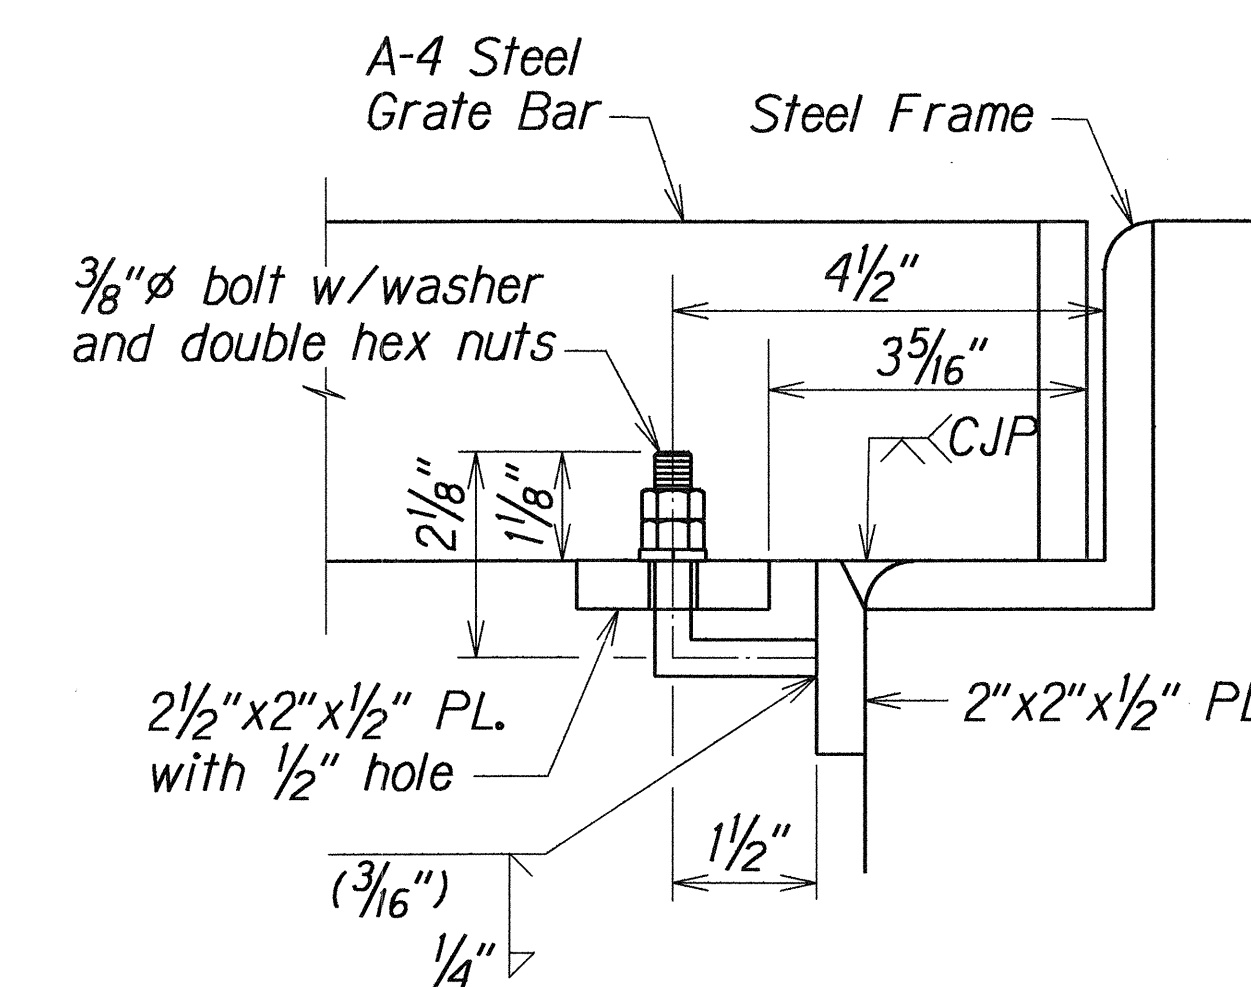

ELEVATION OF ANGLE IRON CONNECTION

Half Size

ORIGINAL PLAN	SURVEY PLOTTED BY _____ DATE _____
	DRAWN BY <u>J. Cadden, A. Namura</u>
	TRACED BY _____
NOTE BOOK <u>dhidhidian</u>	DESIGNED BY <u>P. Sakamoto</u>
	QUANTITIES BY _____
	CHECKED BY _____
	<u>dh2m42adgn</u>

7/22/94	Sheet added to Contract Plan to show Details of Type 6 MDI	<u>Mililani Interchange to Waipio Interchange</u> <u>F.A.I. PROJECT NO. IR-H2-K27</u> Scale: As Shown	Date: Jul, 1994
DATE	REVISION	SHEET No. H42B OF 42 SHEETS	

C.O. 133 S-2