

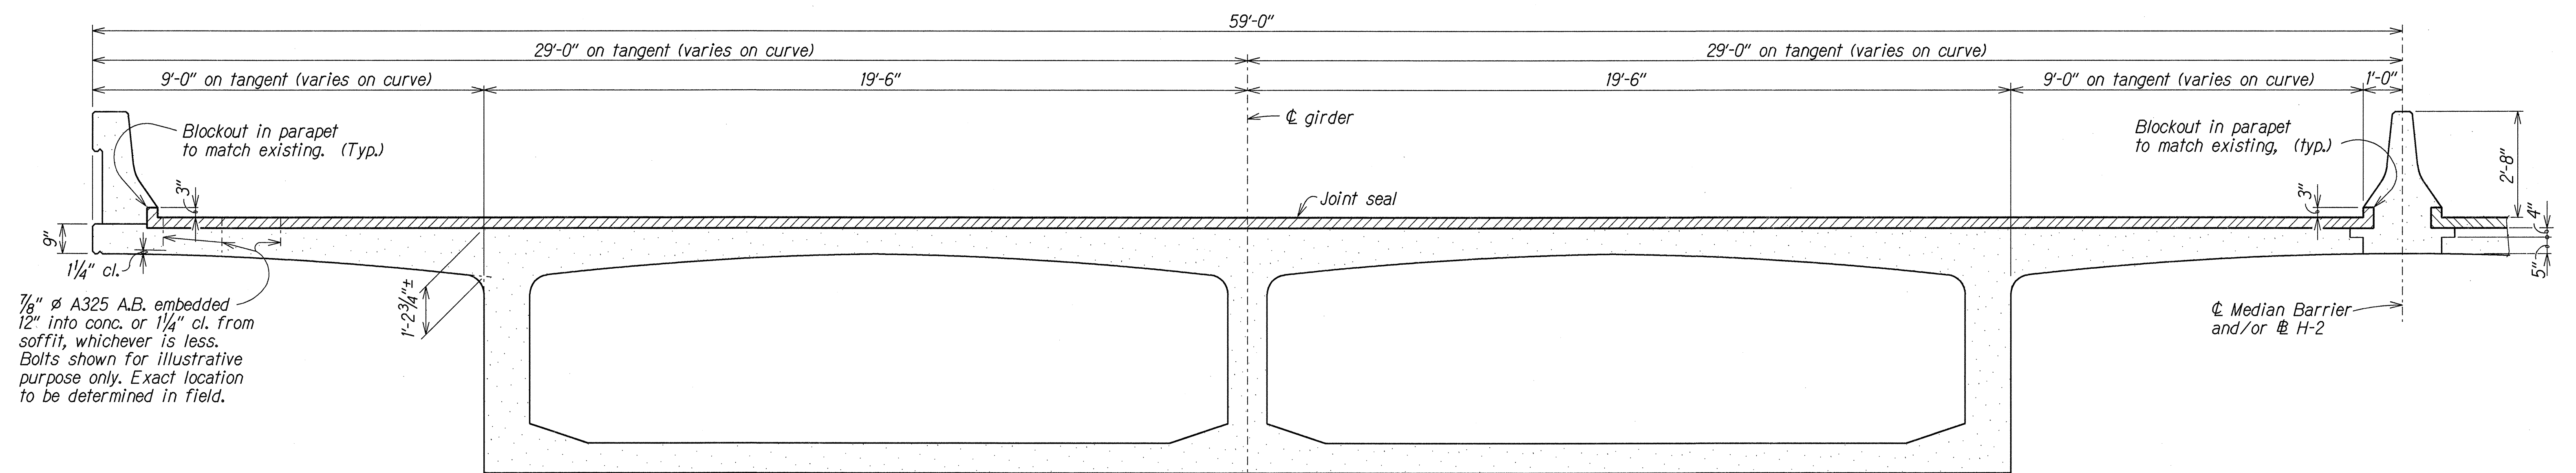


FED. ROAD DIST. NO.	STATE	PROJ. NO.	FISCAL YEAR	SHEET NO.	TOTAL SHEETS
HAWAII	HAW.	H2B-01-91M	1990	3	3

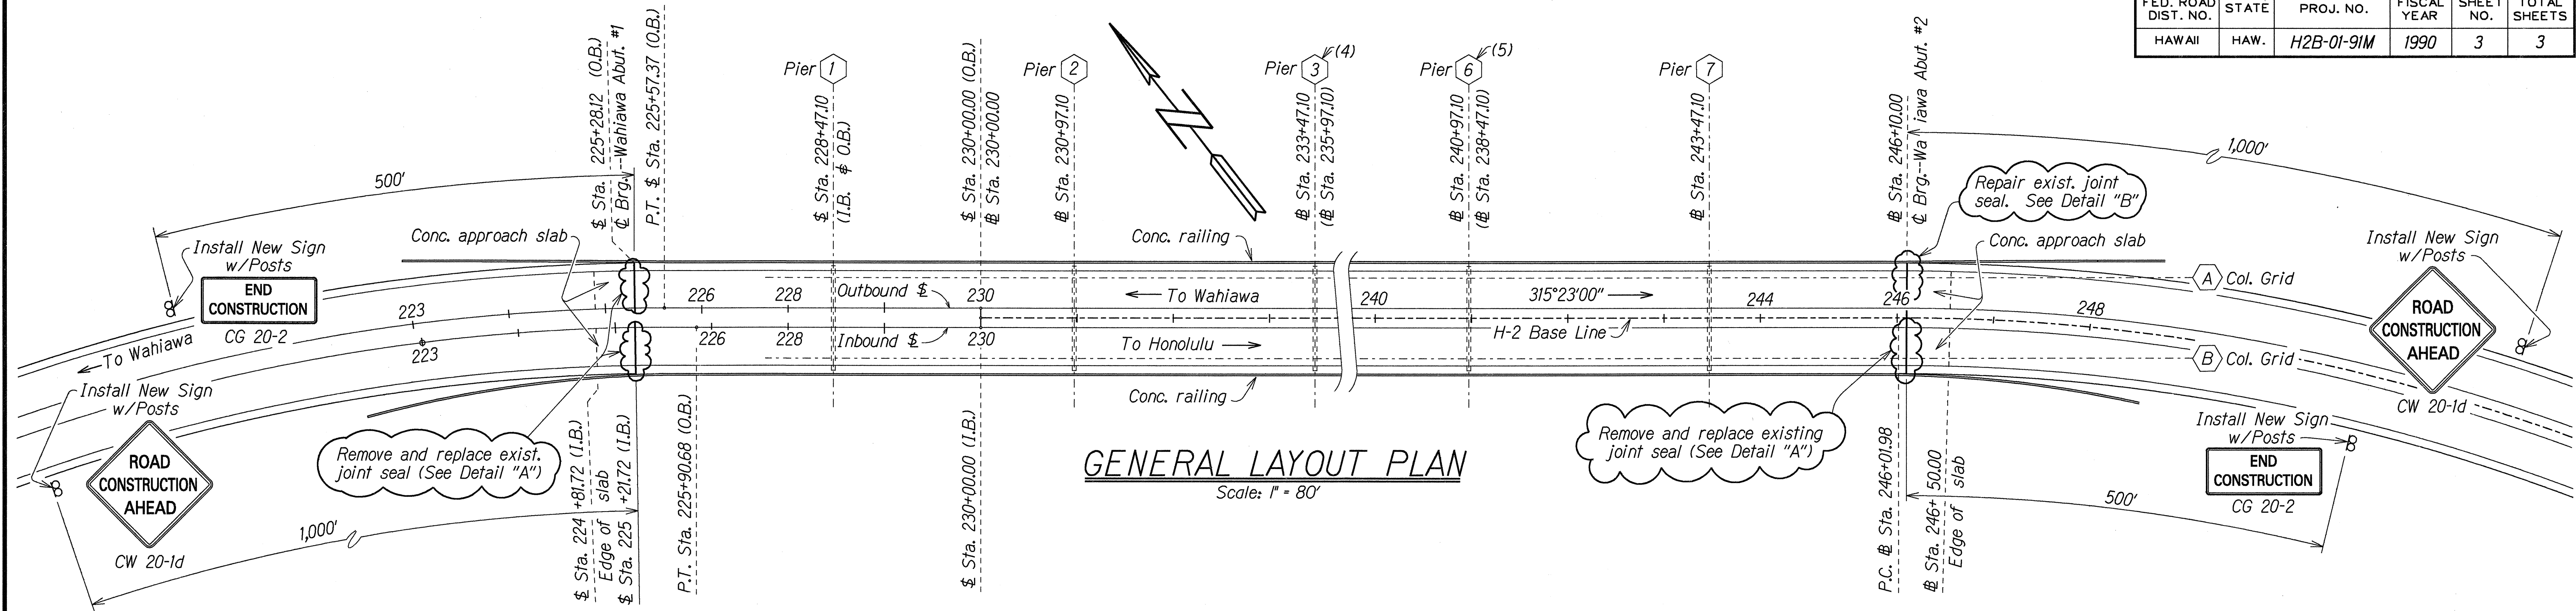

DATE	_____
DESIGNED BY	_____
DRAWN BY	_____
CHECKED BY	_____
IN CHARGE	_____
NOTED BY	_____
QUANTITIES BY	_____
CHECKED BY	_____

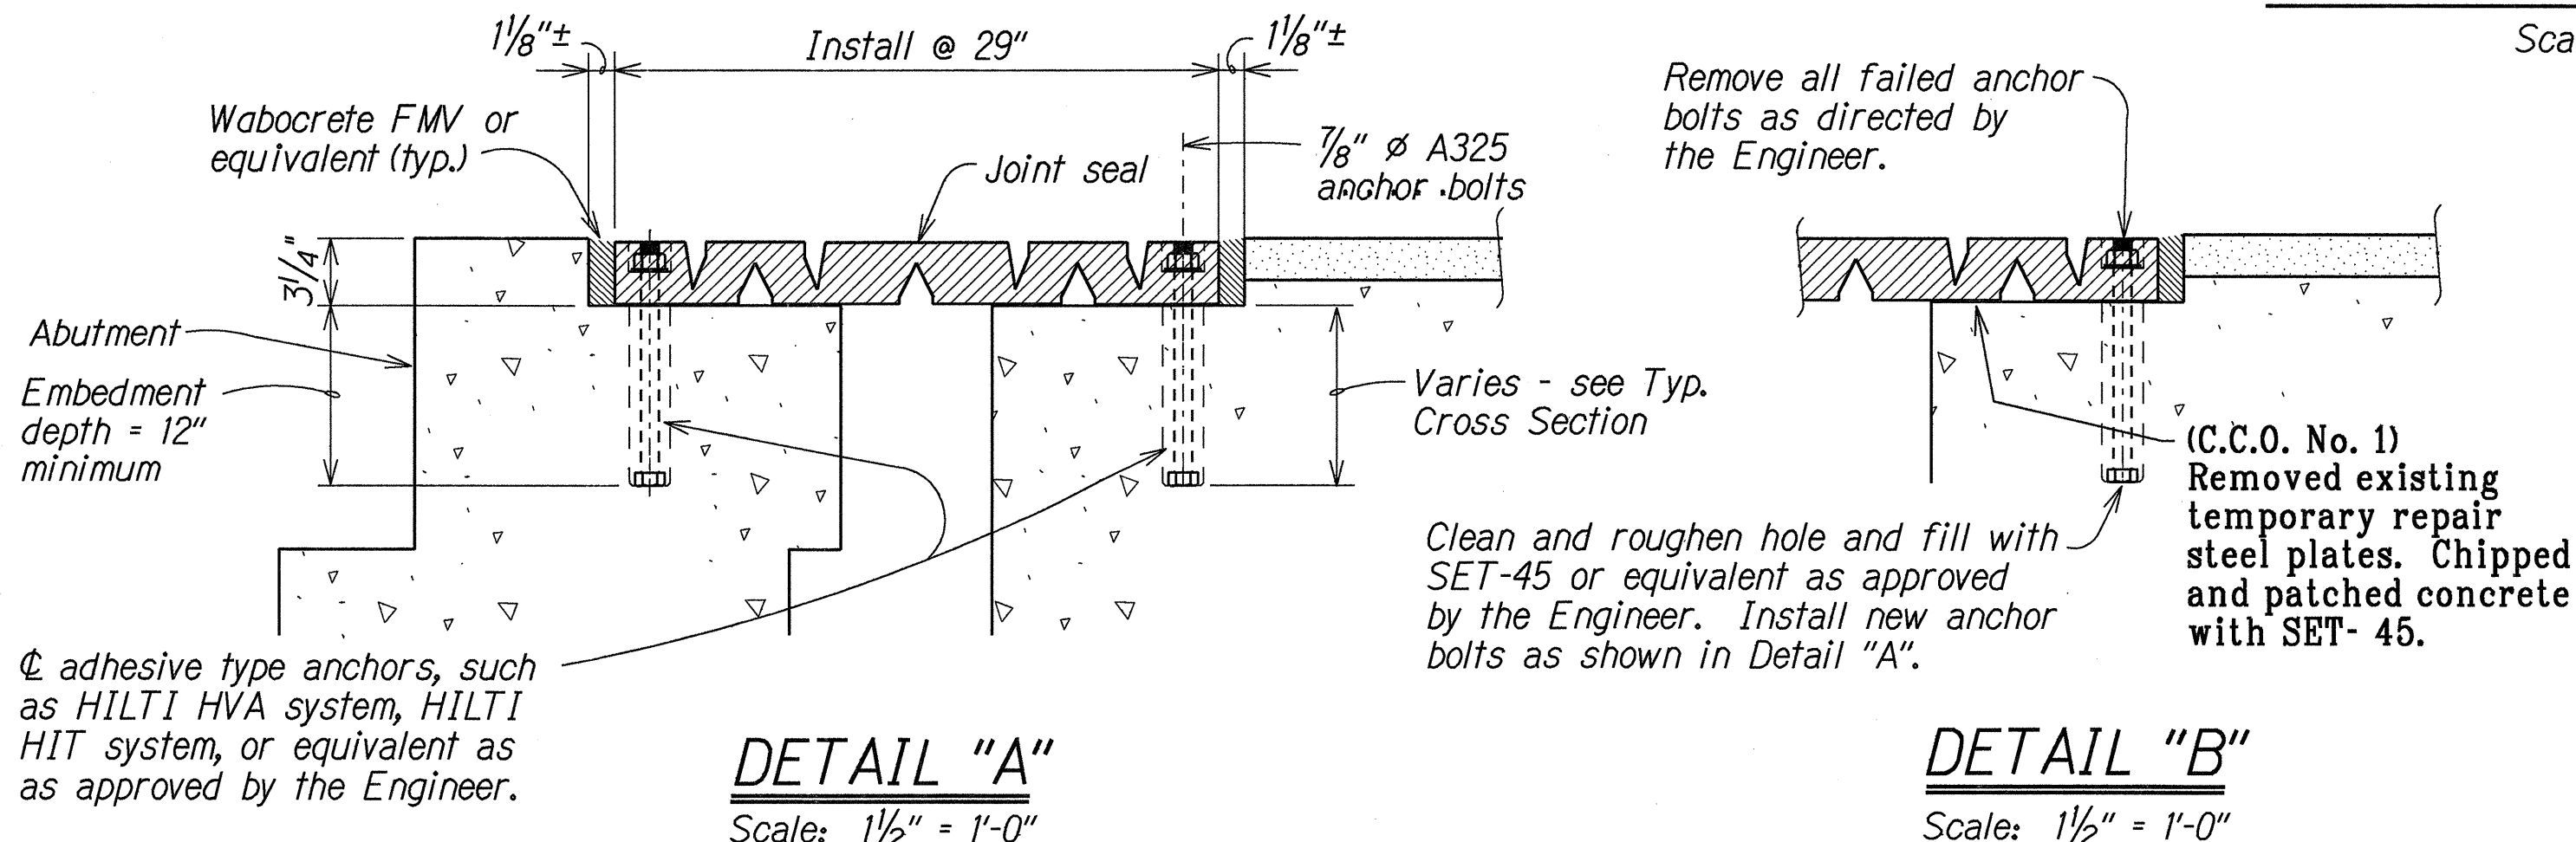

TYPICAL CROSS SECTION--OUTBOUND BRIDGE (INBOUND BRIDGE SIMILAR)

ESTIMATED QUANTITIES			
ITEM NO.	ITEM	APPROX. QUANTITY	UNIT
520.01	Replacing Expansion Joint Seal	(173 L.F.)	L.S.
520.02	Replacing Anchor Bolts	12	EA.

- GENERAL NOTES:**
- Specifications:
 - A. AASHTO Standard Specifications for Highway Bridges. Fourteenth Edition (1989) with 1990 Interim Specifications.
 - B. Hawaii Standard Specifications for Road and Bridge Construction, 1985 and Special Provisions.
 - Expansion joint seal shall be Watson Bowman & Acme SR 6.5A or equivalent as approved by the Engineer.
 - Surface preparation for and installation of expansion joint seal shall be per manufacturer's recommendation.
 - All items, including preparation, required for installation shall be incidental to the expansion joint seal.
 - All dimensions shall be verified in the field.
 - Denotes repair work on existing structure.

LEGEND FOR AS-BUILT POSTINGS	
	Squiggly line for as-built deletion
	Double line for as-built deletion
	Text for as-built posting

STATE OF HAWAII
DEPARTMENT OF TRANSPORTATION
HIGHWAYS DIVISION

PLAN
INTERSTATE ROUTE H-2
KIPAPA STREAM BRIDGE
REPLACE EXPANSION JOINT SEALS
Proj. No. H2B-01-91M

Scale: As Noted Date: Oct. 1990

SHEET No. 31 OF 1 SHEETS

"AS-BUILT"