


[illegible]

FED. ROAD DIST. NO.	STATE	PROJ. NO.	FISCAL YEAR	SHEET NO.	TOTAL SHEET
HAWAII	HAW.	H2B-01-91M	1991	1	3

STATE OF HAWAII
DEPARTMENT OF TRANSPORTATION
HIGHWAYS DIVISION
HONOLULU, HAWAII
"AS-BUILT"
PLANS FOR
INTERSTATE ROUTE H-2
KIPAPA STREAM BRIDGE
REPLACEMENT EXPANSION JOINT SEALS
PROJECT NO. H2B-01-91M

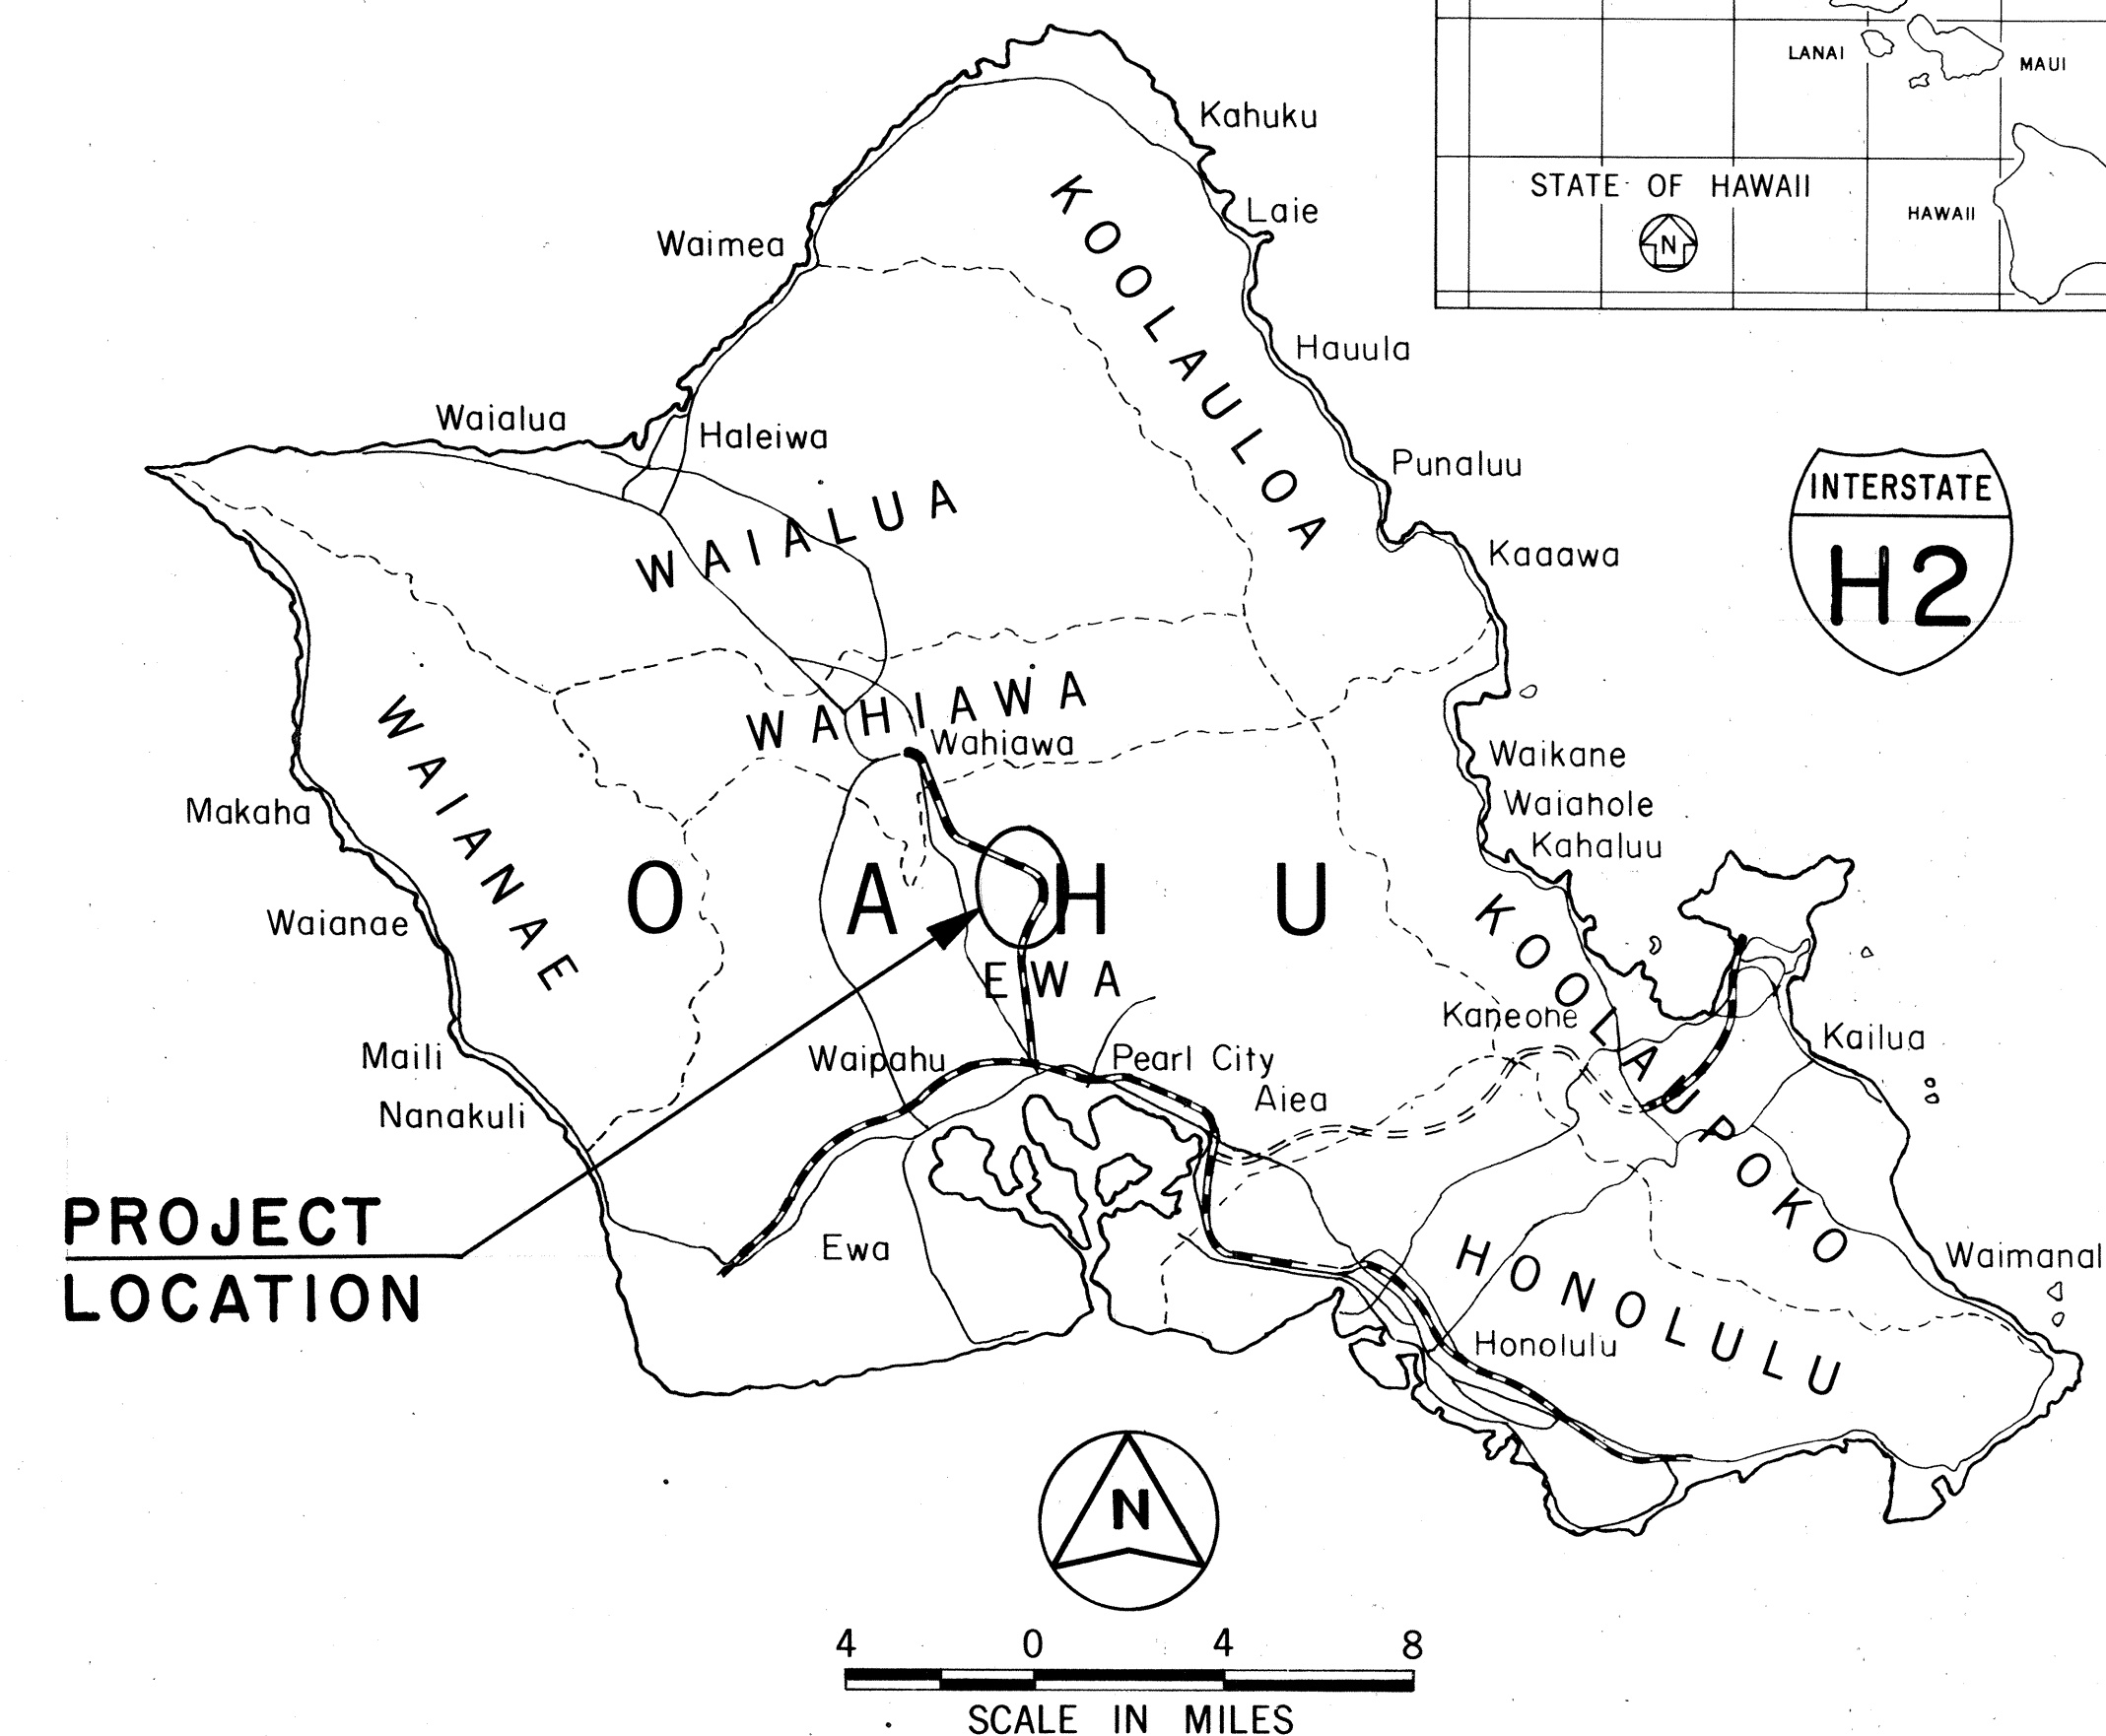

CHANGES MADE DURING CONSTRUCTION HAVE BEEN INCORPORATED ON THESE PLANS EXCEPT CHANGES IN THE ORIGINAL THEORETICAL QUANTITIES. FOR ACTUAL QUANTITIES, REFER TO PROJECT LEADER AND/OR COMPUTATION BOOK.

