



FED. ROAD DIST. NO.	STATE	FED. AID PROJ. NO.	FISCAL YEAR	SHEET NO.	TOTAL SHEETS
HAWAII	HAW.	IM-H2-1 (29)	1997	18	129

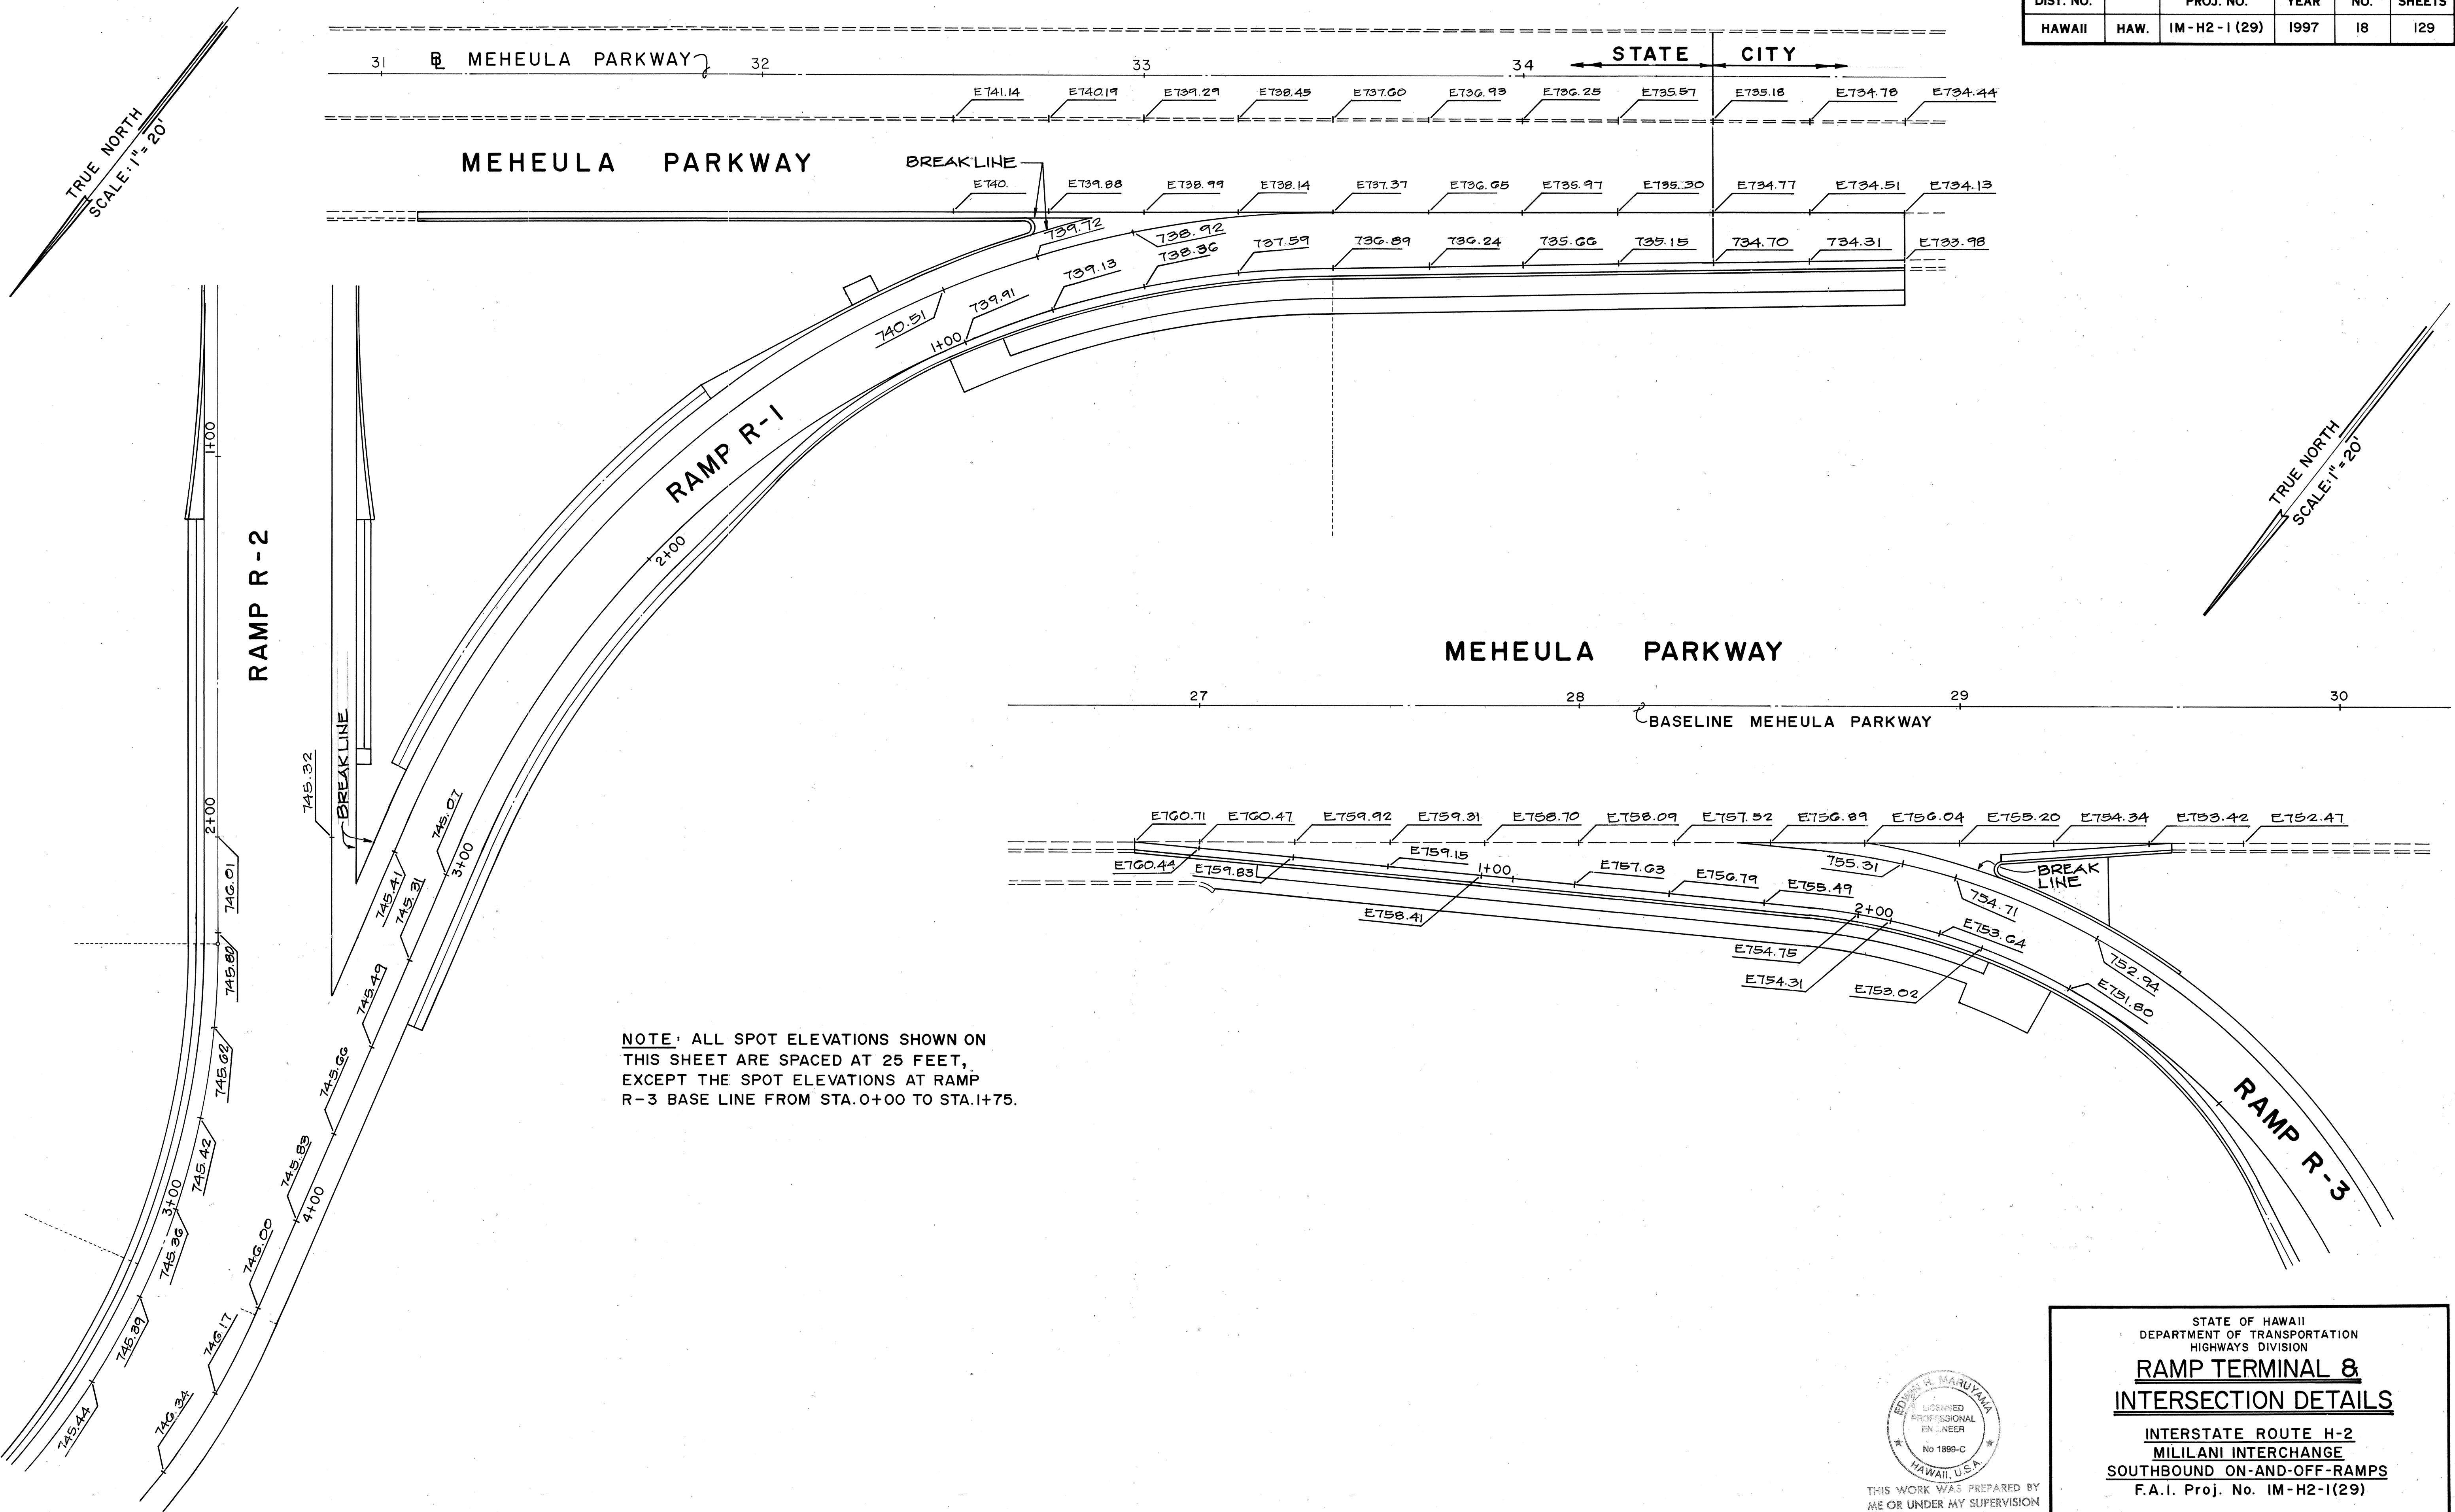

ORIGINAL PLAN	SURVEY PLOTTED BY	DATE
TRACED BY		
NOTED BY		
CHECKED BY		
NO.		

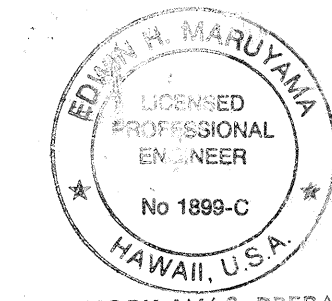

THIS WORK WAS PREPARED BY
ME OR UNDER MY SUPERVISION
By: *Edwin A. Maruyama*
FUJITA & ASSOCIATES

STATE OF HAWAII
DEPARTMENT OF TRANSPORTATION
HIGHWAYS DIVISION

**RAMP TERMINAL &
INTERSECTION DETAILS**

INTERSTATE ROUTE H-2
MILILANI INTERCHANGE
SOUTHBOUND ON-AND-OFF-RAMPS
F.A.I. Proj. No. IM-H2-1(29)

SCALE: 1" = 20' DATE: MAR. 1997

SHEET NO. C10 OF 16 SHEETS

"AS-BUILT" 18