


FINAL SURVEY	DATE
SURVEYED	
PLOTTED	
NOTE BOOK	
AREAS CHECKED	
NO.	


ORIGINAL SURVEY	DATE
SURVEYED	
PLOTTED	
NOTE BOOK	
AREAS CHECKED	
NO.	

FED. ROAD DIST. NO.	STATE	FED. AID PROJ. NO.	FISCAL YEAR	SHEET NO.	TOTAL SHEETS
HAWAII	HAW.	IM-H2-1 (29)	1997	21	129

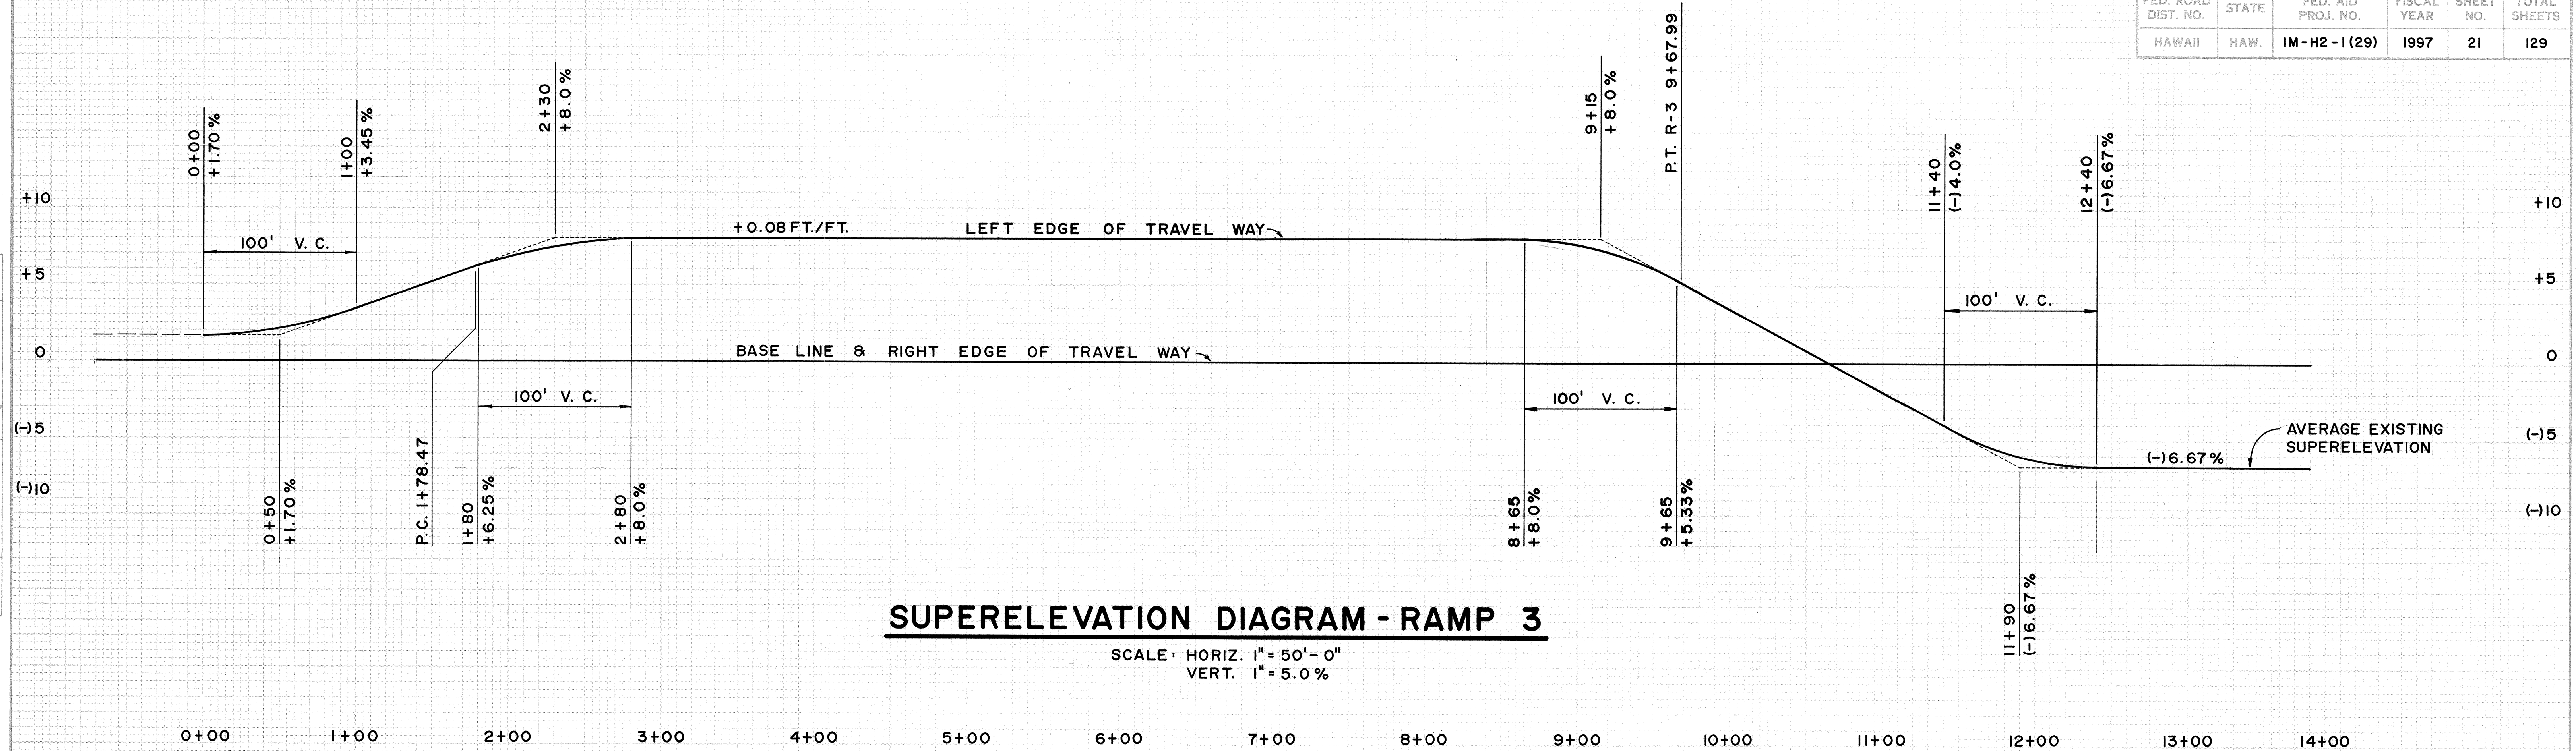


SUPERELEVATION DIAGRAM - RAMP 3

SCALE: HORIZ. 1" = 50' - 0"
VERT. 1" = 5.0%

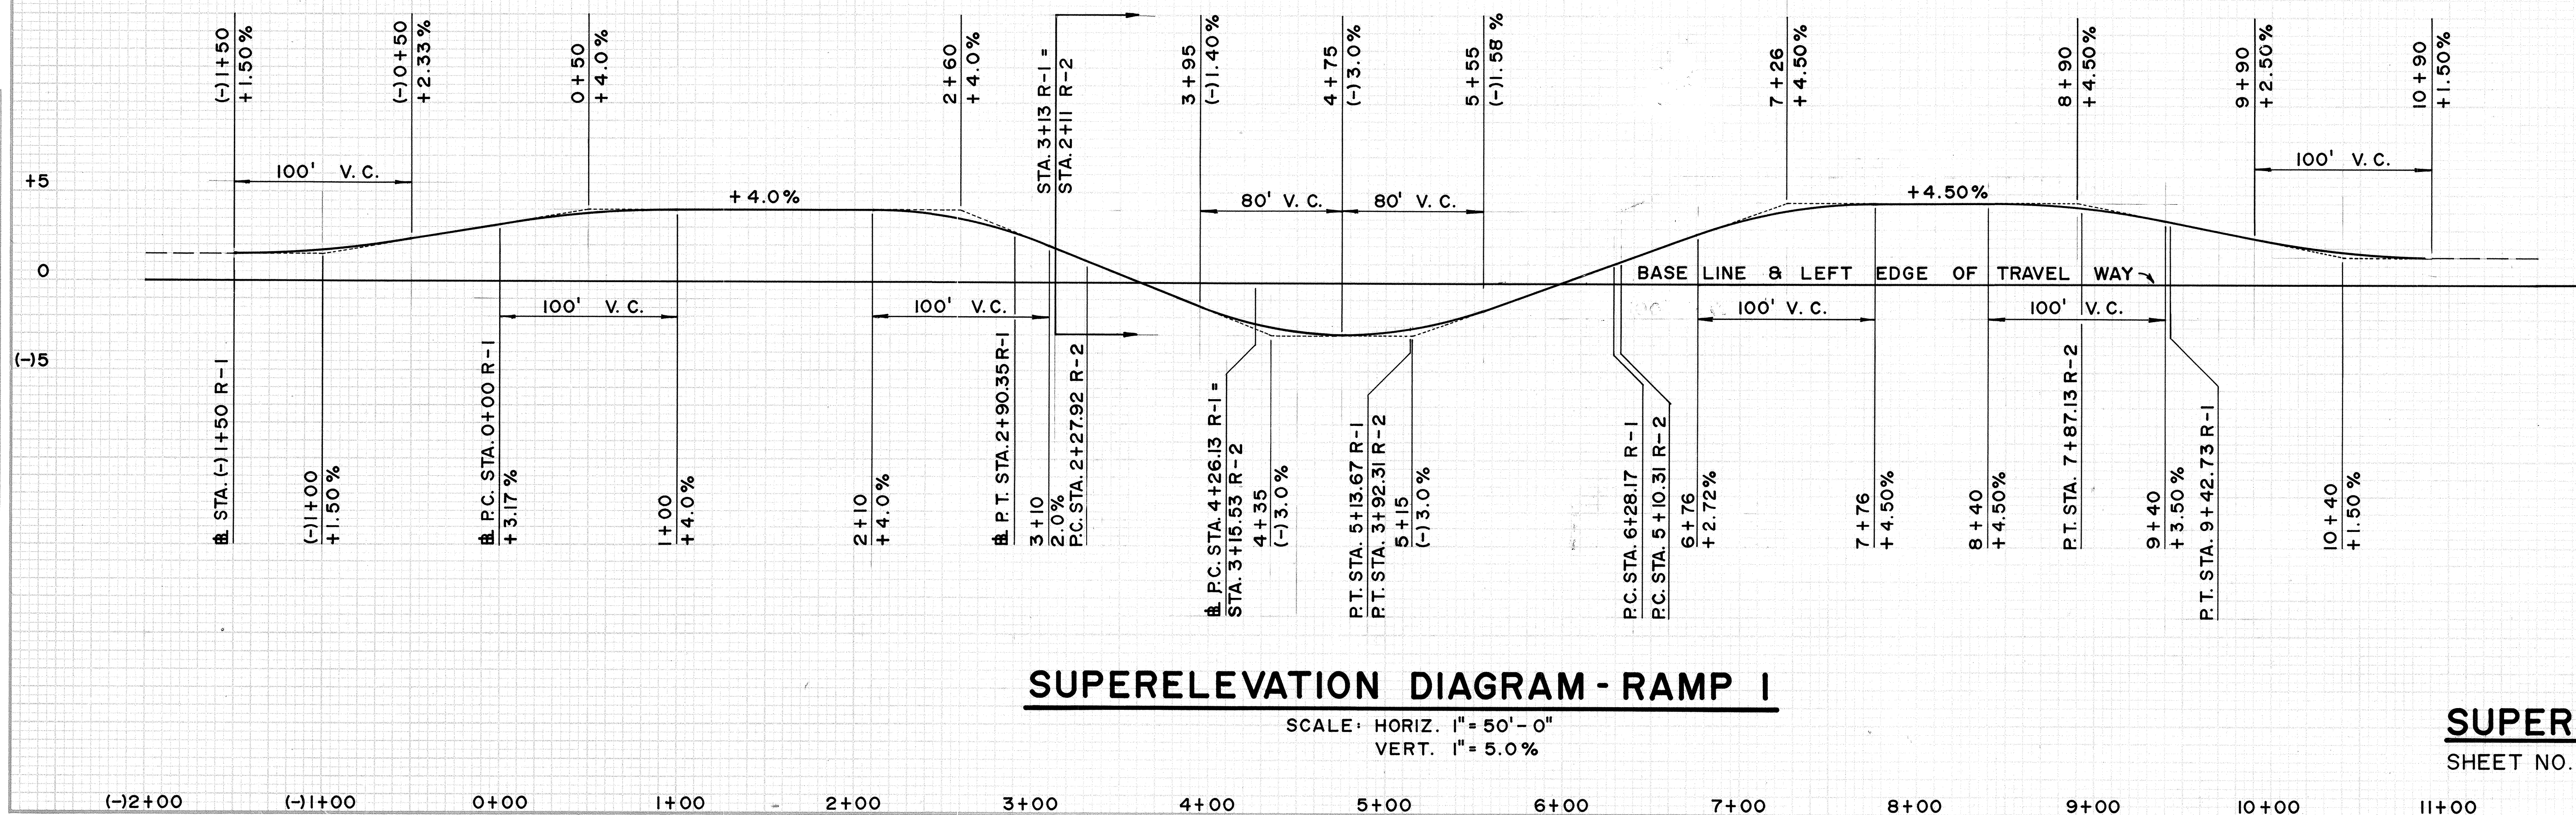

SUPERELEVATION DIAGRAM - RAMP 1

SCALE: HORIZ. 1" = 50' - 0"
VERT. 1" = 5.0%

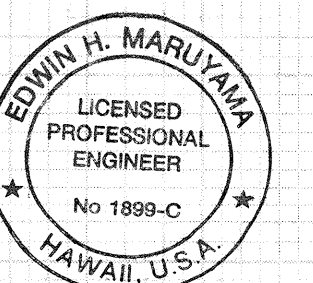

THIS WORK WAS PREPARED BY
ME OR UNDER MY SUPERVISION
By: *Edwin H. Maruyama*
FUJITA & ASSOCIATES

SUPERELEVATION DIAGRAMS

SHEET NO. C13 OF 16 SHEETS



"AS-BUILT"

21

FINAL SURVEY	SURVEYED	BY	DATE
NOTE BOOK NO.	PLOTTED		
	DATE		
	AREAS CHECKED		

ORIGINAL SURVEY	SURVEYED	BY	DATE
NOTE BOOK NO.	PLOTTED		
	DATE		
	AREAS CHECKED		

FED. ROAD DIST. NO.	STATE	FED. AID PROJ. NO.	FISCAL YEAR	SHEET NO.	TOTAL SHEETS
HAWAII	HAW.	IM-H2-1(29)	1997	22	129

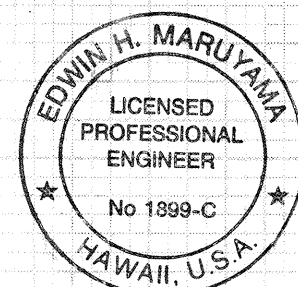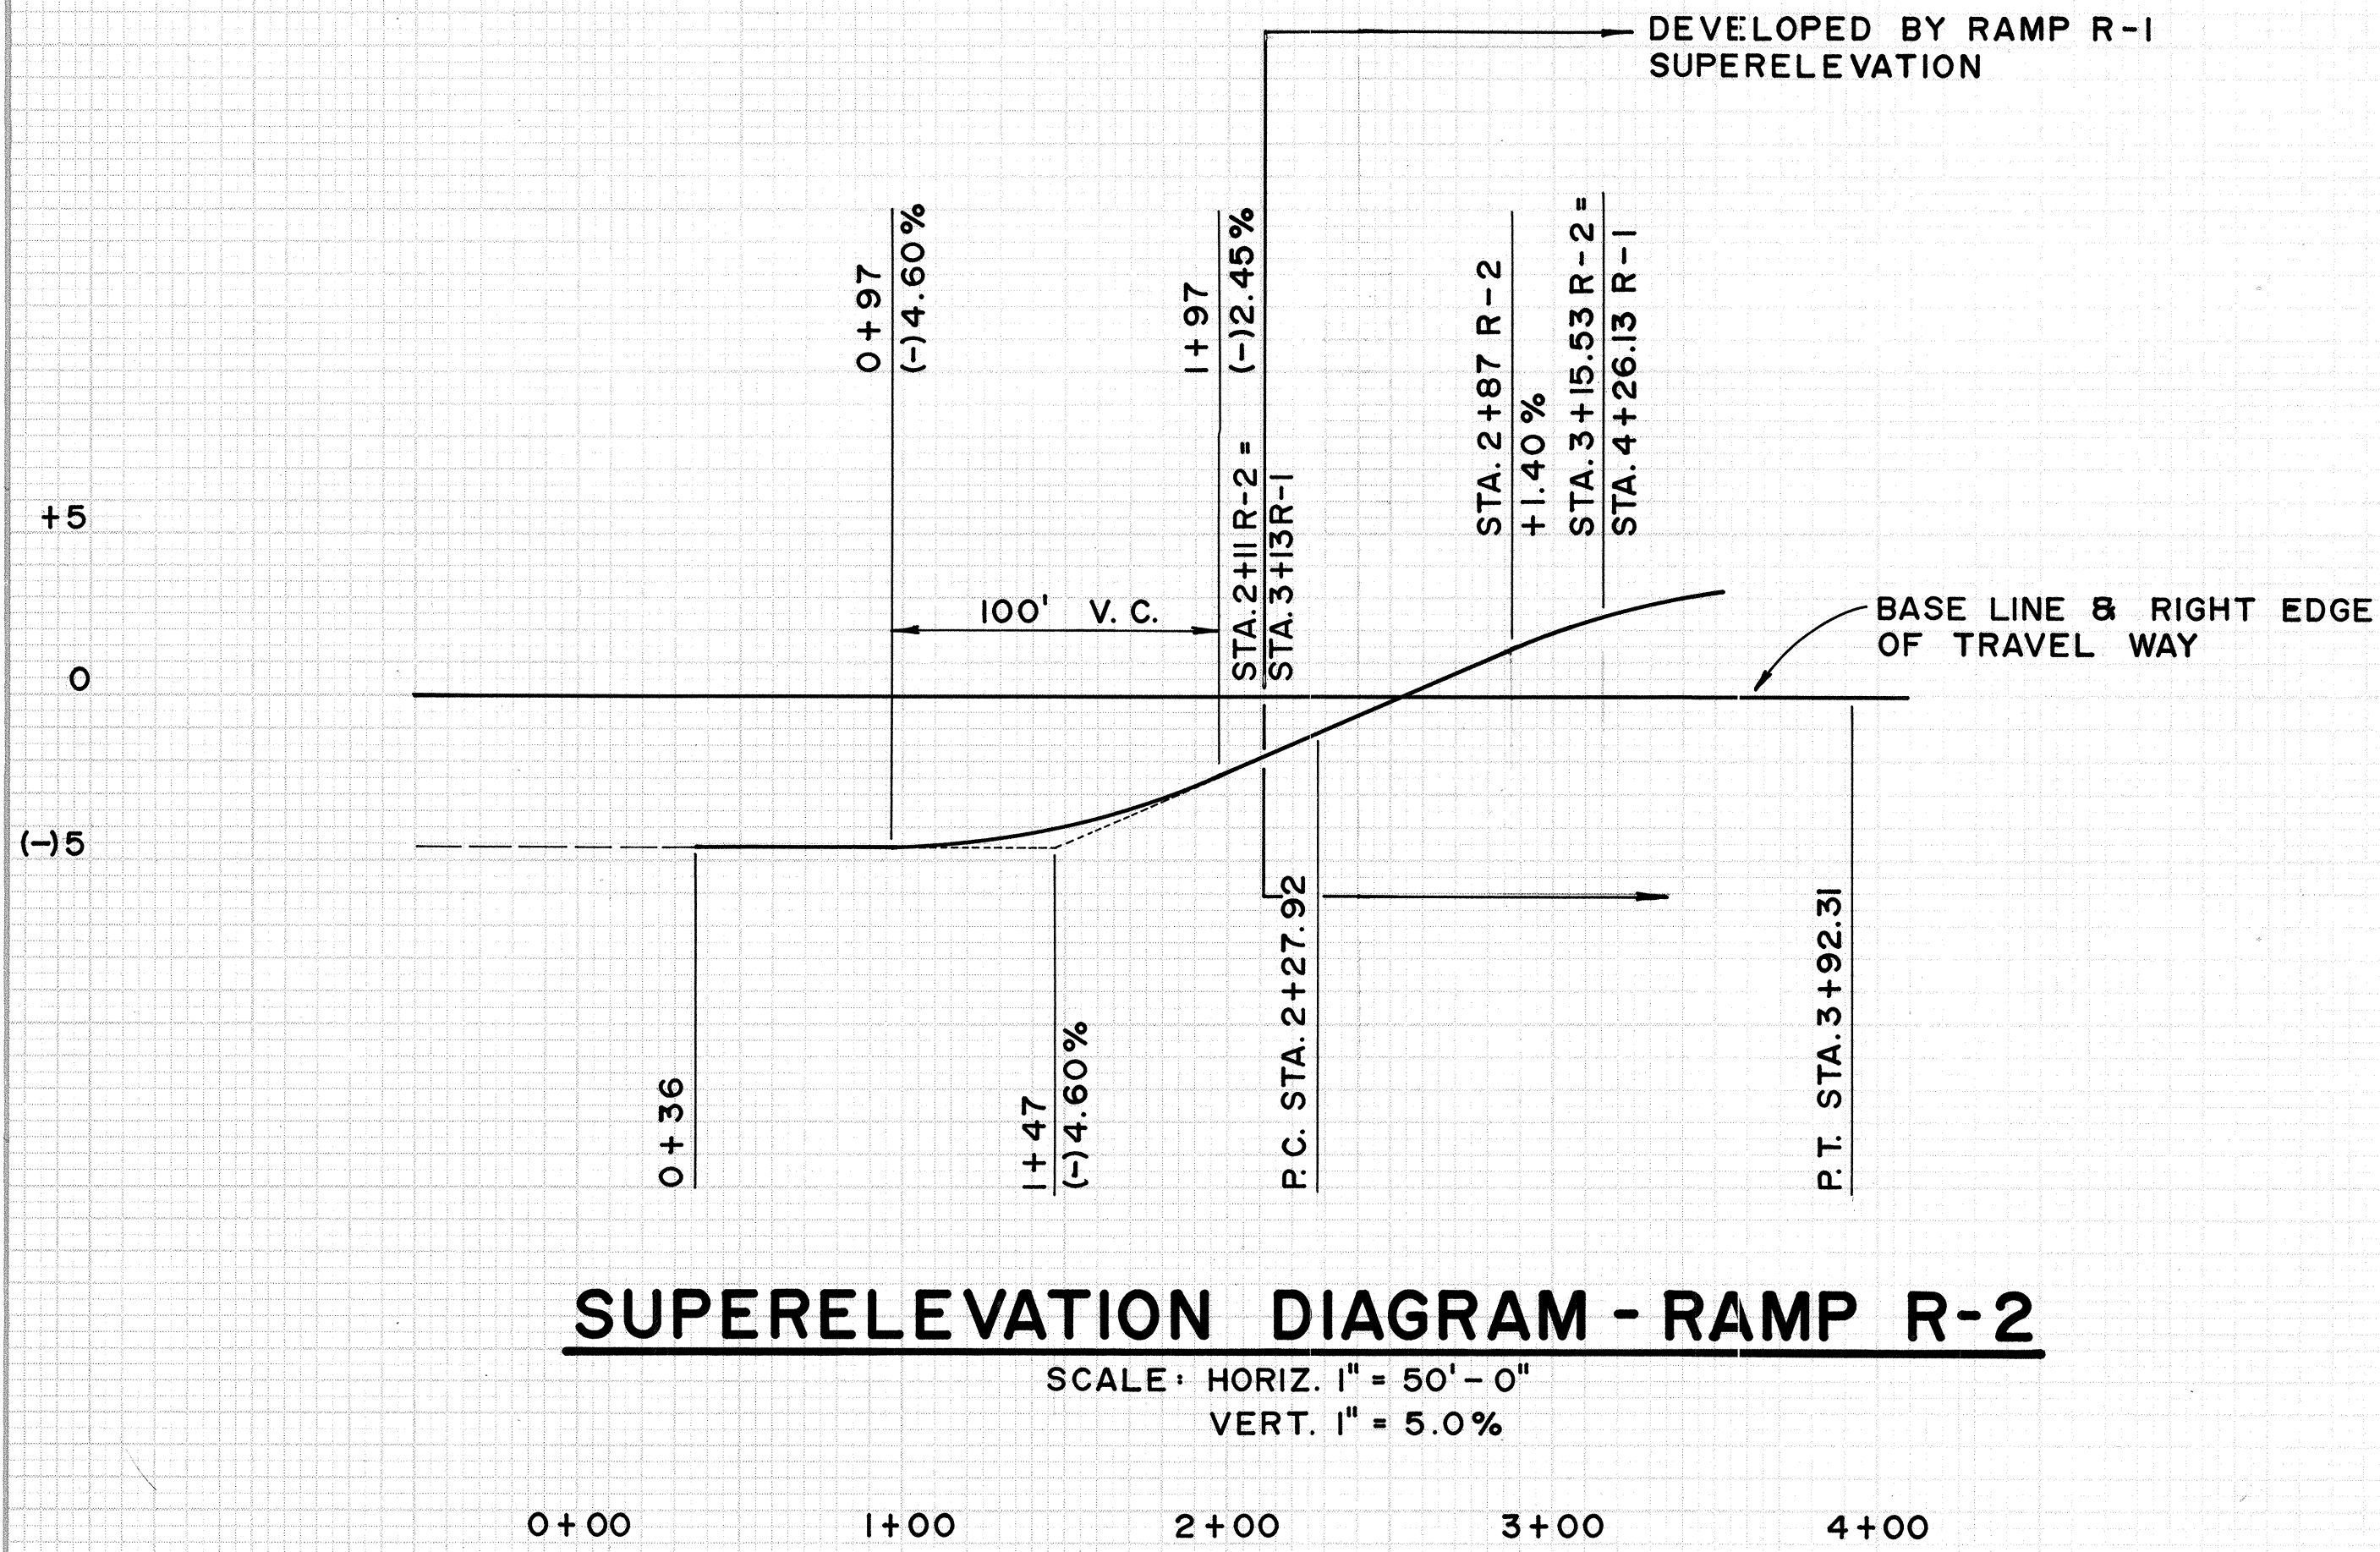

THIS WORK WAS PREPARED BY
ME OR UNDER MY SUPERVISION

By: *Edwin H. Maruyama*
FUJITA & ASSOCIATES

SUPERELEVATION DIAGRAMS

SHEET NO. C14 OF 16 SHEETS