



FED. ROAD DIST. NO.	STATE	FED. AID PROJ. NO.	FISCAL YEAR	SHEET NO.	TOTAL SHEETS
HAWAII	HAW.	IM-H2-1(29)	1997	25	129

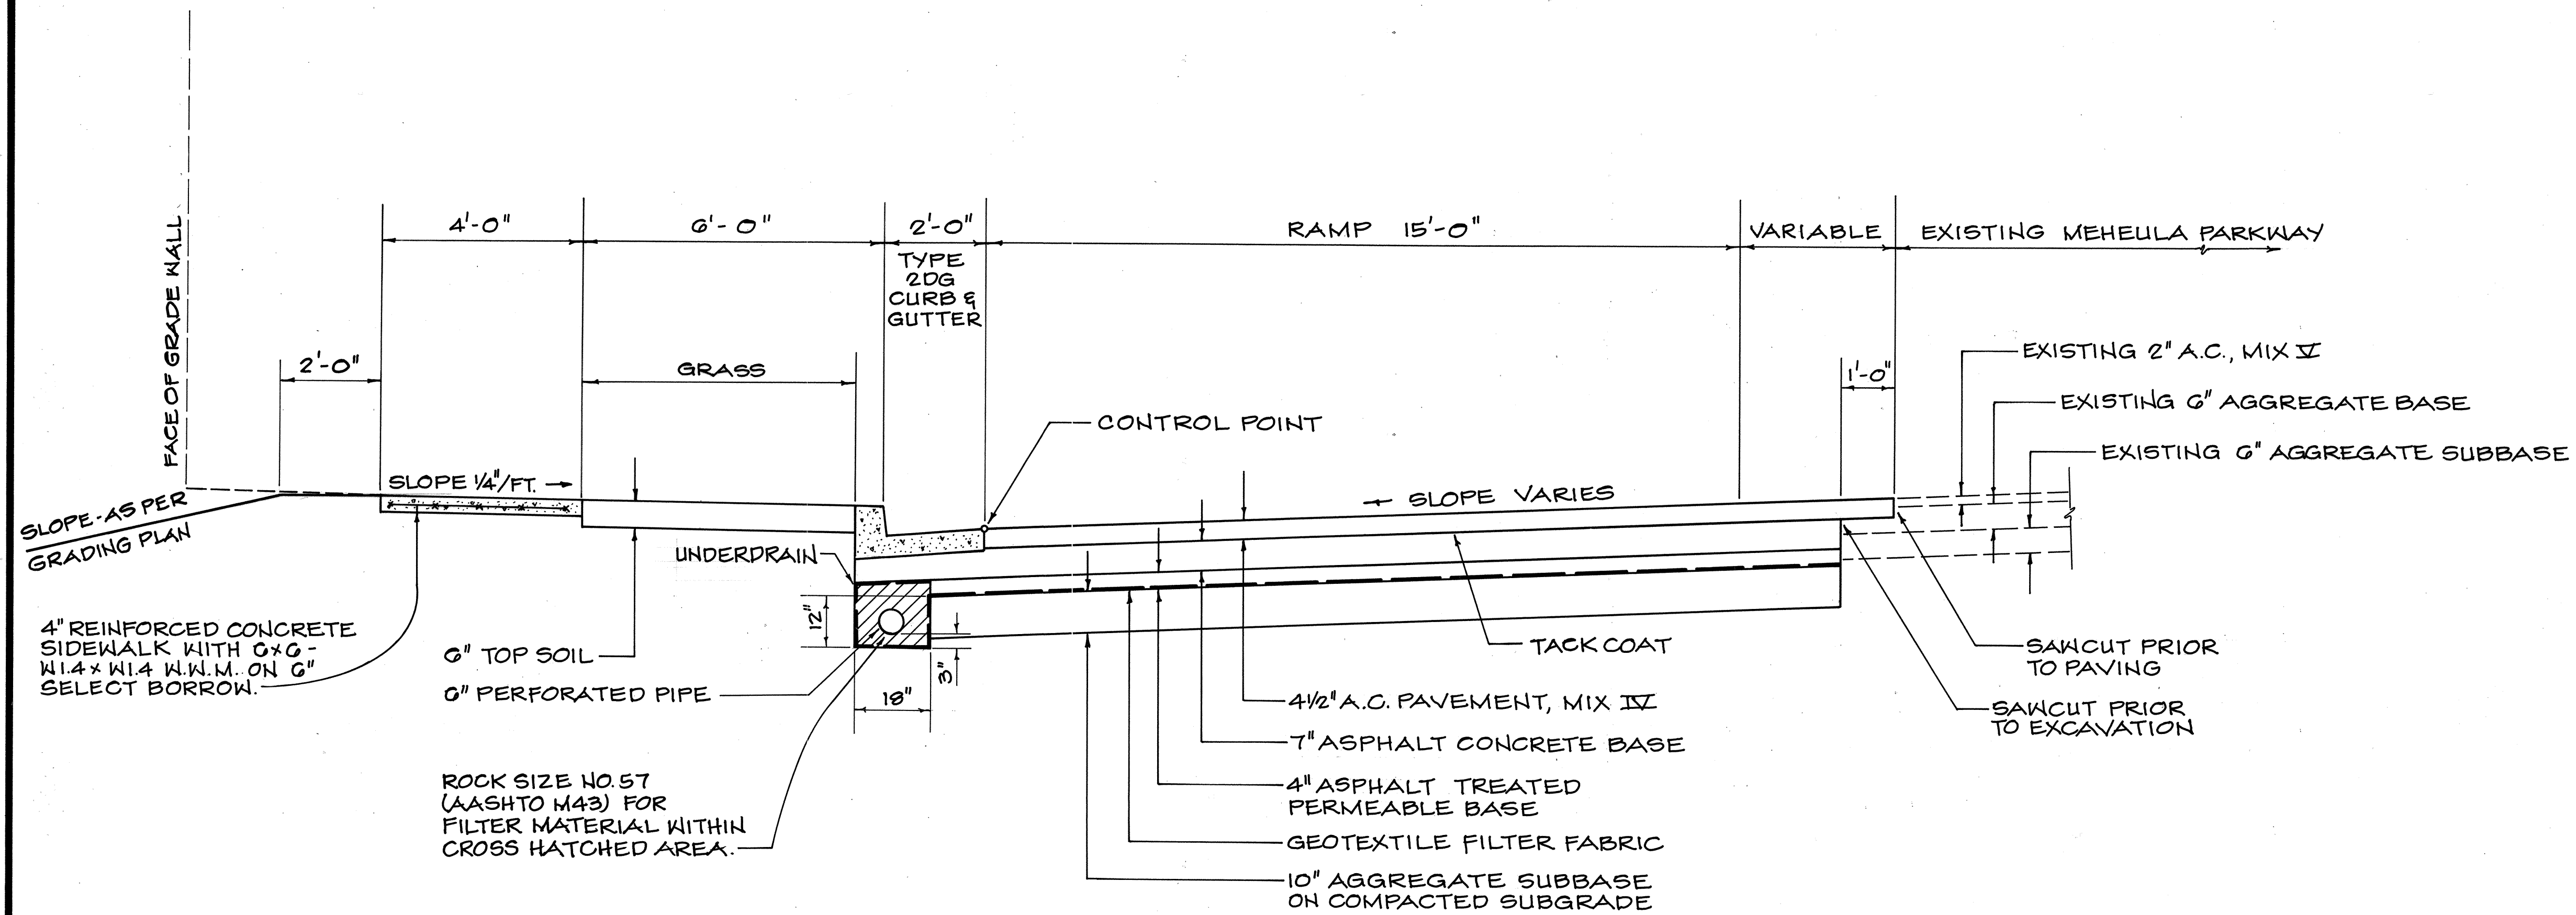


DETAIL
STA. 0+00 (±) TO STA. 0+72 (±) RAMP R-1

THESE NOTES ARE APPLICABLE TO ALL SECTION SHEETS.

1. SECTIONS MUST BE READ IN CONJUNCTION WITH THE ALIGNMENT PLANS AND GRADING PLANS.
2. FILTER MATERIAL WITHIN CROSS HATCHED AREA OF THE SUBDRAIN MUST BE UNTREATED MATERIAL SUCH AS AASHTO M-43 NO. 57 AGGREGATE, AND NO HEAVY COMPACTION EQUIPMENT SHALL BE USED TO COMPACT THIS MATERIAL.

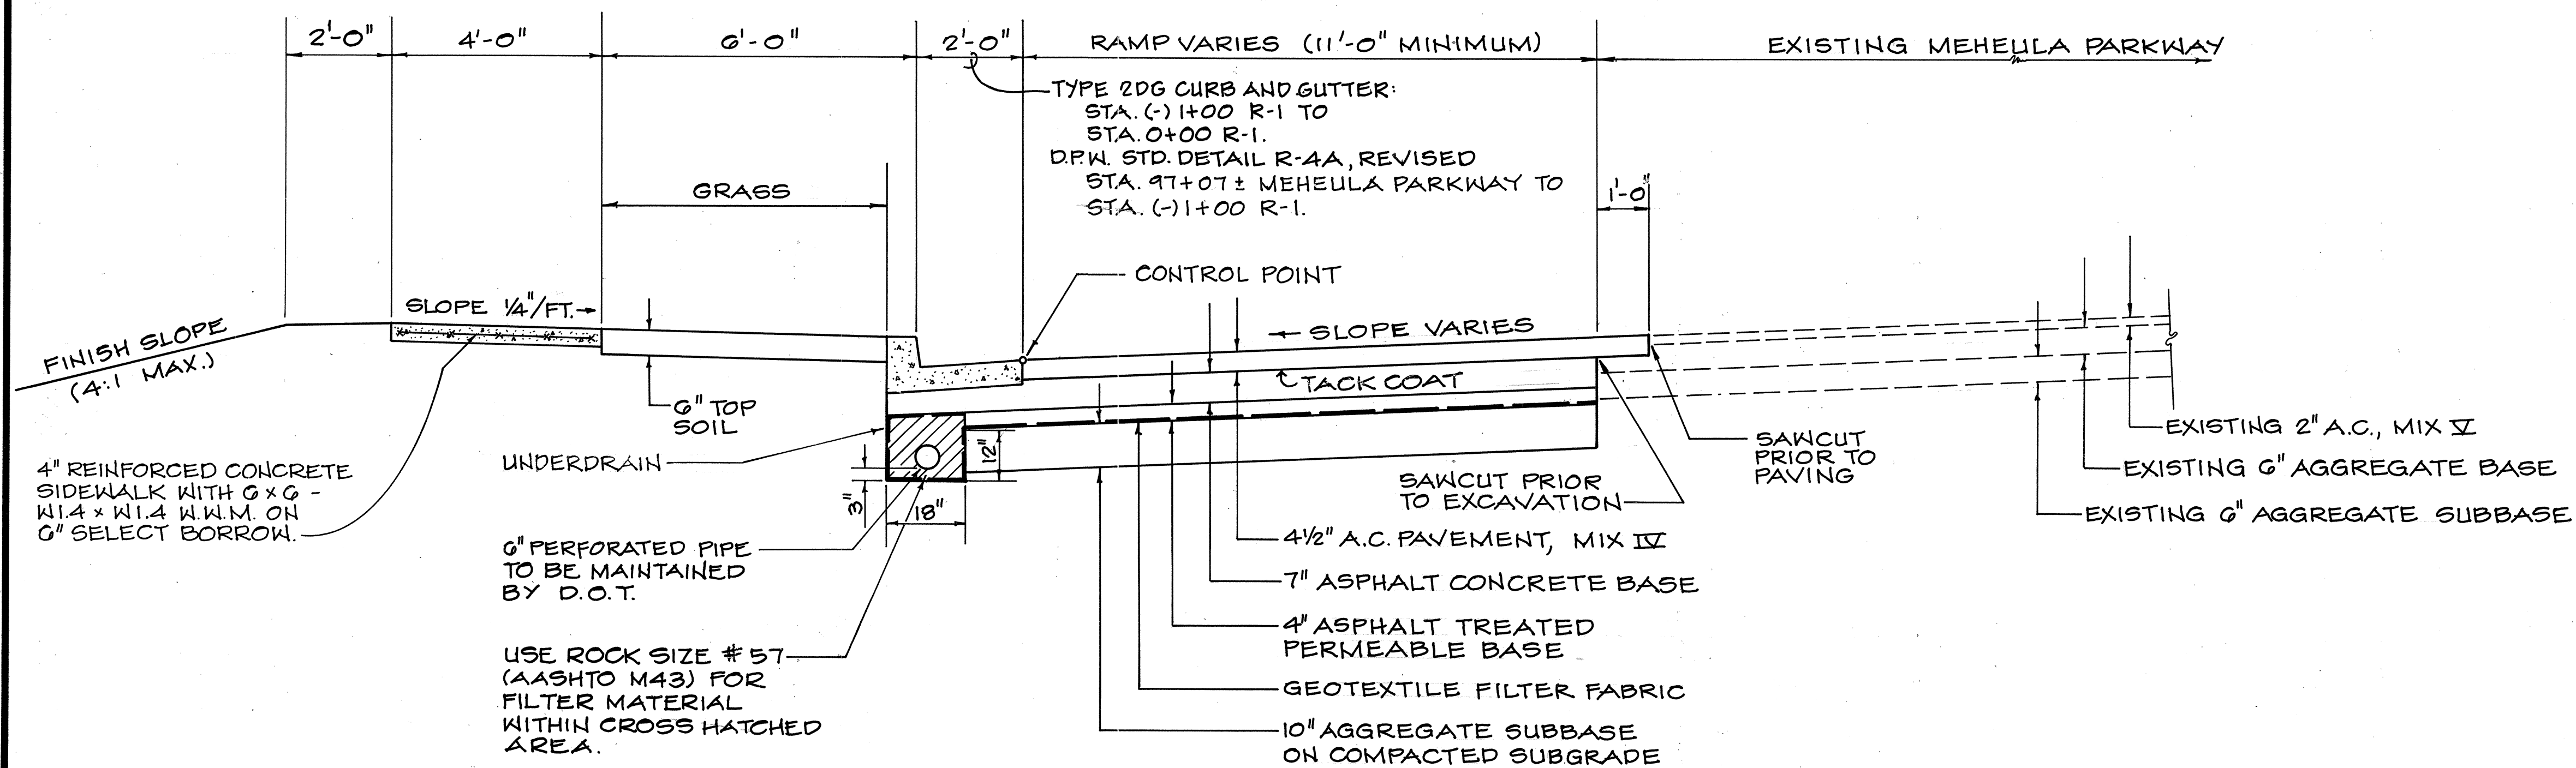

DETAIL
STA. (-)1+50 TO STA. 0+00 (±) RAMP R-1

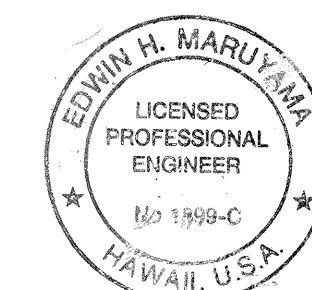

THIS WORK WAS PREPARED BY
ME OR UNDER MY SUPERVISION
By: *Edwin H. Maruyama*
Fujita & Associates

STATE OF HAWAII
DEPARTMENT OF TRANSPORTATION
HIGHWAYS DIVISION

RAMP R-1 SECTIONS


INTERSTATE ROUTE H-2
MILILANI INTERCHANGE
SOUTHBOUND ON-AND-OFF-RAMPS
F.A.I. Proj. No. IM-H2-1 (29)

SCALE: 1/2" = 1'-0" DATE: MAR. 1997


SHEET NO. 21 OF 9 SHEETS

"AS-BUILT" 25


FED. ROAD DIST. NO.	STATE	FED. AID PROJ. NO.	FISCAL YEAR	SHEET NO.	TOTAL SHEETS
HAWAII	HAW.	IM-H2-1(29)	1997	26	129

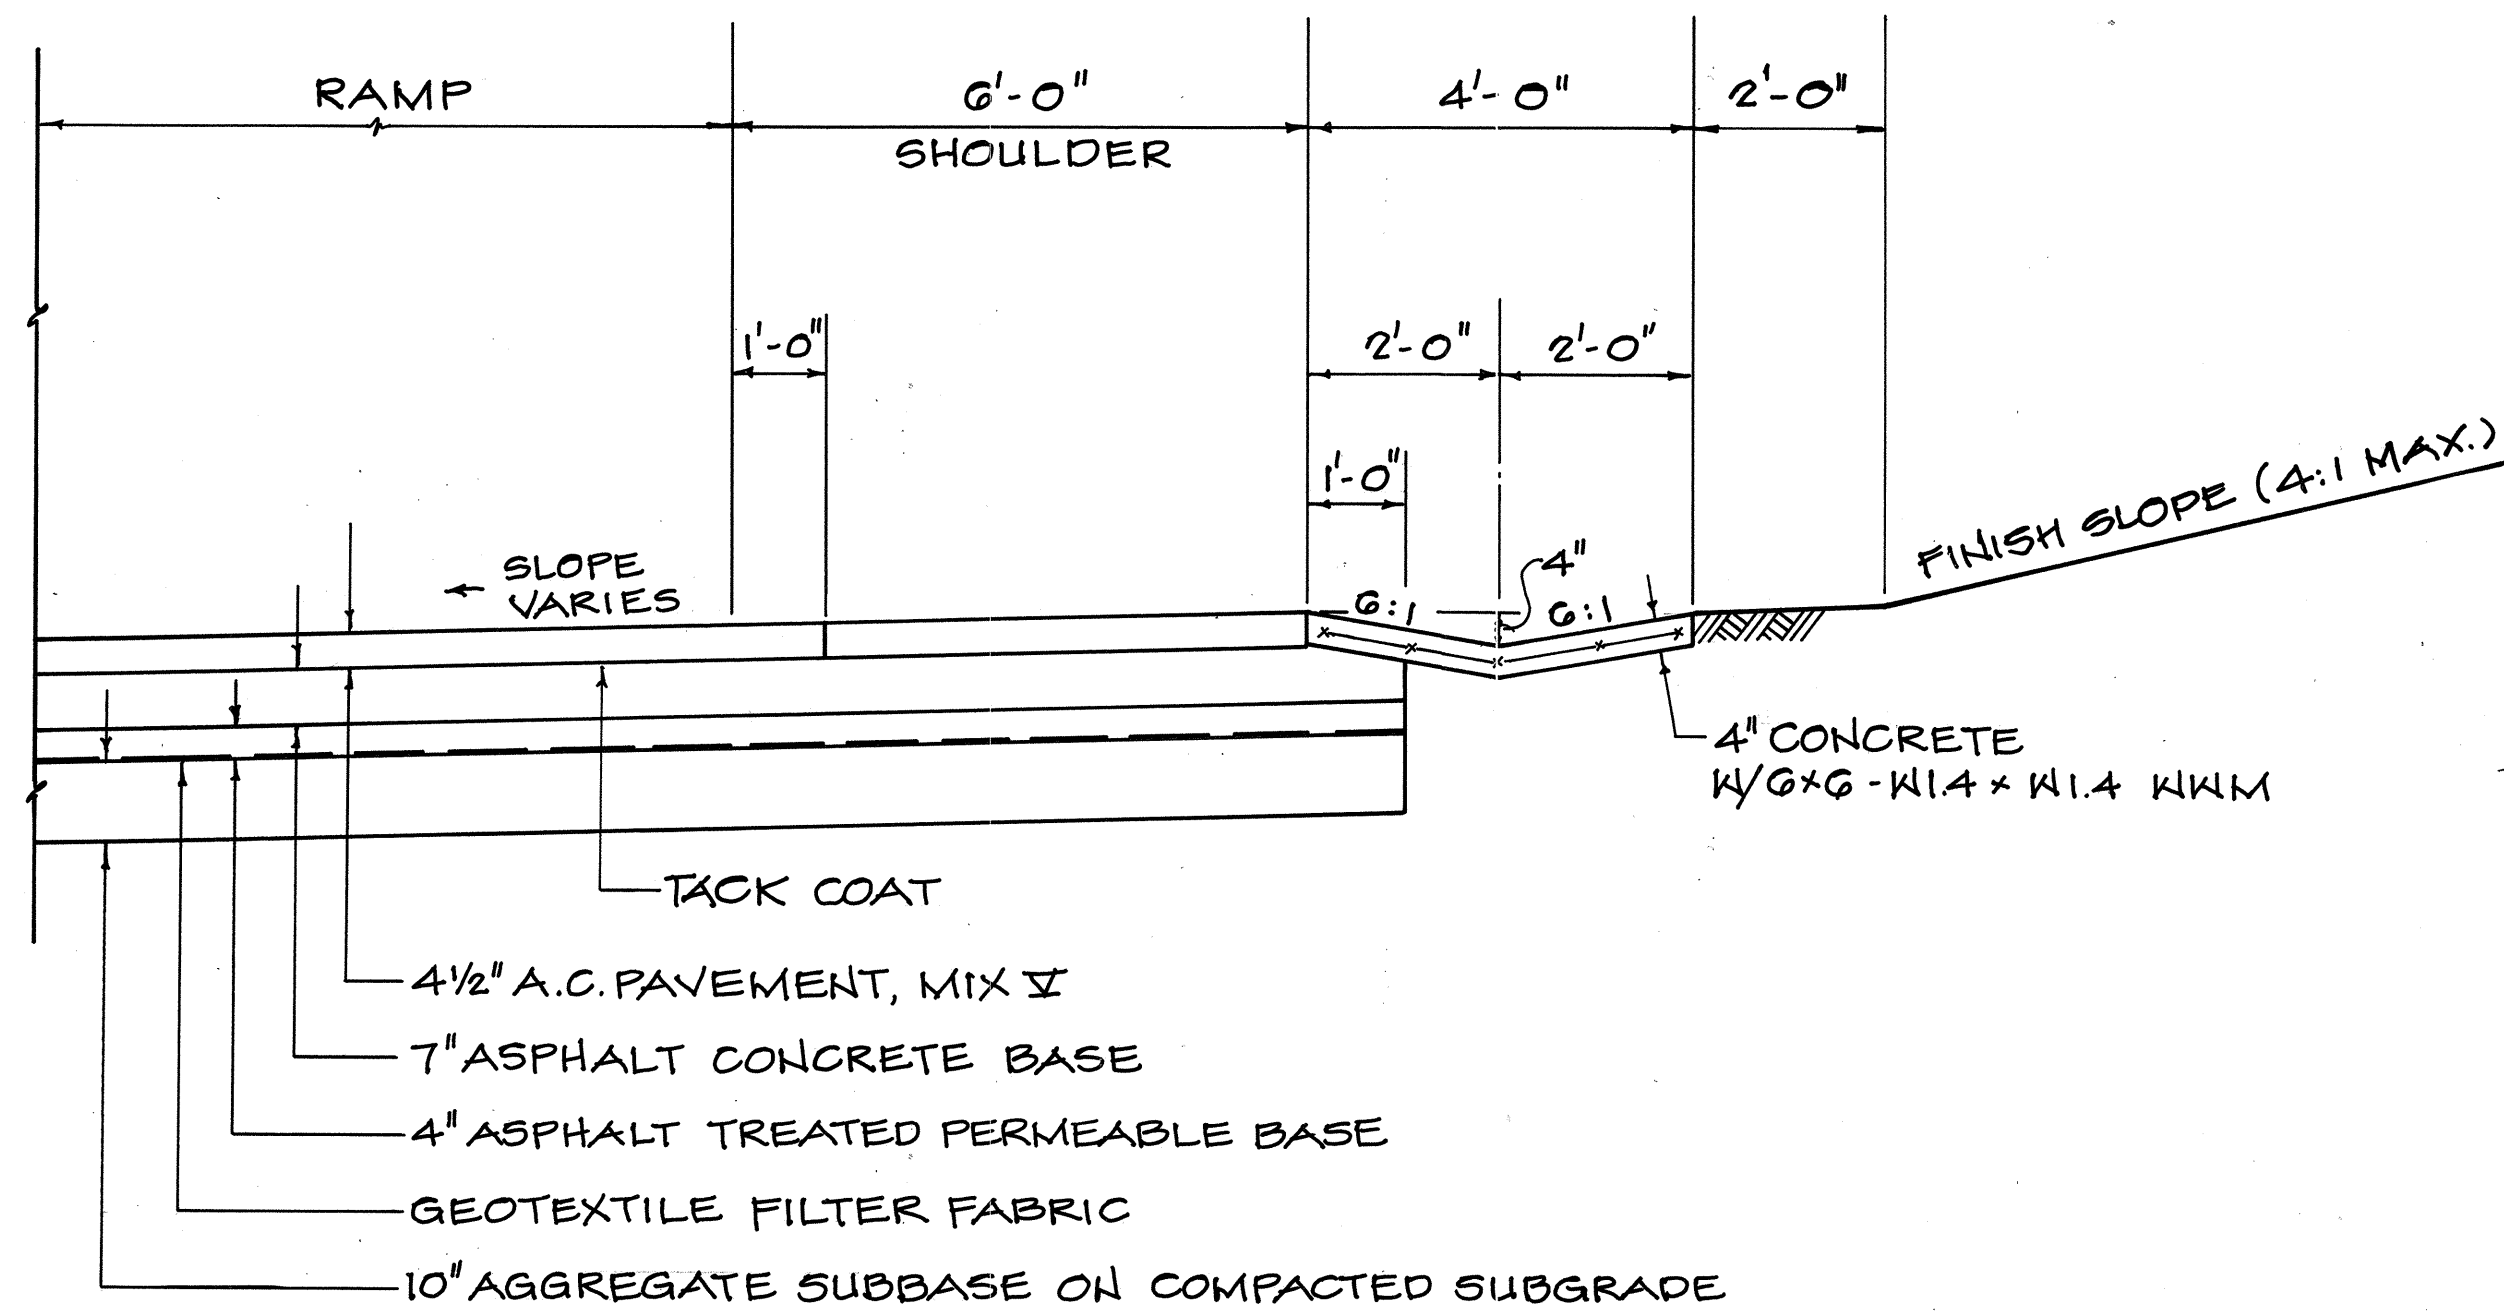


RIGHT HALF SECTION RAMP R-1
STA. 1+60(±) TO STA. 2+80

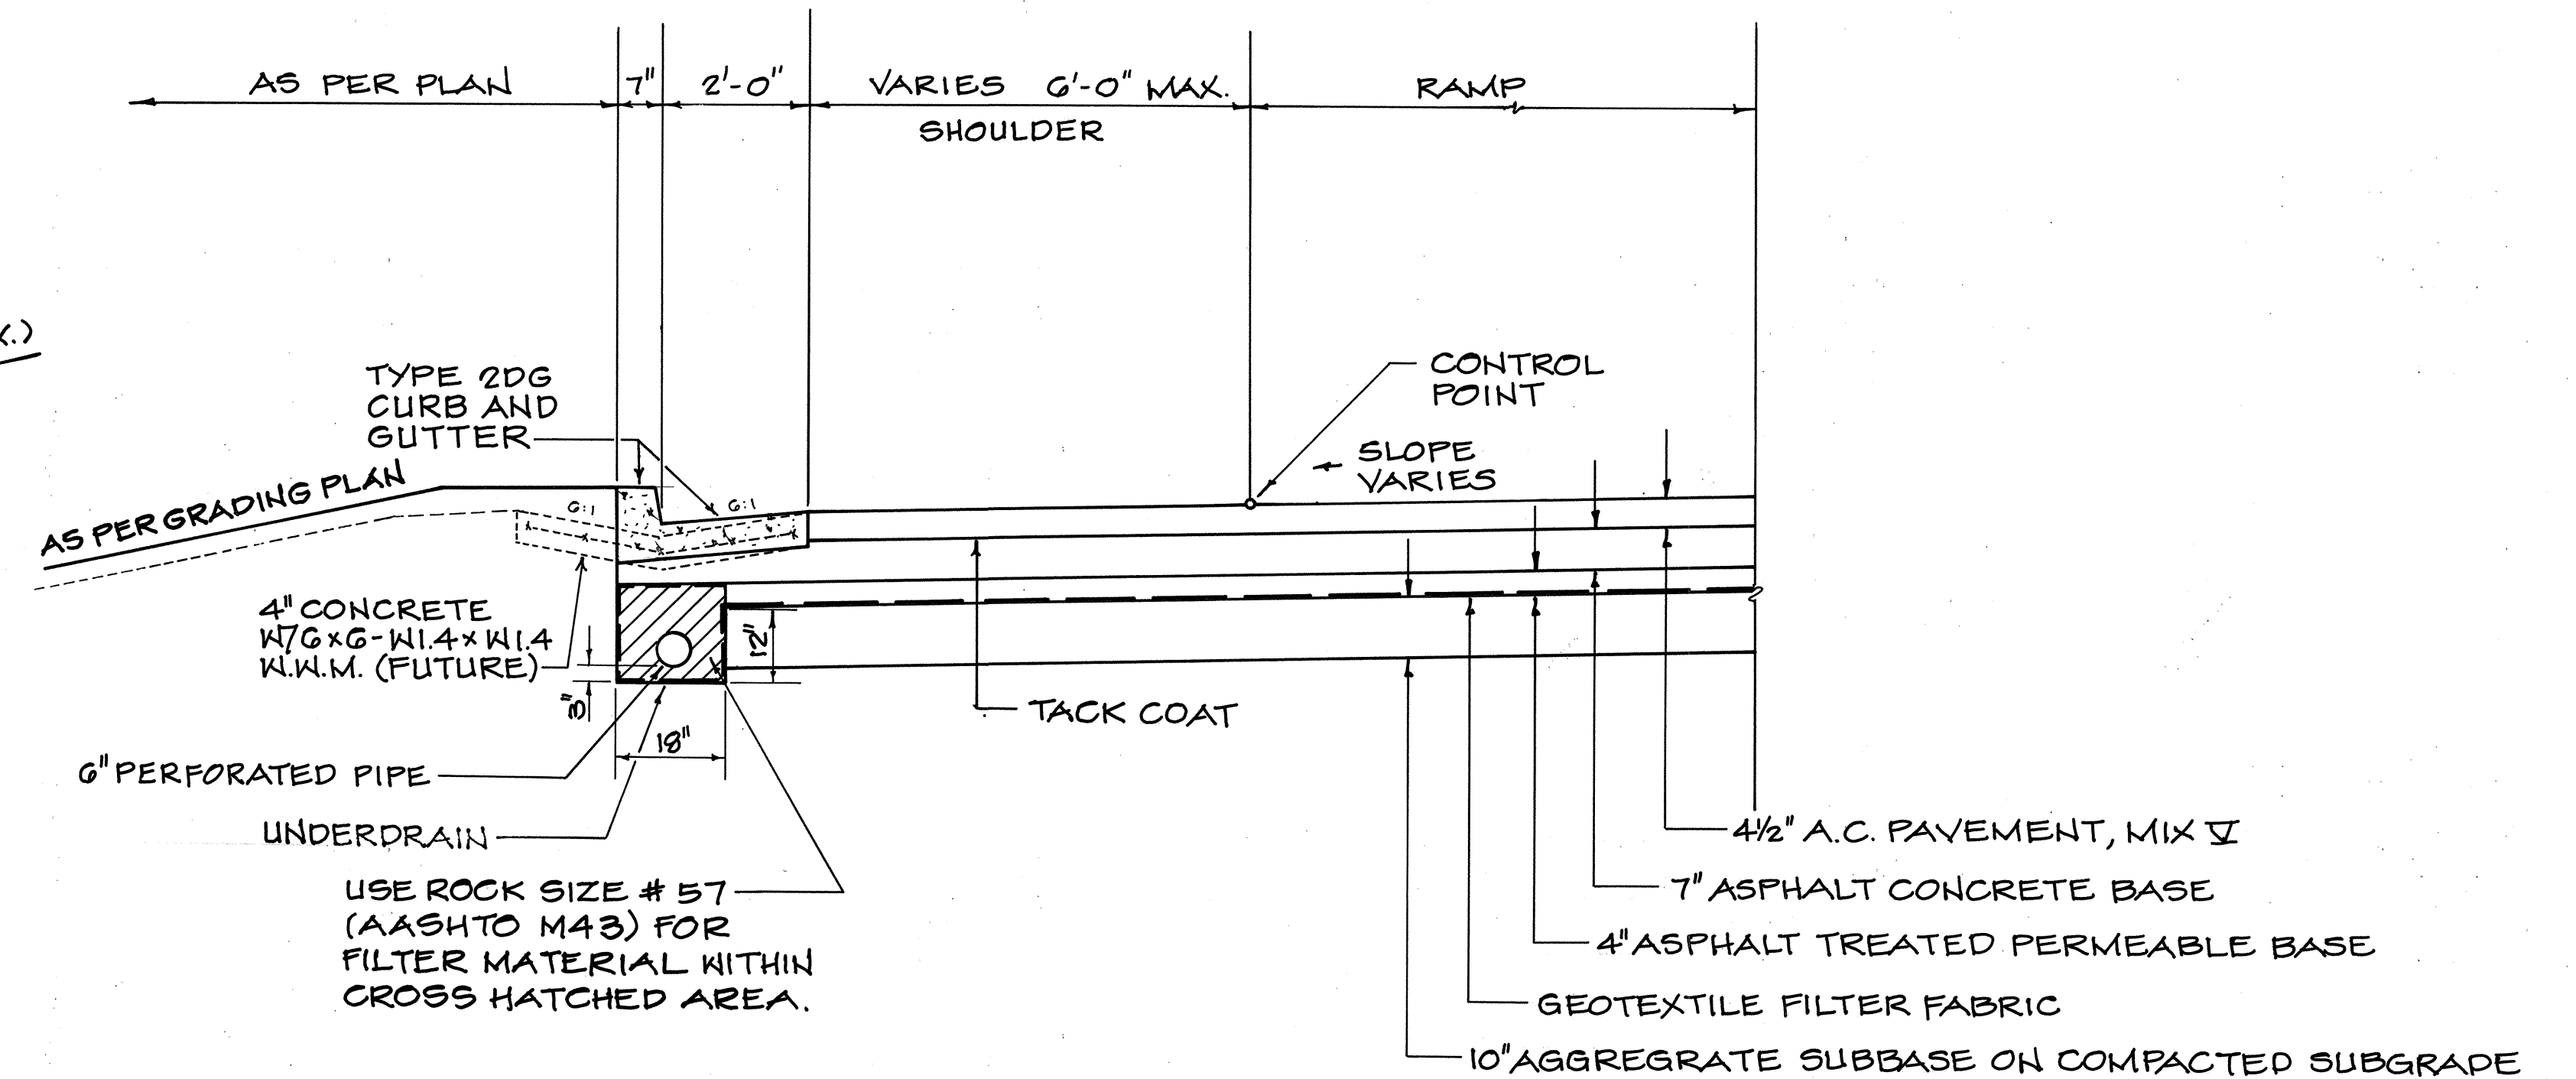

LEFT HALF SECTION RAMP R-1
STA. 1+60(±) TO STA. 3+60

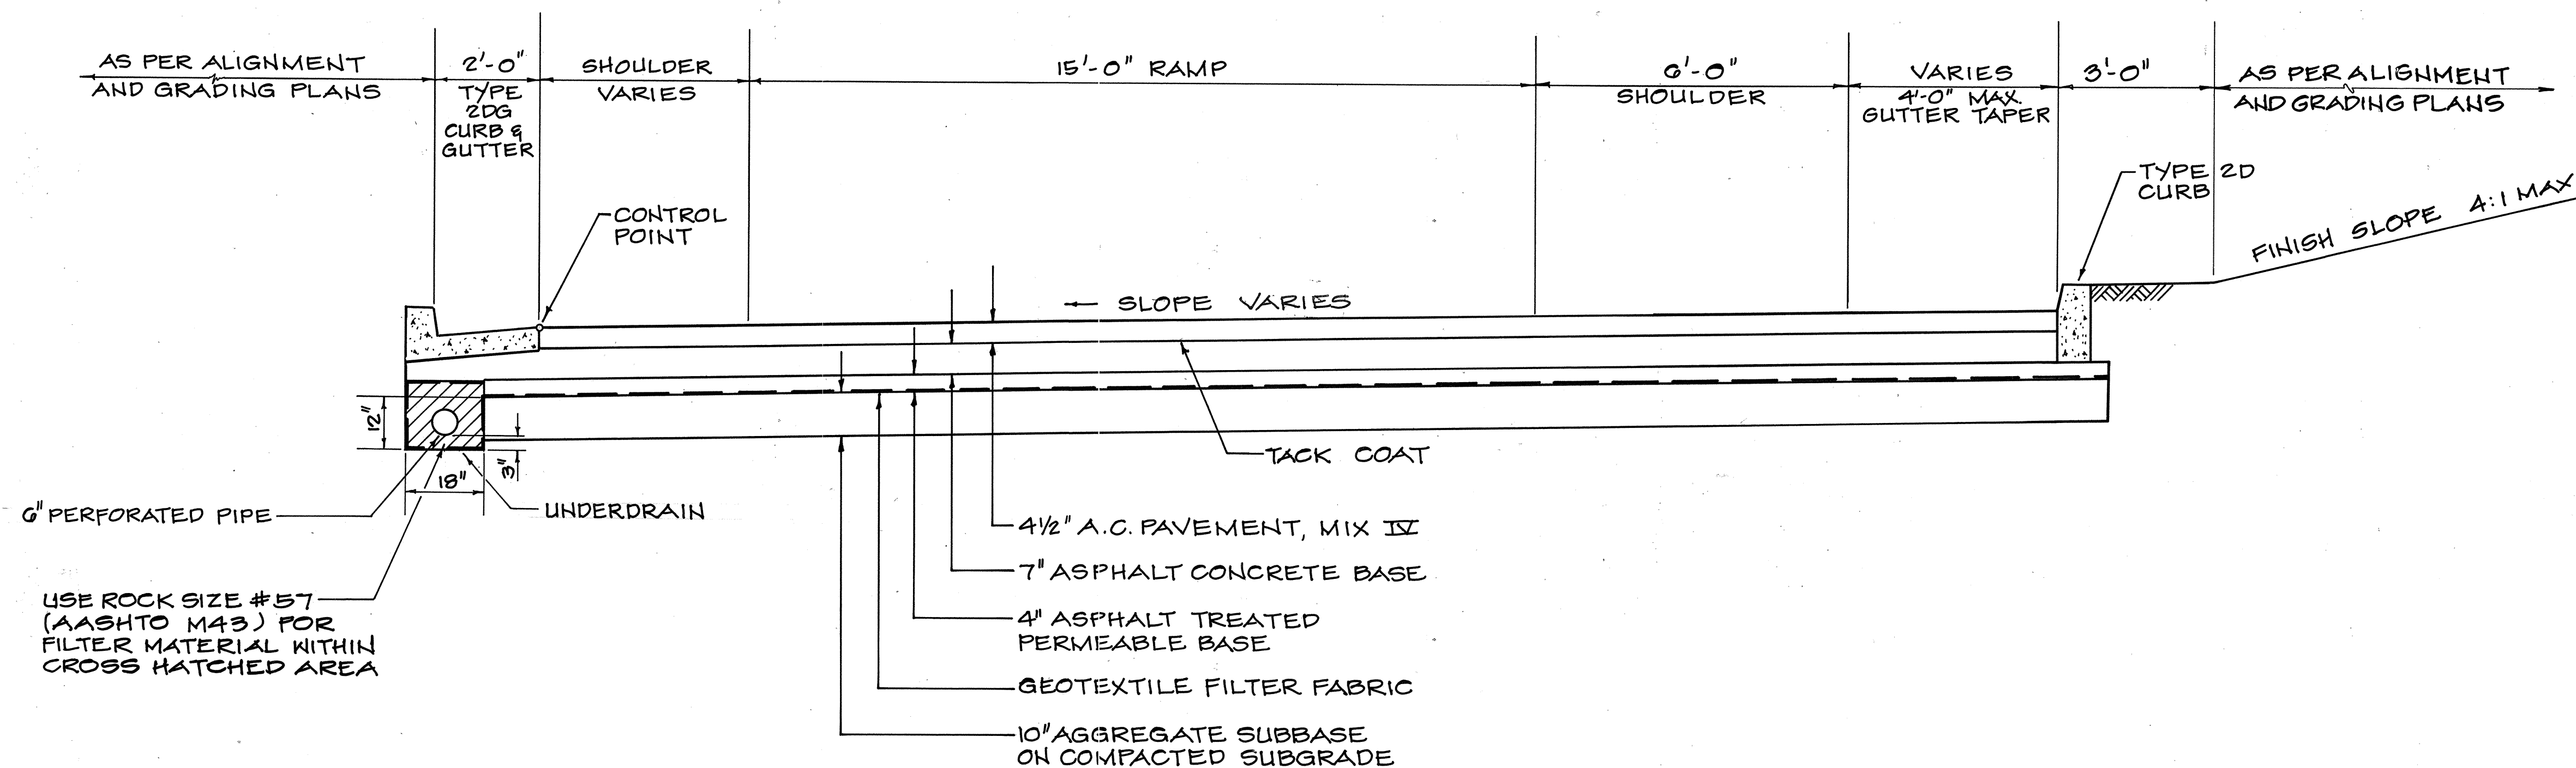

DETAIL
STA. 0+72(±) TO STA. 1+60(±) RAMP R-1

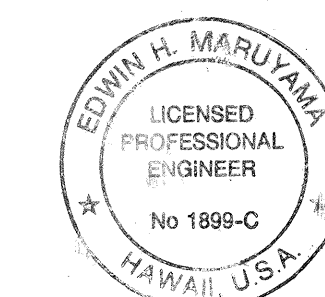

THIS WORK WAS PREPARED BY
ME OR UNDER MY SUPERVISION
By: *Edwin H. Maruyama*
Fujita & Associates

STATE OF HAWAII
DEPARTMENT OF TRANSPORTATION
HIGHWAYS DIVISION


RAMP R-1 SECTIONS

INTERSTATE ROUTE H-2
MILILANI INTERCHANGE
SOUTHBOUND ON-AND-OFF-RAMPS
F.A.I. Proj. No. IM-H2-1(29)


SCALE: 1/2" = 1'-0" DATE: MAR. 1997

SHEET NO. S2 OF 9 SHEETS


FED. ROAD DIST. NO.	STATE	FED. AID PROJ. NO.	FISCAL YEAR	SHEET NO.	TOTAL SHEETS
HAWAII	HAW.	IM-H2-1(29)	1997	27	129

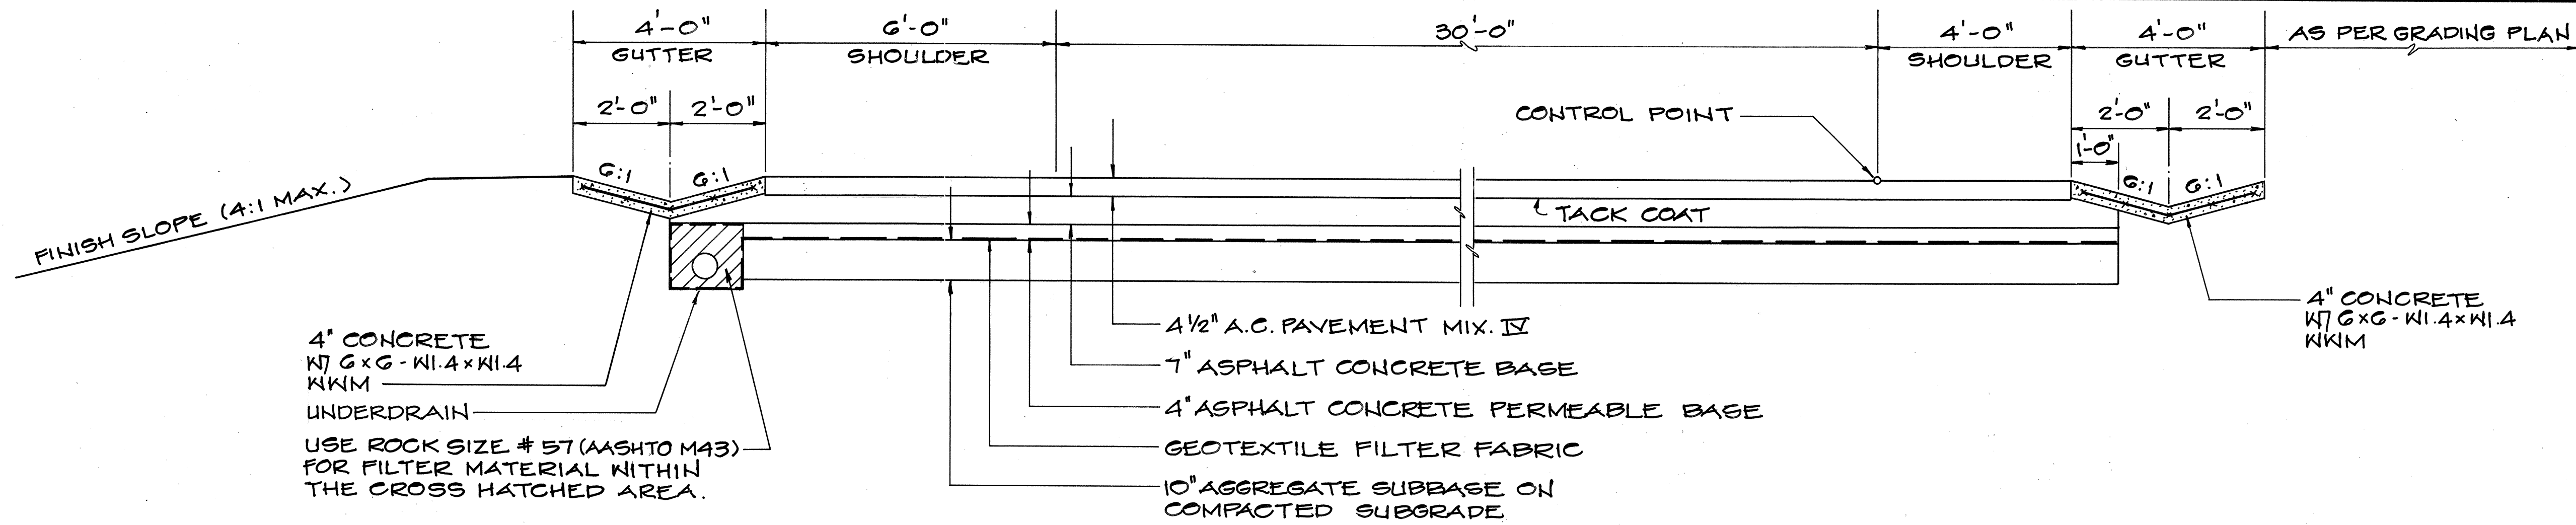

DETAIL
STA. 1+16 TO STA. 1+76 RAMP R-2

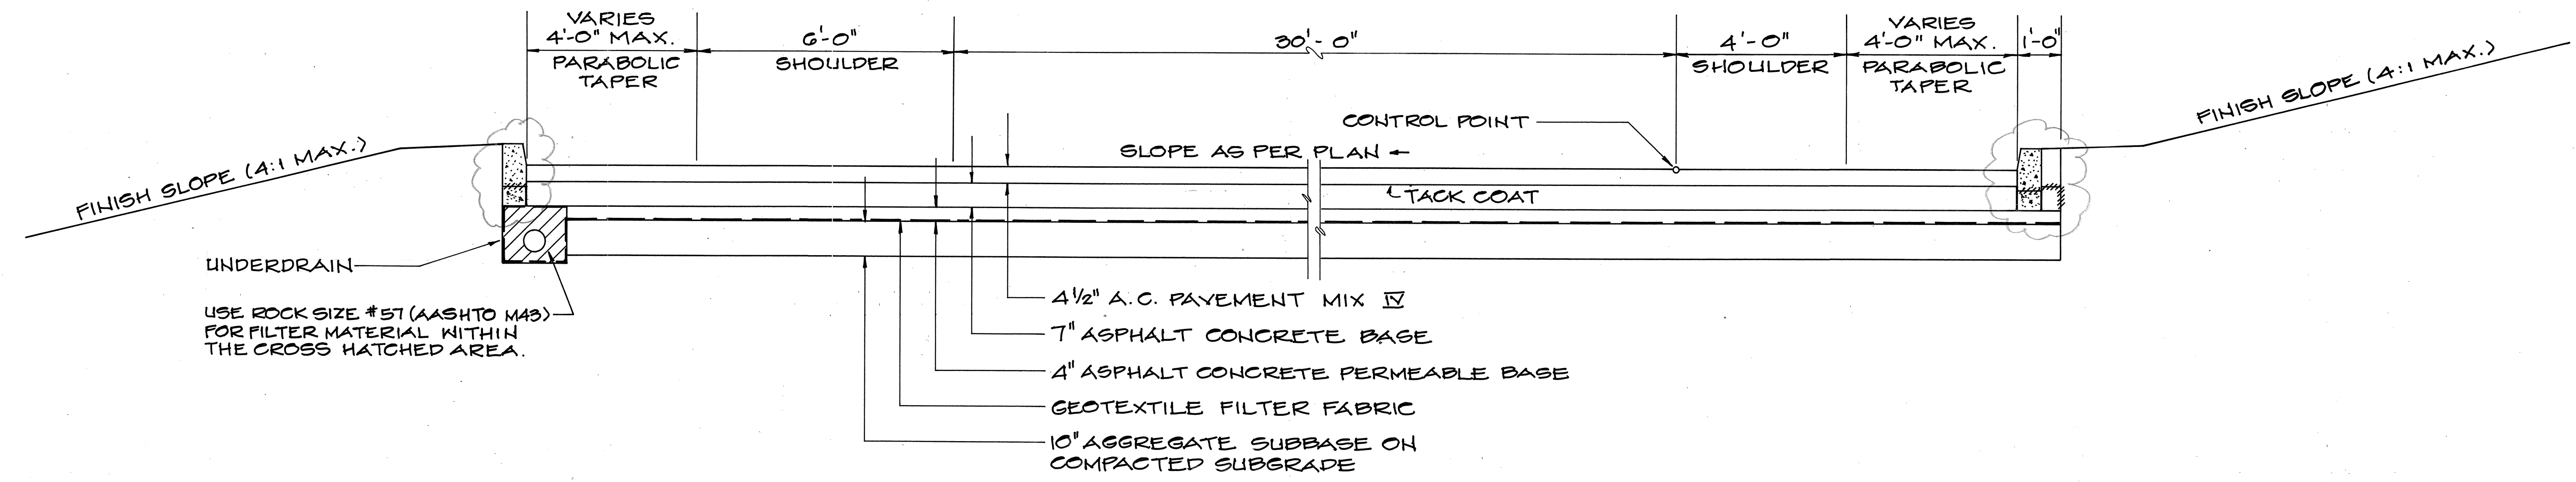

DETAIL
STA. 0+46 TO STA. 1+16 RAMP R-2

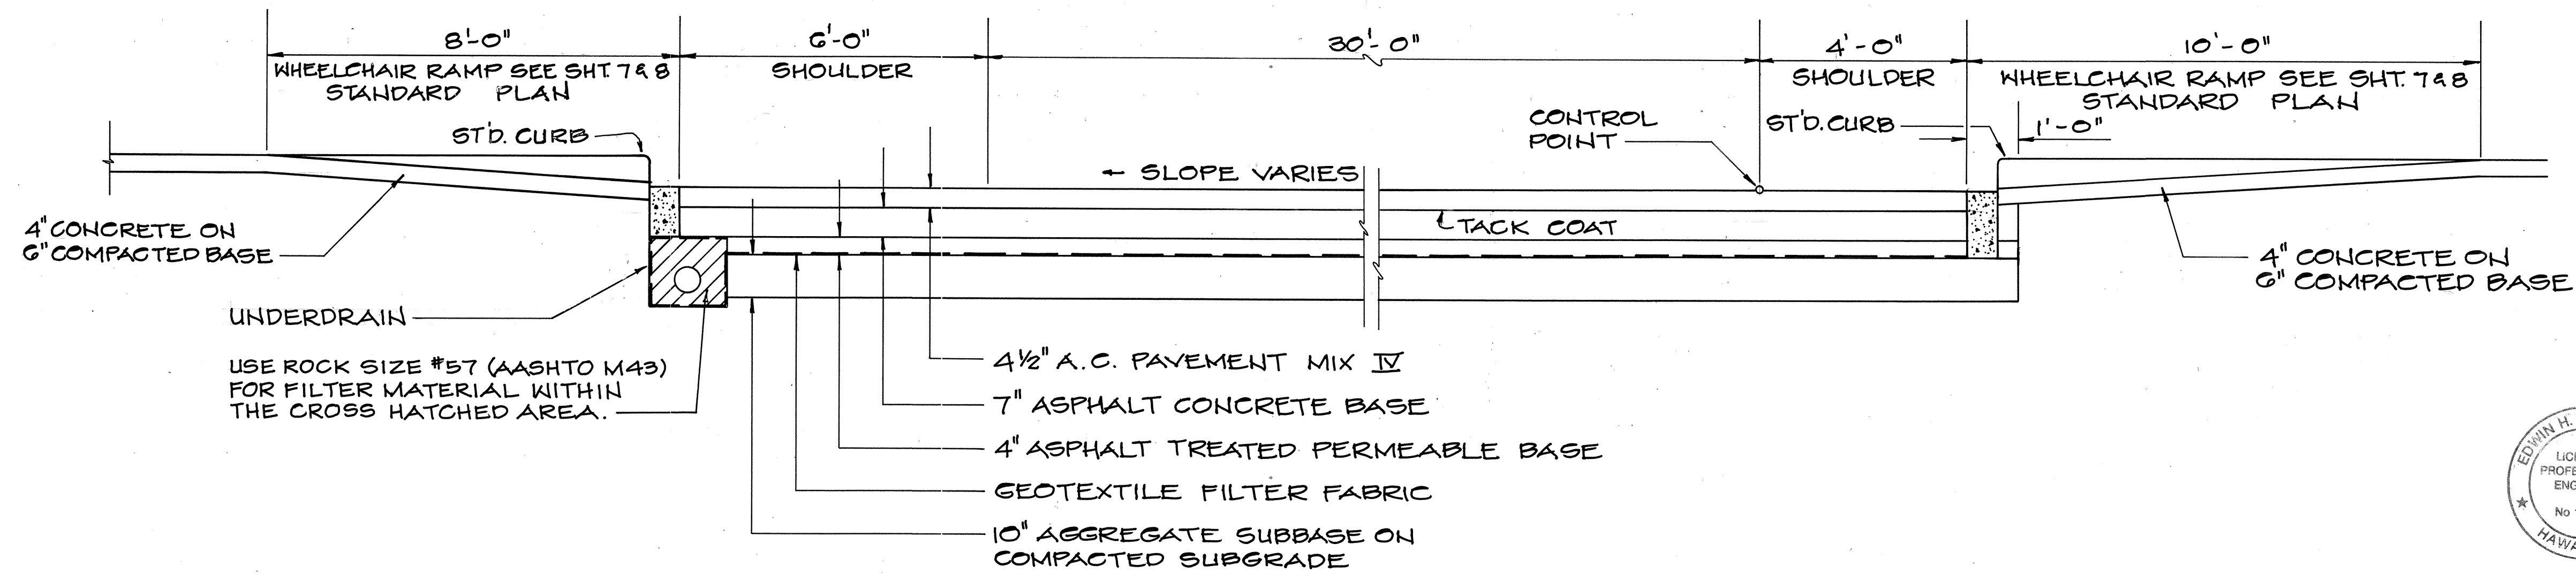

DETAIL
STA. 0+44 RAMP R-2



THIS WORK WAS PREPARED BY
ME OR UNDER MY SUPERVISION
By: *John H. Nguyen*
FUTATA & ASSOCIATES

STATE OF HAWAII
DEPARTMENT OF TRANSPORTATION
HIGHWAYS DIVISION


RAMP R-2 SECTIONS

INTERSTATE ROUTE H-2
MILILANI INTERCHANGE
SOUTHBOUND ON-AND-OFF-RAMPS
F.A.I. Proj. No. IM-H2-1(29)


SCALE: 1/2" = 1'-0" DATE: MAR. 1997

SHEET NO. 33 OF 9 SHEETS


FED. ROAD DIST. NO.	STATE	FED. AID PROJ. NO.	FISCAL YEAR	SHEET NO.	TOTAL SHEETS
HAWAII	HAW.	IM-H2-1(29)	1997	28	129

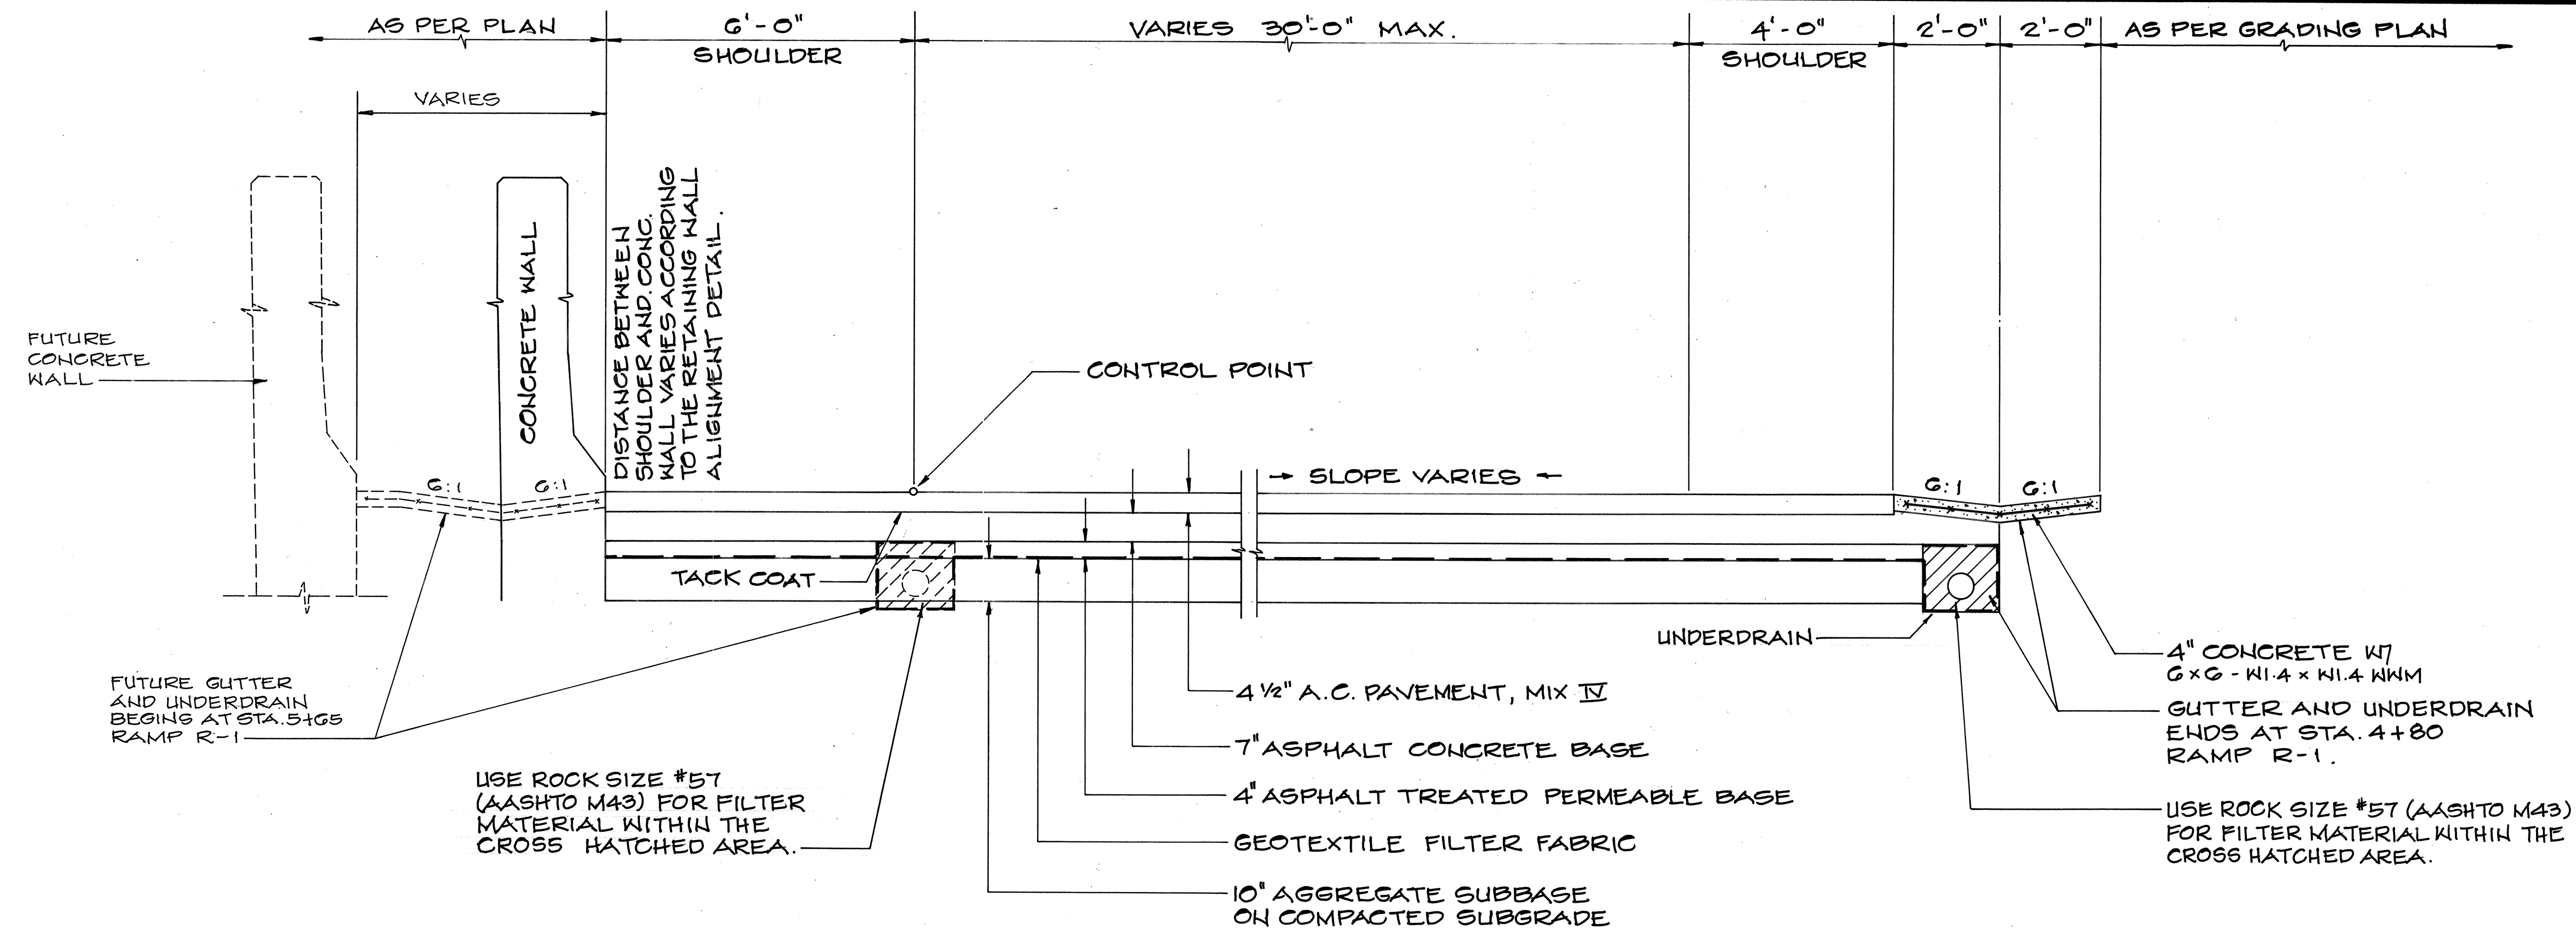

DETAIL STA. 4+26.13 TO END RAMP R-1

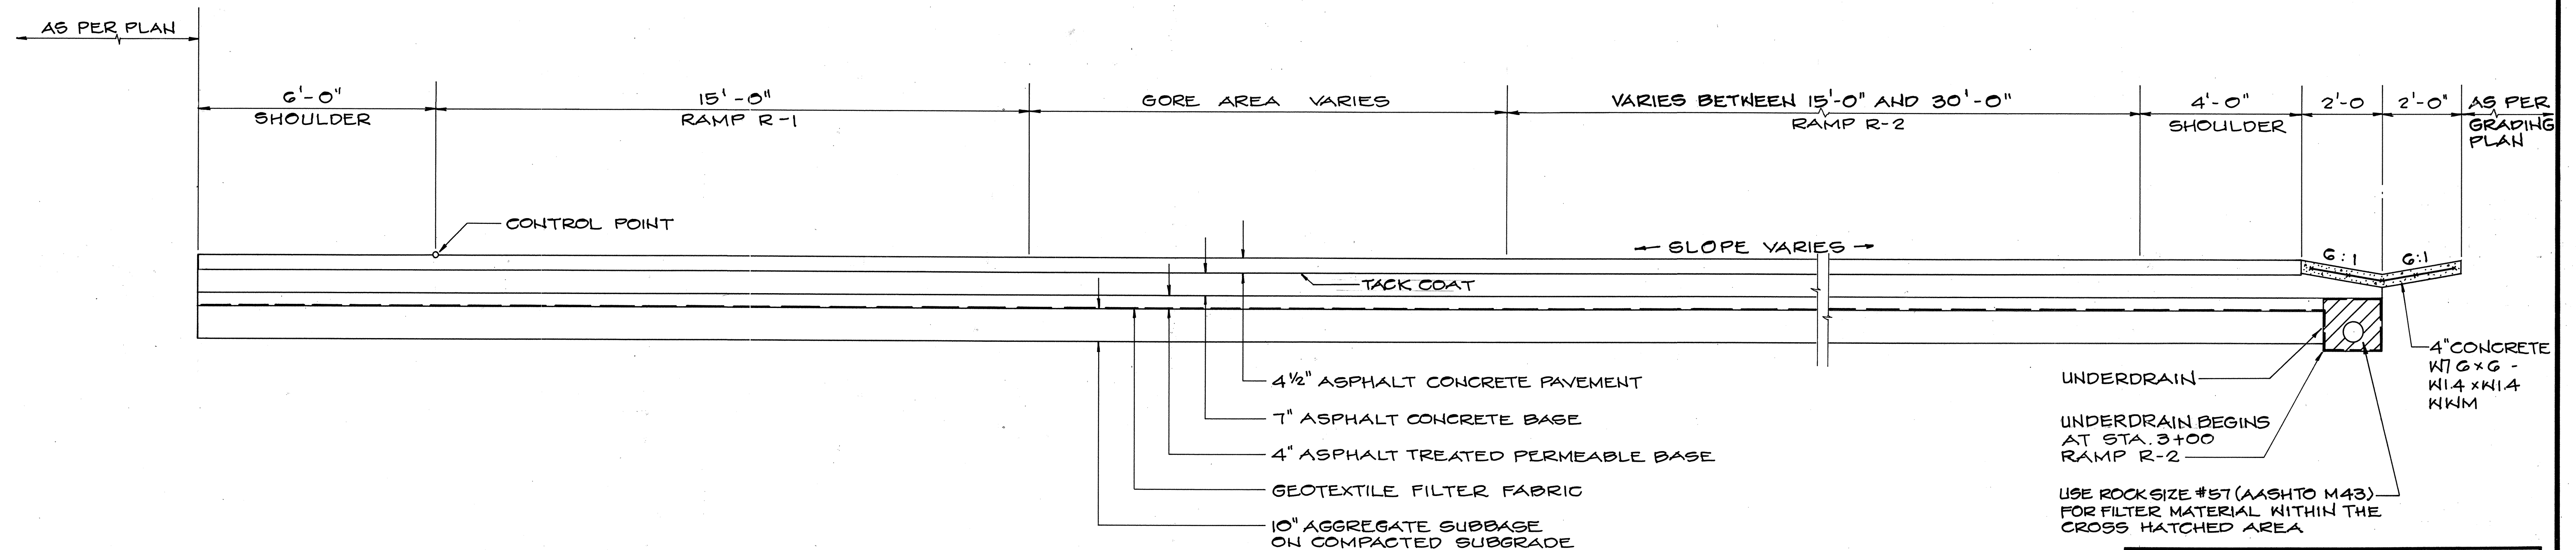

DETAIL STA. 3+13.00 TO STA. 4+26.13 RAMP R-1 STA. 2+12.00 TO STA. 3+15.53 RAMP R-2

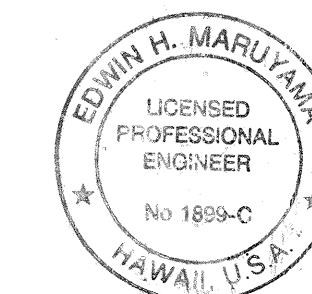

THIS WORK WAS PREPARED BY
ME OR UNDER MY SUPERVISION

By: *Edwin H. Maruyama*
Fujita & Associates

STATE OF HAWAII
DEPARTMENT OF TRANSPORTATION
HIGHWAYS DIVISION

RAMP R-1/R-2 SECTIONS

INTERSTATE ROUTE H-2
MILILANI INTERCHANGE
SOUTHBOUND ON-AND-OFF-RAMPS
F.A.I. Proj. No. IM-H2-1(29)


SCALE: 1/2" = 1'-0" DATE: MAR. 1997

SHEET NO. 54 OF 9 SHEETS


"AS-BUILT" 28

DATE	
SURVEY PLOTTED BY	
DRAWN BY	
CHECKED BY	
NOTED BY	
QUANTITIES BY	
CHECKED BY	
ORIGINAL PLAN	
NOTE BOOK	
No.	

FED. ROAD DIST. NO.	STATE	FED. AID PROJ. NO.	FISCAL YEAR	SHEET NO.	TOTAL SHEETS
HAWAII	HAW.	IM-H2-1(29)	1997	29	129

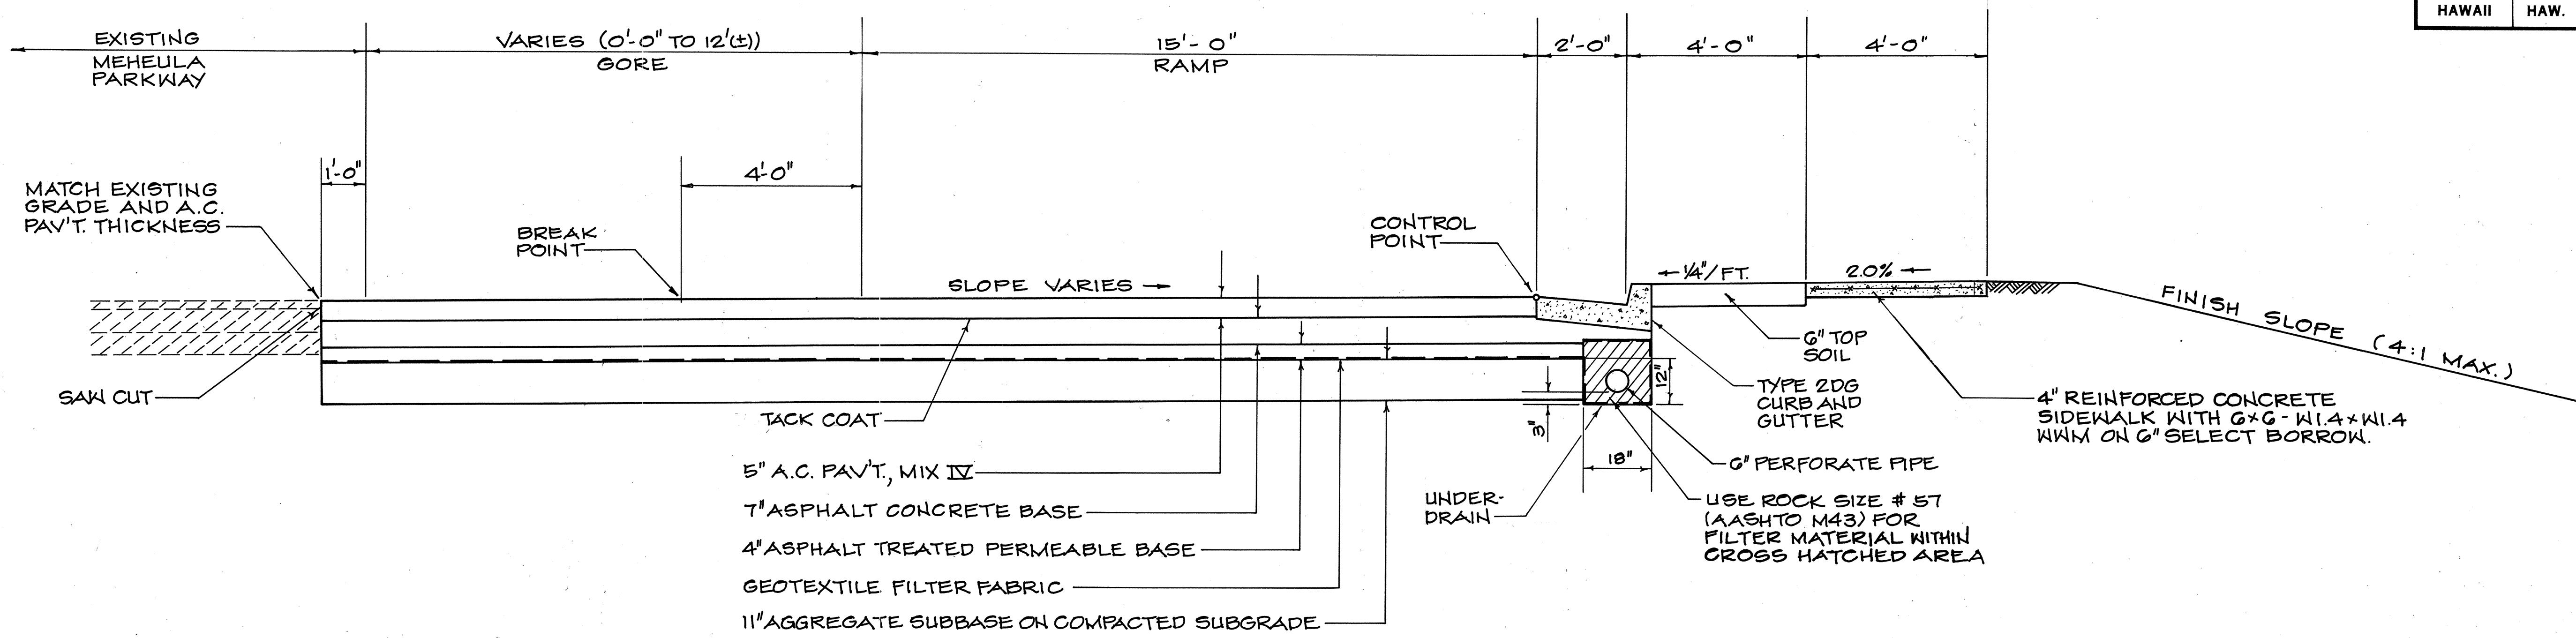

DETAIL
STA. 1+58(±) TO STA. 2+22(±) RAMP R-3

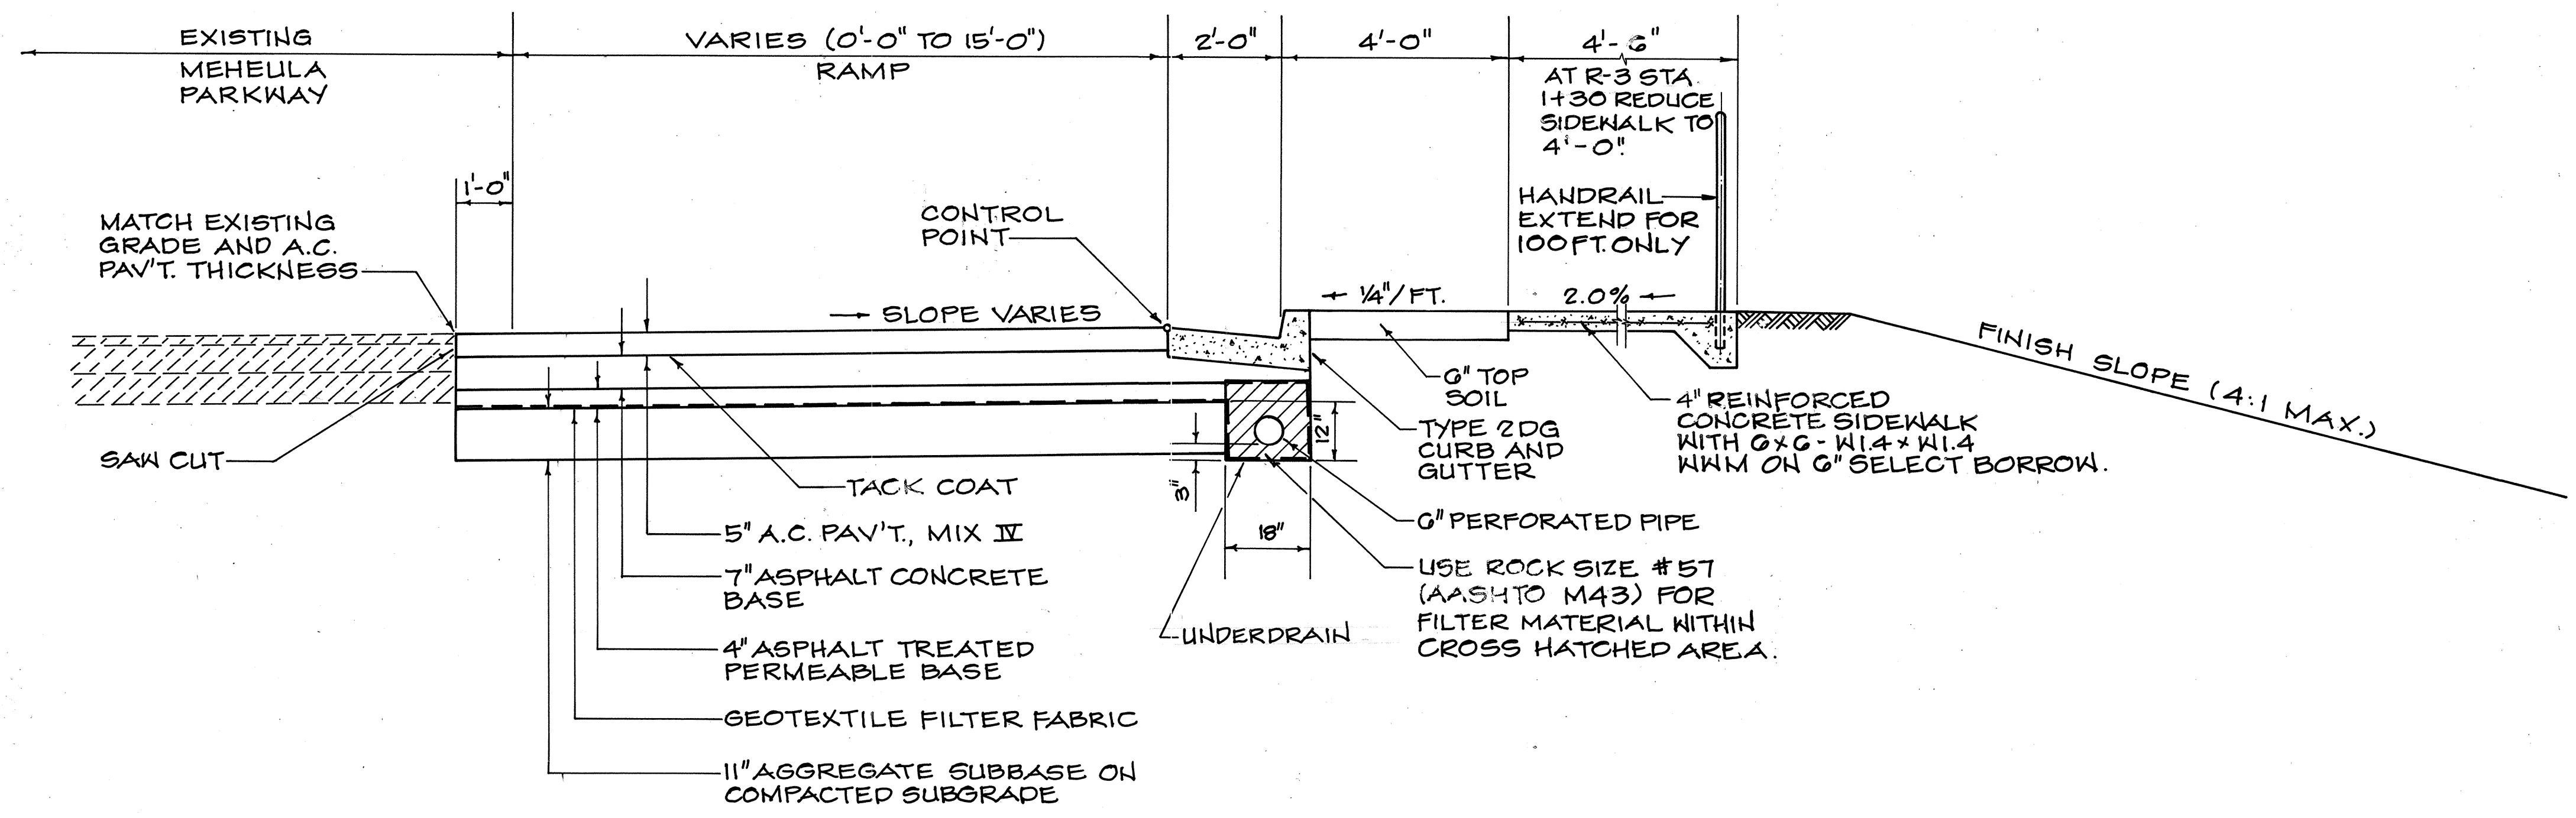

DETAIL
STA. 0+00 TO STA. 1+58(±) RAMP R-3



THIS WORK WAS PREPARED BY
ME OR UNDER MY SUPERVISION
By: *Edwin H. Maruyama*
RUIITA & ASSOCIATES

STATE OF HAWAII
DEPARTMENT OF TRANSPORTATION
HIGHWAYS DIVISION

RAMP R-3 SECTIONS

INTERSTATE ROUTE H-2
MILILANI INTERCHANGE
SOUTHBOUND ON-AND-OFF-RAMPS
F.A.I. Proj. No. IM-H2-1(29)


SCALE: 1/2" = 1'-0" DATE: MAR. 1997

SHEET NO. 55 OF 9 SHEETS

ORIGINAL PLAN	SURVEY PLOTTED BY _____ DATE _____
NOTE BOOK	DRAWN BY _____
	TRACED BY _____
	DESIGNED BY _____
	QUANTITIES BY _____
No. _____	CHECKED BY _____




FED. ROAD DIST. NO.	STATE	FED. AID PROJ. NO.	FISCAL YEAR	SHEET NO.	TOTAL SHEETS
HAWAII	HAW.	IM-H2-1(29)	1997	31	129

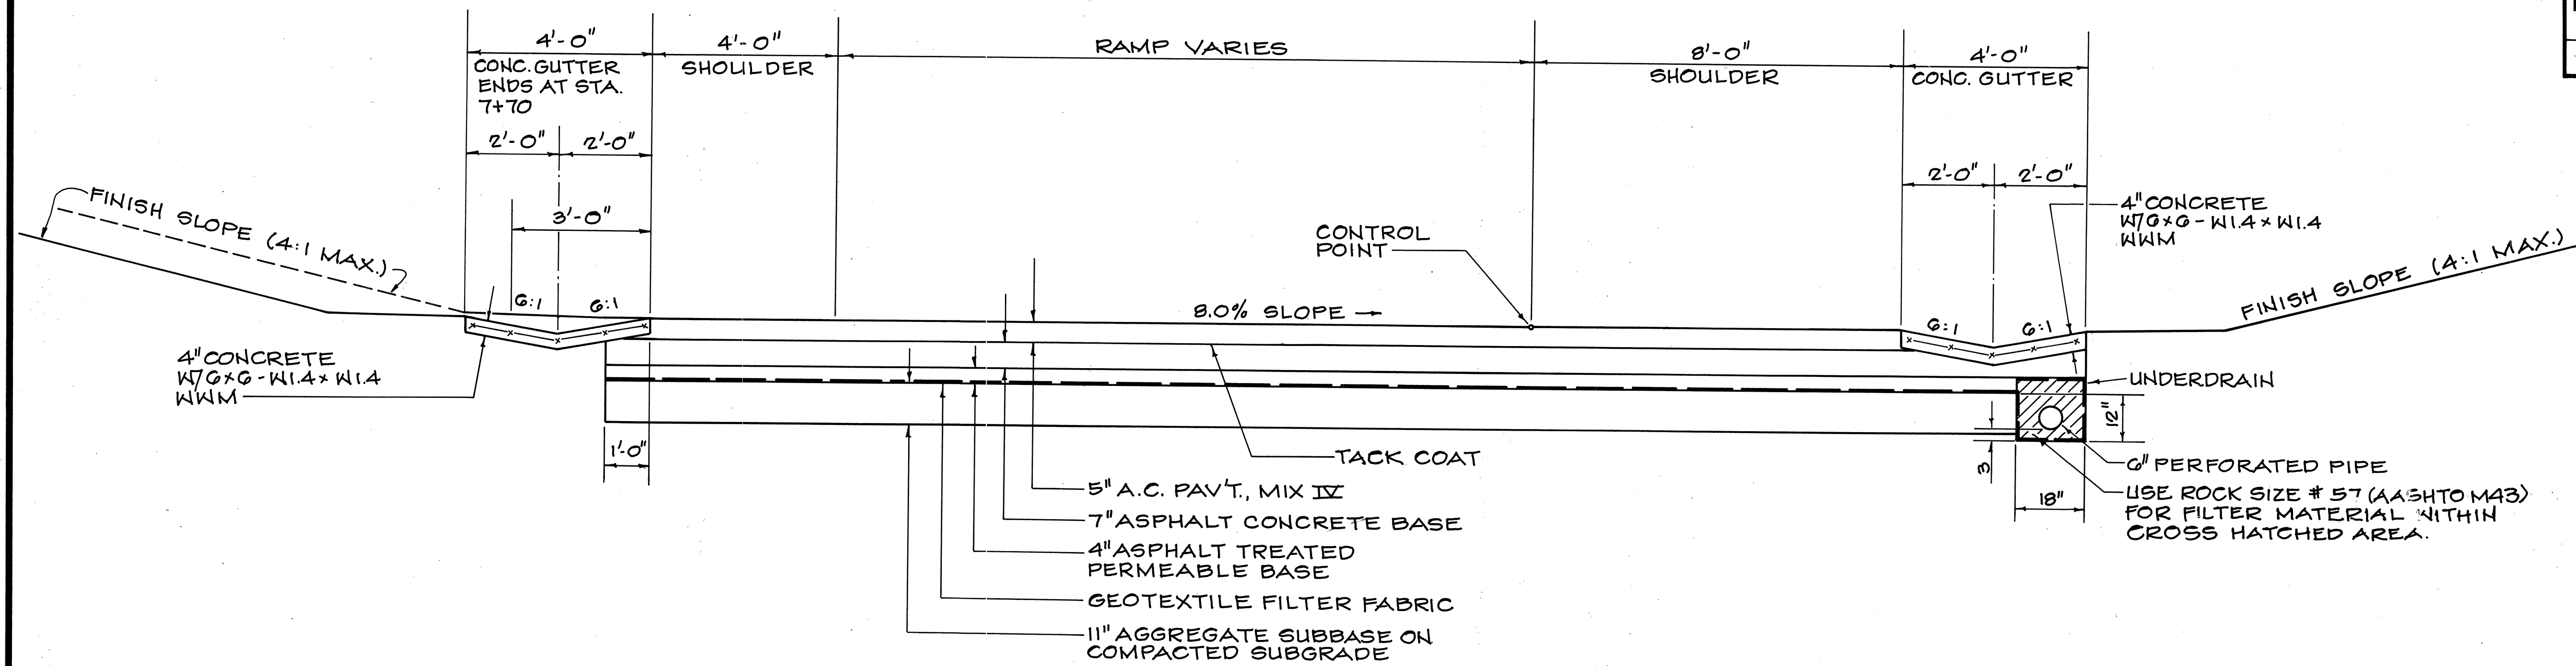

DETAIL

STA. 6+00 TO STA. 8+00 RAMP R-3

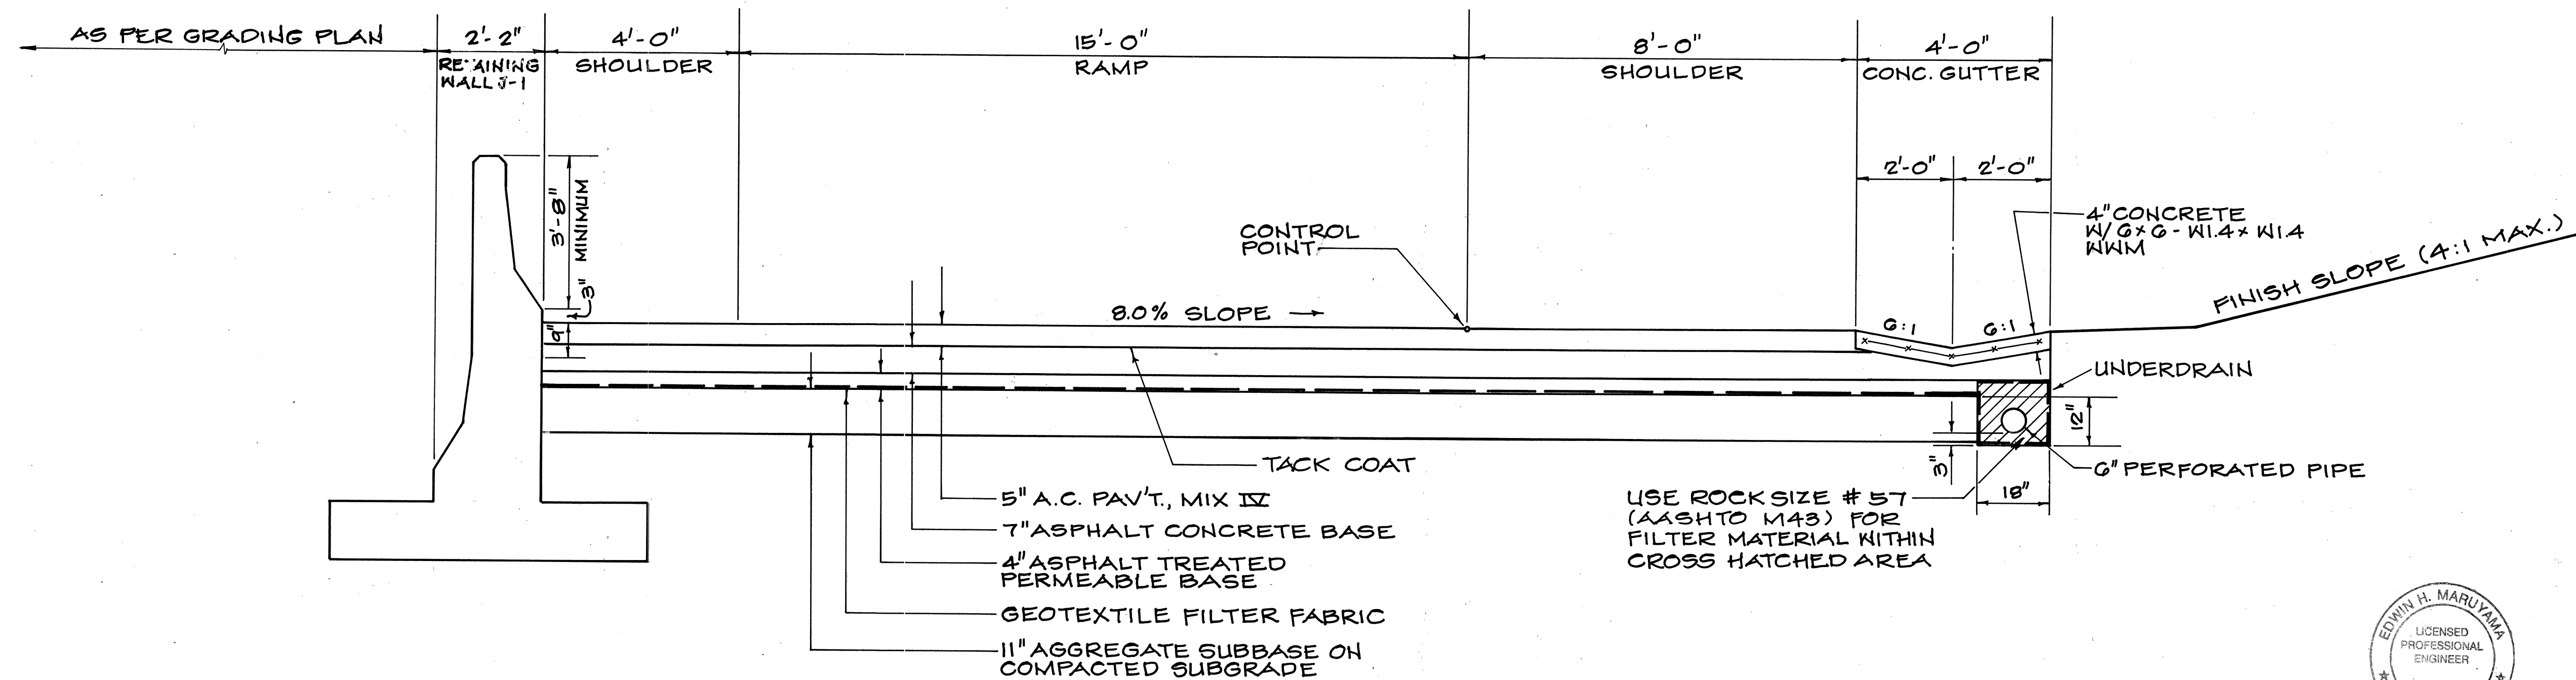

DETAIL

STA. 3+50 TO STA. 6+00 RAMP R-3



THIS WORK WAS PREPARED BY
ME OR UNDER MY SUPERVISION

By: Edwin H. Nguyen
Fujita & Associates

STATE OF HAWAII
DEPARTMENT OF TRANSPORTATION
HIGHWAYS DIVISION

RAMP R-3 SECTIONS

INTERSTATE ROUTE H-2
MILILANI INTERCHANGE
SOUTHBOUND ON-AND-OFF-RAMPS
F.A.I. Proj. No. IM-H2-1(29)


SCALE: $1/2" = 1'-0"$ DATE: MAR. 1997

SHEET No. S7 OF 9 SHEETS


"AS-BUILT" 31

31


FED. ROAD DIST. NO.	STATE	FED. AID PROJ. NO.	FISCAL YEAR	SHEET NO.	TOTAL SHEETS
HAWAII	HAW.	IM-H2-1(29)	1997	32	129

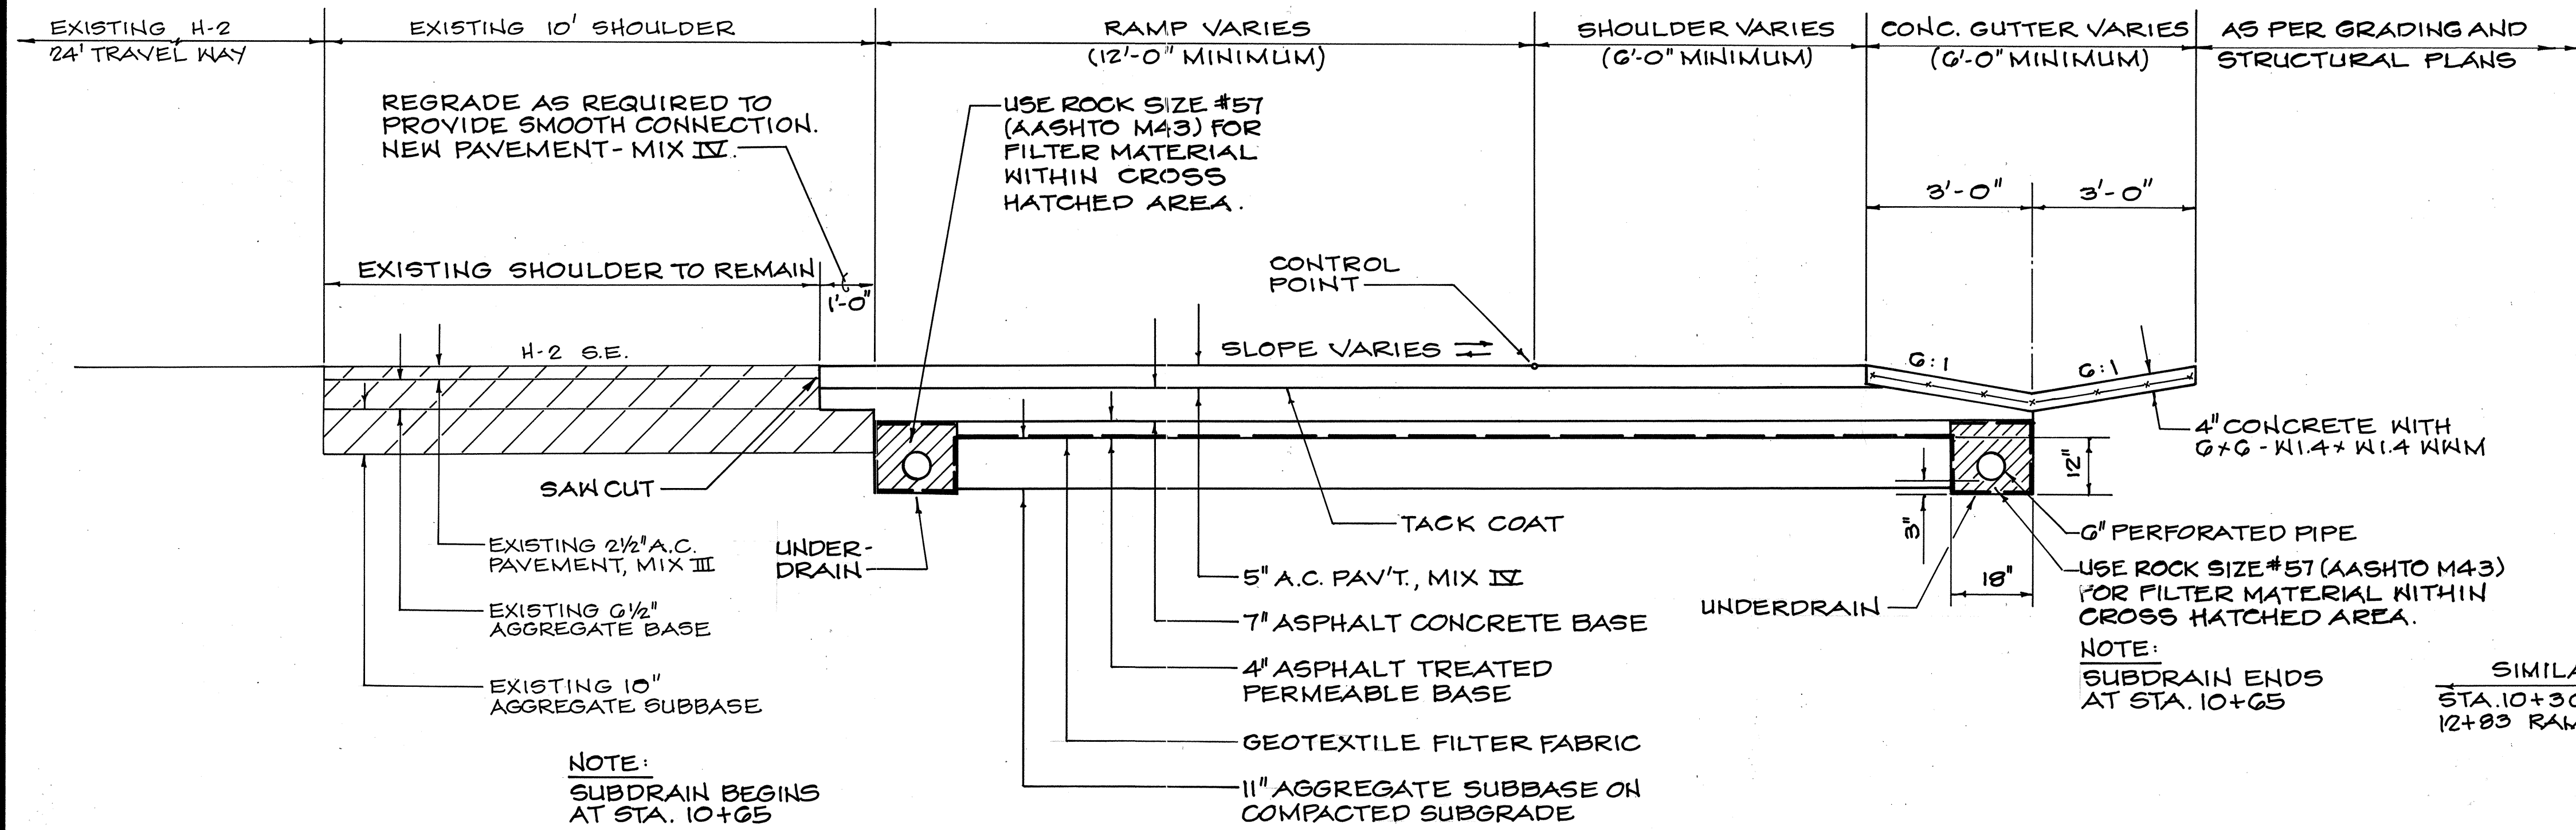


DETAIL
STA. 10+30 TO STA. 12+63 RAMP R-3

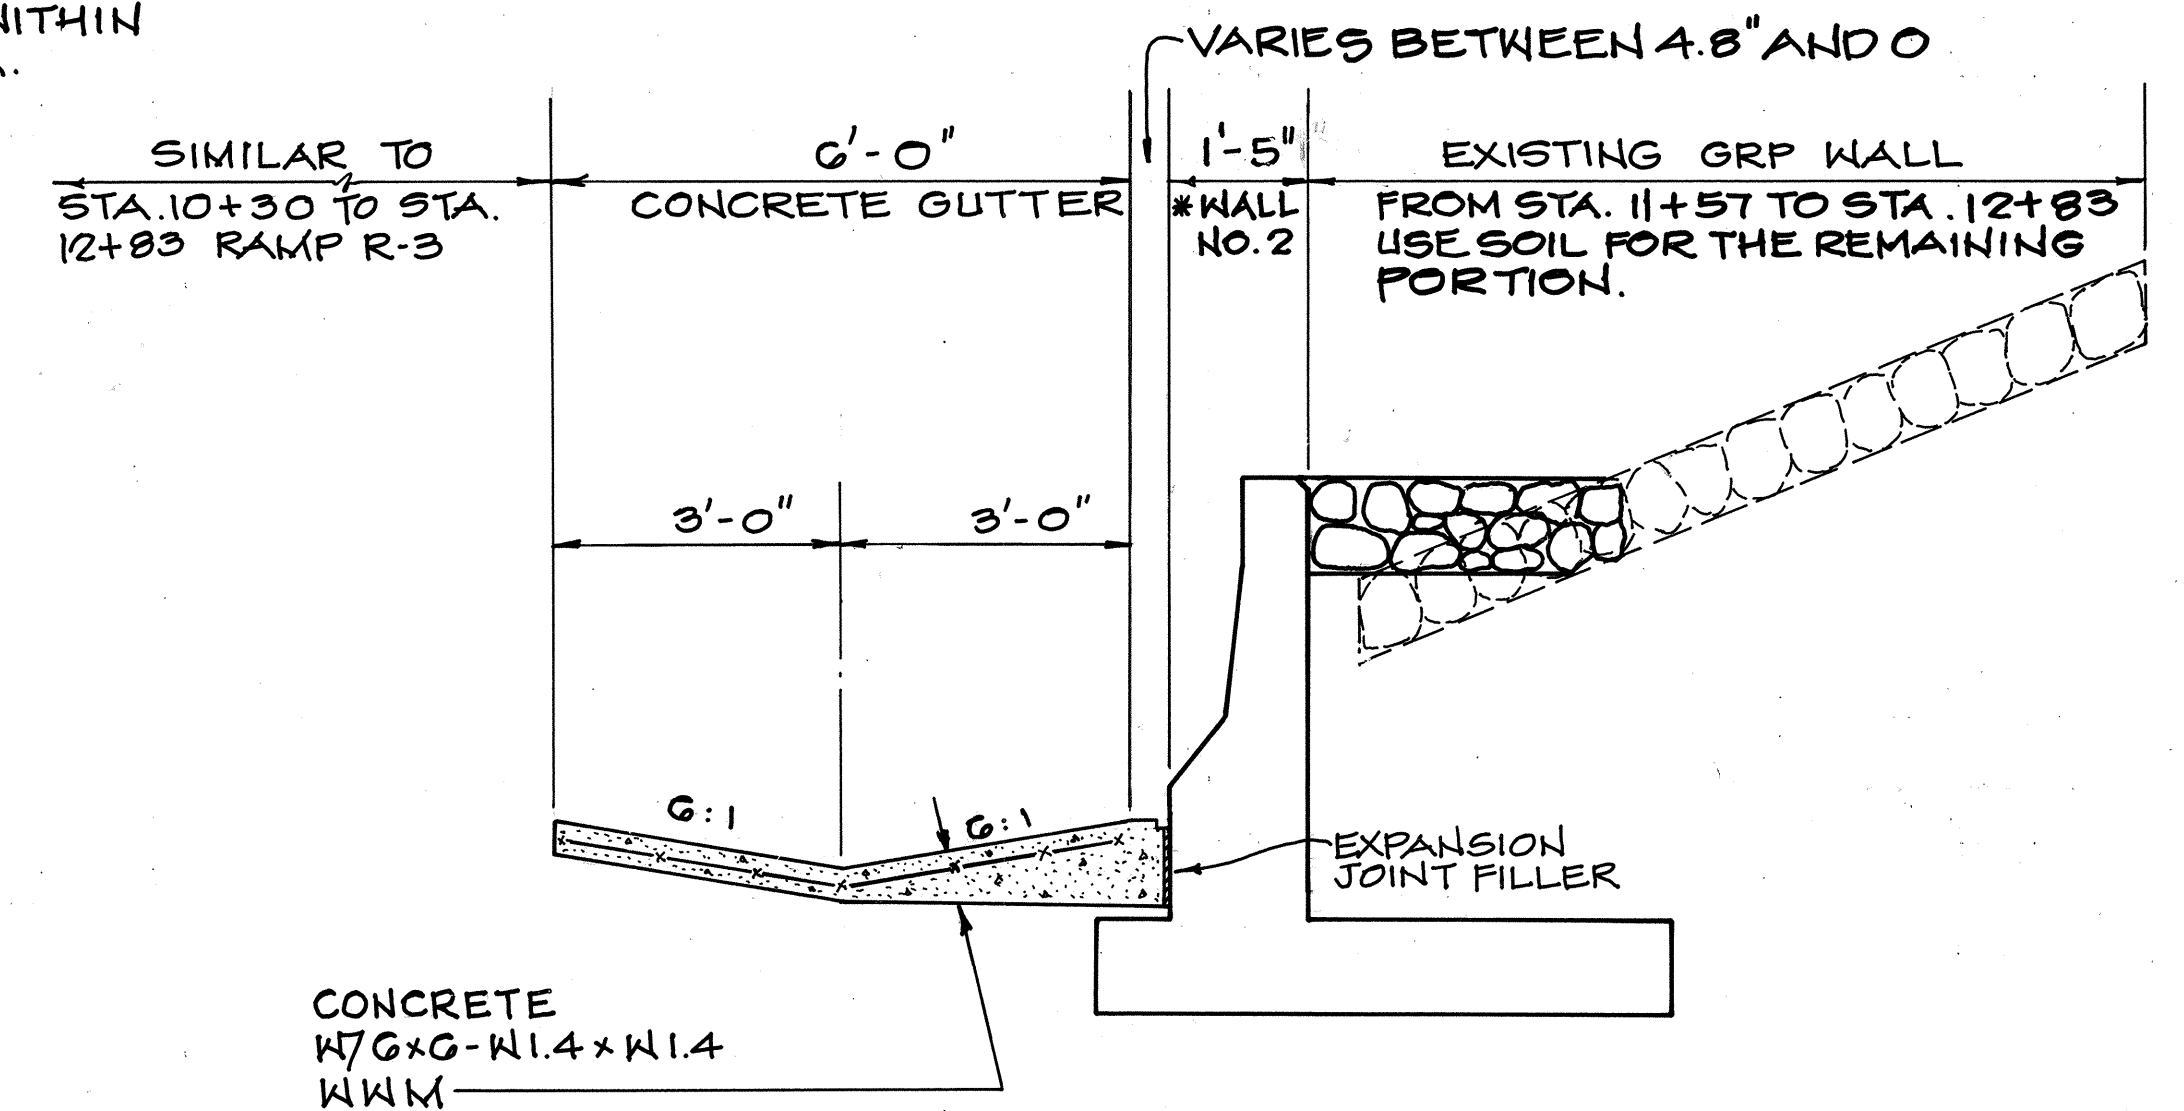

DETAIL
STA. 11+00 TO STA. 13+31 RAMP R-3

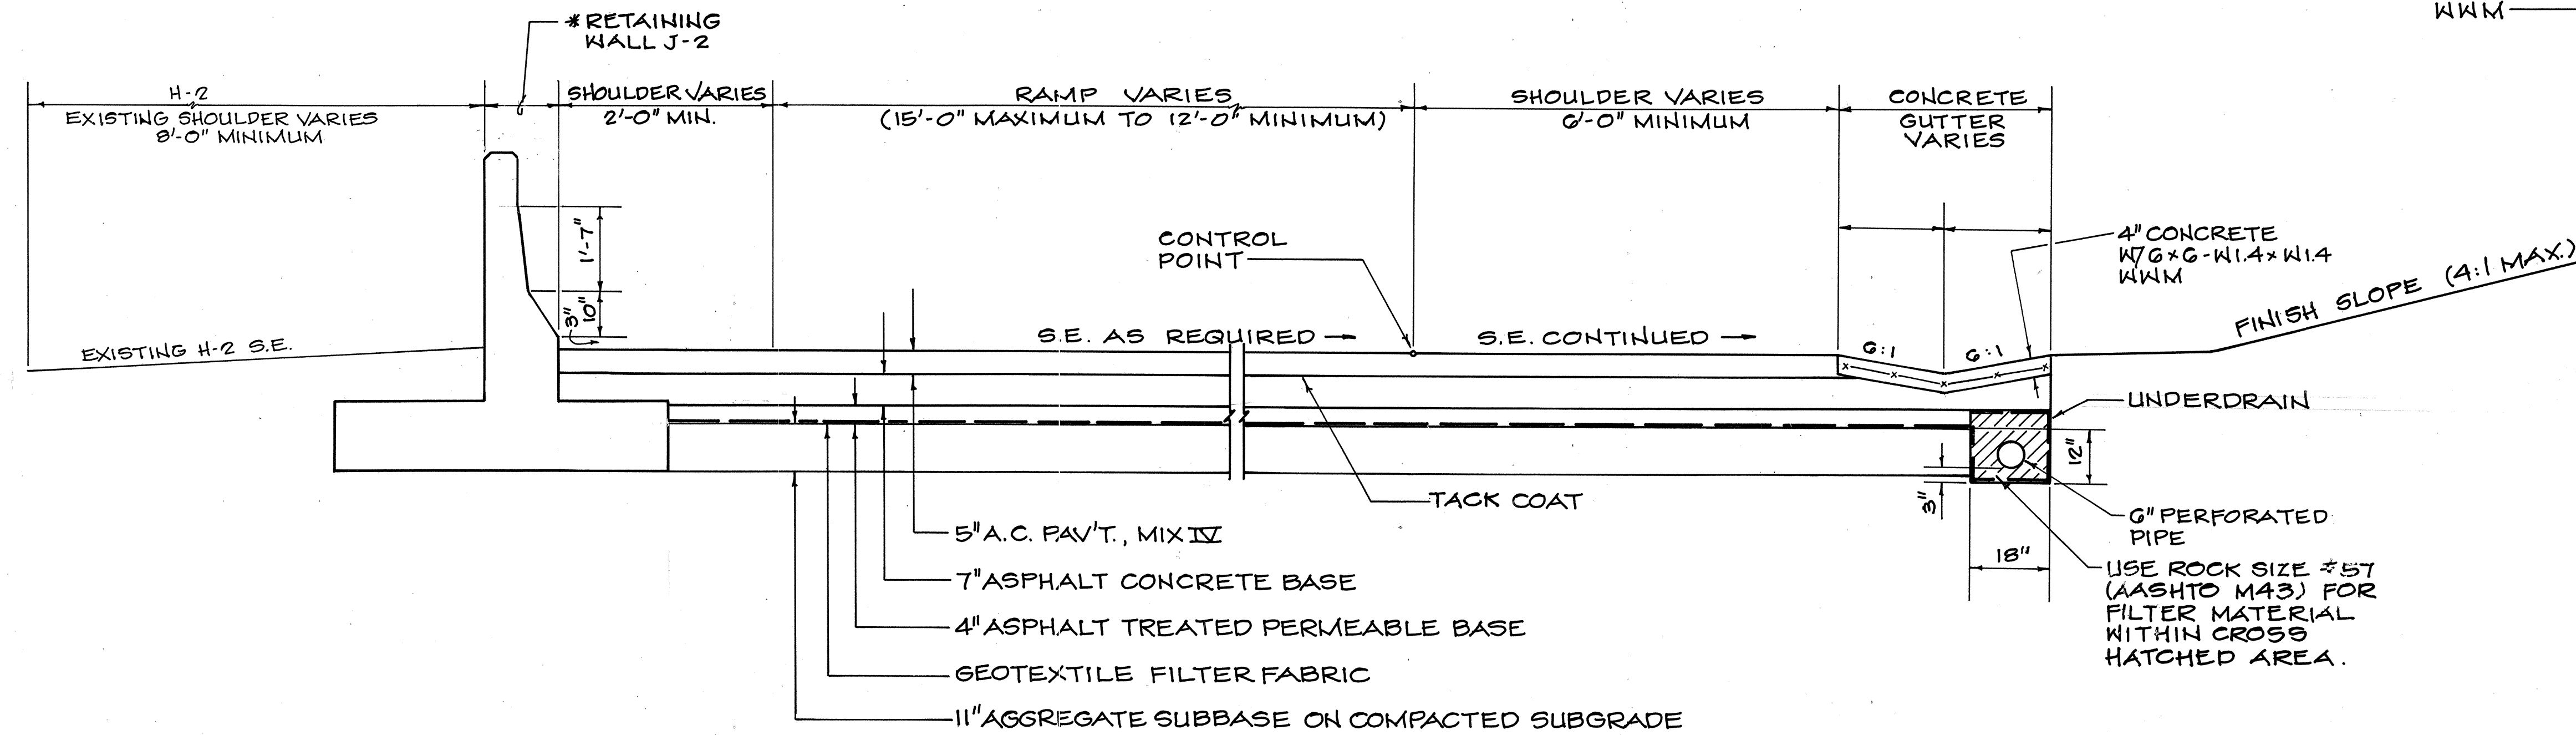

DETAIL
STA. 8+00 TO STA. 10+30 RAMP R-3

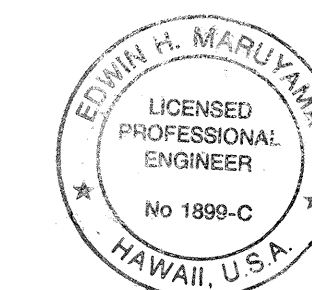

THIS WORK WAS PREPARED BY
ME OR UNDER MY SUPERVISION

By: *Edwin H. Maruyama*
FUTATA & ASSOCIATES

STATE OF HAWAII
DEPARTMENT OF TRANSPORTATION
HIGHWAYS DIVISION

RAMP R-3 SECTIONS

INTERSTATE ROUTE H-2
MILILANI INTERCHANGE
SOUTHBOUND ON-AND-OFF-RAMPS
F.A.I. Proj. No. IM-H2-1 (29)


SCALE: 1/2" = 1'-0" DATE: MAR. 1997

SHEET No. 38 OF 9 SHEETS

"AS-BUILT" **32**


DATE	_____
SURVEY PLOTTED BY	_____
DRAWN BY	_____
TRACED BY	_____
NOTED BY	_____
CHECKED BY	_____
ORIGINAL PLAN	_____
NOTE BOOK	_____
NO.	_____

FED. ROAD DIST. NO.	STATE	FED. AID PROJ. NO.	FISCAL YEAR	SHEET NO.	TOTAL SHEETS
HAWAII	HAW.	1M-H2-1 (29)	1997	33	129

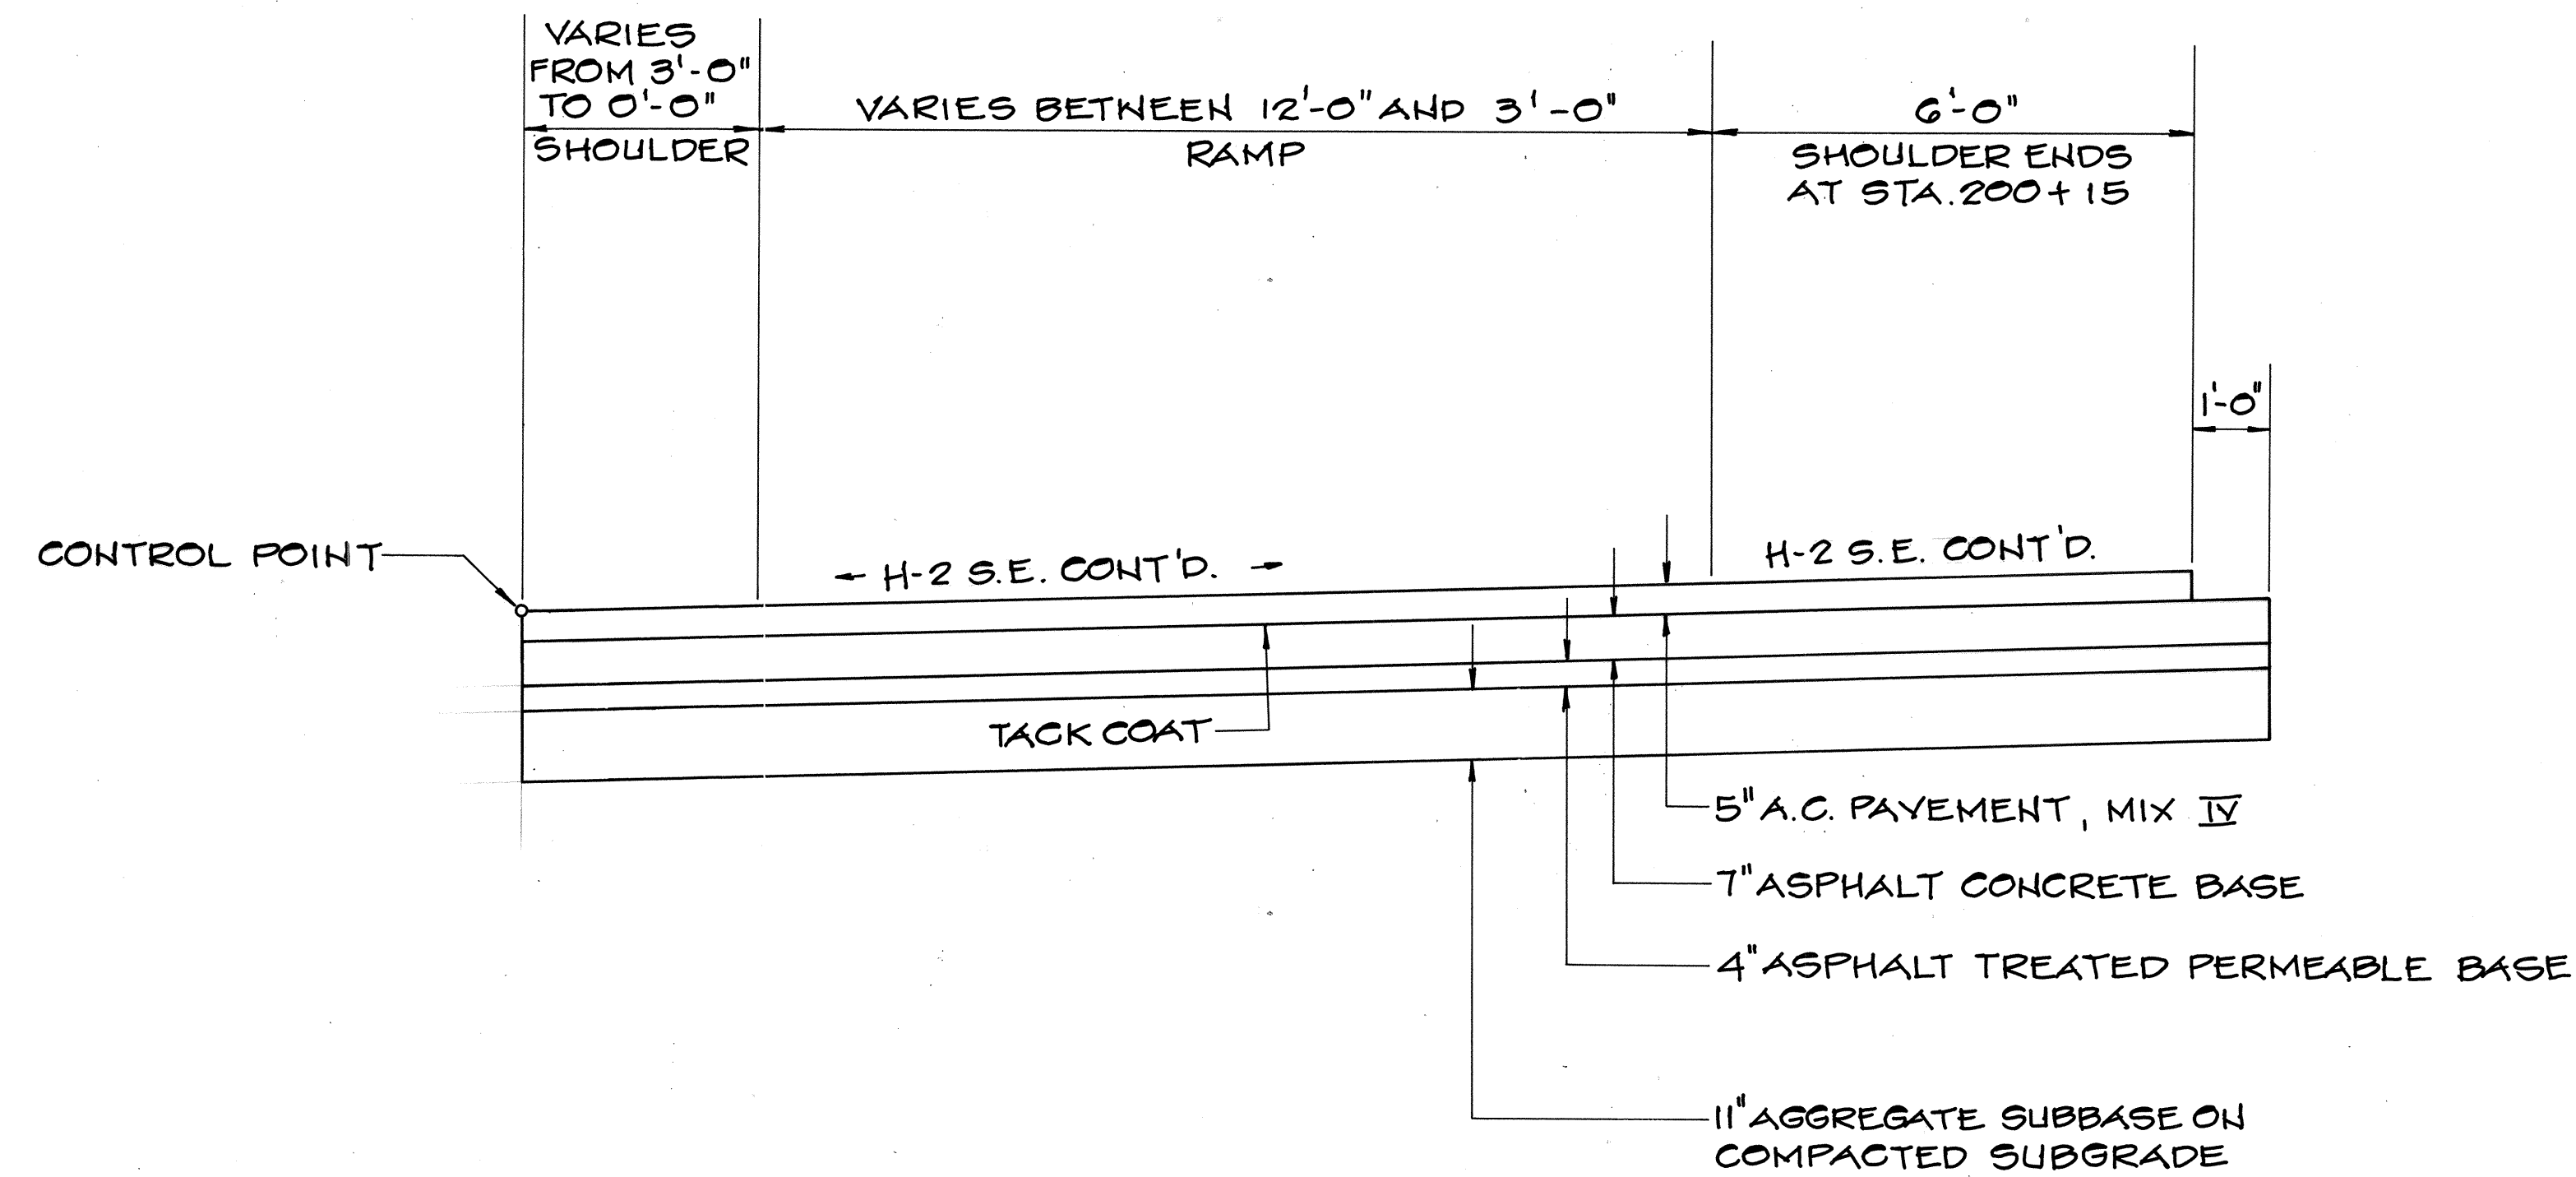


PAVEMENT DESIGN ON MEHEULA PARKWAY
TYPICAL SECTION "A"
SCALE: 1/2" = 1' - 0"

DETAIL
STA. 198 + 75(±) H-2 TO END

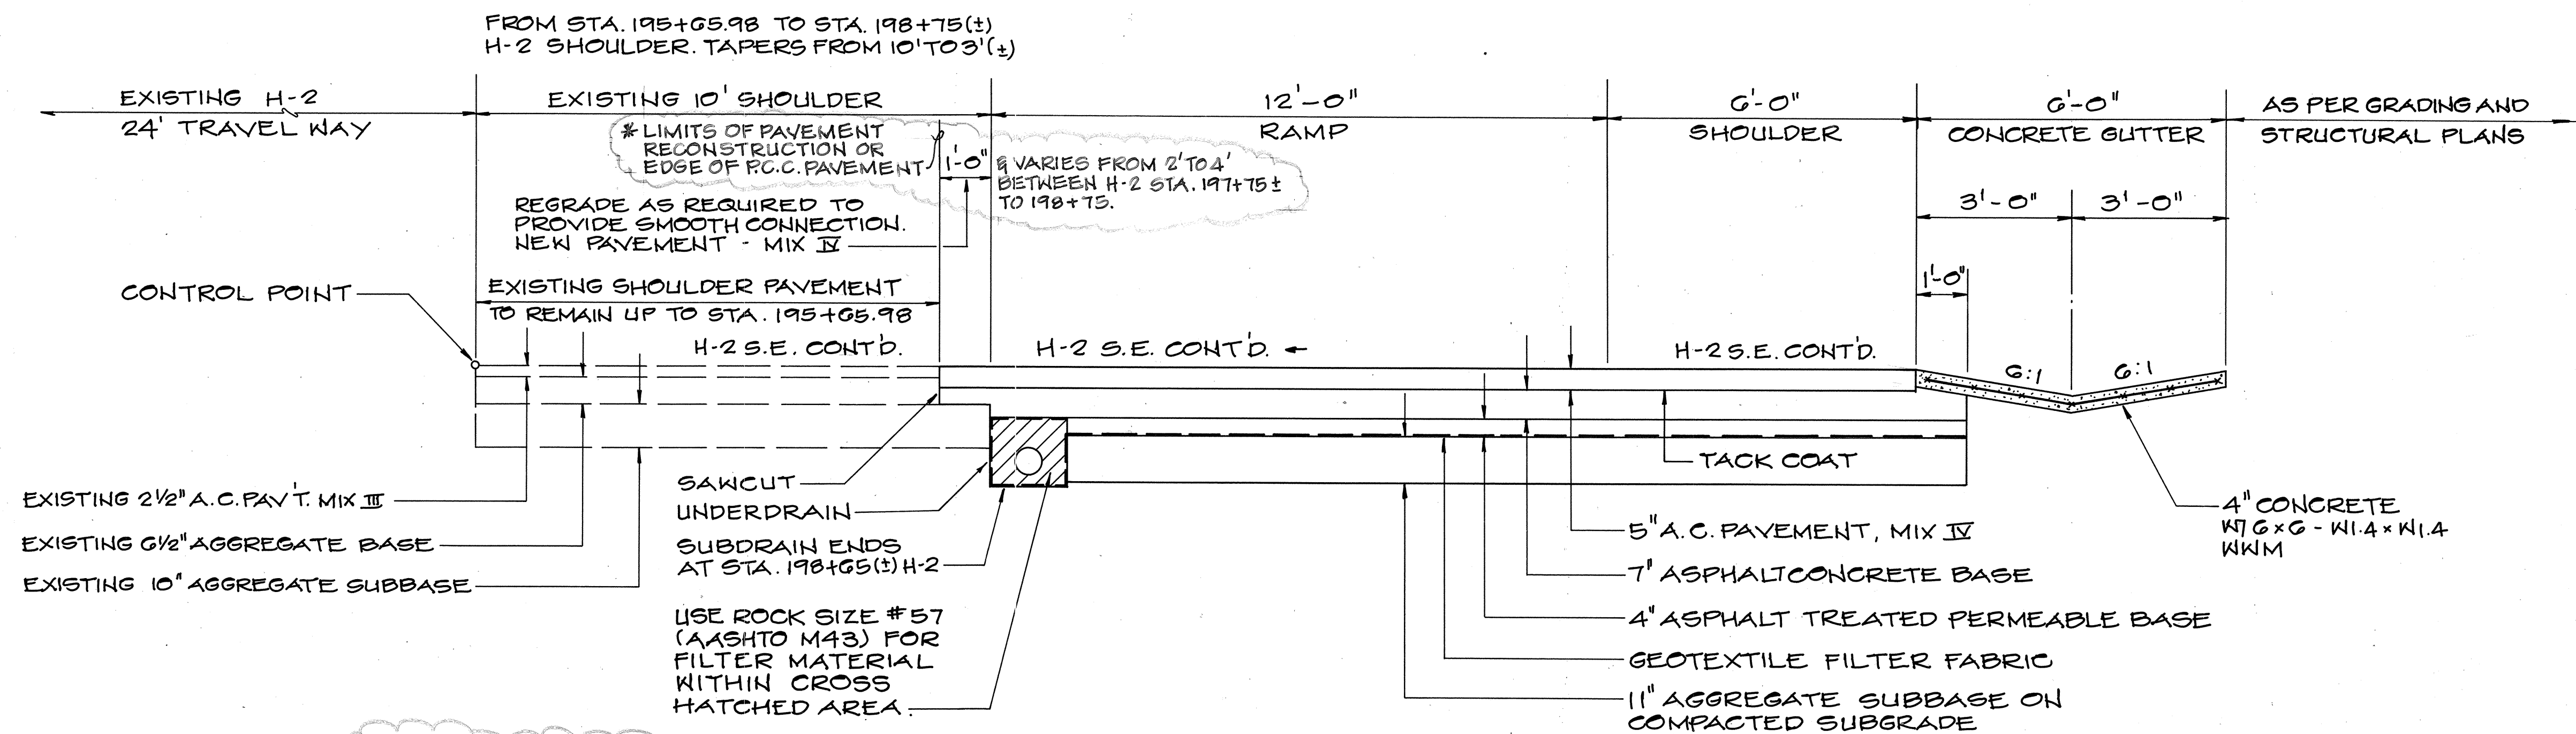

* LIMITS OF PAVEMENT RECONSTRUCTION EXTENDED TO EDGE OF P.C.C. PAVEMENT FROM H-2 STA. 197+75 ± TO 198+75.

DETAIL
STA. 12+63 RAMP R-3 = STA. 190+53.78 H-2 TO STA. 195+65.98 H-2
STA. 195+65.98 H-2 TO STA. 198 + 75(±) AS NOTED

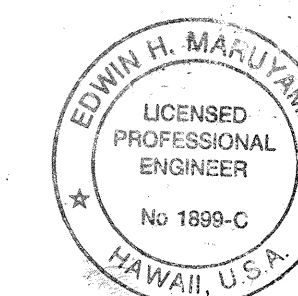

THIS WORK WAS PREPARED BY
ME OR UNDER MY SUPERVISION
By: *Edwin H. Maruyama*
FUJITA & ASSOCIATES

STATE OF HAWAII
DEPARTMENT OF TRANSPORTATION
HIGHWAYS DIVISION

RAMP R-3 SECTIONS

INTERSTATE ROUTE H-2
MILILANI INTERCHANGE
SOUTHBOUND ON-AND-OFF-RAMPS
F.A.I. Proj. No. 1M-H2-1 (29)

SCALE: 1/2" = 1' - 0"

DATE: MAR. 1997

SHEET NO. S9 OF 9 SHEETS

"AS-BUILT"

33

DATE	_____
SURVEY PLOTTED BY	_____
DRAWN BY	_____
CHECKED BY	_____
NOTED BY	_____
QUANTITIES BY	_____
CHECKED BY	_____
ORIGINAL PLAN	_____
NOTE BOOK	_____
NO.	_____