

INDEX TO DRAWINGS	
SHEET NO.	DESCRIPTION
1	TITLE SHEET
2	STANDARD PLANS SUMMARY
3-5	PLANS
6	GENERAL NOTES, TYPICAL INSTALLATION & SIGN DETAILS
7-10	MISCELLANEOUS DETAILS

STATE OF HAWAII

DEPARTMENT OF TRANSPORTATION

HIGHWAYS DIVISION

HONOLULU, HAWAII


"AS-BUILT"
PLANS FOR

INTERSTATE ROUTE H-2
INSTALLATION OF EMERGENCY TELEPHONES

WAIAWA INTERCHANGE TO WILIKINA DRIVE
FEDERAL AID INTERSTATE PROJECT NO. STP-H2-1(31)

DISTRICTS OF EWA AND WAHIAWA
ISLAND OF OAHU

FED. ROAD DIST. NO.	STATE	FED. AID PROJ. NO.	FISCAL YEAR	SHEET NO.	TOTAL SHEETS
HAWAII	HAW.	STP-H2-1(31)	2001	1	10

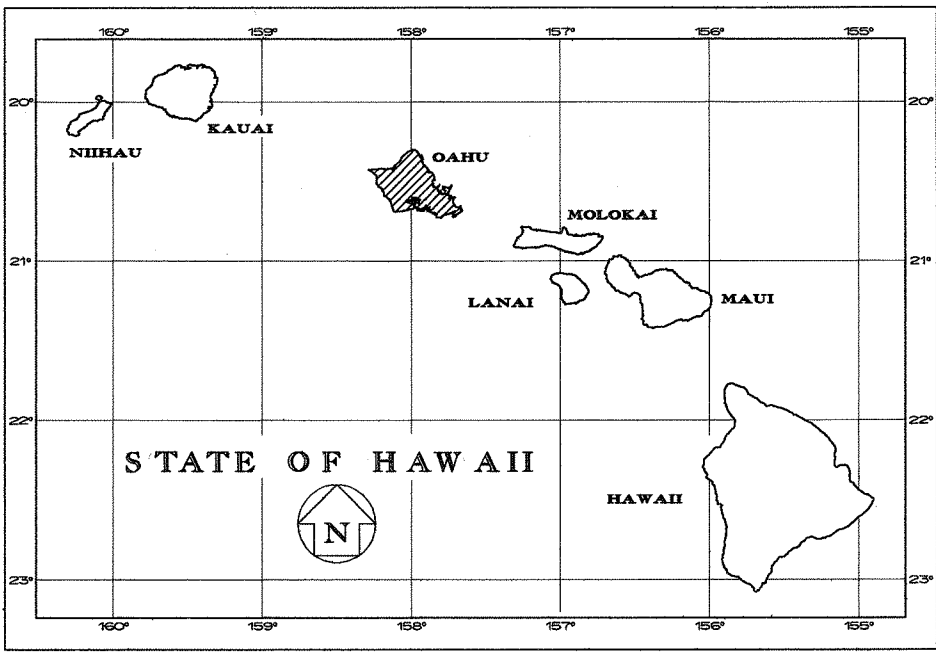


DECEMBER 2000
DATE

692-7679
PHONE

KARL KUNISHIGE
P.S. & E. BY

PARSONS BRINCKERHOFF
DESIGNED BY

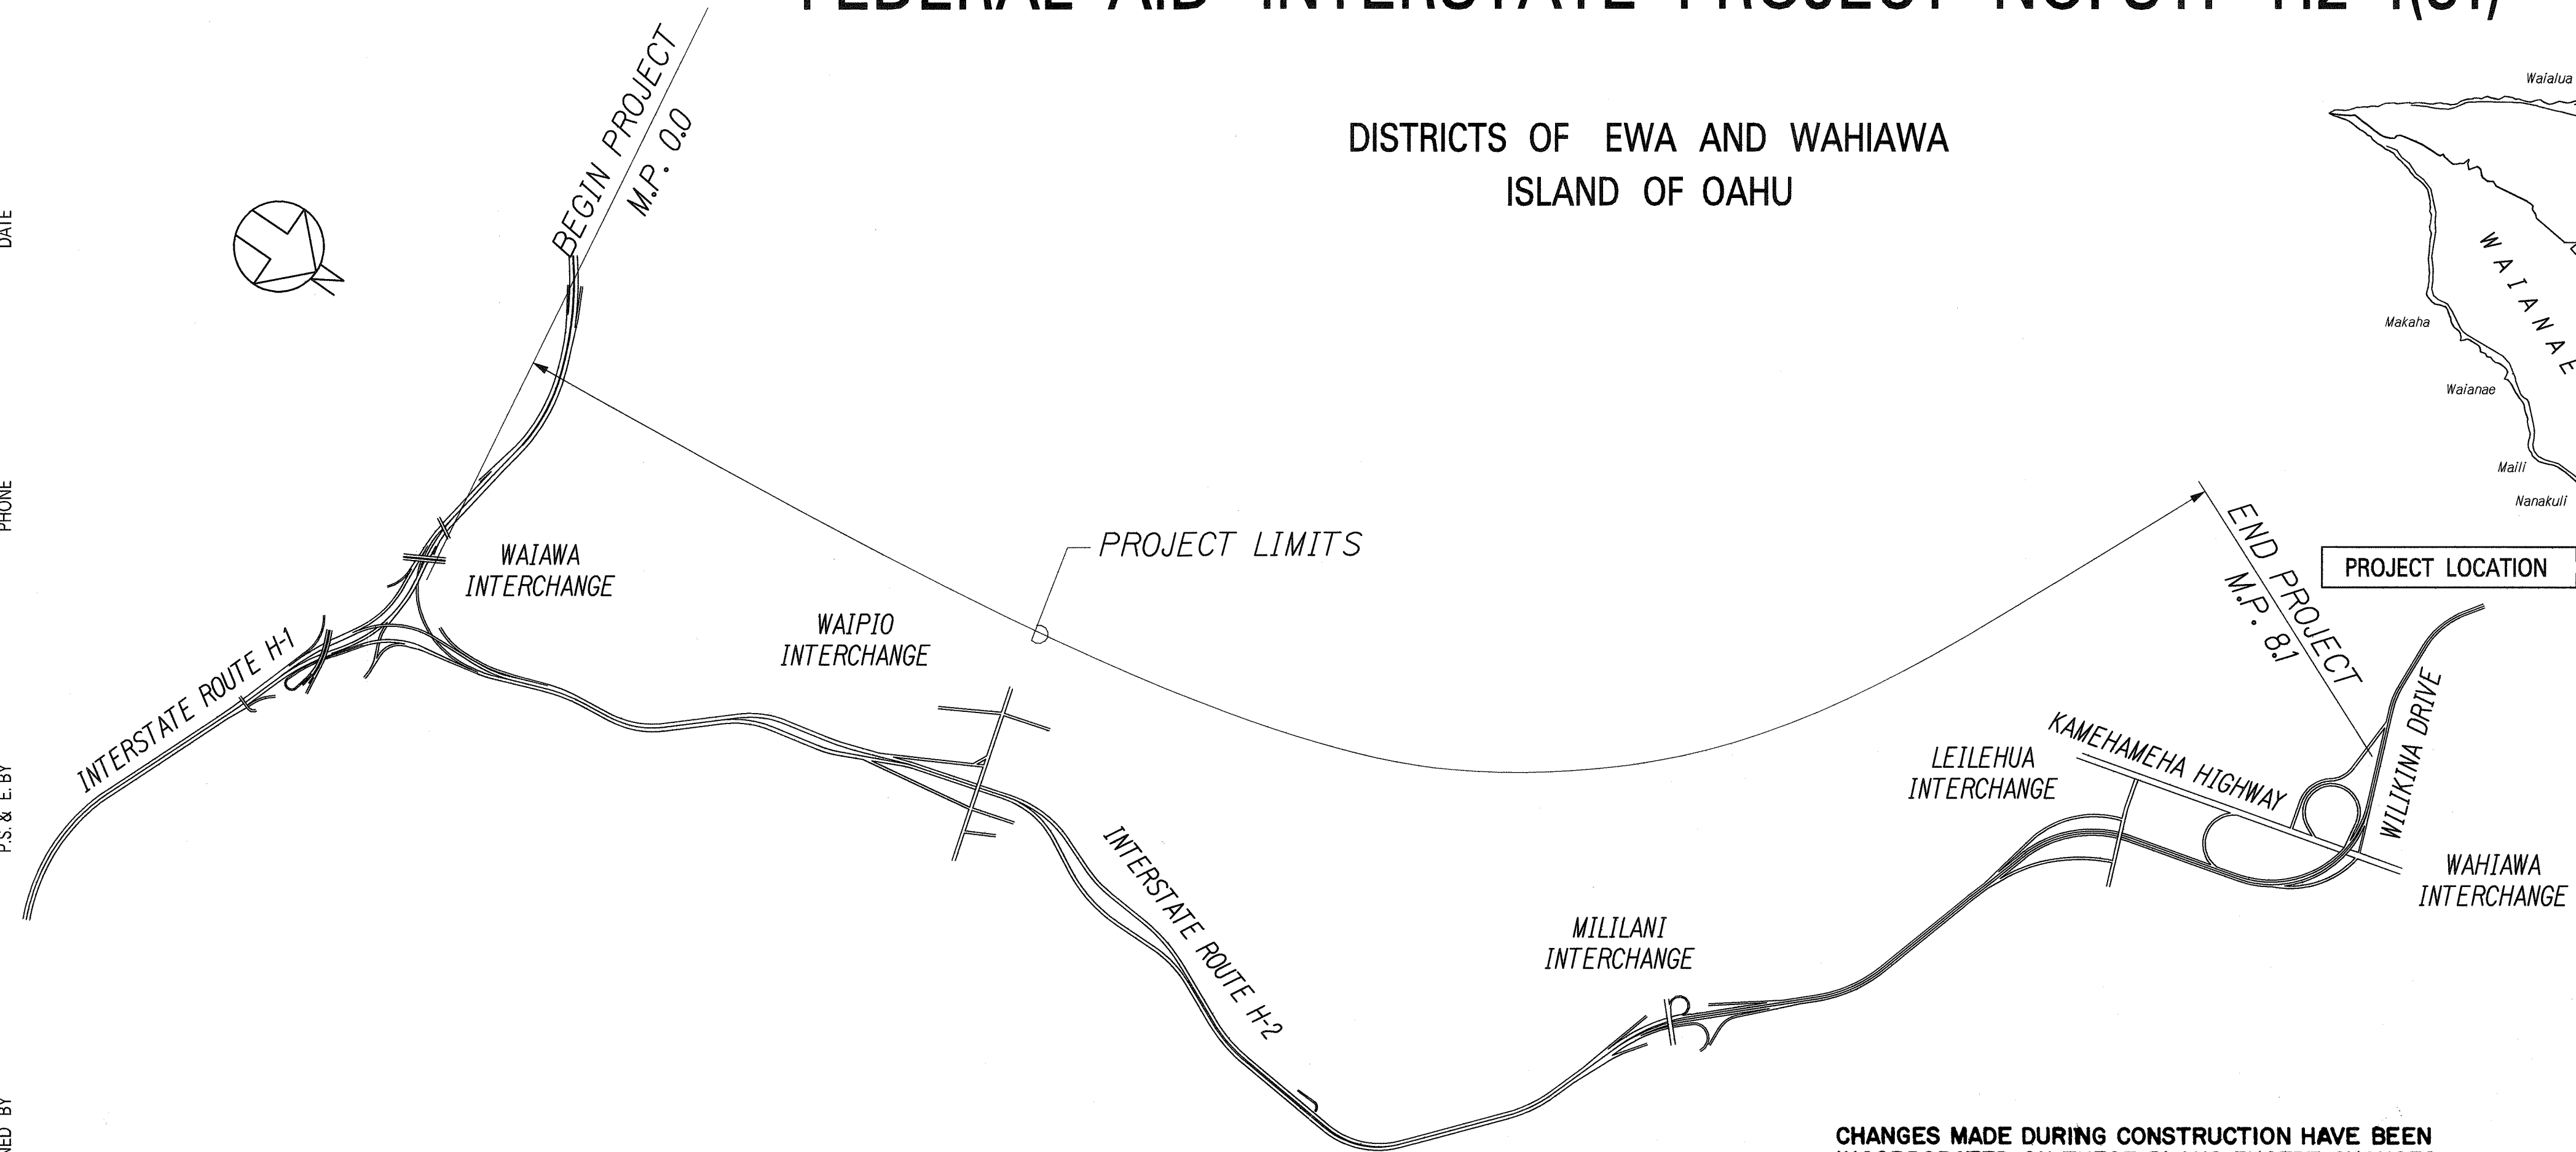

FEDERAL AID INTERSTATE PROJECTS PREVIOUSLY
CONSTRUCTED OR UNDER CONSTRUCTION

MILEPOST 0.0 TO MILEPOST 8.1

LAYOUT PLAN
NOT TO SCALE

NET LENGTH OF PROJECT 8.1 MILES

CHANGES MADE DURING CONSTRUCTION HAVE BEEN
INCORPORATED ON THESE PLANS EXCEPT CHANGES
IN THE ORIGINAL THEORETICAL QUANTITIES. FOR
ACTUAL QUANTITIES, REFER TO PROJECT LEDGER
AND/OR COMPUTATION BOOK.

RESIDENT ENGINEER

DATE

5/7/09

DEPARTMENT OF TRANSPORTATION STATE OF HAWAII	
APPROVED:	
	4-25-01
DIRECTOR OF TRANSPORTATION	DATE