


FED. ROAD DIST. NO.	STATE	PROJ. NO.	FISCAL YEAR	SHEET NO.	TOTAL SHEETS
HAWAII	HAW.	H2CDE-01-98	2000	3	12




ORIGINAL PLAN	SURVEY PLOTTED BY	DATE
NOTE BOOK	DRAWN BY	11/5/98
No.	DESIGNED BY	
	QUANTITIES BY	
	CHECKED BY	

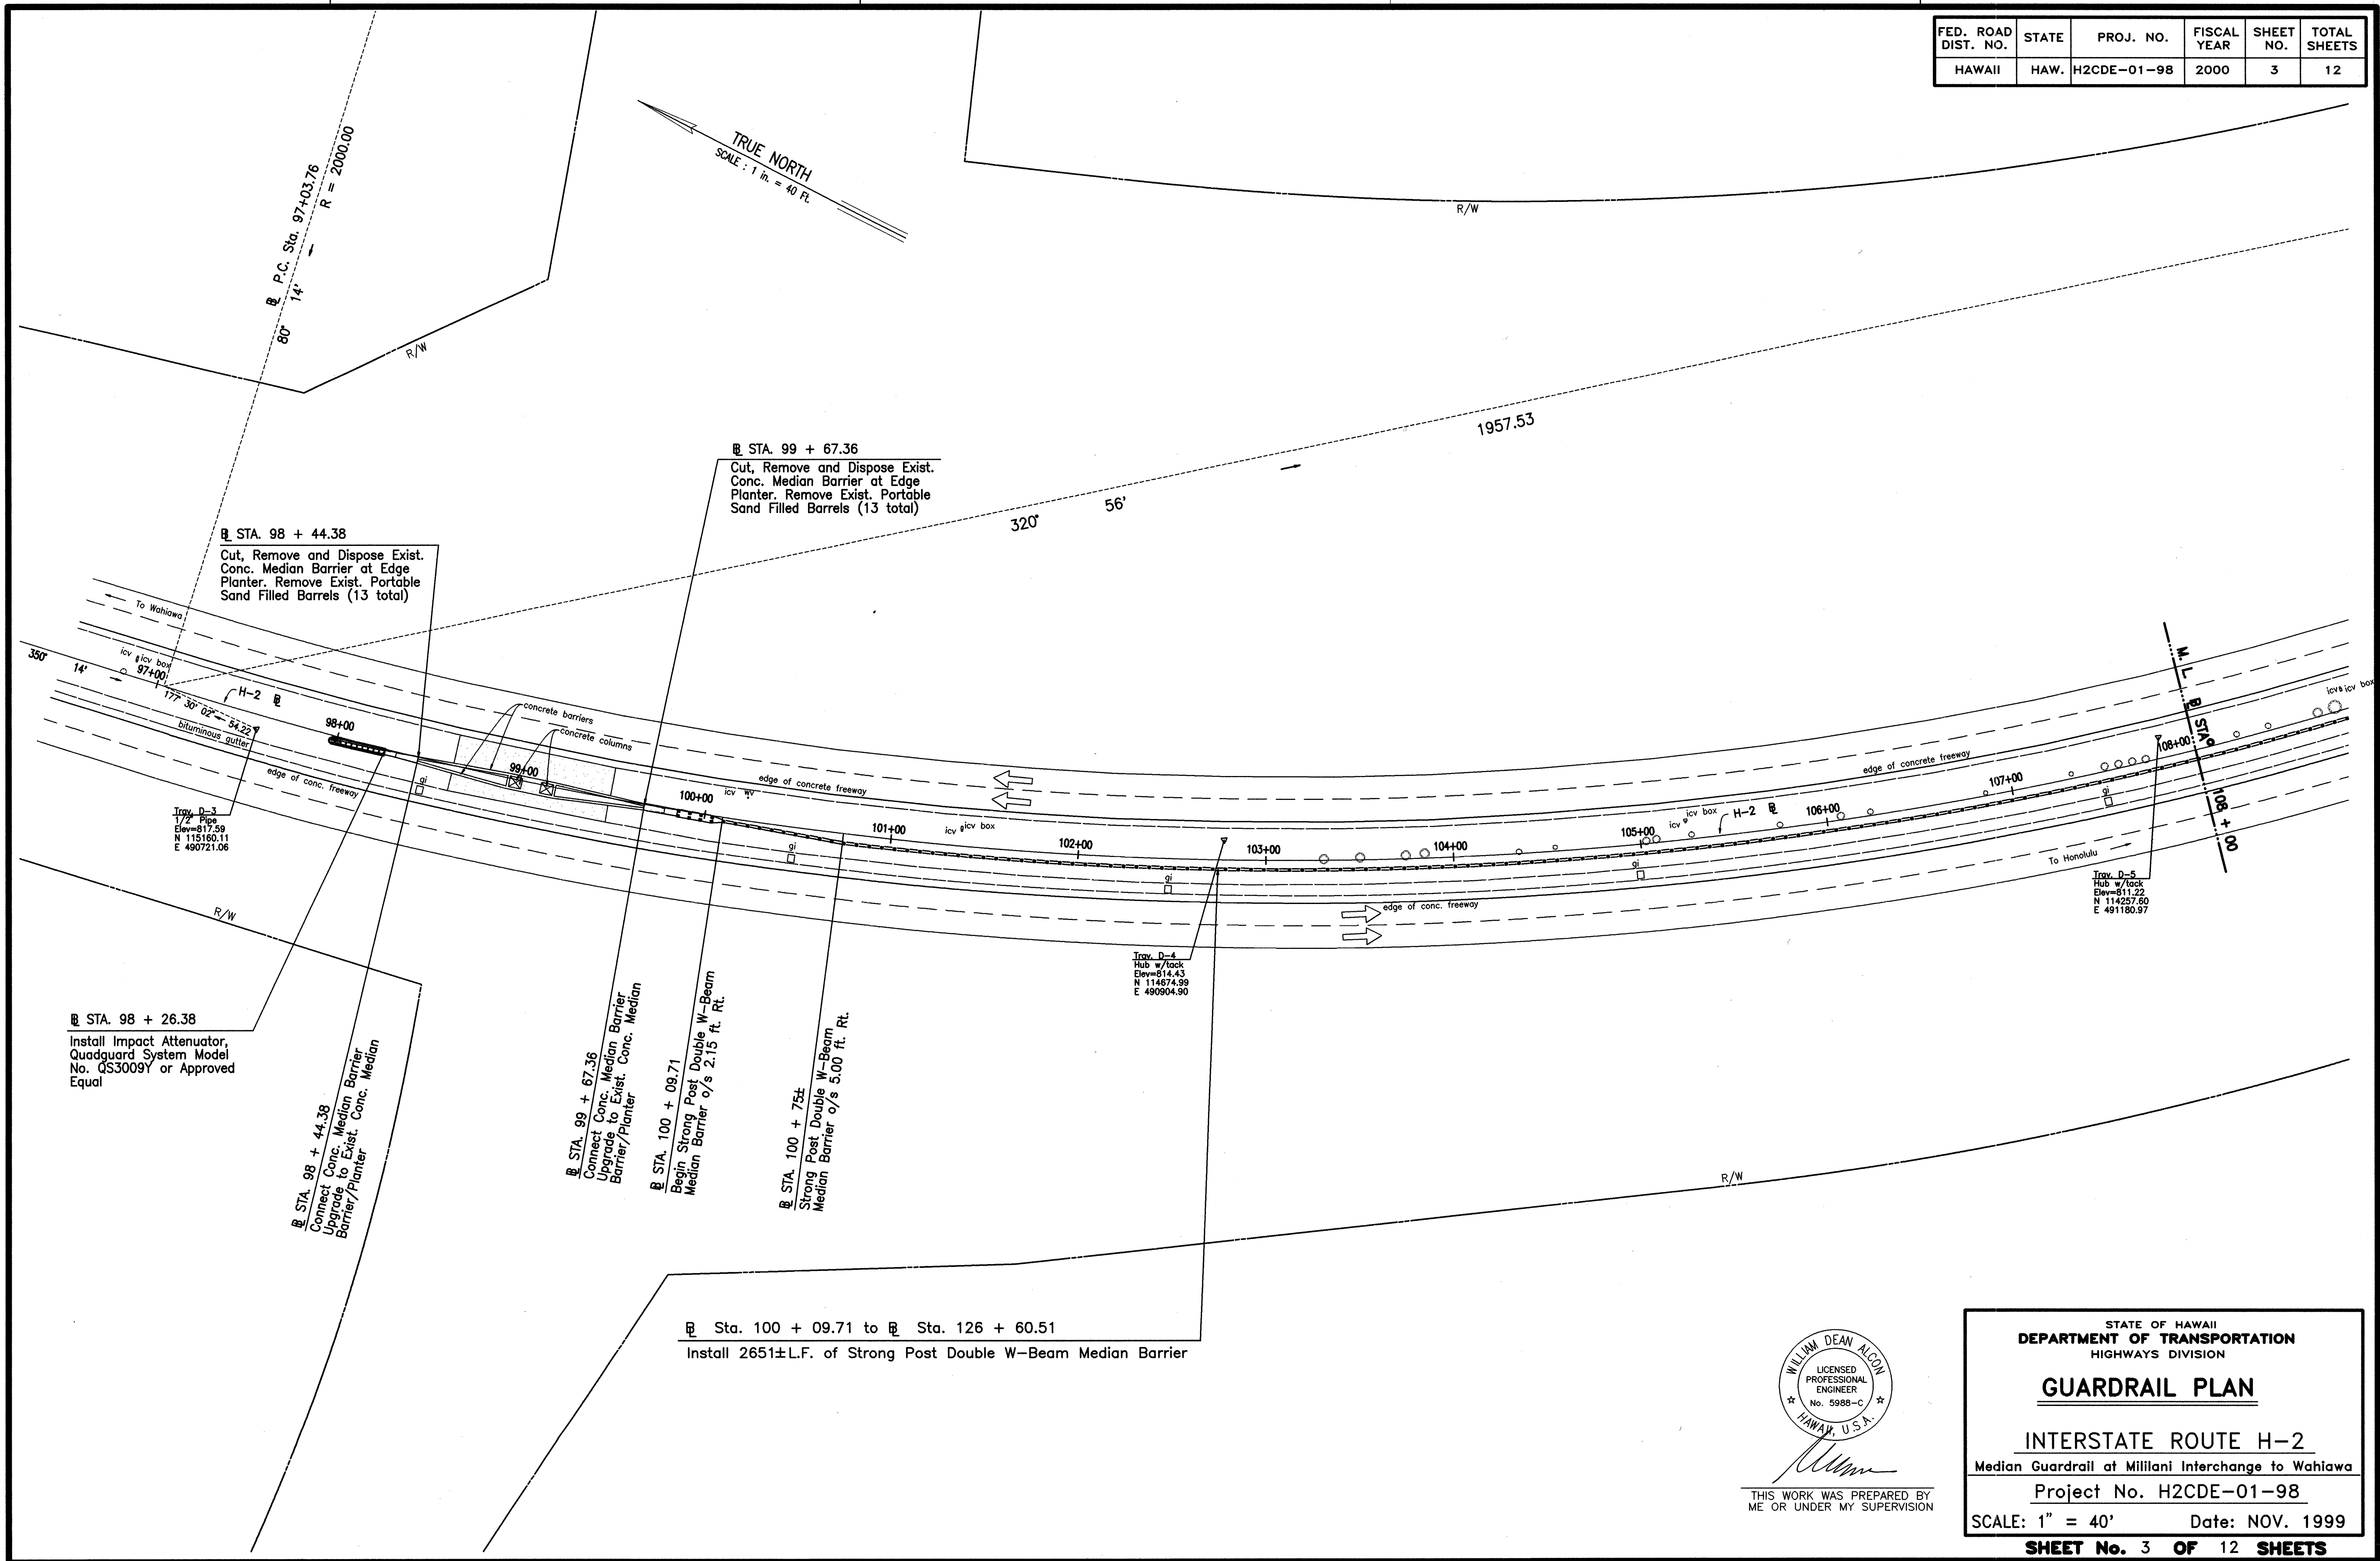

THIS WORK WAS PREPARED BY ME OR UNDER MY SUPERVISION

STATE OF HAWAII
DEPARTMENT OF TRANSPORTATION
HIGHWAYS DIVISION
GUARDRAIL PLAN
INTERSTATE ROUTE H-2
Median Guardrail at Mililani Interchange to Wahiawa
Project No. H2CDE-01-98
SCALE: 1" = 40' Date: NOV. 1999
SHEET No. 3 OF 12 SHEETS

FED. ROAD DIST. NO.	STATE	PROJ. NO.	FISCAL YEAR	SHEET NO.	TOTAL SHEETS
HAWAII	HAW.	H2CD2-01-98	2000	4	12

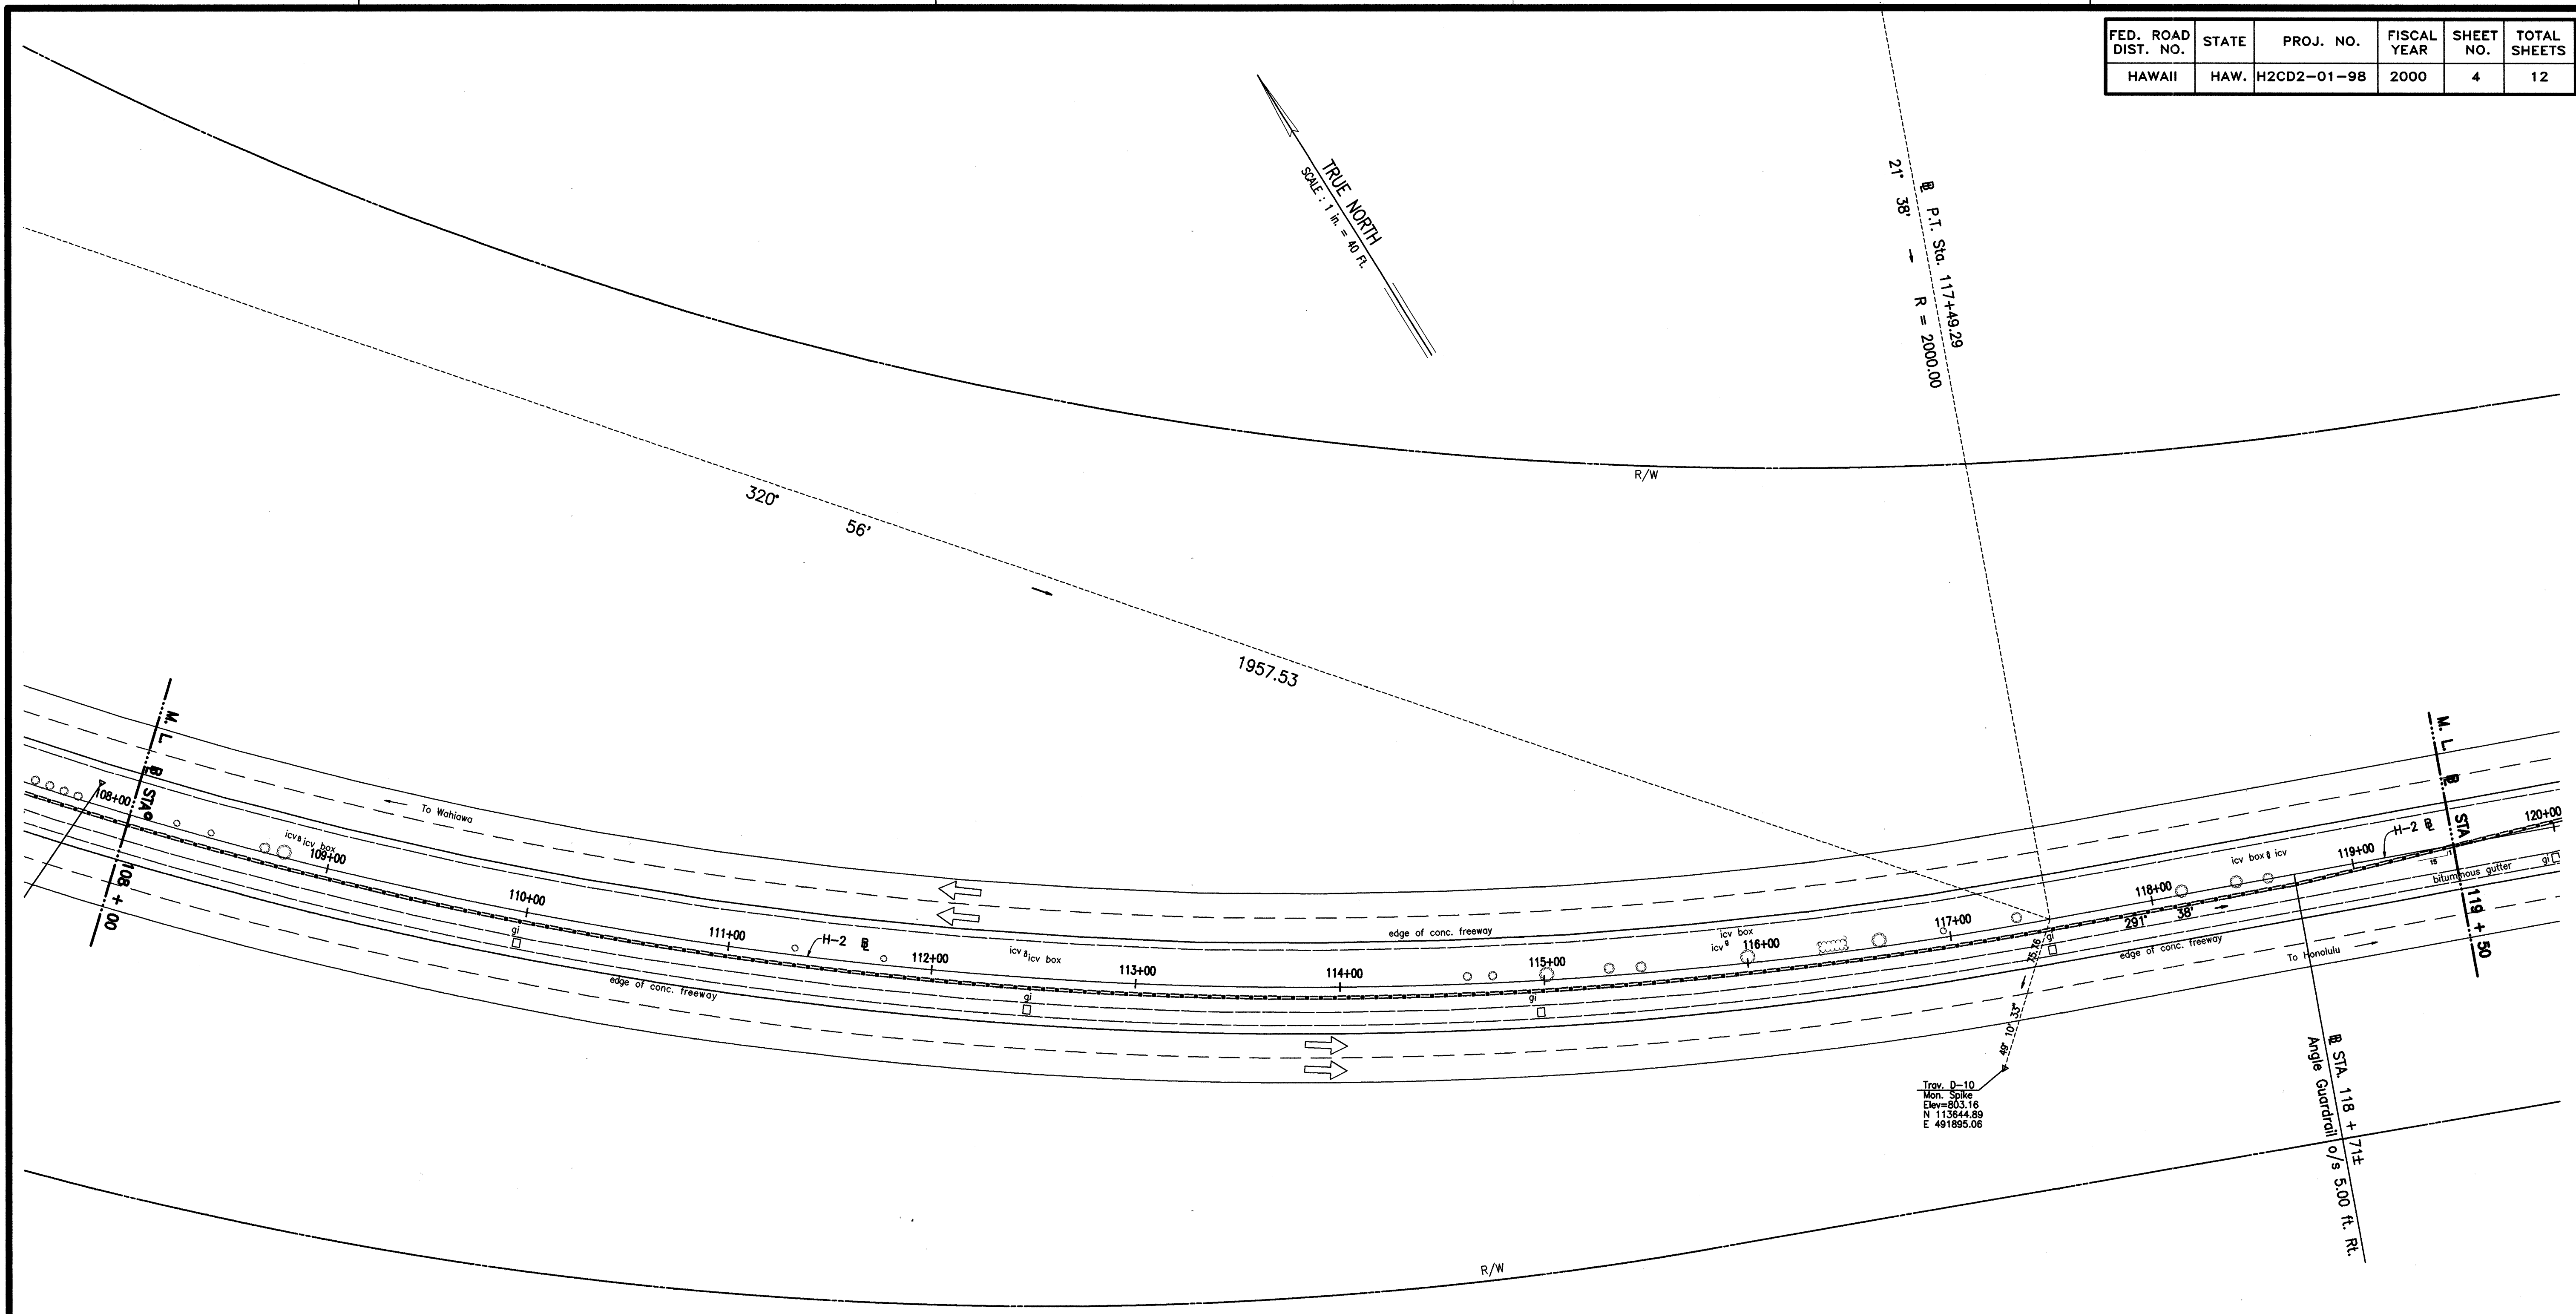


ORIGINAL PLAN	SURVEY PLOTTED BY	DATE
NOTE BOOK	DRAWN BY D. Mison, E. Lum	11/5/98
No.	DESIGNED BY S. Hagan	
	CHECKED BY M. D. Allen	



THIS WORK WAS PREPARED BY ME OR UNDER MY SUPERVISION

STATE OF HAWAII
DEPARTMENT OF TRANSPORTATION
HIGHWAYS DIVISION
GUARDRAIL PLAN
INTERSTATE ROUTE H-2
Median Guardrail at Mililani Interchange to Wahiawa
Project No. H2CDE-01-98
SCALE: 1" = 40' Date: NOV. 1999
SHEET No. 4 OF 12 SHEETS

FED. ROAD DIST. NO.	STATE	PROJ. NO.	FISCAL YEAR	SHEET NO.	TOTAL SHEETS
HAWAII	HAW.	H2CDE-01-98	2000	5	12

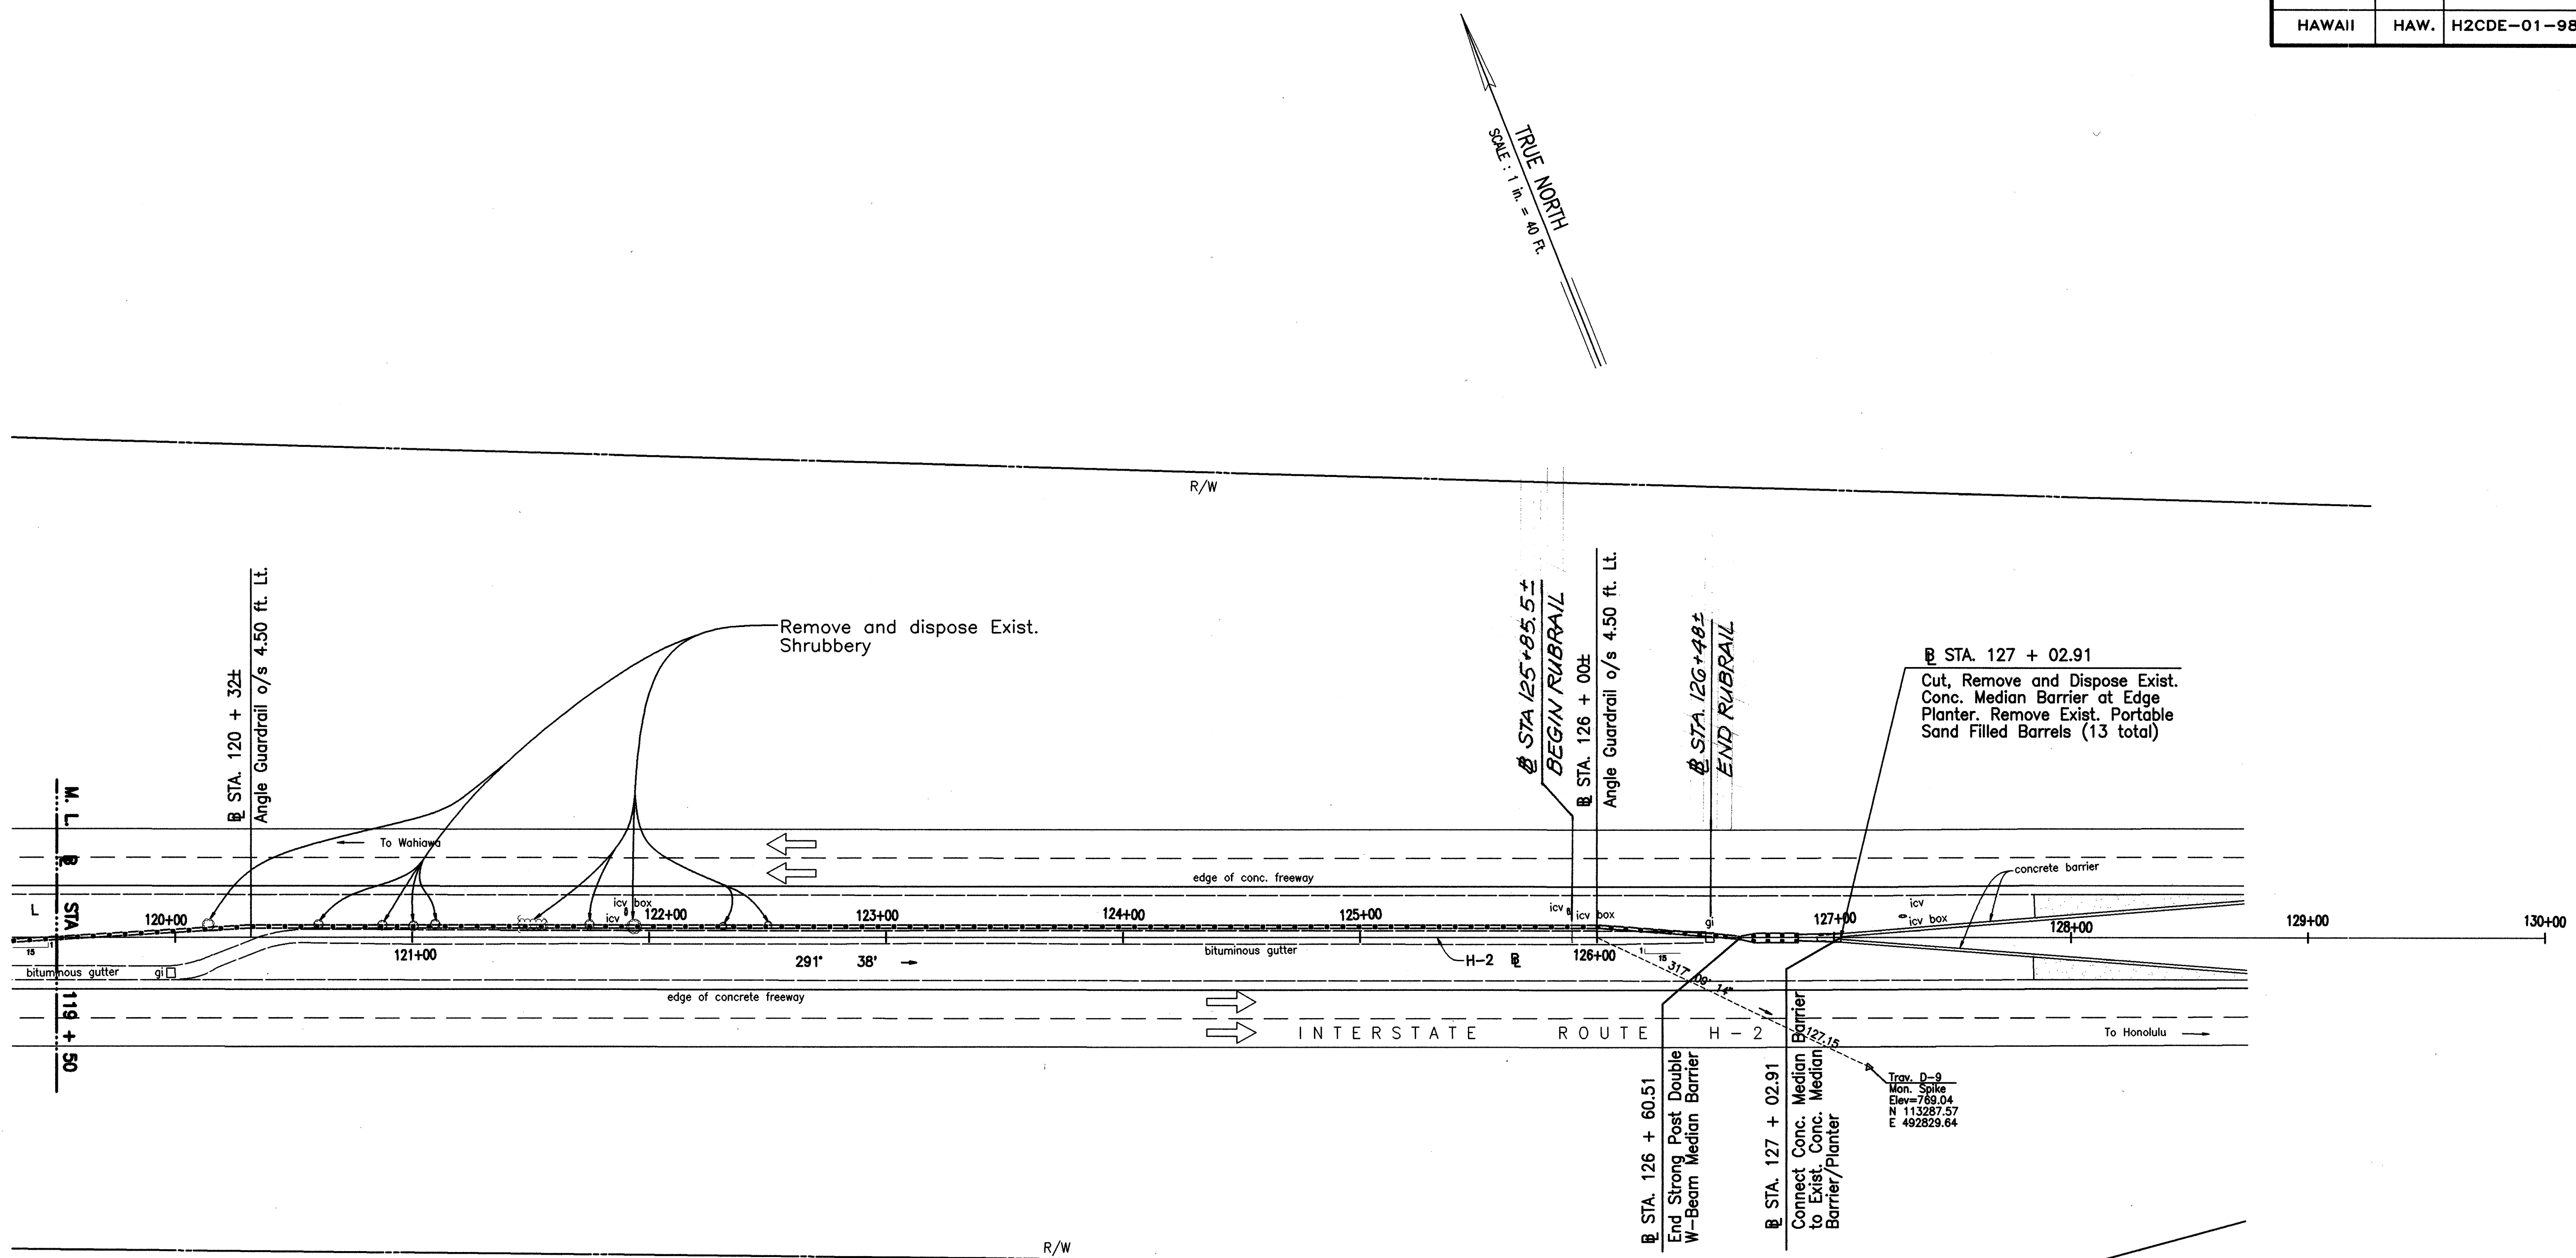

ORIGINAL PLAN	SURVEY PLOTTED BY	DATE
NOTE BOOK	DRAWN BY D. Mison, E. Lum	11/5/98
No.	DESIGNED BY S. Hirono	
	CHECKED BY M. D. Alcon	



THIS WORK WAS PREPARED BY
ME OR UNDER MY SUPERVISION

STATE OF HAWAII
DEPARTMENT OF TRANSPORTATION
HIGHWAYS DIVISION
GUARDRAIL PLAN
INTERSTATE ROUTE H-2
Median Guardrail at Milliani Interchange to Wahiawa
Project No. H2CDE-01-98
SCALE: 1" = 40' Date: NOV. 1999
SHEET No. 5 OF 12 SHEETS

"AS-BUILT"