

INDEX TO DRAWINGS	
SHEET NO.	DESCRIPTION
1	TITLE SHEET
2	GENERAL NOTES, LEGEND, & ABBREVIATIONS
3-5	GUARDRAIL PLAN
6	QUADGUARD SYSTEM CONNECTION TO CONCRETE MEDIAN BARRIER
7-8	GUARDRAIL CONNECTION TO CONCRETE MEDIAN BARRIER
9-10	CONCRETE MEDIAN BARRIER SECTIONS
11	TYPE "A" ENDPOST DETAILS METAL GUARDRAIL TYPE 3 THRIE BEAM AND APPURTENANCES DETAILS
12	STRONG POST W-BEAM MEDIAN BARRIER

STATE OF HAWAII

DEPARTMENT OF TRANSPORTATION

HIGHWAYS DIVISION

HONOLULU, HAWAII

"AS-BUILT"

PLANS FOR

INTERSTATE ROUTE H-2


MEDIAN GUARDRAIL AT

MILILANI INTERCHANGE TO WAHIAWA



PROJECT NO. H2CDE-01-98

DISTRICT OF WAHIAWA & EWA

ISLAND OF OAHU

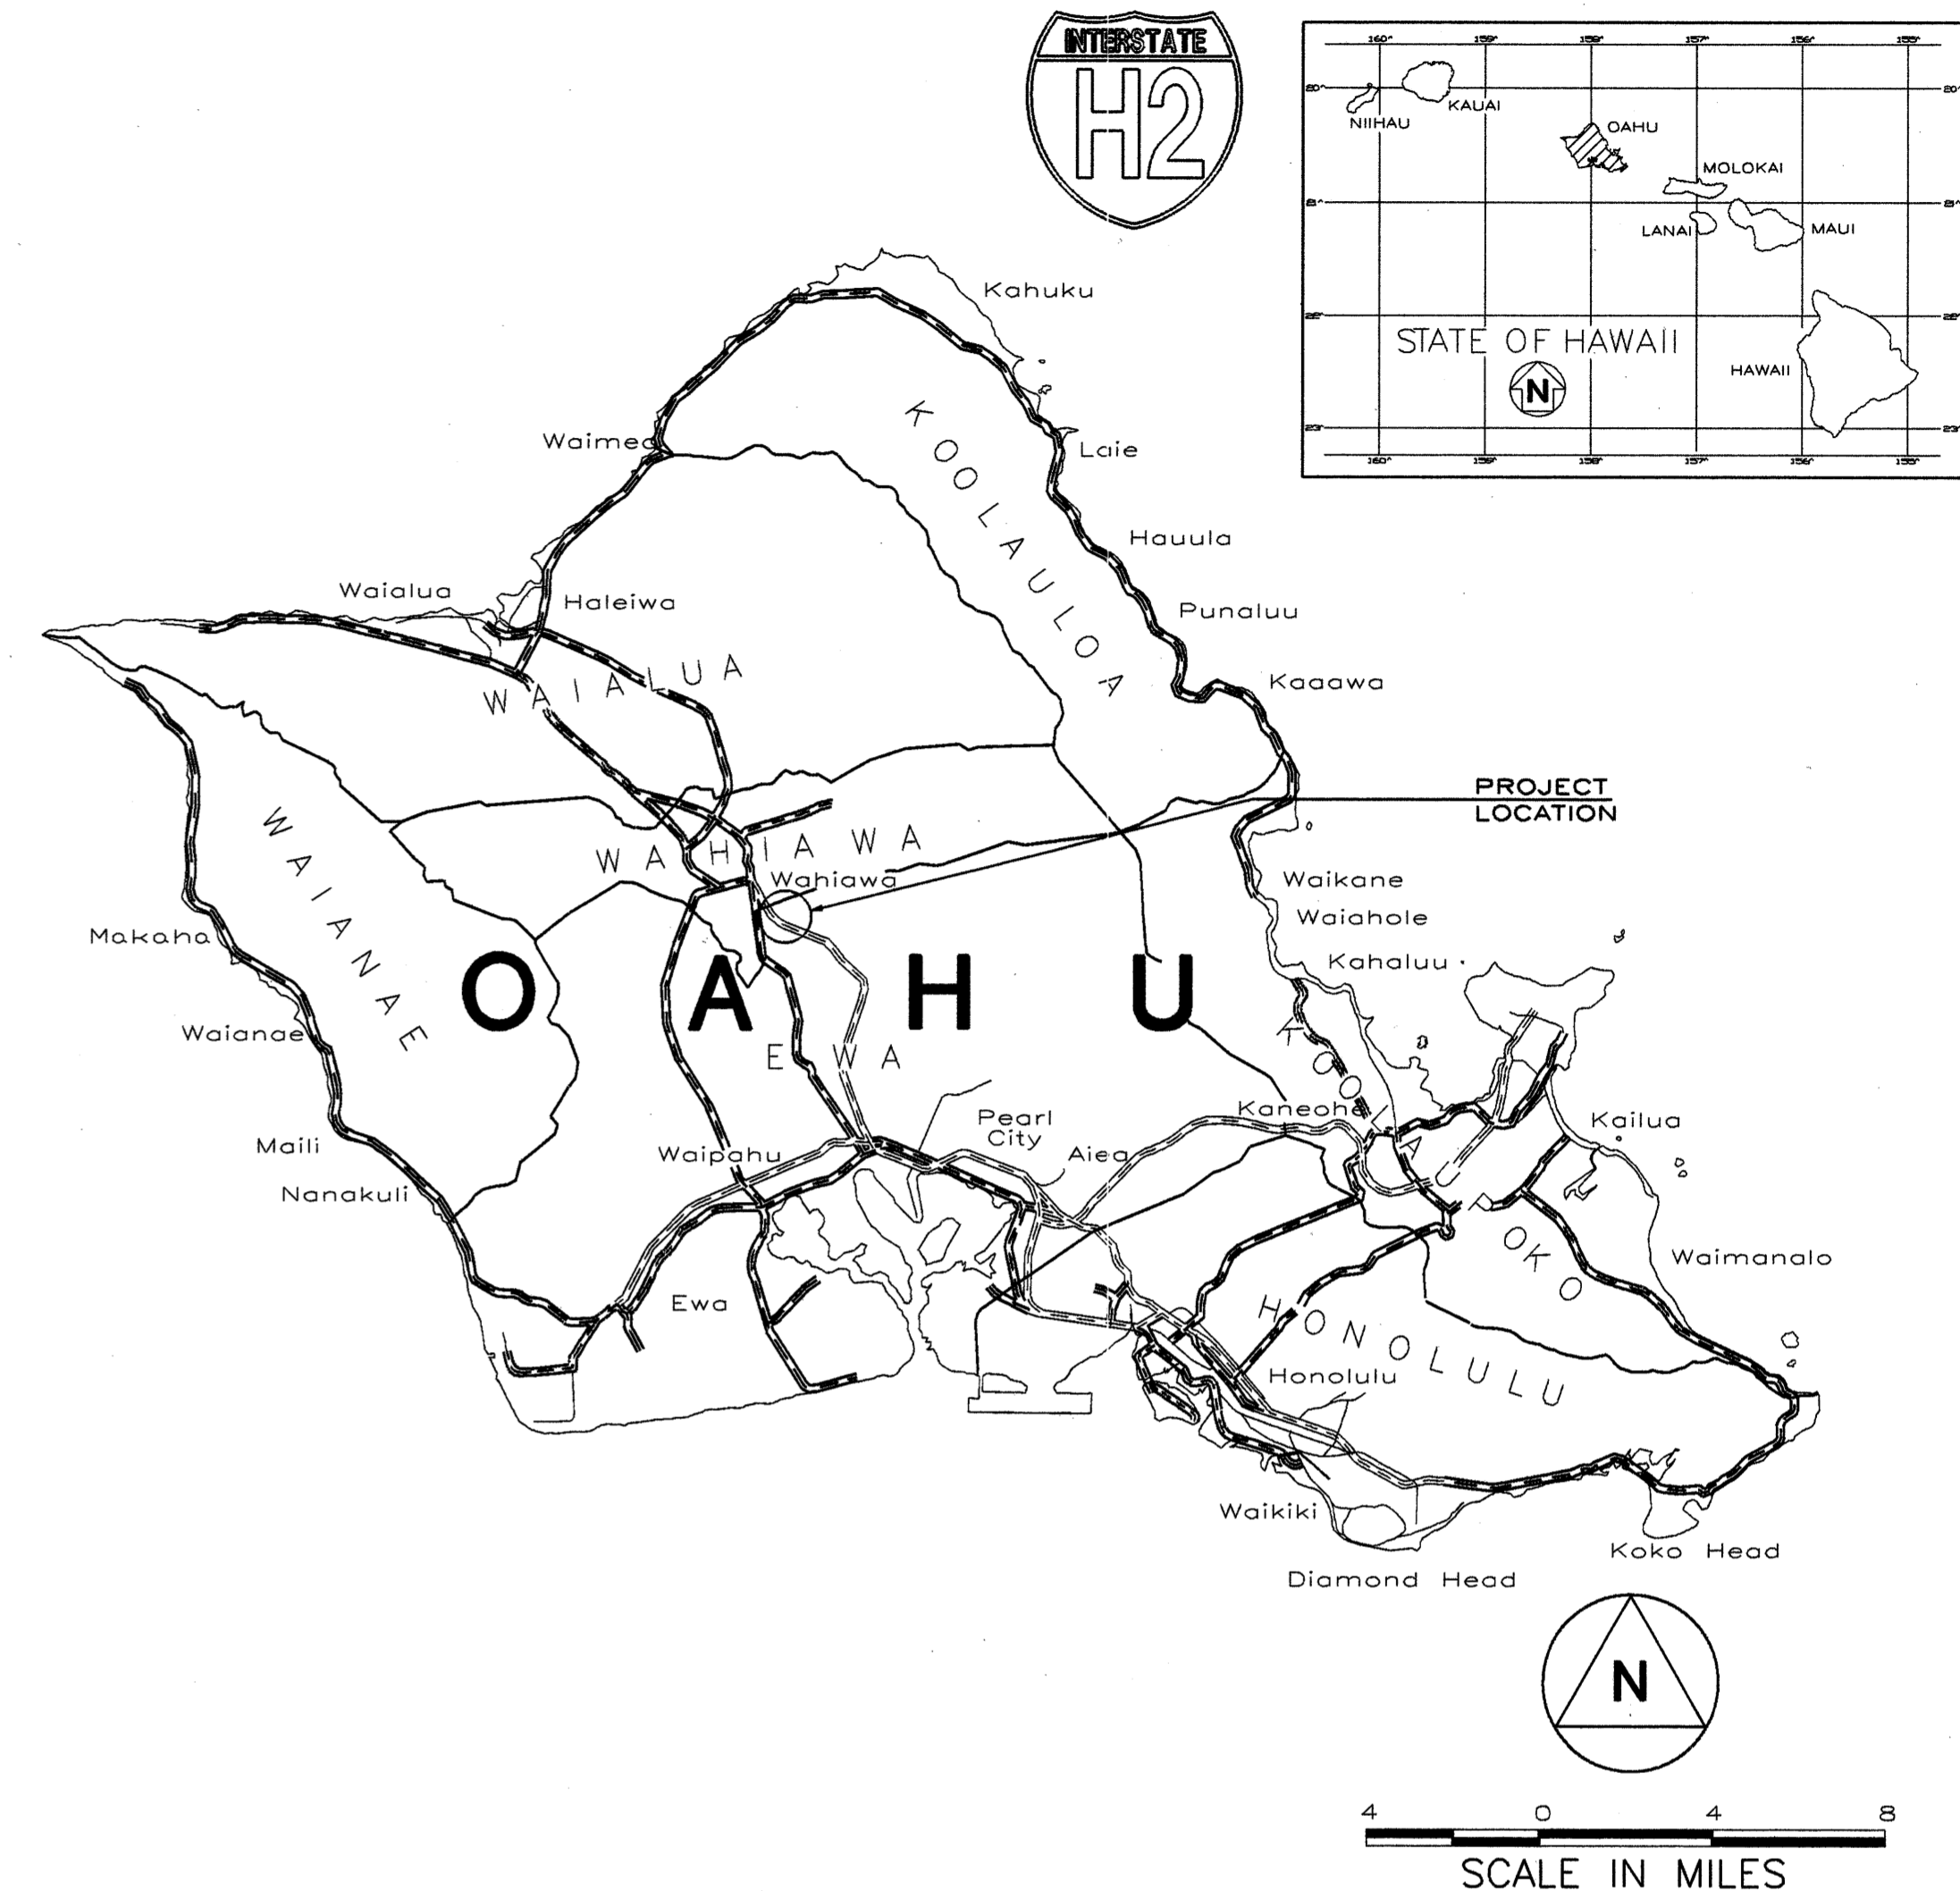

FED. ROAD DIST. NO.	STATE	PROJ. NO.	FISCAL YEAR	SHEET NO.	TOTAL SHEETS
HAWAII	HAW.	H2CDE-01-98	2000	1	12

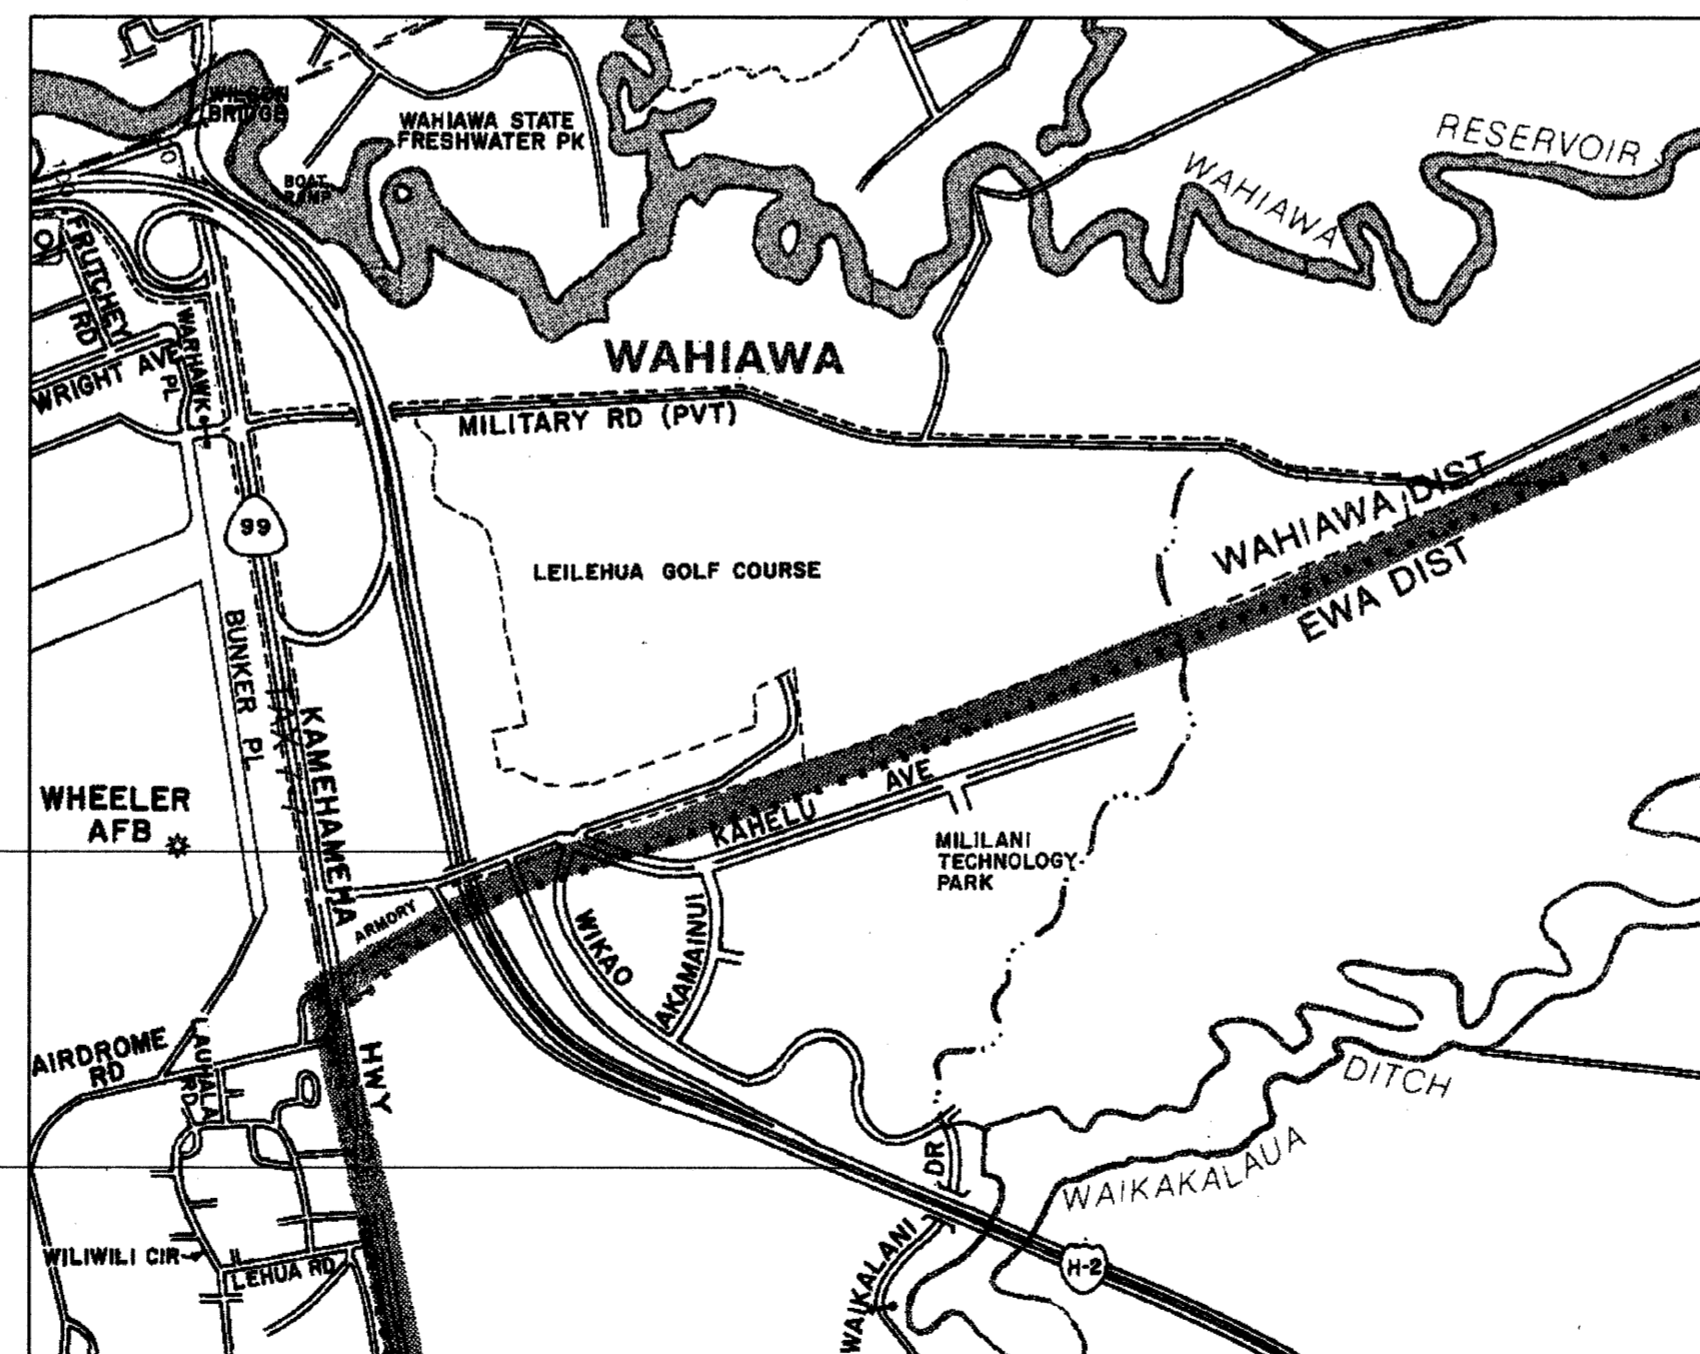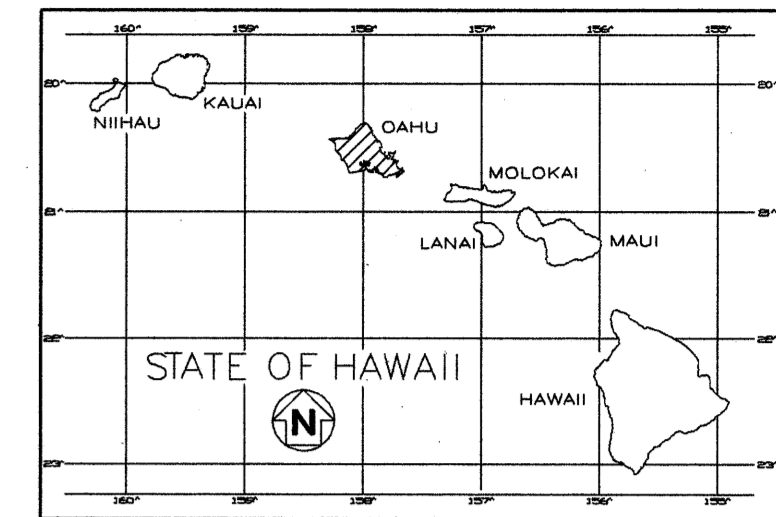

LIMITS OF PROJECT

0.55 MILE

BEGIN PROJECT

P.C. STA. 97 + 95.83

END PROJECT

STA. 127 + 02.91

LAYOUT PLAN

NOT TO SCALE

T.M.K. : 9 - 5 - 02 & 46, 7 - 6 - 01

FEDERAL AID PROJECTS PREVIOUSLY CONSTRUCTED OR UNDER CONSTRUCTION

MILE POST 6.65 TO MILE POST 7.20

CHANGES MADE DURING CONSTRUCTION HAVE BEEN INCORPORATED ON THESE PLANS EXCEPT CHANGES IN THE ORIGINAL THEORETICAL QUANTITIES. FOR ACTUAL QUANTITIES, REFER TO PROJECT LEDGER AND/OR COMPUTATION BOOK.

RESIDENT ENGINEER

DATE

DEPARTMENT OF TRANSPORTATION

STATE OF HAWAII

APPROVED:

DIR. OF TRANSPORTATION

DATE

ORIGINAL PLAN	DATE
DESIGNED BY	11/5/99
DRAWN BY	
NOTED BY	
CHECKED BY	
QUANTITIES BY	
NO.	

Wm. Dean Alcon Assoc. Henry Kennedy 692-7550 Nov. 1999

DESIGNED BY P. S. & E. BY PHONE DATE