
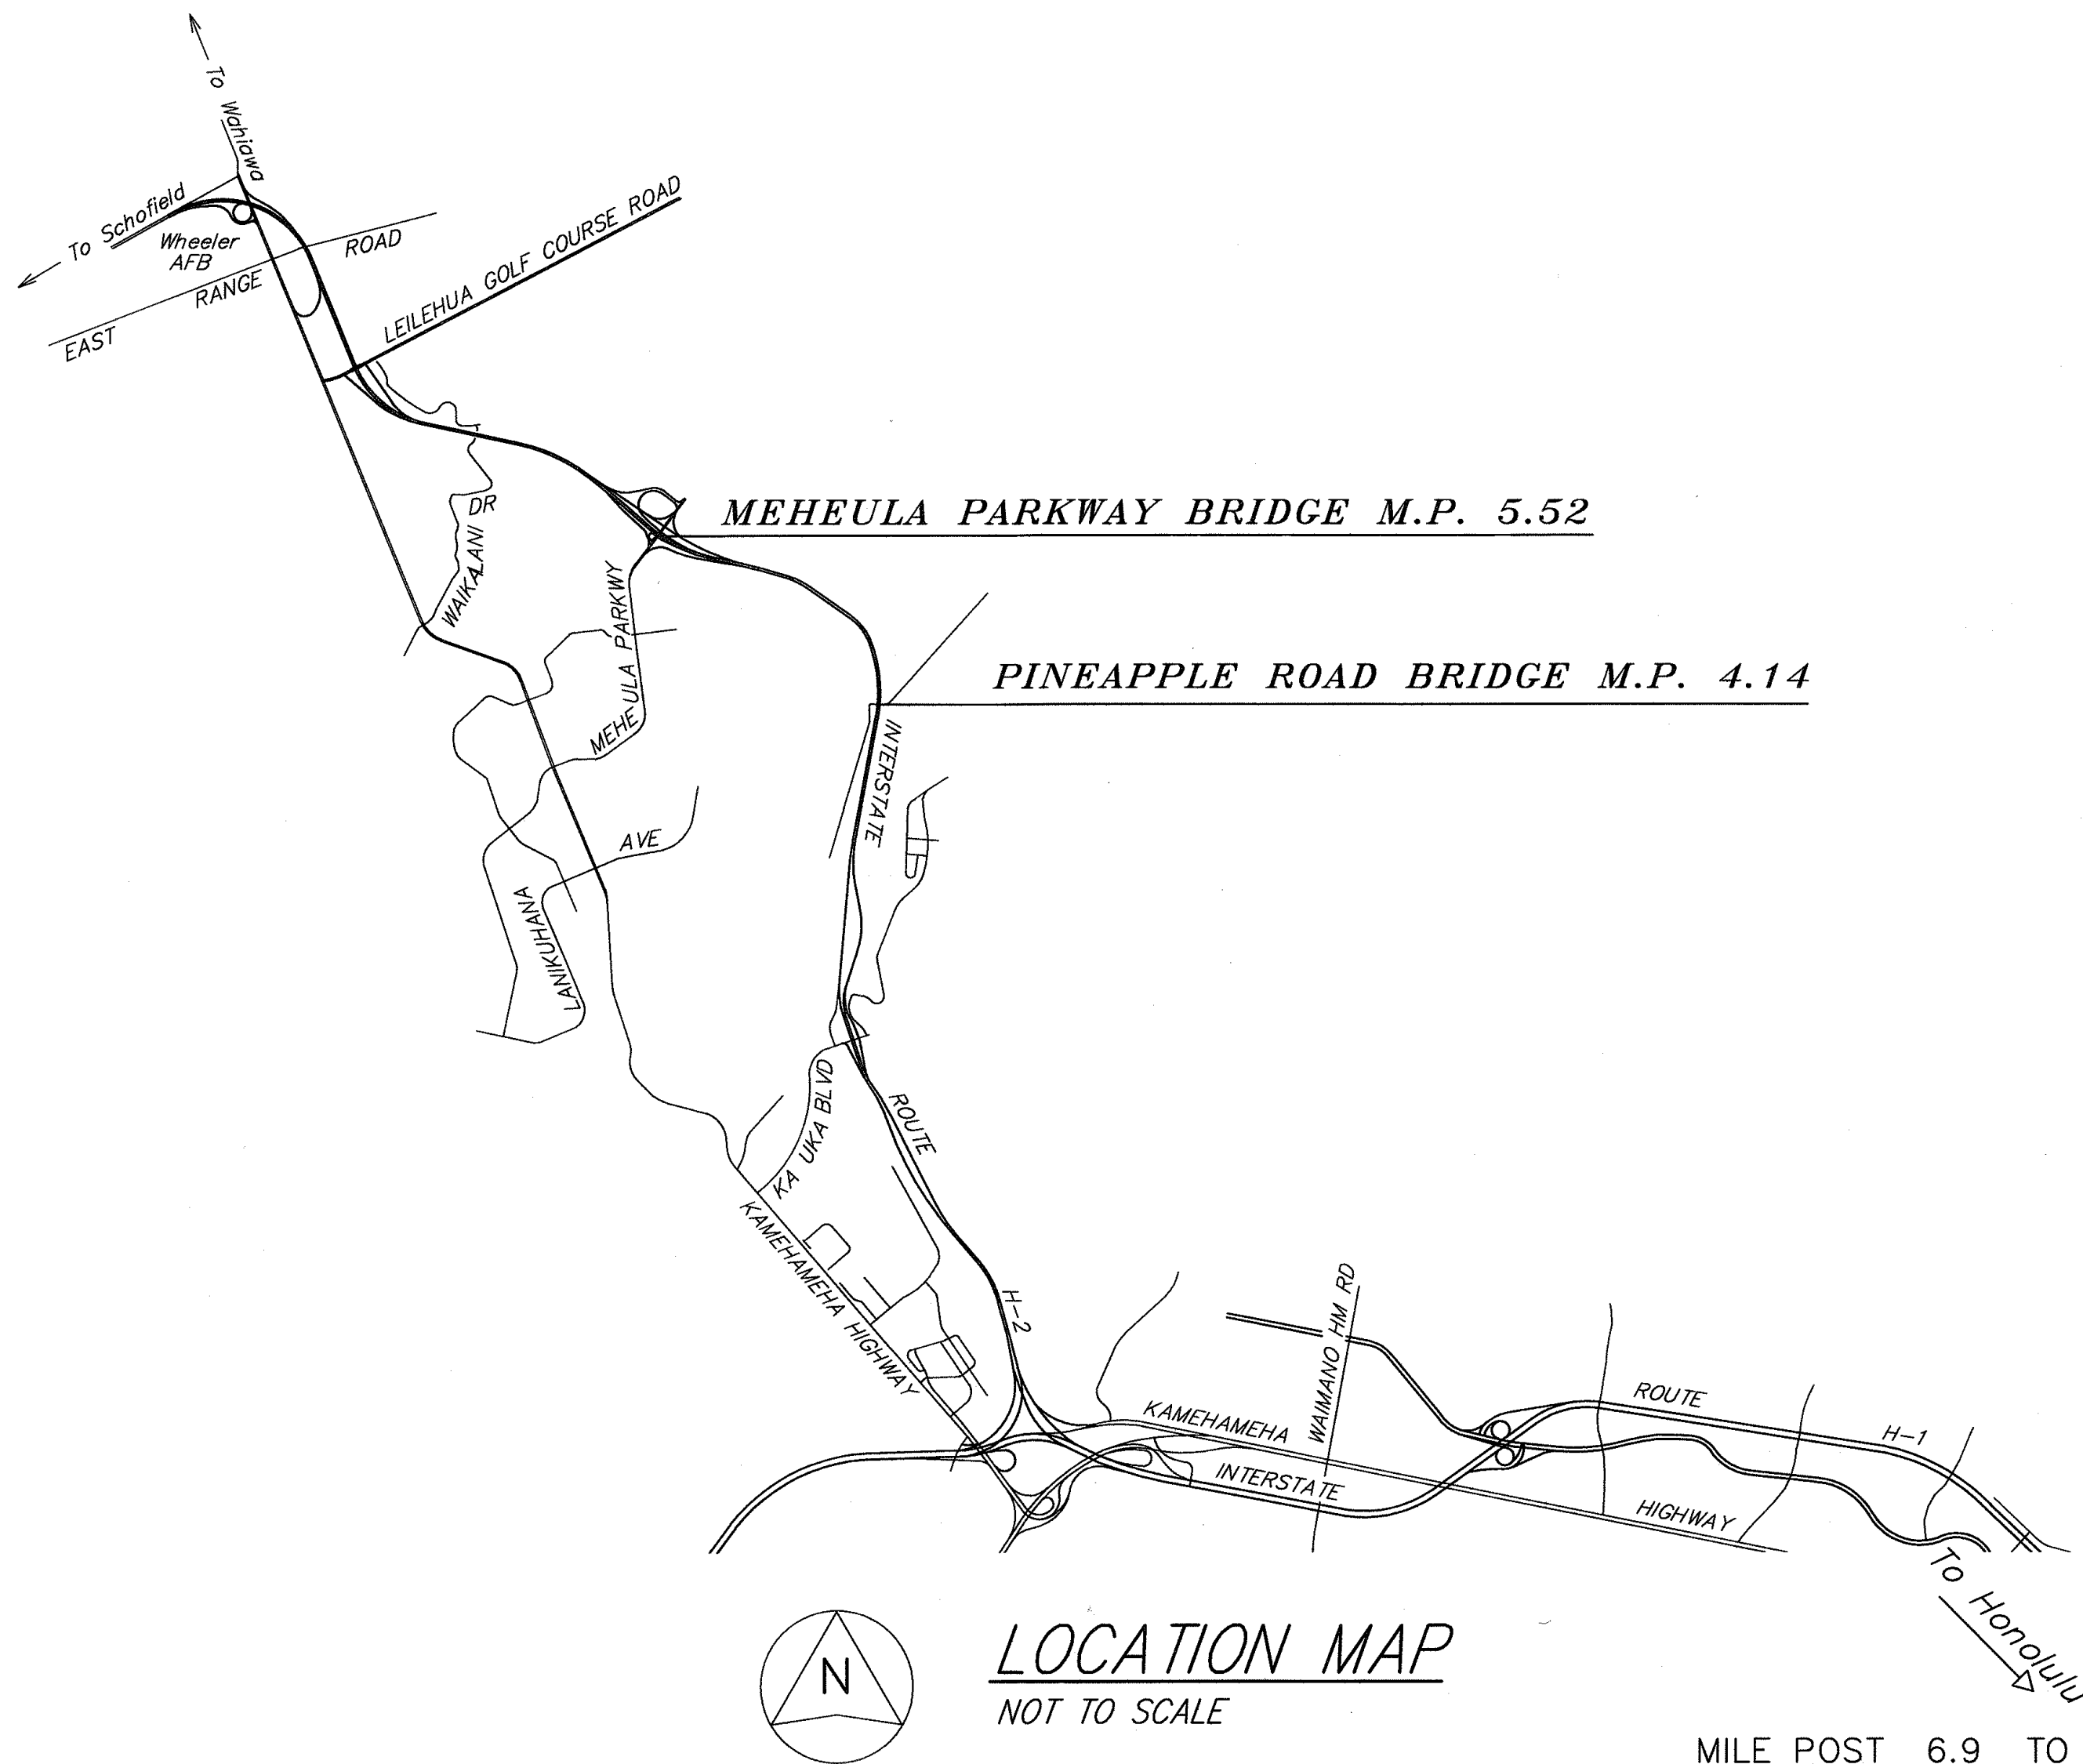
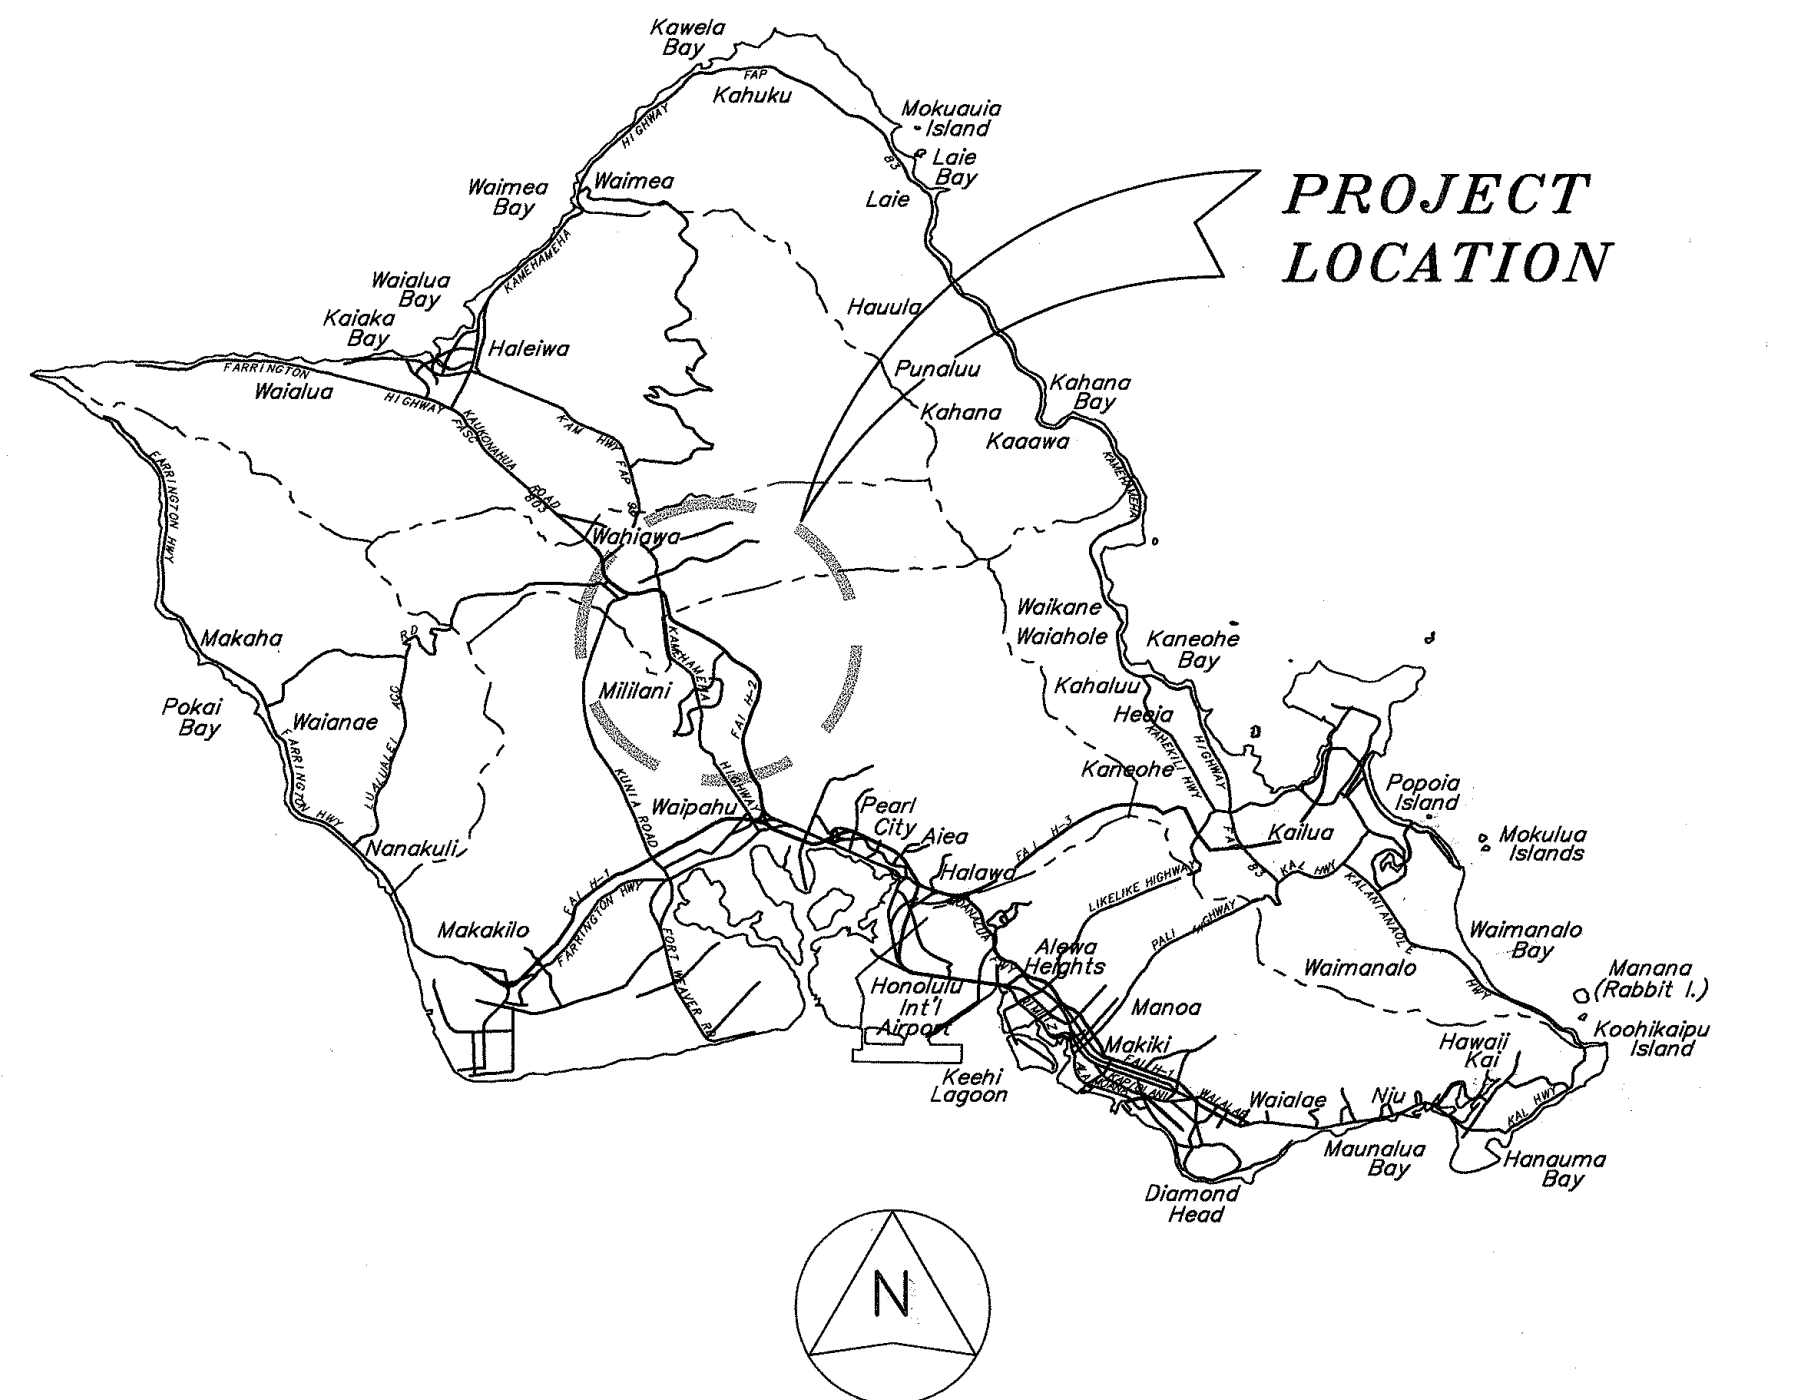
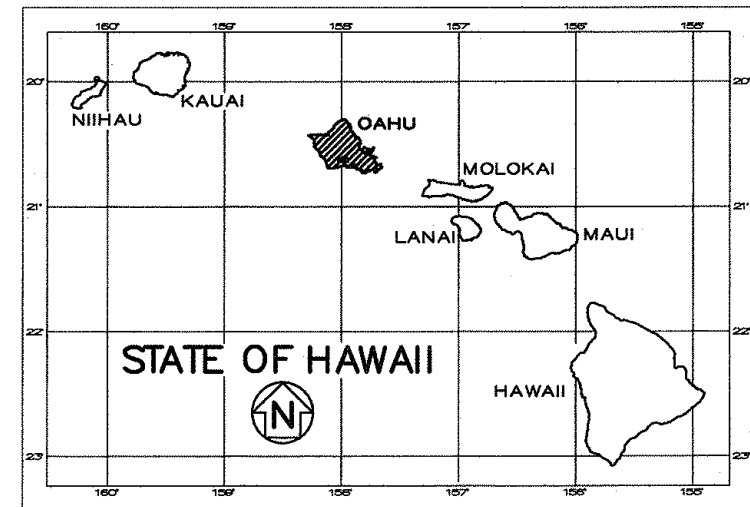


INDEX TO DRAWINGS	
SHEET NO.	DESCRIPTION
1	TITLE SHEET
2	STANDARD PLANS SUMMARY
3-15	TRAFFIC CONTROL PLANS
16	INDEX TO STRUCTURAL DRAWINGS AND ESTIMATED QUANTITIES
17	GENERAL NOTES
18	WATER POLLUTION AND EROSION CONTROL NOTES
19	SYMBOLS AND ABBREVIATIONS
20-25	MEHEULA PARKWAY BRIDGE
26-32	PINEAPPLE ROAD BRIDGE

STATE OF HAWAII
DEPARTMENT OF TRANSPORTATION
HIGHWAYS DIVISION
HONOLULU, HAWAII
"AS-BUILT"
PLANS FOR
INTERSTATE ROUTE H-2 SEISMIC RETROFIT
MEHEULA PARKWAY
AND PINEAPPLE ROAD BRIDGES
FEDERAL AID PROJECT NO. BR-H2-1(32)
DISTRICT OF EWA
ISLAND OF OAHU

FED. ROAD DIST. NO.	STATE	FED. AID PROJ. NO.	FISCAL YEAR	SHEET NO.	TOTAL SHEETS
HAWAII	HAW.	BR-H2-1(32)	2004	1	32

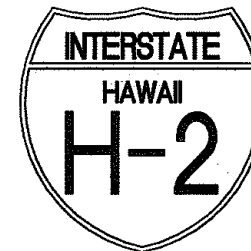

NO SIGNIFICANT CHANGES WERE MADE DURING CONSTRUCTION ON THIS PROJECT EXCEPT CHANGES IN THE ORIGINAL QUANTITIES. FOR ACTUAL QUANTITIES, REFER TO PROJECT LEDGER AND/OR COMPUTATION BOOK.

DESIGN DESIGNATION		
	Interstate Route H-2 at Pineapple Road Bridge	Interstate Route H-2 at Meheula Parkway Bridge
2003 AD	78,200	47,800
2023 AD	89,200	54,600
DHV	6,700	4,400
Design K	7.5	8.0
Design D	60/40	55/45
Design T	1.5	1.5
T24	2.5	2.0
V	70 MPH	70 MPH

DEPARTMENT OF TRANSPORTATION
STATE OF HAWAII
APPROVED: James M. Yamani 1-20-04
DIR. OF TRANSPORTATION DATE
SHEET NO. TO.1 OF 1 SHEETS

ORIGINAL PLAN
NOTE BOOK
No. _____
SURVEY PLOTTED BY _____ DATE _____
DRAWN BY _____
CHECKED BY _____
QUANTITIES BY _____
CHECKED BY _____

KSF, INC. DESIGNED BY _____
HWY-DD 692-7570 JAN. 2004
MANAGE BY _____ PHONE _____ DATE _____

LOCATION MAP
NOT TO SCALE

MILE POST 6.9 TO MILE POST 3.6