



FED. ROAD DIST. NO.	STATE	FED. AID PROJ. NO.	FISCAL YEAR	SHEET NO.	TOTAL SHEETS
HAWAII	HAW.	IM-H2-1(33)	2007	ADD. 76	168

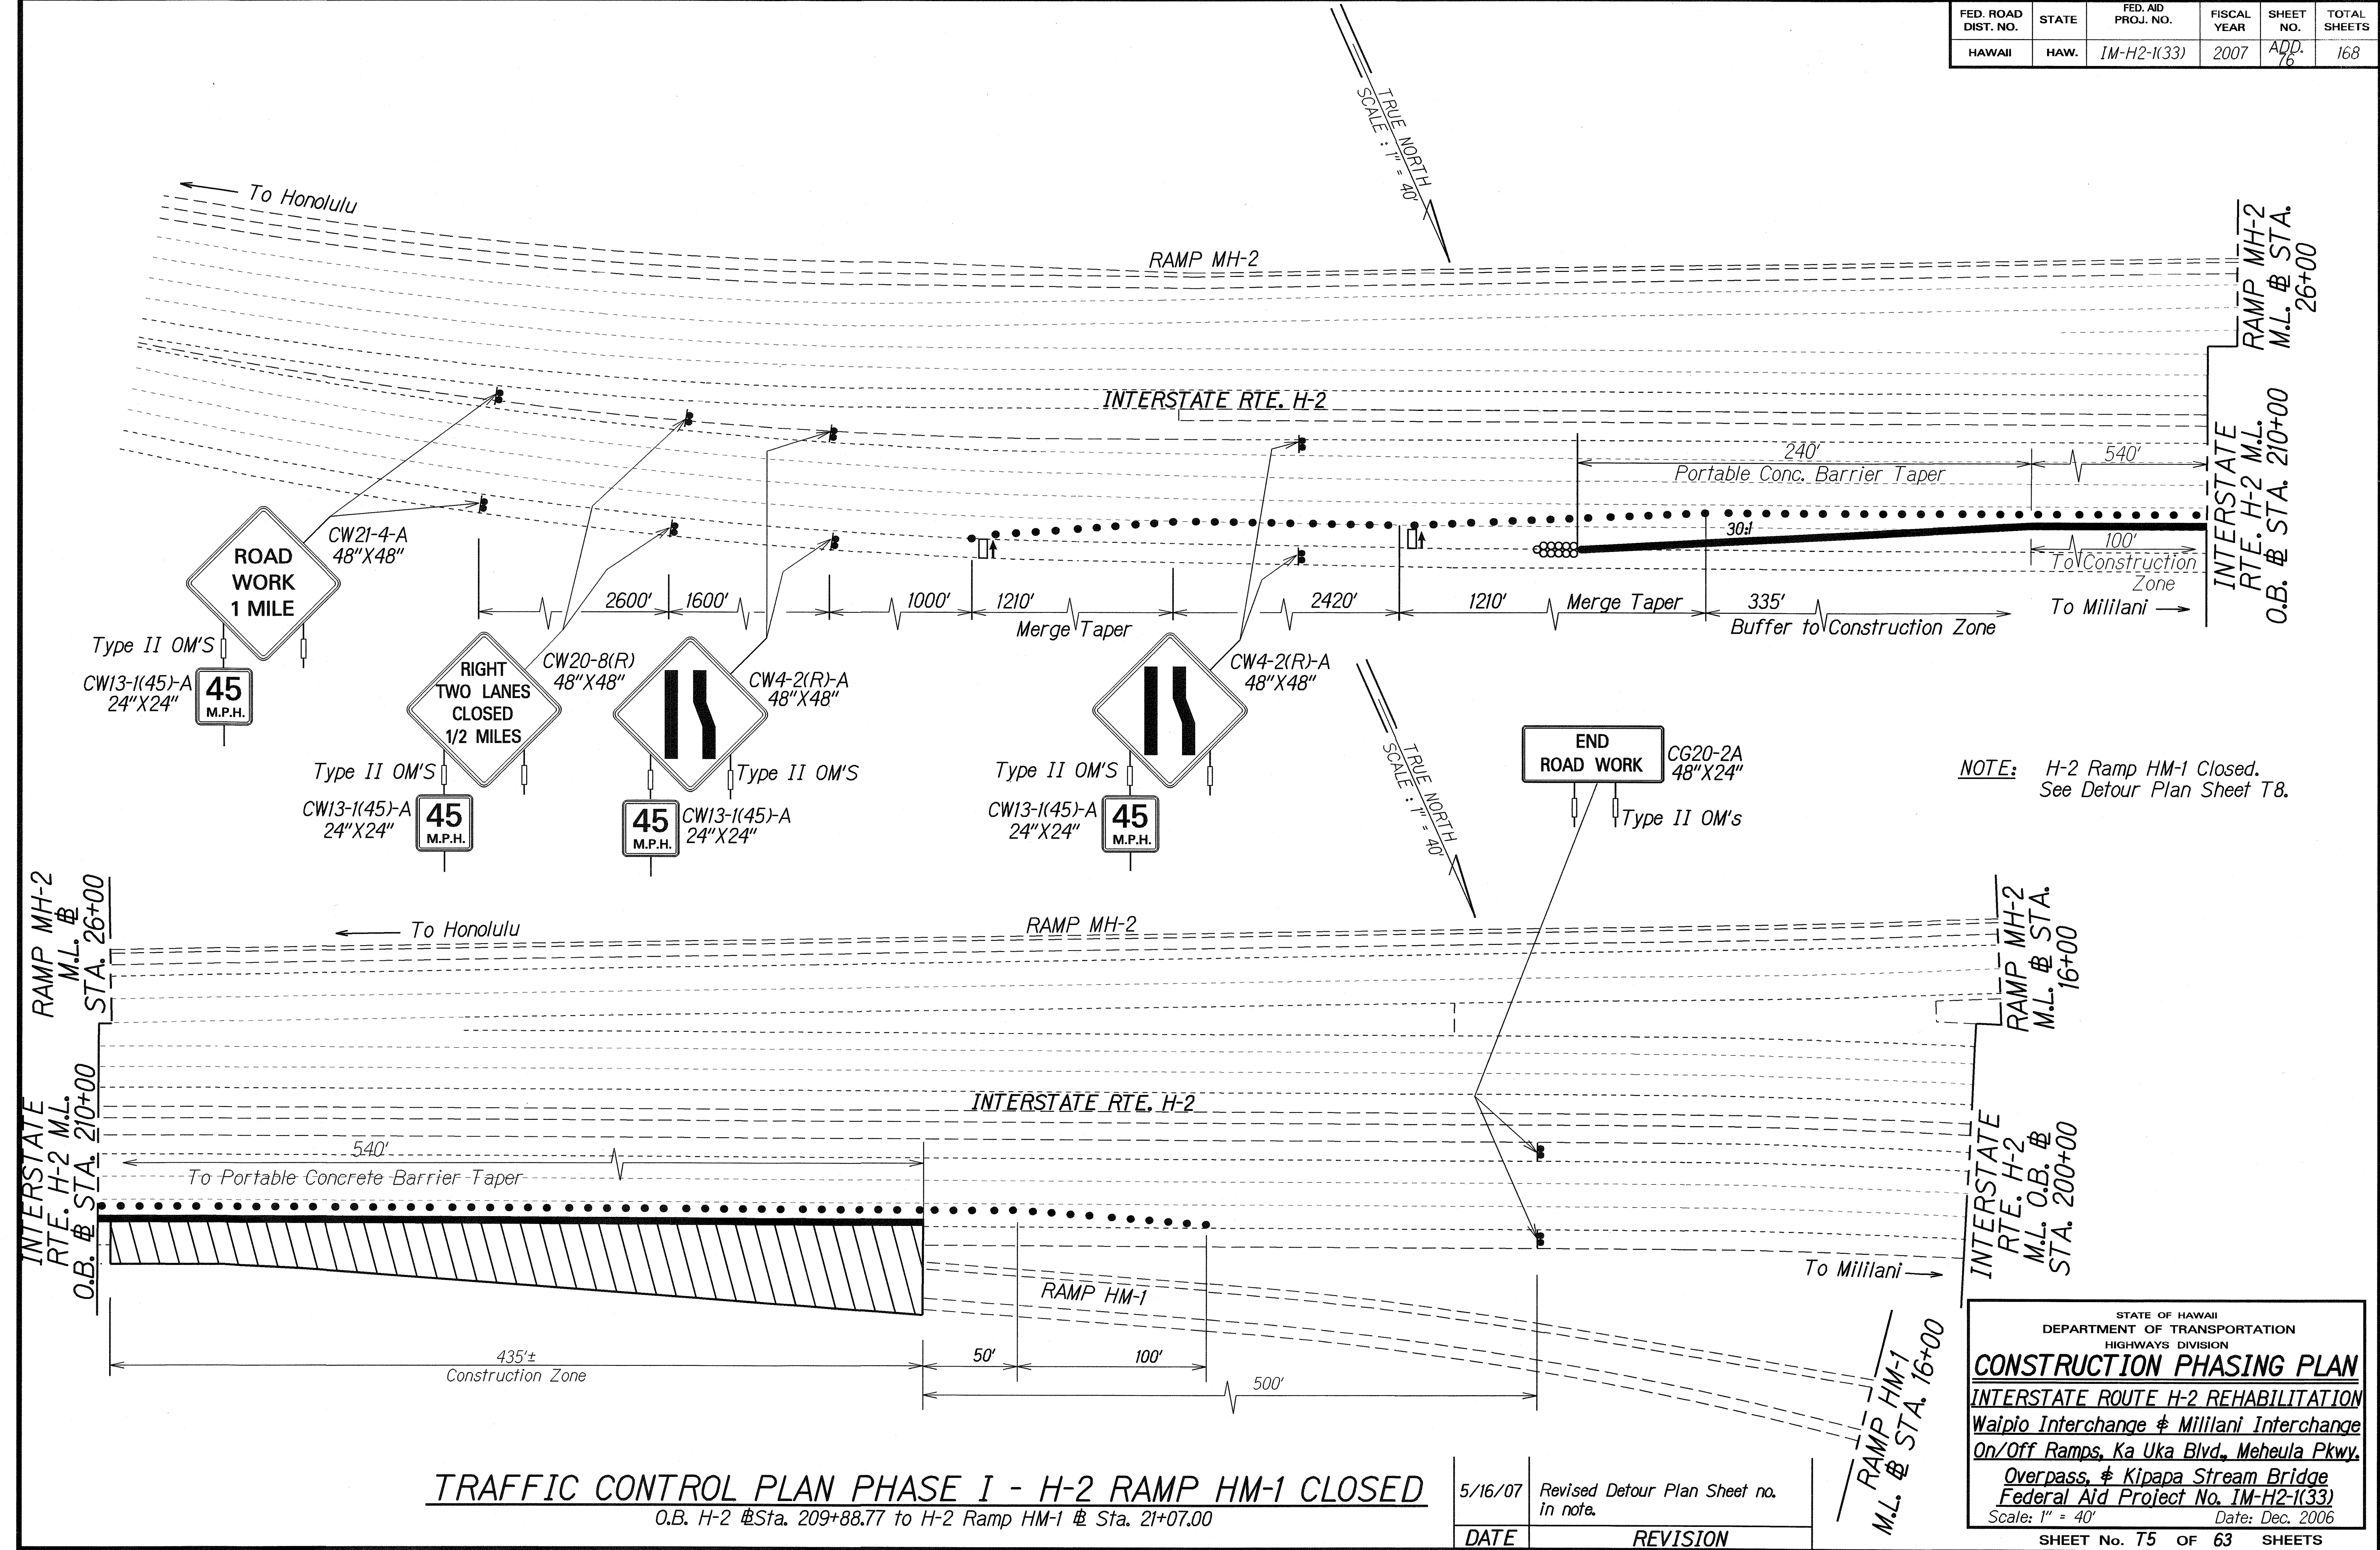

FED. ROAD DIST. NO.	STATE	FED. AID PROJ. NO.	FISCAL YEAR	SHEET NO.	TOTAL SHEETS
HAWAII	HAW.	IM-H2-1(33)	2007	ADD. 77	168

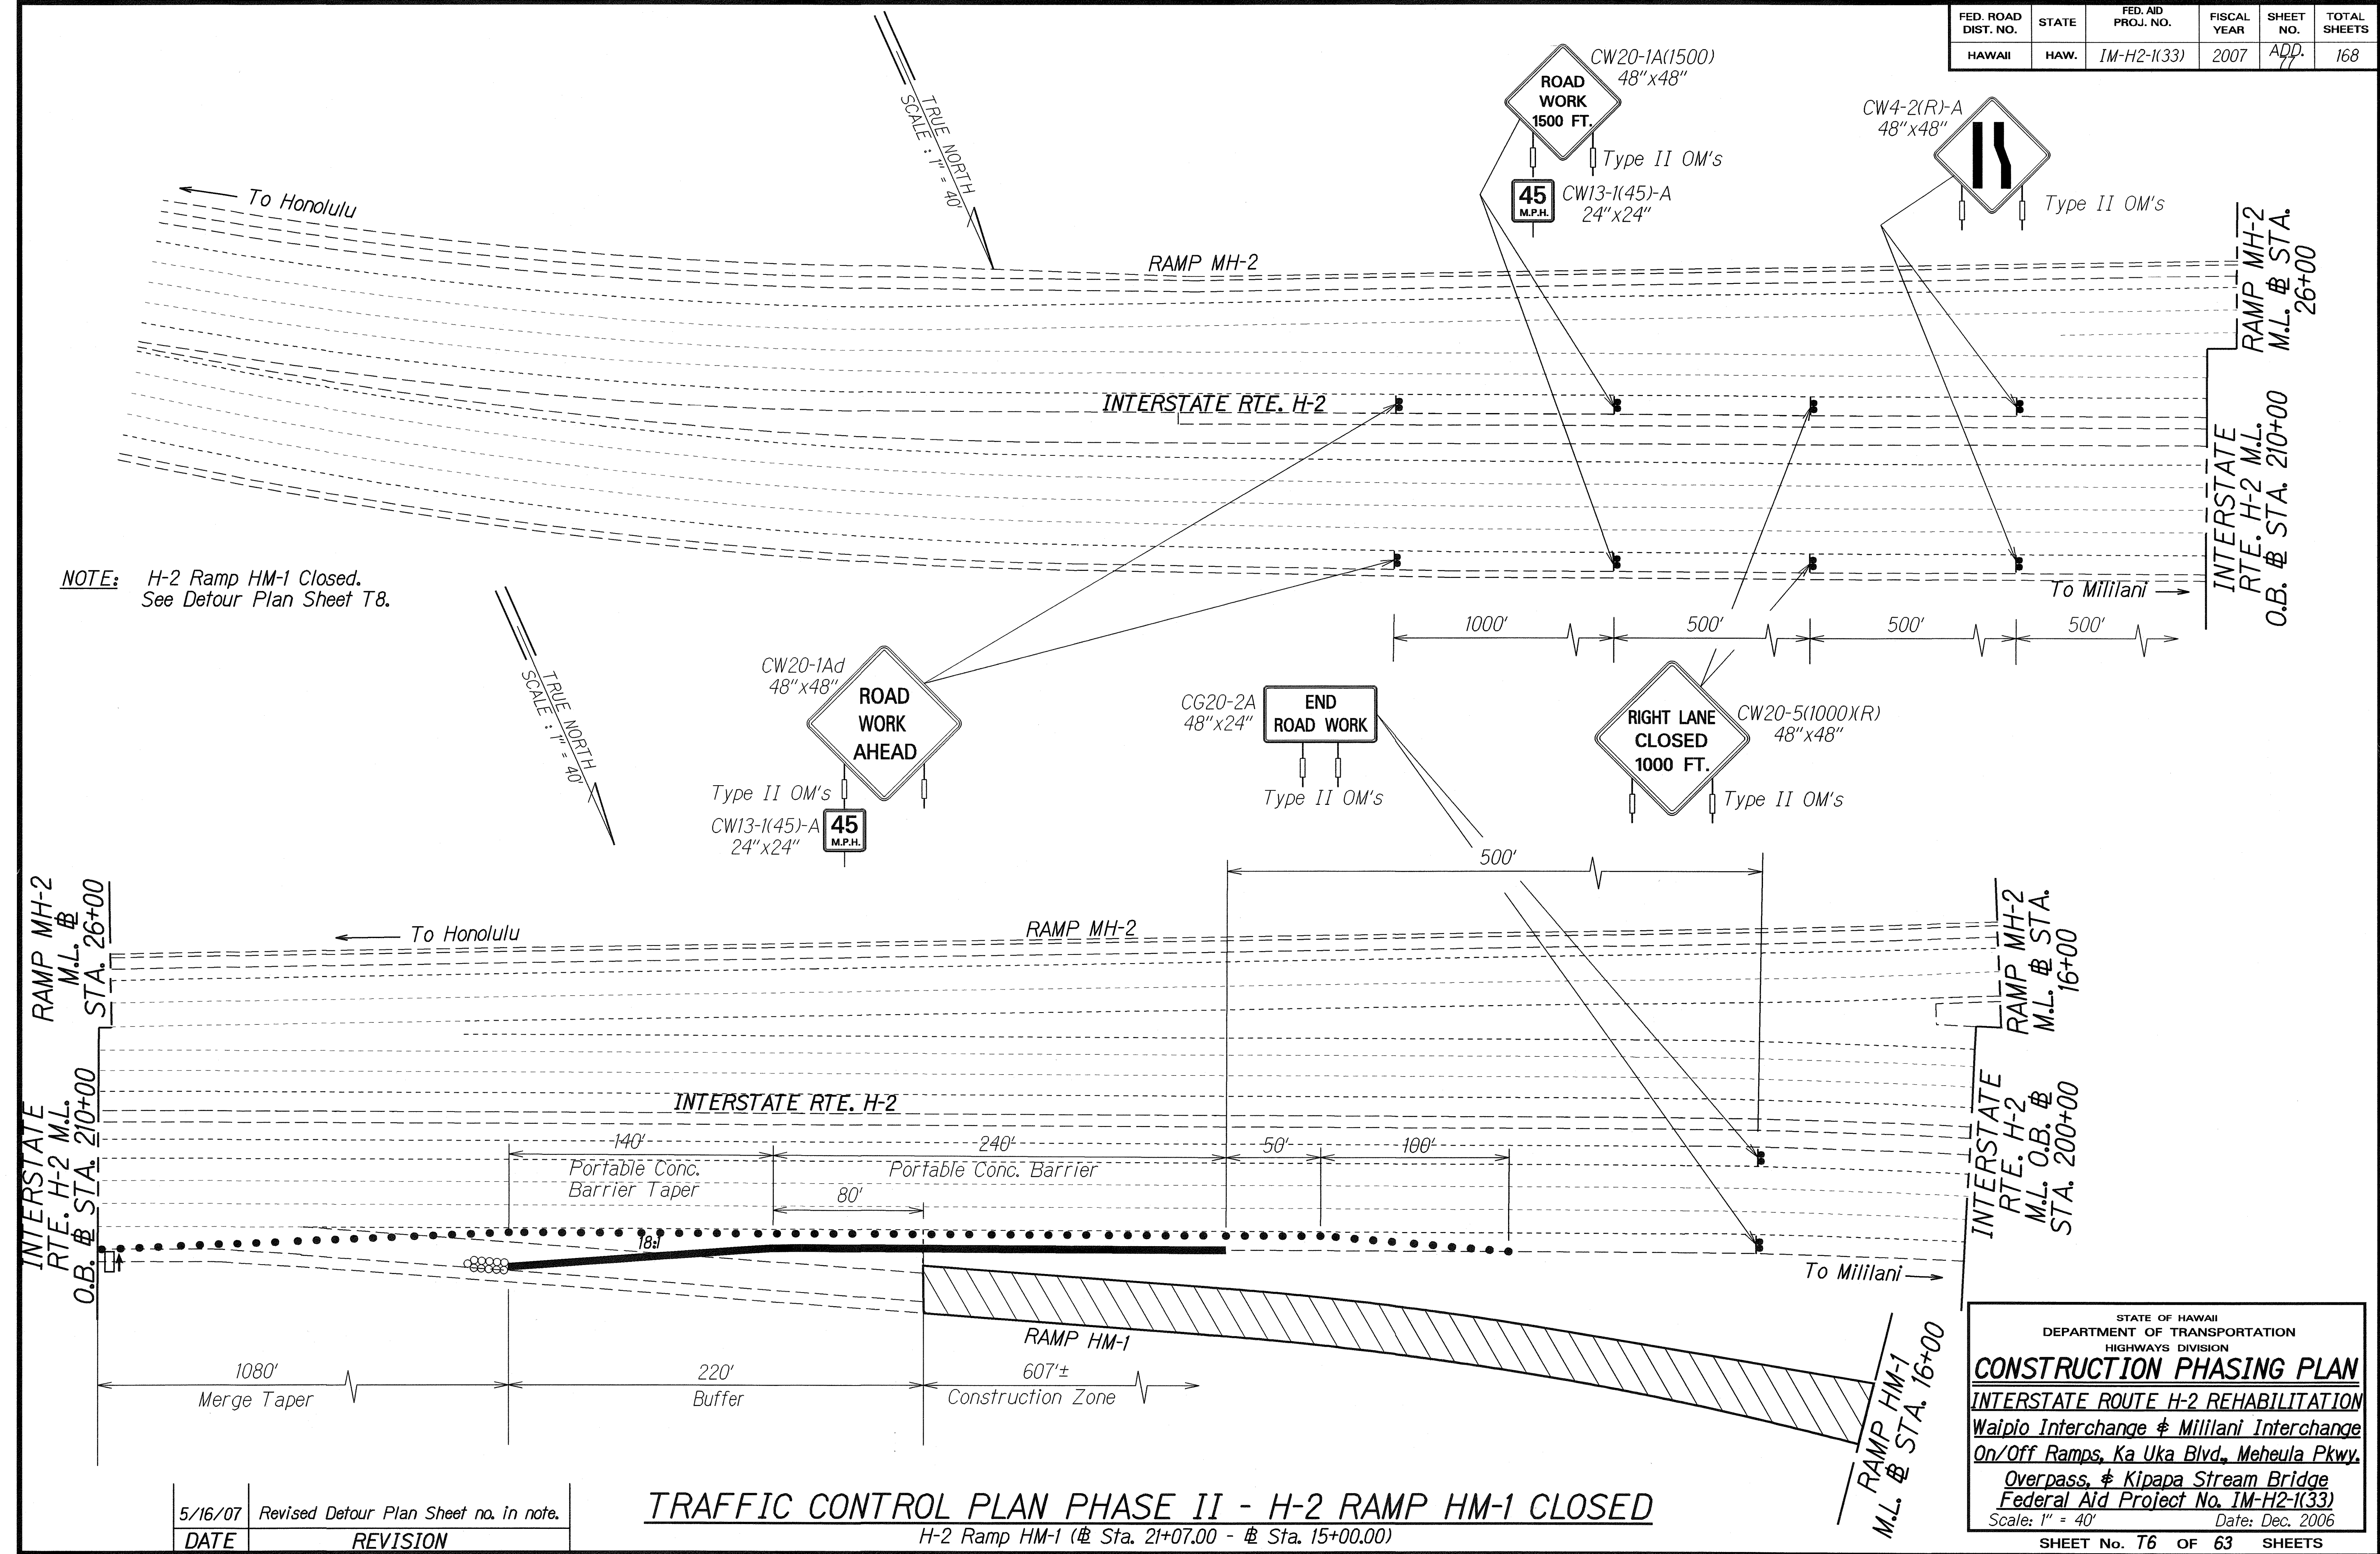

SURVEY PLOTTED BY	DATE
DESIGNED BY	
DESIGNED BY	
QUANTITIES BY	
CHECKED BY	

5/16/07	Revised Detour Plan Sheet no. in note.
DATE	REVISION


STATE OF HAWAII
DEPARTMENT OF TRANSPORTATION
HIGHWAYS DIVISION

CONSTRUCTION PHASING PLAN
INTERSTATE ROUTE H-2 REHABILITATION
Waipio Interchange & Mililani Interchange
On/Off Ramps, Ka Uka Blvd., Meheula Pkwy.
Overpass, & Kipapa Stream Bridge
Federal Aid Project No. IM-H2-1(33)
Scale: 1" = 40' Date: Dec. 2006

SHEET No. 76 OF 63 SHEETS

FED. ROAD DIST. NO.	STATE	FED. AID PROJ. NO.	FISCAL YEAR	SHEET NO.	TOTAL SHEETS
HAWAII	HAW.	IM-H2-1(33)	2007	ADD. 78	168

NOTE: H-2 Ramp HM-1 Closed.
See Detour Plan Sheet T8.

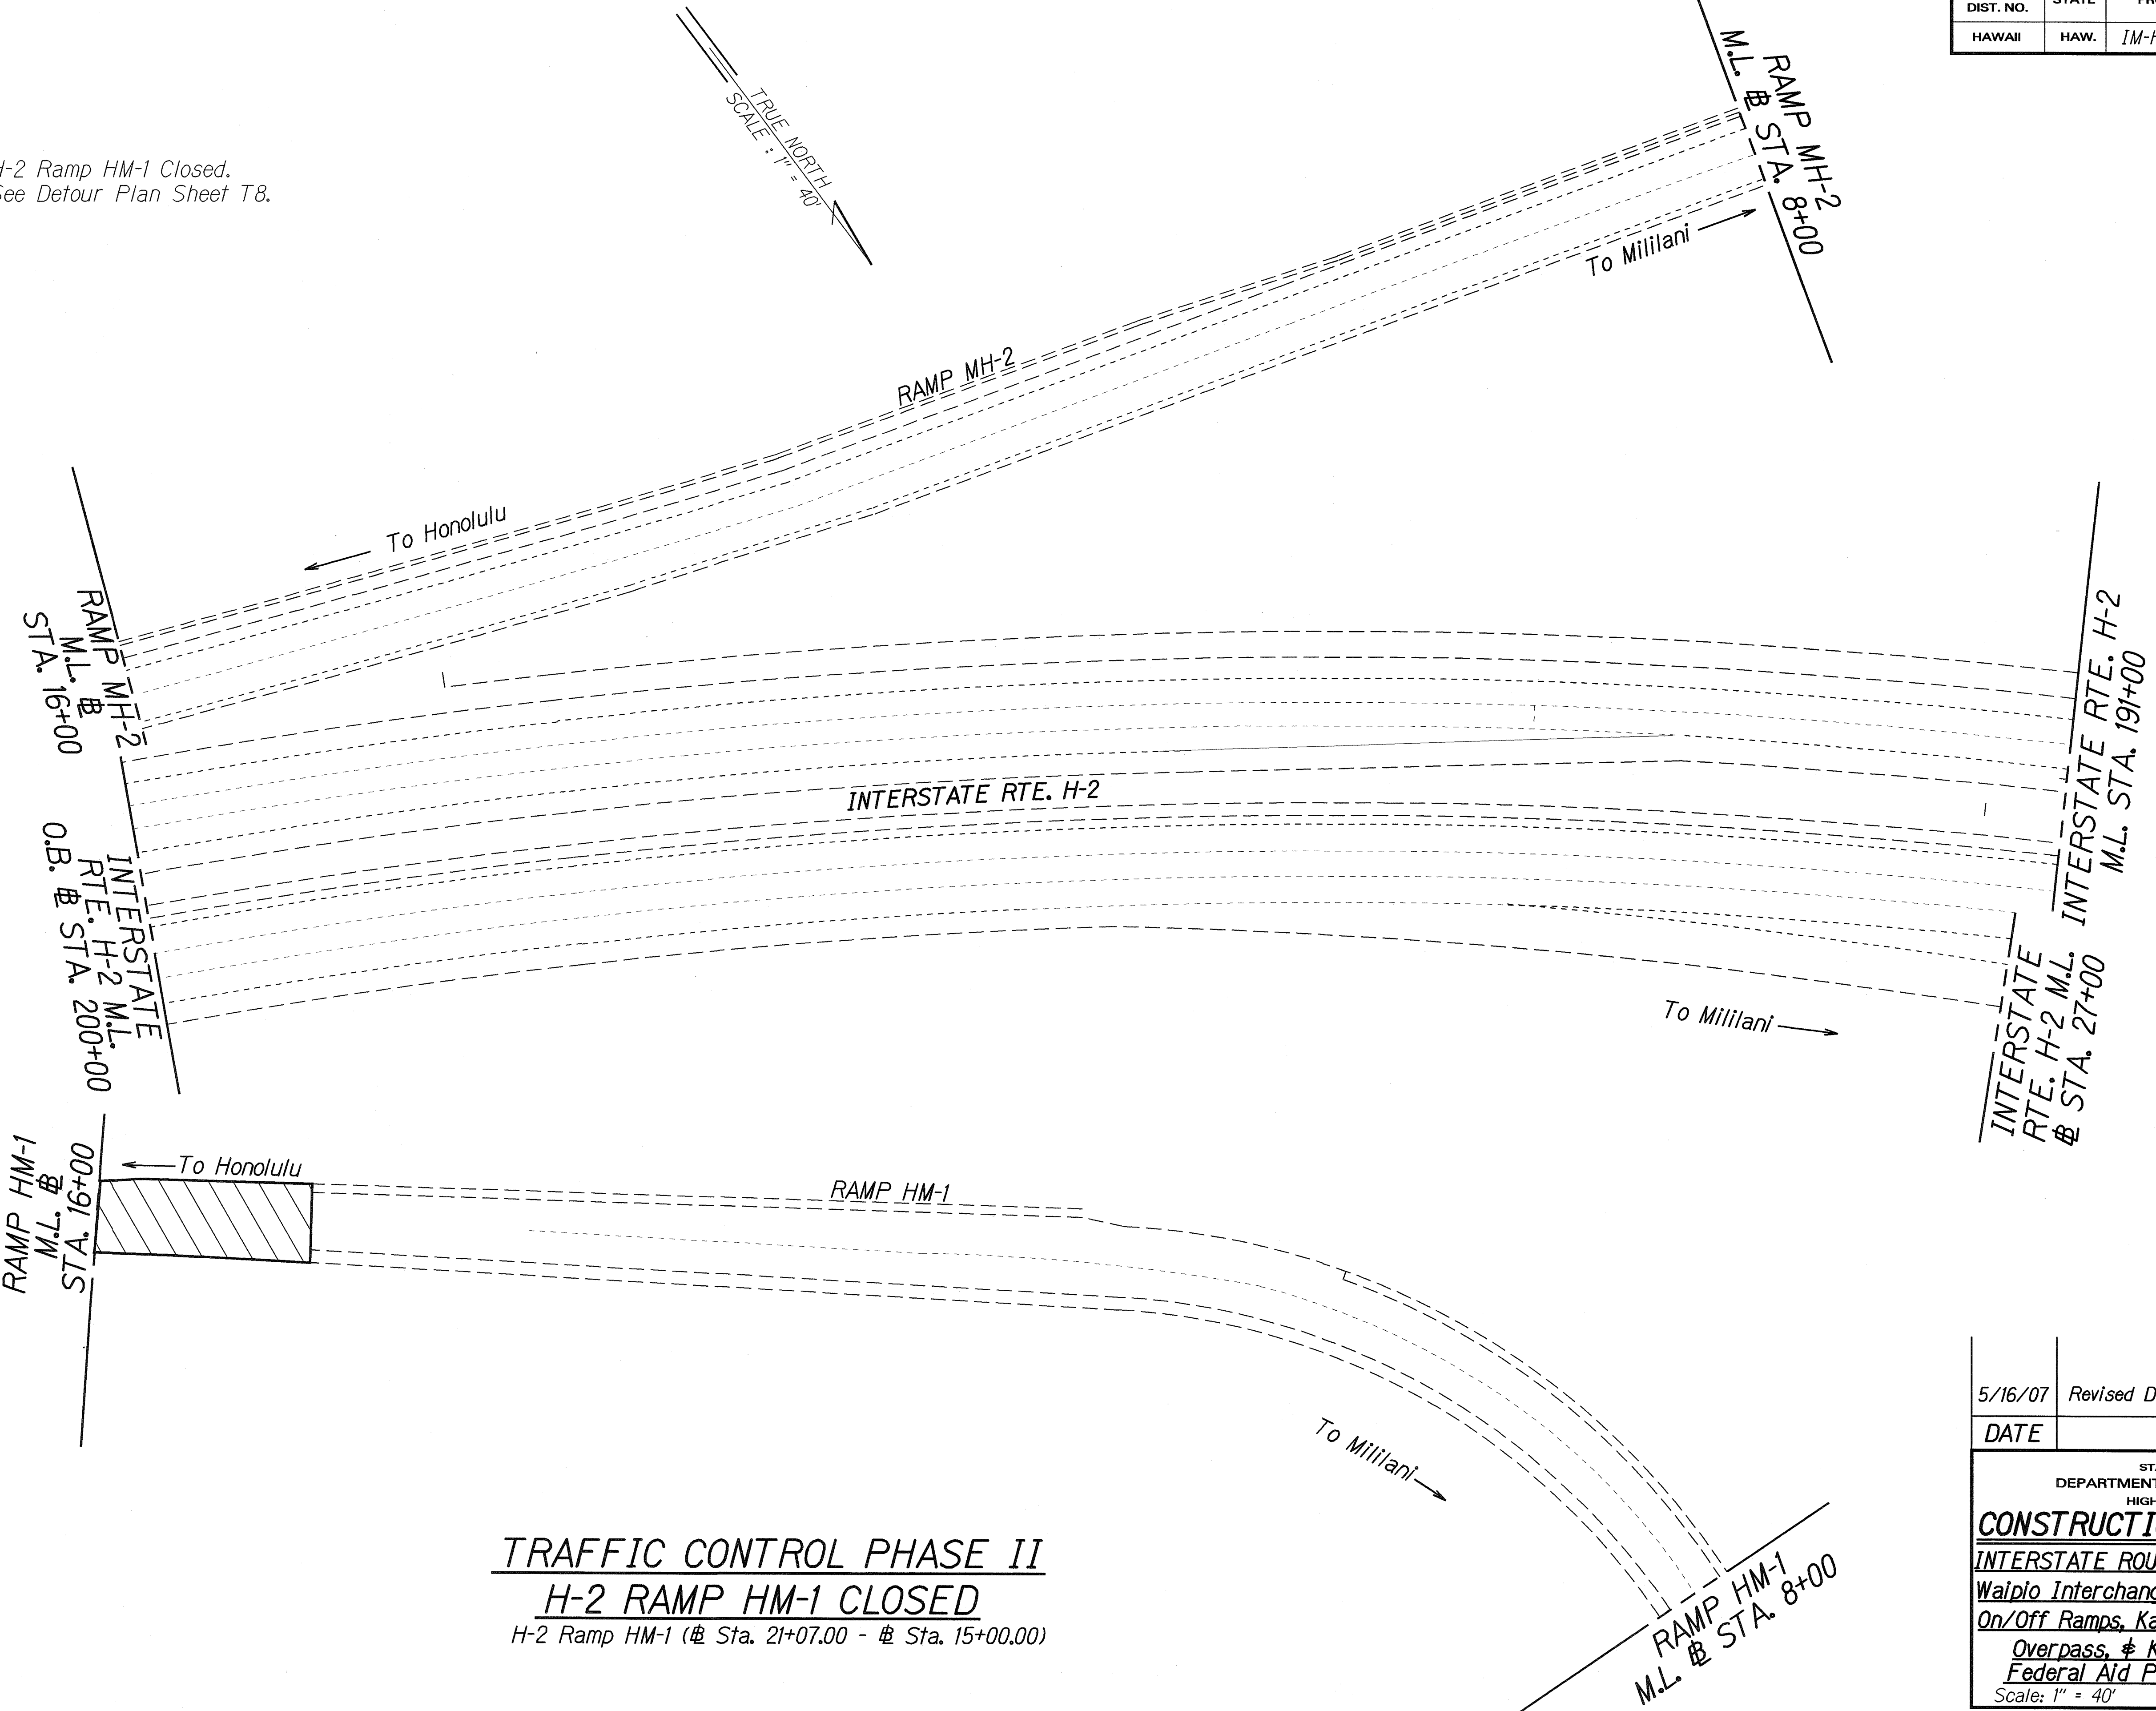

TRAFFIC CONTROL PHASE II
H-2 RAMP HM-1 CLOSED
H-2 Ramp HM-1 (& Sta. 21+07.00 - & Sta. 15+00.00)

5/16/07	Revised Detour Plan Sheet no. in note.
DATE	REVISION
STATE OF HAWAII DEPARTMENT OF TRANSPORTATION HIGHWAYS DIVISION CONSTRUCTION PHASING PLAN INTERSTATE ROUTE H-2 REHABILITATION Waipio Interchange & Mililani Interchange On/Off Ramps, Ka Uka Blvd., Meheula Pkwy. Overpass, & Kipapa Stream Bridge Federal Aid Project No. IM-H2-1(33) Scale: 1" = 40' Date: Dec. 2006	
SHEET No. 77 OF 63 SHEETS	

ORIGINAL PLAN	SURVEY PLOTTED BY	DATE
NOTE BOOK	DRAWN BY	12/2/06
10/2/06	DESIGNED BY	12/2/06
12/2/06	QUANTITIES BY	12/2/06
12/2/06	CHECKED BY	12/2/06

FED. ROAD DIST. NO.	STATE	FED. AID PROJ. NO.	FISCAL YEAR	SHEET NO.	TOTAL SHEETS
HAWAII	HAW.	IM-H2-1(33)	2007	79	168

CW20-2d
(48"x48")

CM4-6a Supplement
(MILILANI MAUKA)
(30"x24")

1

CM4-8a
(24"x18")

CM4-6a Supplement
(MILILANI MAUKA)
(30"x24")

2

CM4-6a Supplement
(MILILANI MAUKA)
(30"x24")

CM4-9(S)
(30"x30")

a1

CM4-6a Supplement
(MILILANI MAUKA)
(30"x24")

CM4-9(DR)
(30"x30")

a2

CM4-6a Supplement
(MILILANI MAUKA)
(30"x24")

CM4-9(R)
(30"x24")


a3

CM4-6a Supplement
(MILILANI MAUKA)
(30"x24")

CM4-9(UL)
(30"x30")

a4

DETOUR PLAN FOR CONSTRUCTION
PHASE I & PHASE II
Not to Scale

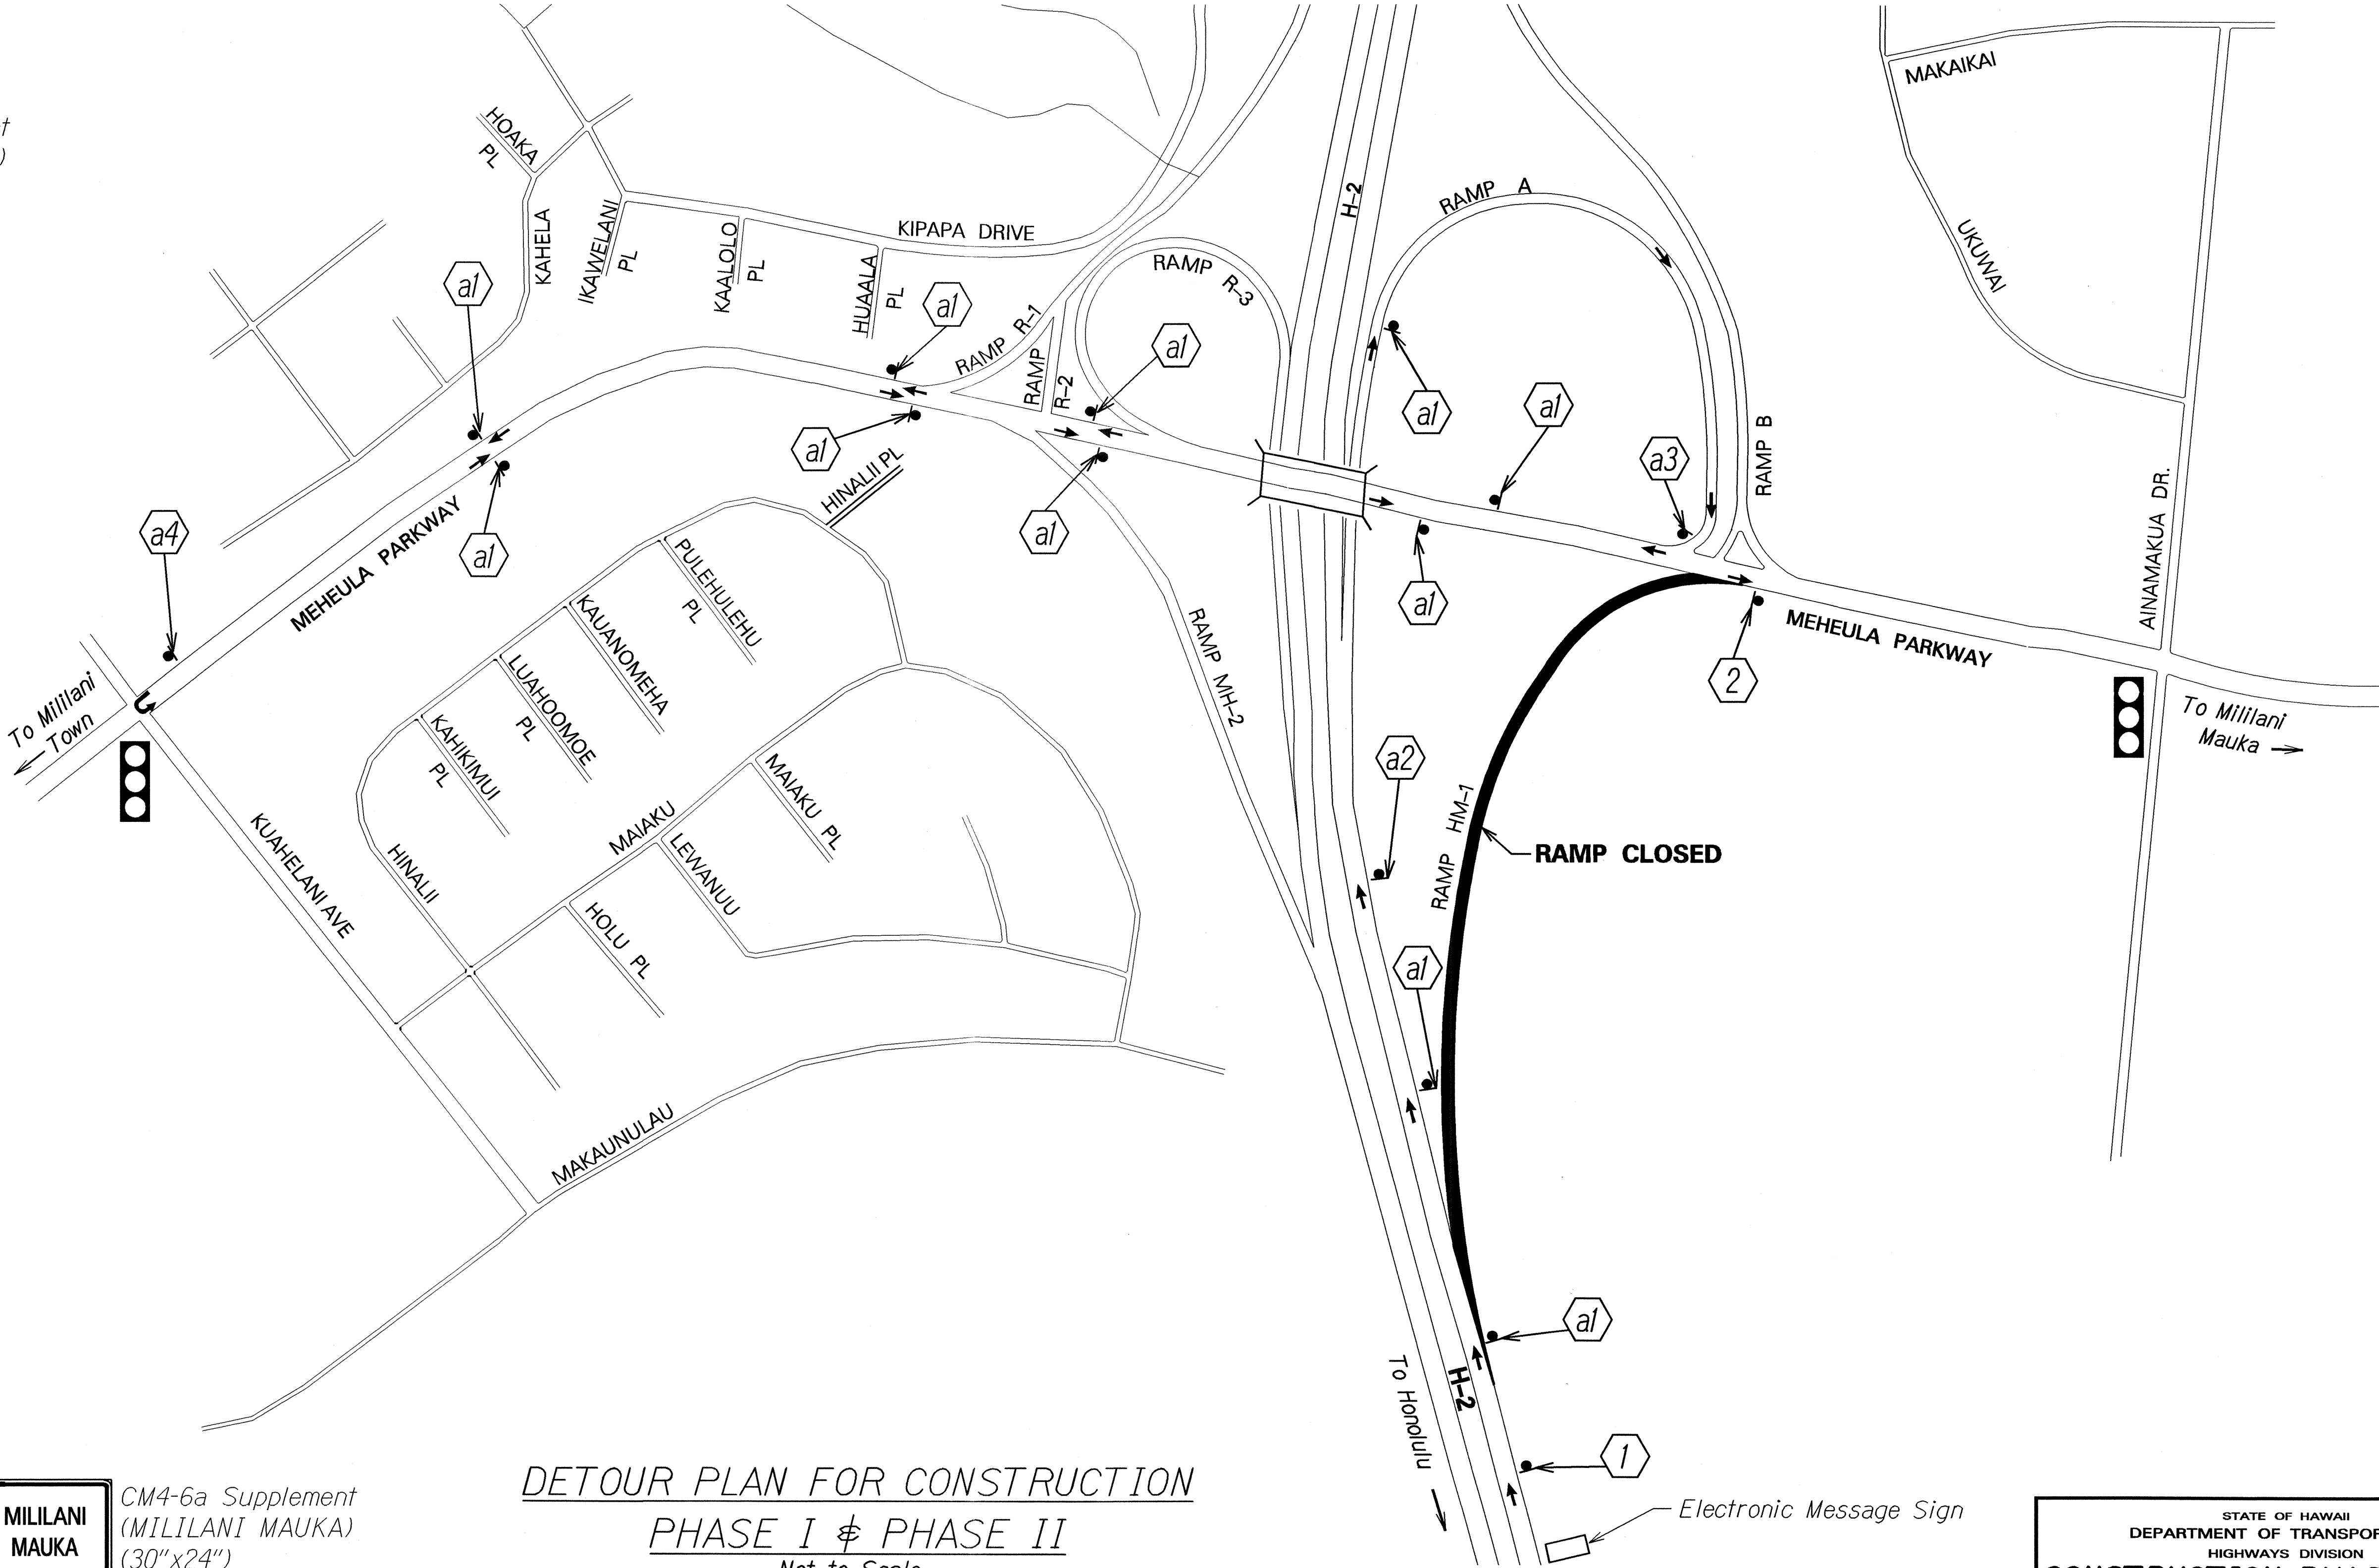


ORIGINAL PLAN	SURVEY PLOTTED BY	DATE
NOTED BOOK	DRAWN BY	4/24/06
NOTED BY	DESIGNED BY	
NOTED BY	CHECKED BY	
NOTED BY	CHECKED BY	

STATE OF HAWAII
DEPARTMENT OF TRANSPORTATION
HIGHWAYS DIVISION

CONSTRUCTION PHASING PLAN
INTERSTATE ROUTE H-2 REHABILITATION
Waipio Interchange & Mililani Interchange
On/Off Ramps, Ka Uka Blvd, Meheula Pkwy.
Overpass, & Kipapa Stream Bridge
Federal Aid Project No. IM-H2-1(33)
Not to Scale Date: Dec. 2006

FED. ROAD DIST. NO.	STATE	FED. AID PROJ. NO.	FISCAL YEAR	SHEET NO.	TOTAL SHEETS
HAWAII	HAW.	IM-H2-1(33)	2007	80	168

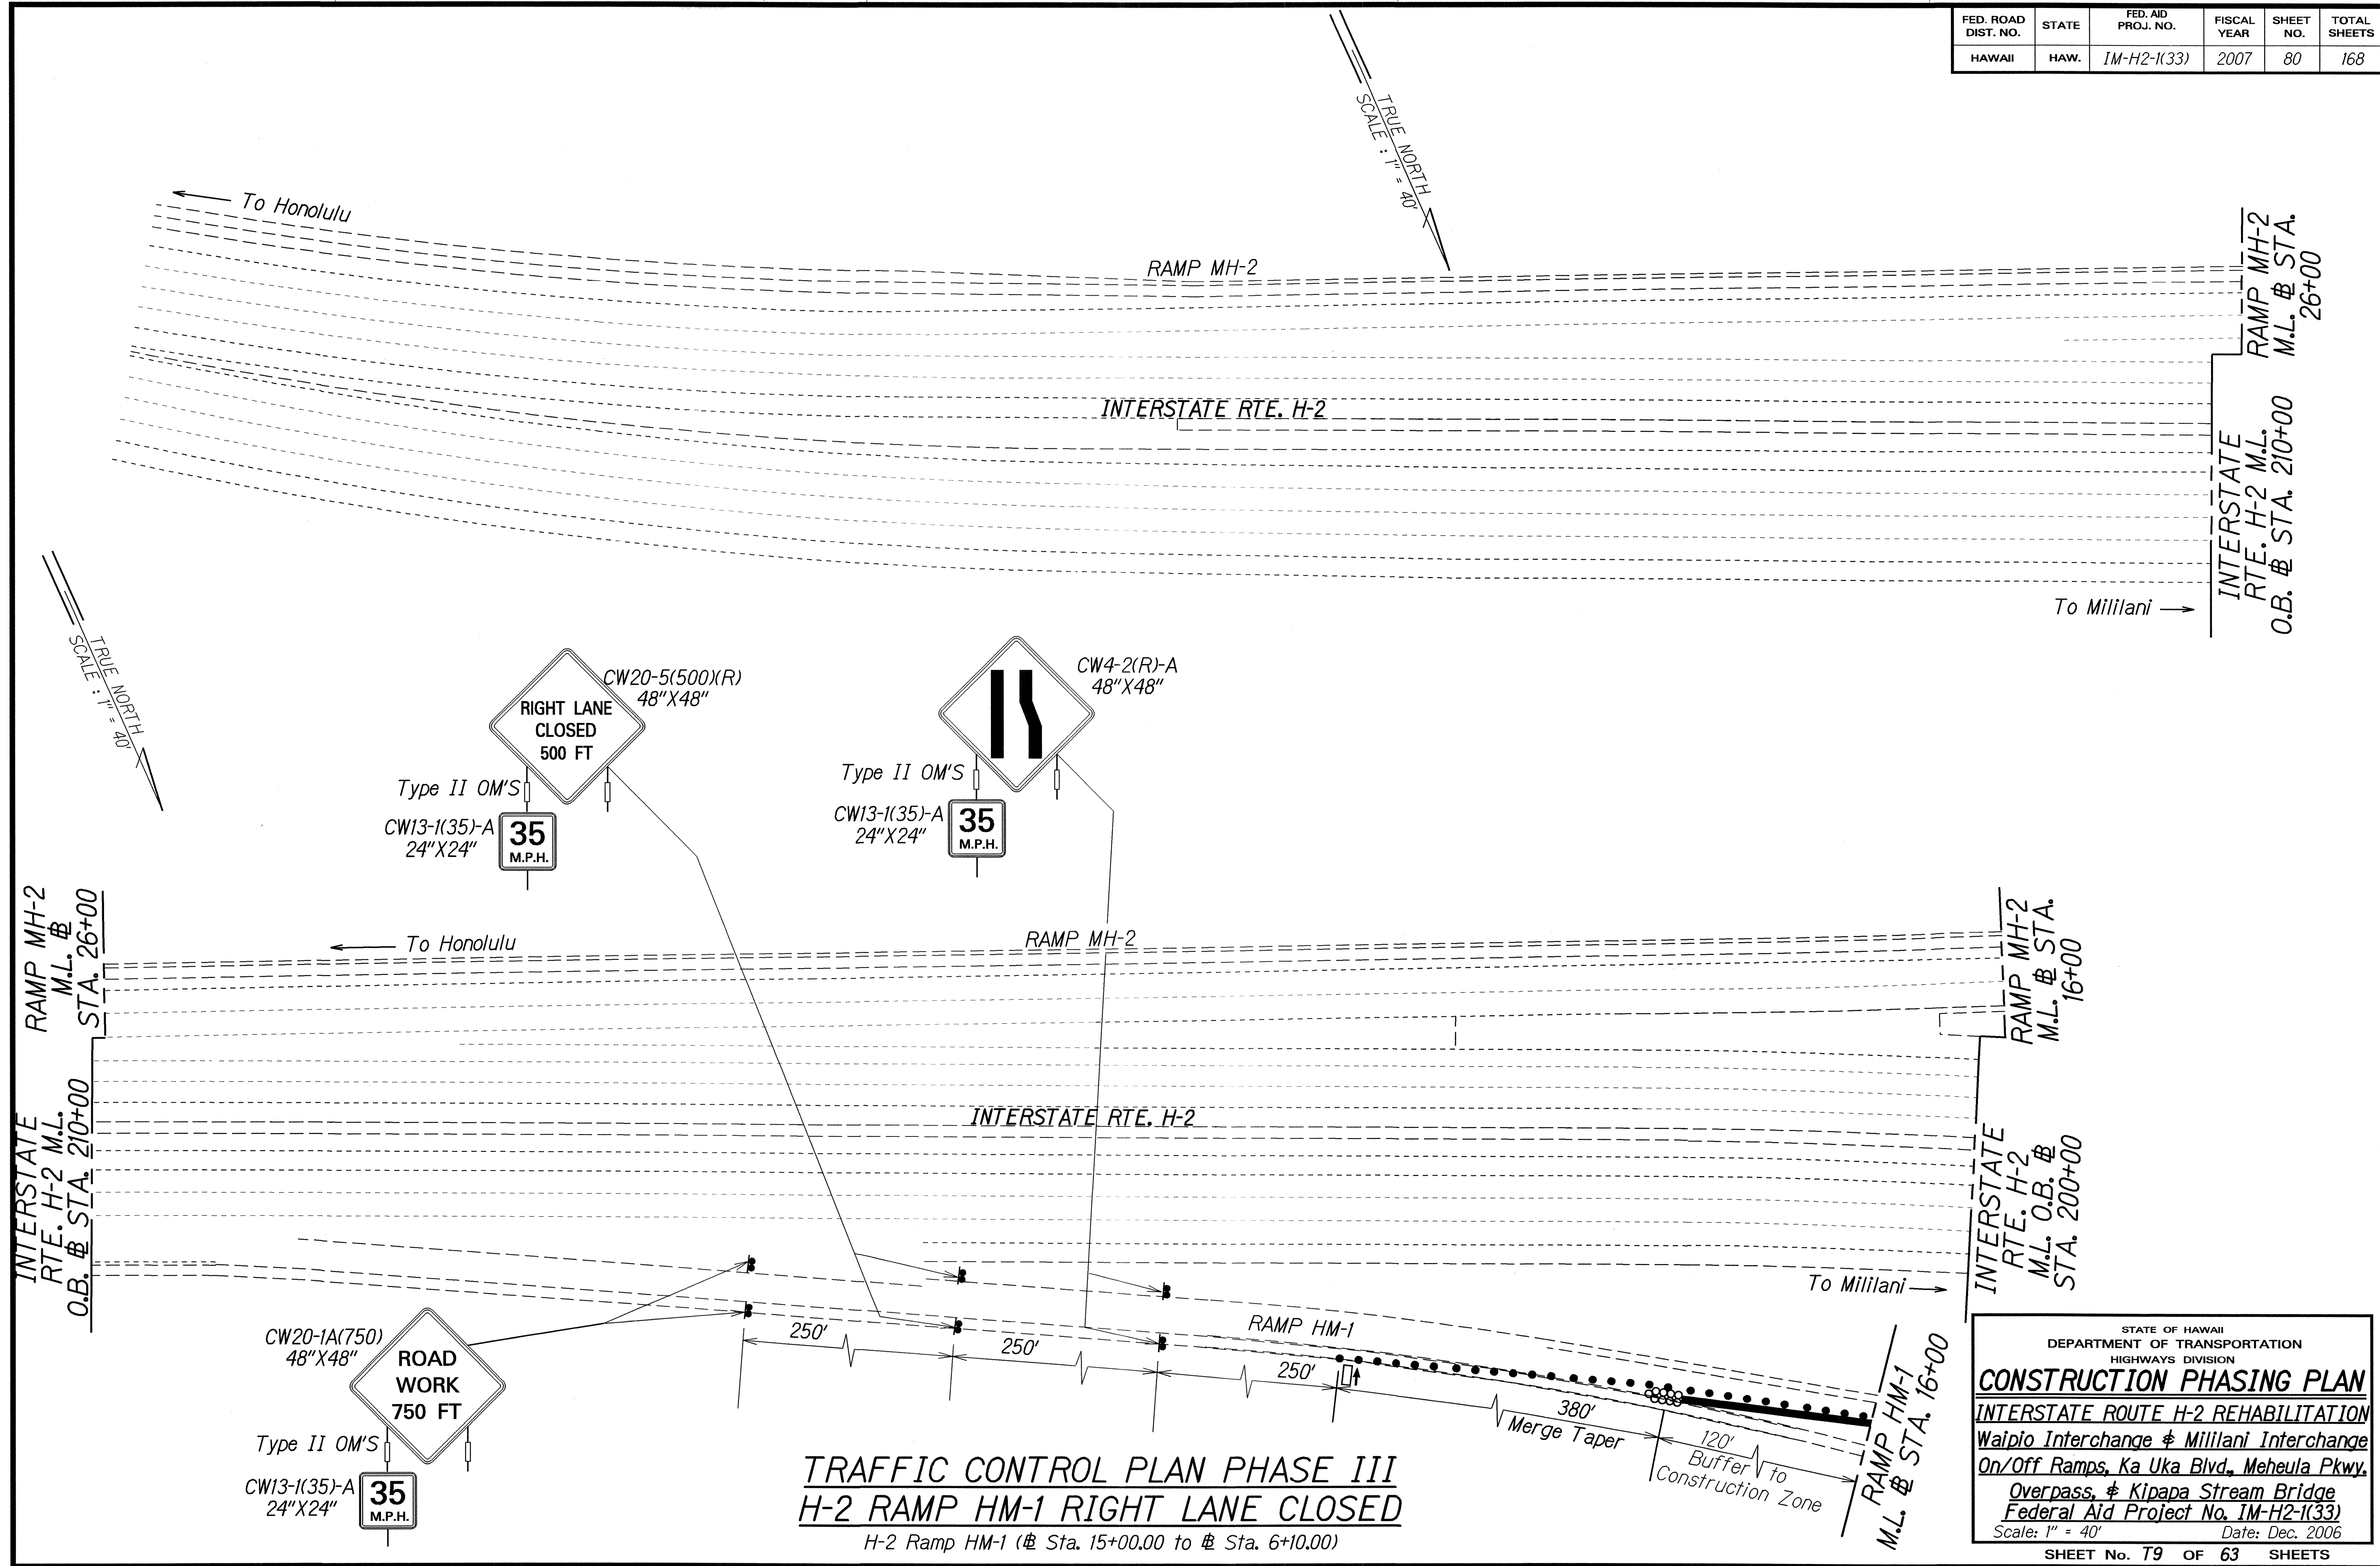


ORIGINAL PLAN	DATE
SURVEY PLOTTED BY	
DRAWN BY	
DESIGNED BY	
CHECKED BY	
NOTED BY	
DATE	

STATE OF HAWAII
 DEPARTMENT OF TRANSPORTATION
 HIGHWAYS DIVISION

CONSTRUCTION PHASING PLAN
 INTERSTATE ROUTE H-2 REHABILITATION
 Waipio Interchange & Mililani Interchange
 On/Off Ramps, Ka Uka Blvd., Meheula Pkwy.
 Overpass, & Kipapa Stream Bridge
 Federal Aid Project No. IM-H2-1(33)
 Scale: 1" = 40' Date: Dec. 2006

SHEET No. T9 OF 63 SHEETS

FED. ROAD DIST. NO.	STATE	FED. AID PROJ. NO.	FISCAL YEAR	SHEET NO.	TOTAL SHEETS
HAWAII	HAW.	IM-H2-1(33)	2007	81	168

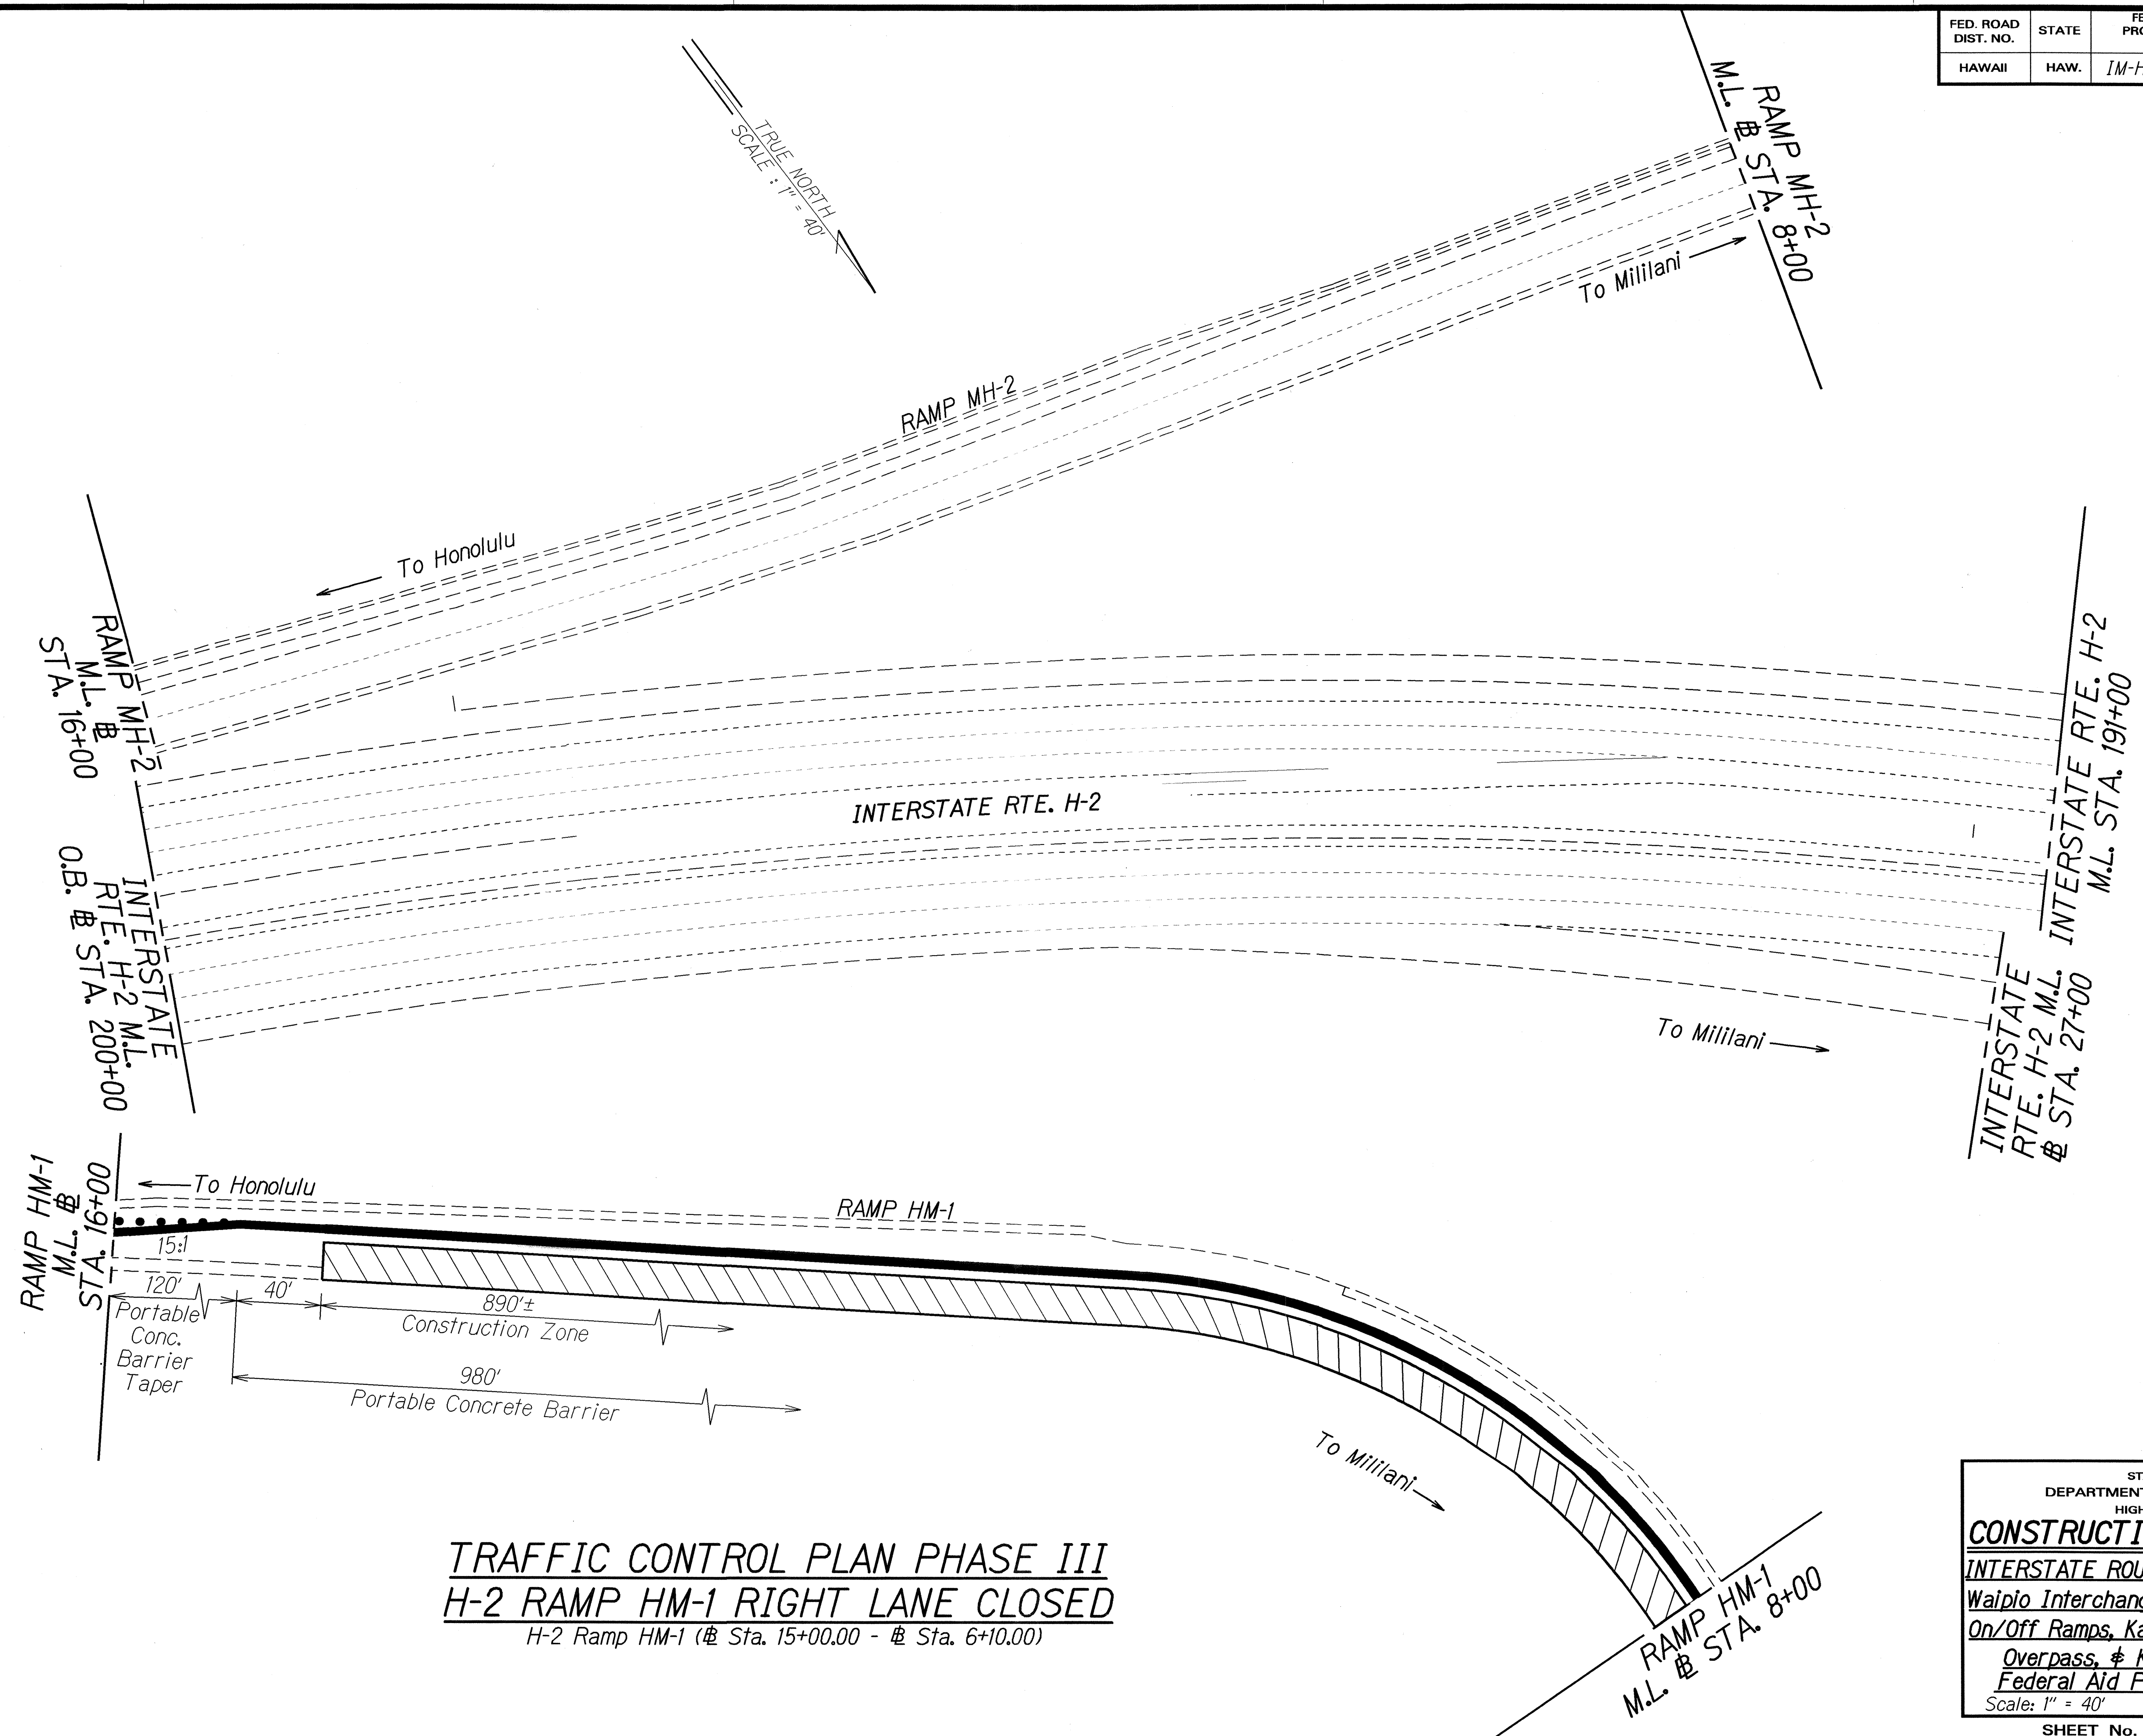

TRAFFIC CONTROL PLAN PHASE III
H-2 RAMP HM-1 RIGHT LANE CLOSED
 H-2 Ramp HM-1 (# Sta. 15+00.00 - # Sta. 6+10.00)


ORIGINAL PLAN	SURVEY PLOTTED BY	DATE
NOTE BOOK	DRAWN BY	
DESIGNED BY	TRACED BY	
CHECKED BY	DESIGNED BY	

STATE OF HAWAII
 DEPARTMENT OF TRANSPORTATION
 HIGHWAYS DIVISION

CONSTRUCTION PHASING PLAN
 INTERSTATE ROUTE H-2 REHABILITATION
 Waipio Interchange & Mililani Interchange
 On/Off Ramps, Ka Uka Blvd., Meheula Pkwy.
 Overpass, & Kipapa Stream Bridge
 Federal Aid Project No. IM-H2-1(33)
 Scale: 1" = 40' Date: Dec. 2006

SHEET No. T10 OF 63 SHEETS

FED. ROAD DIST. NO.	STATE	FED. AID PROJ. NO.	FISCAL YEAR	SHEET NO.	TOTAL SHEETS
HAWAII	HAW.	IM-H2-1(33)	2007	82	168

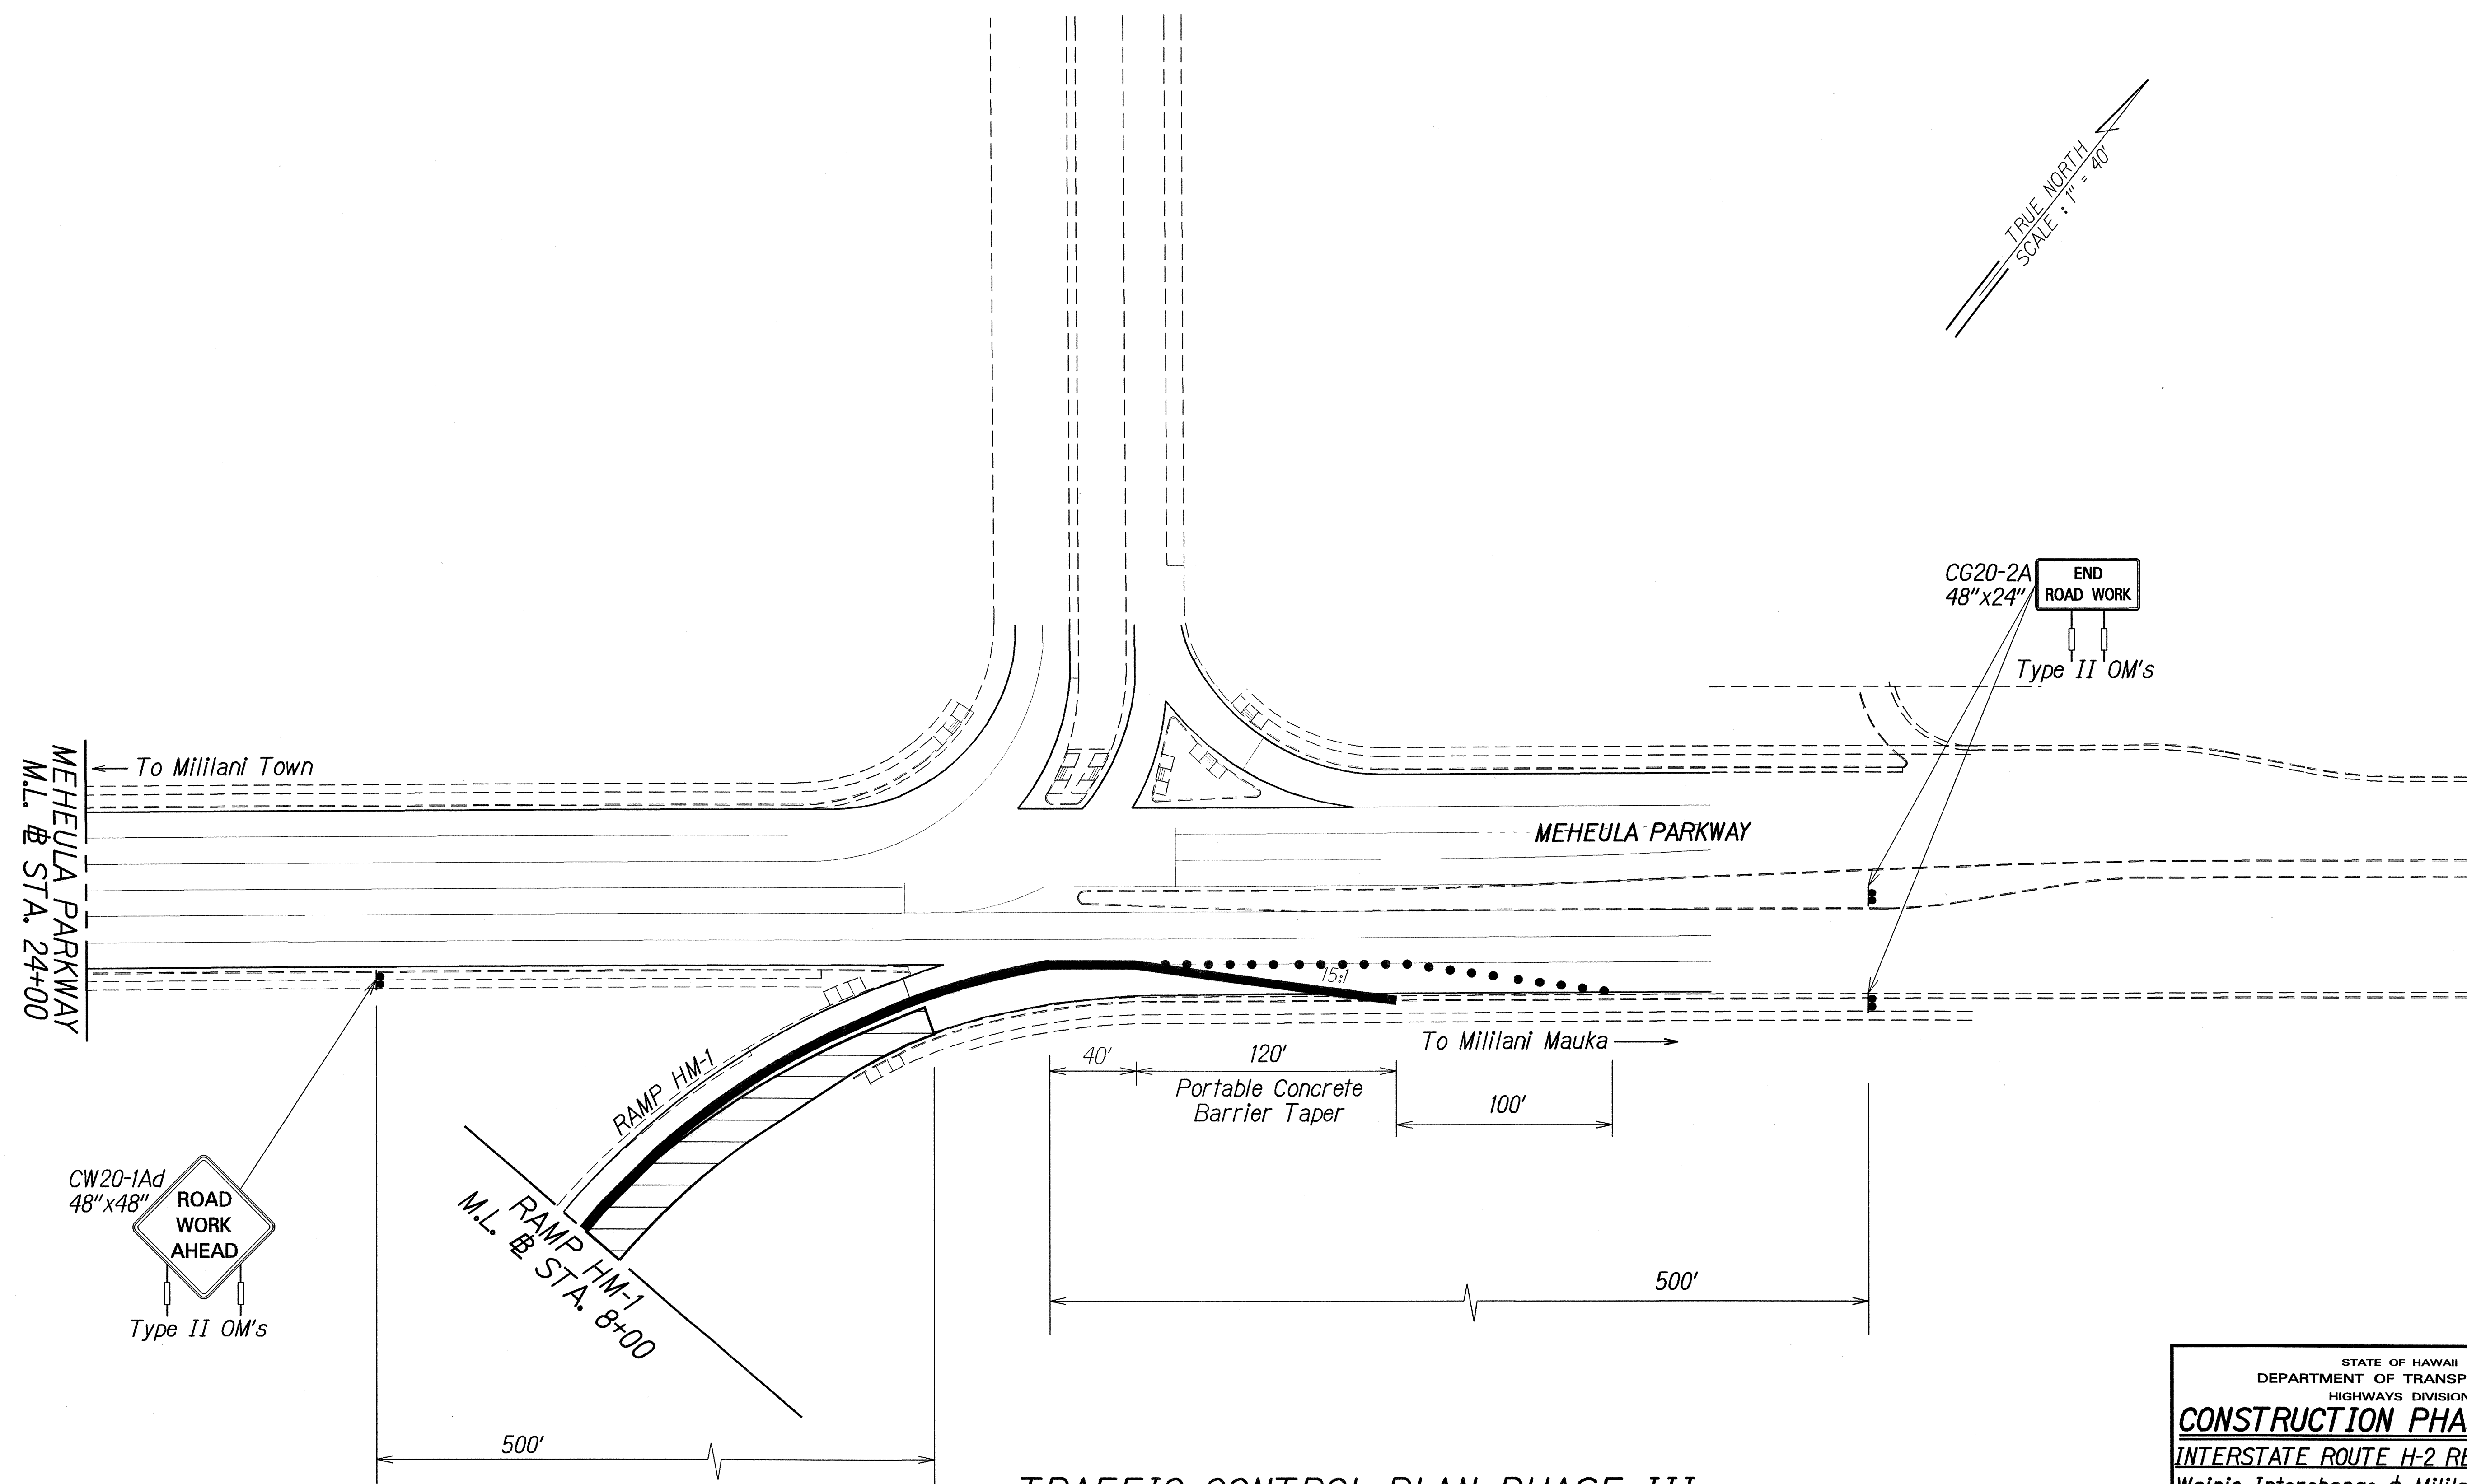

ORIGINAL PLAN	SURVEY PLOTTED BY	DATE
	DRAWN BY	
	DESIGNED BY	
	CHECKED BY	
NOTE BOOK	NOTE BOOK	
	DATE	
	BY	
	CHECKED BY	


TRAFFIC CONTROL PLAN PHASE III
H-2 RAMP HM-1 RIGHT LANE CLOSED
 H-2 Ramp HM-1 (Sta. 15+00.00 - Sta. 6+10.00)

STATE OF HAWAII
DEPARTMENT OF TRANSPORTATION
HIGHWAYS DIVISION

CONSTRUCTION PHASING PLAN
INTERSTATE ROUTE H-2 REHABILITATION
Waipio Interchange & Millilani Interchange
On/Off Ramps, Ka Uka Blvd., Meheula Pkwy.
Overpass, & Kipapa Stream Bridge
Federal Aid Project No. IM-H2-1(33)
Scale: 1" = 40' Date: Dec. 2006

SHEET No. 711 OF 63 SHEETS

FED. ROAD DIST. NO.	STATE	FED. AID PROJ. NO.	FISCAL YEAR	SHEET NO.	TOTAL SHEETS
HAWAII	HAW.	IM-H2-1(33)	2007	83	168

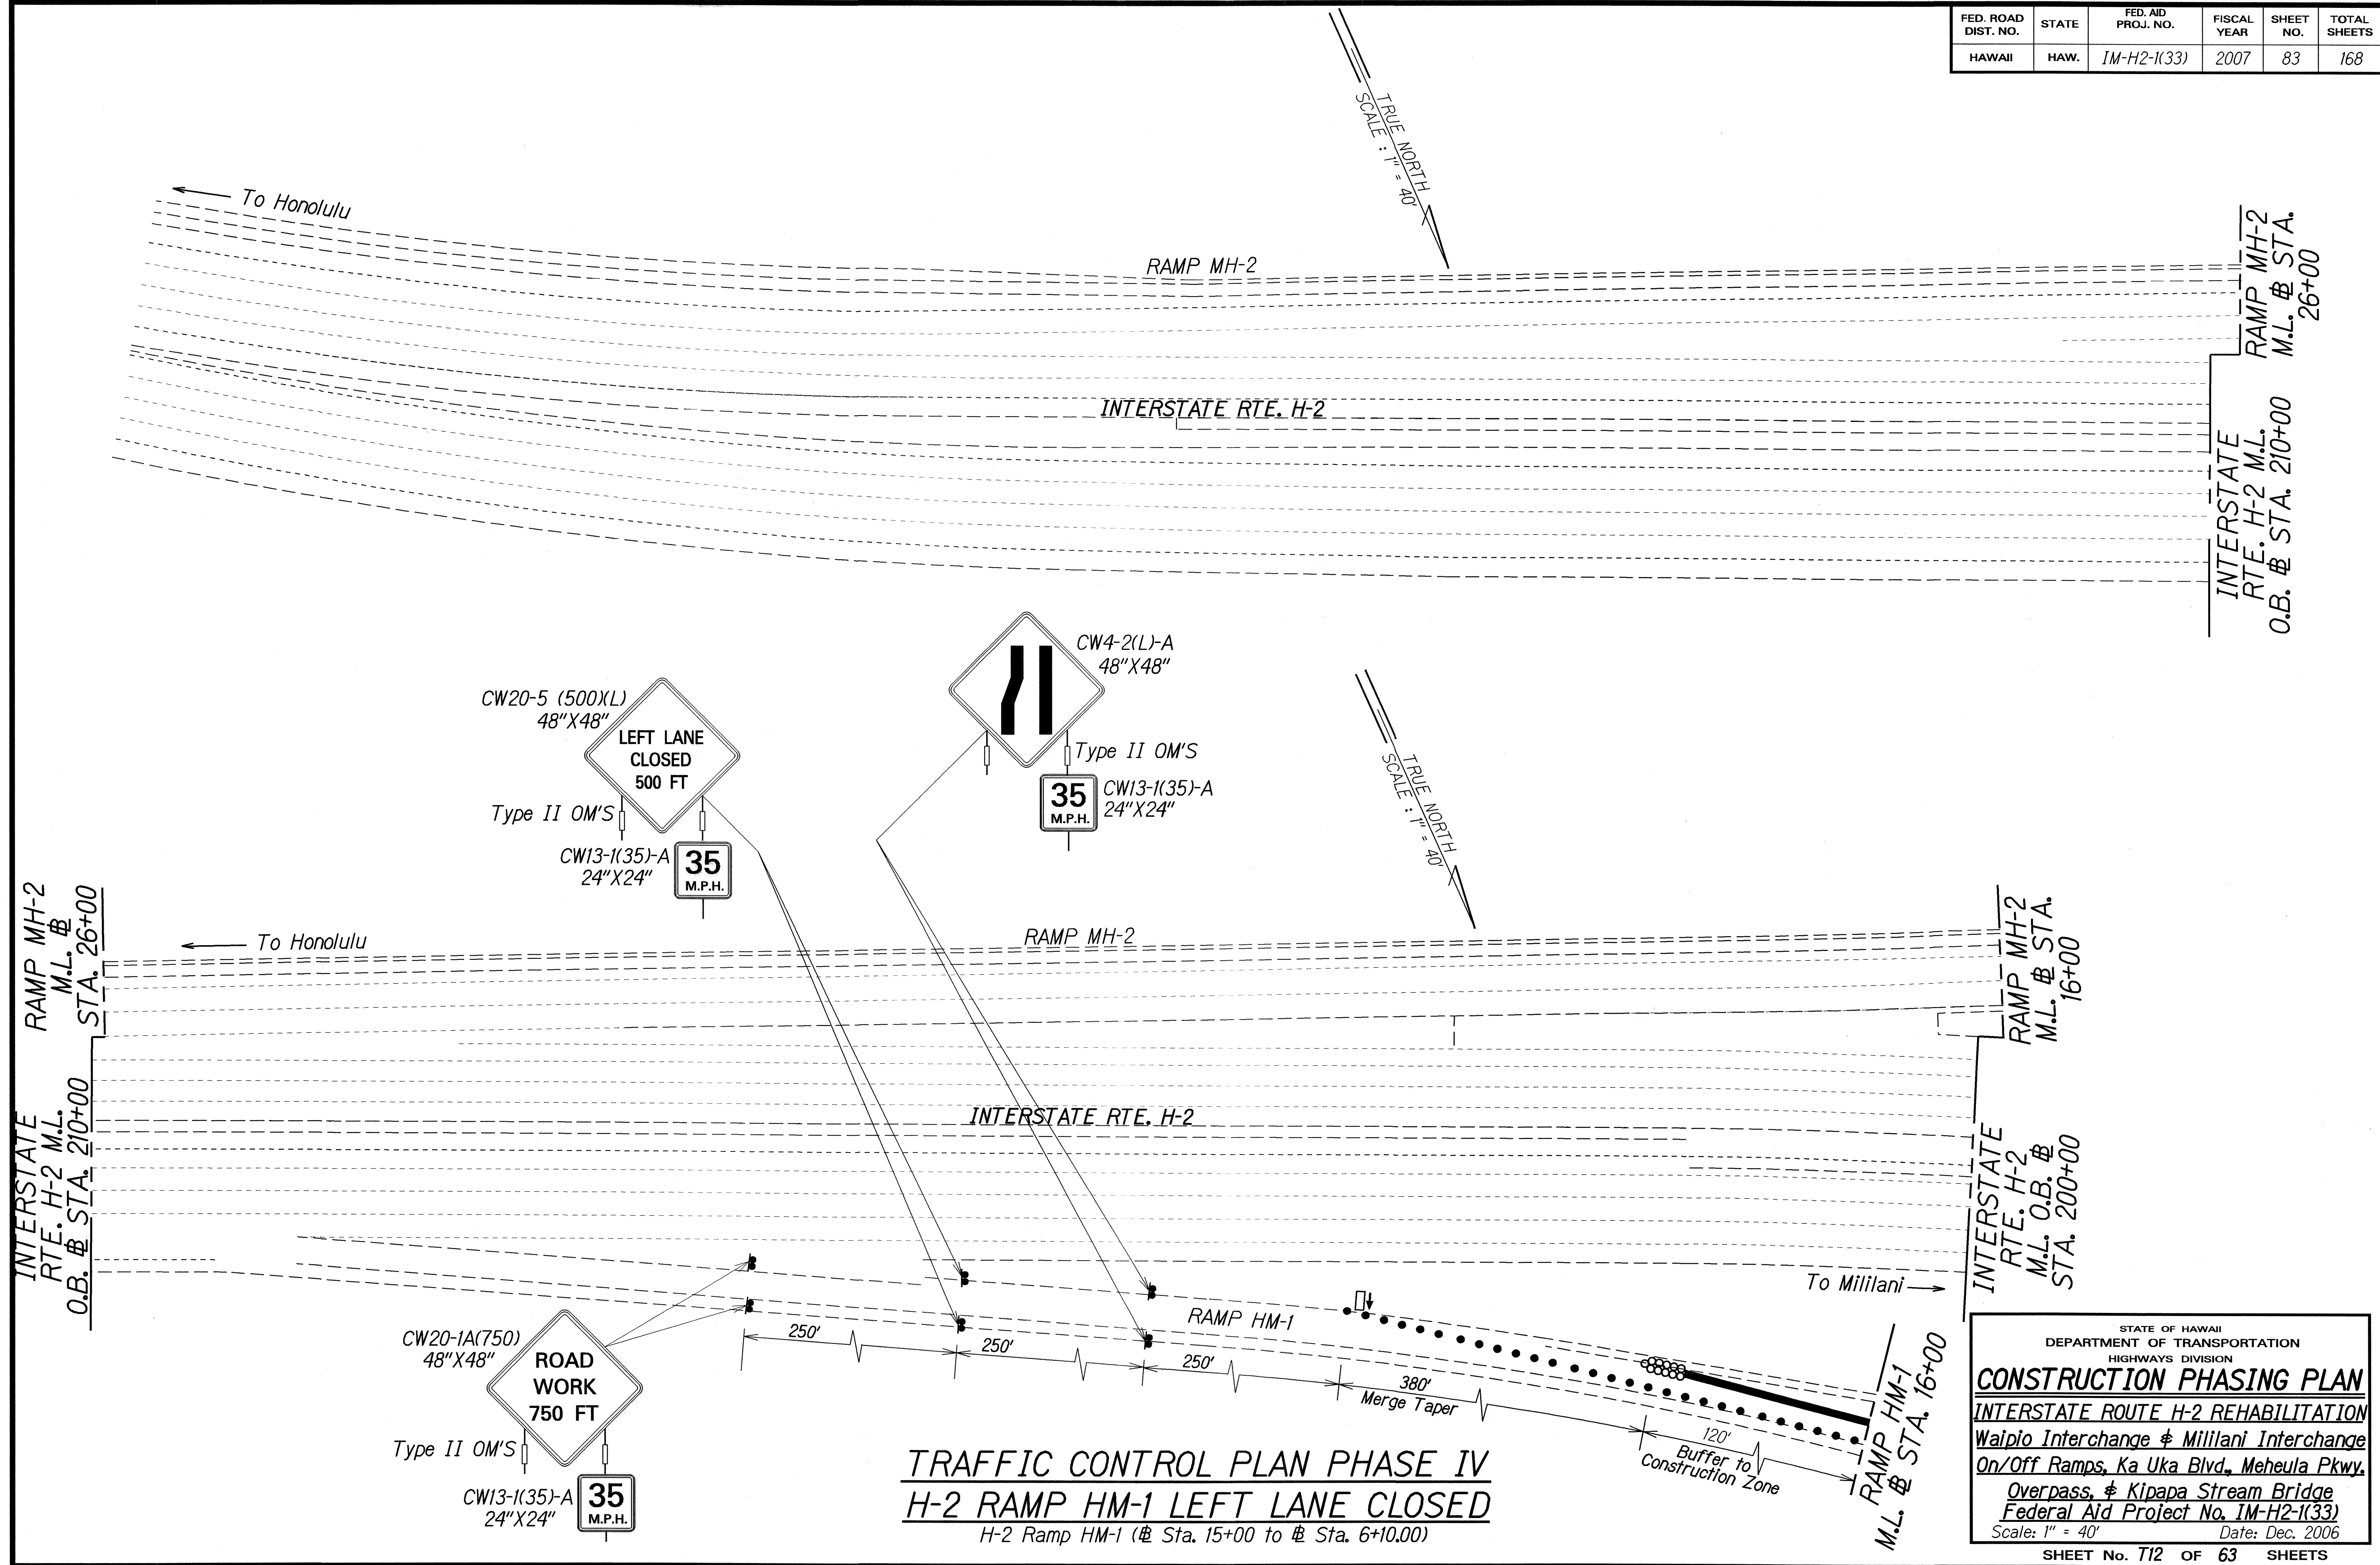


ORIGINAL PLAN	DATE
SURVEY PLOTTED BY	
DRAWN BY	
DESIGNED BY	
CHECKED BY	

STATE OF HAWAII
 DEPARTMENT OF TRANSPORTATION
 HIGHWAYS DIVISION

CONSTRUCTION PHASING PLAN
 INTERSTATE ROUTE H-2 REHABILITATION
 Waipio Interchange & Mililani Interchange
 On/Off Ramps, Ka Uka Blvd., Meheula Pkwy.
 Overpass, & Kipapa Stream Bridge
 Federal Aid Project No. IM-H2-1(33)
 Scale: 1" = 40' Date: Dec. 2006

SHEET No. 712 OF 63 SHEETS


FED. ROAD DIST. NO.	STATE	FED. AID PROJ. NO.	FISCAL YEAR	SHEET NO.	TOTAL SHEETS
HAWAII	HAW.	IM-H2-1(33)	2007	ADD. 84	168

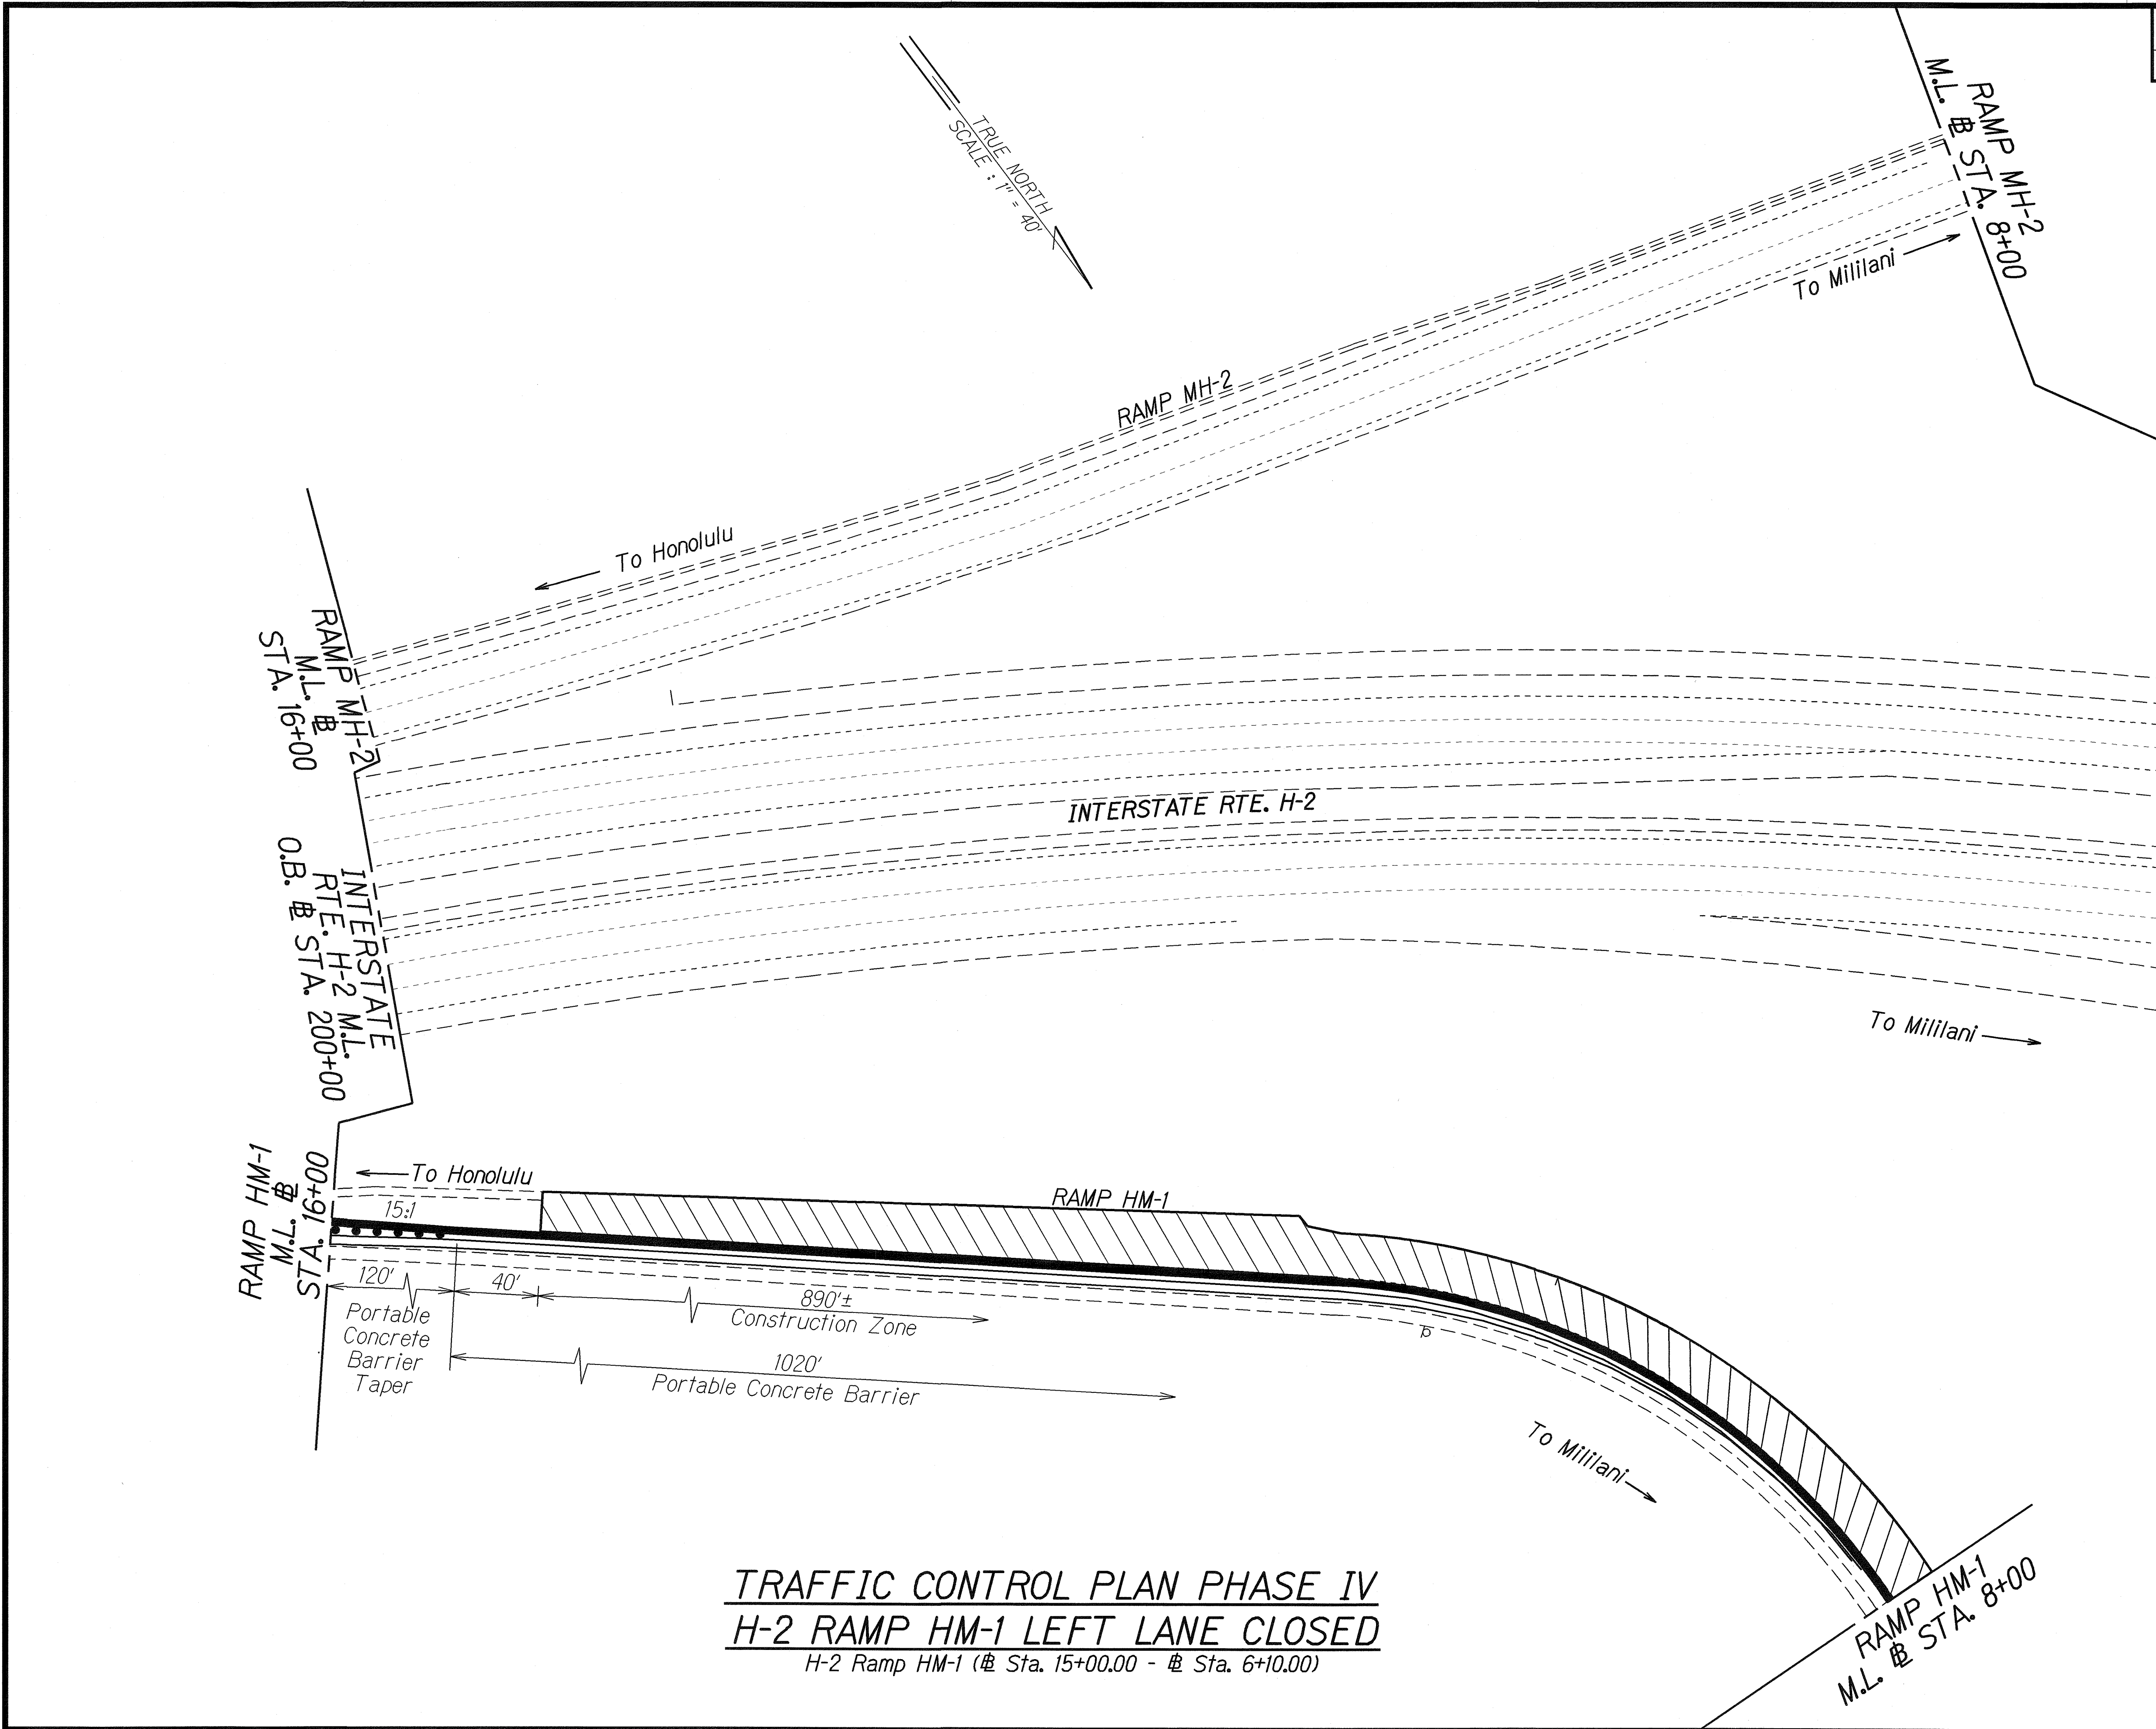

SURVEY PLOTTED BY	DATE
DESIGNED BY	
QUANTITIES BY	
CHECKED BY	

5/16/07	Revised length for Portable Concrete Barrier.
DATE	REVISION
STATE OF HAWAII DEPARTMENT OF TRANSPORTATION HIGHWAYS DIVISION CONSTRUCTION PHASING PLAN INTERSTATE ROUTE H-2 REHABILITATION Waipio Interchange & Mililani Interchange On/Off Ramps, Ka Uka Blvd., Meheula Pkwy. Overpass, & Kipapa Stream Bridge Federal Aid Project No. IM-H2-1(33) Scale: 1" = 40' Date: Dec. 2006	
SHEET No. 713 OF 63 SHEETS	

FED. ROAD DIST. NO.	STATE	FED. AID PROJ. NO.	FISCAL YEAR	SHEET NO.	TOTAL SHEETS
HAWAII	HAW.	IM-H2-1(33)	2007	85	168

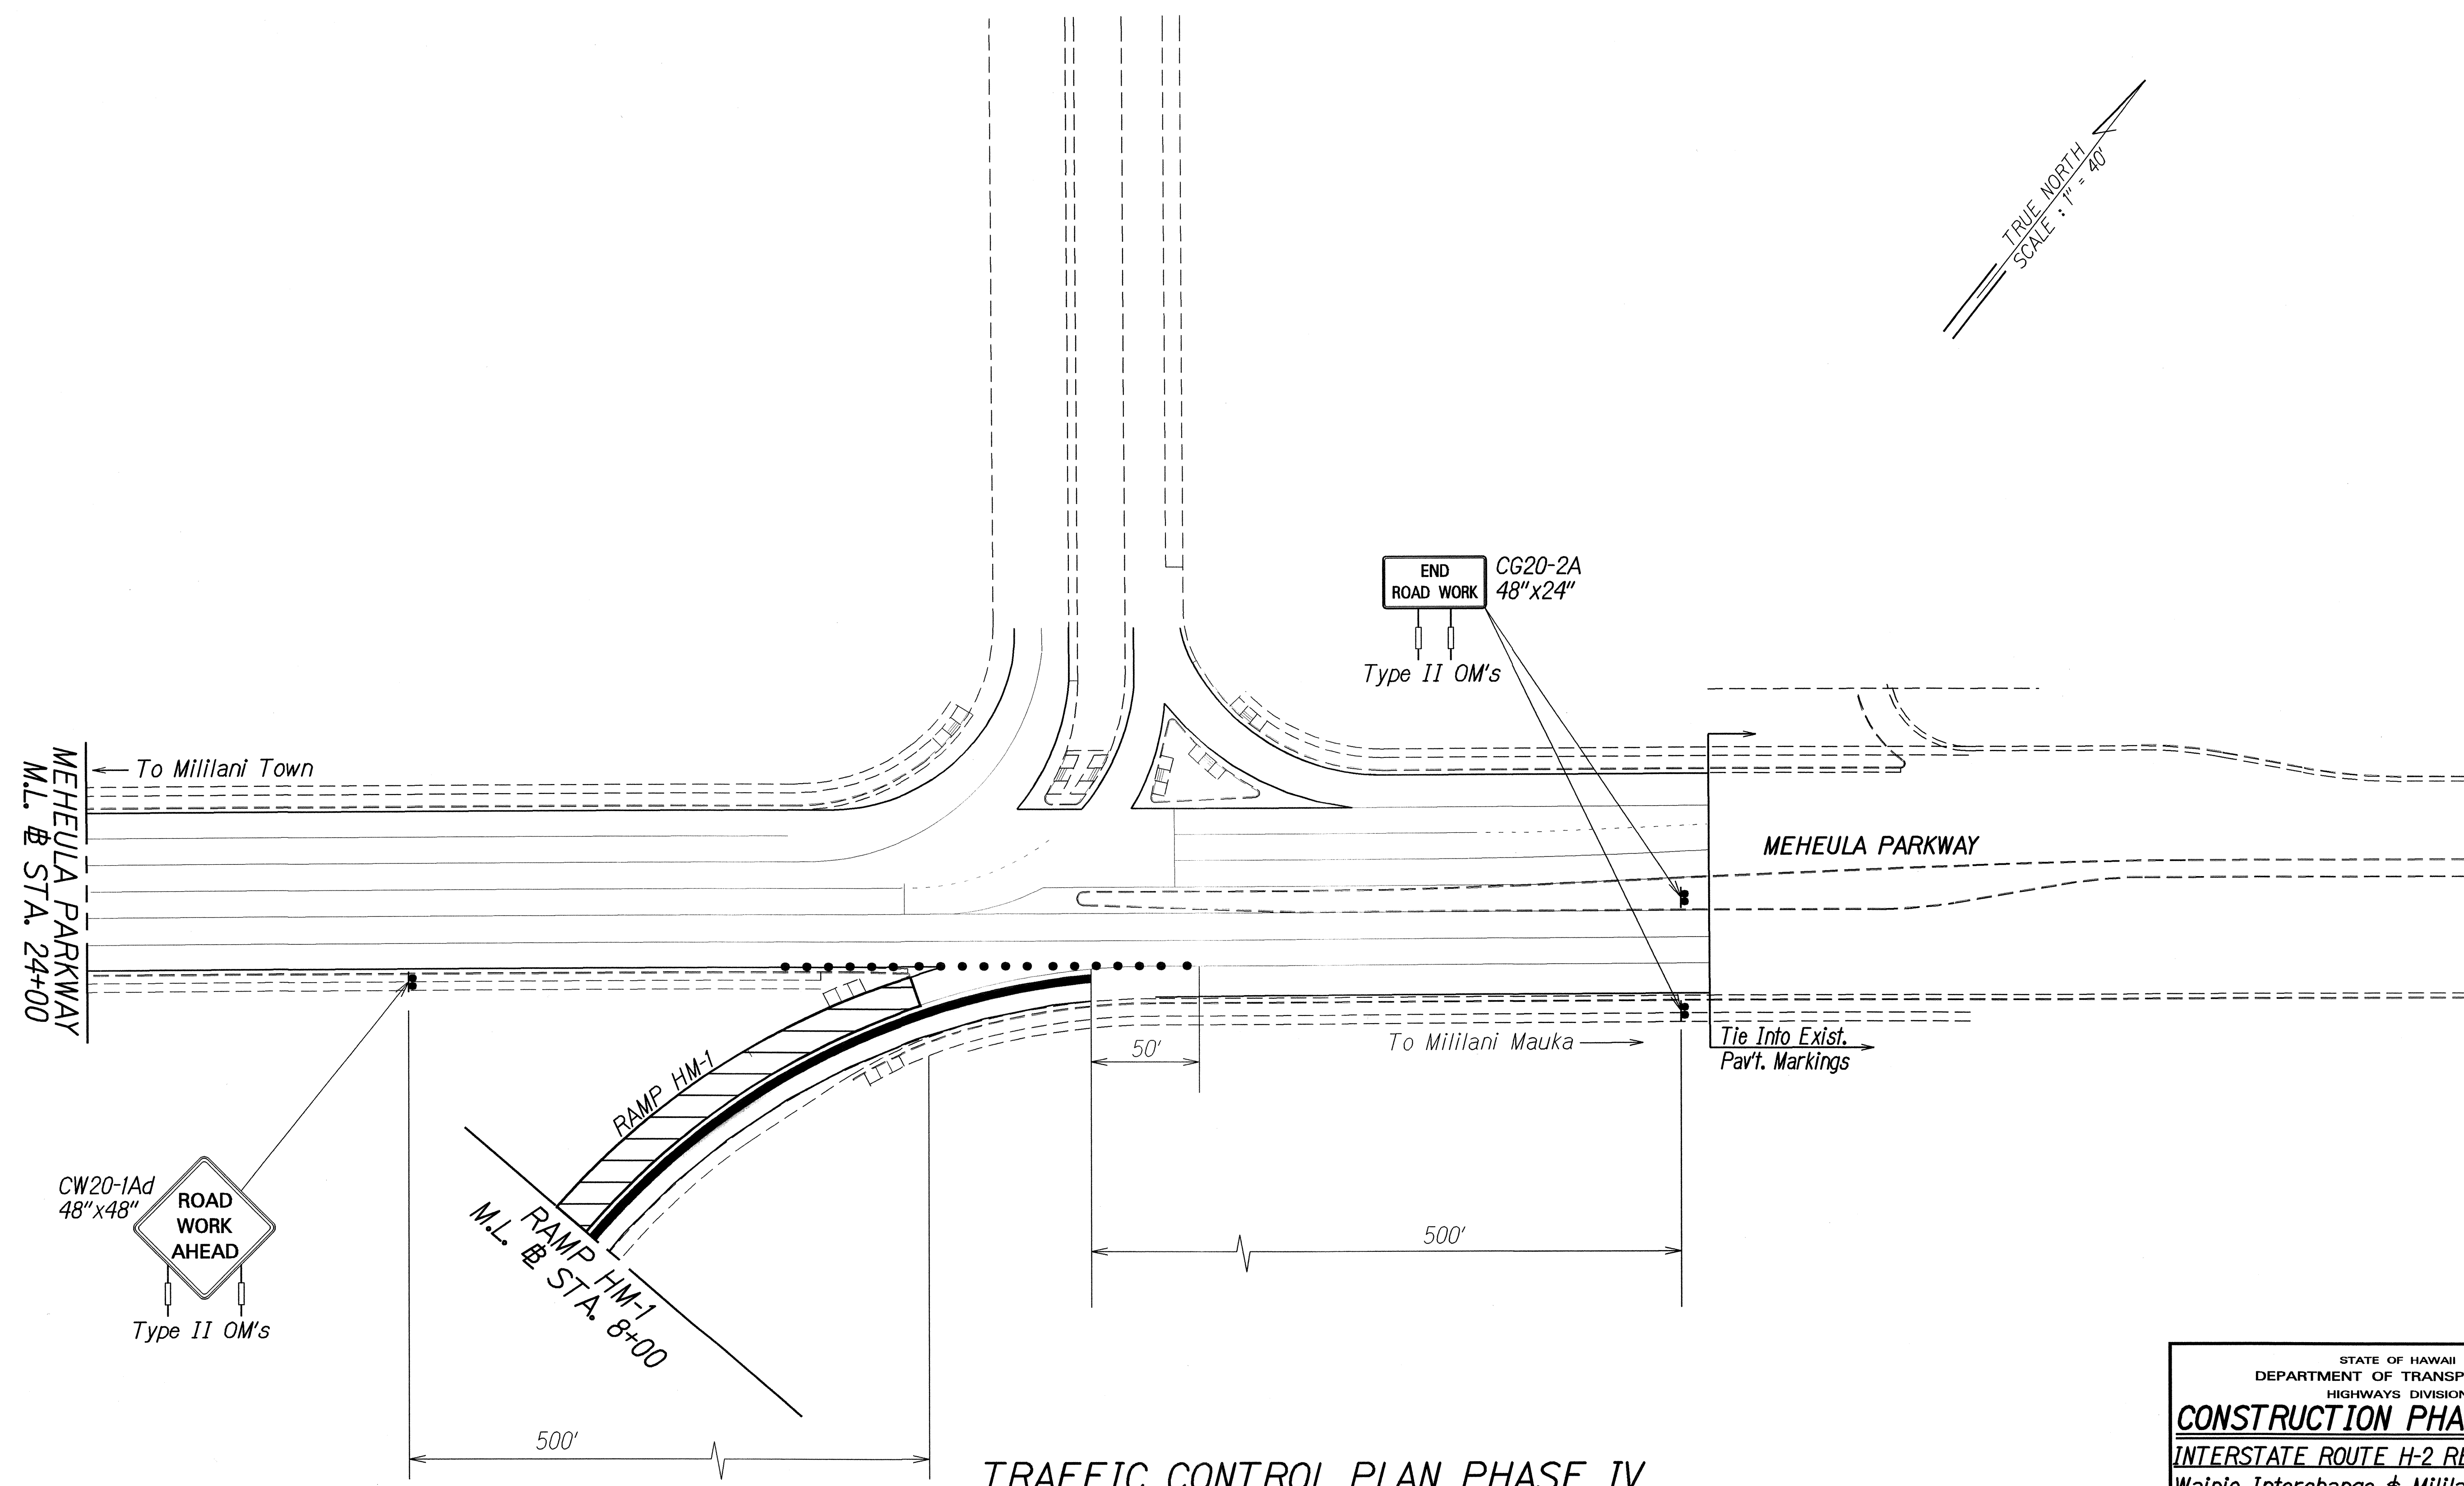

ORIGINAL PLAN	3/4/06/12/11/1/4
SURVEY PLOTTED BY	DATE
DRAWN BY	
DESIGNED BY	
CHECKED BY	


TRAFFIC CONTROL PLAN PHASE IV
H-2 RAMP HM-1 LEFT LANE CLOSED
H-2 Ramp HM-1 (# Sta. 15+00.00 - # Sta. 6+10.00)

STATE OF HAWAII
DEPARTMENT OF TRANSPORTATION
HIGHWAYS DIVISION

CONSTRUCTION PHASING PLAN
INTERSTATE ROUTE H-2 REHABILITATION
Waipio Interchange & Mililani Interchange
On/Off Ramps, Ka Uka Blvd., Meheula Pkwy.
Overpass, & Kipapa Stream Bridge
Federal Aid Project No. IM-H2-1(33)
Scale: 1" = 40' Date: Dec. 2006

SHEET No. T14 OF 63 SHEETS

FED. ROAD DIST. NO.	STATE	FED. AID PROJ. NO.	FISCAL YEAR	SHEET NO.	TOTAL SHEETS
HAWAII	HAW.	IM-H2-1(33)	2007	ADD. 86	168

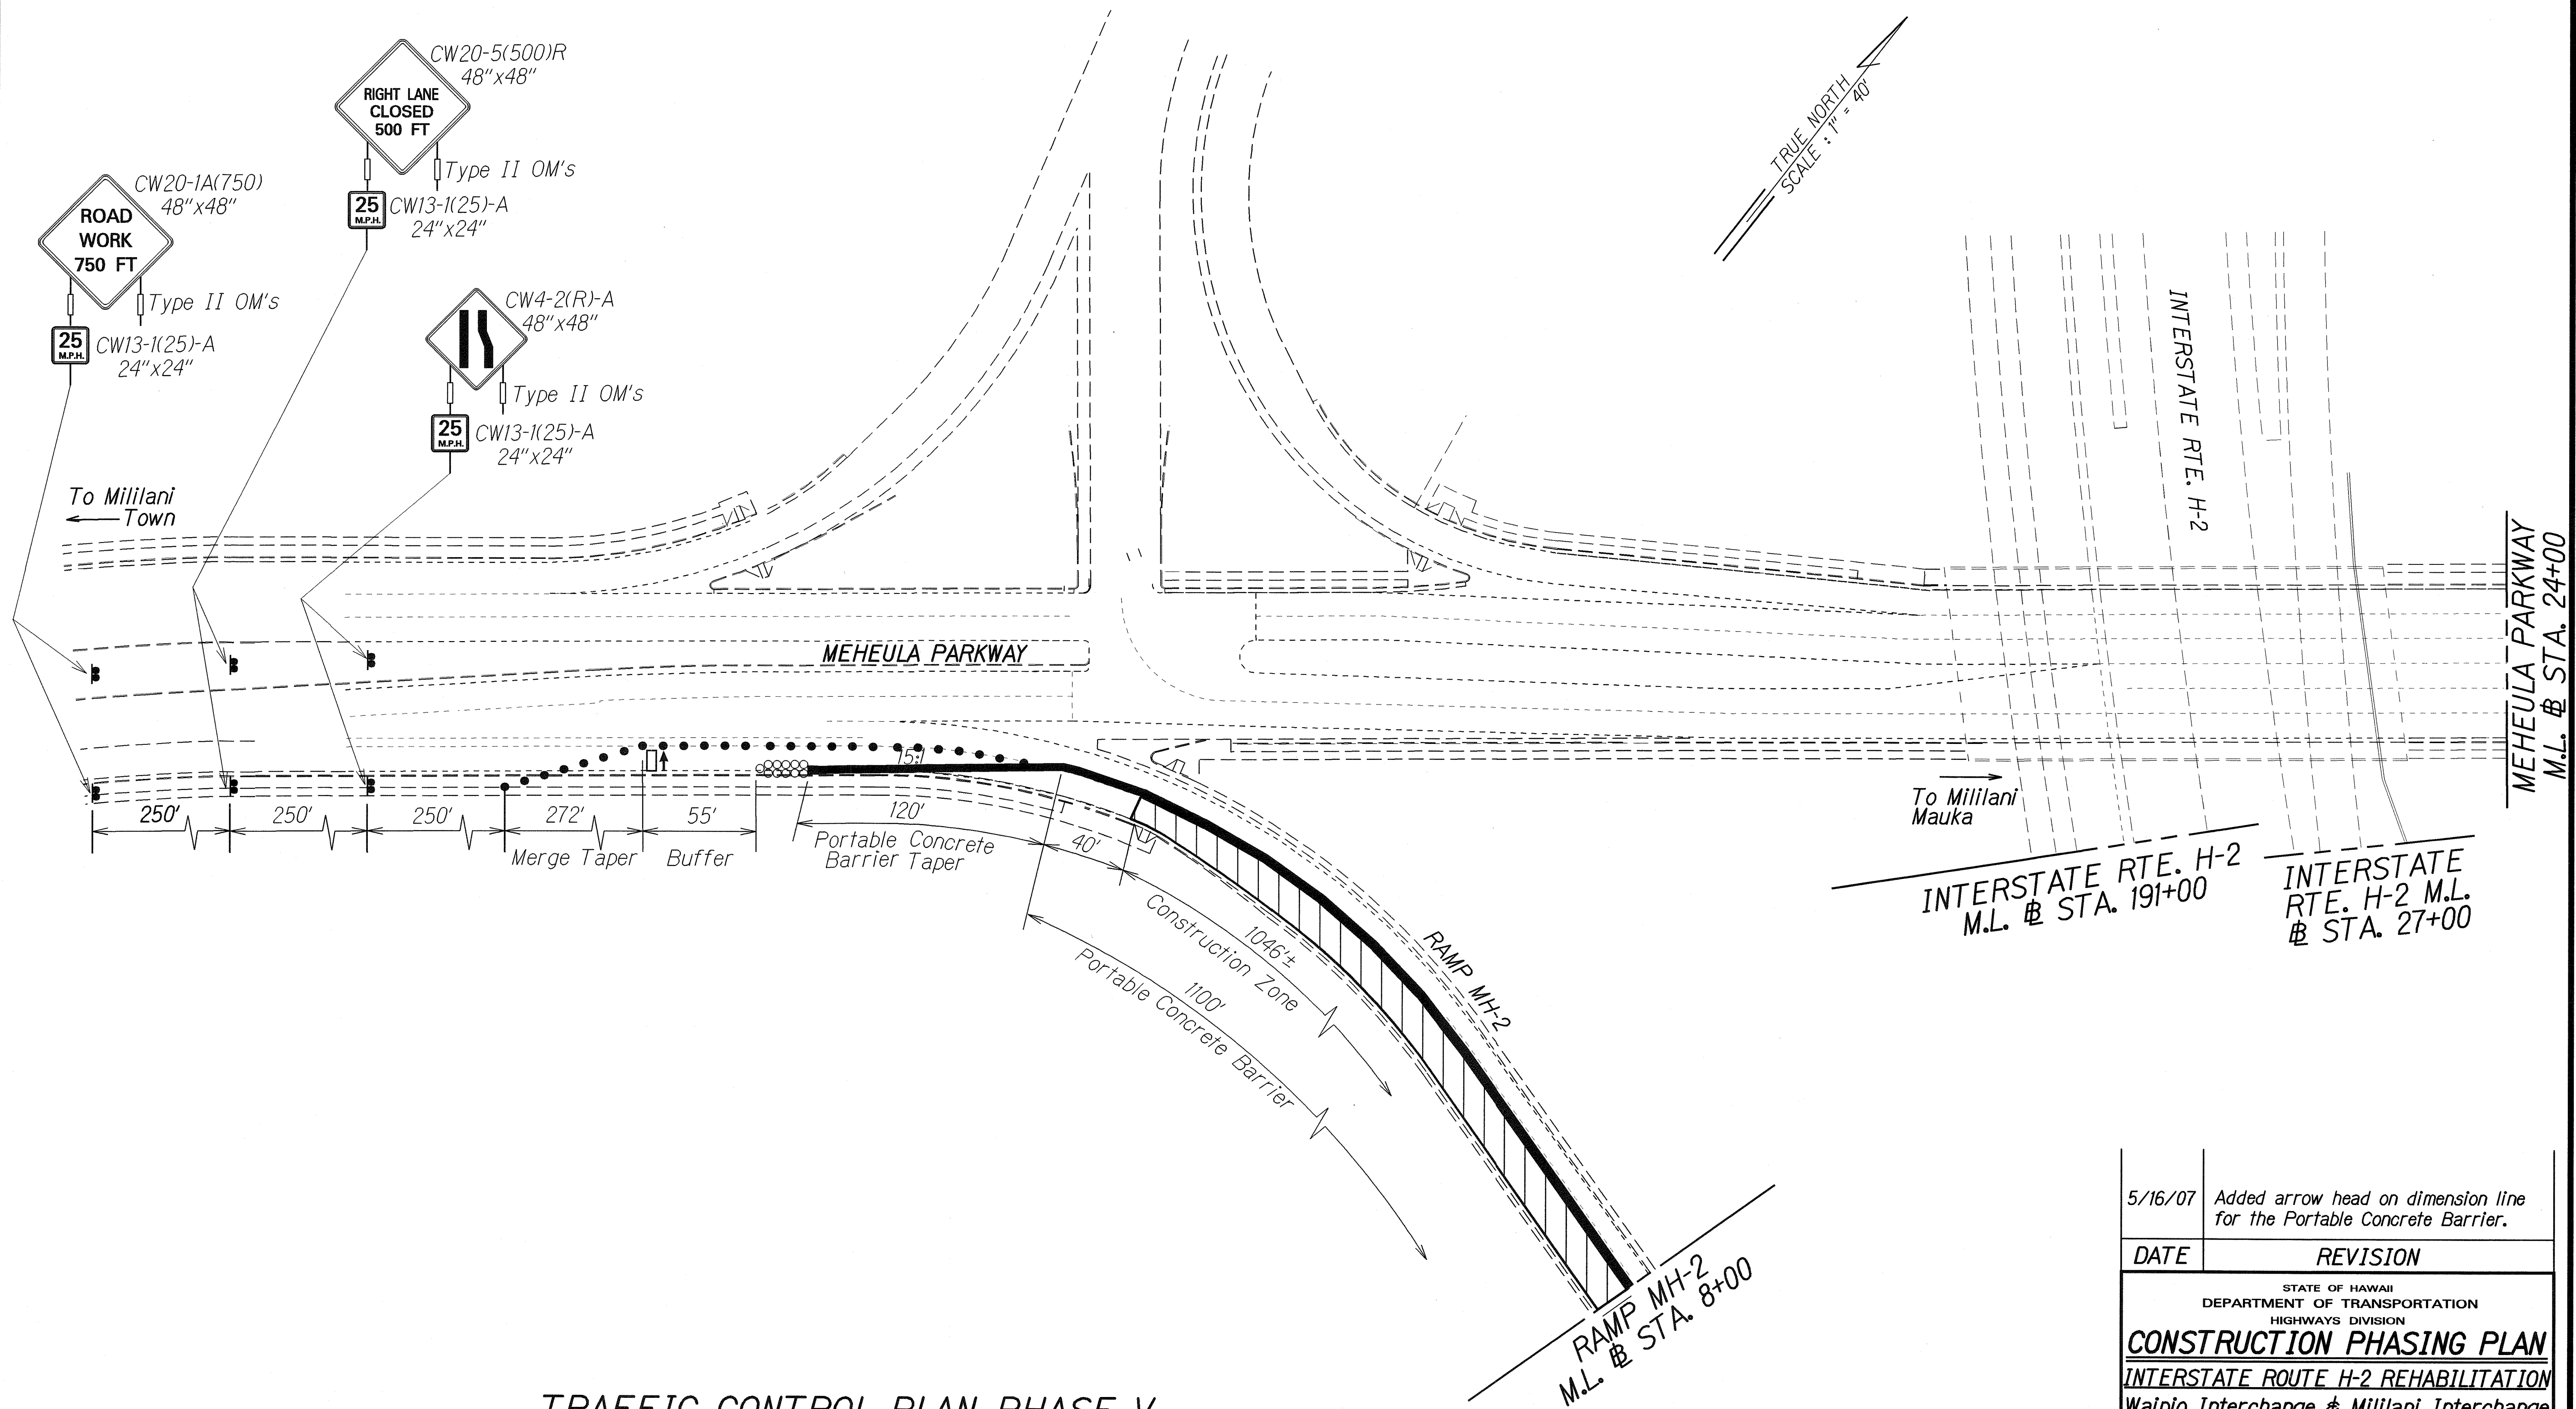


TRAFFIC CONTROL PLAN PHASE V
H-2 RAMP MH-2 RIGHT LANE CLOSED
H-2 Ramp MH-2 (# Sta. 4+54.00 - # Sta. 15+00.00)

DESIGNED BY	DATE
DRAWN BY	
CHECKED BY	
NOTED BY	
QUANTITIES BY	
CHECKED BY	

5/16/07	Added arrow head on dimension line for the Portable Concrete Barrier.
DATE	REVISION
STATE OF HAWAII DEPARTMENT OF TRANSPORTATION HIGHWAYS DIVISION CONSTRUCTION PHASING PLAN INTERSTATE ROUTE H-2 REHABILITATION Waipio Interchange & Mililani Interchange On/Off Ramps, Ka Uka Blvd., Meheula Pkwy, Overpass, & Kipapa Stream Bridge Federal Aid Project No. IM-H2-1(33) Scale: 1" = 40' Date: Dec. 2006	
SHEET No. 715 OF 63 SHEETS	

FED. ROAD DIST. NO.	STATE	FED. AID PROJ. NO.	FISCAL YEAR	SHEET NO.	TOTAL SHEETS
HAWAII	HAW.	IM-H2-1(33)	2007	87	168

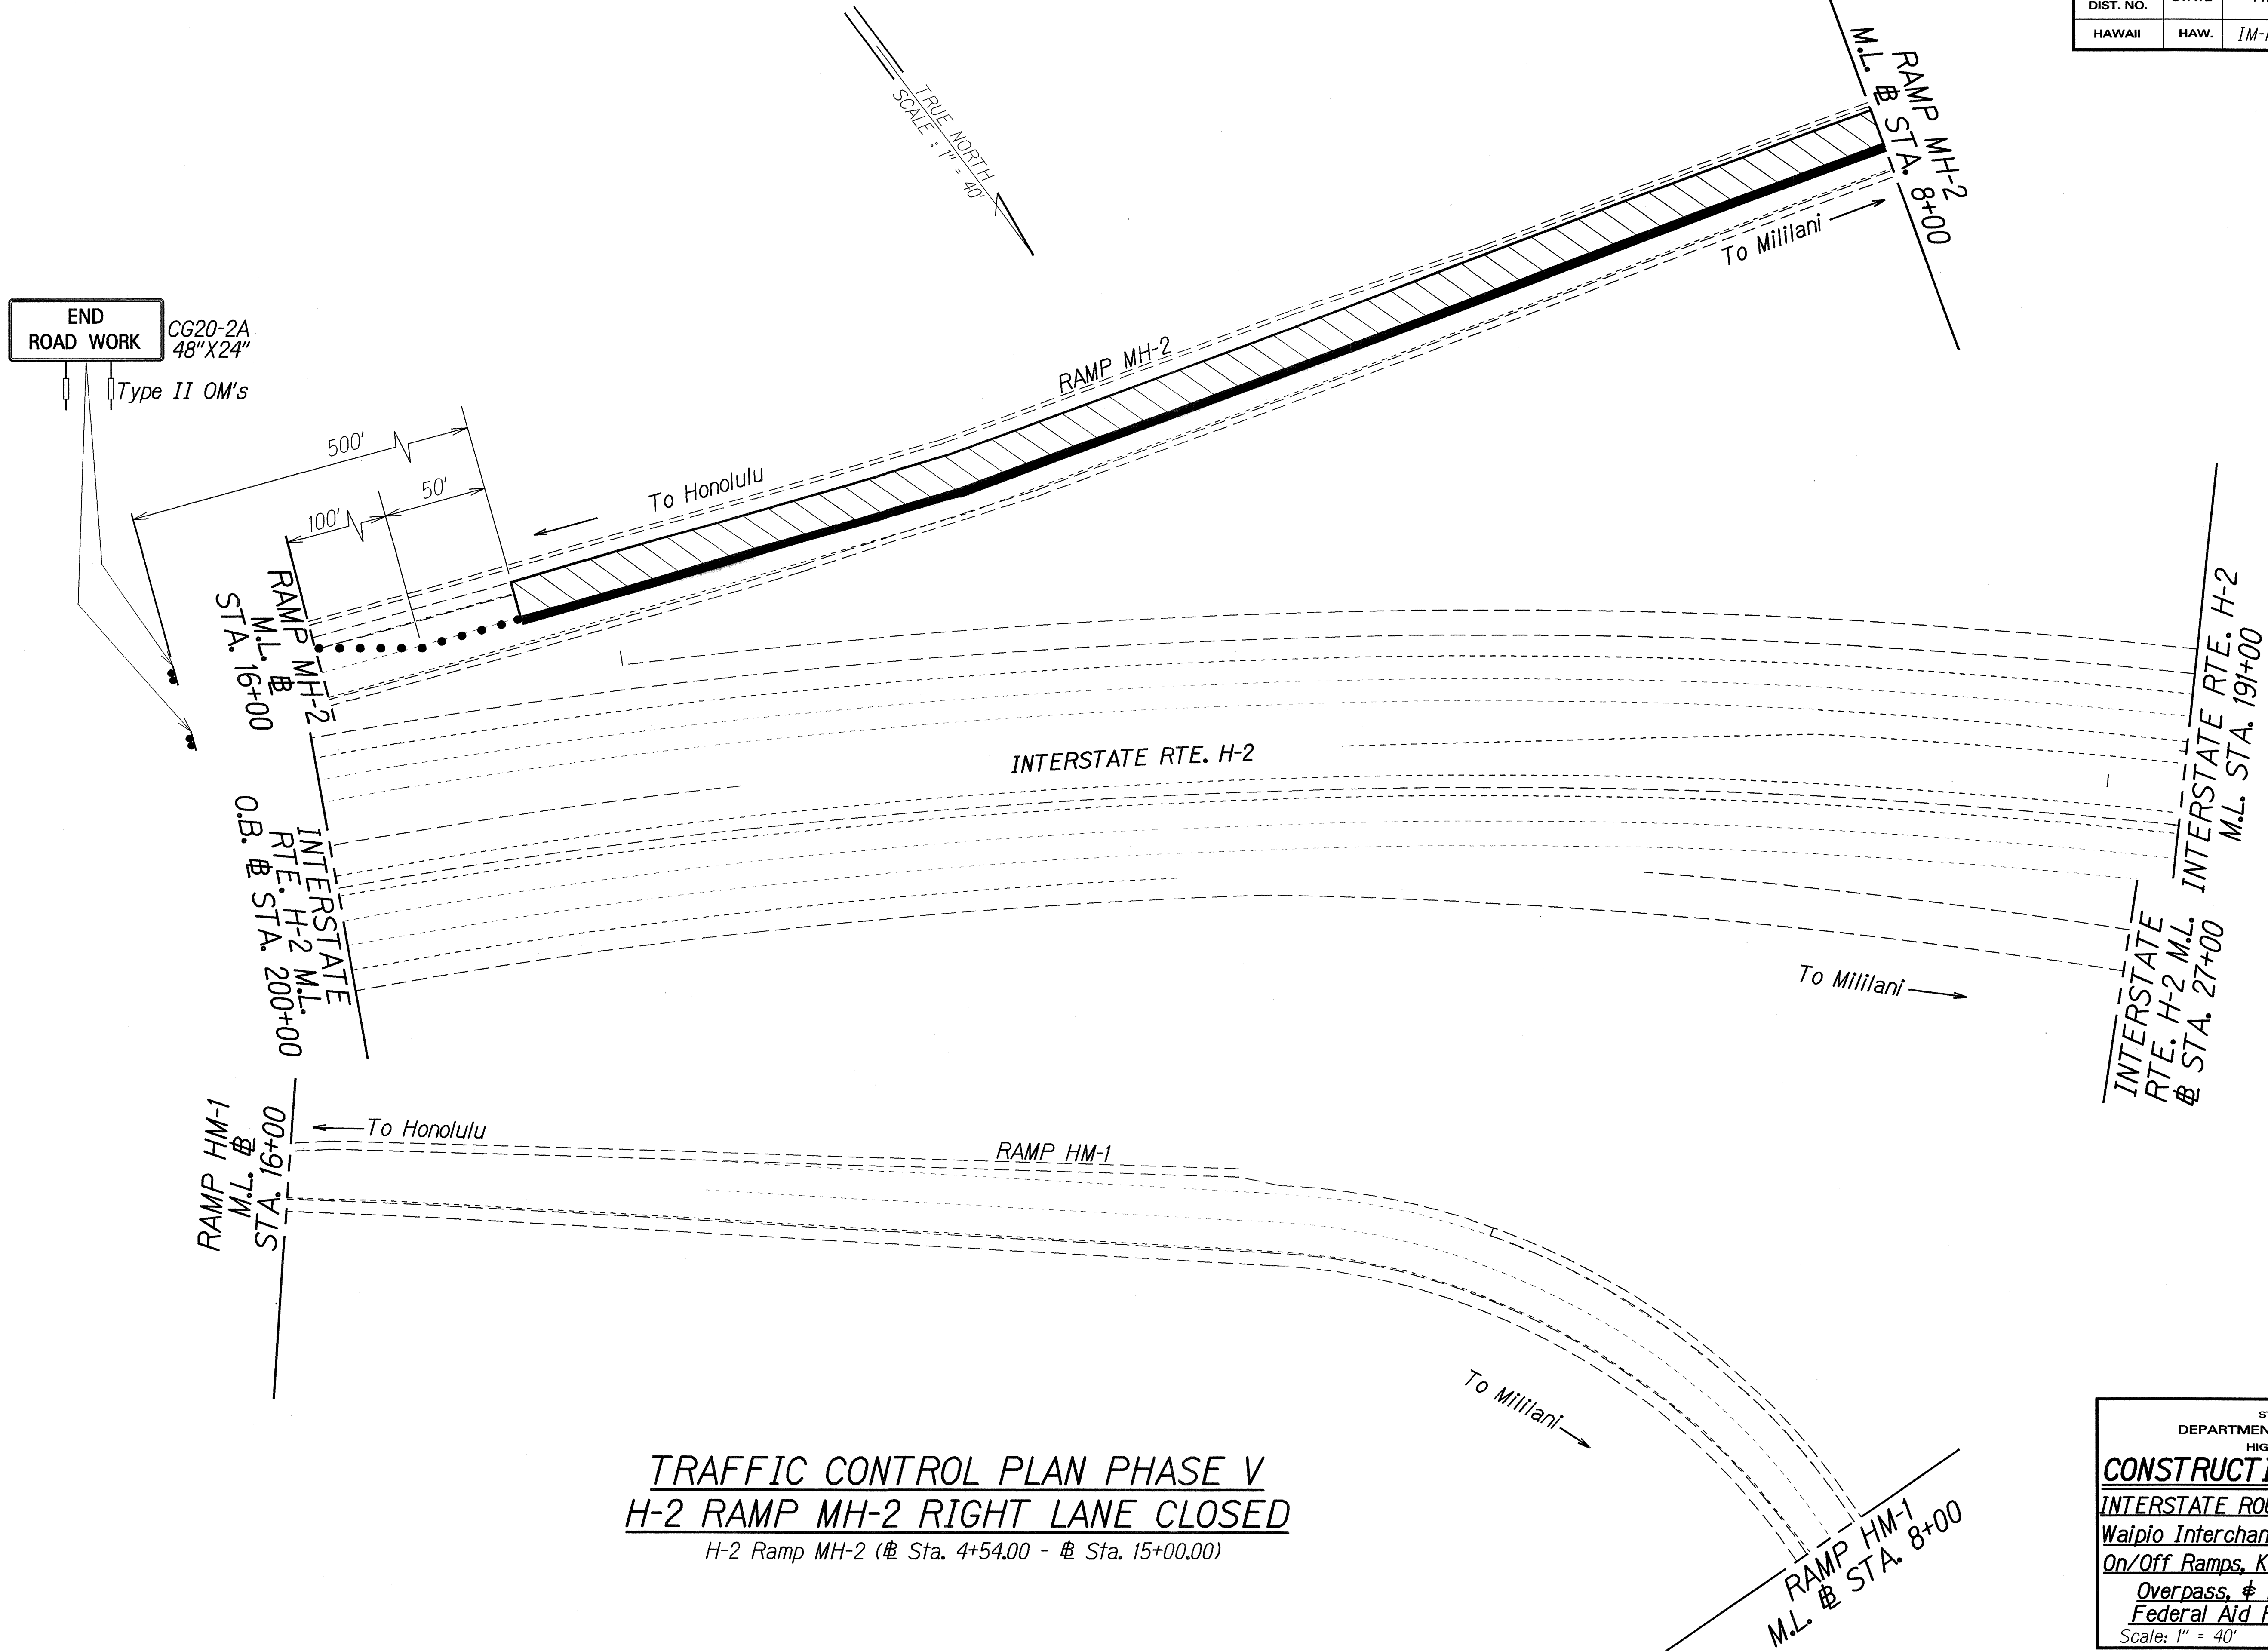


STATE OF HAWAII
DEPARTMENT OF TRANSPORTATION
HIGHWAYS DIVISION

CONSTRUCTION PHASING PLAN
INTERSTATE ROUTE H-2 REHABILITATION
Waipio Interchange & Mililani Interchange
On/Off Ramps, Ka Uka Blvd., Meheula Pkwy,
Overpass, & Kipapa Stream Bridge
Federal Aid Project No. IM-H2-1(33)
Scale: 1" = 40' Date: Dec. 2006

SHEET No. T16 OF 63 SHEETS

FED. ROAD DIST. NO.	STATE	FED. AID PROJ. NO.	FISCAL YEAR	SHEET NO.	TOTAL SHEETS
HAWAII	HAW.	IM-H2-1(33)	2007	ADD. 88	168

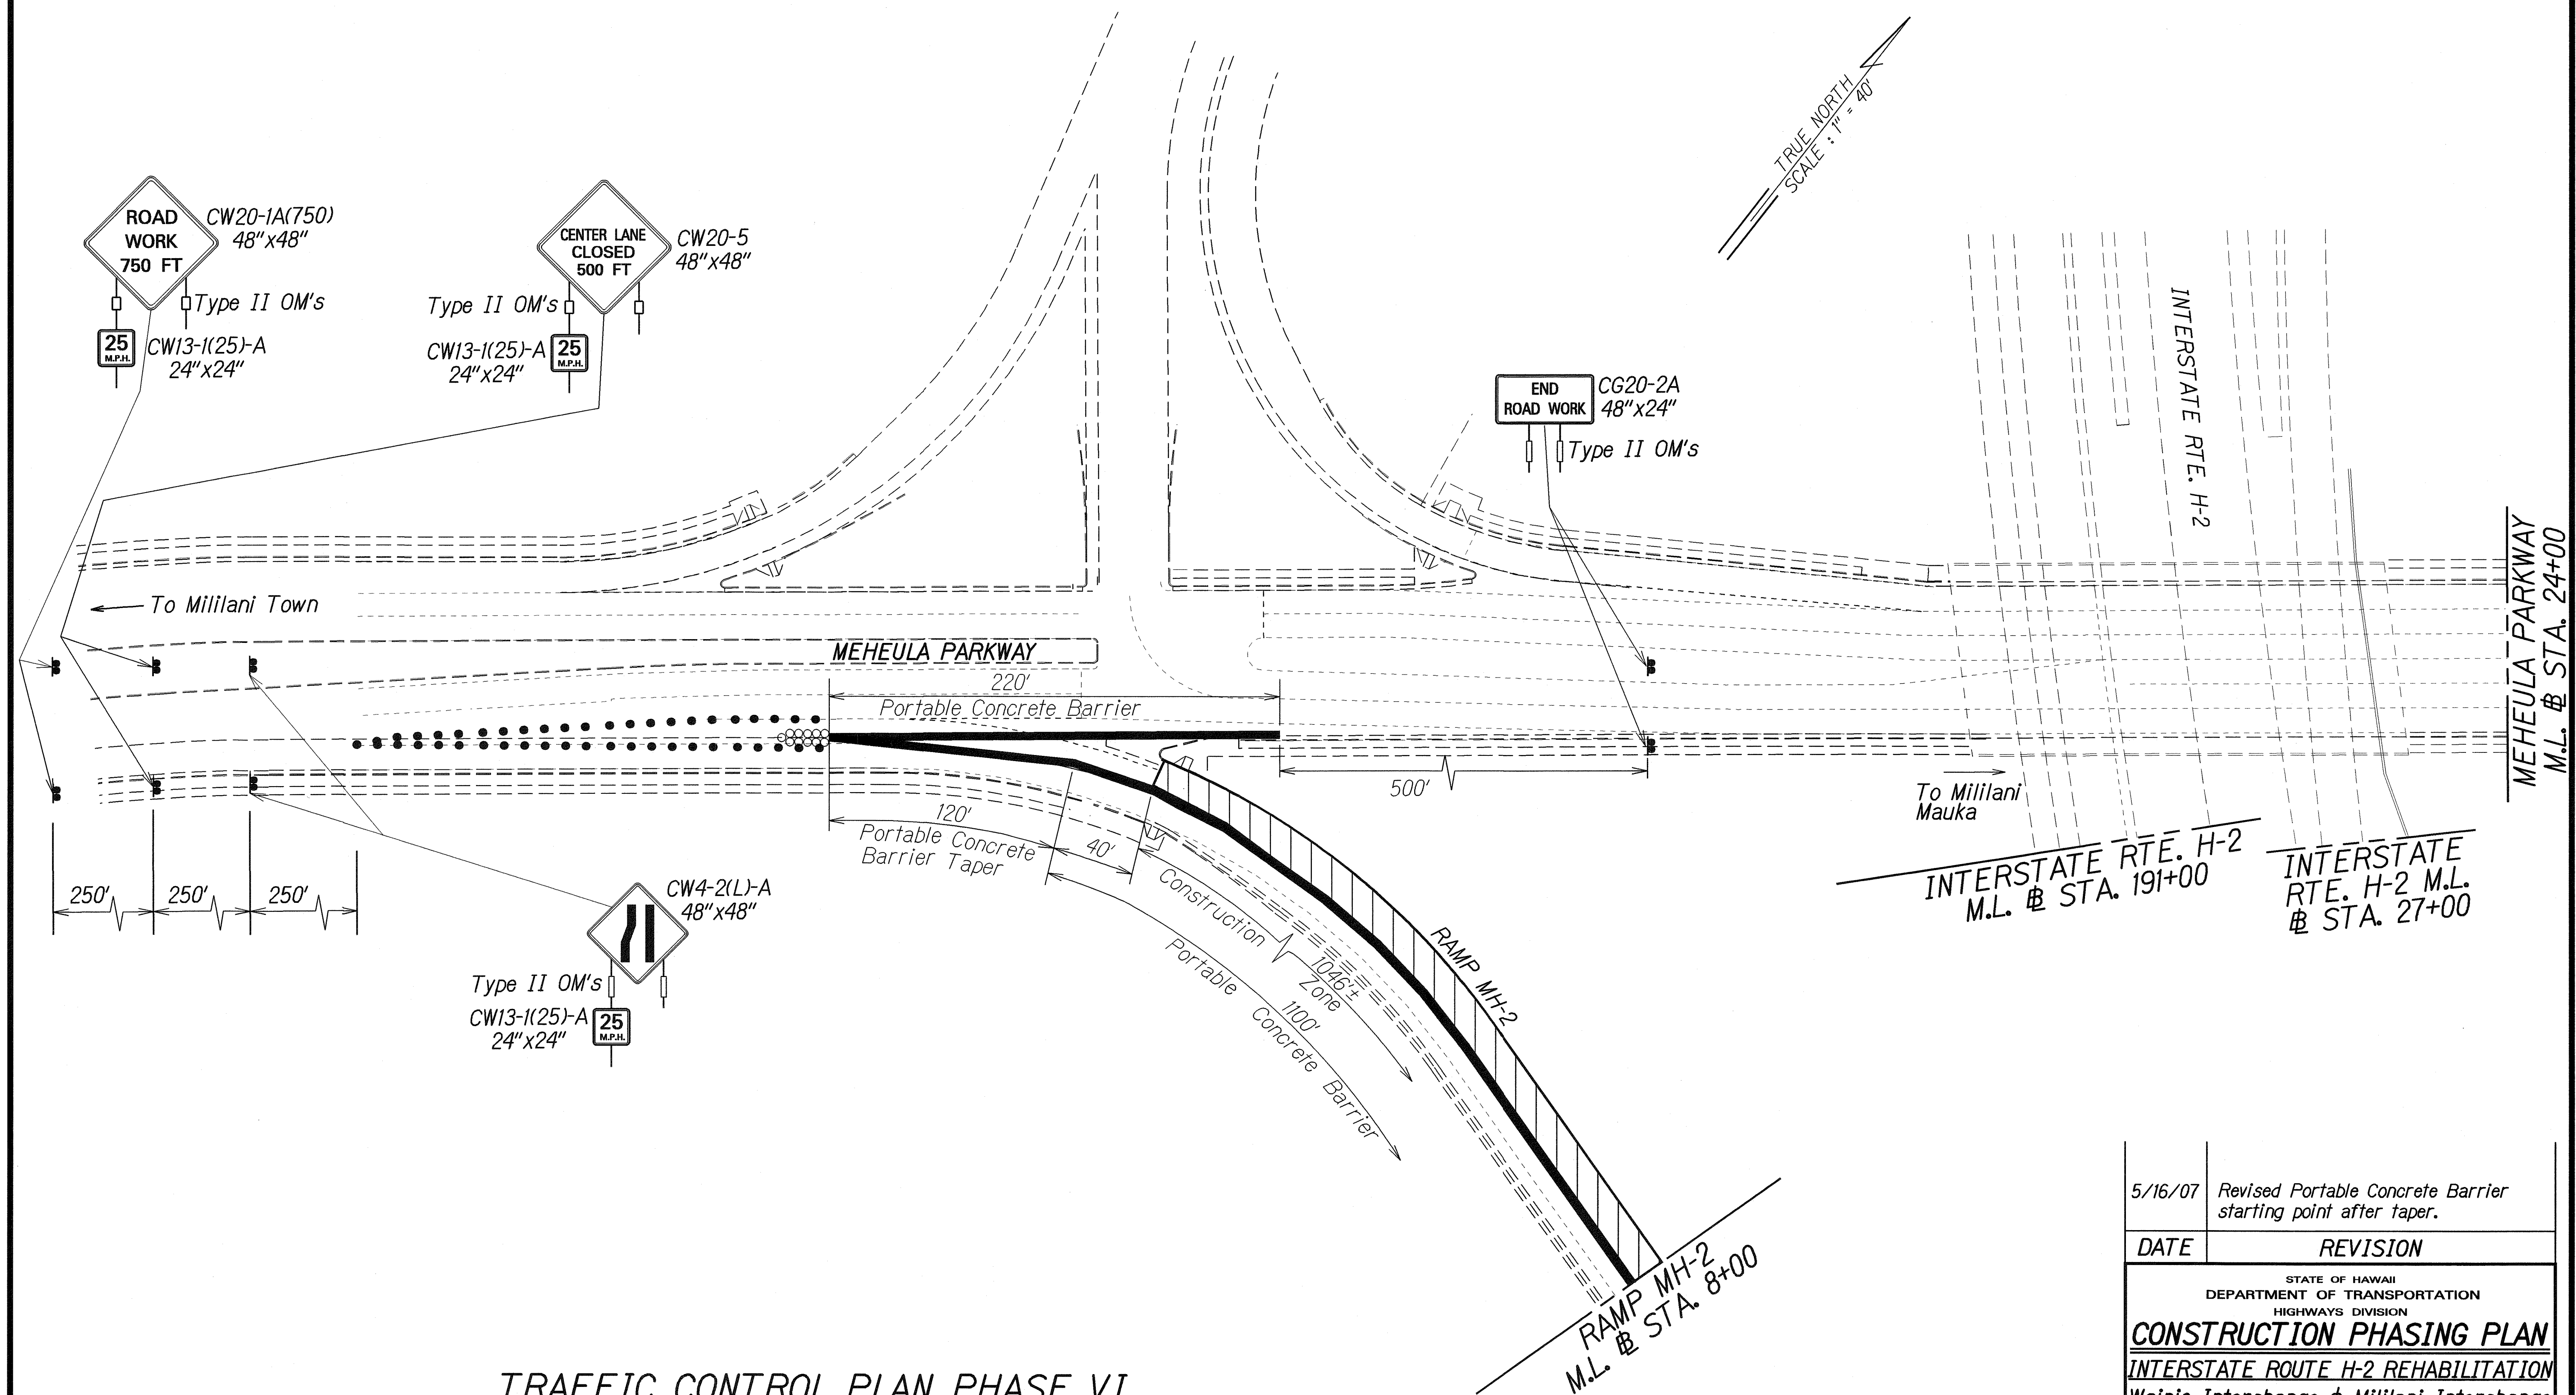

TRAFFIC CONTROL PLAN PHASE VI
H-2 RAMP MH-2 LEFT LANE CLOSED
H-2 Ramp MH-2 (M.L. Sta. 4+54.00 - M.L. Sta. 15+00.00)

5/16/07 Revised Portable Concrete Barrier starting point after taper.

DATE REVISION


STATE OF HAWAII
DEPARTMENT OF TRANSPORTATION
HIGHWAYS DIVISION
CONSTRUCTION PHASING PLAN
INTERSTATE ROUTE H-2 REHABILITATION
Waipio Interchange & Mililani Interchange
On/Off Ramps, Ka Uka Blvd., Meheula Pkwy.
Overpass, & Kipapa Stream Bridge
Federal Aid Project No. IM-H2-1(33)
Scale: 1" = 40' Date: Dec. 2006

SHEET No. 117 OF 63 SHEETS

ADD. 88

SURVEY PLOTTED BY	DATE
DRAWN BY	
DESIGNED BY	
QUANTITIES BY	
CHECKED BY	

FED. ROAD DIST. NO.	STATE	FED. AID PROJ. NO.	FISCAL YEAR	SHEET NO.	TOTAL SHEETS
HAWAII	HAW.	IM-H2-1(33)	2007	89	168

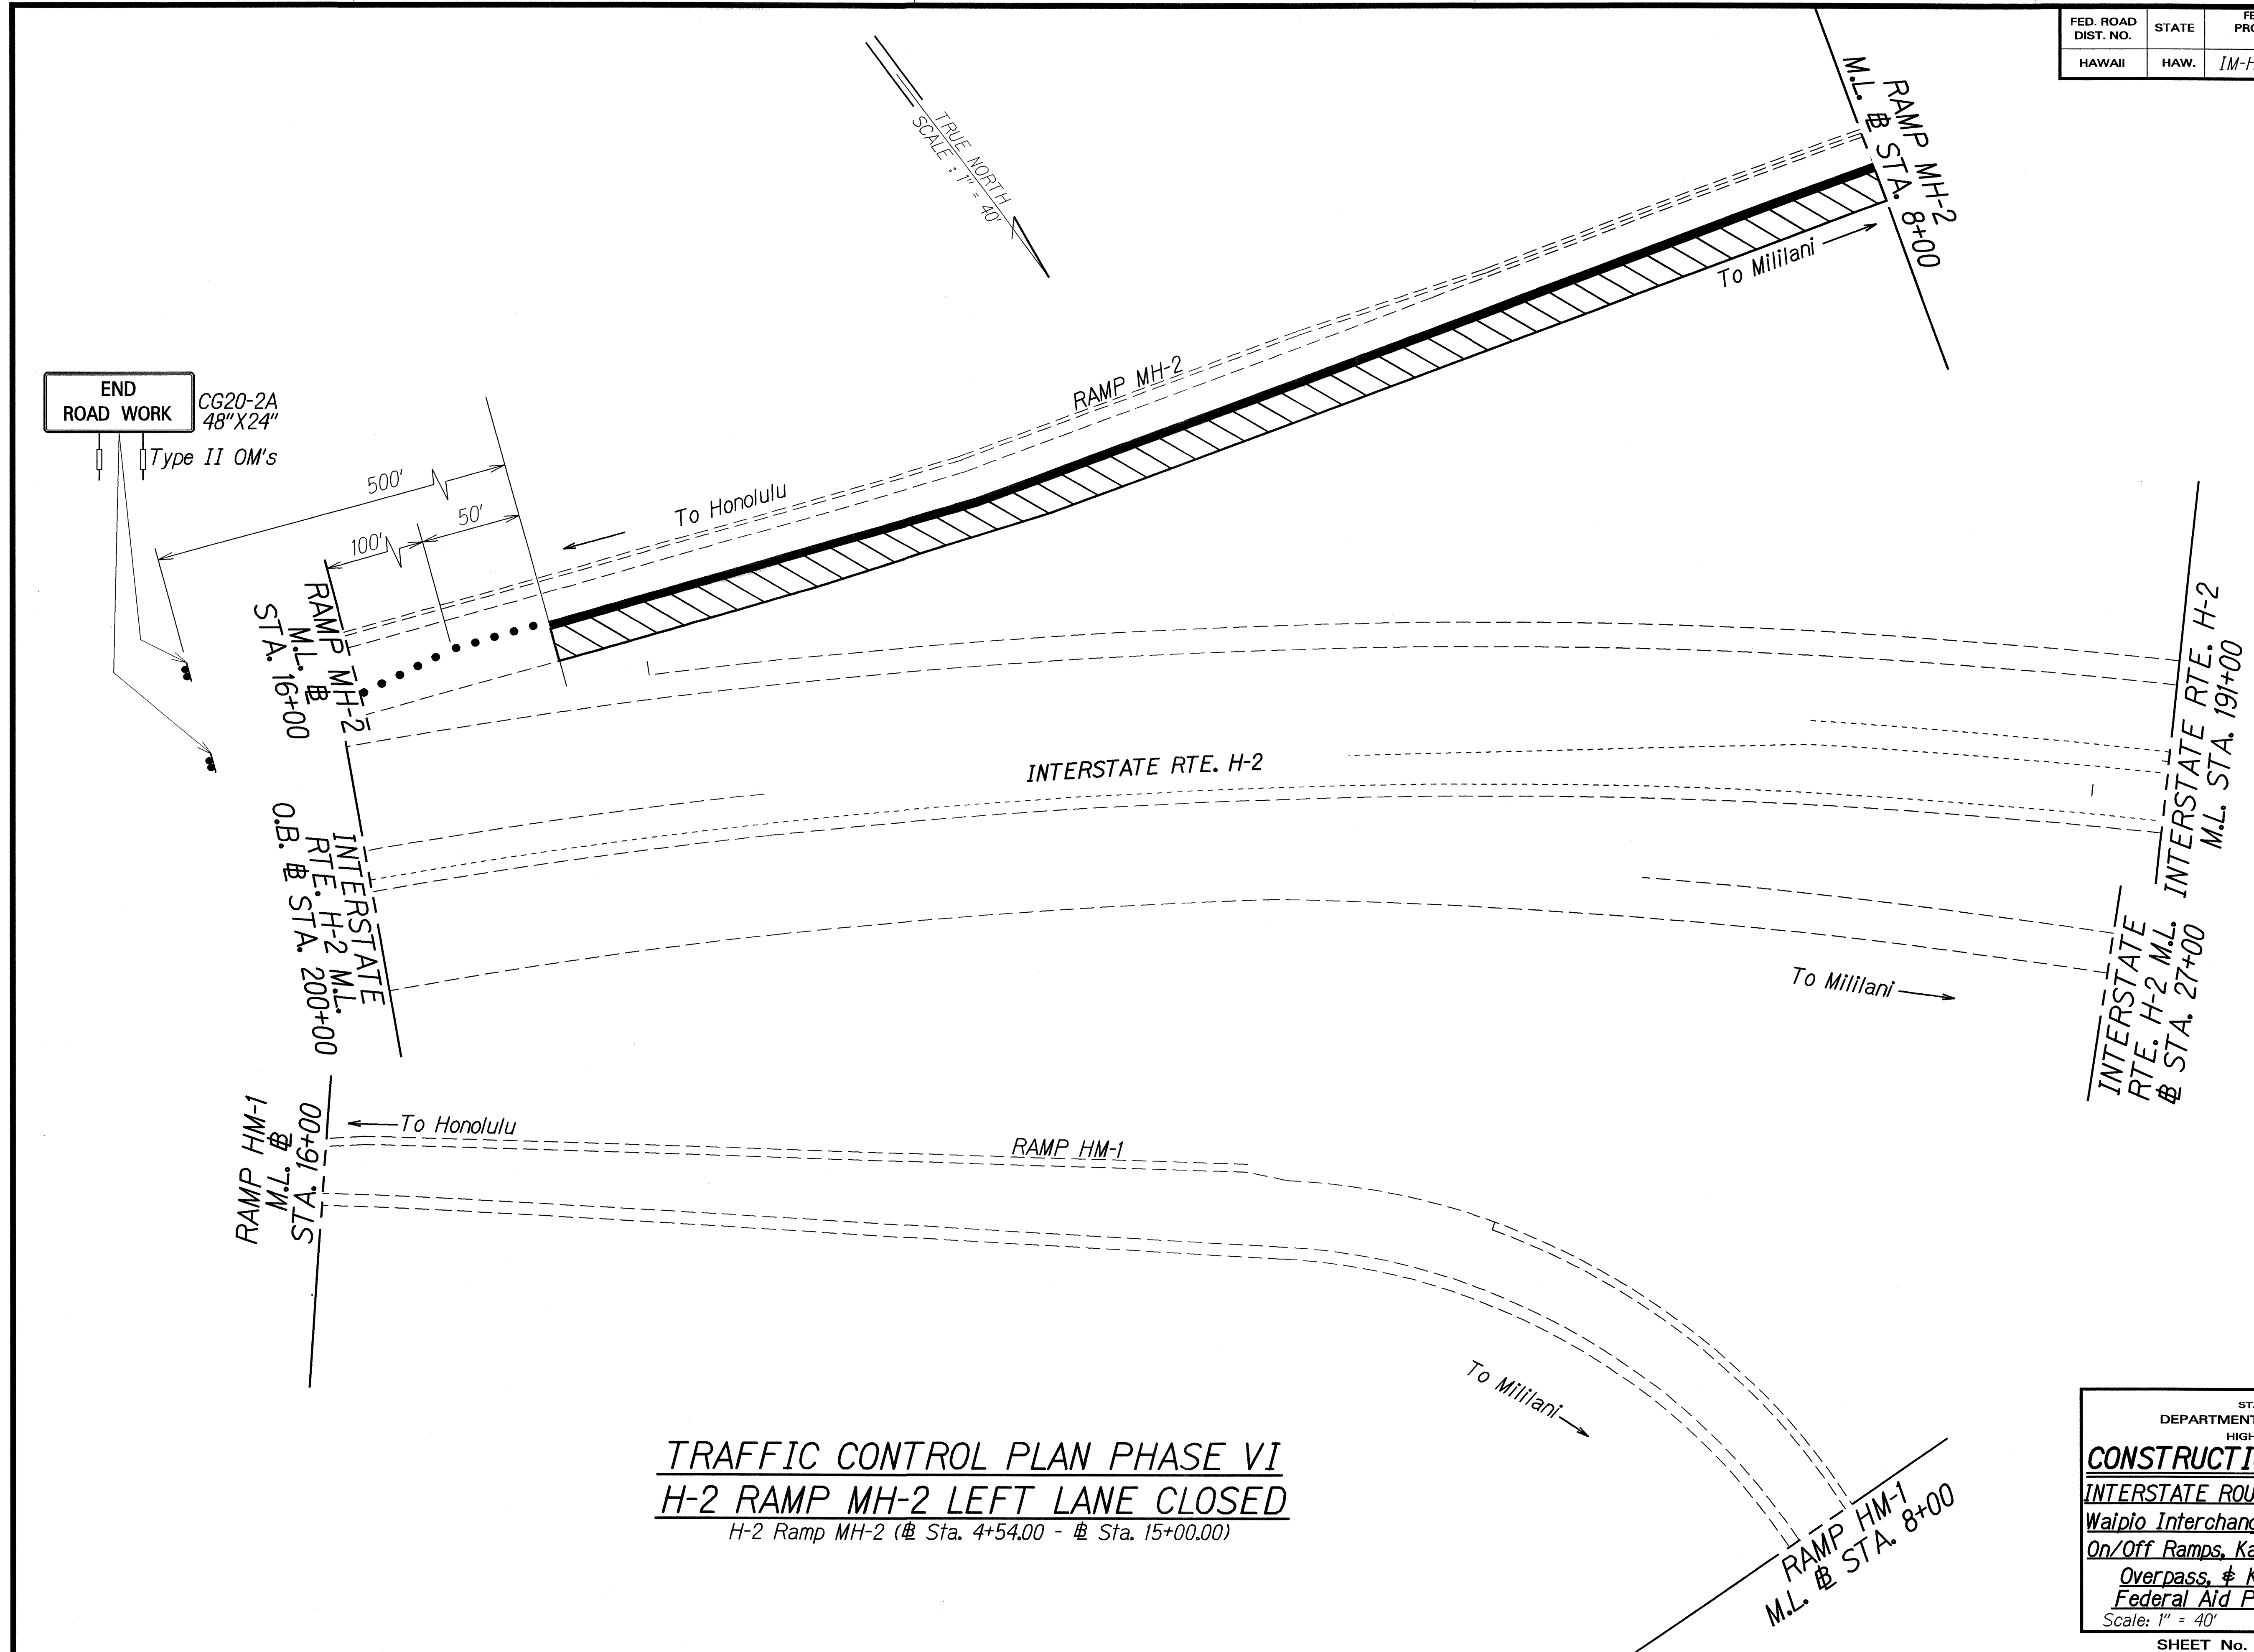

TRAFFIC CONTROL PLAN PHASE VI
H-2 RAMP MH-2 LEFT LANE CLOSED
 H-2 Ramp MH-2 (# Sta. 4+54.00 - # Sta. 15+00.00)

ORIGINAL PLAN	SURVEY PLOTTED BY	DATE
	DRAWN BY <i>M. Takahashi</i>	<i>1/10/07</i>
	DESIGNED BY <i>W. T. D.</i>	
	CHECKED BY	
	NOTED BY <i>W. T. D.</i>	
	DATE	

STATE OF HAWAII
 DEPARTMENT OF TRANSPORTATION
 HIGHWAYS DIVISION


CONSTRUCTION PHASING PLAN

INTERSTATE ROUTE H-2 REHABILITATION
 Waipio Interchange & Mililani Interchange
 On/Off Ramps, Ka Uka Blvd., Meheula Pkwy.
 Overpass, & Kipapa Stream Bridge
 Federal Aid Project No. IM-H2-1(33)

Scale: 1" = 40' Date: Dec. 2006

SHEET No. 718 OF 63 SHEETS

FED. ROAD DIST. NO.	STATE	FED. AID PROJ. NO.	FISCAL YEAR	SHEET NO.	TOTAL SHEETS
HAWAII	HAW.	IM-H2-1(33)	2007	90	168

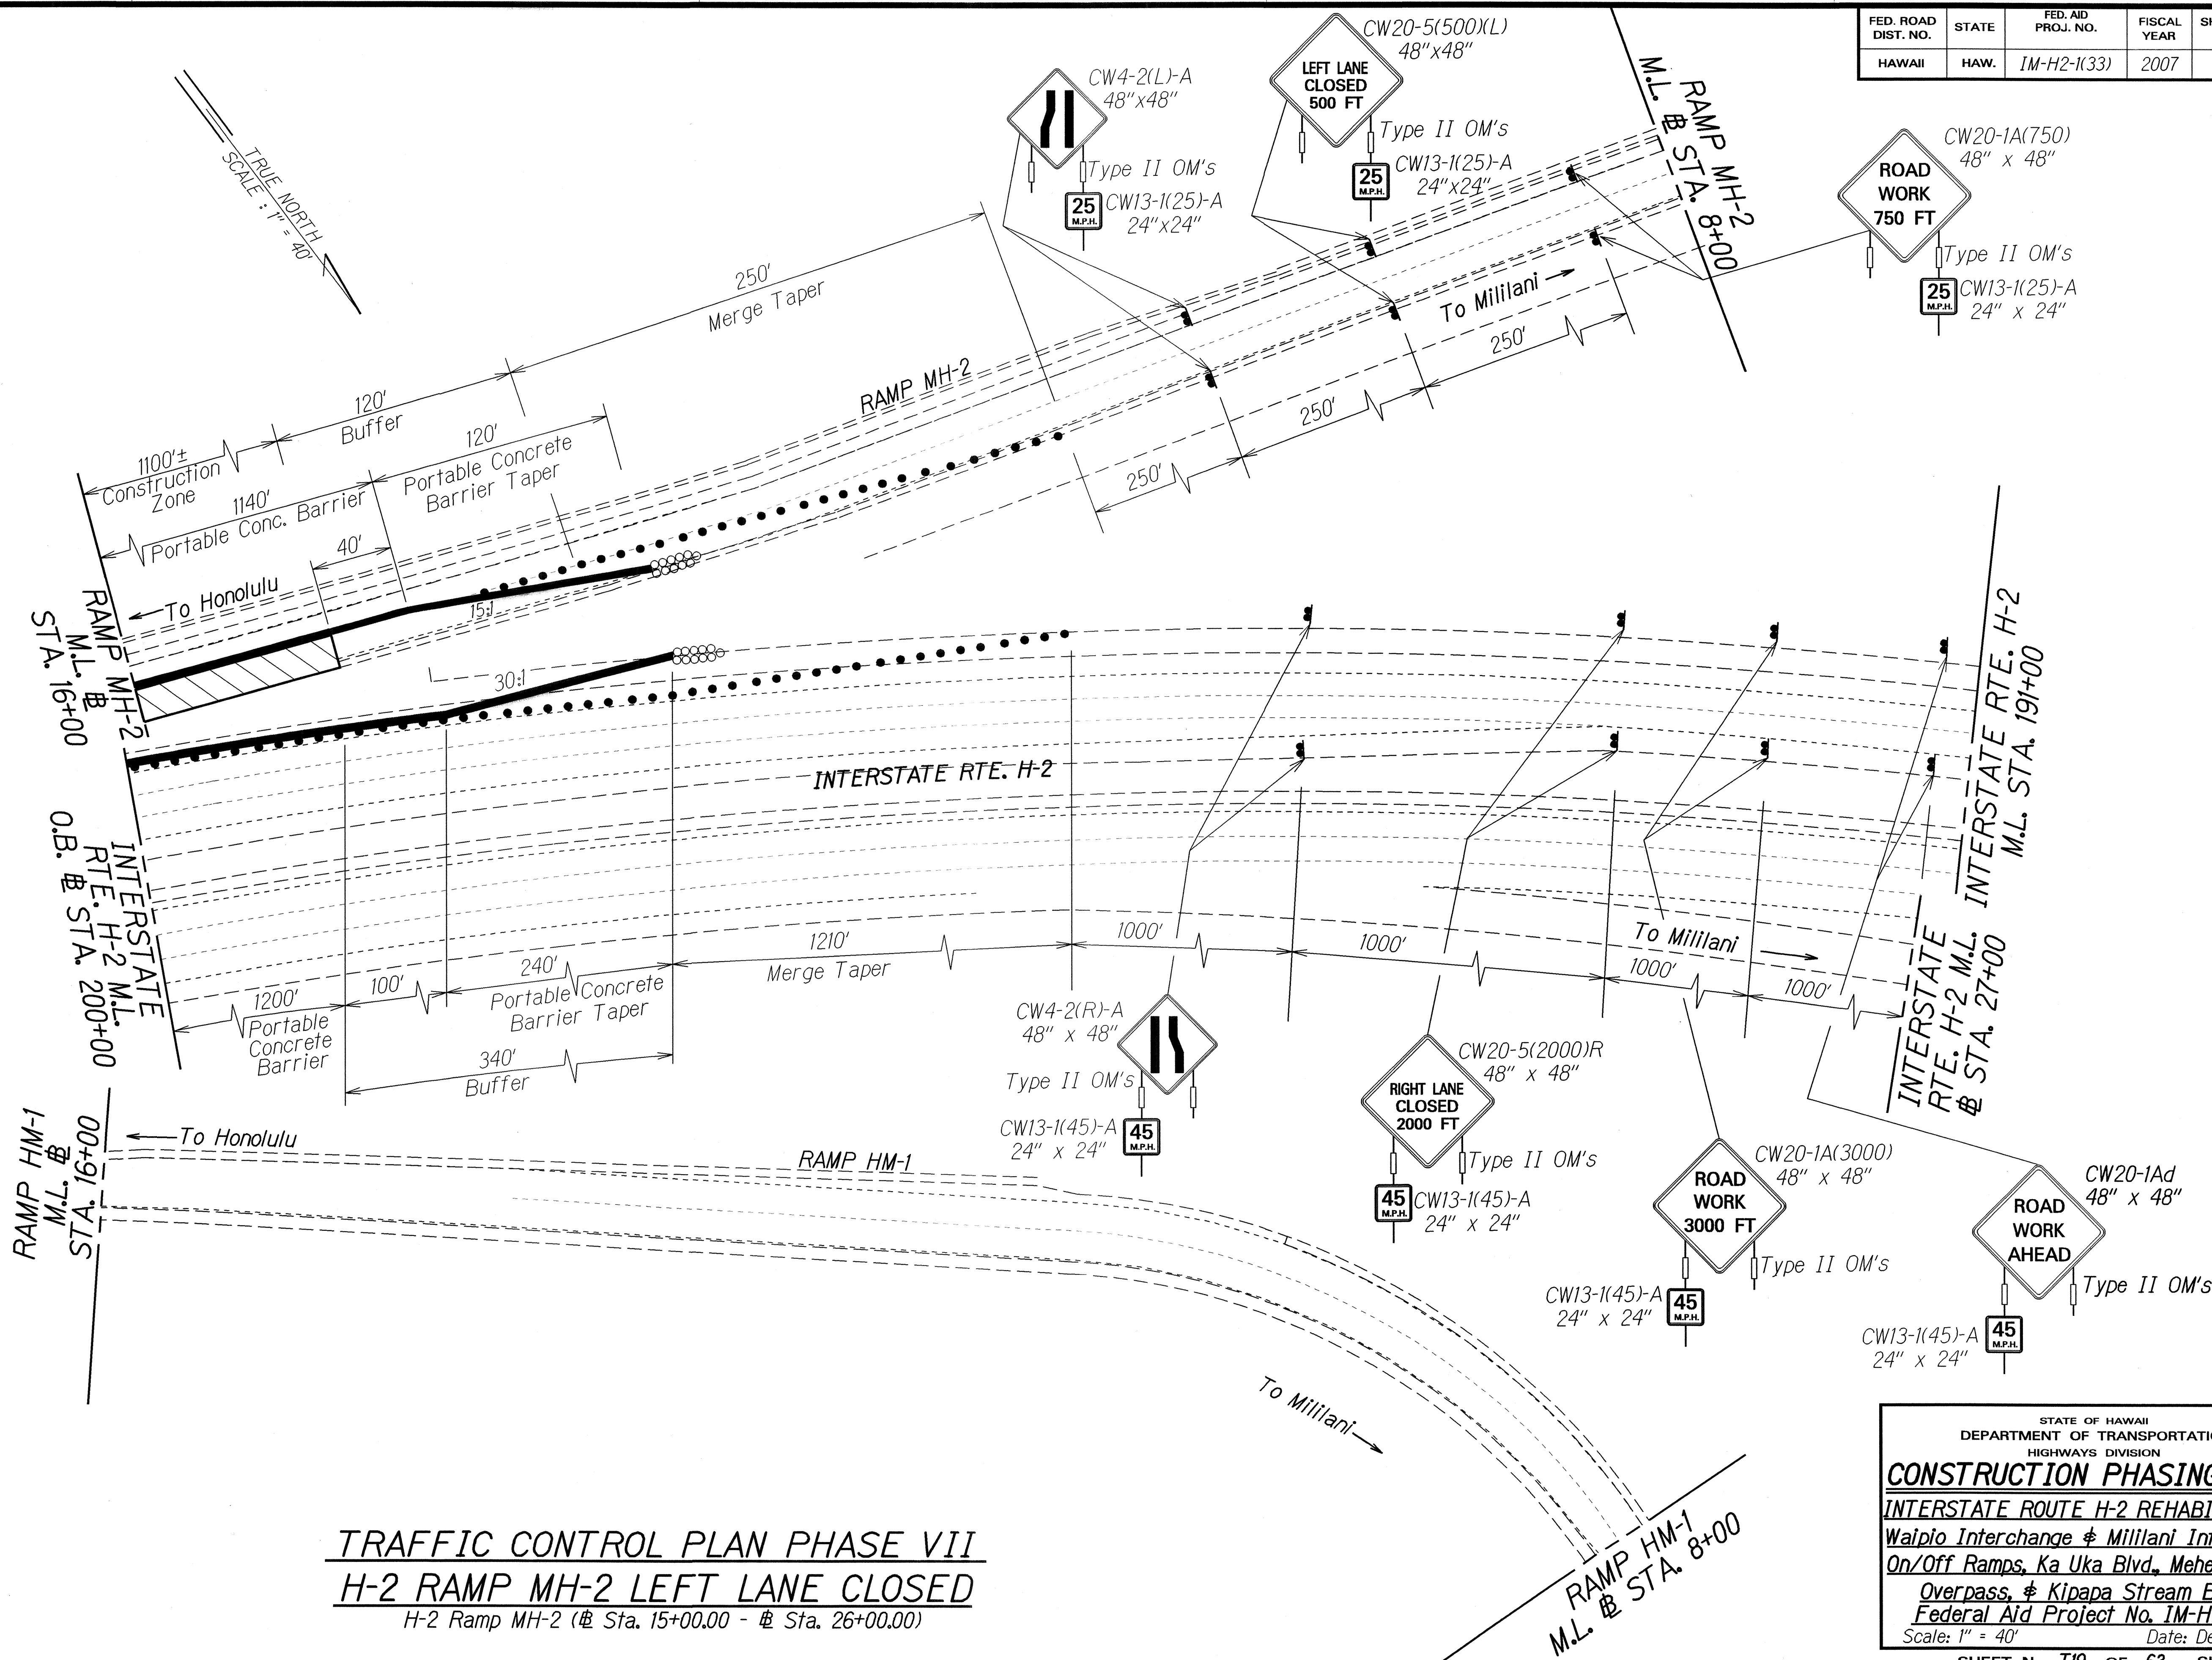


ORIGINAL PLAN	SURVEY PLOTTED BY	DATE
NOTE BOOK	DRAWN BY M. Takafuji	
142 May	DESIGNED BY JHW/TD	
4/12/2007	CHECKED BY	

STATE OF HAWAII
 DEPARTMENT OF TRANSPORTATION
 HIGHWAYS DIVISION

CONSTRUCTION PHASING PLAN
 INTERSTATE ROUTE H-2 REHABILITATION
 Waipio Interchange & Mililani Interchange
 On/Off Ramps, Ka Uka Blvd., Meheula Pkwy.
 Overpass, & Kipapa Stream Bridge
 Federal Aid Project No. IM-H2-1(33)
 Scale: 1" = 40' Date: Dec. 2006


SHEET No. T19 OF 63 SHEETS

FED. ROAD DIST. NO.	STATE	FED. AID PROJ. NO.	FISCAL YEAR	SHEET NO.	TOTAL SHEETS
HAWAII	HAW.	IM-H2-1(33)	2007	91	168

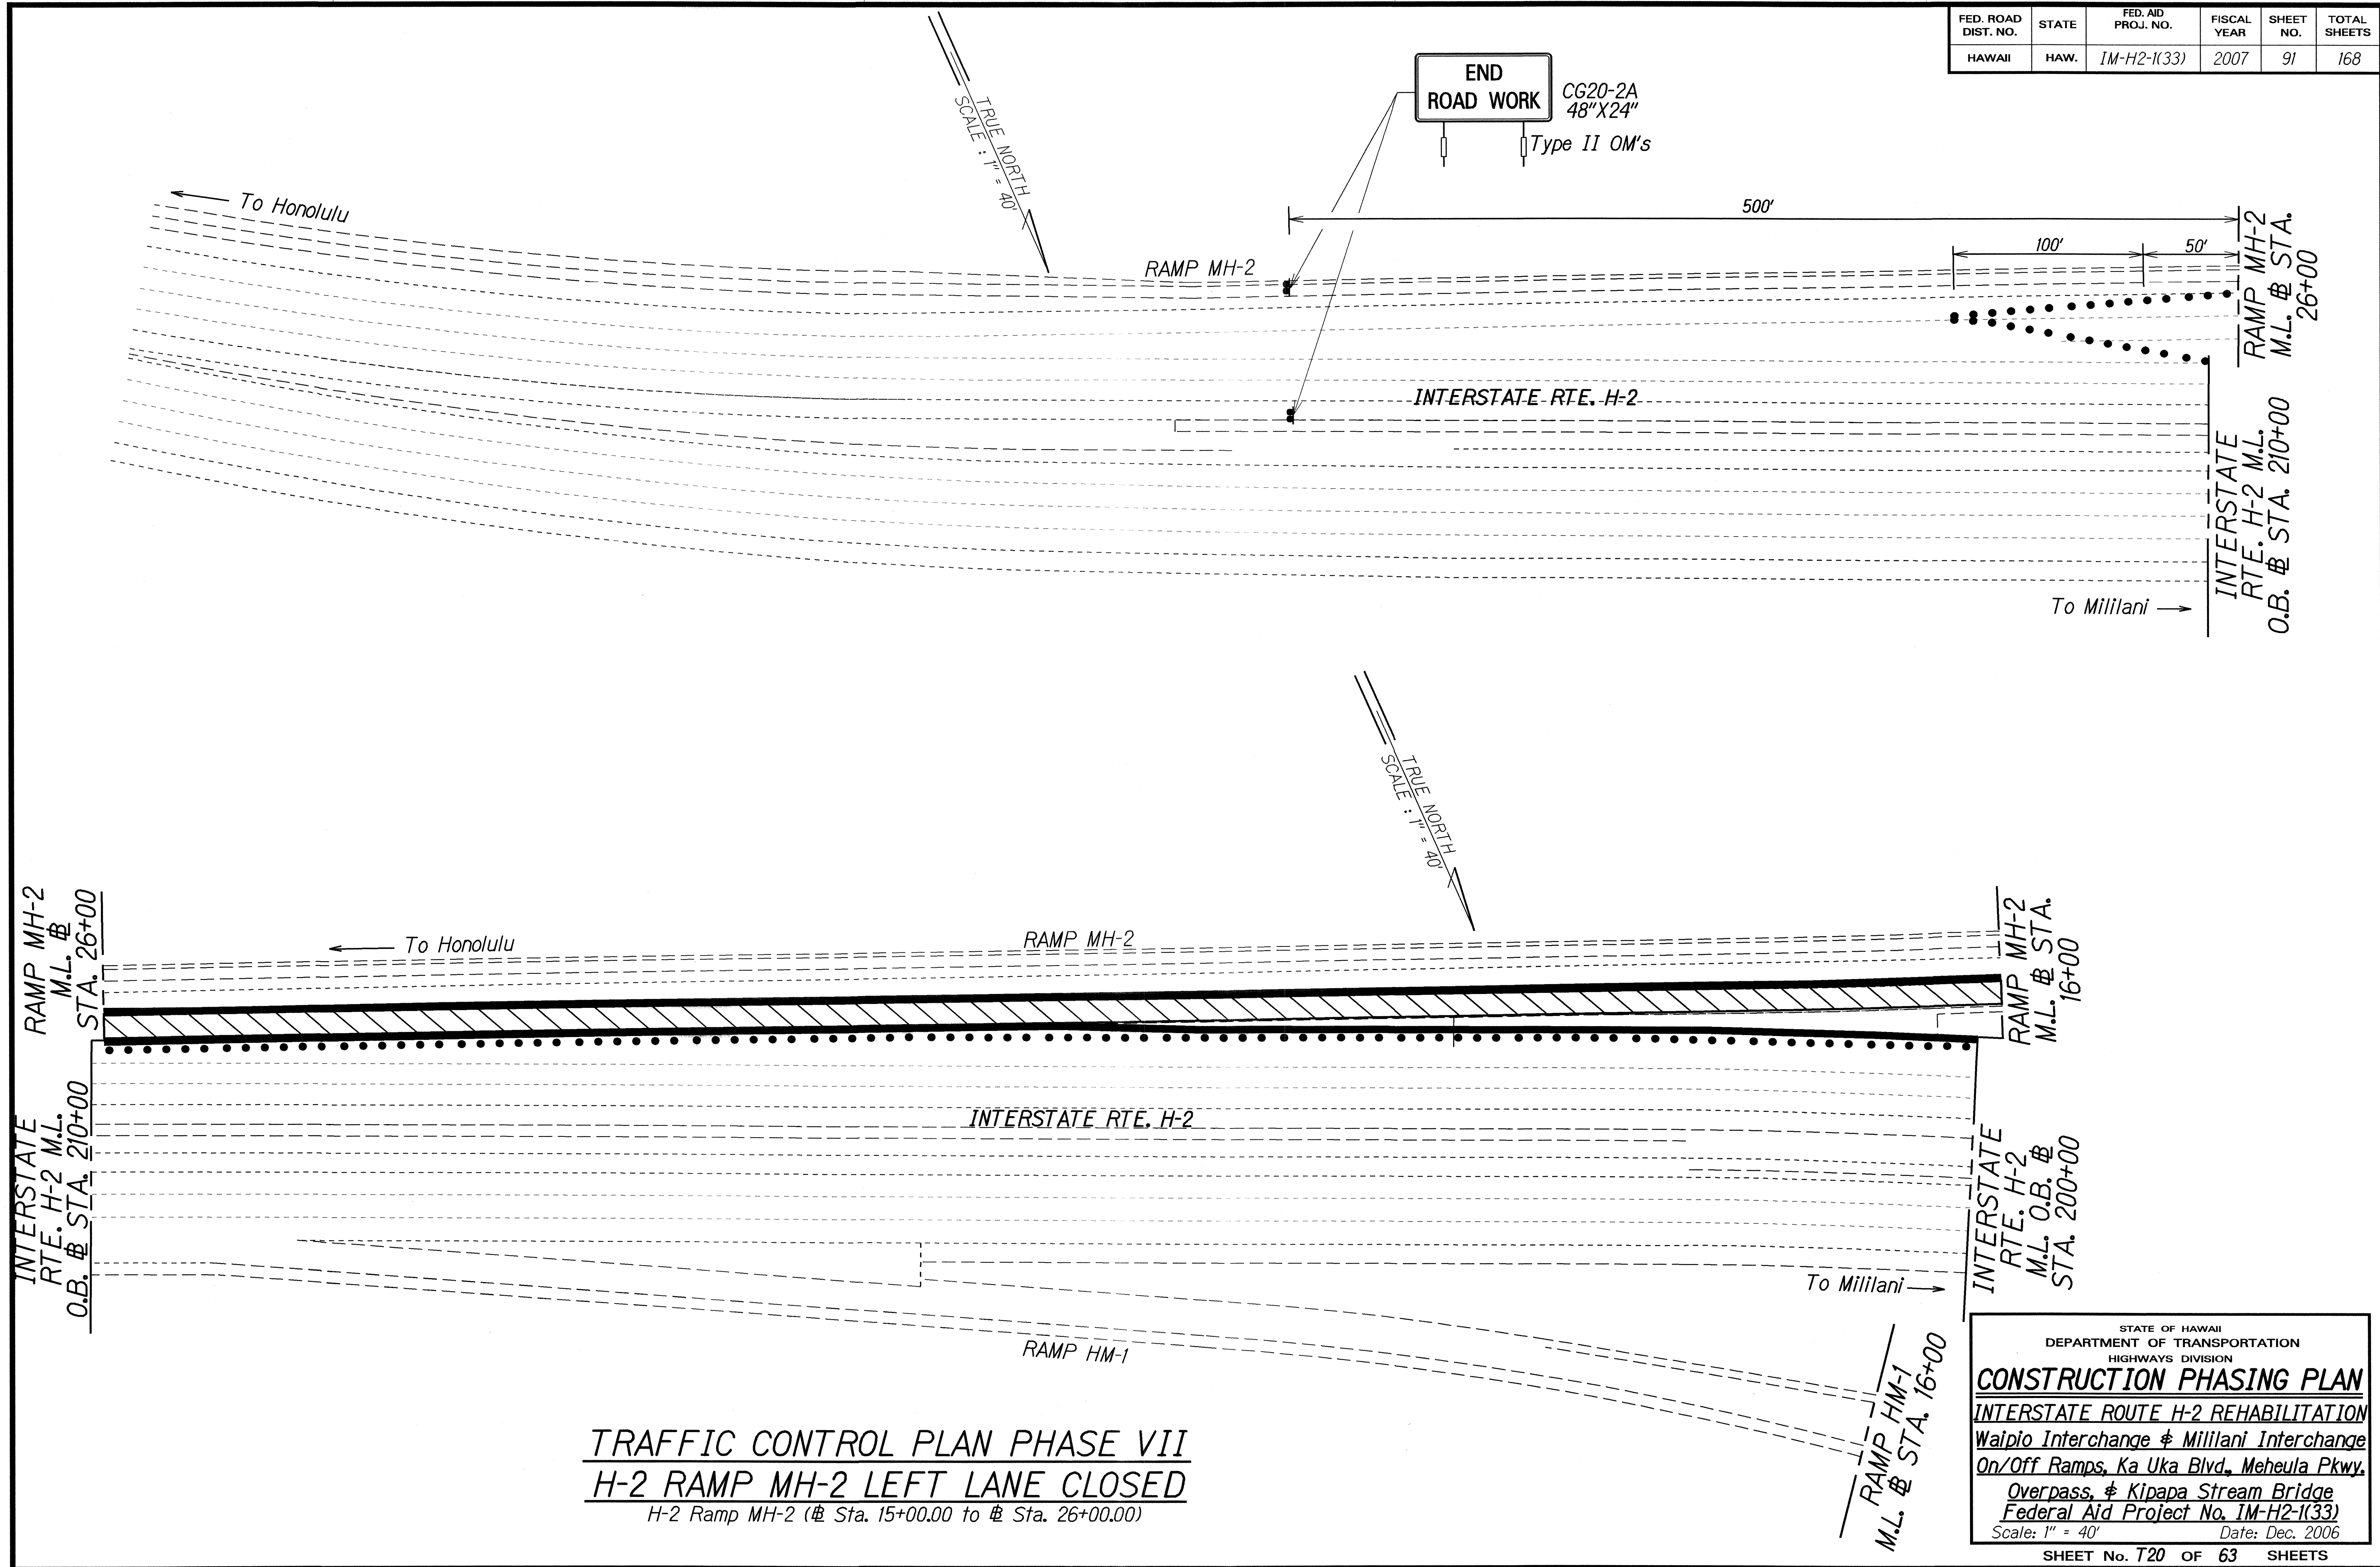

ORIGINAL PLAN	DATE
SURVEY PLOTTED BY	
DRAWN BY	
DESIGNED BY	
CHECKED BY	


FED. ROAD DIST. NO.	STATE	FED. AID PROJ. NO.	FISCAL YEAR	SHEET NO.	TOTAL SHEETS
HAWAII	HAW.	IM-H2-1(33)	2007	92	168

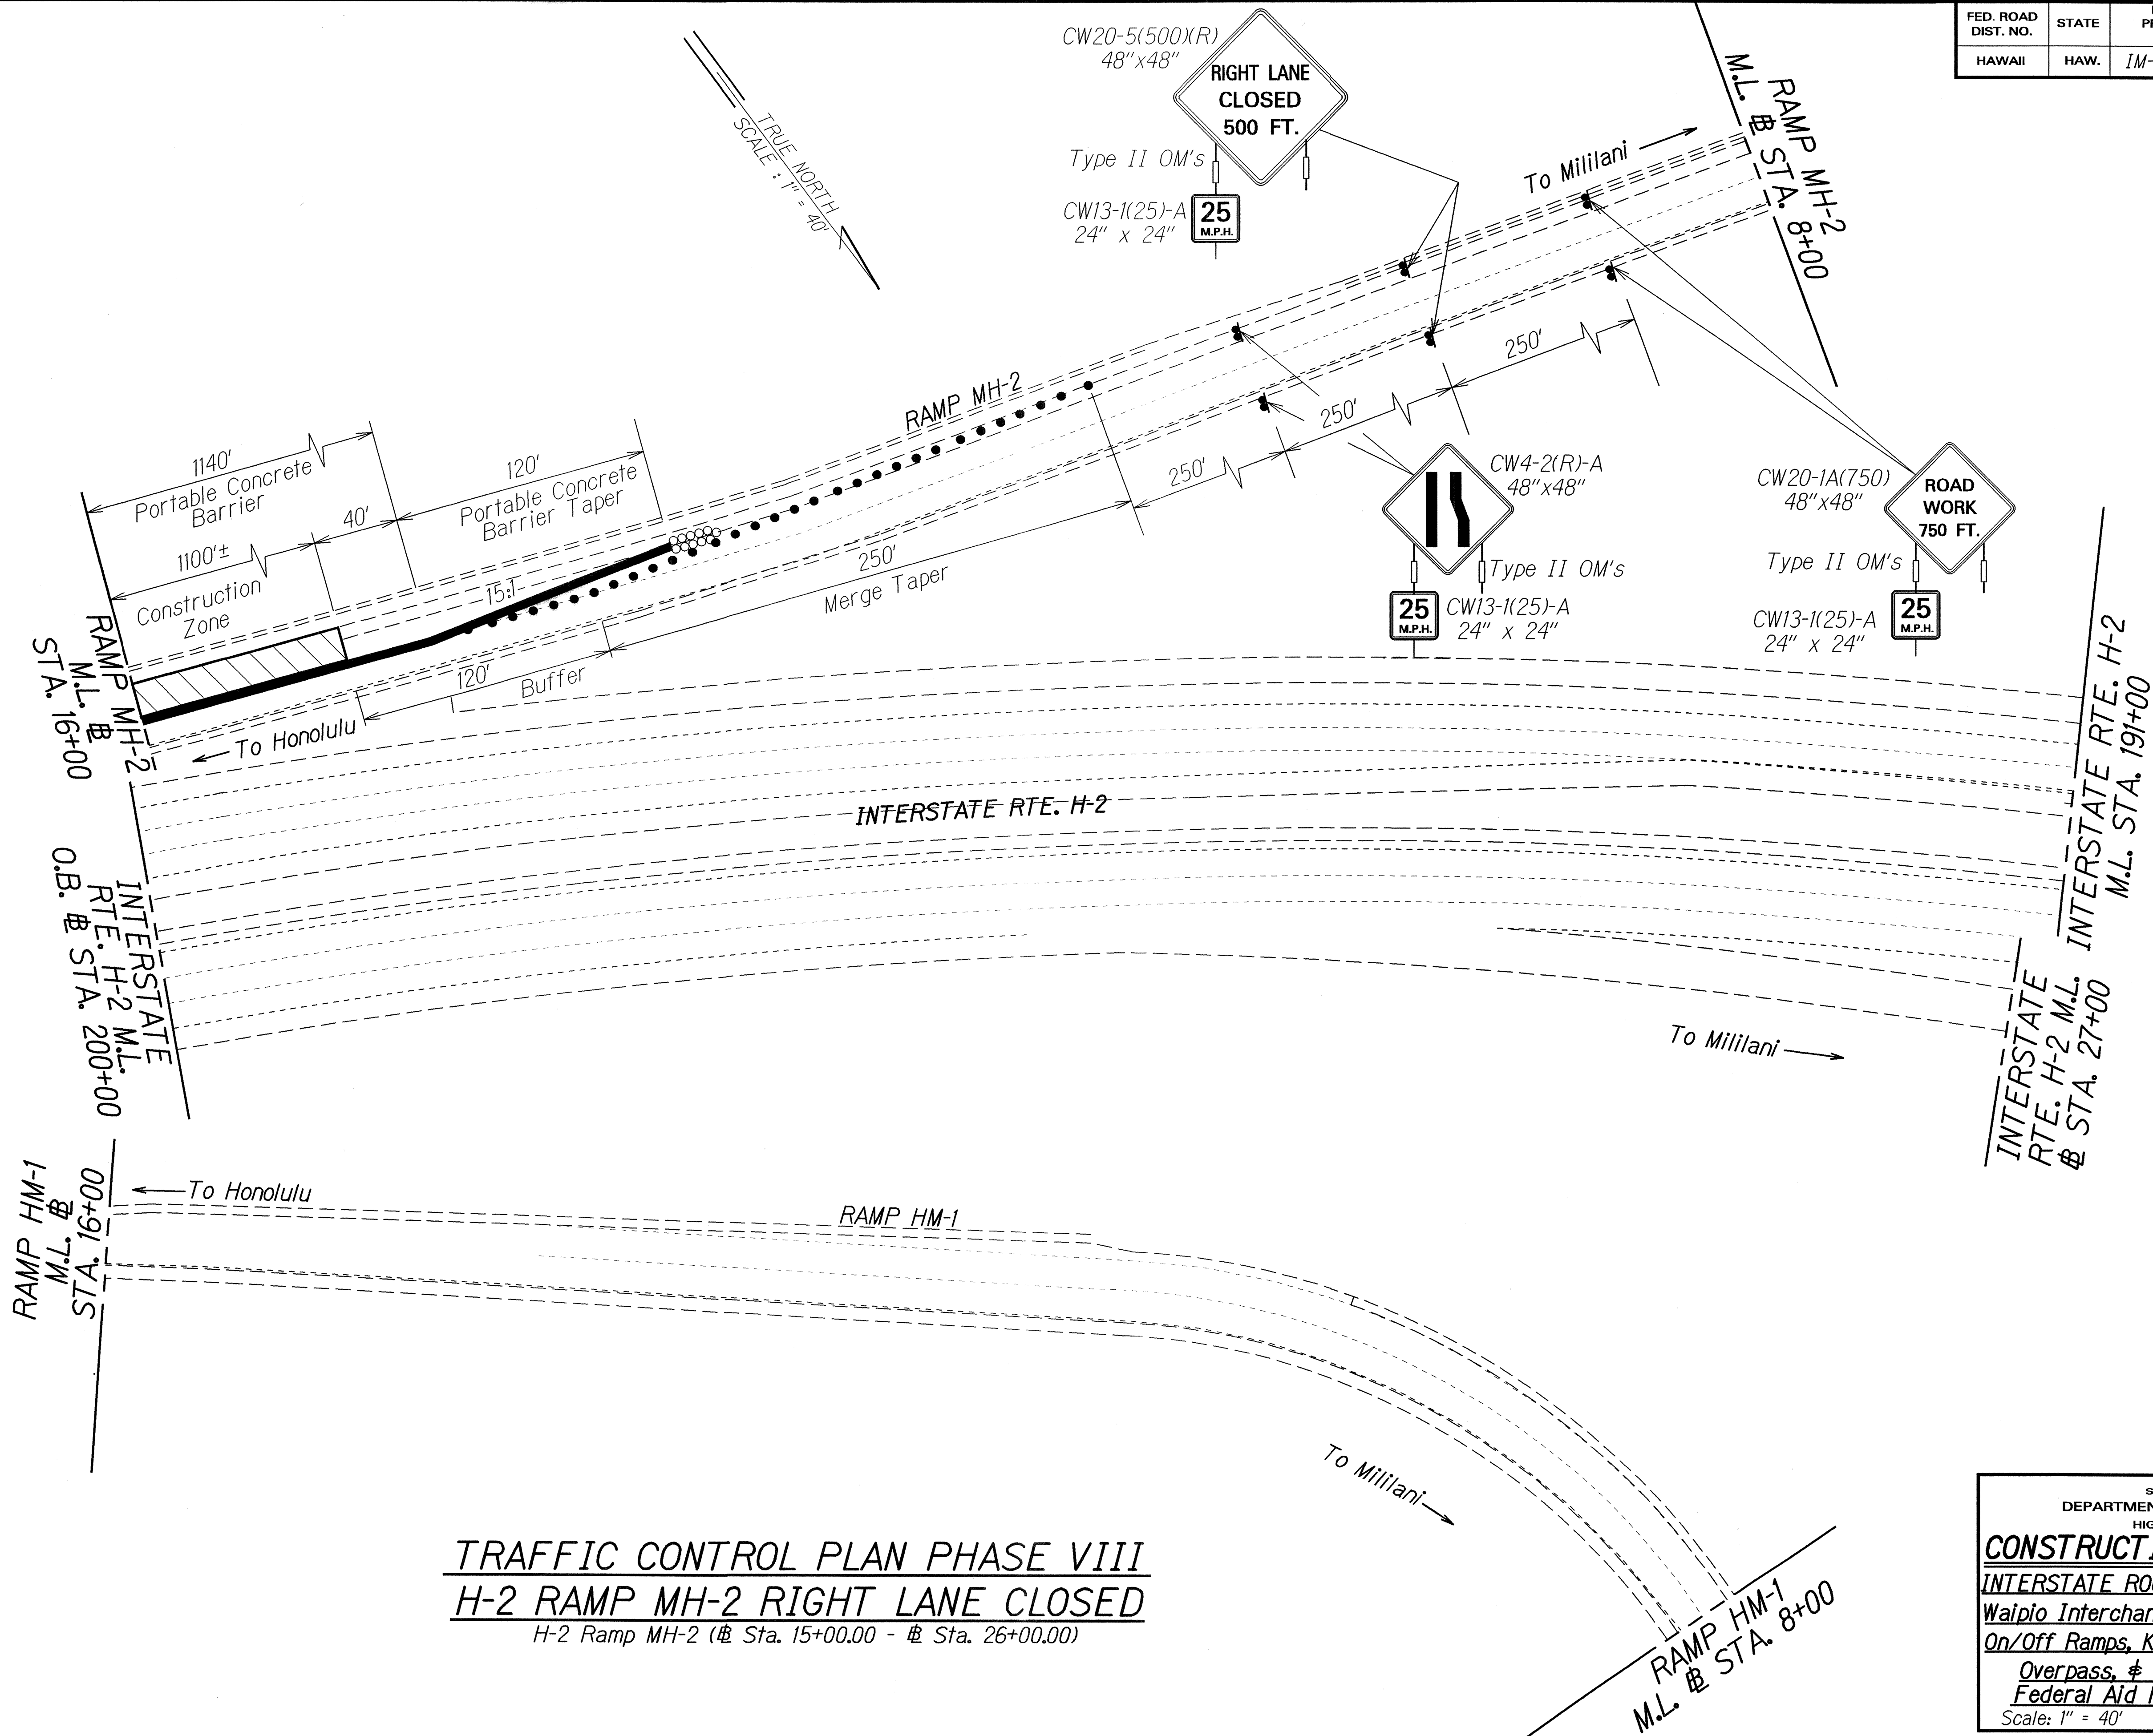

TRAFFIC CONTROL PLAN PHASE VIII
H-2 RAMP MH-2 RIGHT LANE CLOSED
 H-2 Ramp MH-2 (Sta. 15+00.00 - Sta. 26+00.00)

STATE OF HAWAII
 DEPARTMENT OF TRANSPORTATION
 HIGHWAYS DIVISION
CONSTRUCTION PHASING PLAN
 INTERSTATE ROUTE H-2 REHABILITATION
 Waipio Interchange & Mililani Interchange
 On/Off Ramps, Ka Uka Blvd., Meheula Pkwy.
 Overpass, & Kipapa Stream Bridge
 Federal Aid Project No. IM-H2-1(33)
 Scale: 1" = 40' Date: Dec. 2006
 SHEET No. T21 OF 63 SHEETS

FED. ROAD DIST. NO.	STATE	FED. AID PROJ. NO.	FISCAL YEAR	SHEET NO.	TOTAL SHEETS
HAWAII	HAW.	IM-H2-1(33)	2007	ADD. 94	168

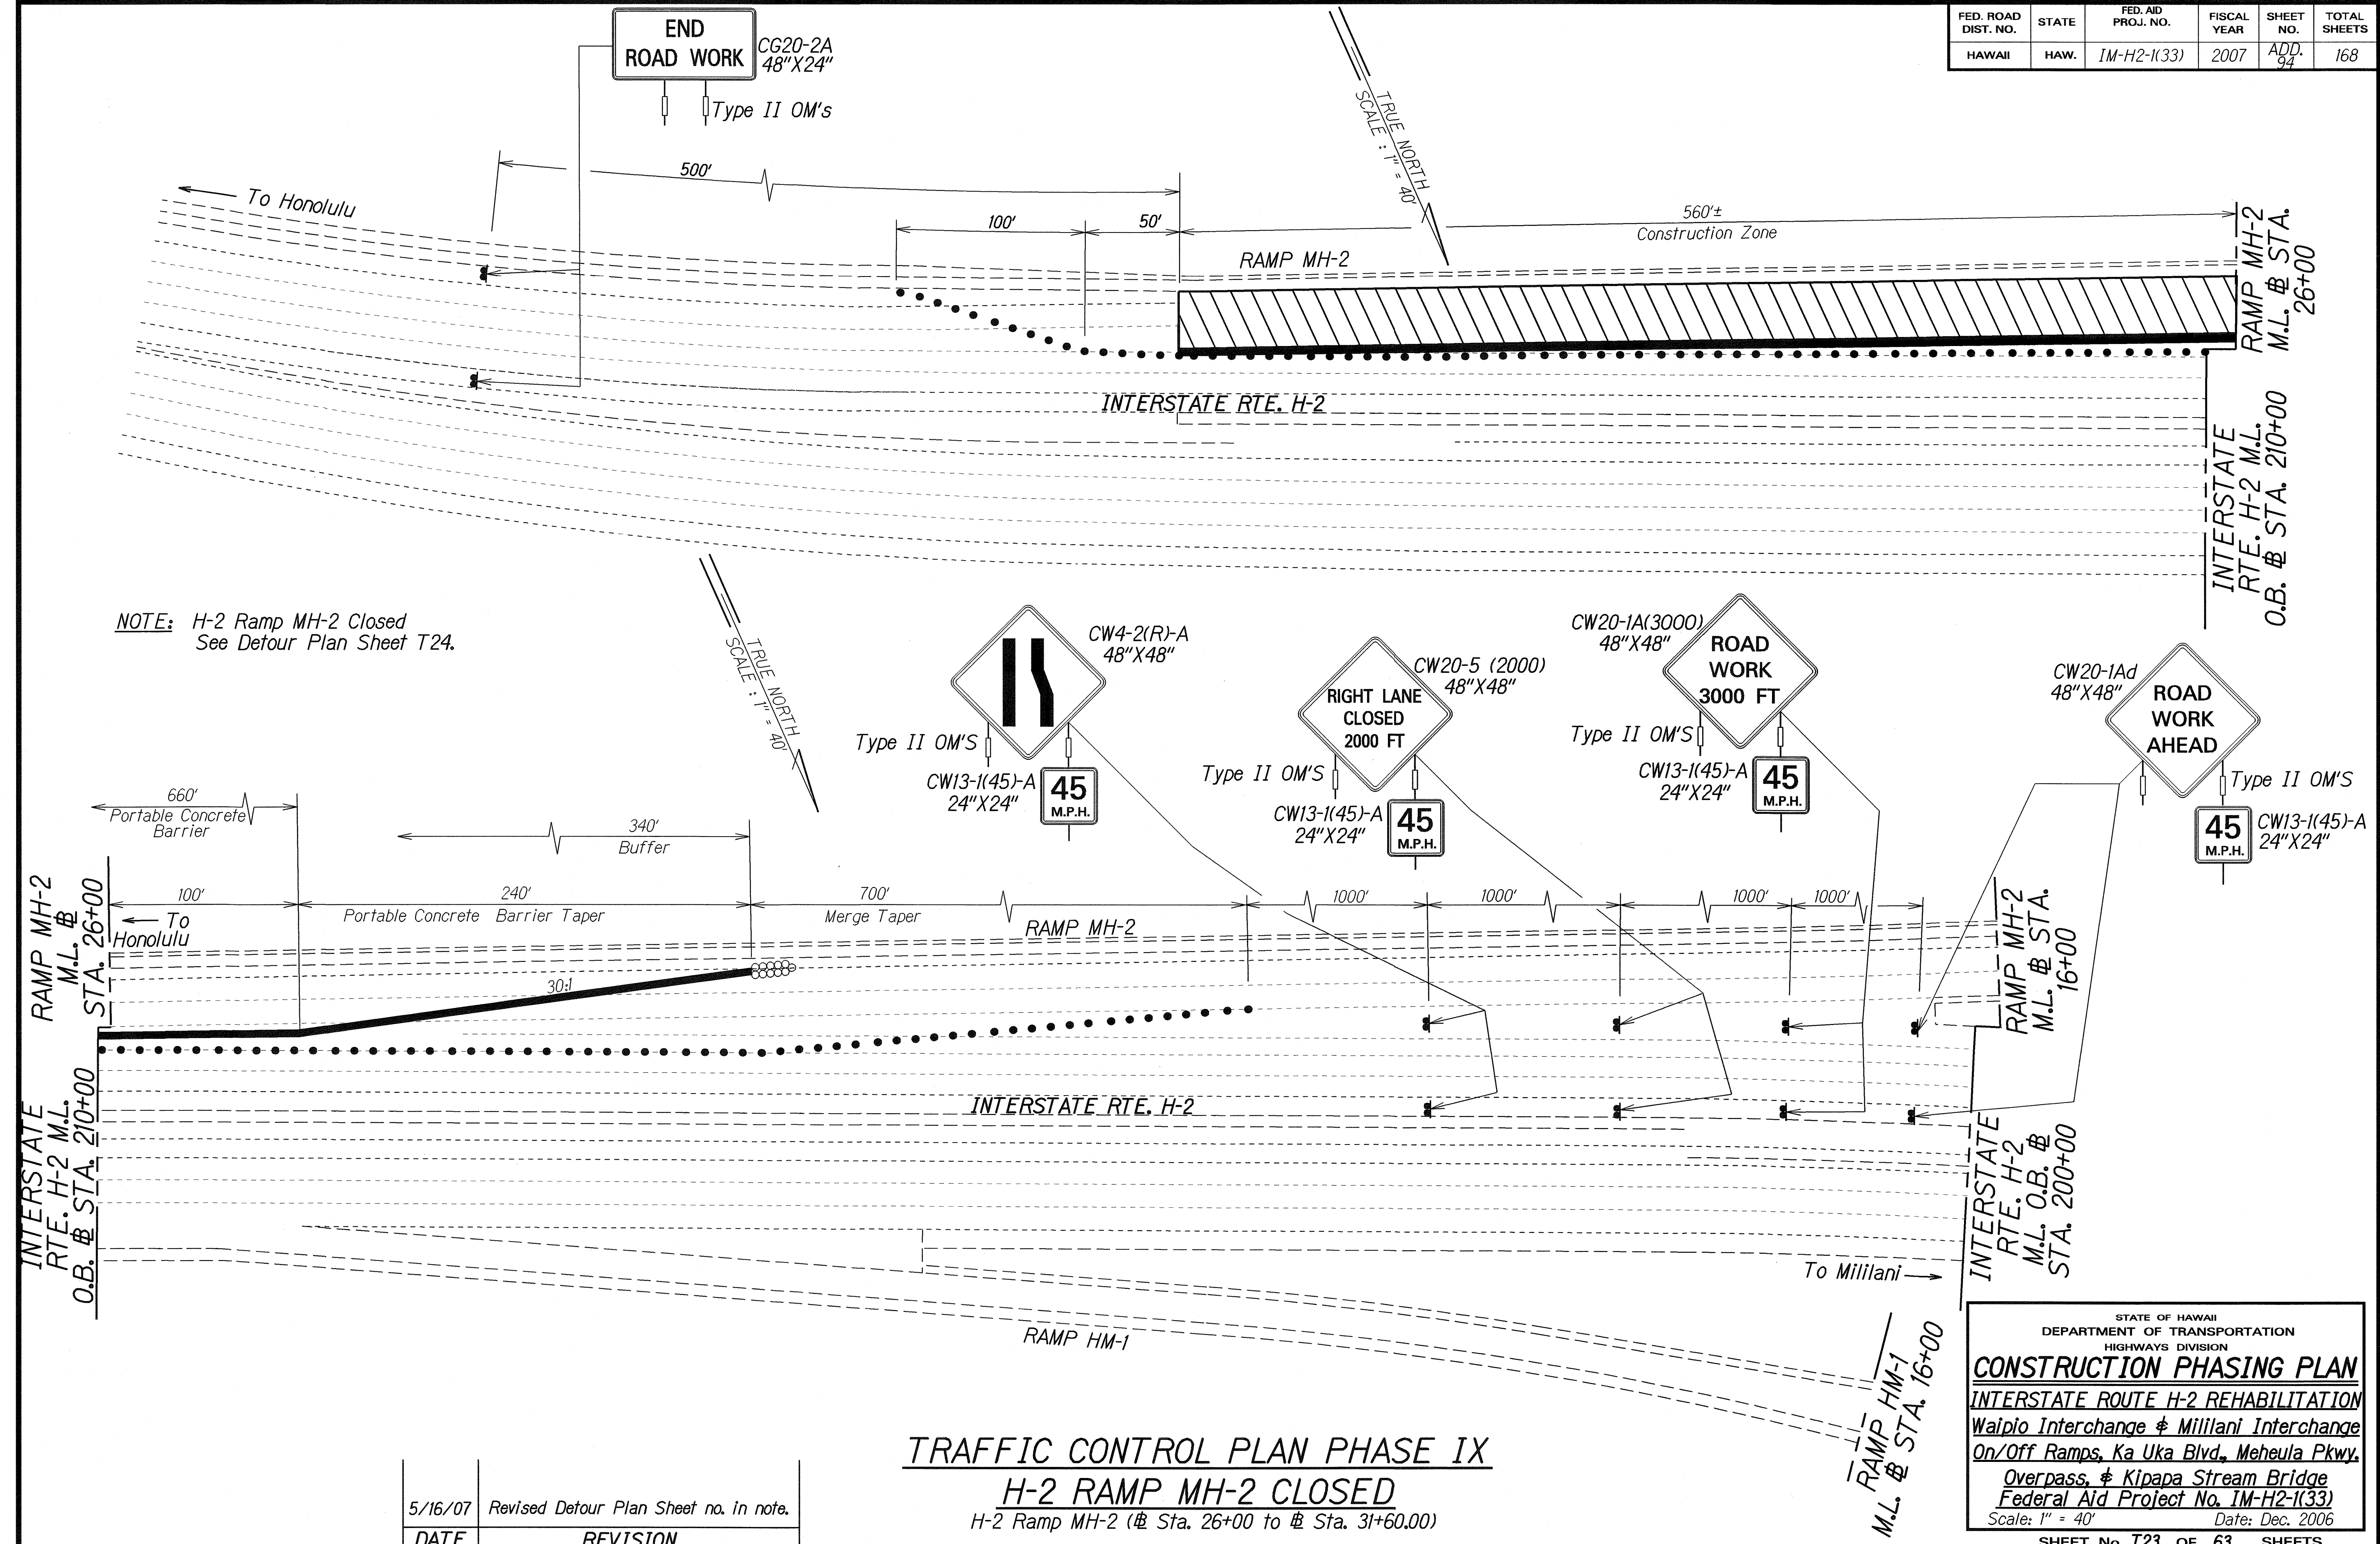

SURVEY PLOTTED BY	DATE
PLAN	5/16/07
DESIGNED BY	5/16/07
QUANTITIES BY	5/16/07
CHECKED BY	5/16/07

5/16/07	Revised Detour Plan Sheet no. in note.
DATE	REVISION

STATE OF HAWAII
DEPARTMENT OF TRANSPORTATION
HIGHWAYS DIVISION

CONSTRUCTION PHASING PLAN
INTERSTATE ROUTE H-2 REHABILITATION
Waipio Interchange & Mililani Interchange
On/Off Ramps, Ka Uka Blvd., Meheula Pkwy.
Overpass, & Kipapa Stream Bridge
Federal Aid Project No. IM-H2-1(33)
Scale: 1" = 40' Date: Dec. 2006

FED. ROAD DIST. NO.	STATE	FED. AID PROJ. NO.	FISCAL YEAR	SHEET NO.	TOTAL SHEETS
HAWAII	HAW.	IM-H2-1(33)	2007	95	168

RAMP
CLOSED
AHEAD

CW20-3
(36"x36")

SOUTH

IM3-3
(24"x12")

INTERSTATE

H2

IM-1(H2)
(24"x24")

3

DETOUR

CM4-8
(24"x12")

SOUTH

IM3-3
(24"x12")

INTERSTATE

H2

IM-1(H2)
(24"x24")

↑

IM6-3
(21"x15")

b1

DETOUR

CM4-8
(24"x12")

SOUTH

IM3-3
(24"x12")

INTERSTATE

H2

IM-1(H2)
(24"x24")

↶

CW1-11(U)
(21"x18")

b2

DETOUR

CM4-8
(24"x12")

SOUTH

IM3-3
(24"x12")

INTERSTATE


H2

IM-1(H2)
(24"x24")

↗

IM6-2
(21"x15")

b3

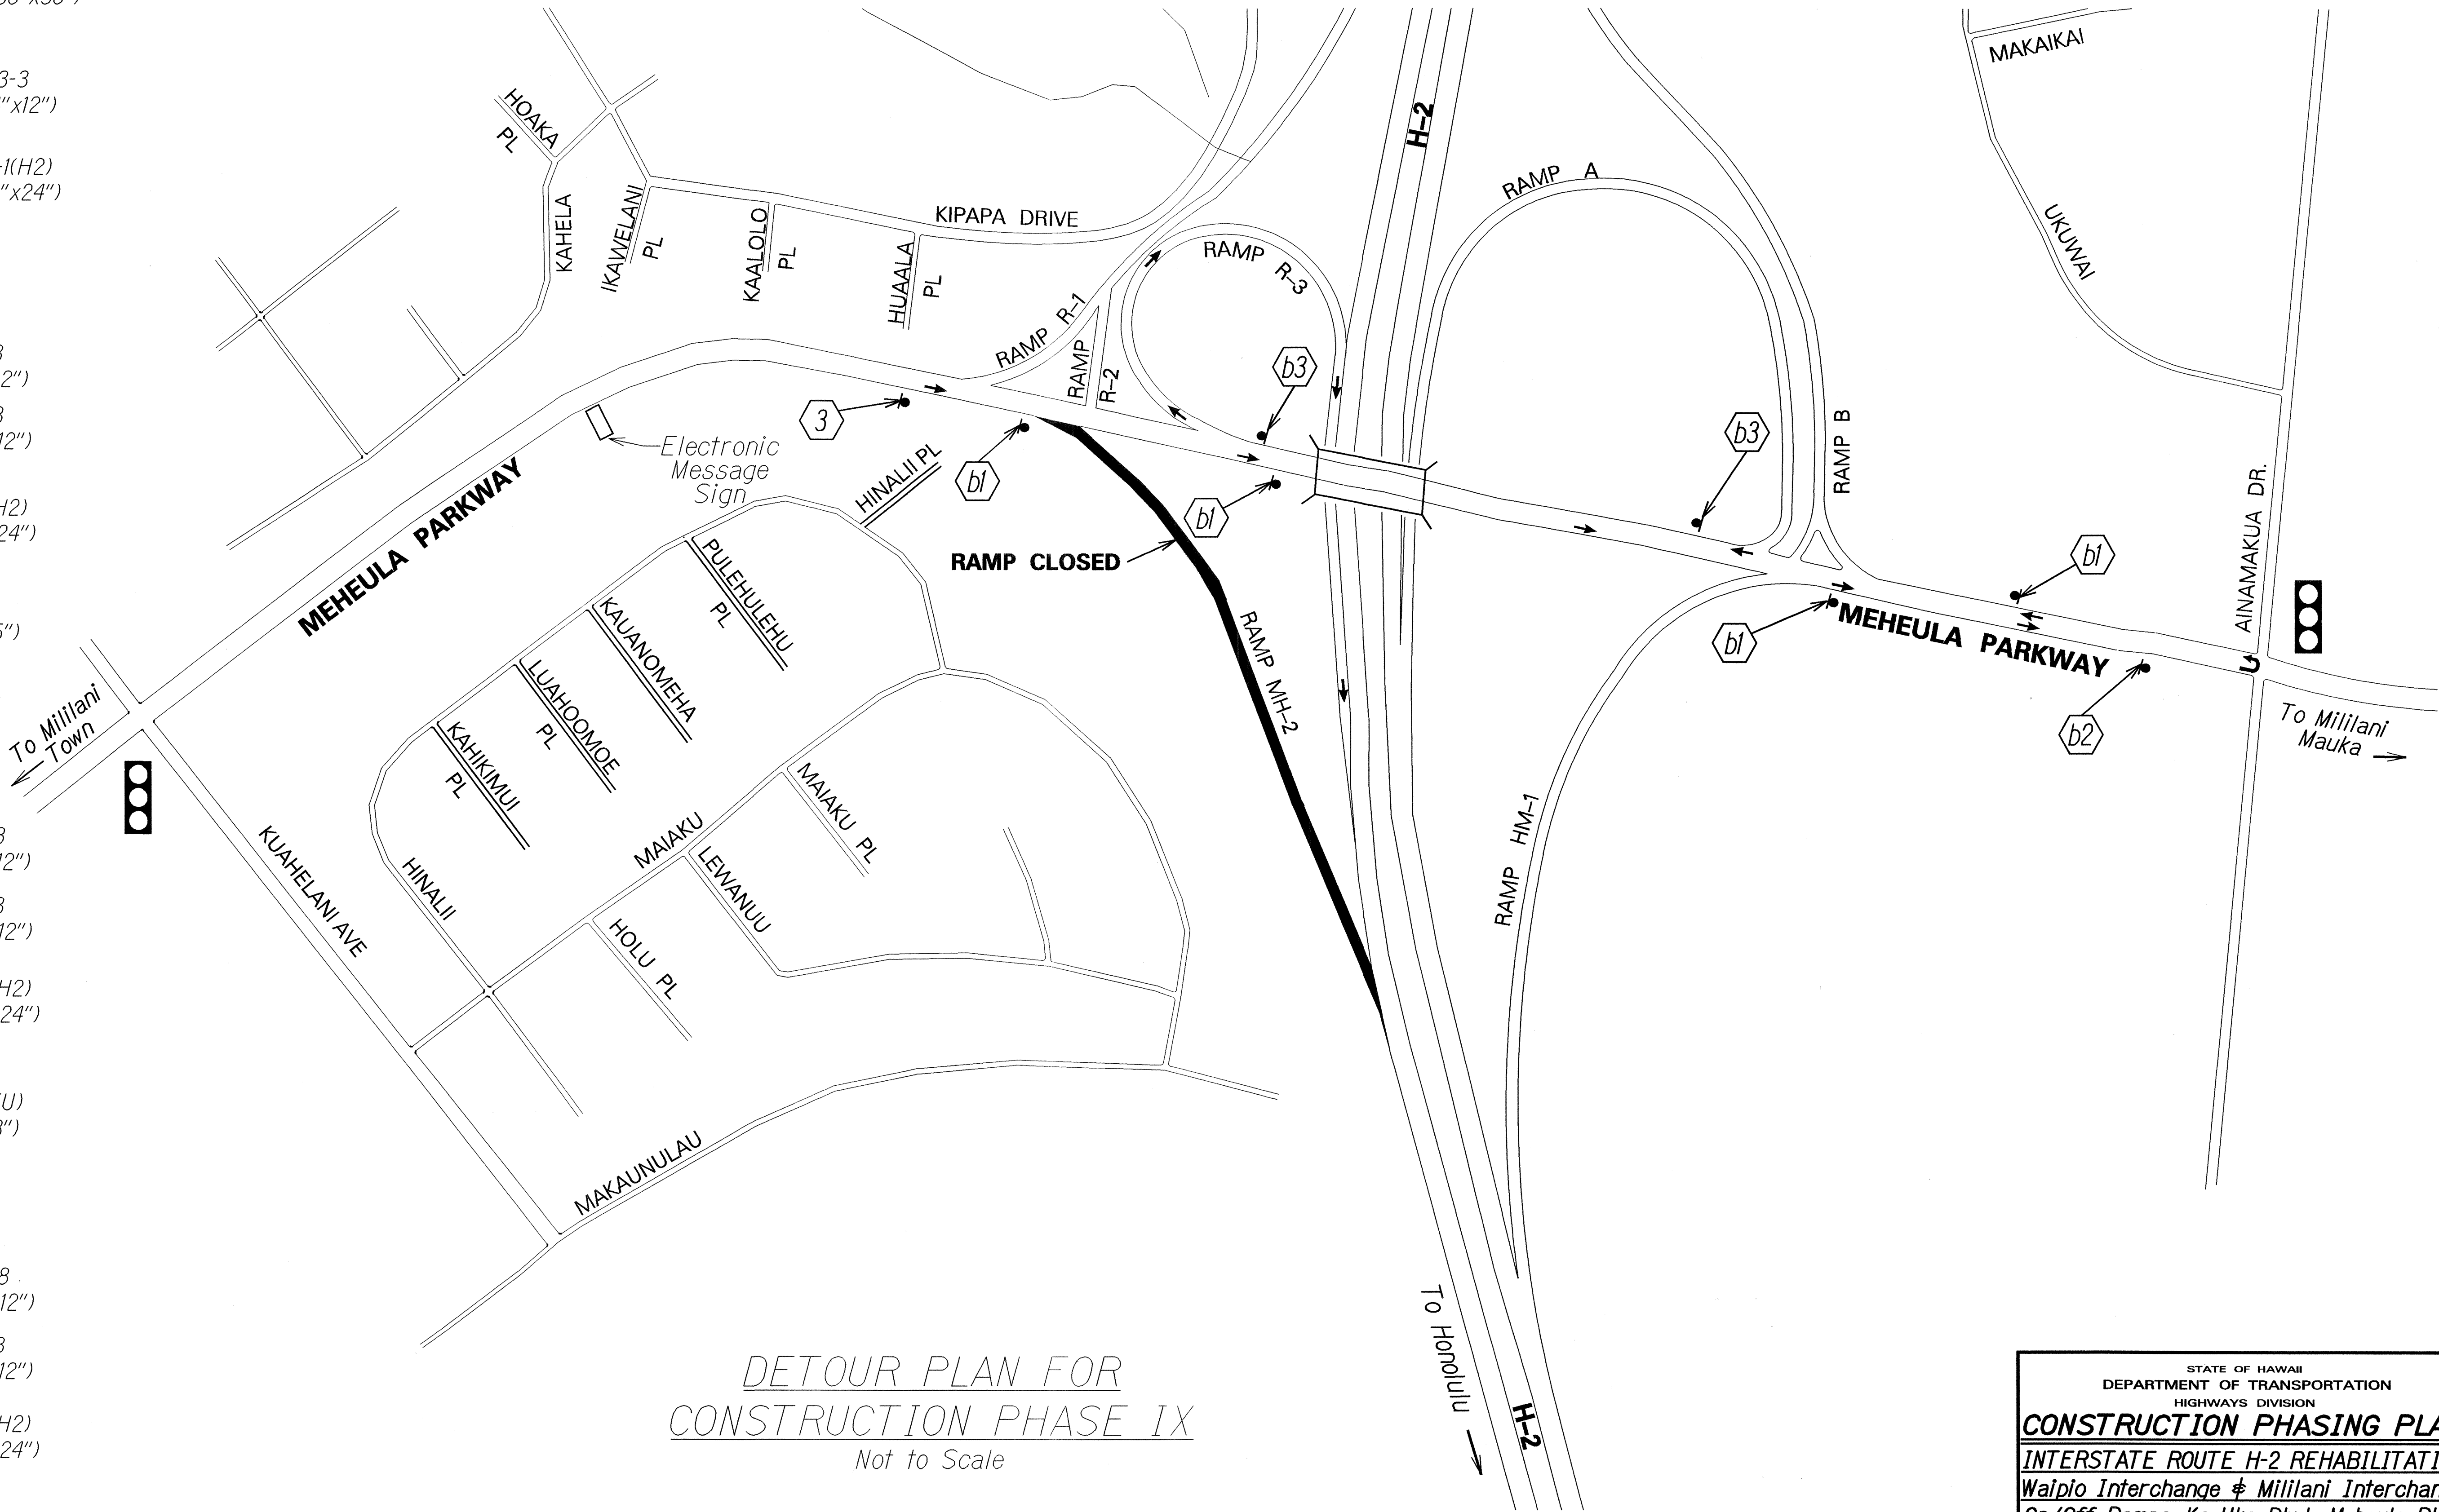

DETOUR PLAN FOR
 CONSTRUCTION PHASE IX
 Not to Scale

STATE OF HAWAII

DEPARTMENT OF TRANSPORTATION

HIGHWAYS DIVISION

CONSTRUCTION PHASING PLAN

INTERSTATE ROUTE H-2 REHABILITATION

Waipio Interchange & Mililani Interchange

On/Off Ramps, Ka Uka Blvd., Meheula Pkwy.

Overpass, & Kipapa Stream Bridge


Federal Aid Project No. IM-H2-1(33)

Not to Scale

Date: Dec. 2006

NOTE: Mililani Mauka Bound Lanes, H-2 Ramp MH-2 and H-2 Ramp R-2 Closed. See Detour Plan Sheet T26.

FED. ROAD DIST. NO.	STATE	FED. AID PROJ. NO.	FISCAL YEAR	SHEET NO.	TOTAL SHEETS
HAWAII	HAW.	1M-H2-1(33)	2007	ADD. 96	168

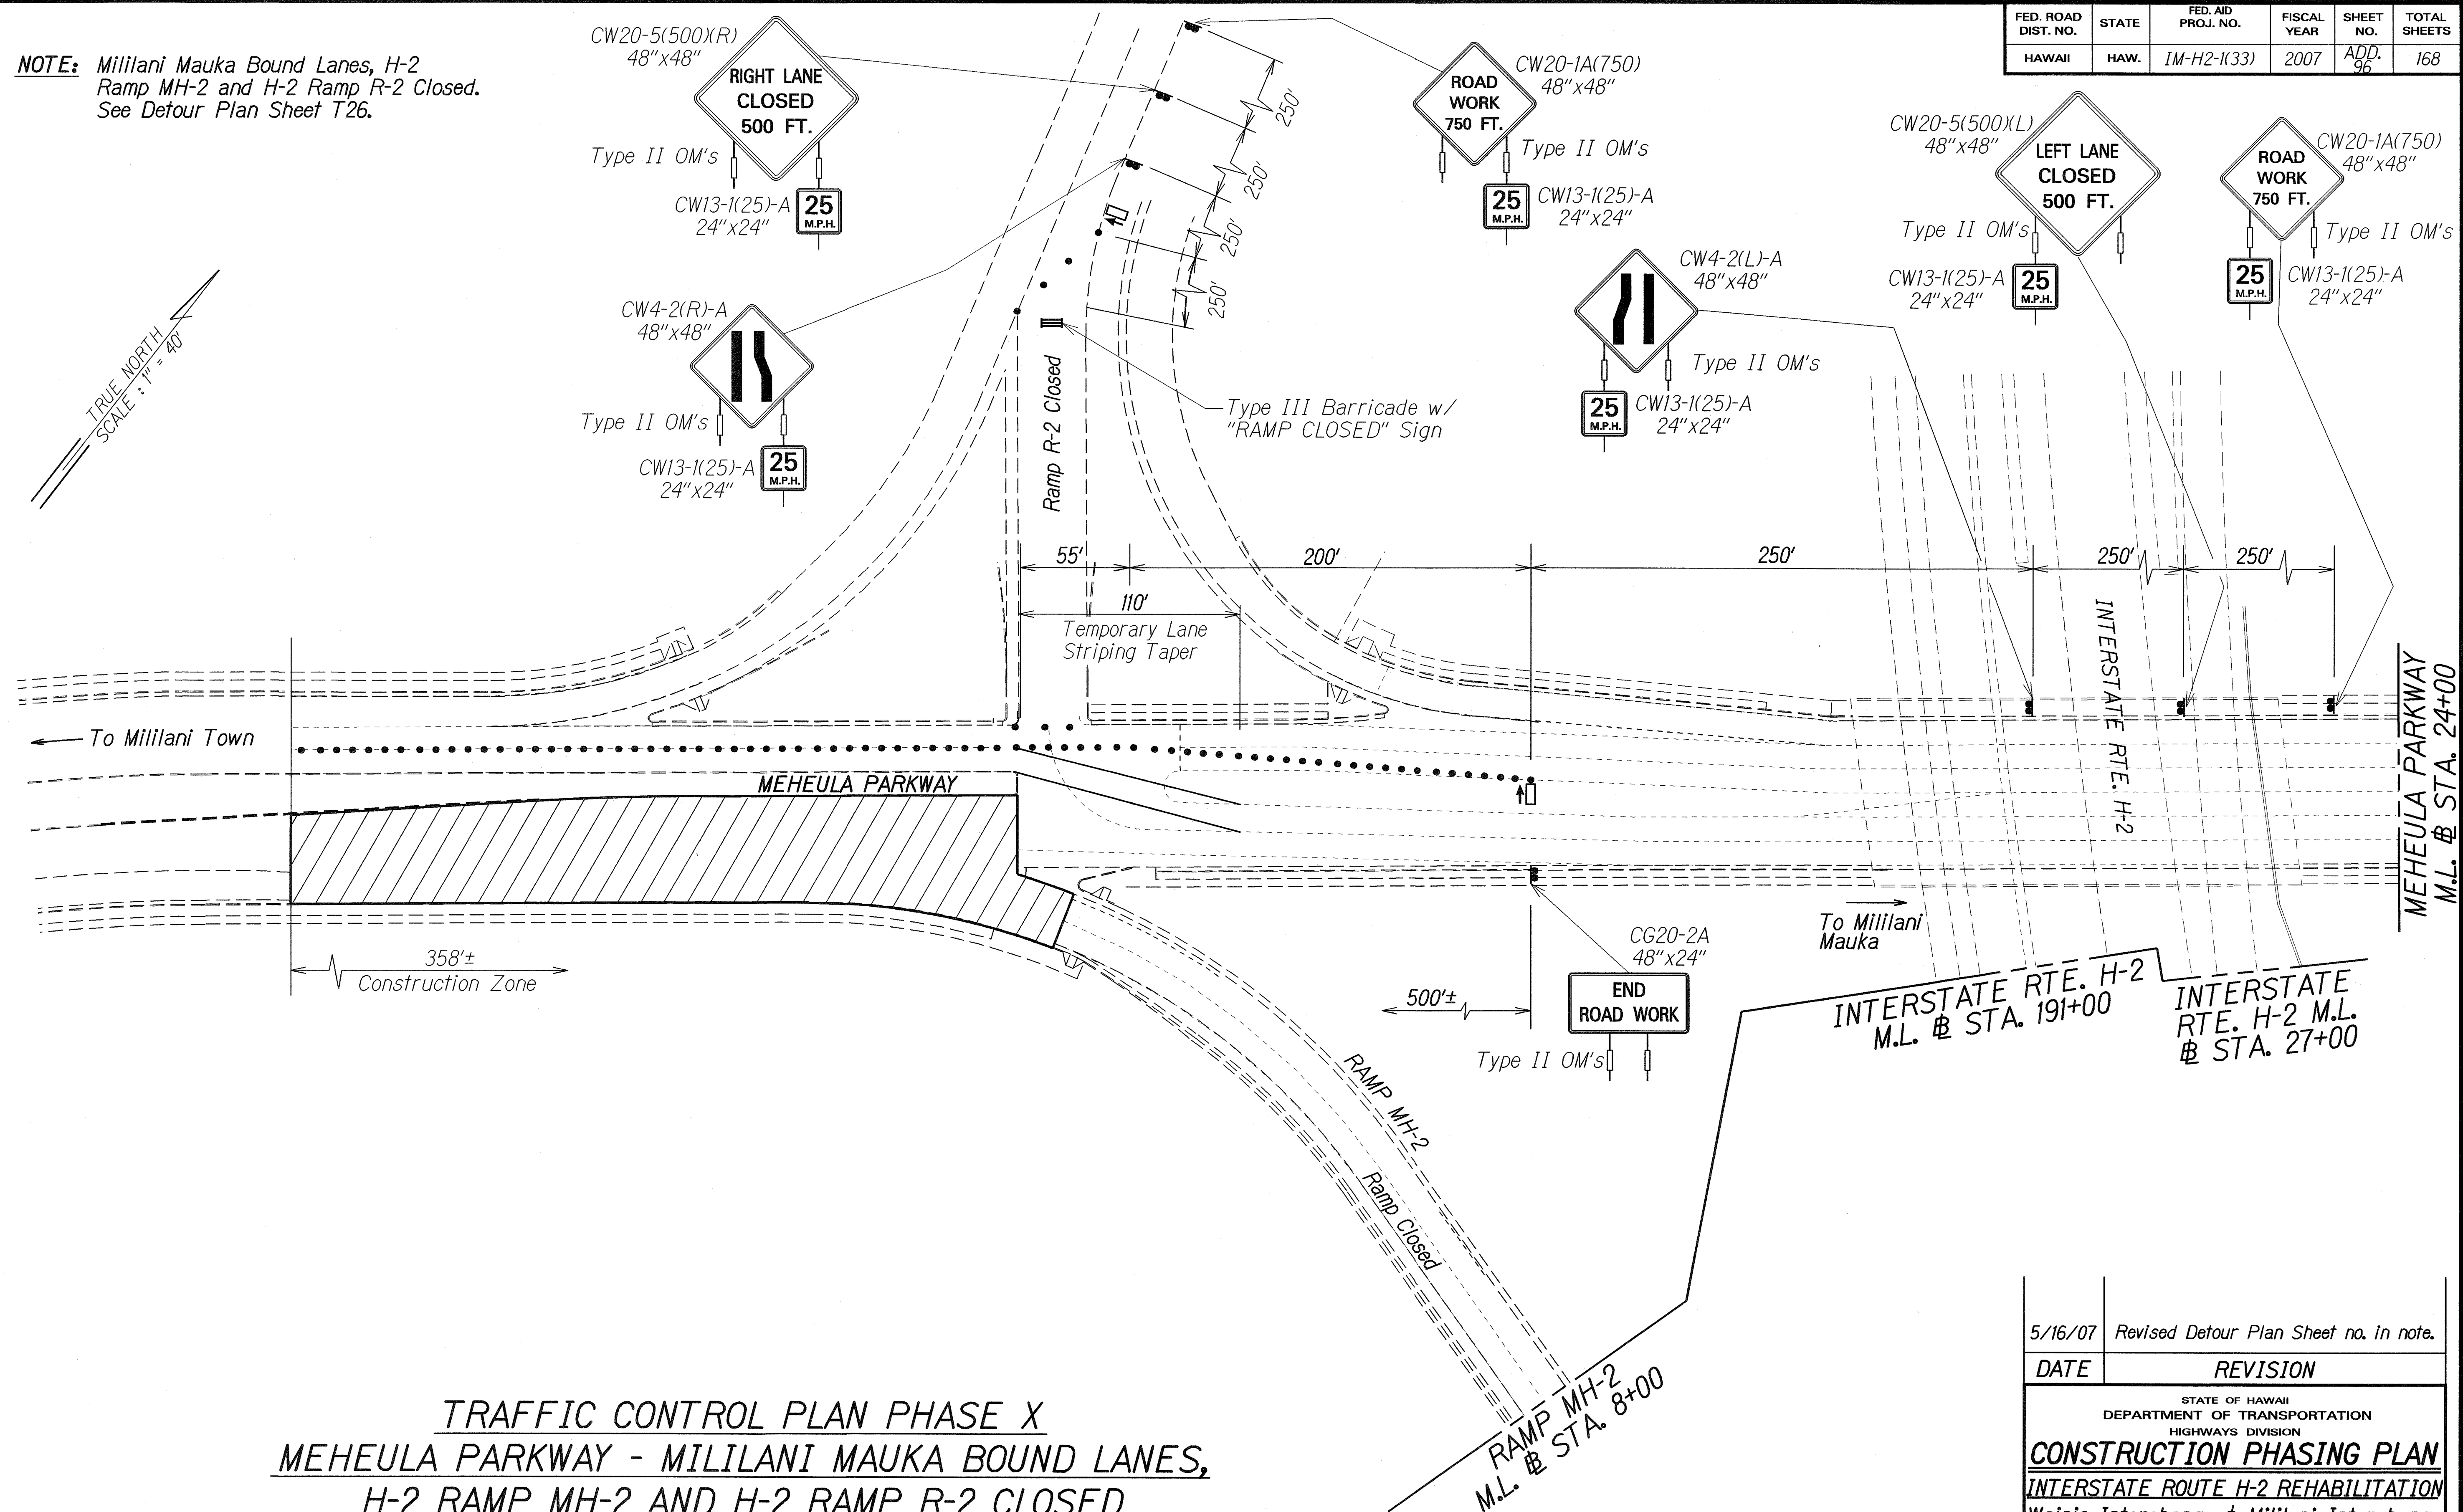


TRAFFIC CONTROL PLAN PHASE X
MEHEULA PARKWAY - MILILANI MAUKA BOUND LANES,
H-2 RAMP MH-2 AND H-2 RAMP R-2 CLOSED

(# Sta. 34+40.00 Rt. to # Sta. 30+82.00 Rt.)

SURVEY PLOTTED BY	DATE
DRAWN BY	
DESIGNED BY	
QUANTITIES BY	
CHECKED BY	

5/16/07	Revised Detour Plan Sheet no. in note.
DATE	REVISION
STATE OF HAWAII DEPARTMENT OF TRANSPORTATION HIGHWAYS DIVISION CONSTRUCTION PHASING PLAN INTERSTATE ROUTE H-2 REHABILITATION Waipio Interchange & Mililani Interchange On/Off Ramps, Ka Uka Blvd., Meheula Pkwy. Overpass, & Kipapa Stream Bridge Federal Aid Project No. 1M-H2-1(33) Scale: 1" = 40' Date: Dec. 2006	
SHEET No. T25 OF 63 SHEETS	

FED. ROAD DIST. NO.	STATE	FED. AID PROJ. NO.	FISCAL YEAR	SHEET NO.	TOTAL SHEETS
HAWAII	HAW.	IM-H2-1(33)	2007	ADD. 97	168

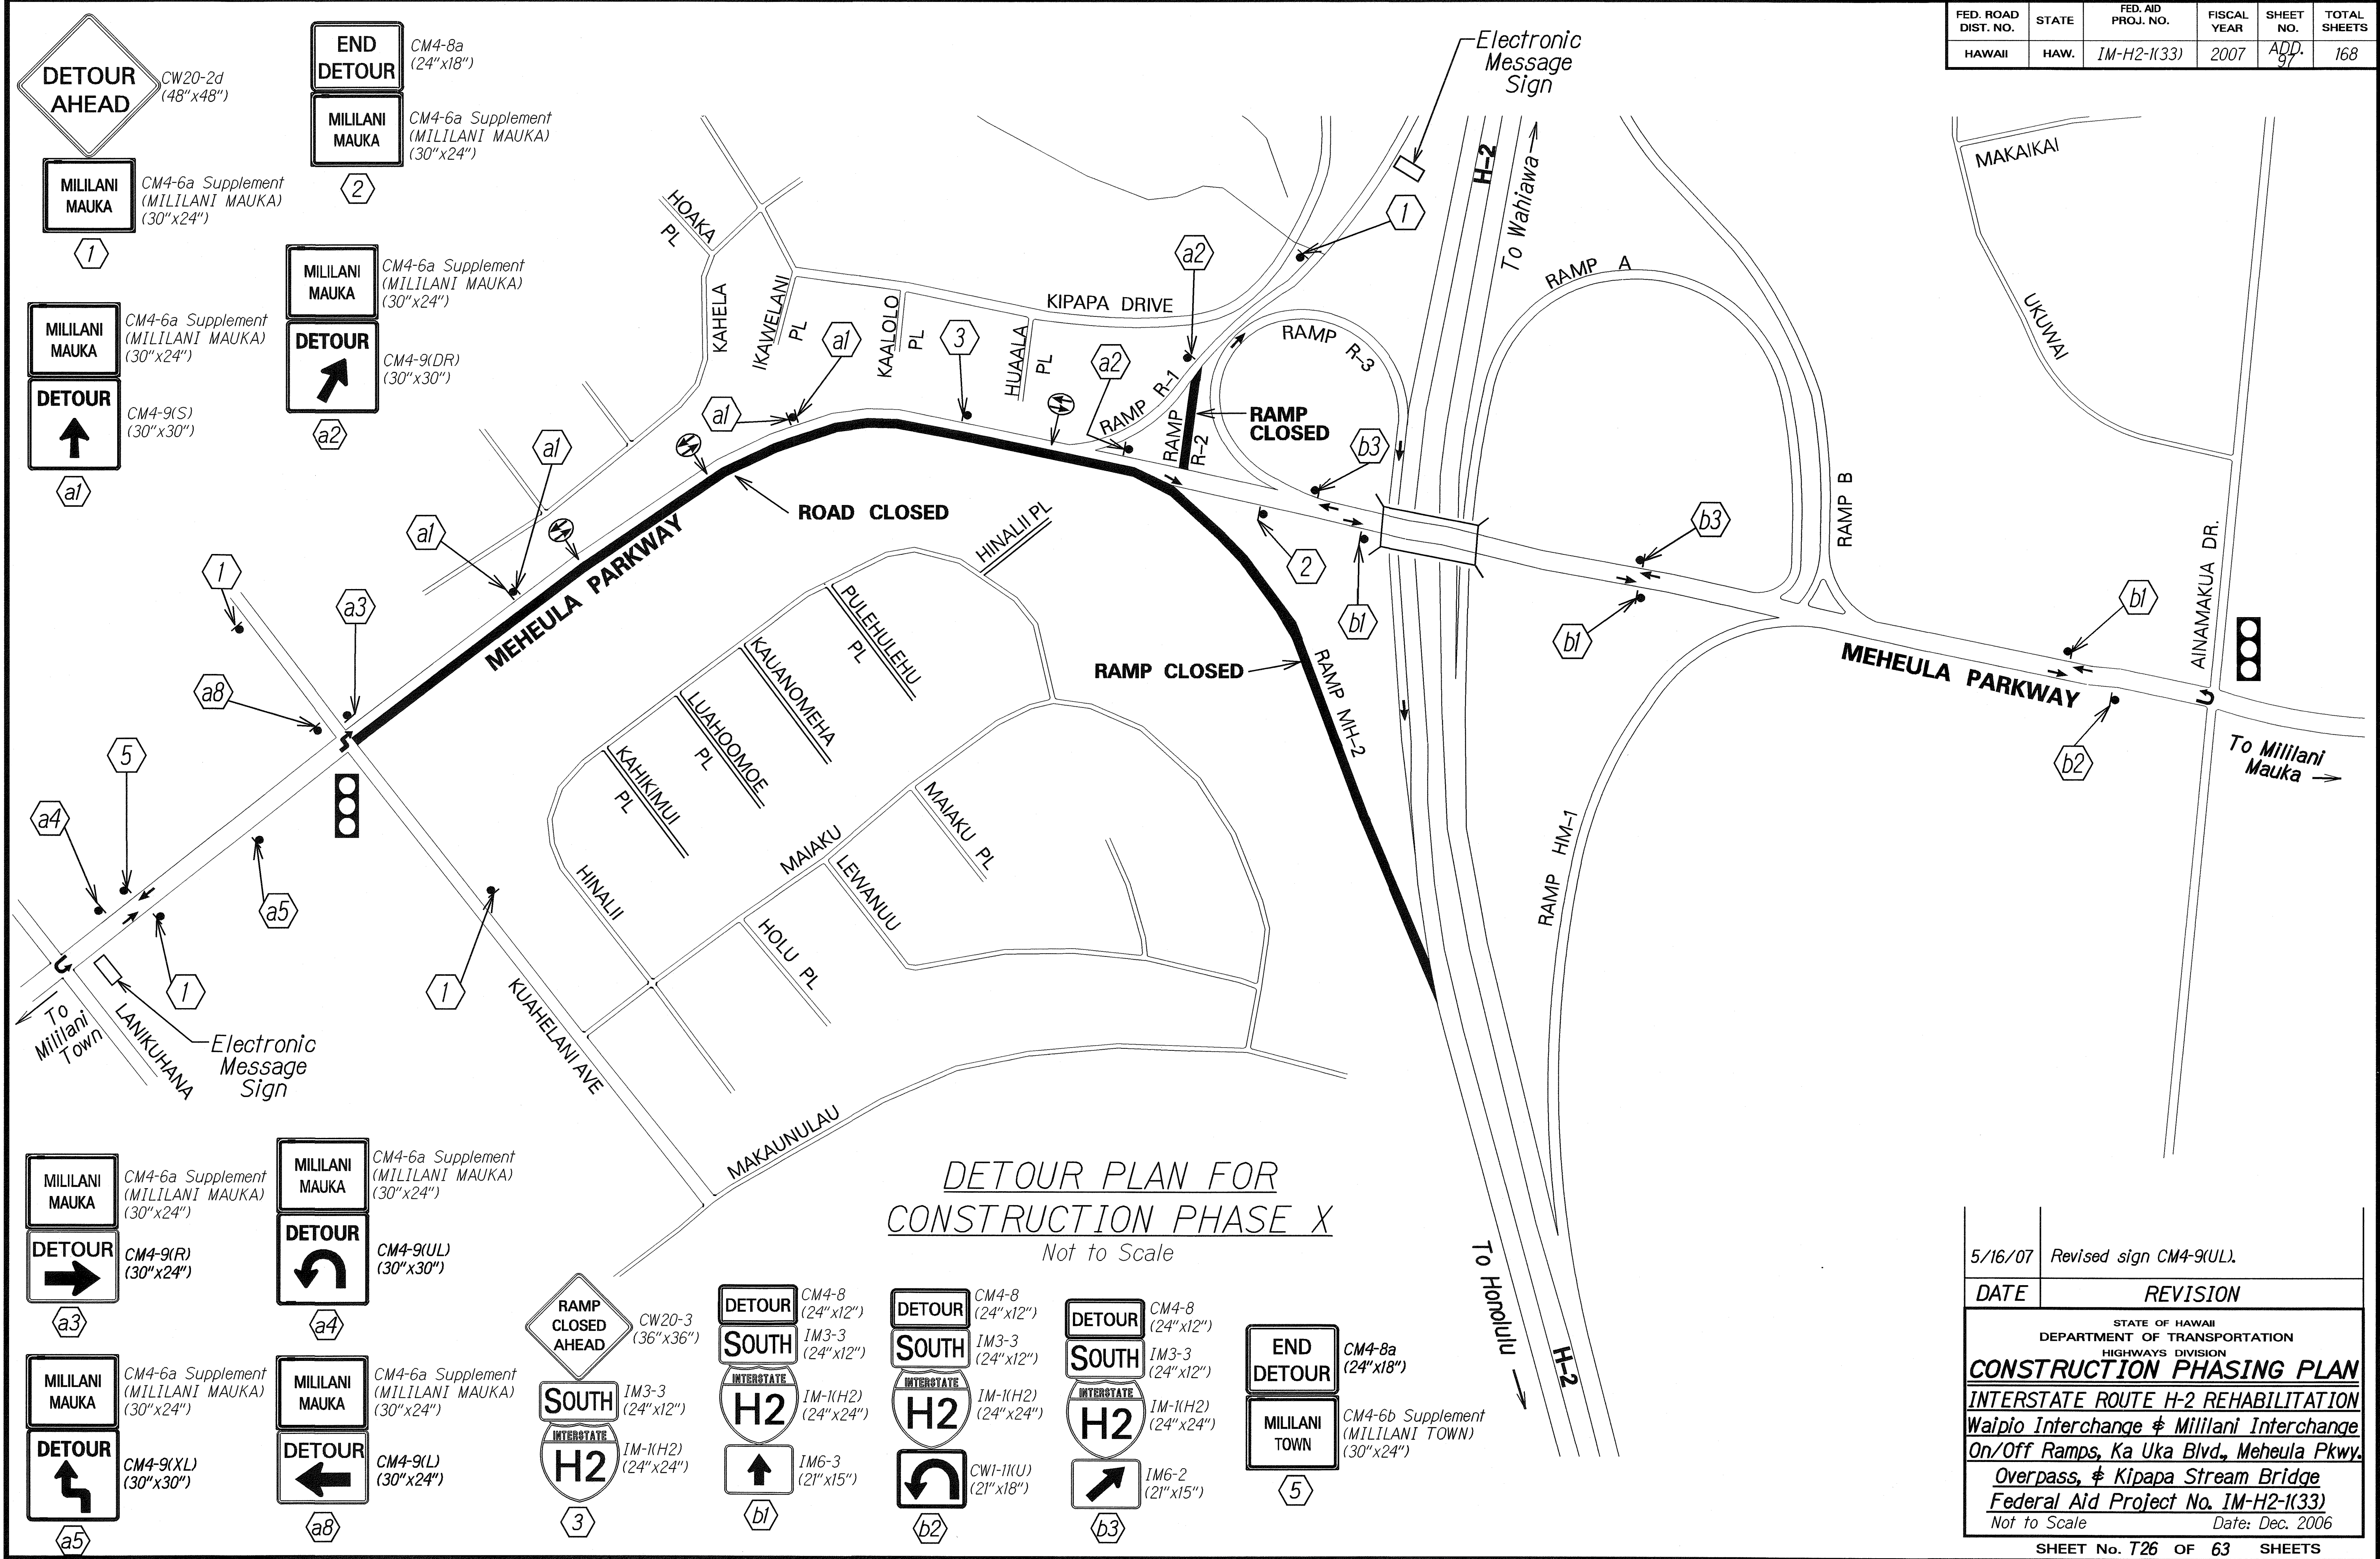

DETOUR PLAN FOR
CONSTRUCTION PHASE X
Not to Scale

5/16/07 Revised sign CM4-9(UL).

DATE REVISION


STATE OF HAWAII DEPARTMENT OF TRANSPORTATION HIGHWAYS DIVISION	
CONSTRUCTION PHASING PLAN	
INTERSTATE ROUTE H-2 REHABILITATION	
Waipio Interchange & Mililani Interchange	
On/Off Ramps, Ka Uka Blvd., Meheula Pkwy.	
Overpass, & Kipapa Stream Bridge	
Federal Aid Project No. IM-H2-1(33)	
Not to Scale	Date: Dec. 2006

SHEET No. T26 OF 63 SHEETS

ADD. 97

DATE	5/16/07
DESIGNED BY	...
CHECKED BY	...
APPROVED BY	...
ORIGINAL PLAN	...
NOTE BOOK	...
QUANTITIES BY	...
CHECKED BY	...

NOTE: Mililani Mauka Bound Lanes, H-2 Ramp MH-2 and H-2 Ramp R-2 Closed. See Detour Plan Sheet T28.

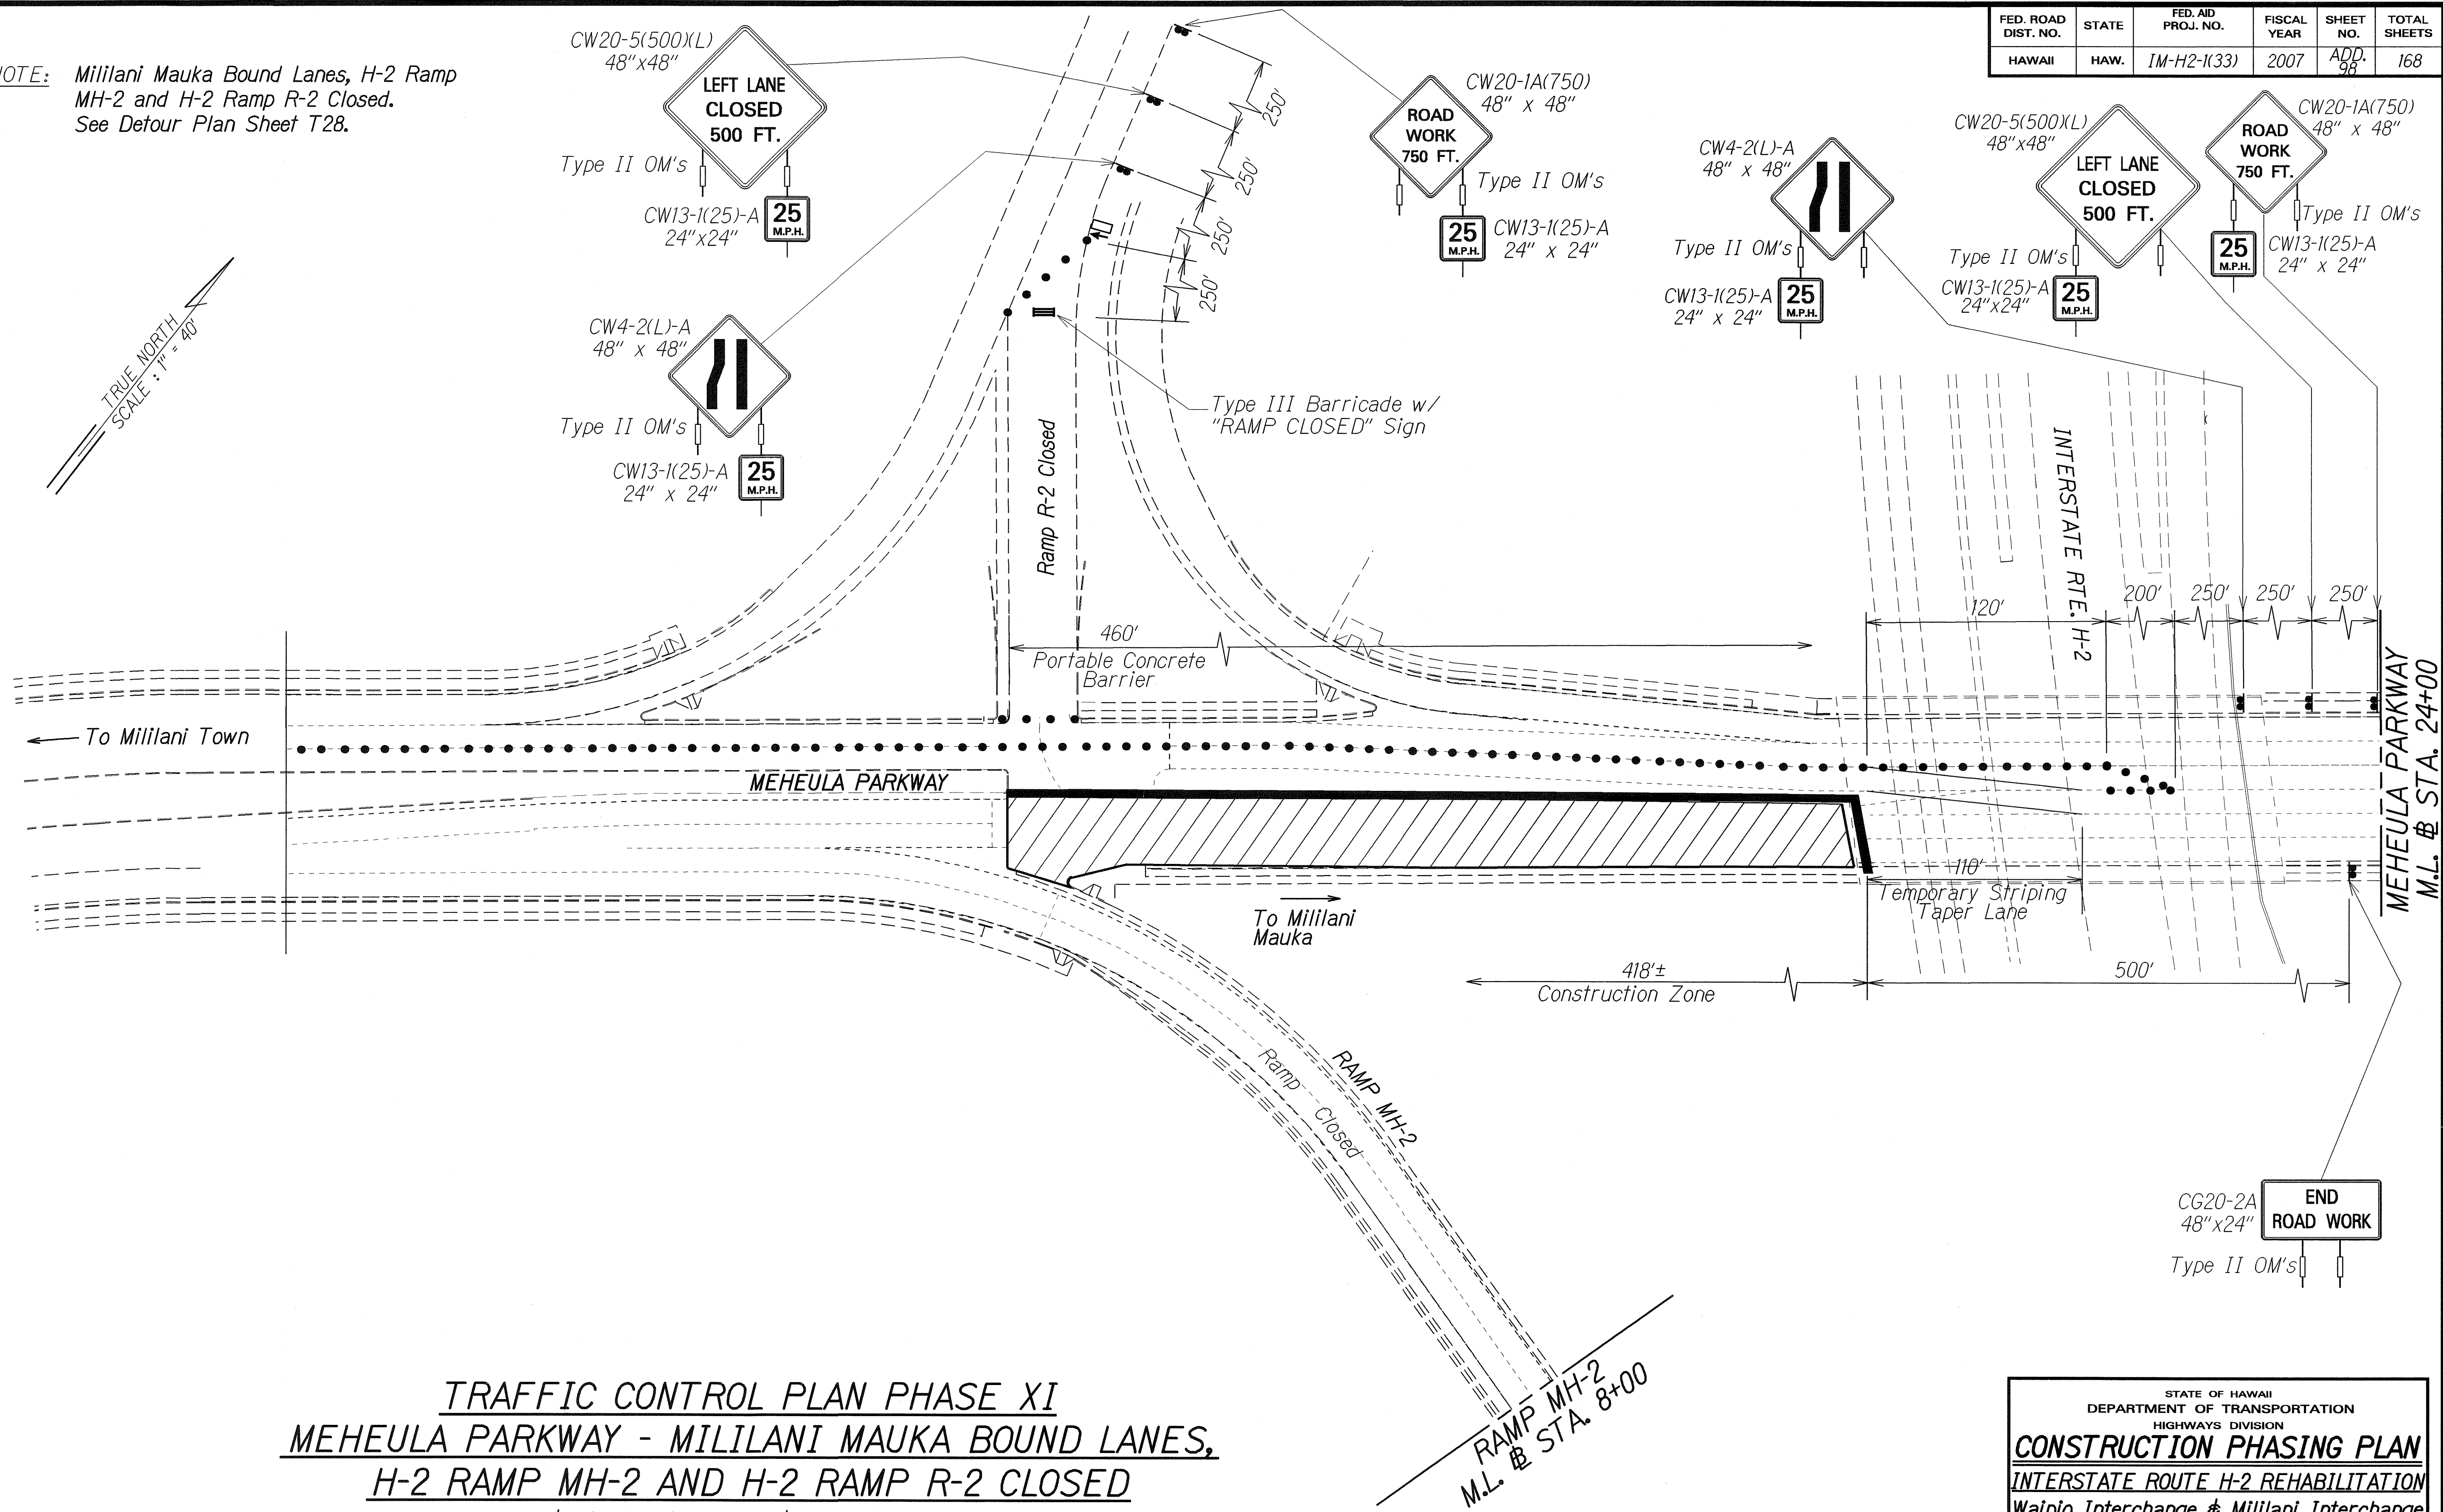

TRAFFIC CONTROL PLAN PHASE XI
MEHEULA PARKWAY - MILILANI MAUKA BOUND LANES,
H-2 RAMP MH-2 AND H-2 RAMP R-2 CLOSED
 (# Sta. 30+82.00 Rt. to # Sta. 26+64.00 Rt.)

FED. ROAD DIST. NO.	STATE	FED. AID PROJ. NO.	FISCAL YEAR	SHEET NO.	TOTAL SHEETS
HAWAII	HAW.	IM-H2-1(33)	2007	ADD. 98	168


STATE OF HAWAII
DEPARTMENT OF TRANSPORTATION
HIGHWAYS DIVISION

CONSTRUCTION PHASING PLAN
INTERSTATE ROUTE H-2 REHABILITATION
Waipio Interchange & Mililani Interchange
On/Off Ramps, Ka Uka Blvd., Meheula Pkwy.
Overpass, & Kipapa Stream Bridge
Federal Aid Project No. IM-H2-1(33)
Scale: 1" = 40' Date: Dec. 2006

5/16/07	Revised Detour Plan Sheet no. in note.
DATE	REVISION


SURVEY PLOTTED BY	DATE
DRAWN BY	
DESIGNED BY	
QUANTITIES BY	
CHECKED BY	

FED. ROAD DIST. NO.	STATE	FED. AID PROJ. NO.	FISCAL YEAR	SHEET NO.	TOTAL SHEETS
HAWAII	HAW.	IM-H2-1(33)	2007	99	168

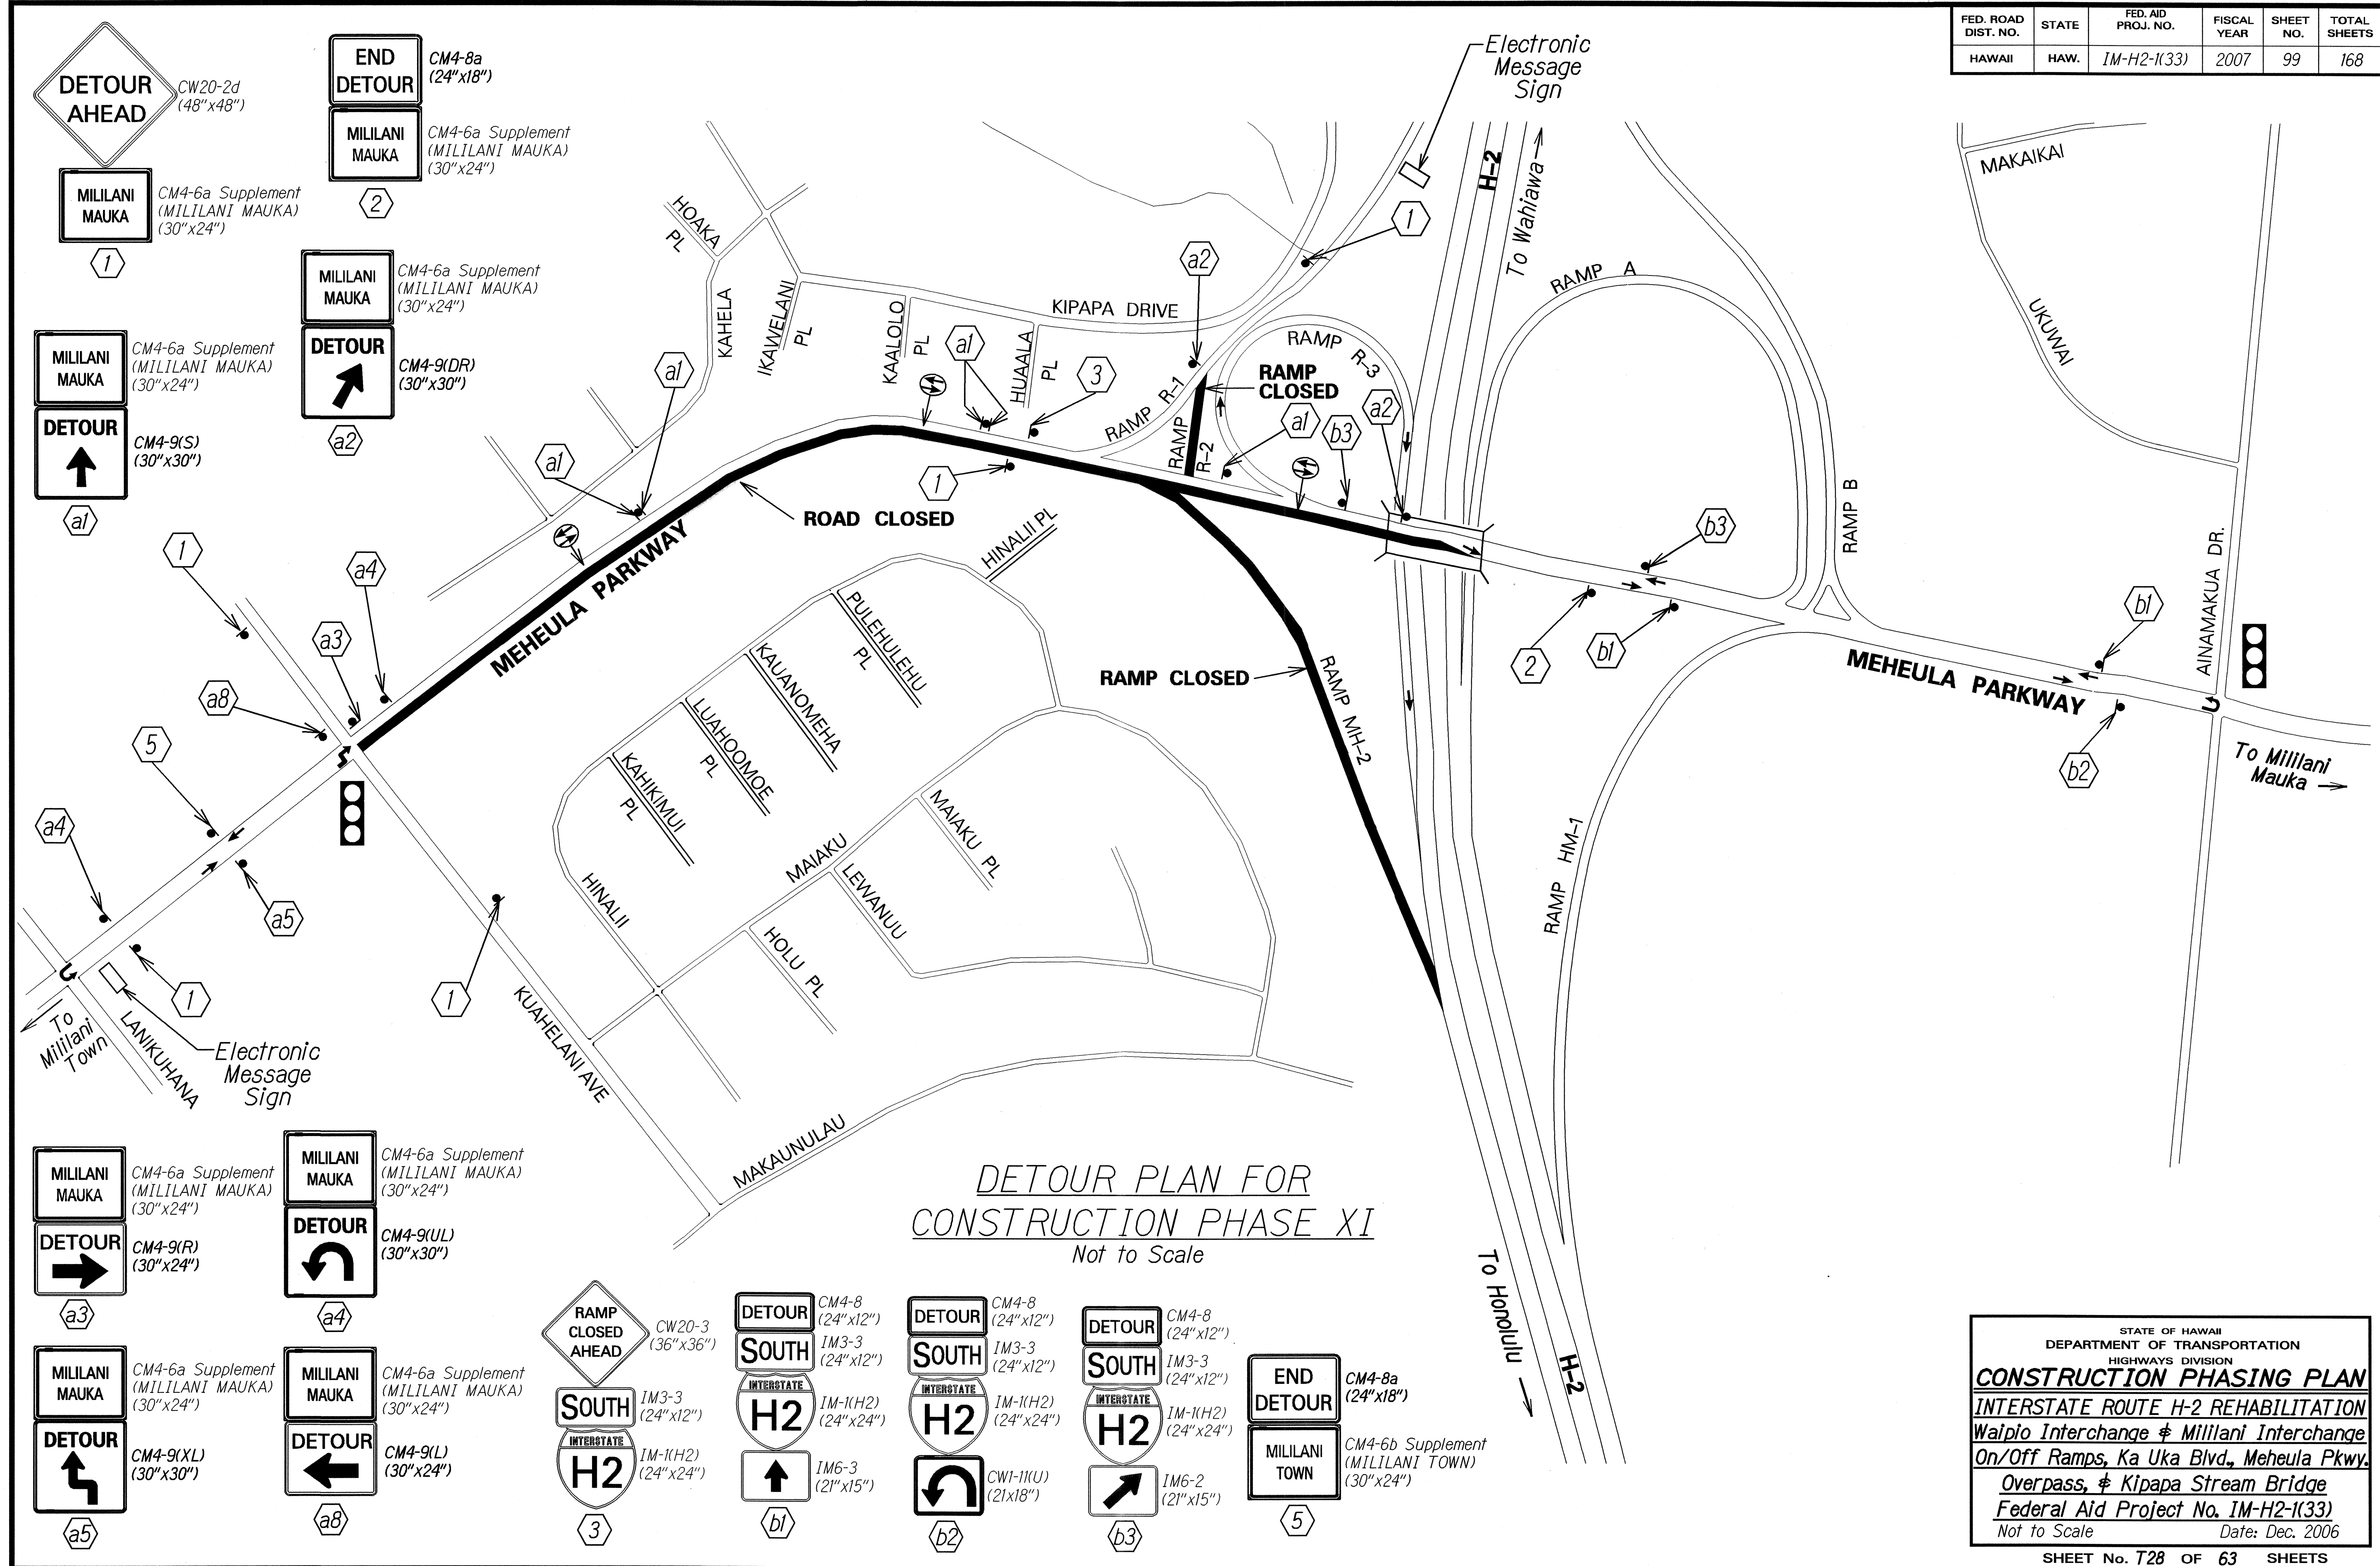

FED. ROAD DIST. NO.	STATE	FED. AID PROJ. NO.	FISCAL YEAR	SHEET NO.	TOTAL SHEETS
HAWAII	HAW.	1M-H2-1(33)	2007	ADD. 100	168

NOTE: Mililani Town Bound Lanes, H-2 Ramp R-2 and H-2 Ramp R-3 Closed. See Detour Plan Sheet T31.

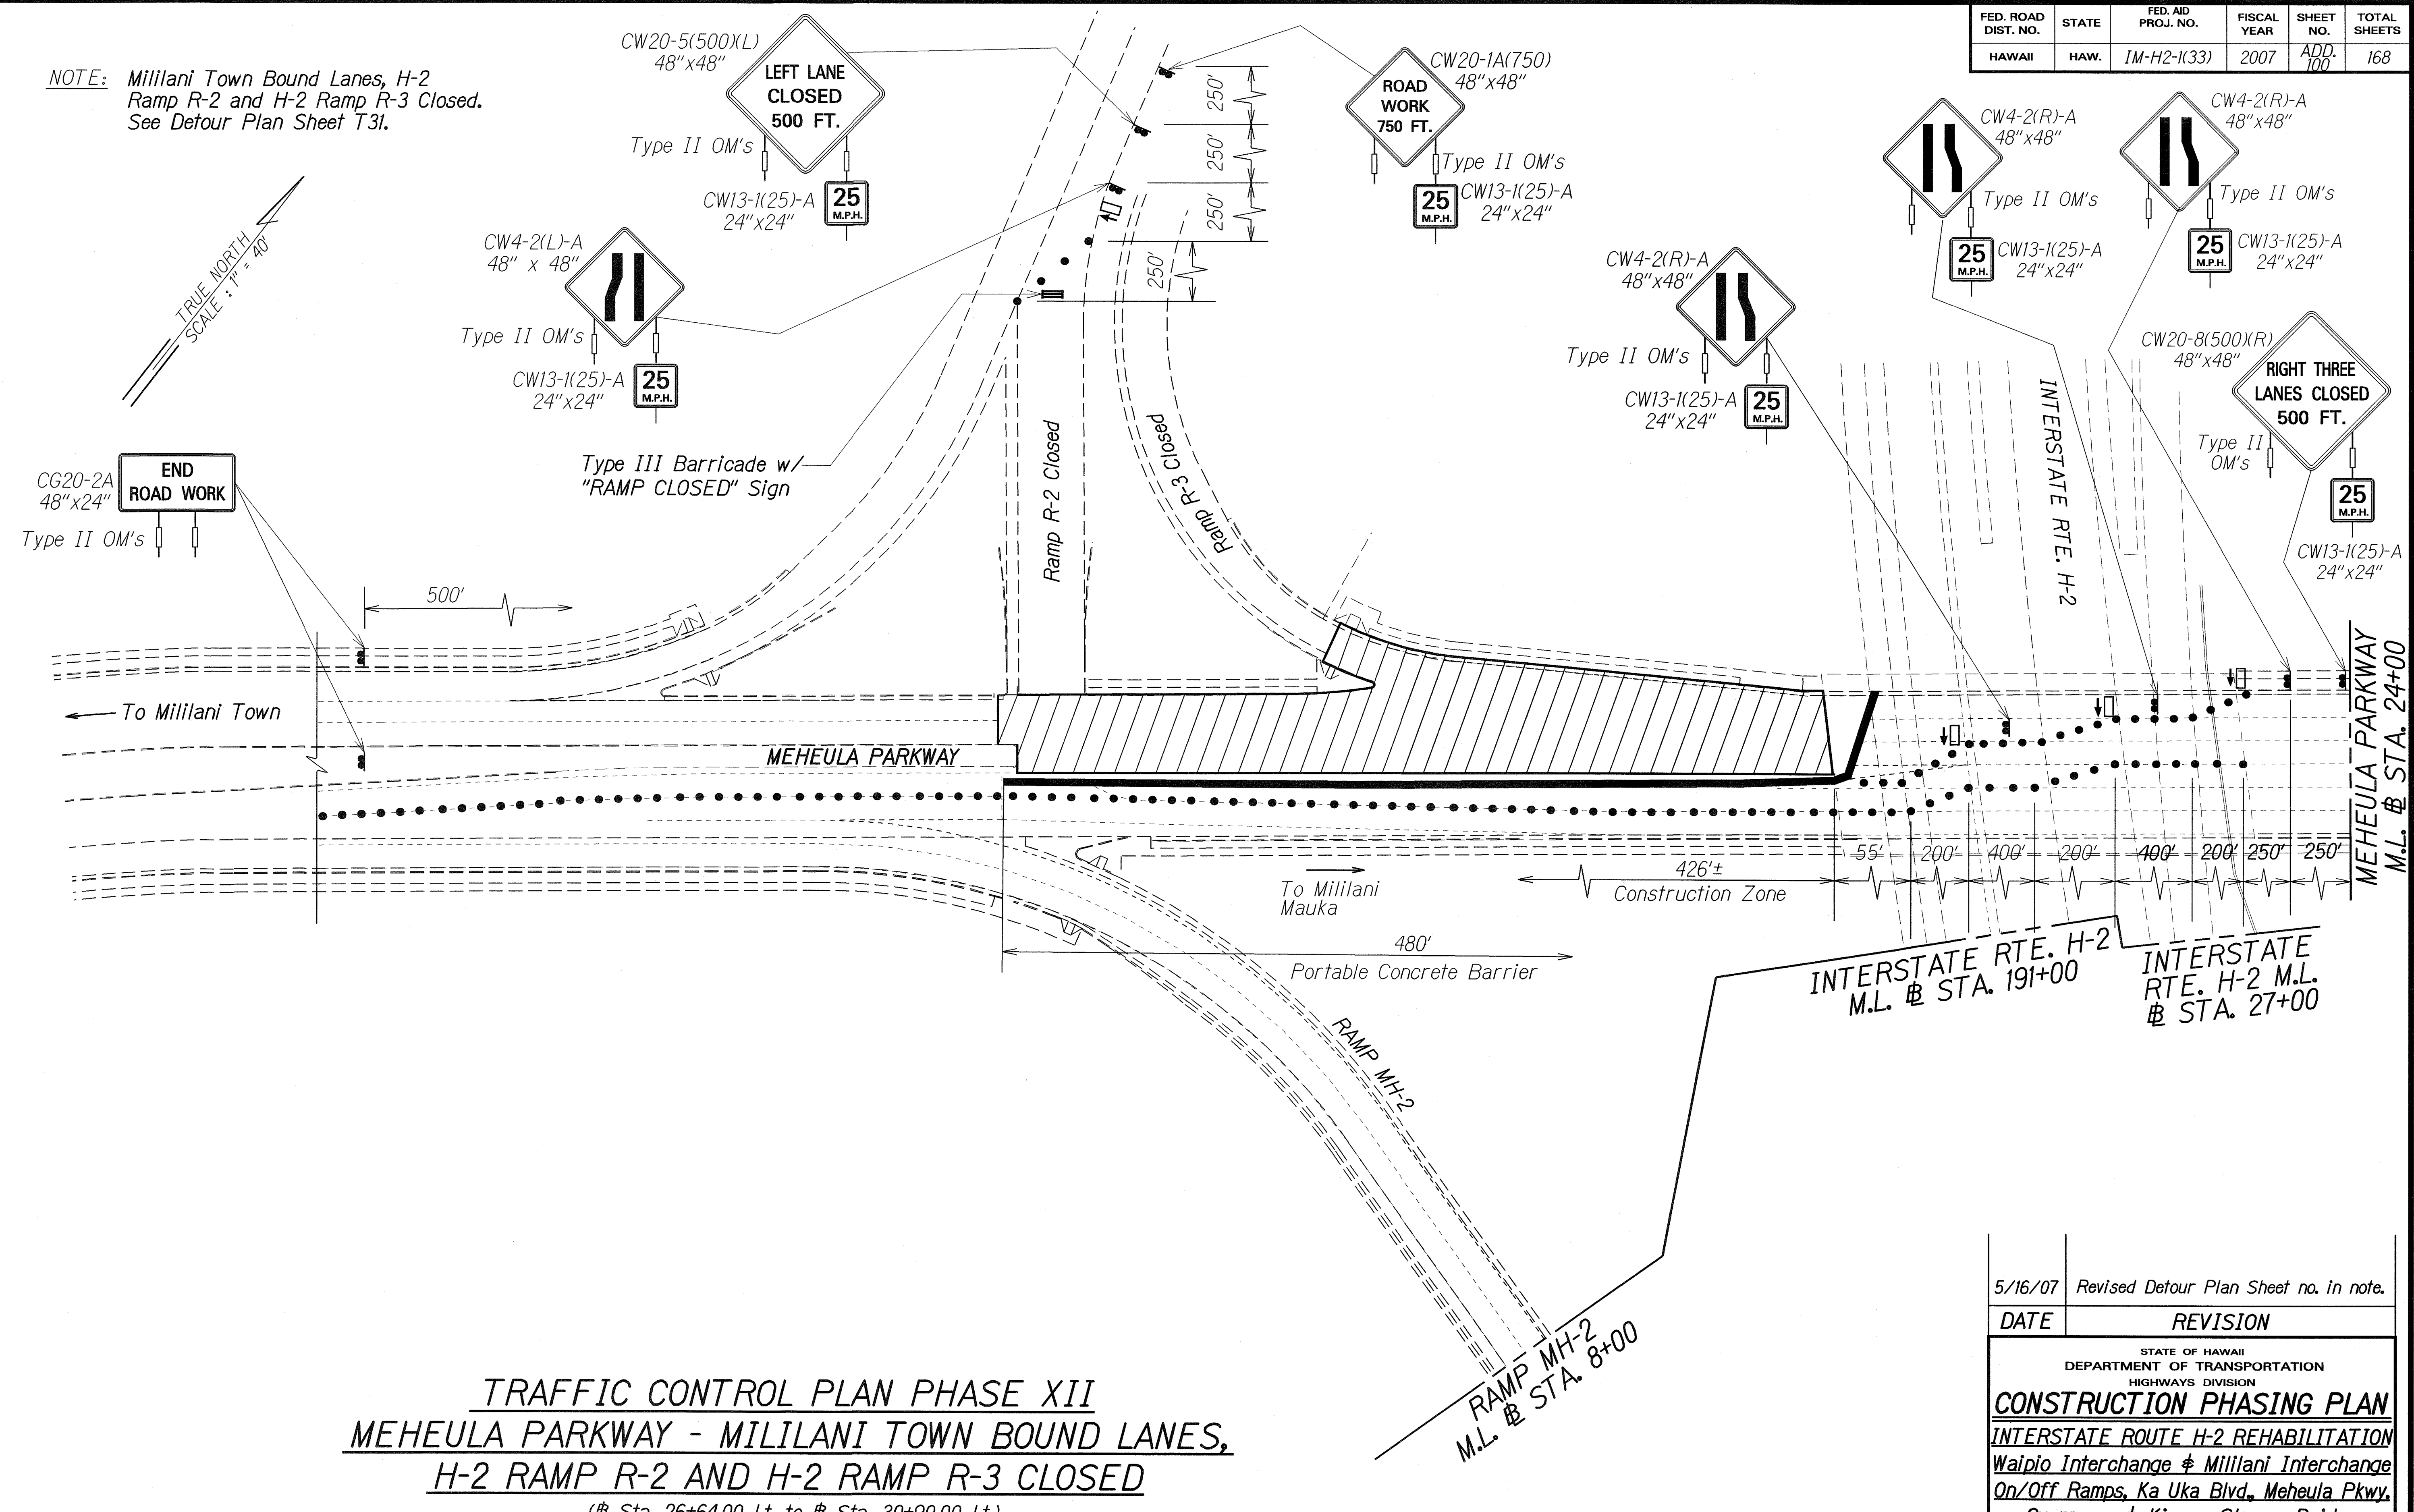


TRAFFIC CONTROL PLAN PHASE XII
MEHEULA PARKWAY - MILILANI TOWN BOUND LANES,
H-2 RAMP R-2 AND H-2 RAMP R-3 CLOSED
 (Sta. 26+64.00 Lt. to Sta. 30+90.00 Lt.)

SURVEY PLANNED BY	DATE
DESIGNED BY	
DRAWN BY	
CHECKED BY	
NOTED BY	
QUANTITIES BY	
CHECKED BY	

5/16/07	Revised Detour Plan Sheet no. in note.
DATE	REVISION
STATE OF HAWAII DEPARTMENT OF TRANSPORTATION HIGHWAYS DIVISION	
CONSTRUCTION PHASING PLAN	
INTERSTATE ROUTE H-2 REHABILITATION	
Waipio Interchange & Mililani Interchange	
On/Off Ramps, Ka Uka Blvd., Meheula Pkwy.	
Overpass, & Kipapa Stream Bridge	
Federal Aid Project No. 1M-H2-1(33)	
Scale: 1" = 40'	Date: Dec. 2006
SHEET No. T29 OF 63 SHEETS	

FED. ROAD DIST. NO.	STATE	FED. AID PROJ. NO.	FISCAL YEAR	SHEET NO.	TOTAL SHEETS
HAWAII	HAW.	IM-H2-1(33)	2006	ADD. 101	100

NOTES: Mililani Town Bound Lanes, H-2 Ramp R-2 and H-2 Ramp R-3 Closed. See Detour Plan Sheet T31.

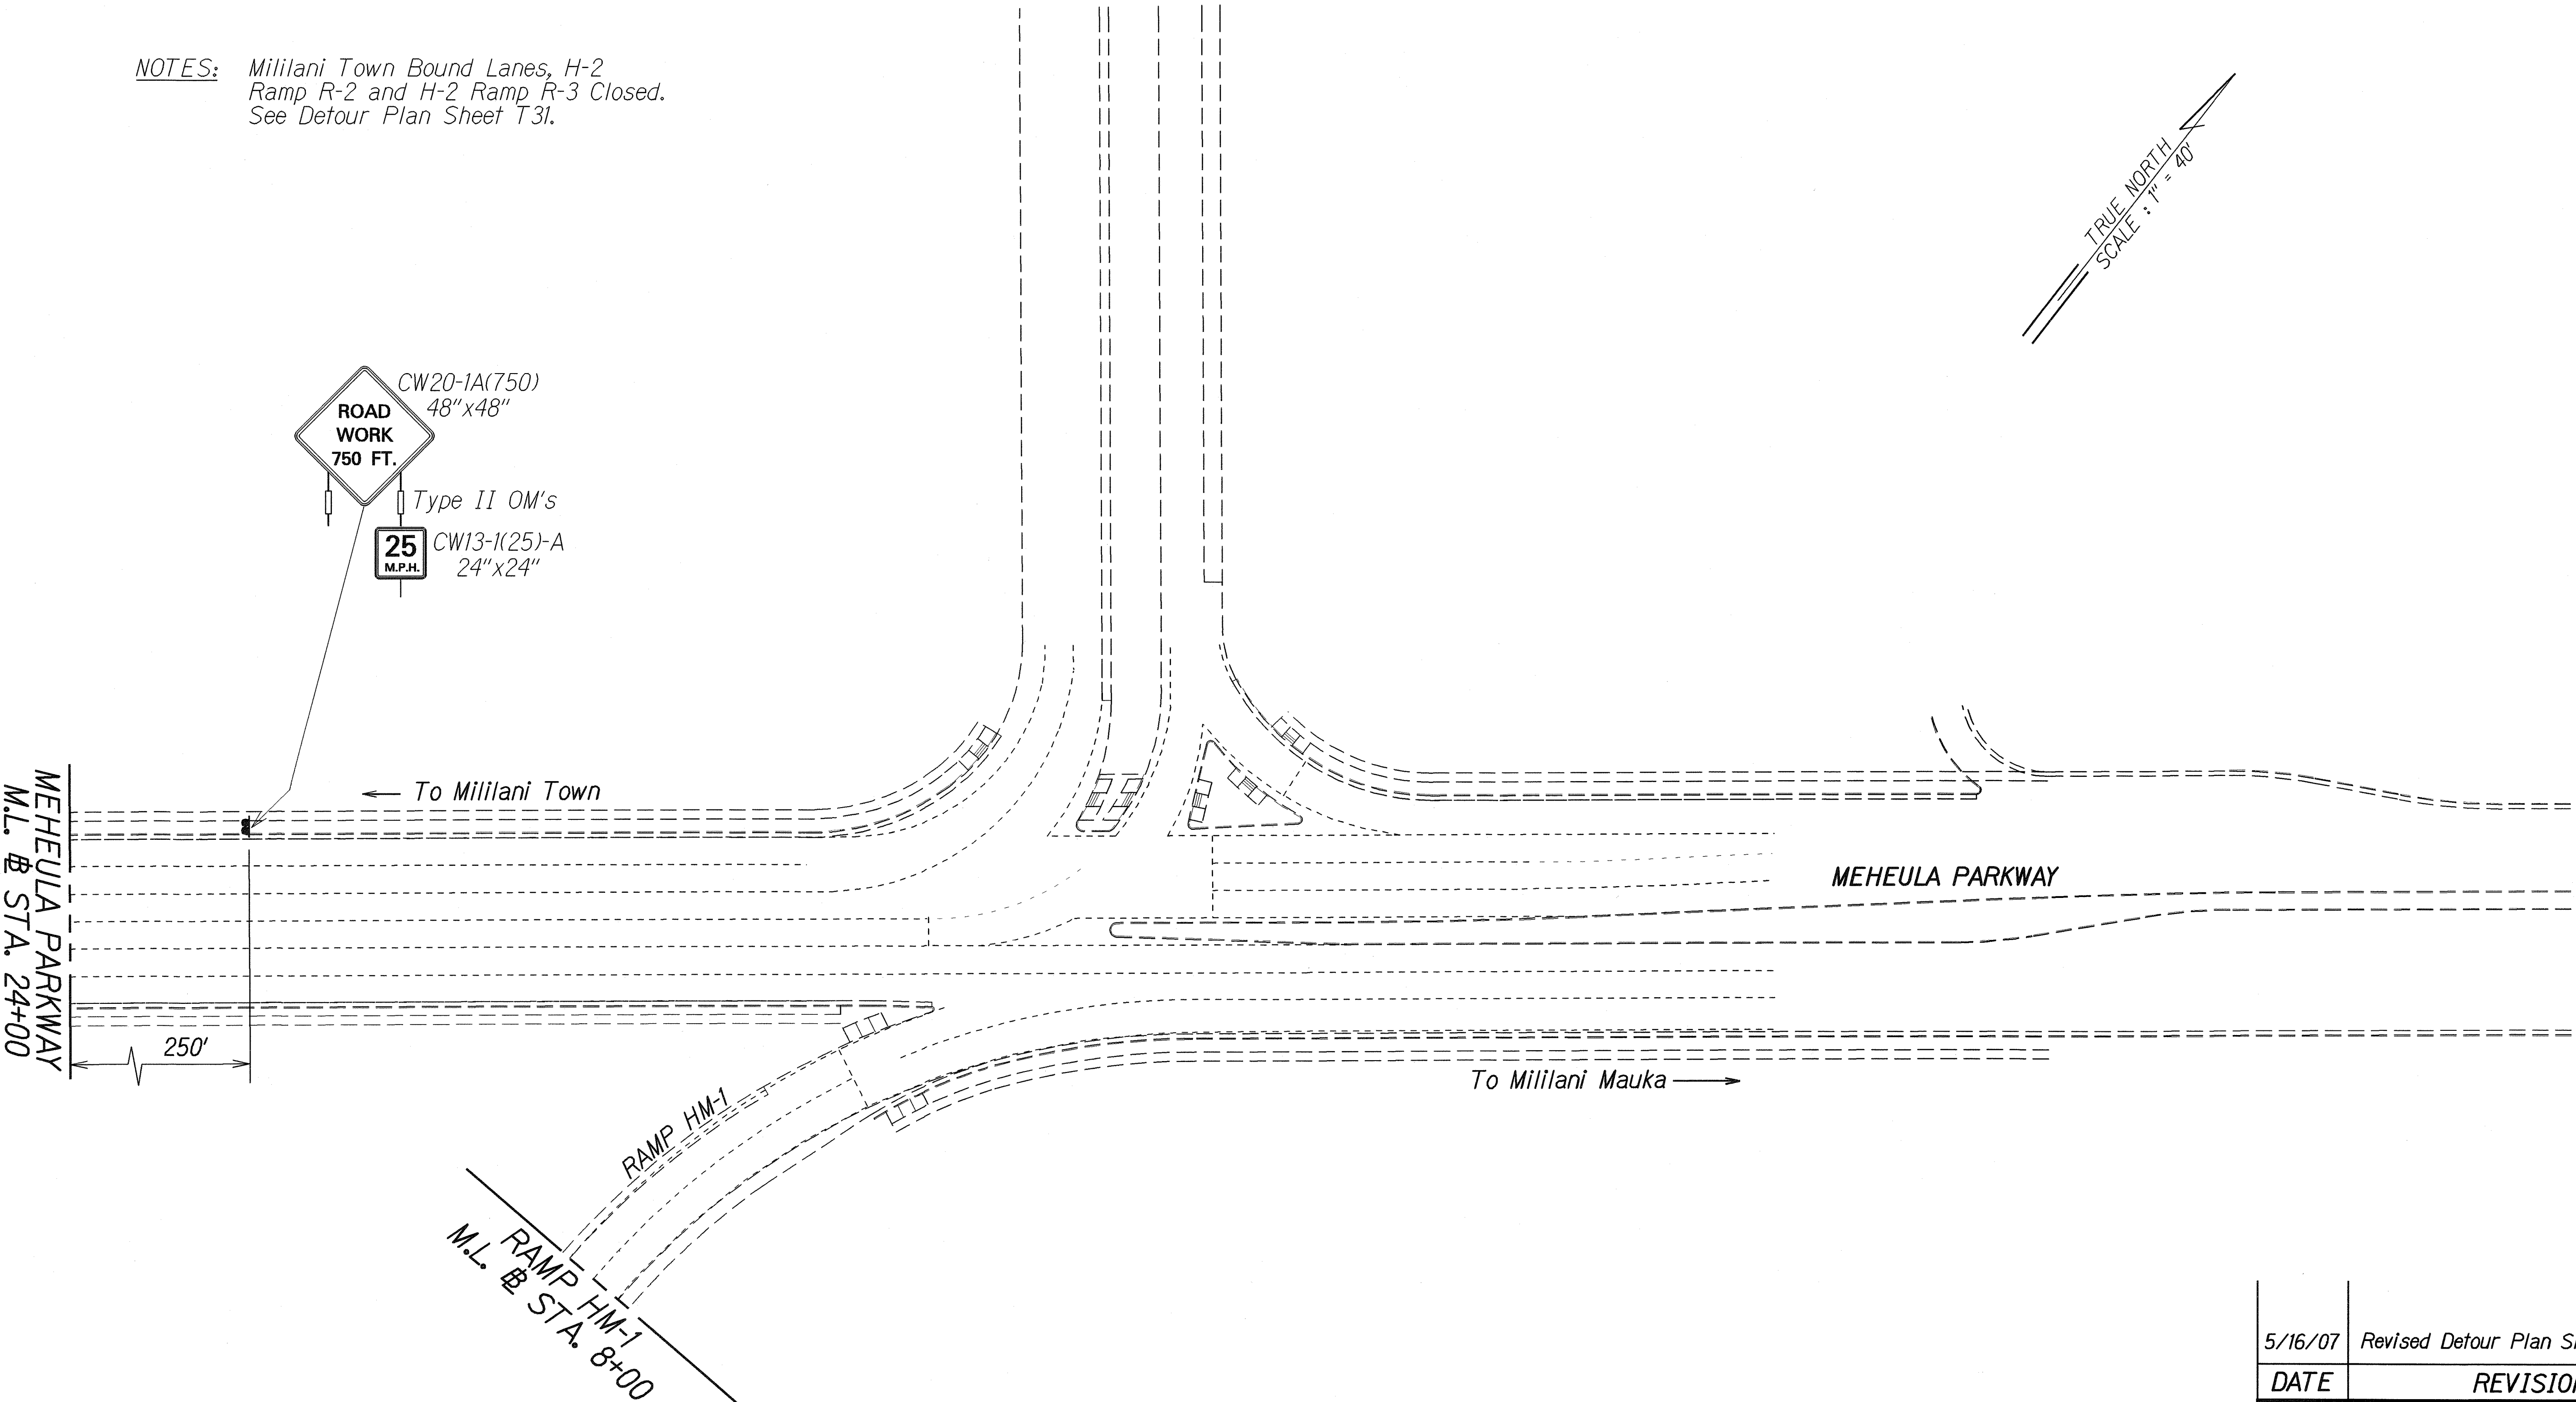

TRAFFIC CONTROL PLAN PHASE XII
 MEHEULA PARKWAY - MILILANI TOWN BOUND LANES,
 H-2 RAMP R-2 AND H-2 RAMP R-3 CLOSED
 (Sta. 26+64.00 Lt. to Sta. 30+90.00 Lt.)

5/16/07 Revised Detour Plan Sheet no. In note.


DATE REVISION

STATE OF HAWAII
 DEPARTMENT OF TRANSPORTATION
 HIGHWAYS DIVISION
CONSTRUCTION PHASING PLAN
 INTERSTATE ROUTE H-2 REHABILITATION
 Waipio Interchange & Mililani Interchange
 On/Off Ramps, Ka Uka Blvd., Meheula Pkwy.
 Overpass, & Kipapa Stream Bridge
 Federal Aid Project No. IM-H2-1(33)
 Scale: 1" = 40' Date: Dec. 2006


SHEET No. T30 OF 63 SHEETS

ADD. 101

GENERAL PLAN	DATE
DESIGNED BY	5/16/07
DRAWN BY	
CHECKED BY	
NOTED BY	
QUANTITIES BY	
APPROVED BY	

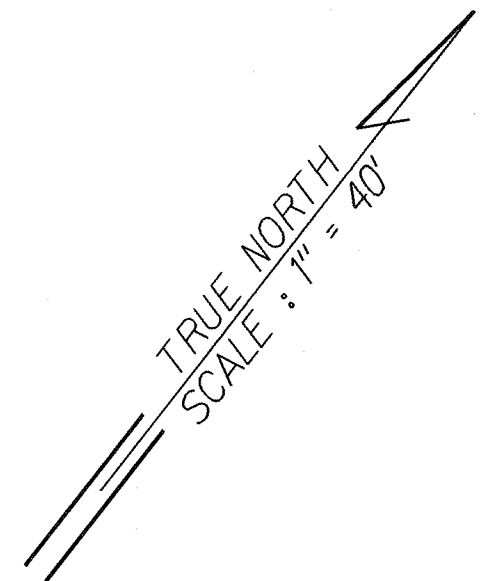

NOTE: Mililani Town Bound Lanes and H-2 Ramp R-1 Closed. See Detour Plan Sheet T33.

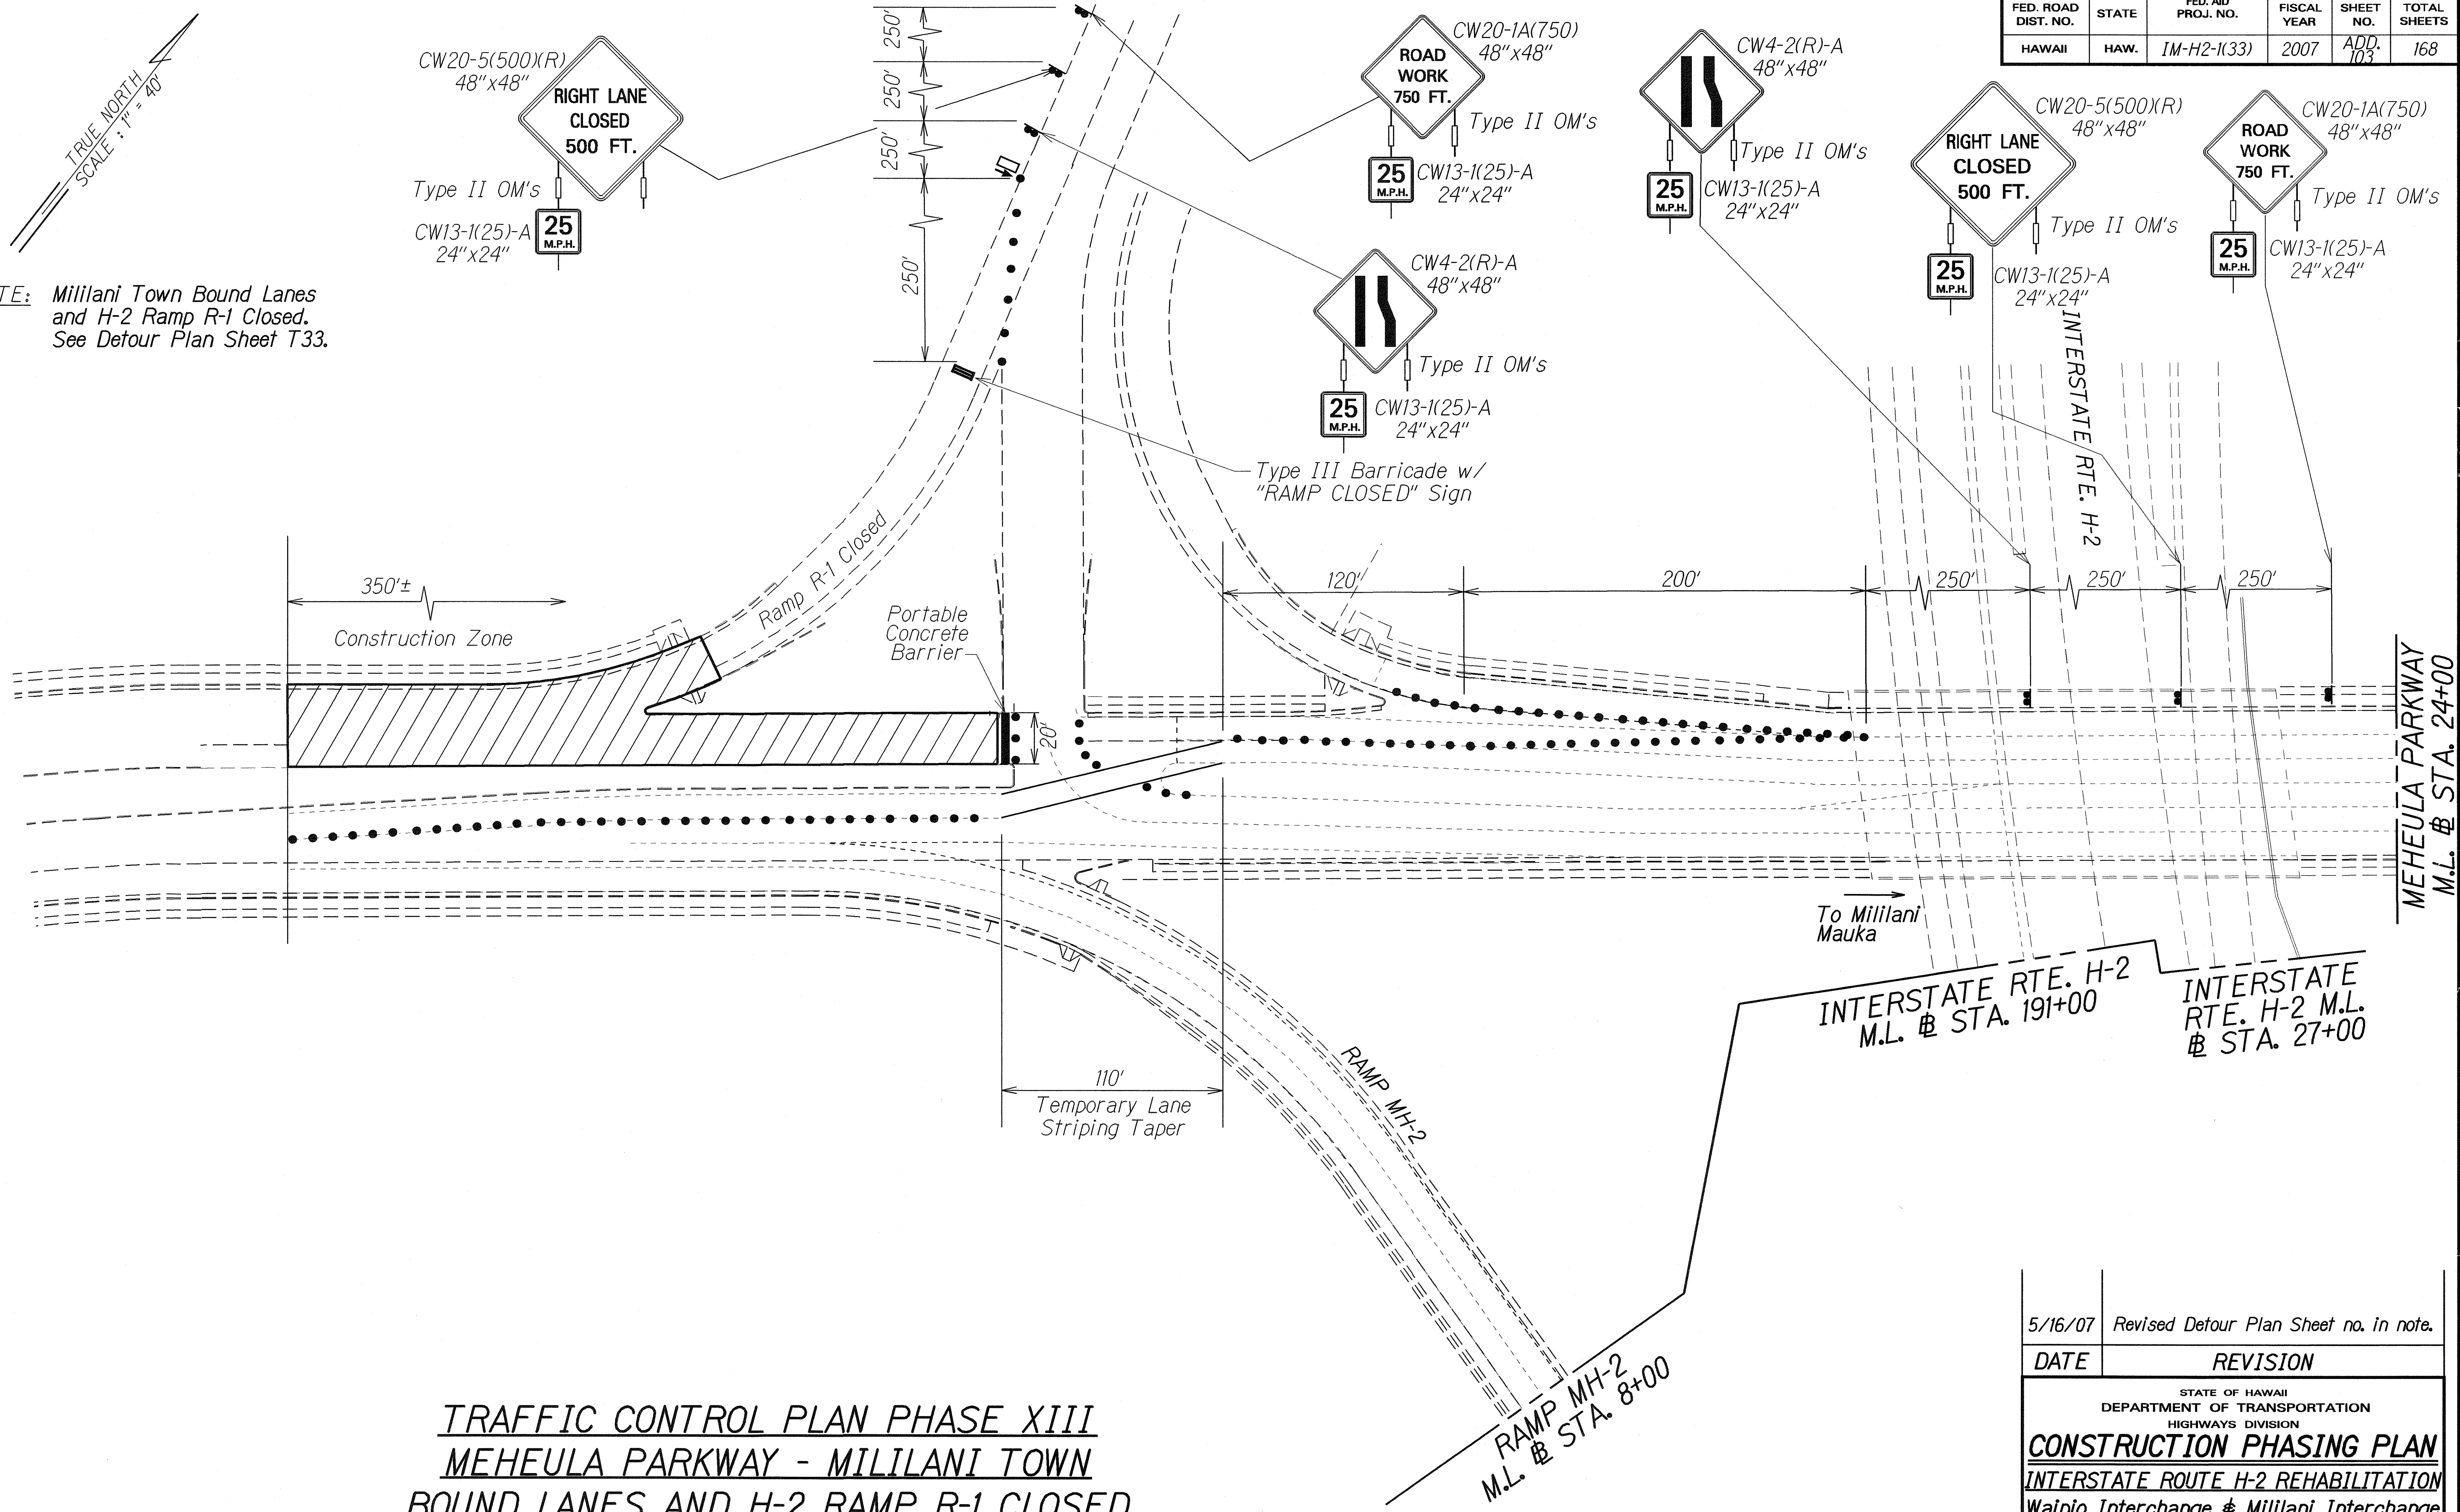

FED. ROAD DIST. NO.	STATE	FED. AID PROJ. NO.	FISCAL YEAR	SHEET NO.	TOTAL SHEETS
HAWAII	HAW.	IM-H2-1(33)	2007	ADD. 103	168

SURVEY PLOTTED BY	DATE
DESIGNED BY	
NOTED BY	
QUANTITIES BY	
CHECKED BY	


ORIGINAL PLAN

NOTES: 4/12/2003

TRAFFIC CONTROL PLAN PHASE XIII
MEHEULA PARKWAY - MILILANI TOWN
BOUND LANES AND H-2 RAMP R-1 CLOSED
(# Sta. 30+90.00 Lt. to # Sta. 34+40.00 Lt.)

5/16/07	Revised Detour Plan Sheet no. in note.
DATE	REVISION
STATE OF HAWAII DEPARTMENT OF TRANSPORTATION HIGHWAYS DIVISION CONSTRUCTION PHASING PLAN INTERSTATE ROUTE H-2 REHABILITATION Waipio Interchange & Mililani Interchange On/Off Ramps, Ka Uka Blvd., Meheula Pkwy. Overpass, & Kipapa Stream Bridge Federal Aid Project No. IM-H2-1(33) Scale: 1" = 40' Date: Dec. 2006	
SHEET No. T32 OF 63 SHEETS	

FED. ROAD DIST. NO.	STATE	FED. AID PROJ. NO.	FISCAL YEAR	SHEET NO.	TOTAL SHEETS
HAWAII	HAW.	IM-H2-1(33)	2007	104	168

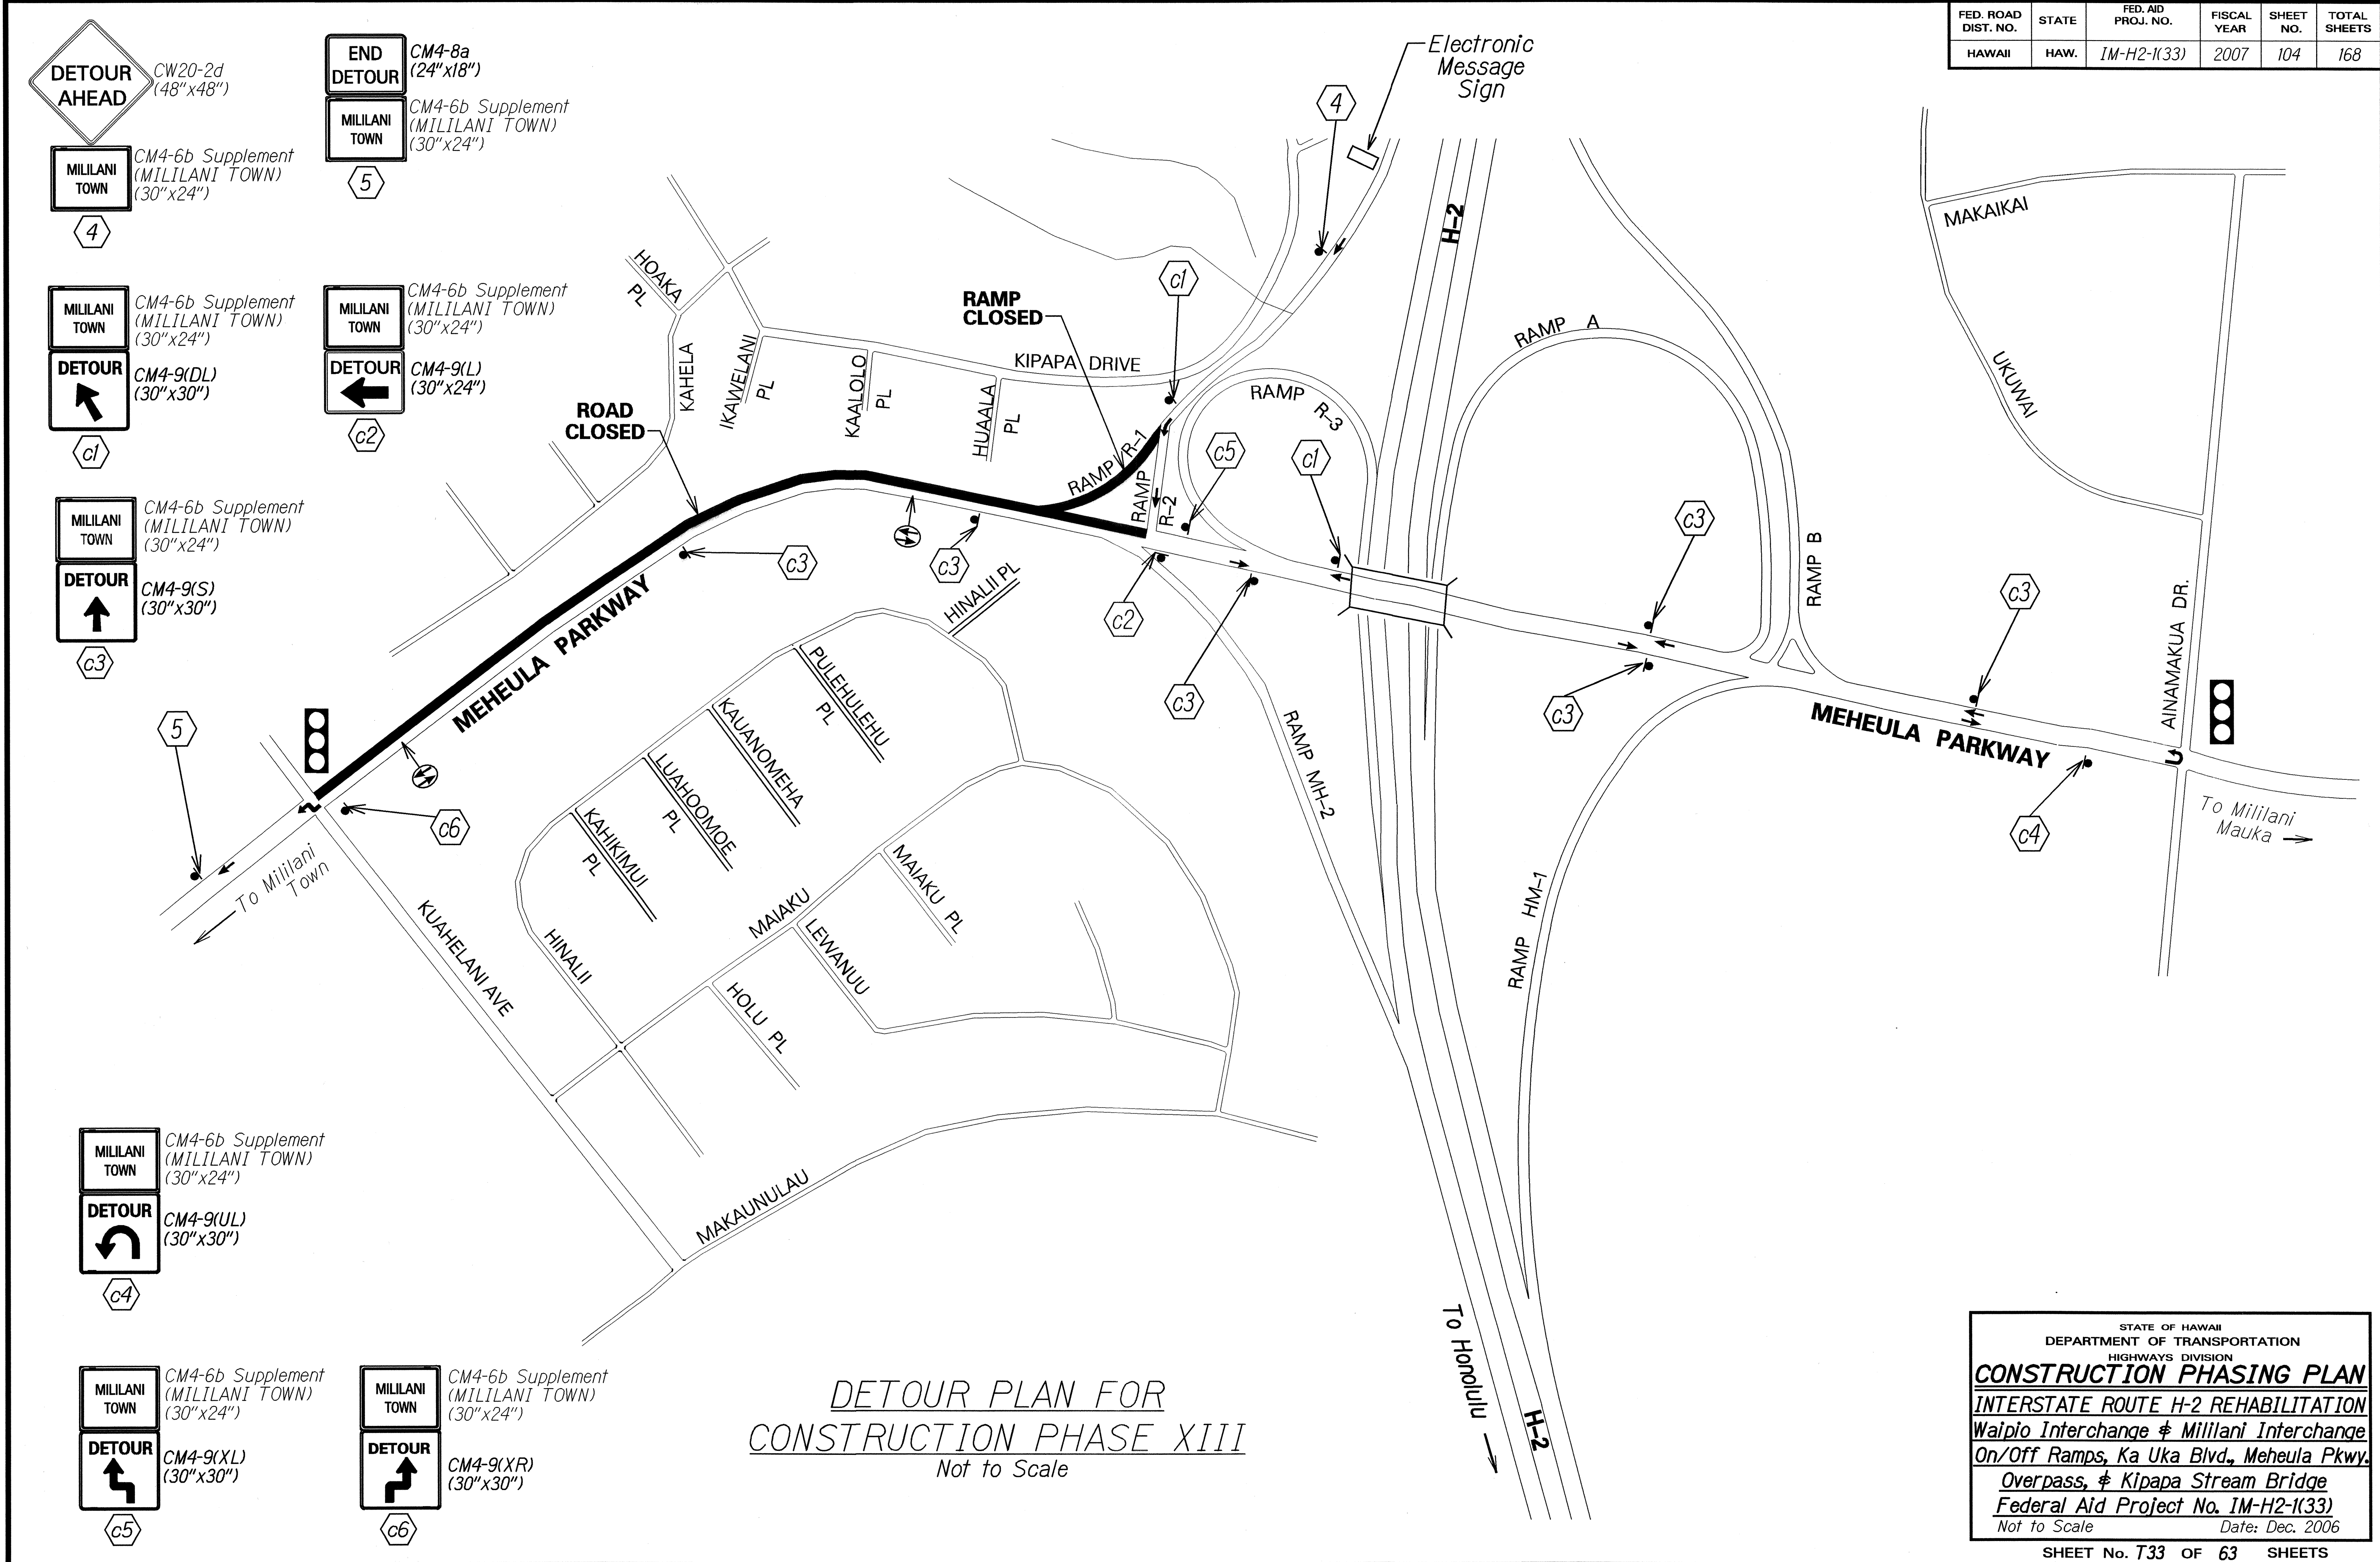

DETOUR PLAN FOR
CONSTRUCTION PHASE XIII
Not to Scale

STATE OF HAWAII
DEPARTMENT OF TRANSPORTATION
HIGHWAYS DIVISION


CONSTRUCTION PHASING PLAN
INTERSTATE ROUTE H-2 REHABILITATION
Waipio Interchange & Mililani Interchange
On/Off Ramps, Ka Uka Blvd., Meheula Pkwy.
Overpass, & Kipapa Stream Bridge
Federal Aid Project No. IM-H2-1(33)
Not to Scale
Date: Dec. 2006

SHEET No. 733 OF 63 SHEETS

ORIGINAL PLAN	DATE
DRAWN BY M. Takaijii	4/25/06
DESIGNED BY	
CHECKED BY	
APPROVED BY	
DATE	

FED. ROAD DIST. NO.	STATE	FED. AID PROJ. NO.	FISCAL YEAR	SHEET NO.	TOTAL SHEETS
HAWAII	HAW.	IM-H2-1(33)	2007	ADD. 105	168

NOTE: Mililani Mauka Bound Lanes and H-2 Ramp HM-1 Closed. See Detour Plan Sheet T36.

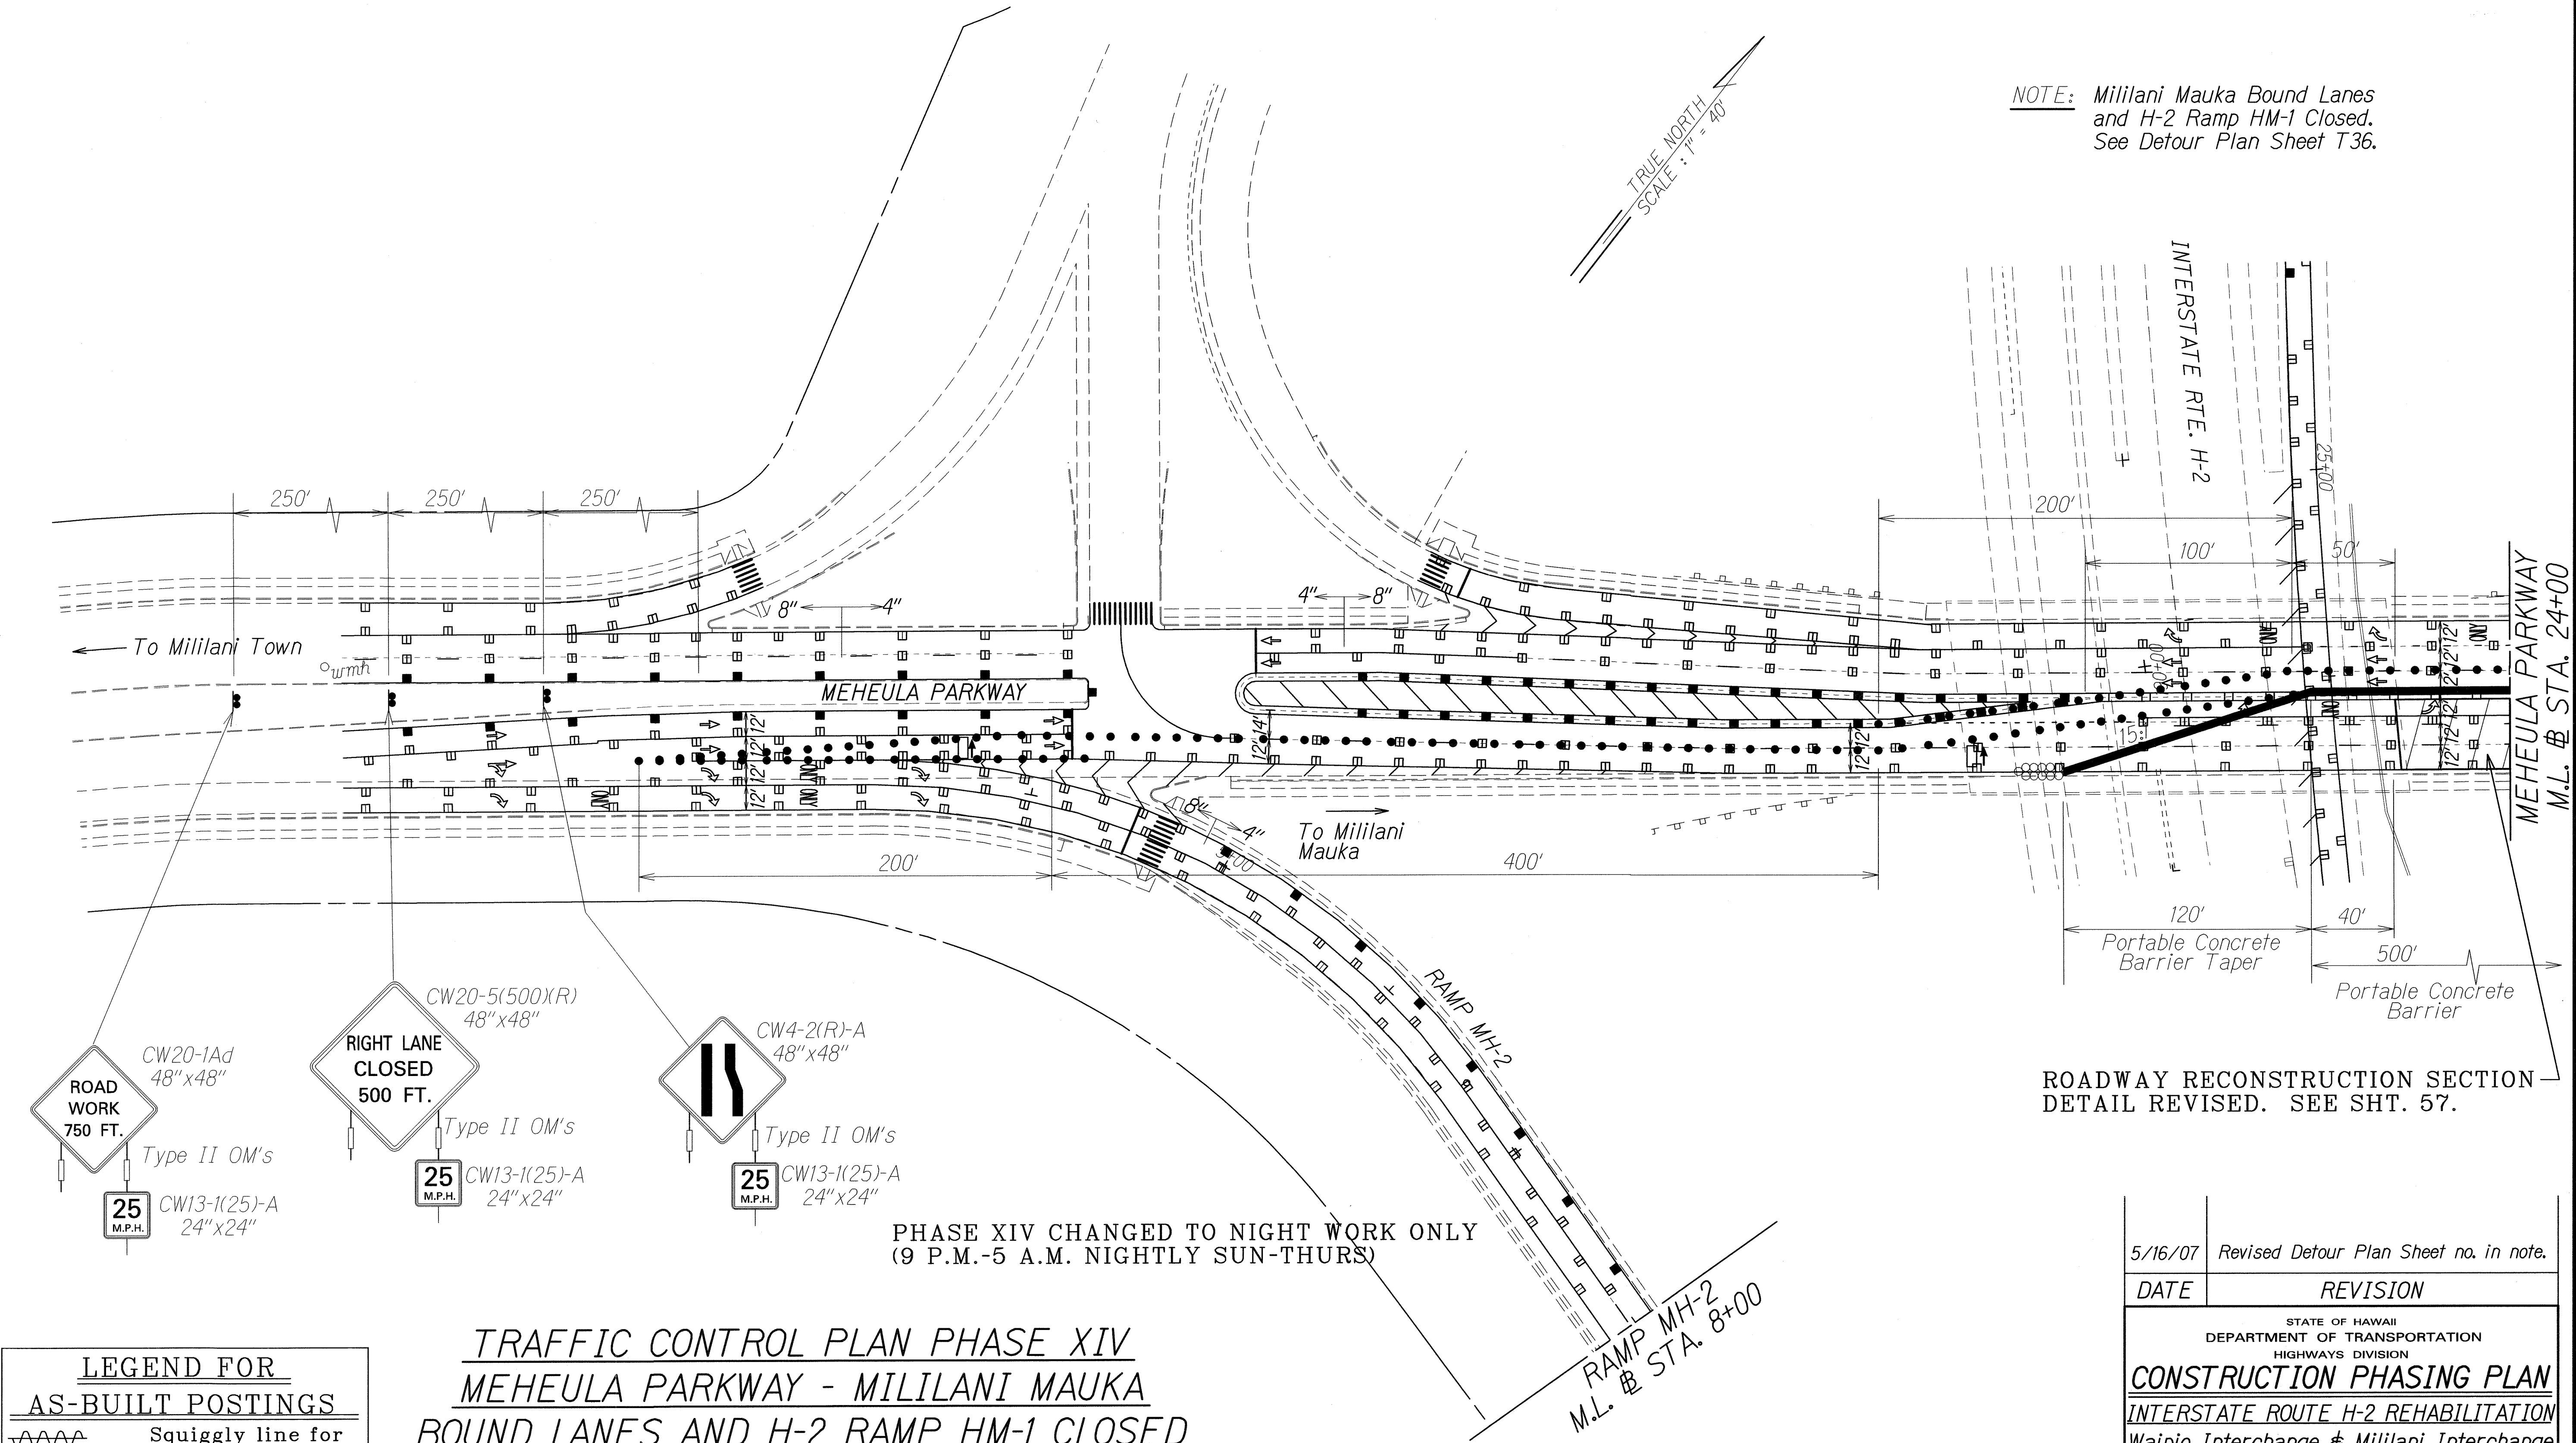

ROADWAY RECONSTRUCTION SECTION
DETAIL REVISED. SEE SHT. 57.

5/16/07	Revised Detour Plan Sheet no. in note.
DATE	REVISION
STATE OF HAWAII DEPARTMENT OF TRANSPORTATION HIGHWAYS DIVISION CONSTRUCTION PHASING PLAN INTERSTATE ROUTE H-2 REHABILITATION Waipio Interchange & Mililani Interchange On/Off Ramps, Ka Uka Blvd., Meheula Pkwy. Overpass, & Kipapa Stream Bridge Federal Aid Project No. IM-H2-1(33) Scale: 1" = 40' Date: Dec. 2006	
SHEET No. T34 OF 63 SHEETS	

LEGEND FOR AS-BUILT POSTINGS	
	Squiggly line for as-built deletion
	Double line for as-built deletion
Roadway	Text for as-built posting


TRAFFIC CONTROL PLAN PHASE XIV
MEHEULA PARKWAY - MILILANI MAUKA
BOUND LANES AND H-2 RAMP HM-1 CLOSED
(Sta. 23+46.00 Rt to Sta. 31+45.00 Rt)

SURVEY PLOTTED BY	DATE
DRAWN BY M. Takafuji	X
TRACED BY	
DESIGNED BY J. H. T. D.	
CHECKED BY	
NOTES	
102 may	
11/12/2006/14	

"AS-BUILT"

ADD. 105

FED. ROAD DIST. NO.	STATE	FED. AID PROJ. NO.	FISCAL YEAR	SHEET NO.	TOTAL SHEETS
HAWAII	HAW.	IM-H2-1(33)	2007	ADD. 106	168

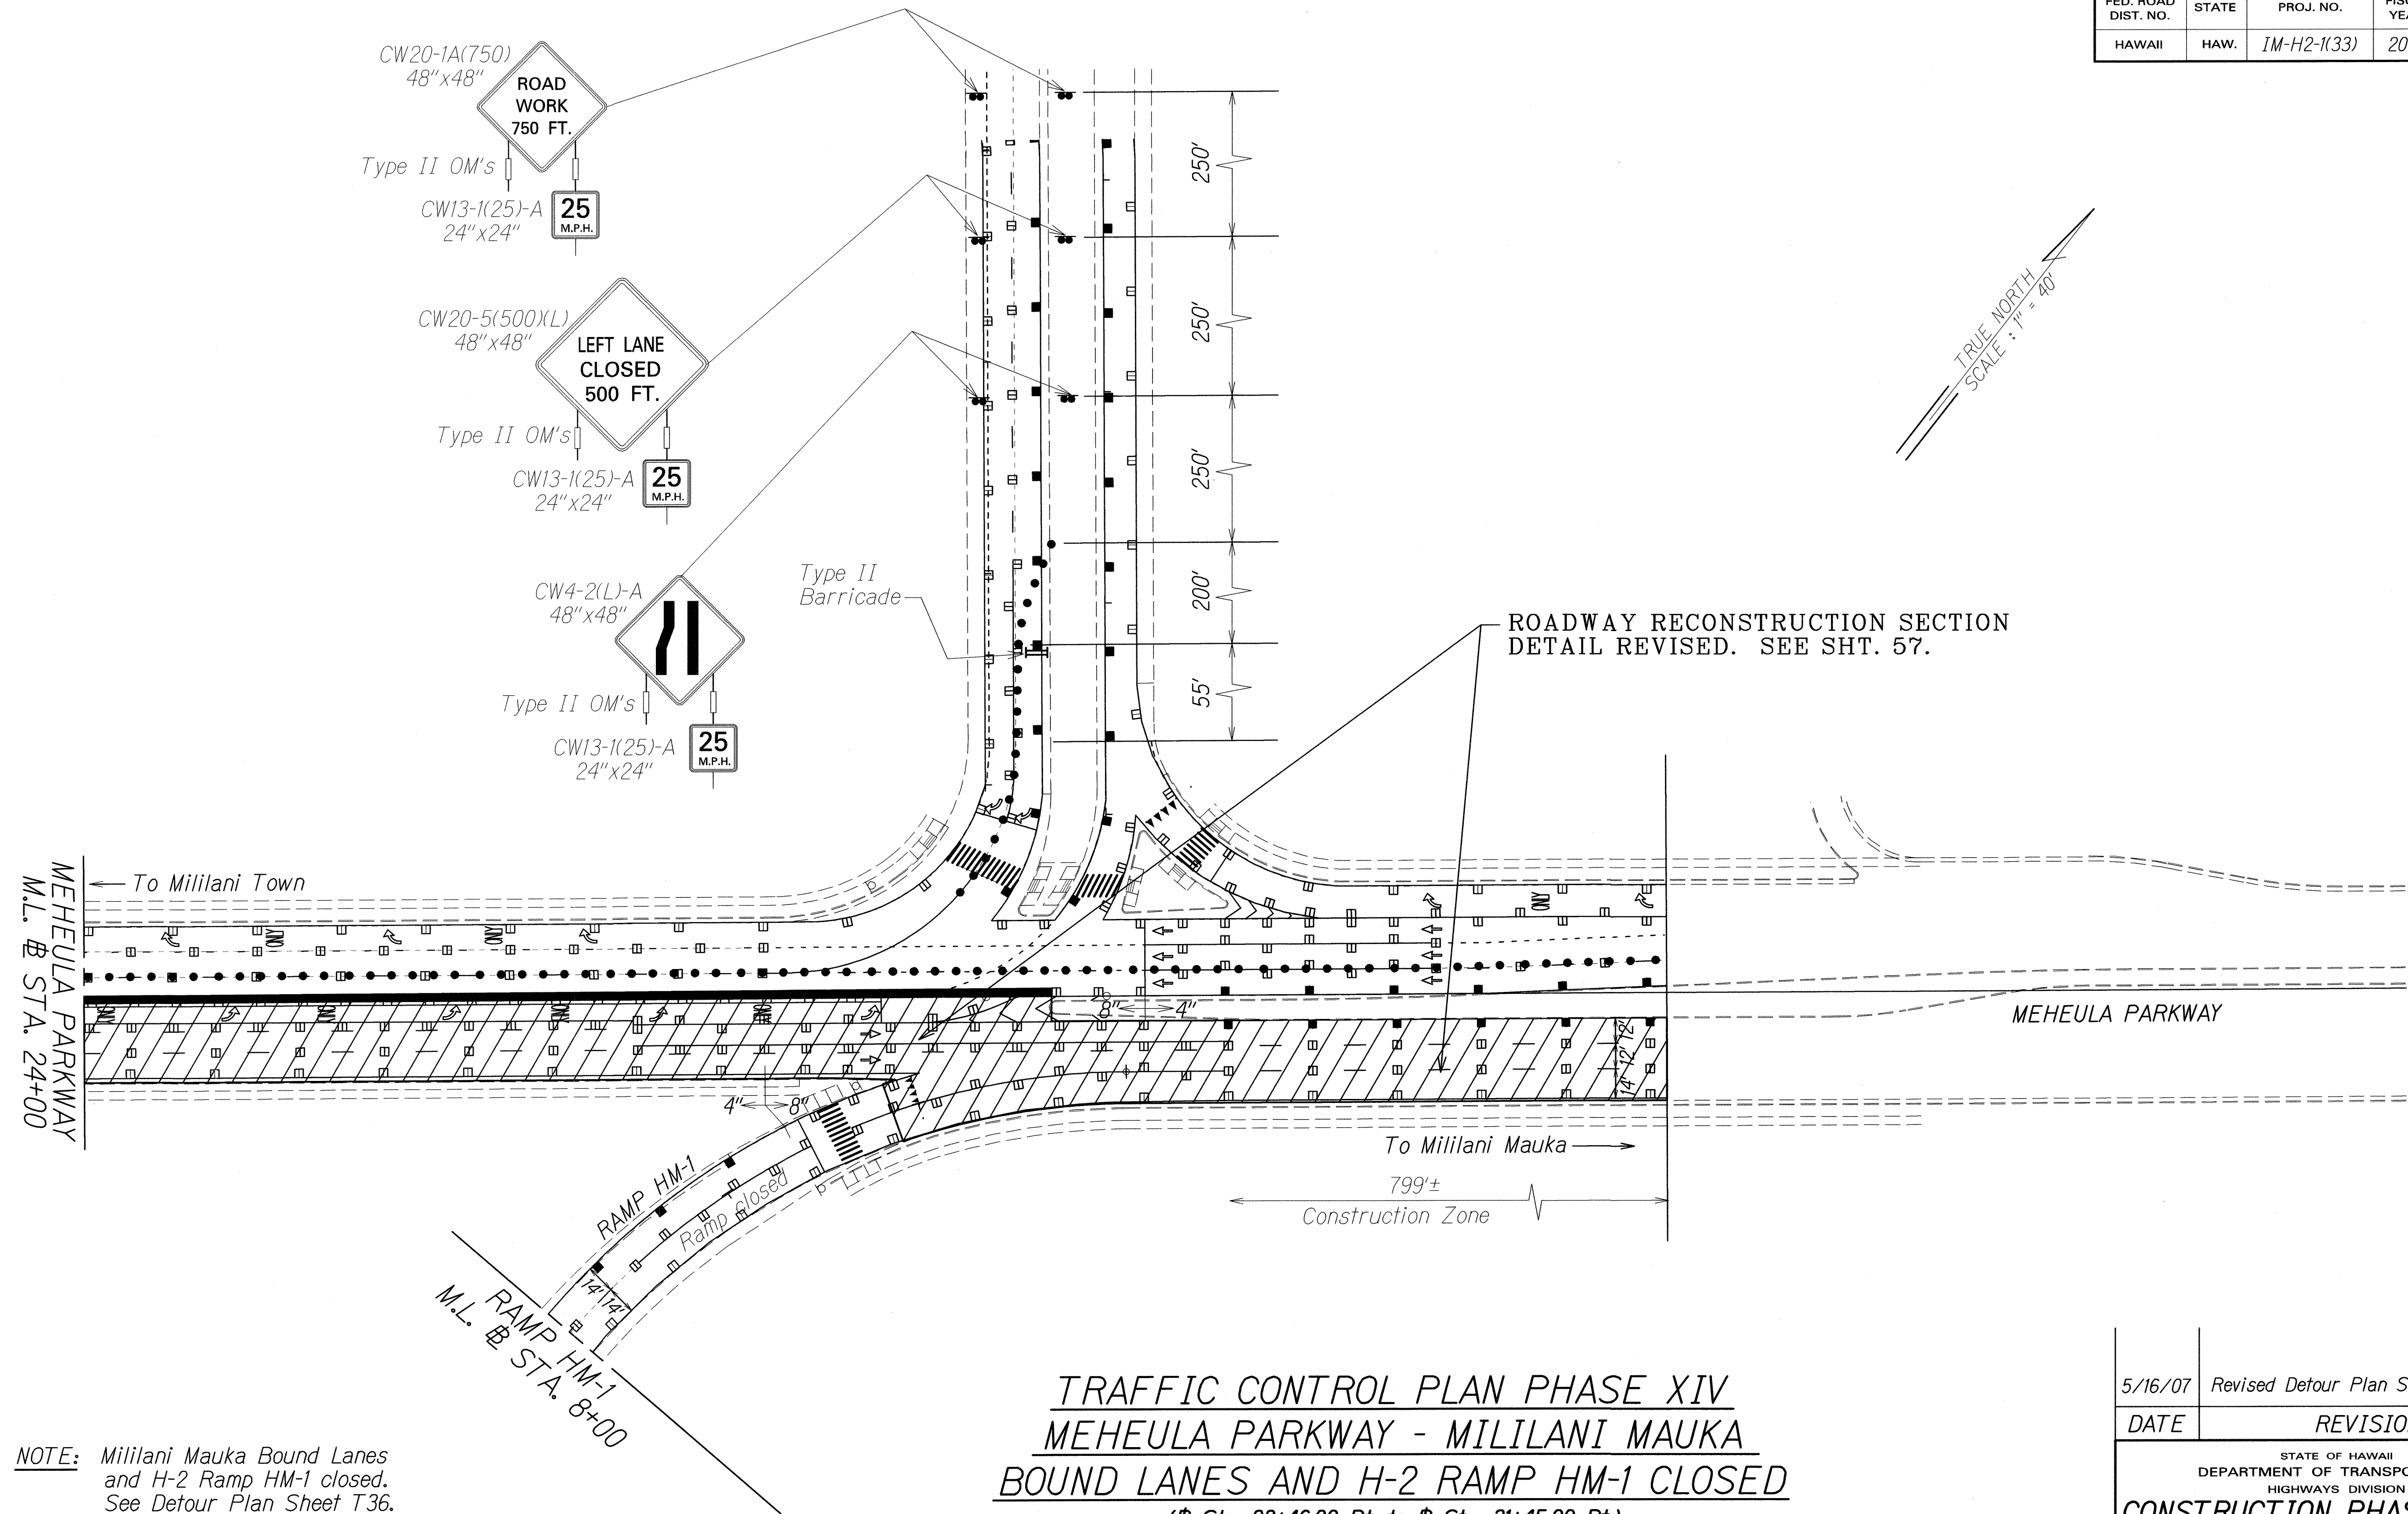

NOTE: Mililani Mauka Bound Lanes and H-2 Ramp HM-1 closed. See Detour Plan Sheet T36.


**TRAFFIC CONTROL PLAN PHASE XIV
MEHEULA PARKWAY - MILILANI MAUKA
BOUND LANES AND H-2 RAMP HM-1 CLOSED**
(Sta. 23+46.00 Rt. to Sta. 31+45.00 Rt.)

PHASE XIV CHANGED TO NIGHT WORK ONLY
(9 P.M.-5 A.M. NIGHTLY SUN-THURS)

LEGEND FOR AS-BUILT POSTINGS	
	Squiggly line for as-built deletion
	Double line for as-built deletion
Roadway	Text for as-built posting

5/16/07	Revised Detour Plan Sheet no. in note.
DATE	REVISION
STATE OF HAWAII DEPARTMENT OF TRANSPORTATION HIGHWAYS DIVISION CONSTRUCTION PHASING PLAN INTERSTATE ROUTE H-2 REHABILITATION Waipio Interchange & Mililani Interchange On/Off Ramps, Ka Uka Blvd., Meheula Pkwy. Overpass, & Kipapa Stream Bridge Federal Aid Project No. IM-H2-1(33) Scale: 1" = 40' Date: Dec. 2006	
SHEET No. T35 OF 63 SHEETS	

FED. ROAD DIST. NO.	STATE	PROJ. NO.	FISCAL YEAR	SHEET NO.	TOTAL SHEETS
HAWAII	HAW.	IM-H2-1(33)	2007	109	168

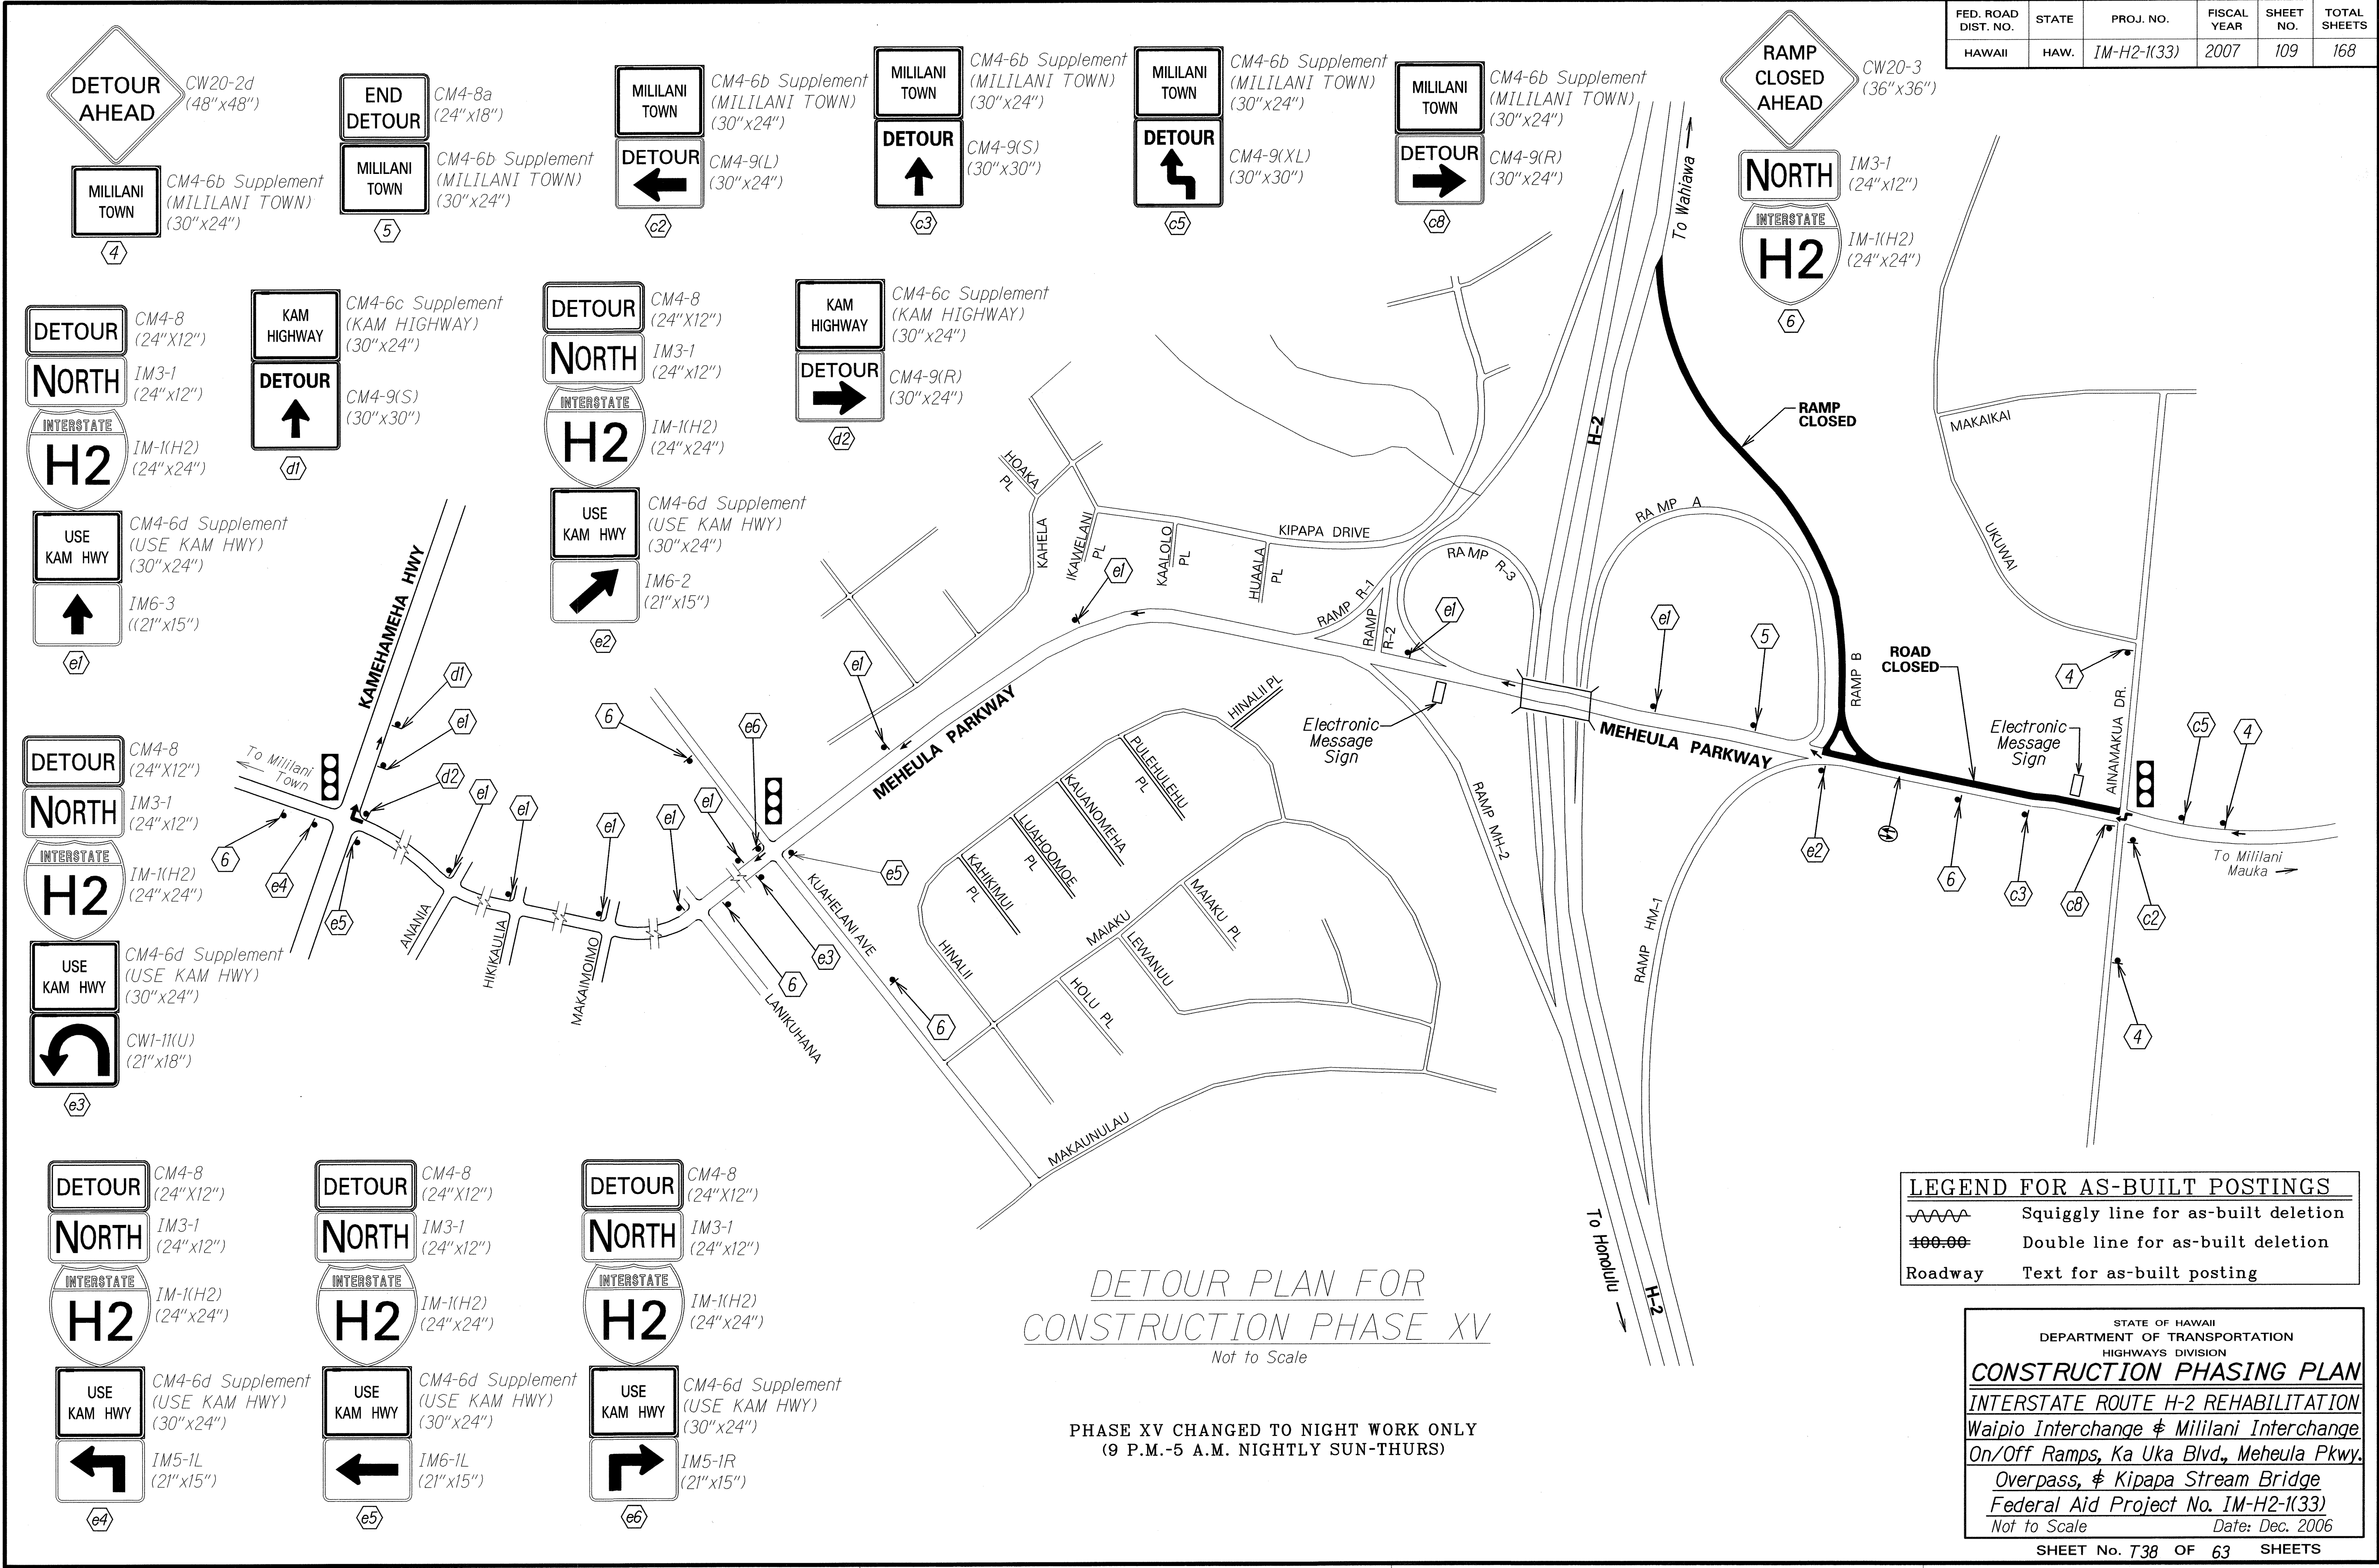


DATE	4/27/06
SURVEY PLOTTED BY	M. T. T. T.
DRAWN BY	M. T. T. T.
DESIGNED BY	M. T. T. T.
CHECKED BY	M. T. T. T.
ORIGINAL PLAN	10/2/06
NOTE BOOK	10/2/06

"AS-BUILT"

FED. ROAD DIST. NO.	STATE	FED. AID PROJ. NO.	FISCAL YEAR	SHEET NO.	TOTAL SHEETS
HAWAII	HAW.	IM-H2-1(33)	2007	ADD. 110	168

NOTE: Mililani Town Bound Lanes and H-2 Ramp A Closed. See Detour Plan Sheet T41.

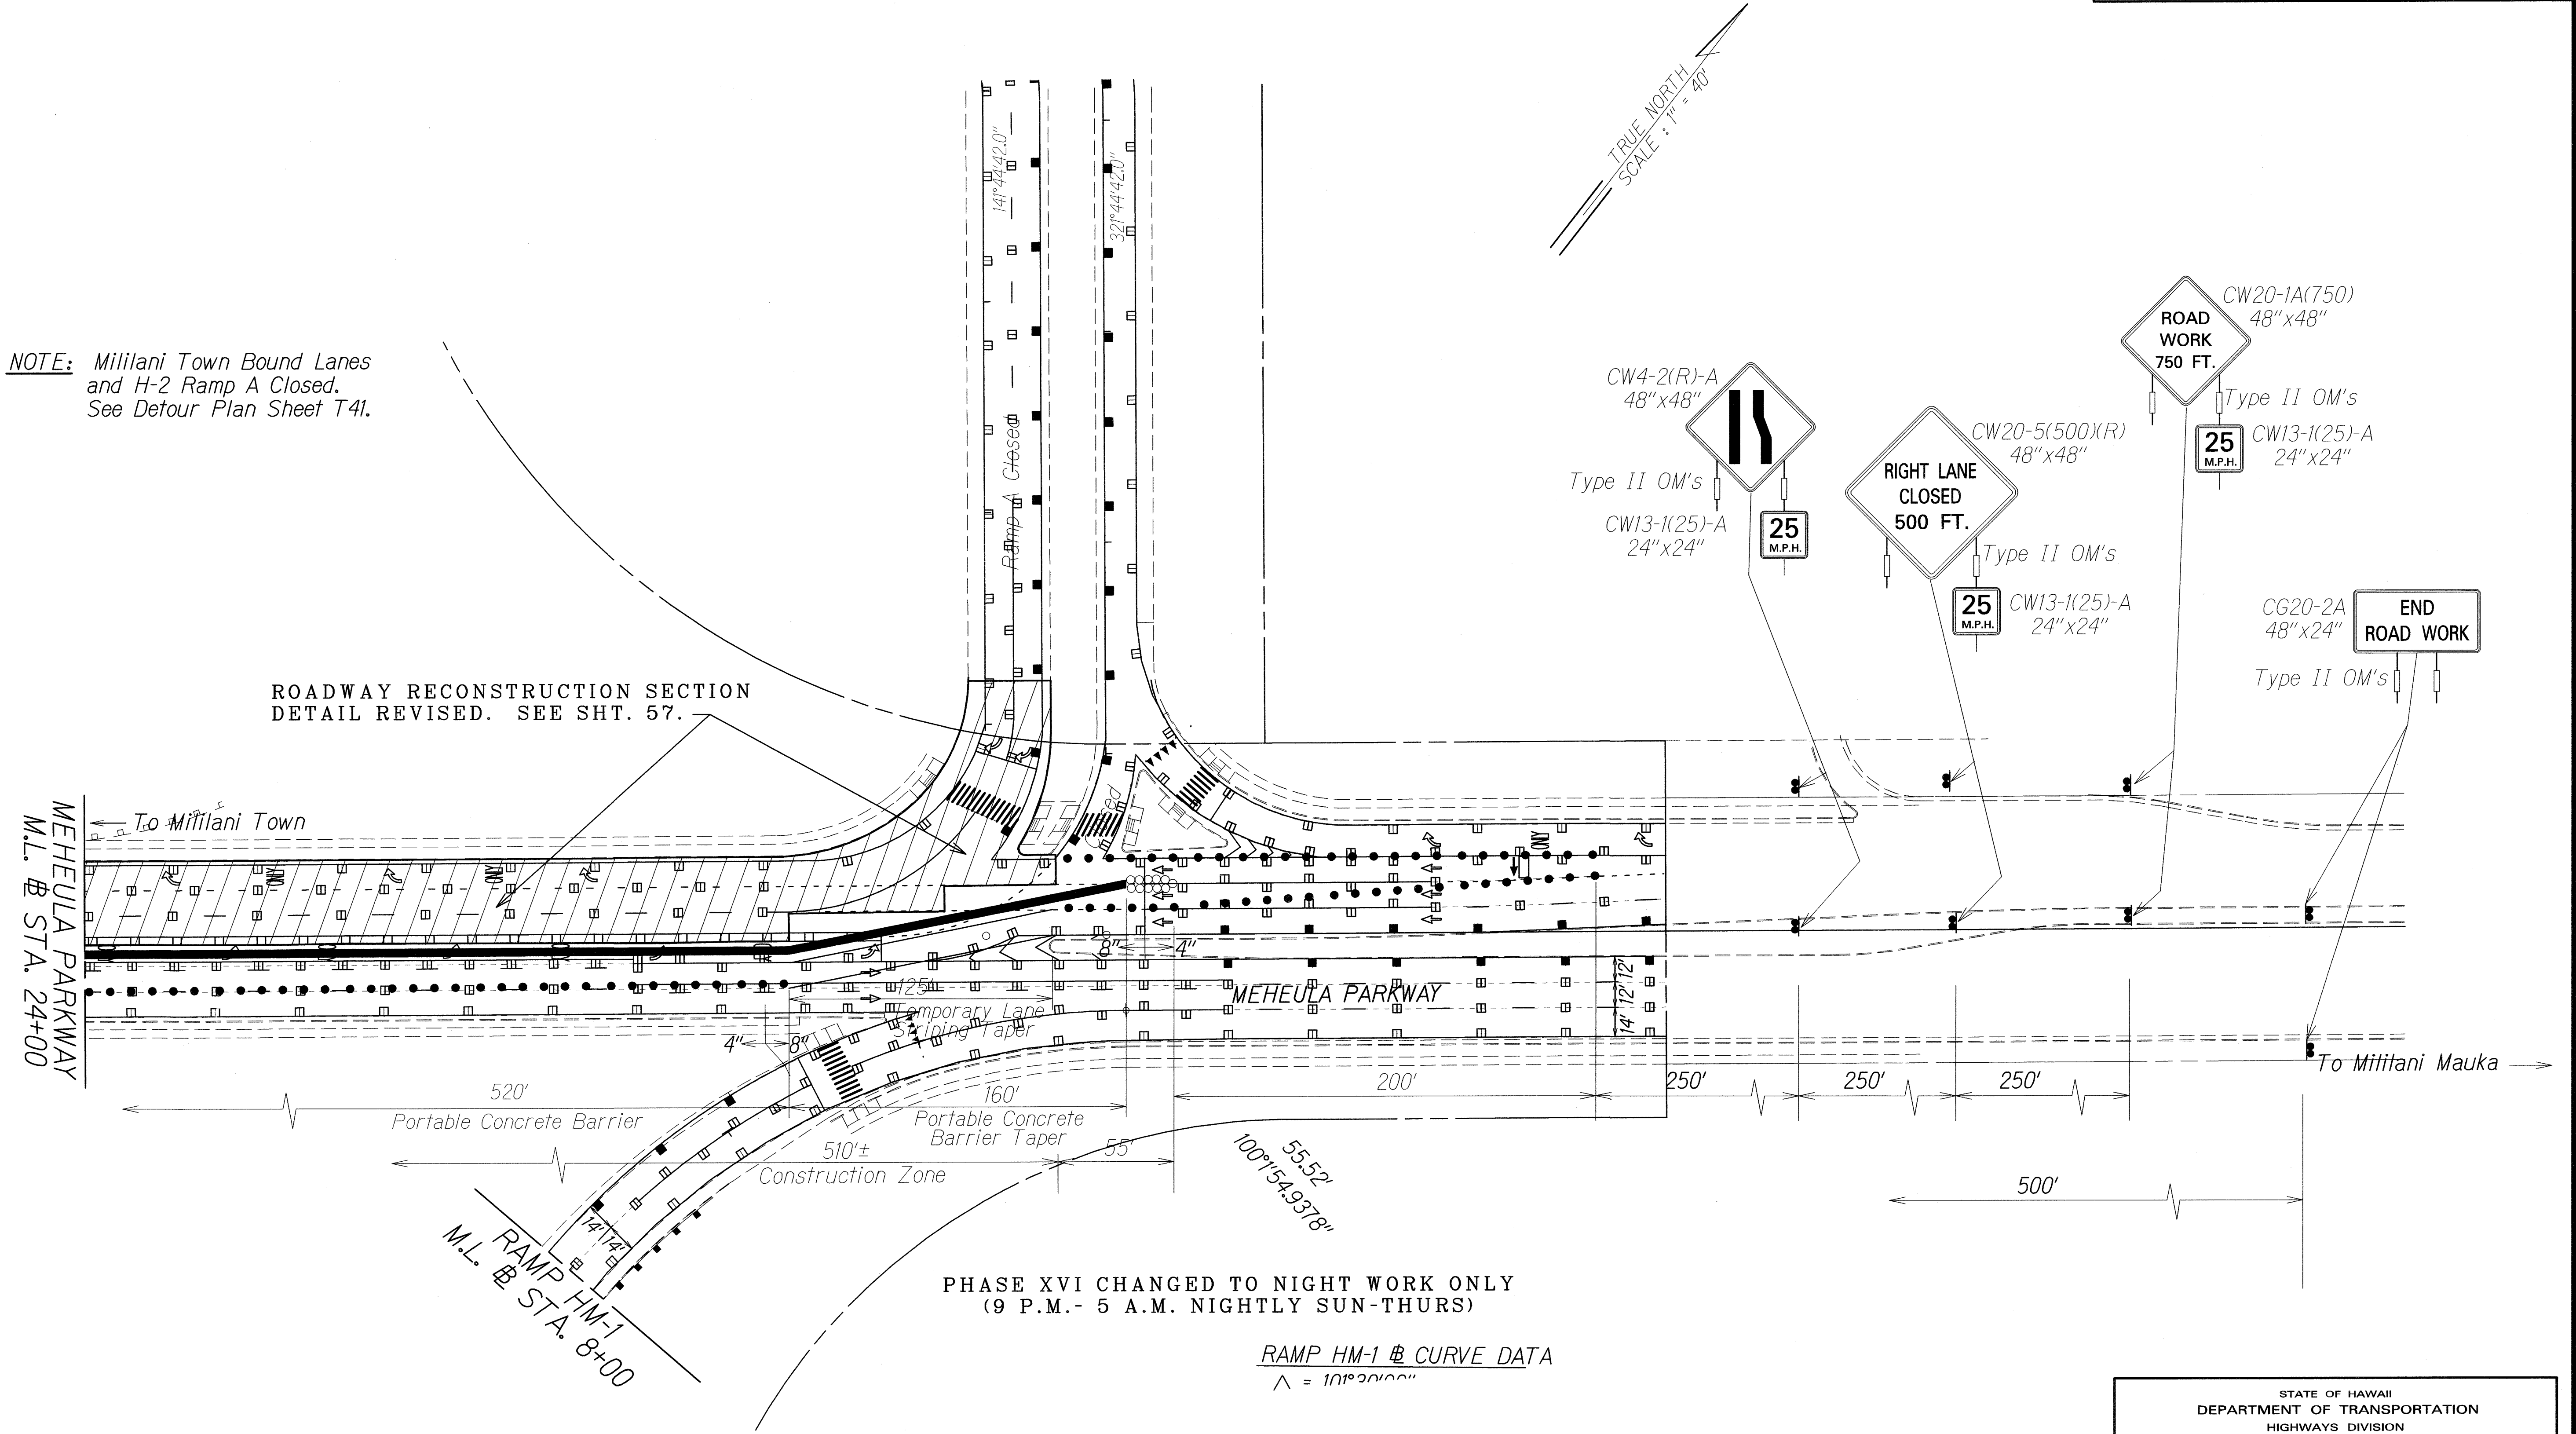

LEGEND FOR AS-BUILT POSTINGS	
	Squiggly line for as-built deletion
	Double line for as-built deletion
Roadway	Text for as-built posting

TRAFFIC CONTROL PLAN PHASE XVI
MEHEULA PARKWAY - MILILANI TOWN
BOUND LANES AND H-2 RAMP A CLOSED
(Sta. 23+46.00 Lt. Sta. 28+56.00 Lt.)

STATE OF HAWAII DEPARTMENT OF TRANSPORTATION HIGHWAYS DIVISION	
CONSTRUCTION PHASING PLAN	
INTERSTATE ROUTE H-2 REHABILITATION	
Waipio Interchange & Mililani Interchange	
On/Off Ramps, Ka Uka Blvd., Meheula Pkwy.	
Overpass, & Kipapa Stream Bridge	
Federal Aid Project No. IM-H2-1(33)	
Scale: 1" = 40'	Date: Dec. 2006
SHEET No. 739 OF 63 SHEETS	

5/16/07	Revised Detour Plan Sheet no. in note.
DATE	REVISION

"AS-BUILT"

ADD. 110

FED. ROAD DIST. NO.	STATE	PROJ. NO.	FISCAL YEAR	SHEET NO.	TOTAL SHEETS
HAWAII	HAW.	IM-H2-1(33)	2007	112	168



CW20-2d
(48"x48")



CM4-6b Supplement
(MILILANI TOWN)
(30"x24")

4



CM4-8a
(24"x18")



CM4-6b Supplement
(MILILANI TOWN)
(30"x24")

5



CM4-6b Supplement
(MILILANI TOWN)
(30"x24")




CM4-9(S)
(30"x30")

c3



CM4-6b Supplement
(MILILANI TOWN)
(30"x24")

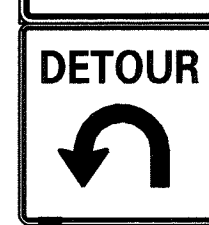


CM4-9(UL)
(30"x30")

c4



CM4-6b Supplement
(MILILANI TOWN)
(30"x24")

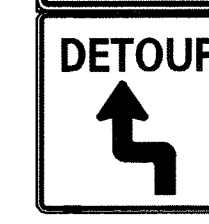


CM4-9(XL)
(30"x30")

c5




CM4-6b Supplement
(MILILANI TOWN)
(30"x24")

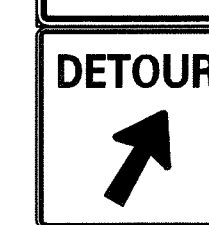

CM4-9(DR)
(30"x30")

c7

ORIGINAL PLAN	SURVEY PLOTTED BY	DATE
NOTE BOOK	DRAWN BY M. Takafuji	4/27/06
102.may	DESIGNED BY	
4/12/09	CHECKED BY	

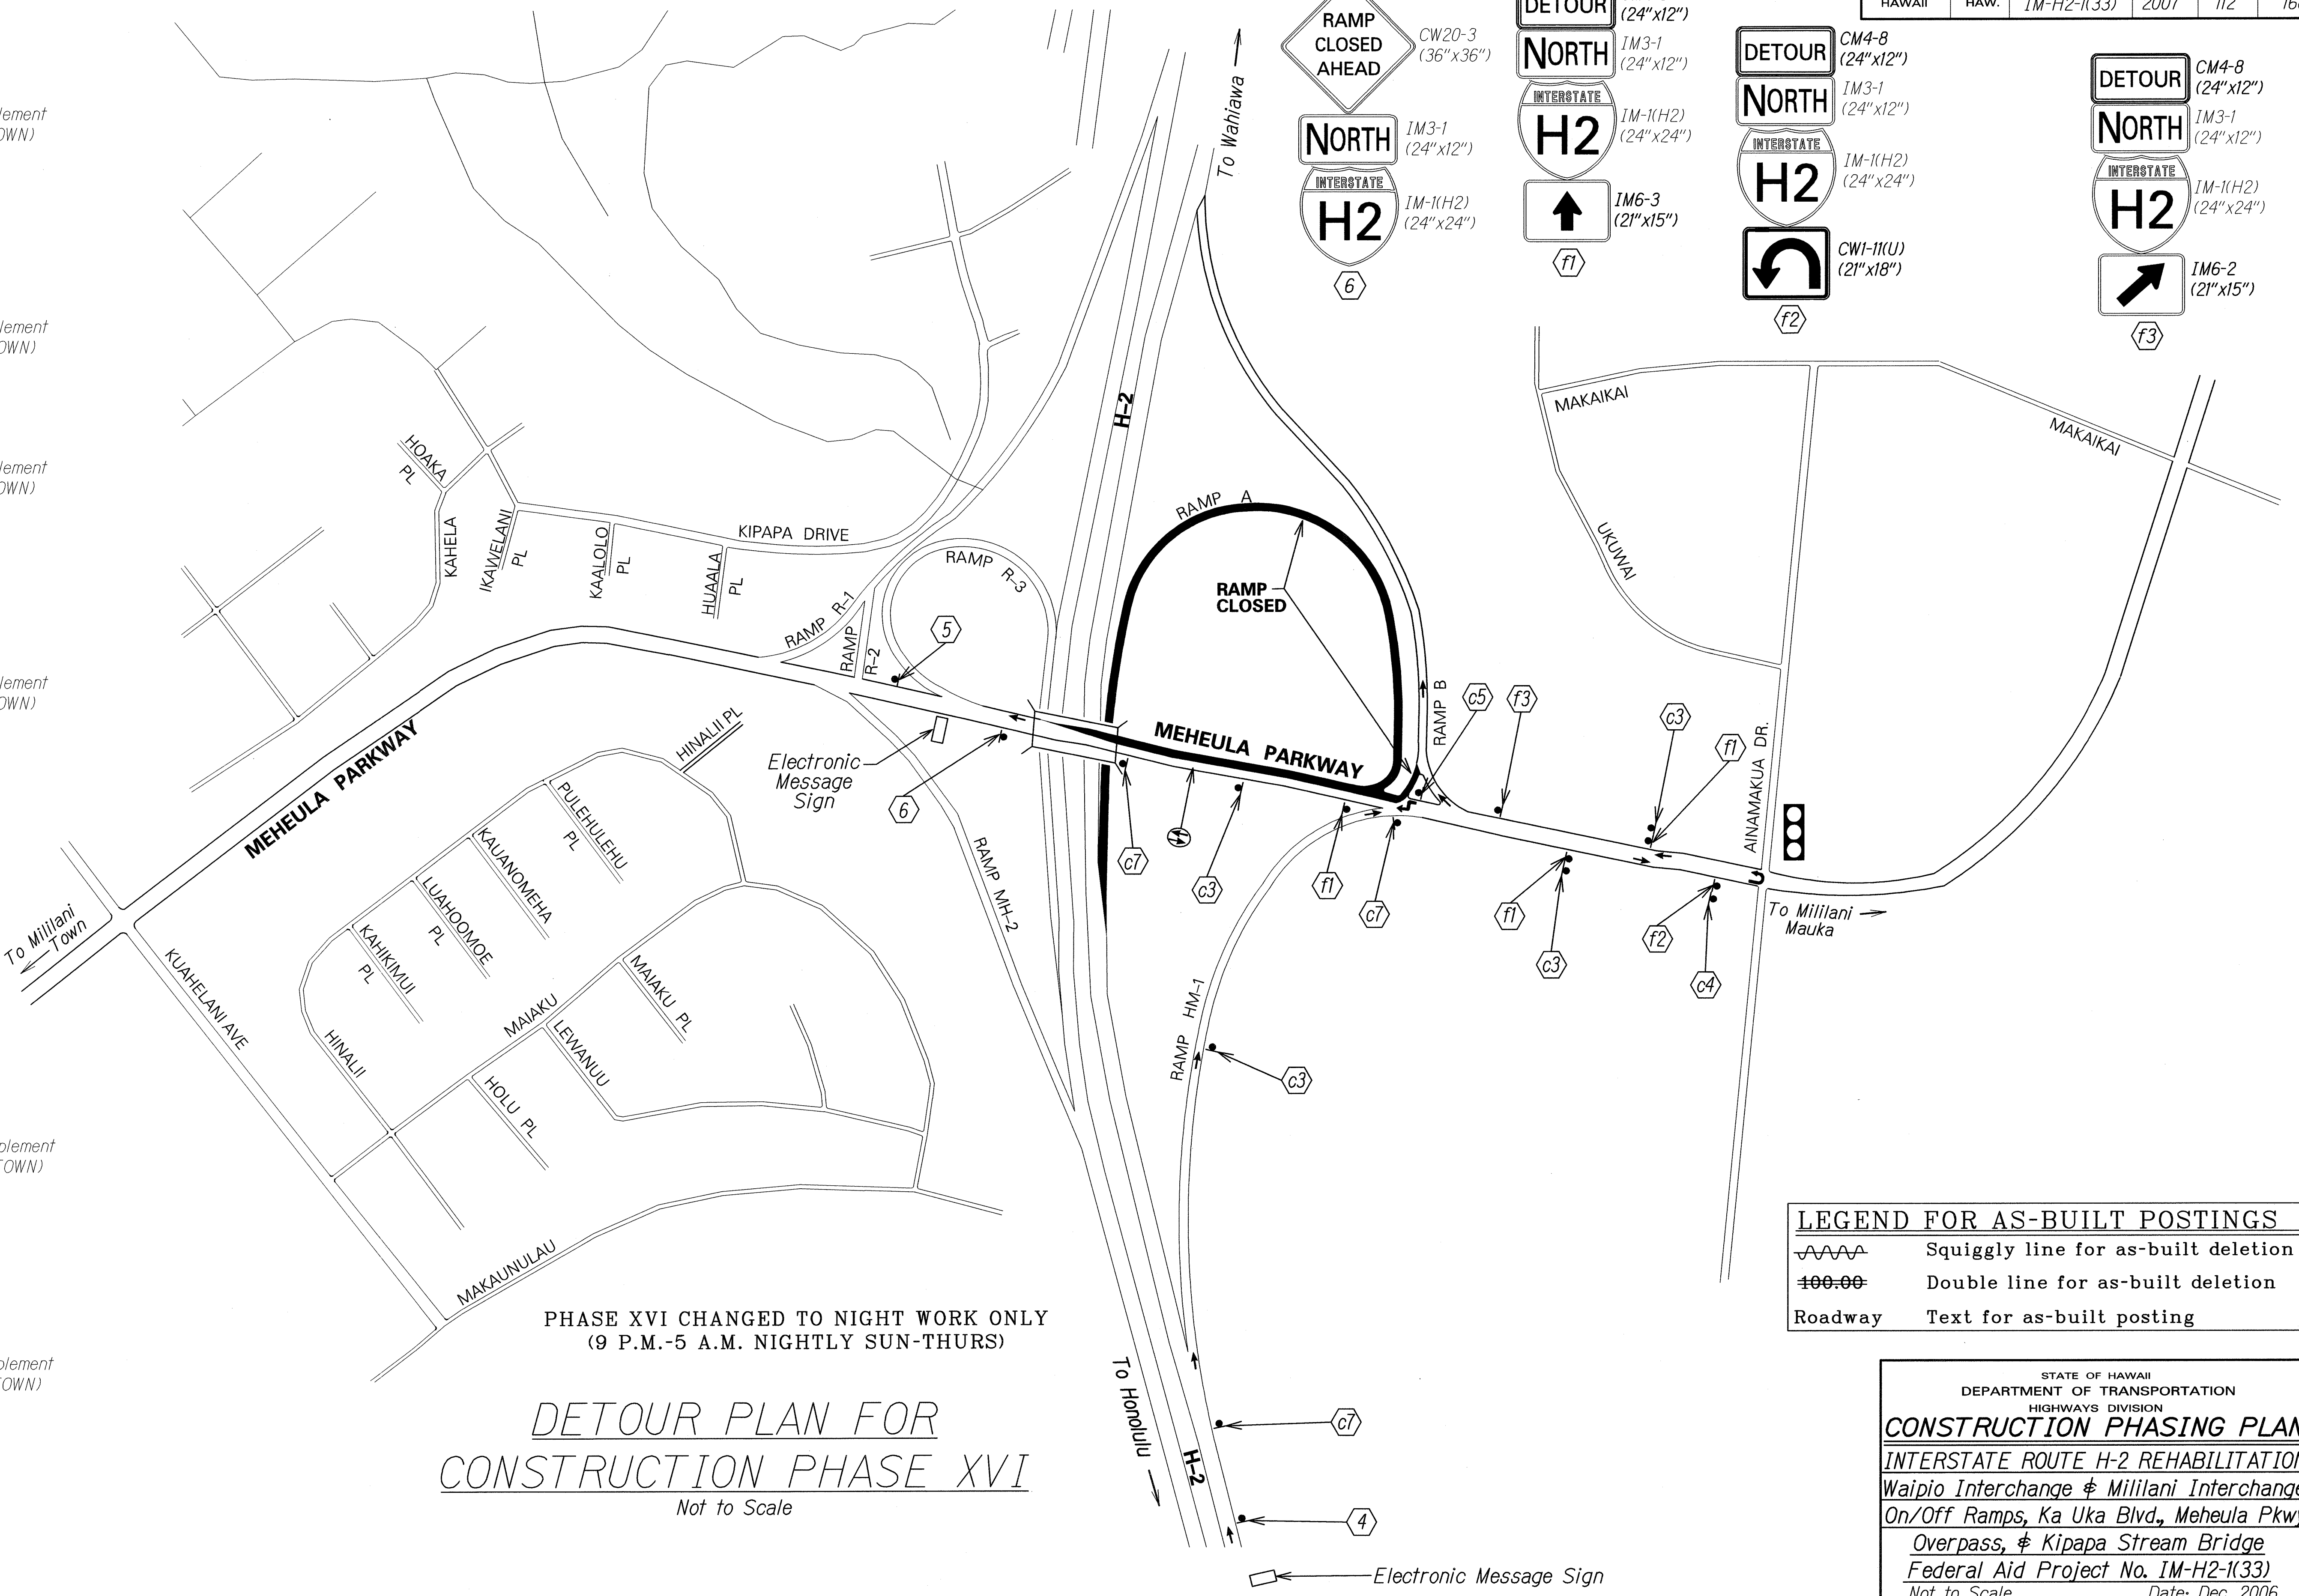

PHASE XVI CHANGED TO NIGHT WORK ONLY
(9 P.M.-5 A.M. NIGHTLY SUN-THURS)

*DETOUR PLAN FOR
CONSTRUCTION PHASE XVI*

Not to Scale

LEGEND FOR AS-BUILT POSTINGS	
	Squiggly line for as-built deletion
	Double line for as-built deletion
Roadway	Text for as-built posting

STATE OF HAWAII DEPARTMENT OF TRANSPORTATION HIGHWAYS DIVISION	
<u>CONSTRUCTION PHASING PLAN</u>	
<u>INTERSTATE ROUTE H-2 REHABILITATION</u>	
<u>Waipio Interchange & Mililani Interchange</u>	
<u>On/Off Ramps, Ka Uka Blvd., Meheula Pkwy.</u>	
<u>Overpass, & Kipapa Stream Bridge</u>	
<u>Federal Aid Project No. IM-H2-1(33)</u>	
<i>Not to Scale</i>	<i>Date: Dec. 2006</i>