


FED. ROAD DIST. NO.	STATE	FED. AID PROJ. NO.	FISCAL YEAR	SHEET NO.	TOTAL SHEETS
HAWAII	HAW.	IM-H2-1(33)	2007	ADD. 130	168

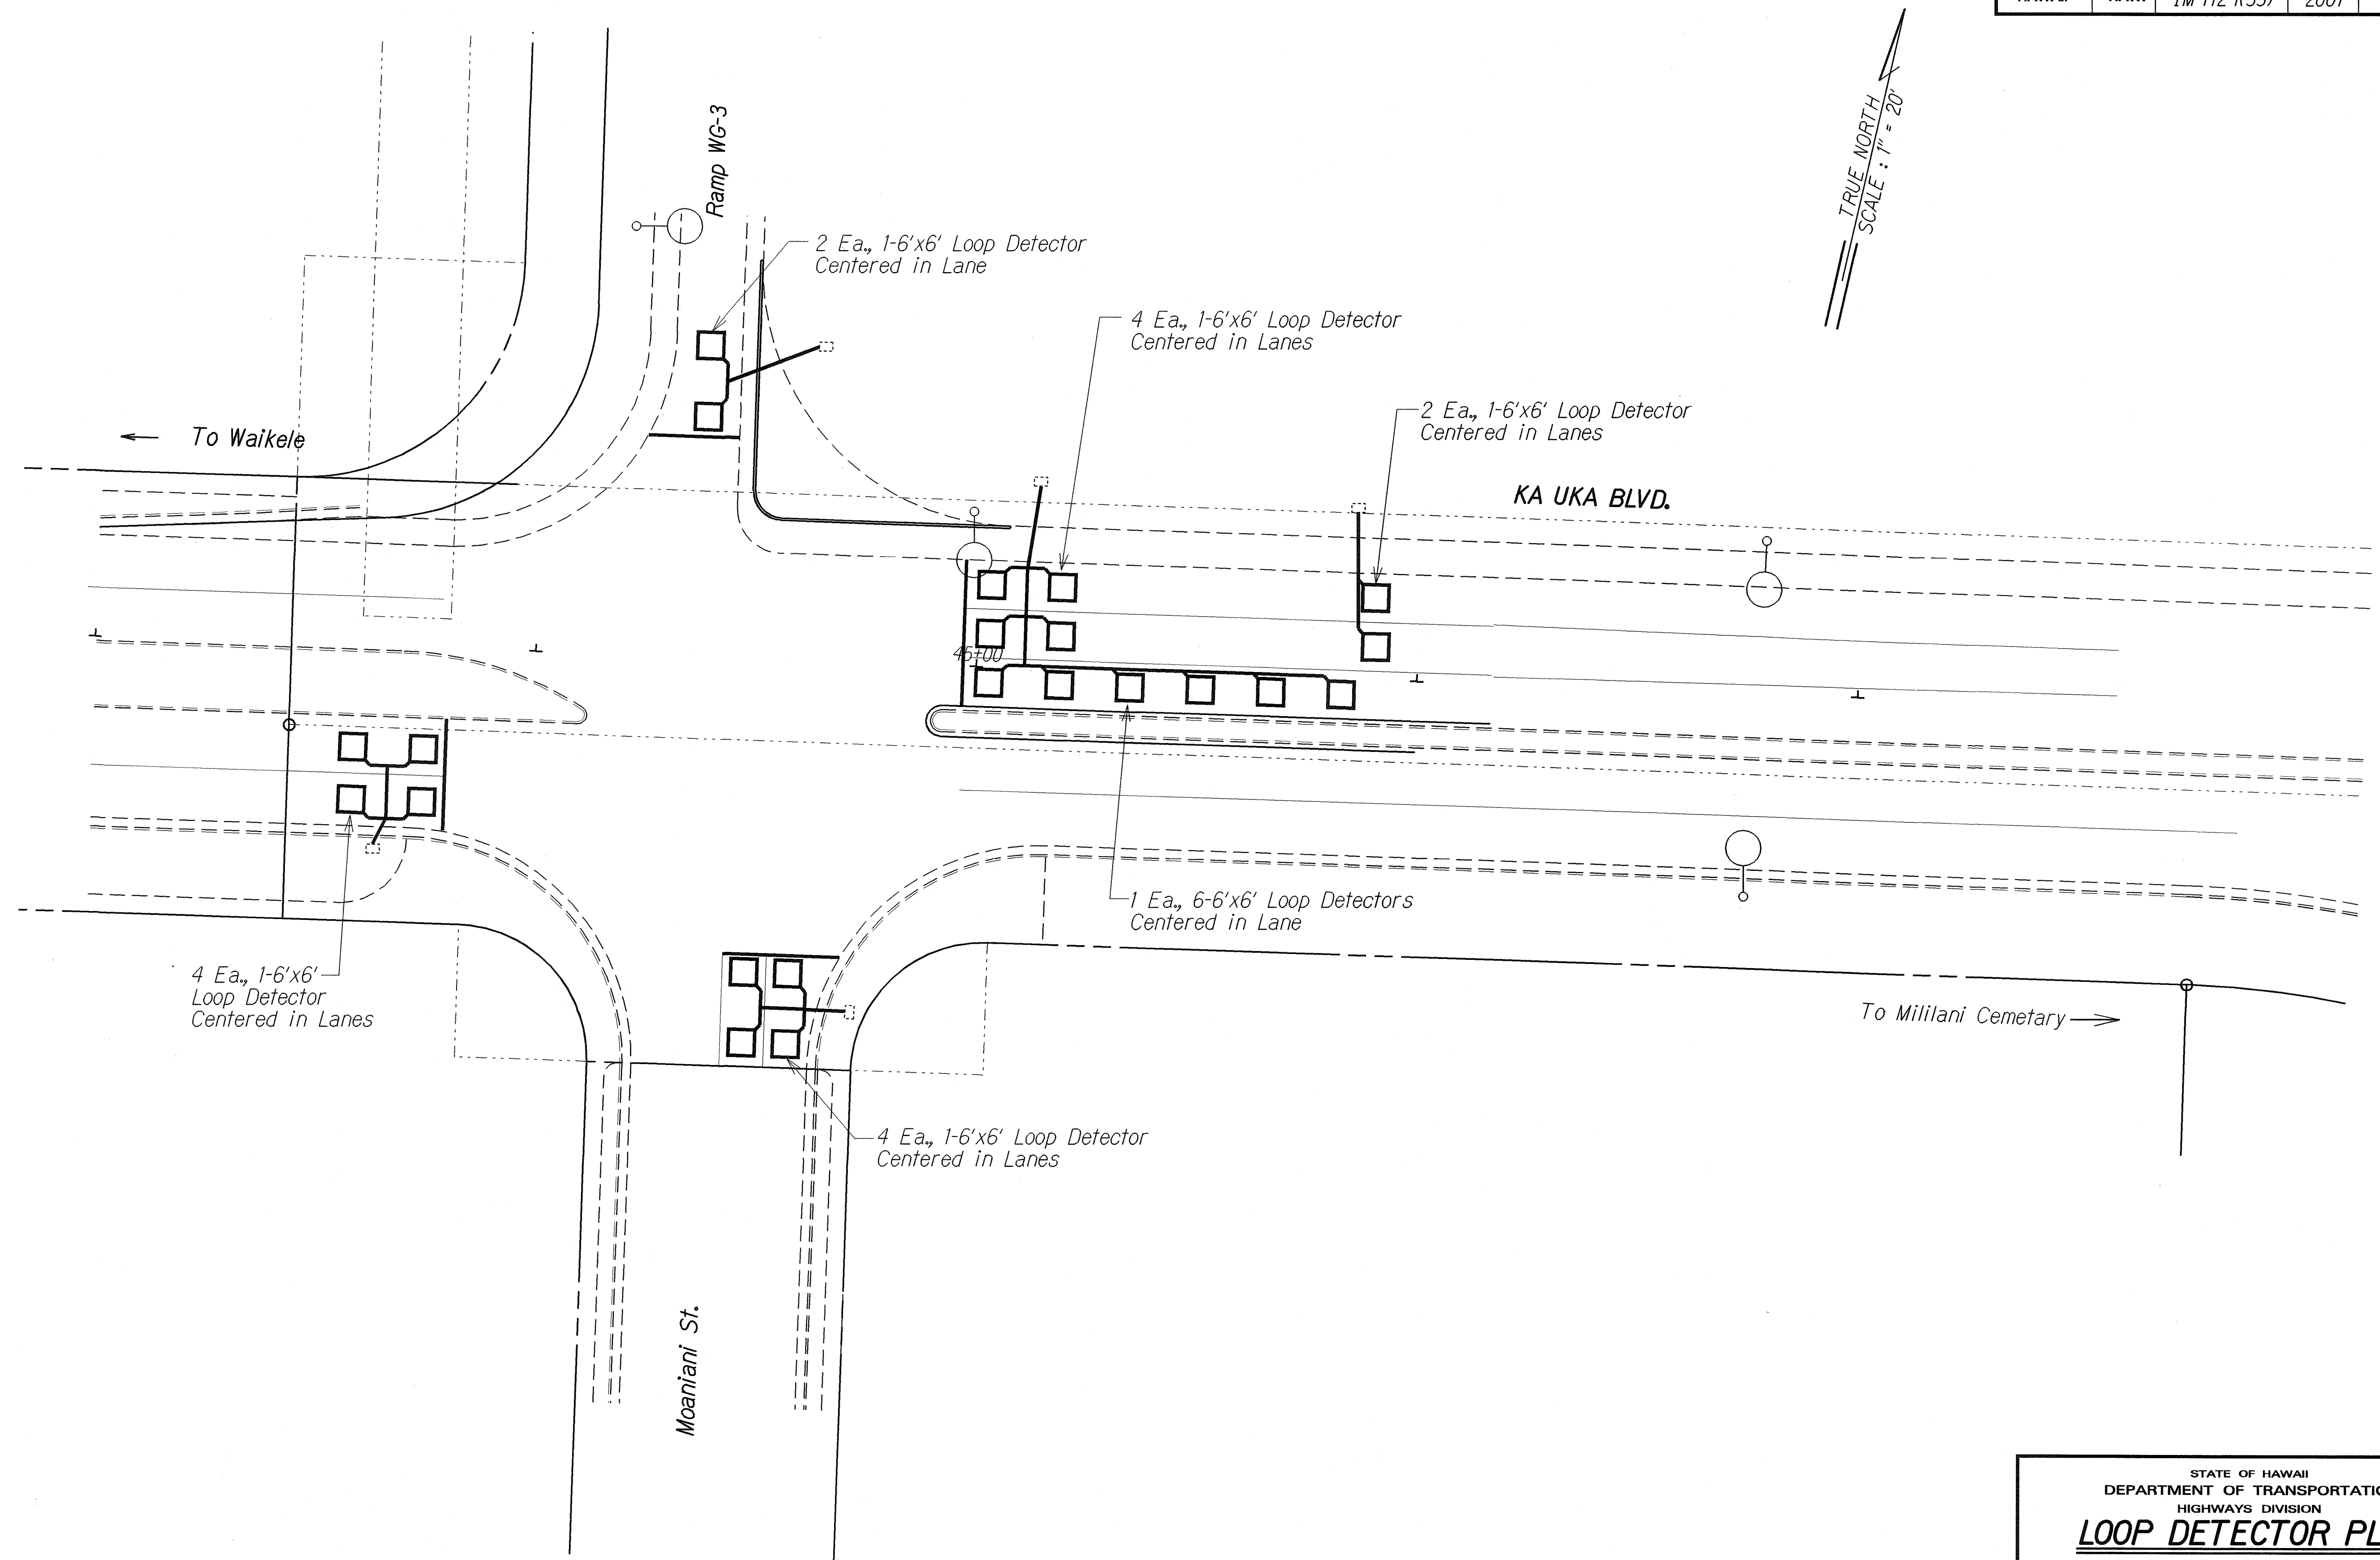

NOTE: Connecting loop cables for loop vehicle detectors shall be incidental to various Contract Items.


ORIGINAL PLAN	DATE
DESIGNED BY	Y
TRACED BY	
DESIGNED BY	
QUANTITIES BY	
CHECKED BY	

5/16/07	Extended leader line on Ramp WG-3.
DATE	REVISION

STATE OF HAWAII DEPARTMENT OF TRANSPORTATION HIGHWAYS DIVISION
LOOP DETECTOR PLAN
INTERSTATE ROUTE H-2 REHABILITATION
Waipio Interchange & Mililani Interchange
On/Off Ramps, Ka Uka Blvd., Meheula Pkwy.
Overpass, & Kipapa Stream Bridge
Federal Aid Project No. IM-H2-1(33)
Scale: 1" = 20' Date: Dec. 2006
SHEET No. T59 OF 63 SHEETS

ADD. 130

FED. ROAD DIST. NO.	STATE	FED. AID PROJ. NO.	FISCAL YEAR	SHEET NO.	TOTAL SHEETS
HAWAII	HAW.	IM-H2-1(33)	2007	131	168

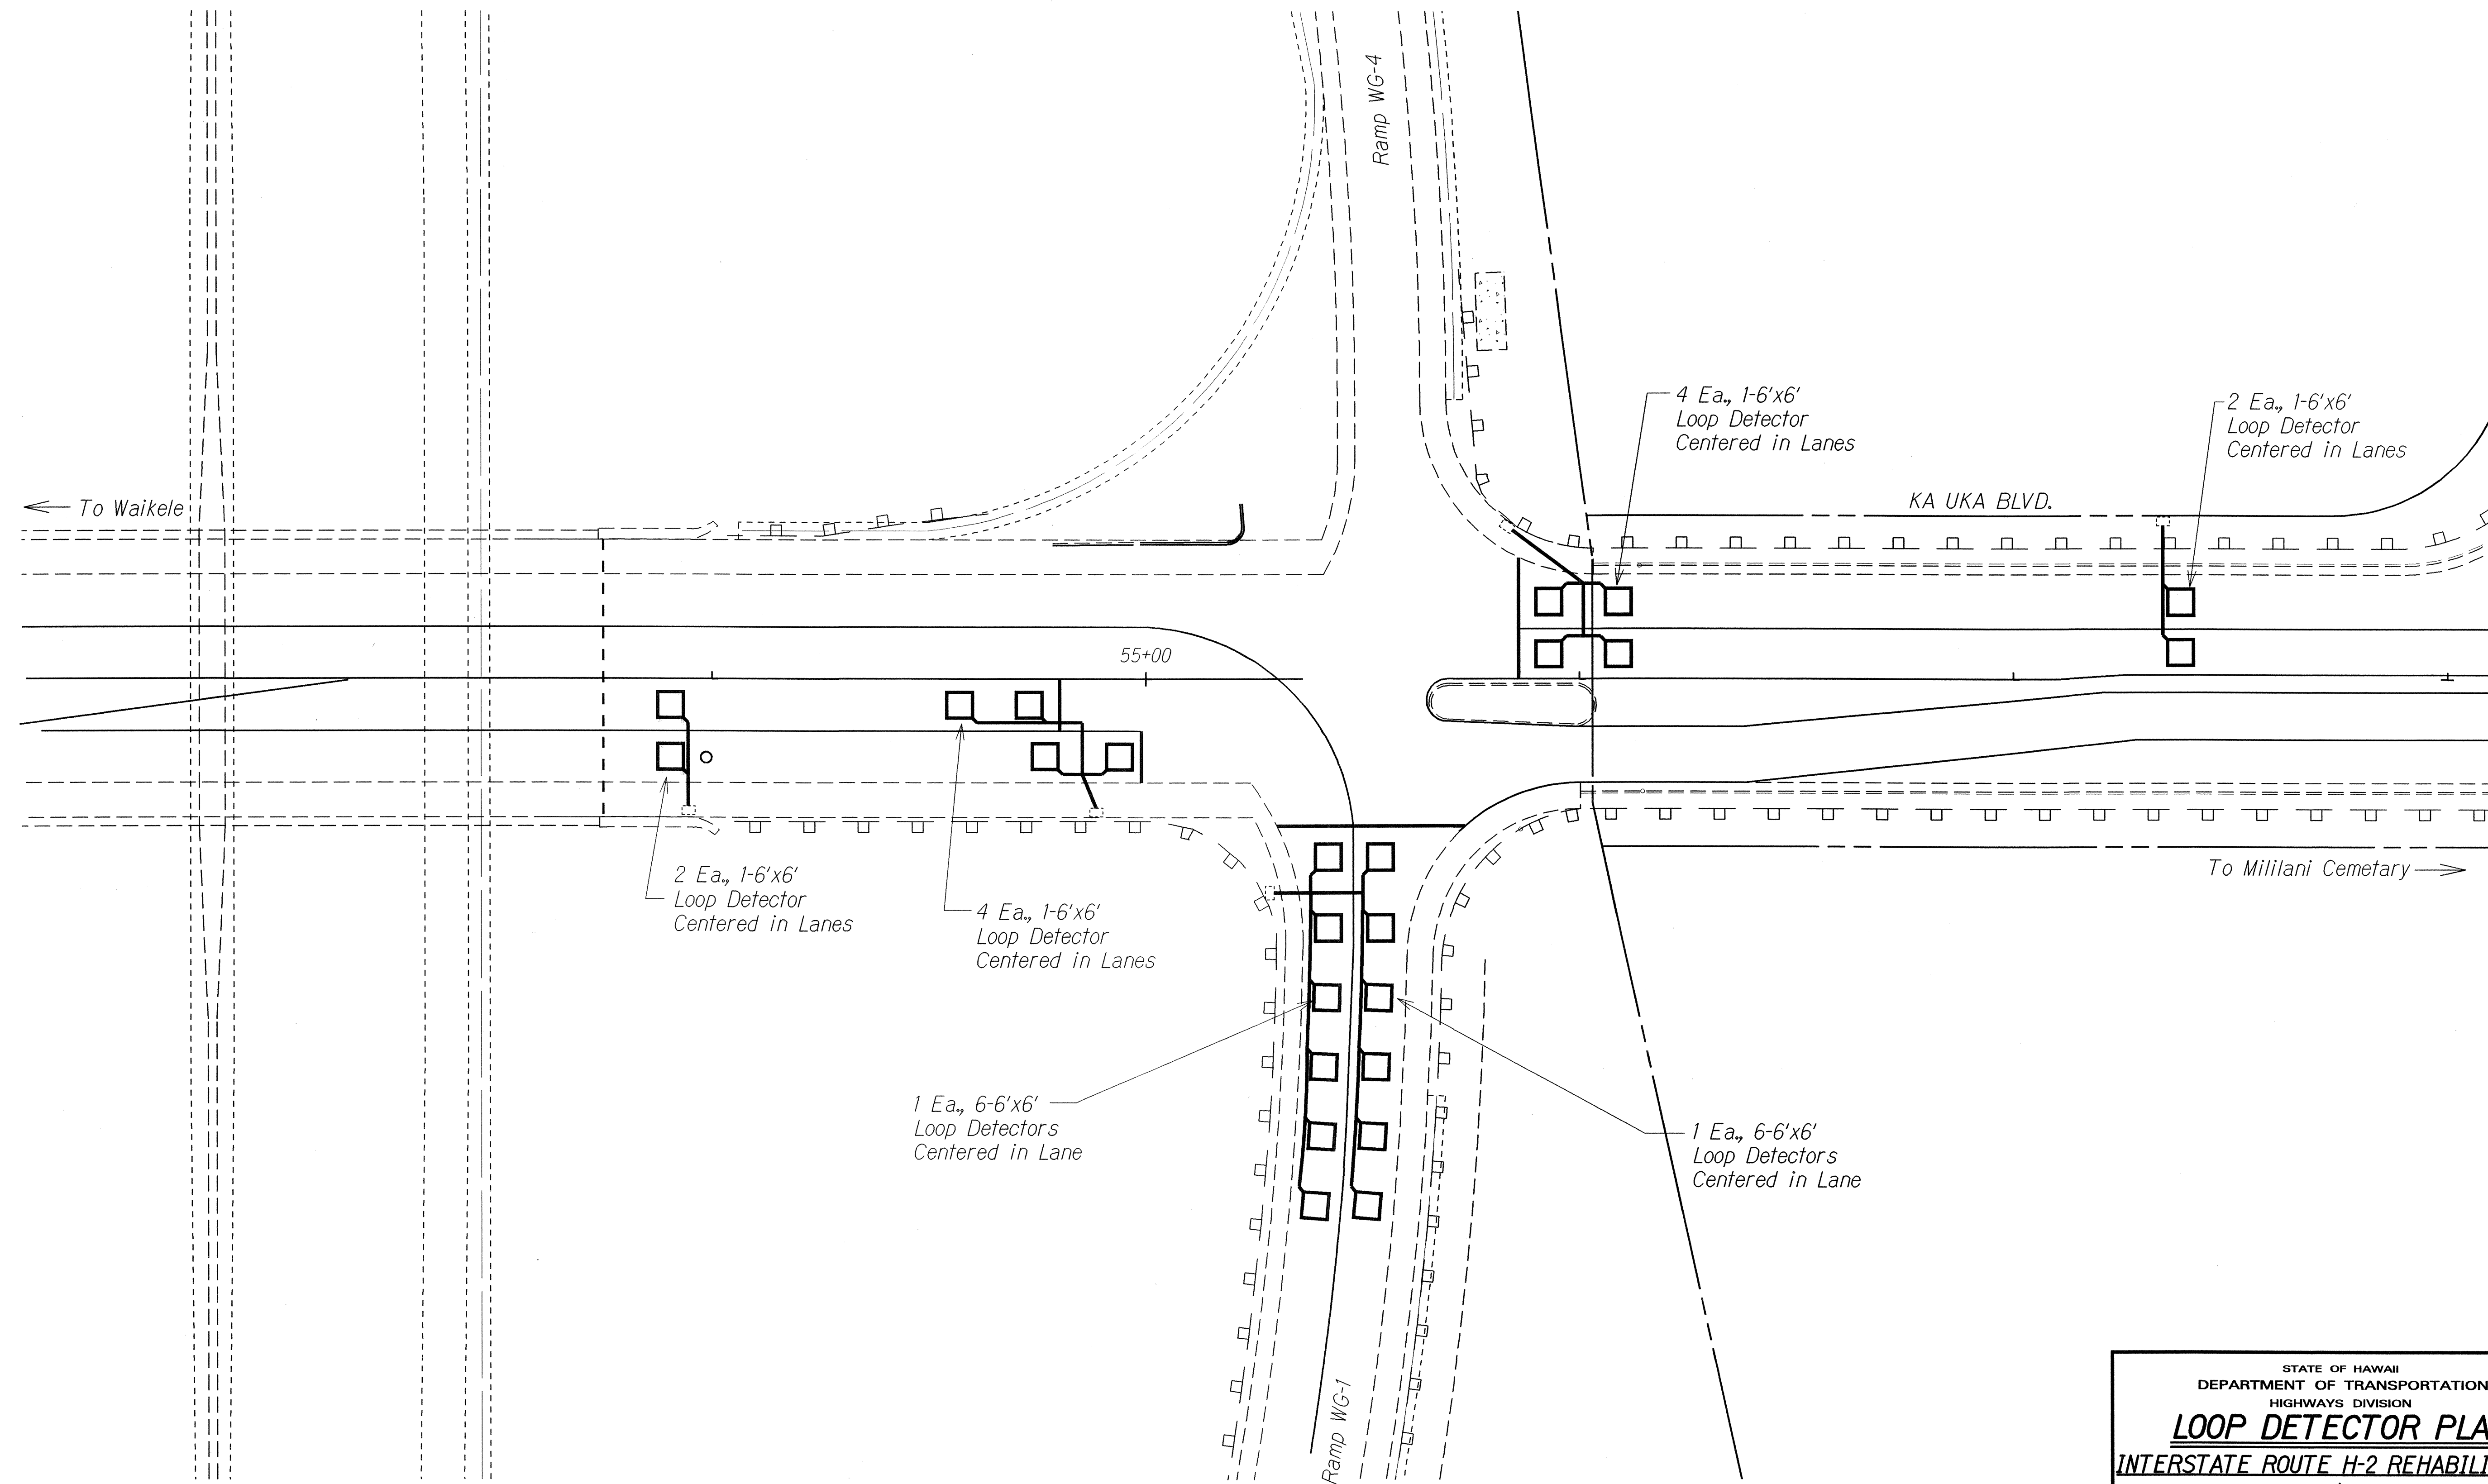

NOTE: Connecting loop cables for loop vehicle detectors shall be incidental to various Contract Items.

ORIGINAL PLAN	SURVEY PLOTTED BY DATE
TRACED BY DATE	DRAWN BY DATE
NOTED BY DATE	CHECKED BY DATE
NO. 4112102	


STATE OF HAWAII
DEPARTMENT OF TRANSPORTATION
HIGHWAYS DIVISION

LOOP DETECTOR PLAN

INTERSTATE ROUTE H-2 REHABILITATION
Waipio Interchange & Millilani Interchange
On/Off Ramps, Ka Uka Blvd., Meheula Pkwy.
Overpass, & Kipapa Stream Bridge
Federal Aid Project No. IM-H2-1(33)
Scale: 1" = 20' Date: Dec. 2006

SHEET No. T60 OF 63 SHEETS

FED. ROAD DIST. NO.	STATE	FED. AID PROJ. NO.	FISCAL YEAR	SHEET NO.	TOTAL SHEETS
HAWAII	HAW.	IM-H2-1(33)	2007	ADD. 132	168

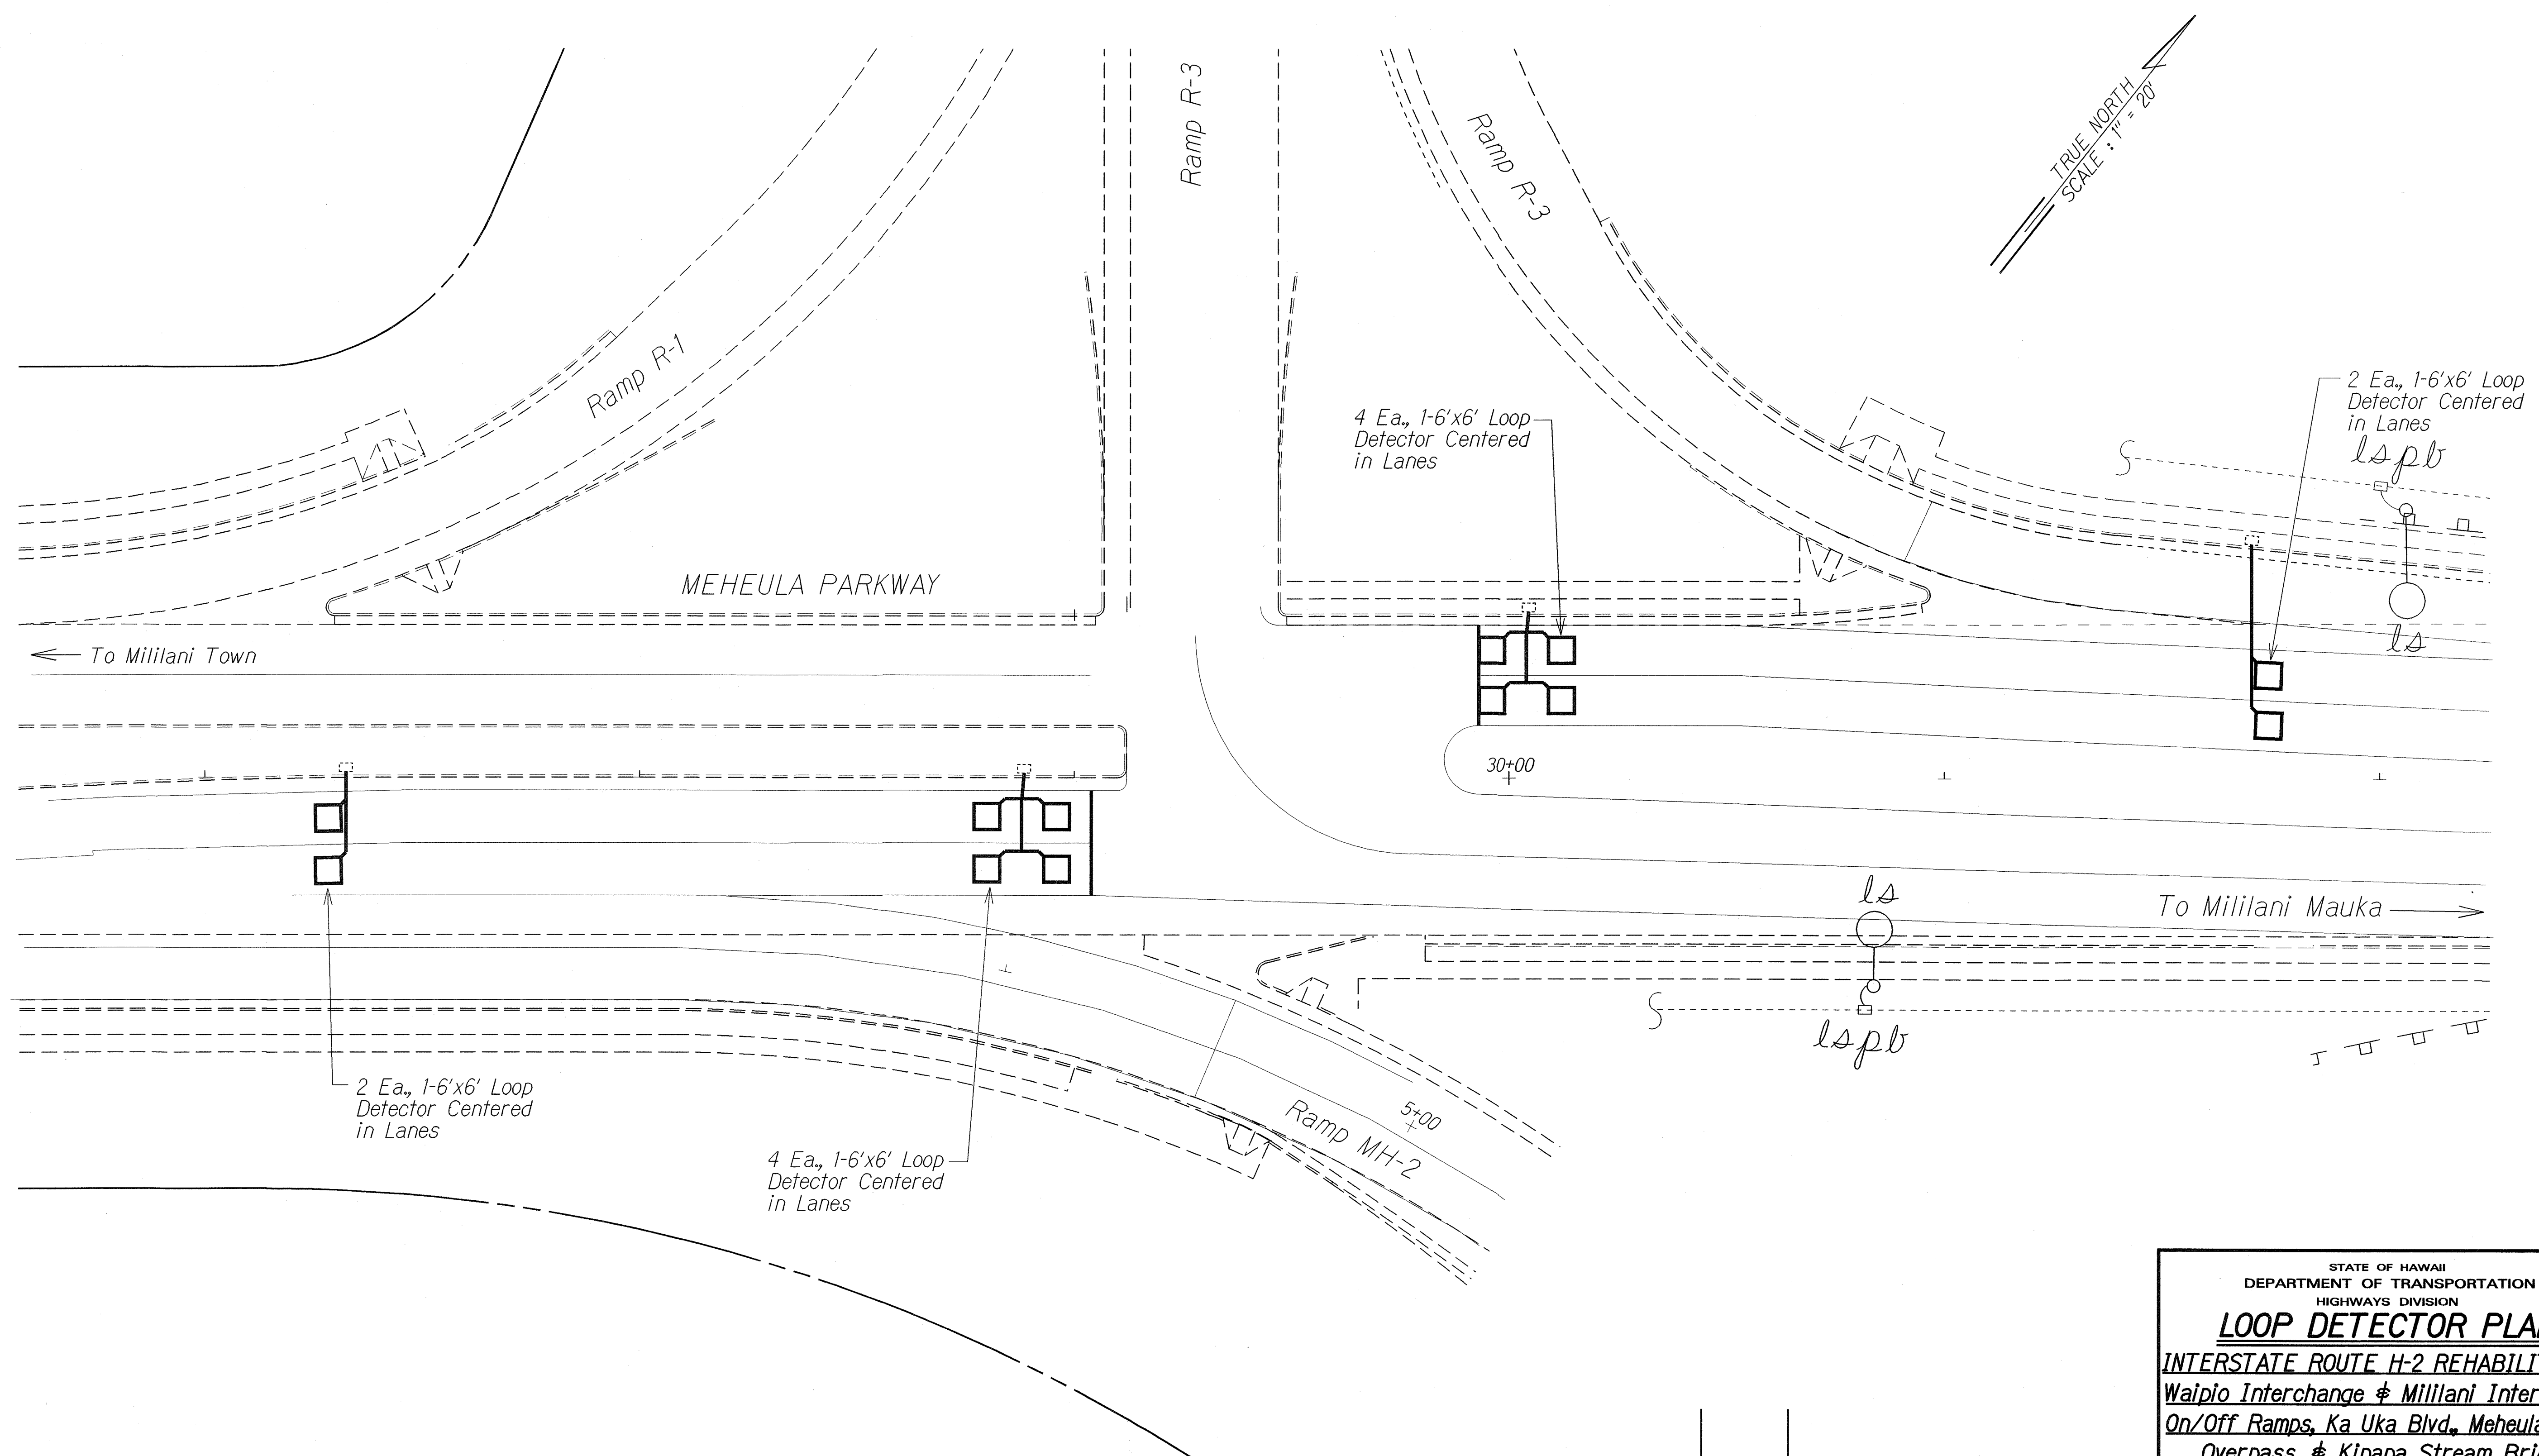

SURVEY PLOTTED BY	DATE
DRAWN BY	
DESIGNED BY	
QUANTITIES BY	
CHECKED BY	
ORIGINAL PLAN	
NOTE BOOK	
10/2/06	
10/2/06	

5/16/07	Removed duplicate @ Sta. 5+00 on Ramp MH-2.
DATE	REVISION

STATE OF HAWAII
DEPARTMENT OF TRANSPORTATION
HIGHWAYS DIVISION

LOOP DETECTOR PLAN

INTERSTATE ROUTE H-2 REHABILITATION

Waipio Interchange & Millani Interchange

On/Off Ramps, Ka Uka Blvd., Meheula Pkwy.


Overpass, & Kipapa Stream Bridge

Federal Aid Project No. IM-H2-1(33)

Scale: 1" = 20' Date: Dec. 2006

SHEET No. 161 OF 63 SHEETS

FED. ROAD DIST. NO.	STATE	FED. AID PROJ. NO.	FISCAL YEAR	SHEET NO.	TOTAL SHEETS
HAWAII	HAW.	IM-H2-1(33)	2007	ADD. 133	168

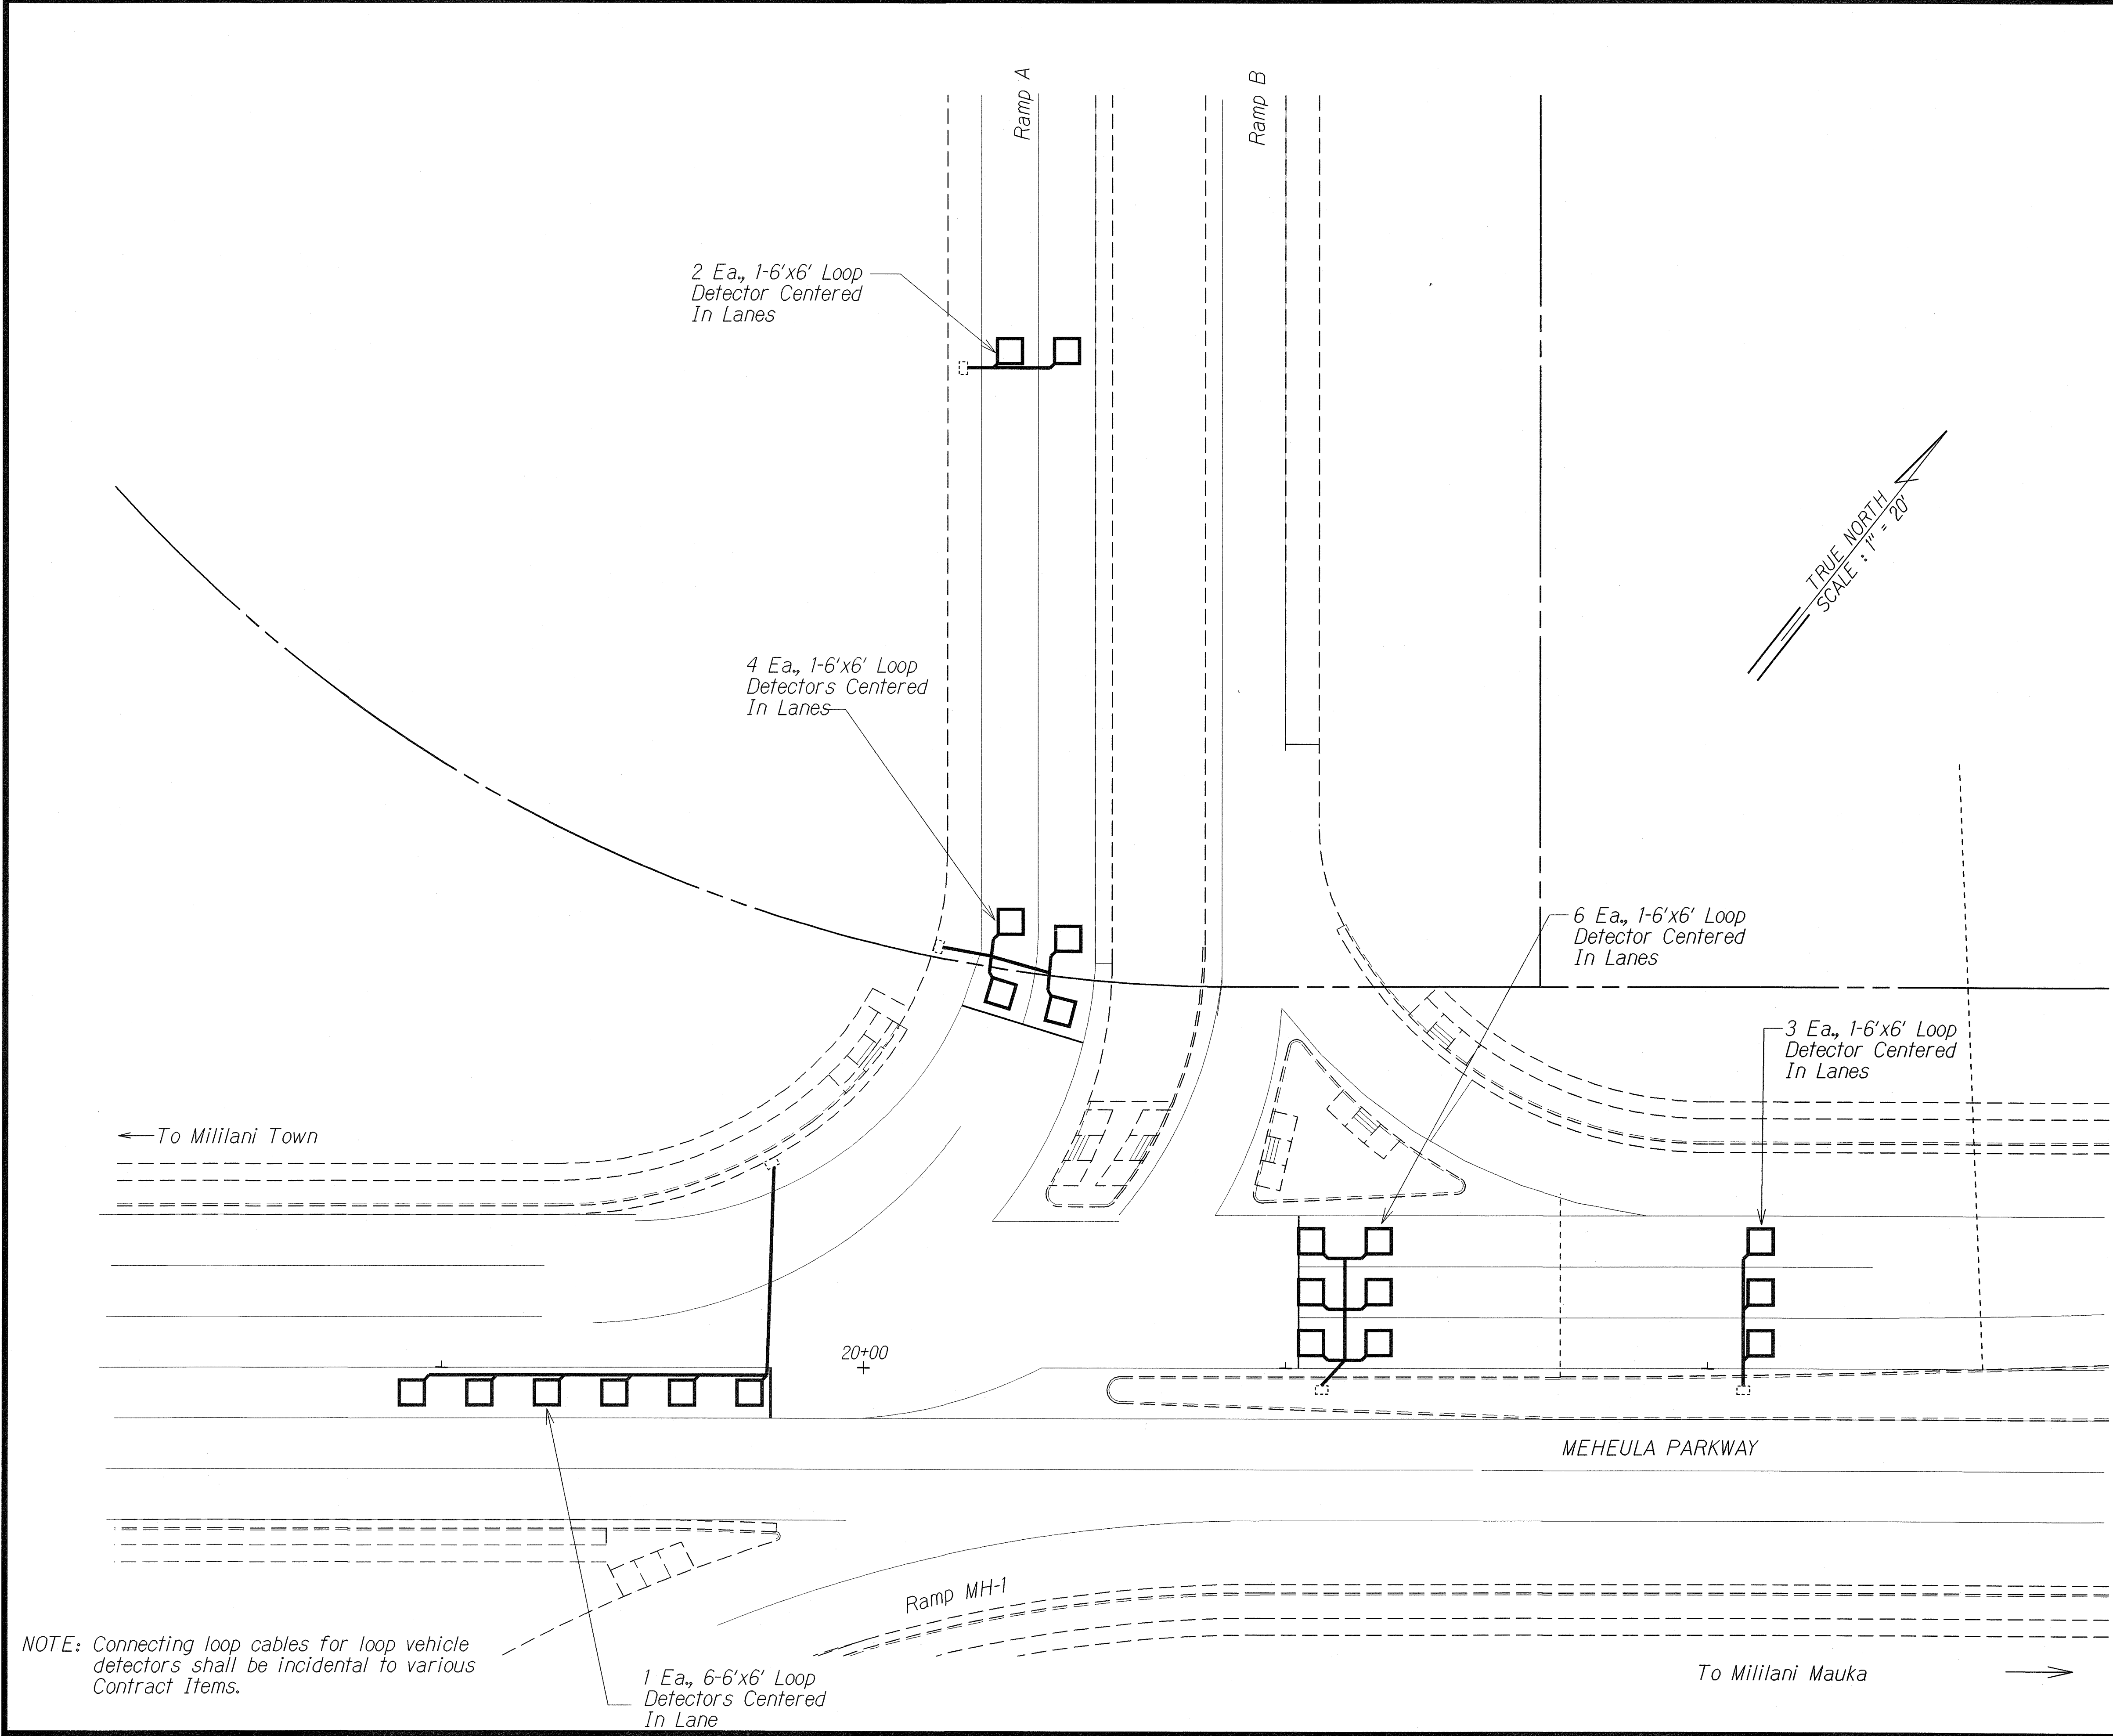

5/16/07 Revised call outs for Loop Detectors on Ramp A.

DATE REVISION

STATE OF HAWAII
DEPARTMENT OF TRANSPORTATION
HIGHWAYS DIVISION
LOOP DETECTOR PLAN
INTERSTATE ROUTE H-2 REHABILITATION
Waipio Interchange & Mililani Interchange
On/Off Ramps, Ka Uka Blvd., Meheula Pkwy.
Overpass, & Kipapa Stream Bridge
Federal Aid Project No. IM-H2-1(33)
Scale: 1" = 20' Date: Dec. 2006

SHEET No. T62 OF 63 SHEETS

ADD. 133