



FED. ROAD DIST. NO.	STATE	FED. AID PROJ. NO.	FISCAL YEAR	SHEET NO.	TOTAL SHEETS
HAWAII	HAW.	IM-H2-1(33)	2007	ADD. 113	168

LEGEND

- 4 each Type A Raised Pavement Markers
Type C Raised Pavement Markers @ 40'-0" o.c.
- 4 each Type J Raised Pavement Markers
Type D Raised Pavement Markers @ 40'-0" o.c.
- 8" White Stripe with Type C Raised Pavement Markers @ 20'-0" o.c. (Tape, Type I or Thermoplastic Extrusion)
- 4" Double Solid Yellow with Type D Raised Pavement Markers @ 20'-0" o.c. (Tape, Type I or Thermoplastic Extrusion))
- 4" Double Solid Yellow Stripes with Type H Raised Pavement Markers @ 20'-0" o.c. (Tape, Type II or Thermoplastic Extrusion))
- 4" Yellow Edge Stripe with Type H Raised Pavement Markers @ 40'-0" o.c. (Tape, Type II or Thermoplastic Extrusion))
- 4" Double Solid White Stripes with Type C Raised Pavement Markers @ 20'-0" o.c. (Tape, Type I or Thermoplastic Extrusion)
- Lane Change Restriction Marking
4 each Type A Raised Pavement Markers
Type C Raised Pavement Markers @ 20'-0" o.c.
4" White Stripe (Tape, Type I or Thermoplastic Extrusion)
- 4" or 8" White Edge Stripe with Type C Raised Pavement Markers @ 40'-0" o.c. (Tape, Type II or Thermoplastic Extrusion)
- 4" White Guide Lines (Tape, Type III or Thermoplastic Extrusion except for bus bays)
- Transverse Median Marking (Tape, Type II or Thermoplastic Extrusion)
- Transverse Shoulder Marking (Tape, Type II or Thermoplastic Extrusion)
- Channelizing Island or Deceleration Lane Gore (Tape, Type II or Thermoplastic Extrusion)
- Crosswalk and Stop Line. All Stop Lines shall be 10'-0" from Crosswalk unless otherwise noted. The circled number indicates the number of lanes for payment (Tape, Type III or Thermoplastic Extrusion)
- Pavement Arrow (Tape, Type III or Thermoplastic Extrusion)
- Pavement Word (Tape, Type III or Thermoplastic Extrusion)
- 4 Each Type J Raised Pavement Markers
Type D Raised Pavement Markers @ 40'-0" o.c.
Type H Raised Pavement Markers (Reflective Surface facing no-passing direction)
4" Single Solid Yellow Stripe (Tape, Type I or Thermoplastic Extrusion)
- Extension of Edge Line, 4" Wide x 2'-0" Long White Stripe @ 10'-0" o.c. w/Type C Markers @ 40'-0" o.c. (Tape, Type III or Thermoplastic Extrusion)
- Reflector Marker (RM-5) Mounted on Existing Metal Guardrail



NOTES

- Layout of pavement markings and striping shall be done by the Contractor and approved by the Engineer prior to any installation work.
- Existing pavement markings not incorporated in the final traffic pattern shall be removed as directed by the Engineer. Costs shall be incidental to the various pavement marking items.
- Raised pavement markers shall not be installed within crosswalks.
- Final locations of all signs shall be approved by the Engineer prior to any installation work.
- Existing signs not shown on these plans shall remain as posted unless otherwise directed by the Engineer. Removal and disposal of existing signs and/or posts as designated on these plans shall be incidental to the various signing items.
- Final locations of all Stop Lines shall be approved by the Engineer prior to installation.
- All pavement striping shall be as noted on the legend or plans.
- All preformed pavement marking tapes over existing pavement shall be applied with an approved primer as recommended by the tape manufacturer and as approved by the Engineer. The primer shall be allowed to dry to the tacky stage prior to tape application.
- The Contractor shall erect at the beginning of the project and at the end of the project advance construction warning signs placed as indicated on the plans or as directed by the Engineer for the duration of the highway project and shall be maintained by the Contractor. These signs shall be placed in addition to the required traffic control signs called for in Section 645 - Traffic Control. The advance construction warning signs shall be new and become the property of the State. The Contractor shall remove, clean, and deliver the signs and posts to the District Baseyard, or as directed by the Engineer, upon the completion of the project.

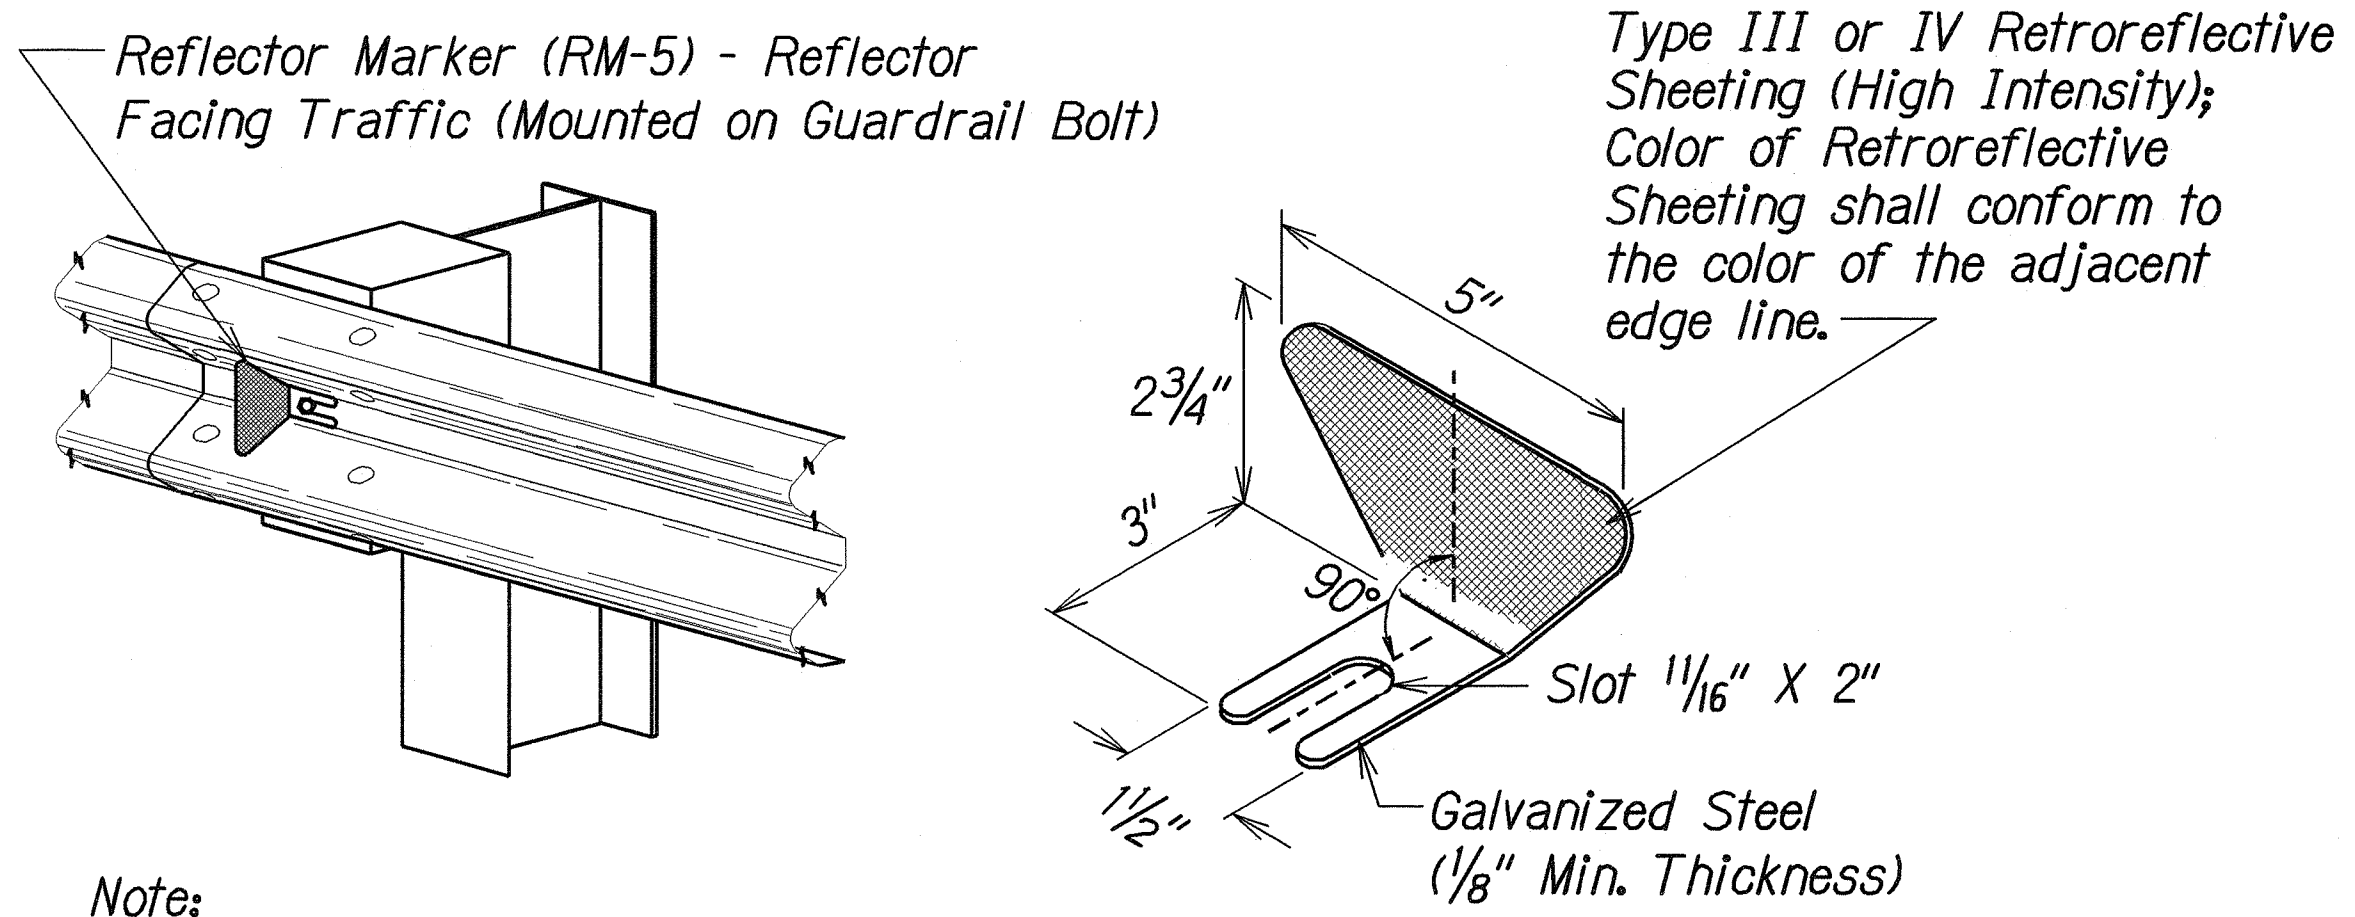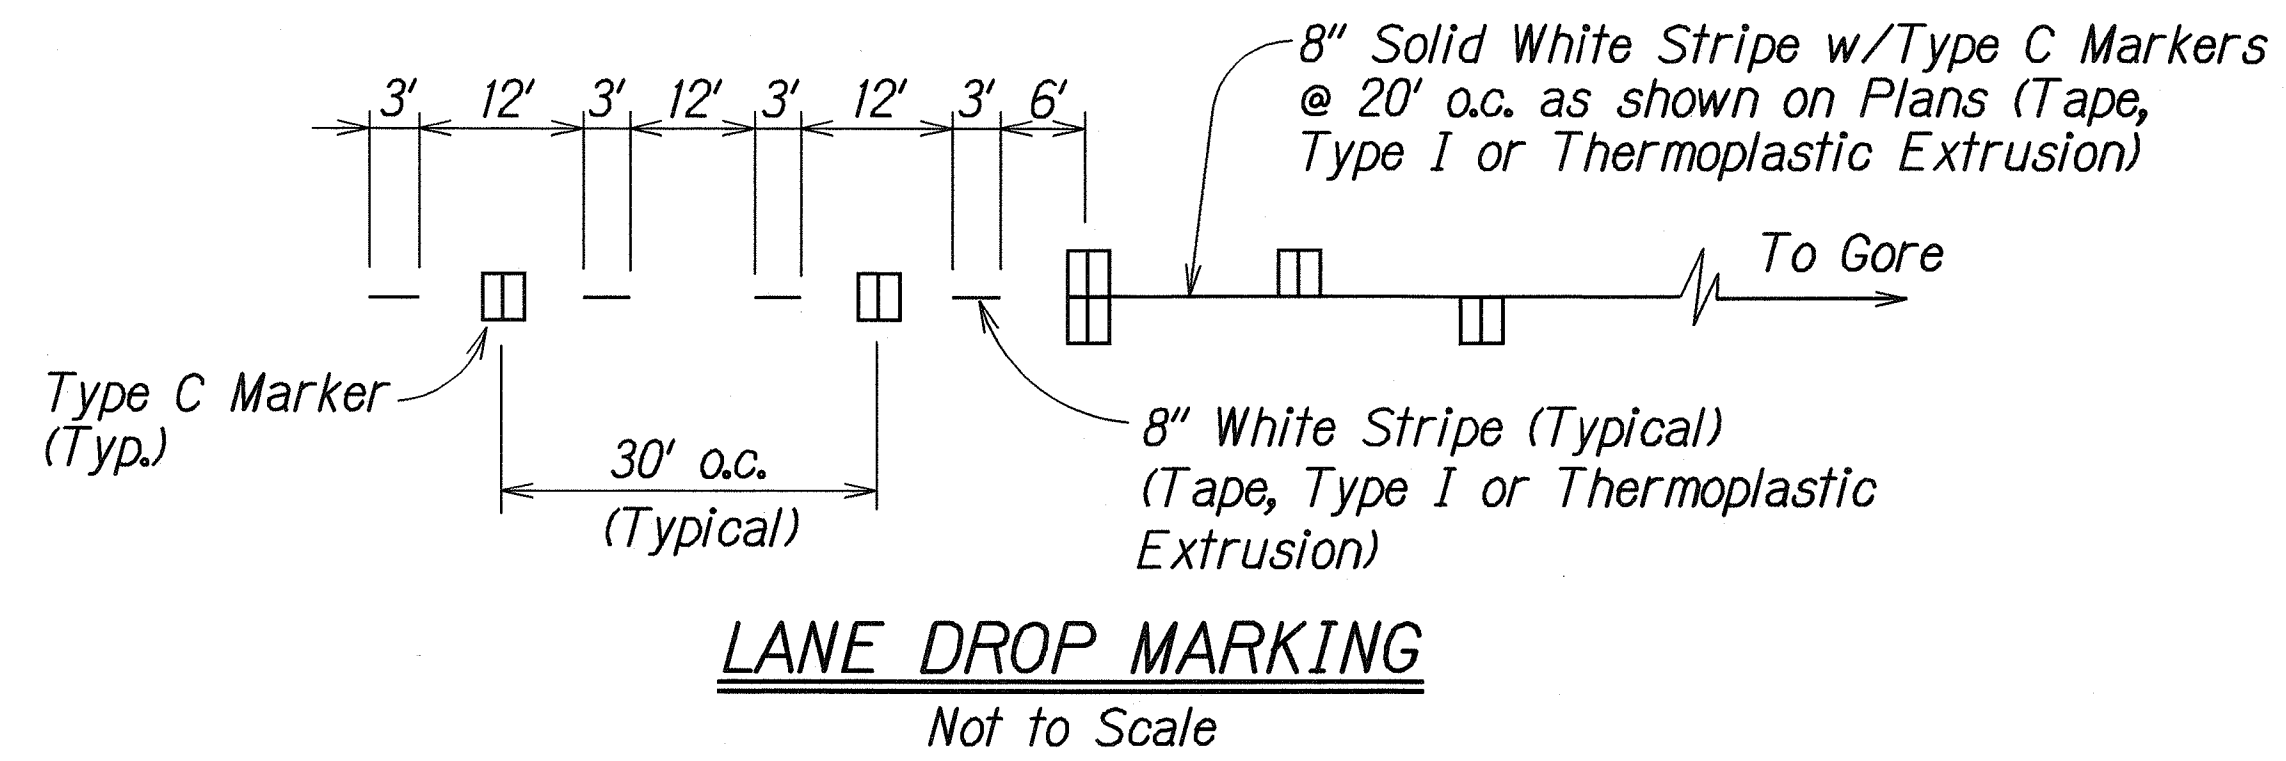


Note:
Reflector Markers (RM-5) mounted on guardrails shall be spaced every 25 feet. RM-5's shall not be installed on Terminal Sections. Furnishing and installing of each RM-5 shall be paid for under Item No. 632.4200 - Reflector Marker (RM-5). The Contractor shall be responsible for mounting RM-5's on all existing metal guardrails even when not shown on the plans.

REFLECTOR MARKER (RM-5) DETAIL AND TYPICAL INSTALLATION

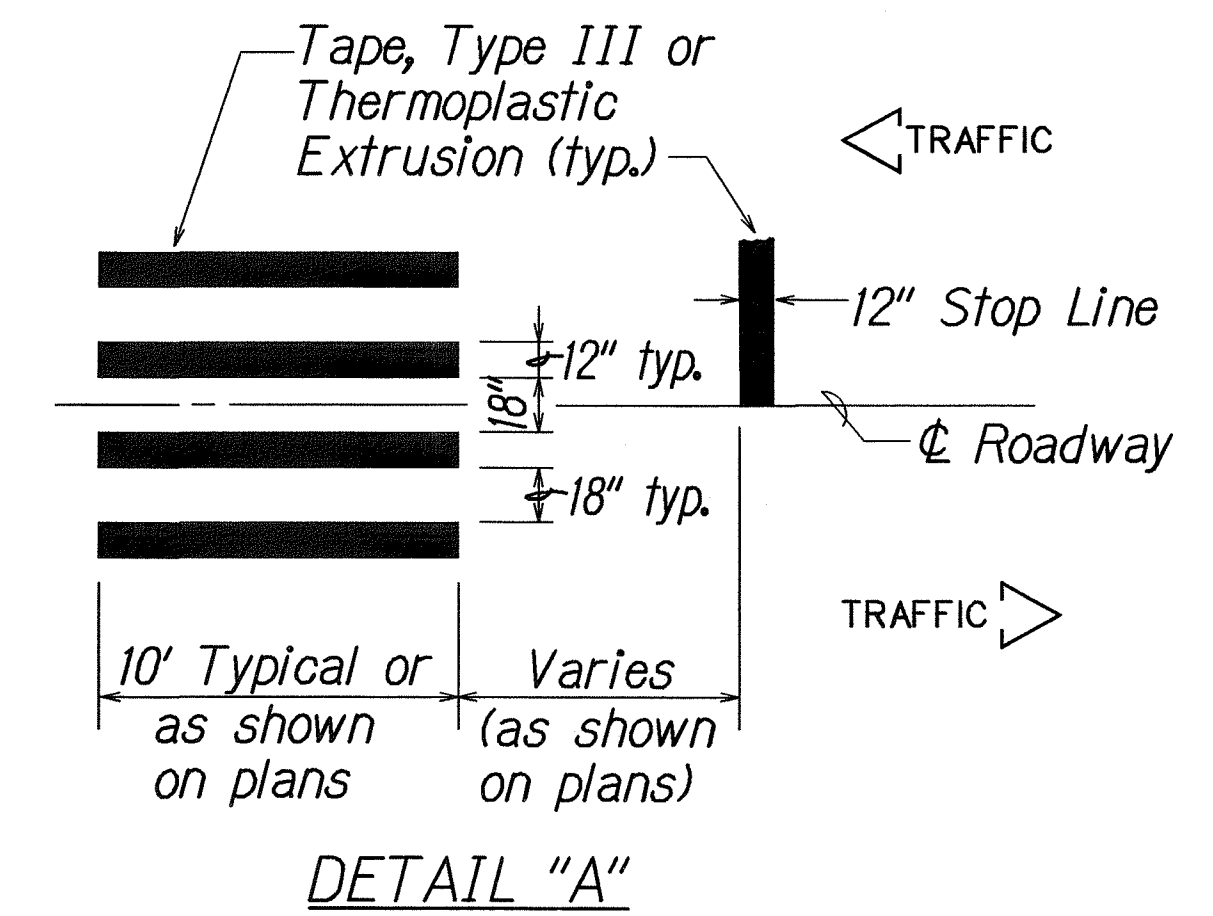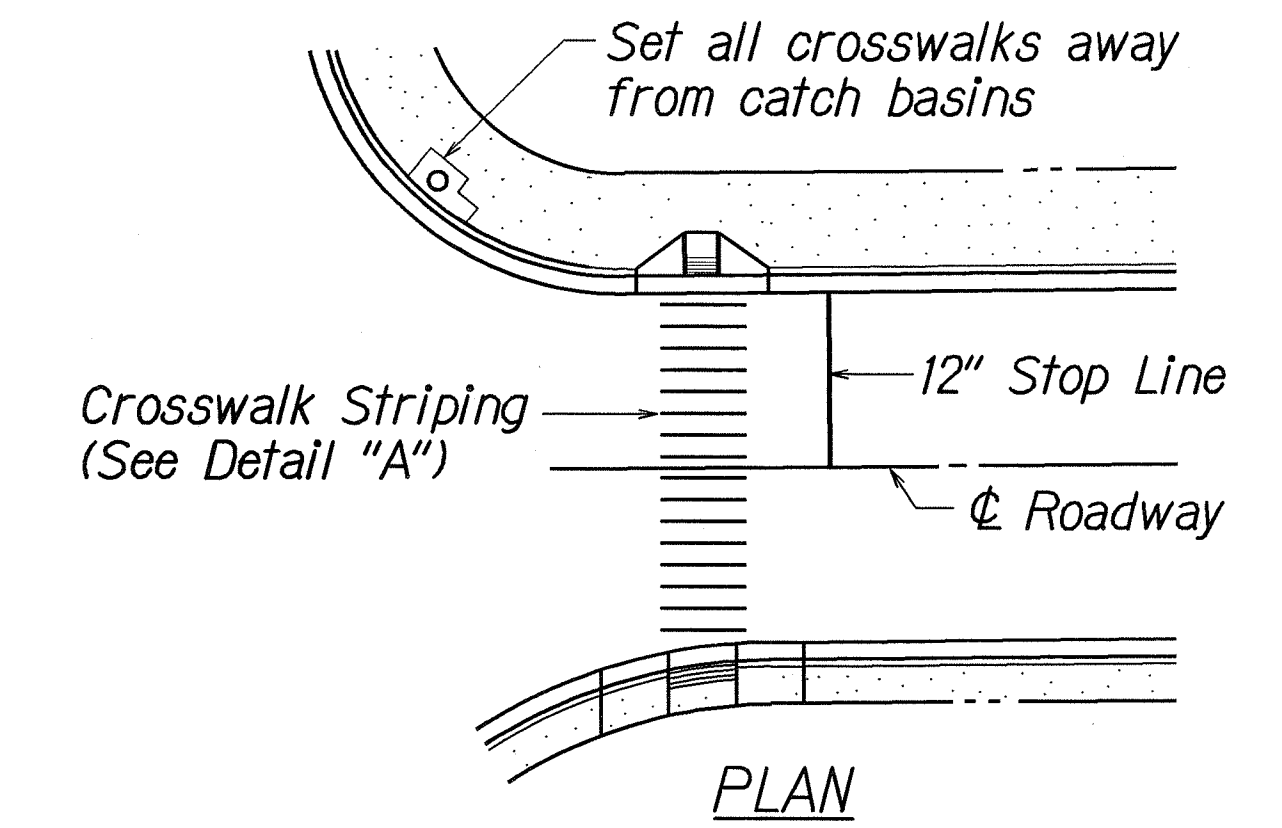

CROSSWALK STRIPING DETAIL

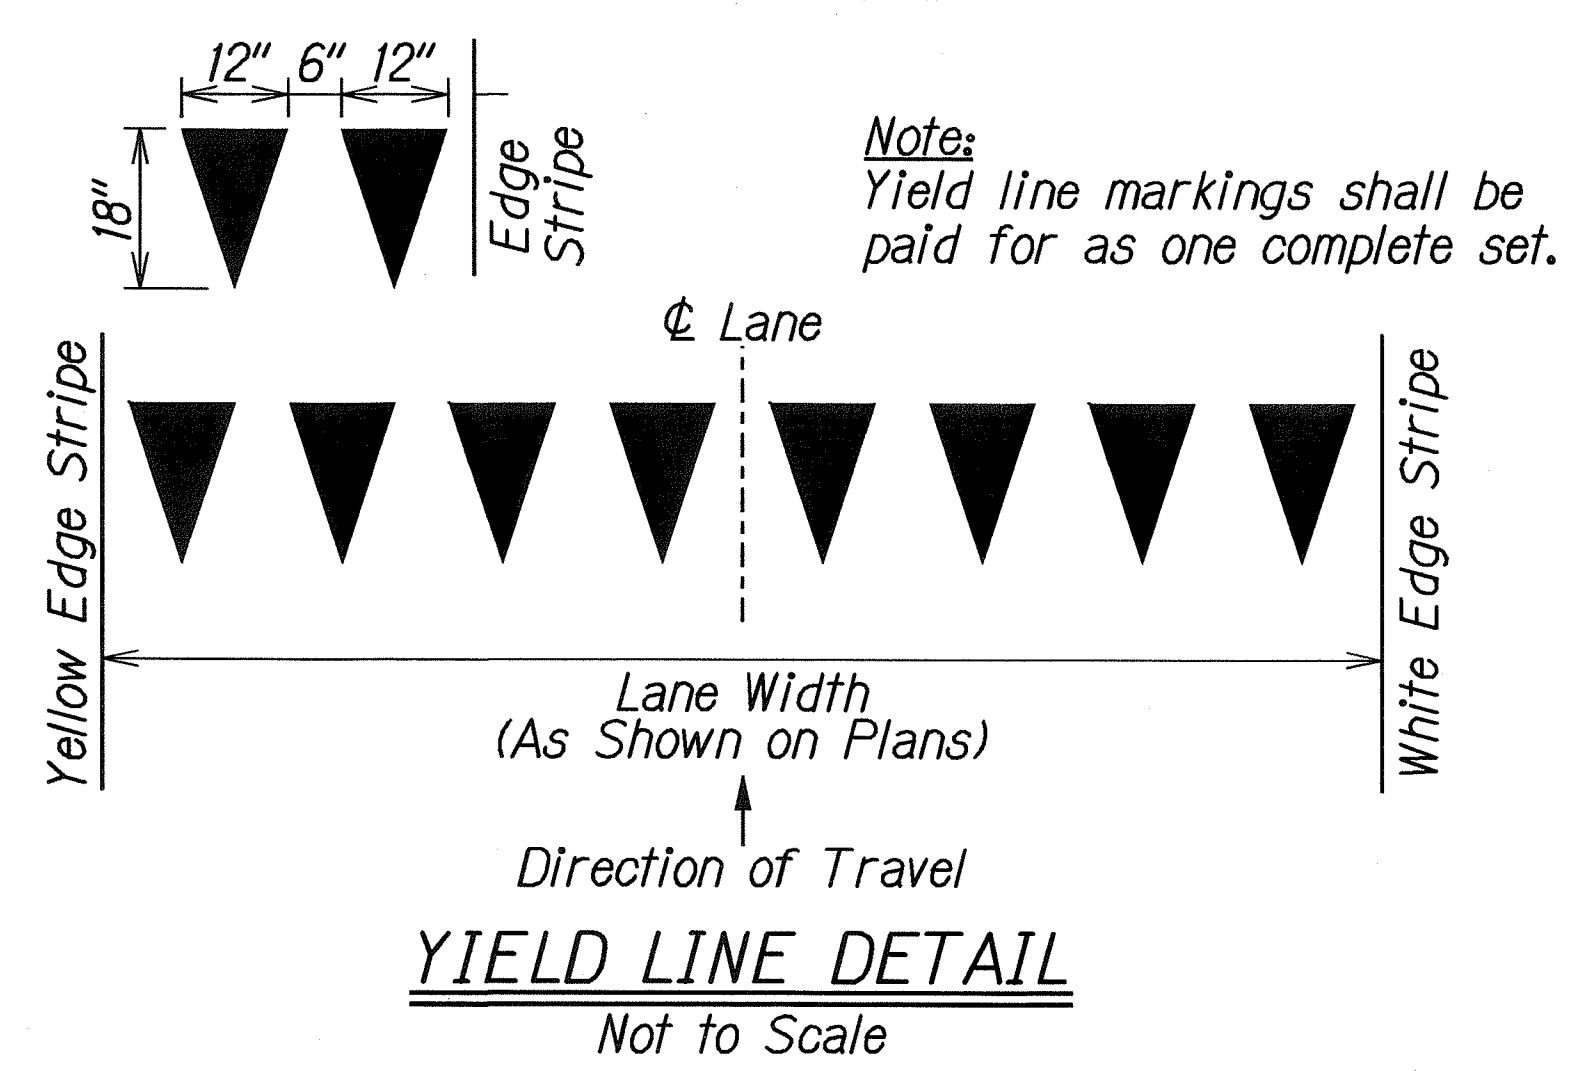


STATE OF HAWAII
DEPARTMENT OF TRANSPORTATION
HIGHWAYS DIVISION

PAVEMENT MARKING
LEGEND, DETAILS & NOTES
INTERSTATE ROUTE H-2 REHABILITATION
Waipio Interchange & Milliani Interchange
On/Off Ramps, Ka Uka Blvd., Meheula Pkwy.
Overpass, & Kipapa Stream Bridge
Federal Aid Project No. IM-H2-1(33)
Scale: 1" = 40' Date: Dec. 2006

DATE	REVISION
5/16/07	Revised pay Item No. in note for Reflector Marker (RM-5) Detail. Added Note and revised title for Yield Line Detail.

FED. ROAD DIST. NO.	STATE	FED. AID PROJ. NO.	FISCAL YEAR	SHEET NO.	TOTAL SHEETS
HAWAII	HAW.	IM-H2-1(33)	2007	ADD. 115	168

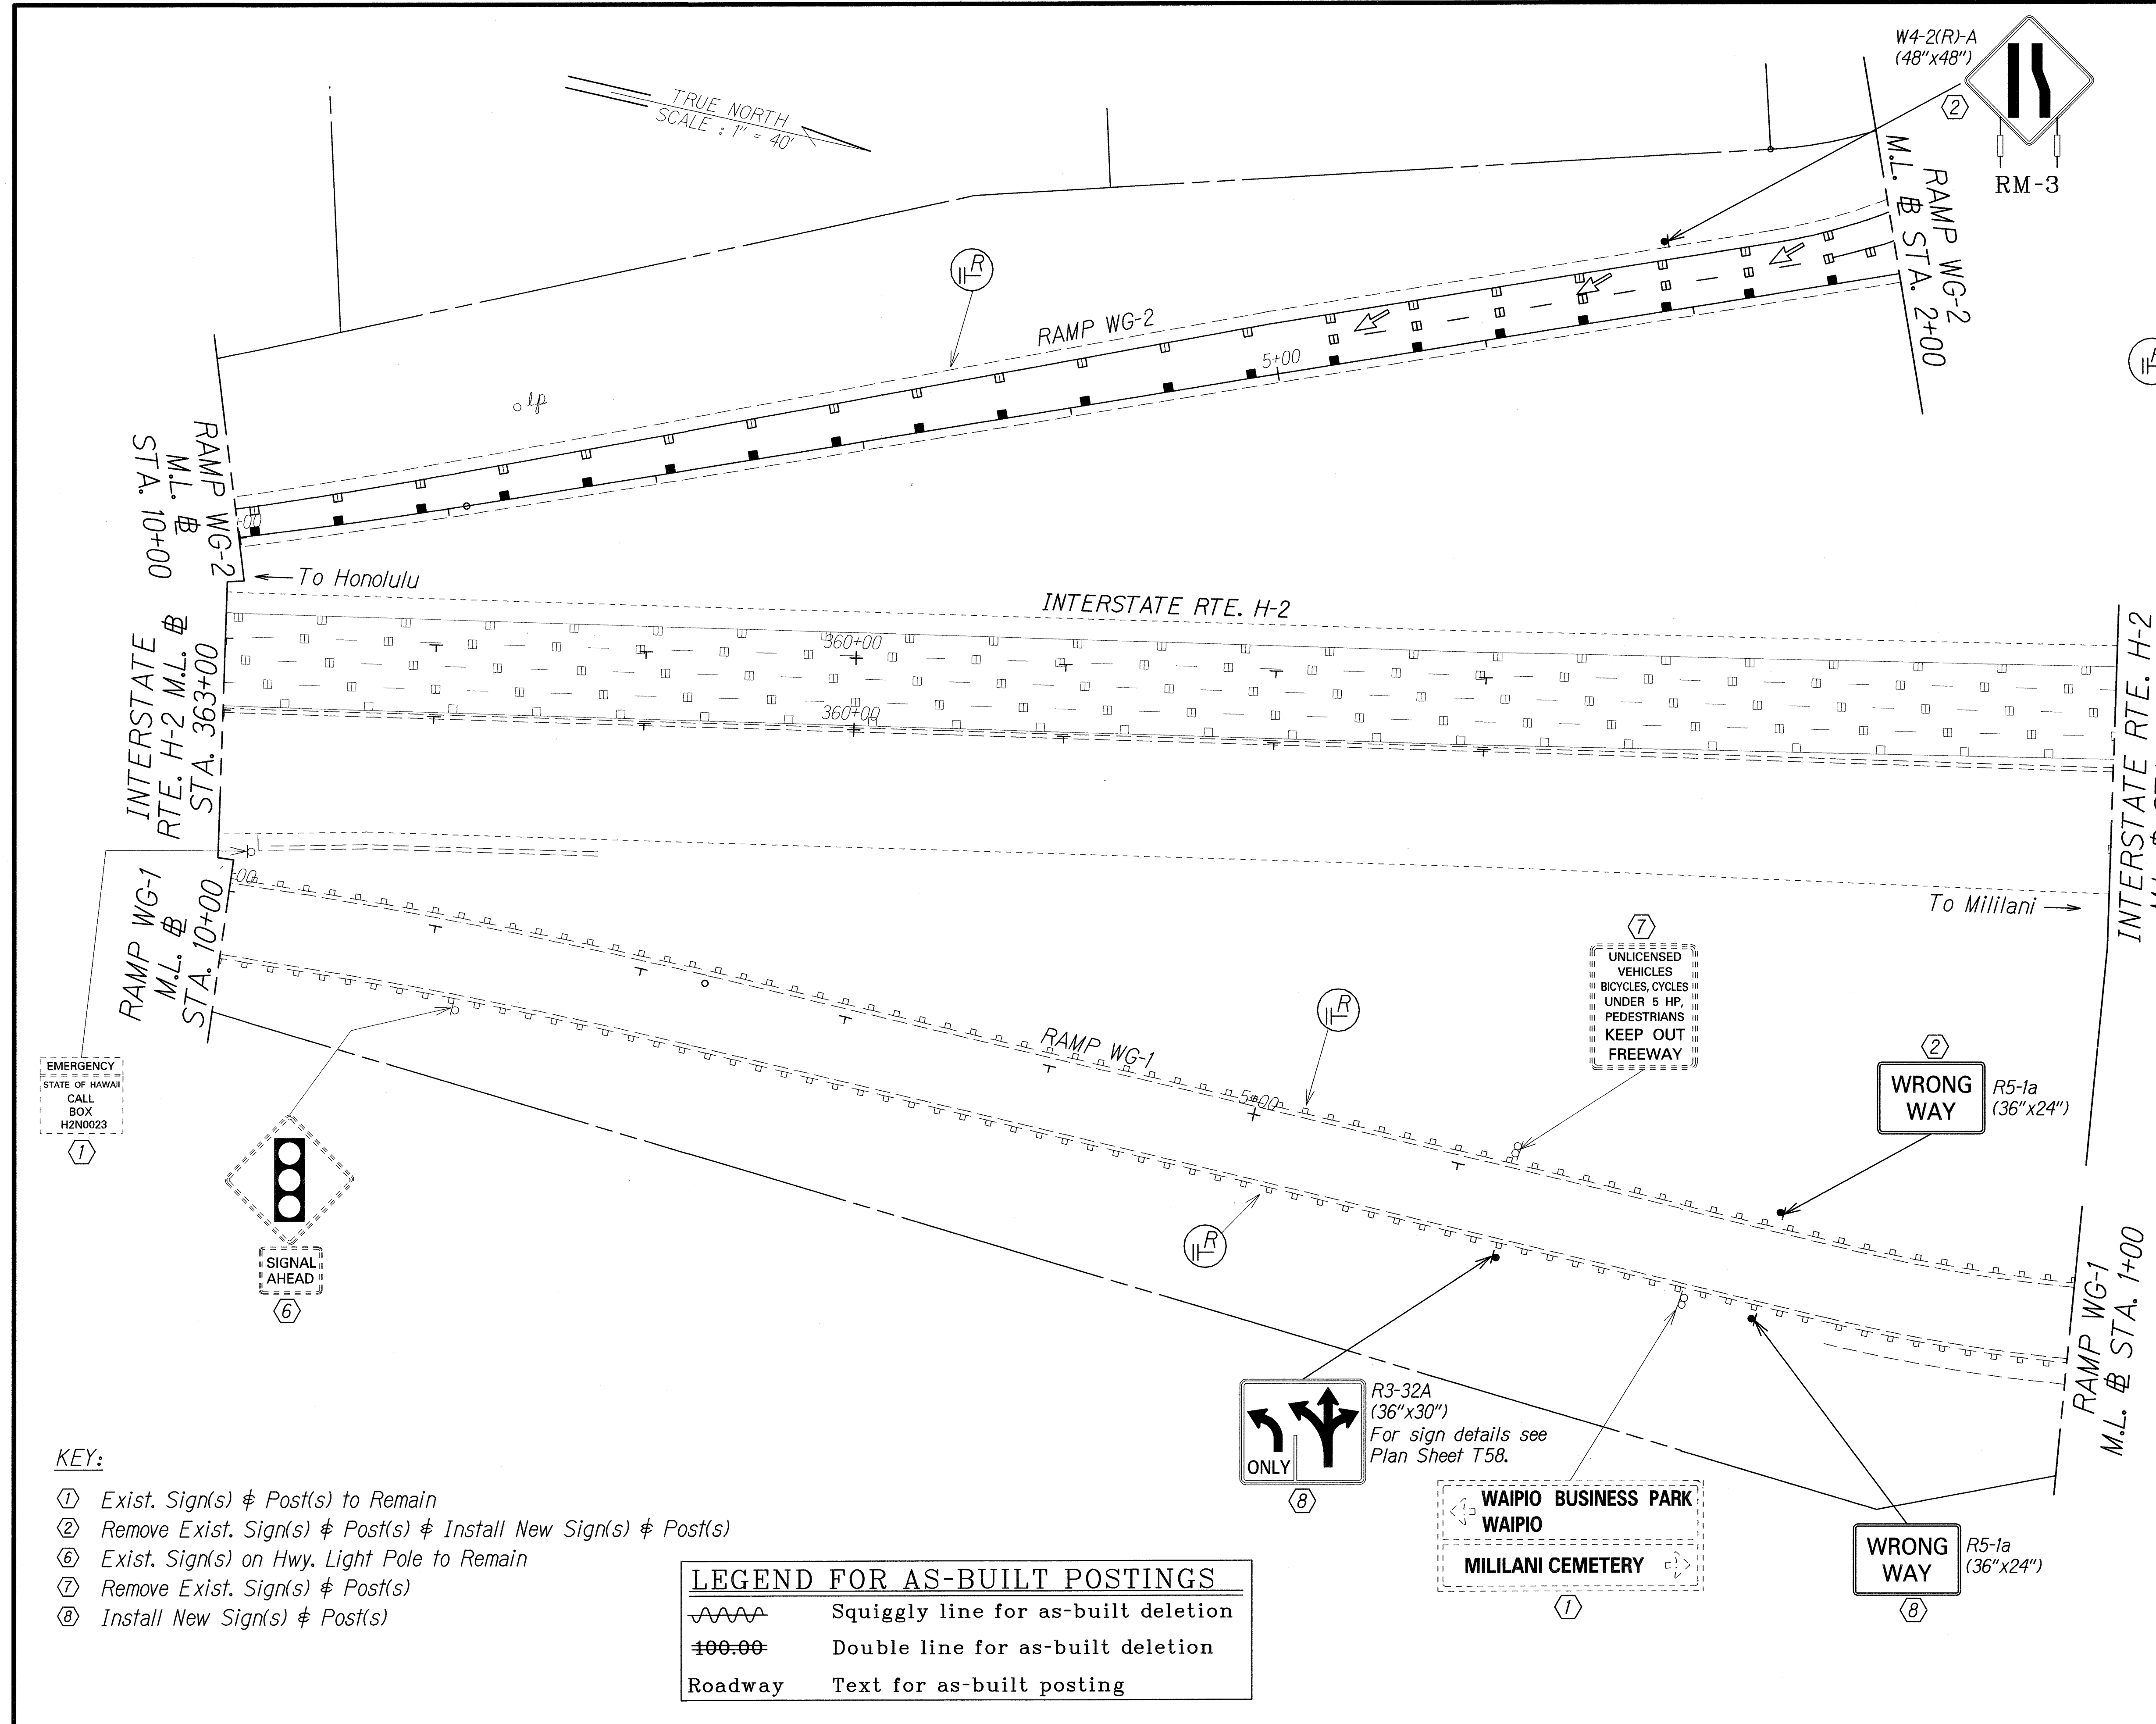

(R) Remove existing reflector markers and delineator posts. The Contractor shall be responsible for removing all reflector markers and delineator posts within the project limits even when not shown on the plans. Removal and disposal of existing reflector markers and delineator posts shall be considered incidental to various contract items.


- KEY:
- ① Exist. Sign(s) & Post(s) to Remain
 - ② Remove Exist. Sign(s) & Post(s) & Install New Sign(s) & Post(s)
 - ⑥ Exist. Sign(s) on Hwy. Light Pole to Remain
 - ⑦ Remove Exist. Sign(s) & Post(s)
 - ⑧ Install New Sign(s) & Post(s)

LEGEND FOR AS-BUILT POSTINGS	
	Squiggly line for as-built deletion
	Double line for as-built deletion
Roadway	Text for as-built posting

5/16/07	Revise sign W4-2(R)-A and sign R3-32A. Removed Key ⑤ note.
DATE	REVISION
STATE OF HAWAII DEPARTMENT OF TRANSPORTATION HIGHWAYS DIVISION PAVEMENT MARKING & SIGNING PLAN INTERSTATE ROUTE H-2 REHABILITATION Waipio Interchange & Mililani Interchange On/Off Ramps, Ka Uka Blvd., Meheula Pkwy. Overpass, & Kipapa Stream Bridge Federal Aid Project No. IM-H2-1(33) Scale: 1" = 40' Date: Dec. 2006	
SHEET No. T44 OF 63 SHEETS	

SURVEY PLOTTED BY	DATE
DRAWN BY M. Takahashi	5/16/07
DESIGNED BY HWY-10	
CHECKED BY	
ORIGINAL PLAN	
NOTE BOOK	
FILE NO.	
CHECKED BY	

FED. ROAD DIST. NO.	STATE	FED. AID PROJ. NO.	FISCAL YEAR	SHEET NO.	TOTAL SHEETS
HAWAII	HAW.	IM-H2-1(33)	2007	ADD. 116	168

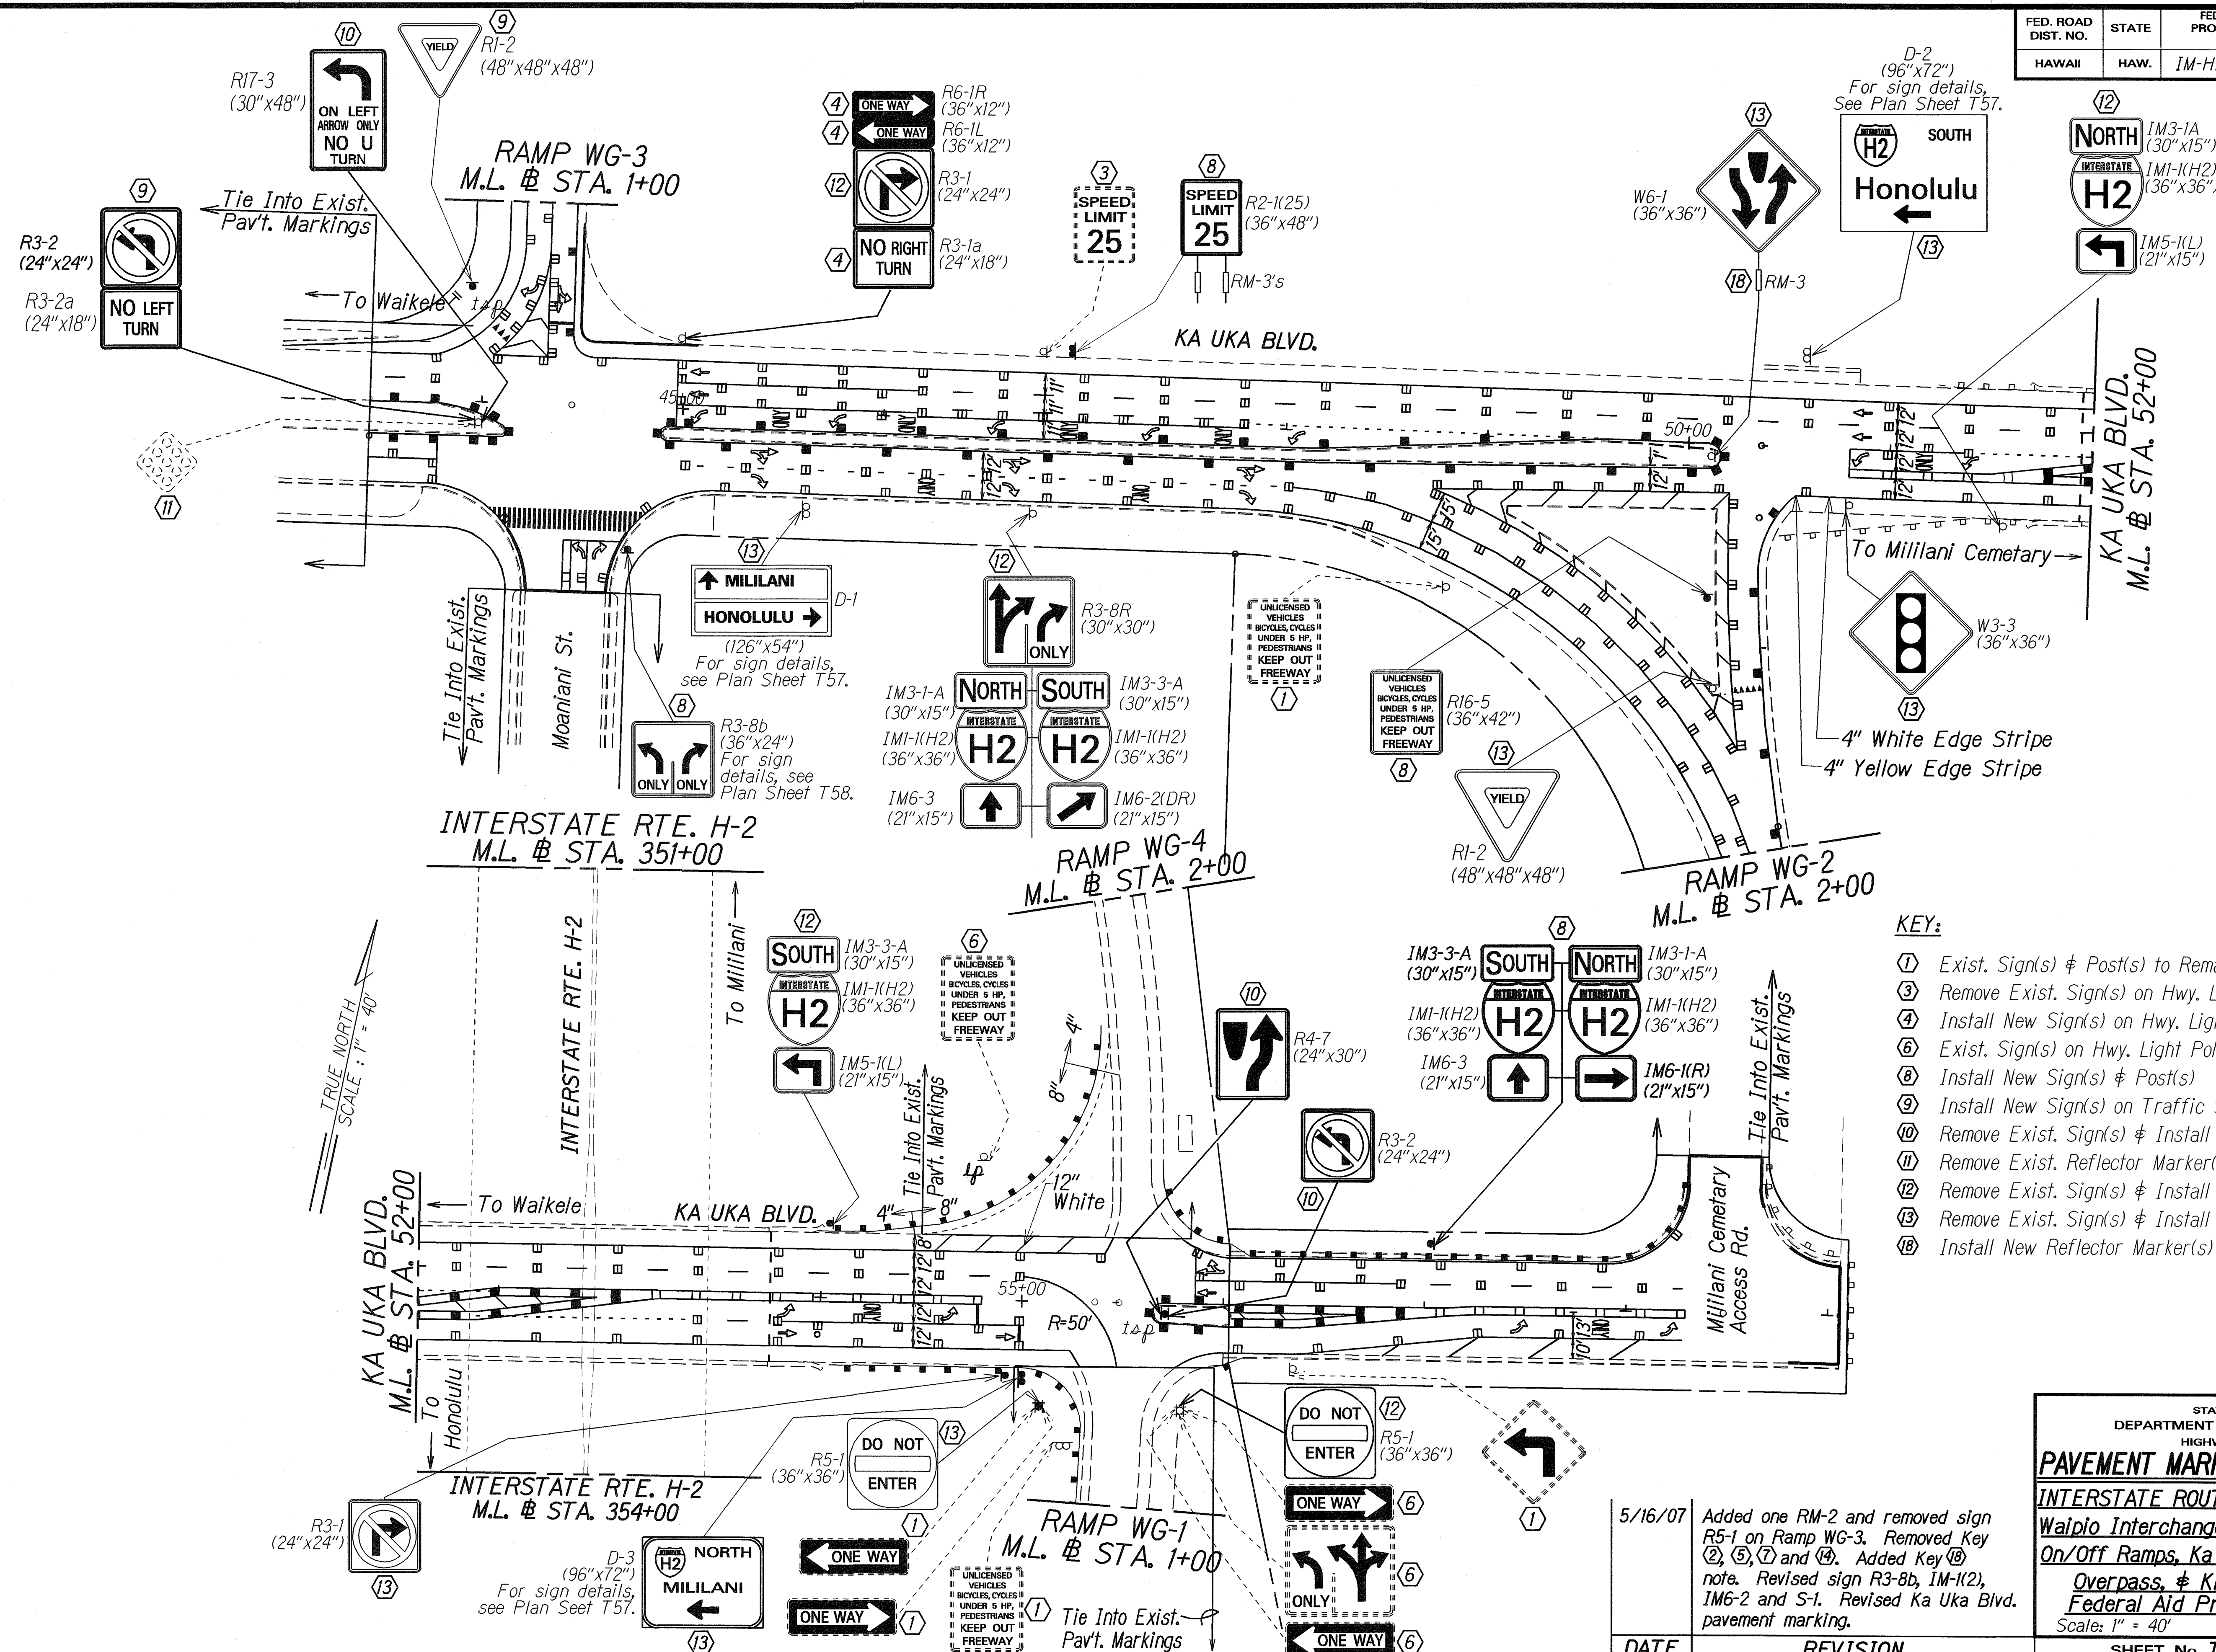

KEY:

- ① Exist. Sign(s) $\nrightarrow$ Post(s) to Remain
- ③ Remove Exist. Sign(s) on Hwy. Light Pole
- ④ Install New Sign(s) on Hwy. Light Pole
- ⑥ Exist. Sign(s) on Hwy. Light Pole to Remain
- ⑧ Install New Sign(s) $\nrightarrow$ Post(s)
- ⑨ Install New Sign(s) on Traffic Signal Pole
- ⑩ Remove Exist. Sign(s) $\nrightarrow$ Install New on Traffic Signal Pole
- ⑪ Remove Exist. Reflector Marker(s) $\nrightarrow$ Post(s)
- ⑫ Remove Exist. Sign(s) $\nrightarrow$ Install New on Hwy. Light Pole
- ⑬ Remove Exist. Sign(s) $\nrightarrow$ Install New on Exist. Post(s)
- ⑭ Install New Reflector Marker(s) on Exist. Post(s)

5/16/07	Added one RM-2 and removed sign R5-1 on Ramp WG-3. Removed Key (2), (5), (7) and (4). Added Key (8) note. Revised sign R3-8b, IM-1(2), IM6-2 and S-1. Revised Ka Uka Blvd. pavement marking.
DATE	REVISION

STATE OF HAWAII
DEPARTMENT OF TRANSPORTATION
HIGHWAYS DIVISION


PAVEMENT MARKING & SIGNING PLAN

INTERSTATE ROUTE H-2 REHABILITATION
Waipio Interchange & Mililani Interchange
On/Off Ramps, Ka Uka Blvd., Meheula Pkwy.
Overpass, & Kipapa Stream Bridge
Federal Aid Project No. IM-H2-1(33)

Scale: 1" = 40' Date: Dec. 2006

SHEET NO. 745 OF 63 SHEETS

FED. ROAD DIST. NO.	STATE	FED. AID PROJ. NO.	FISCAL YEAR	SHEET NO.	TOTAL SHEETS
HAWAII	HAW.	IM-H2-1(33)	2007	ADD. 117	168

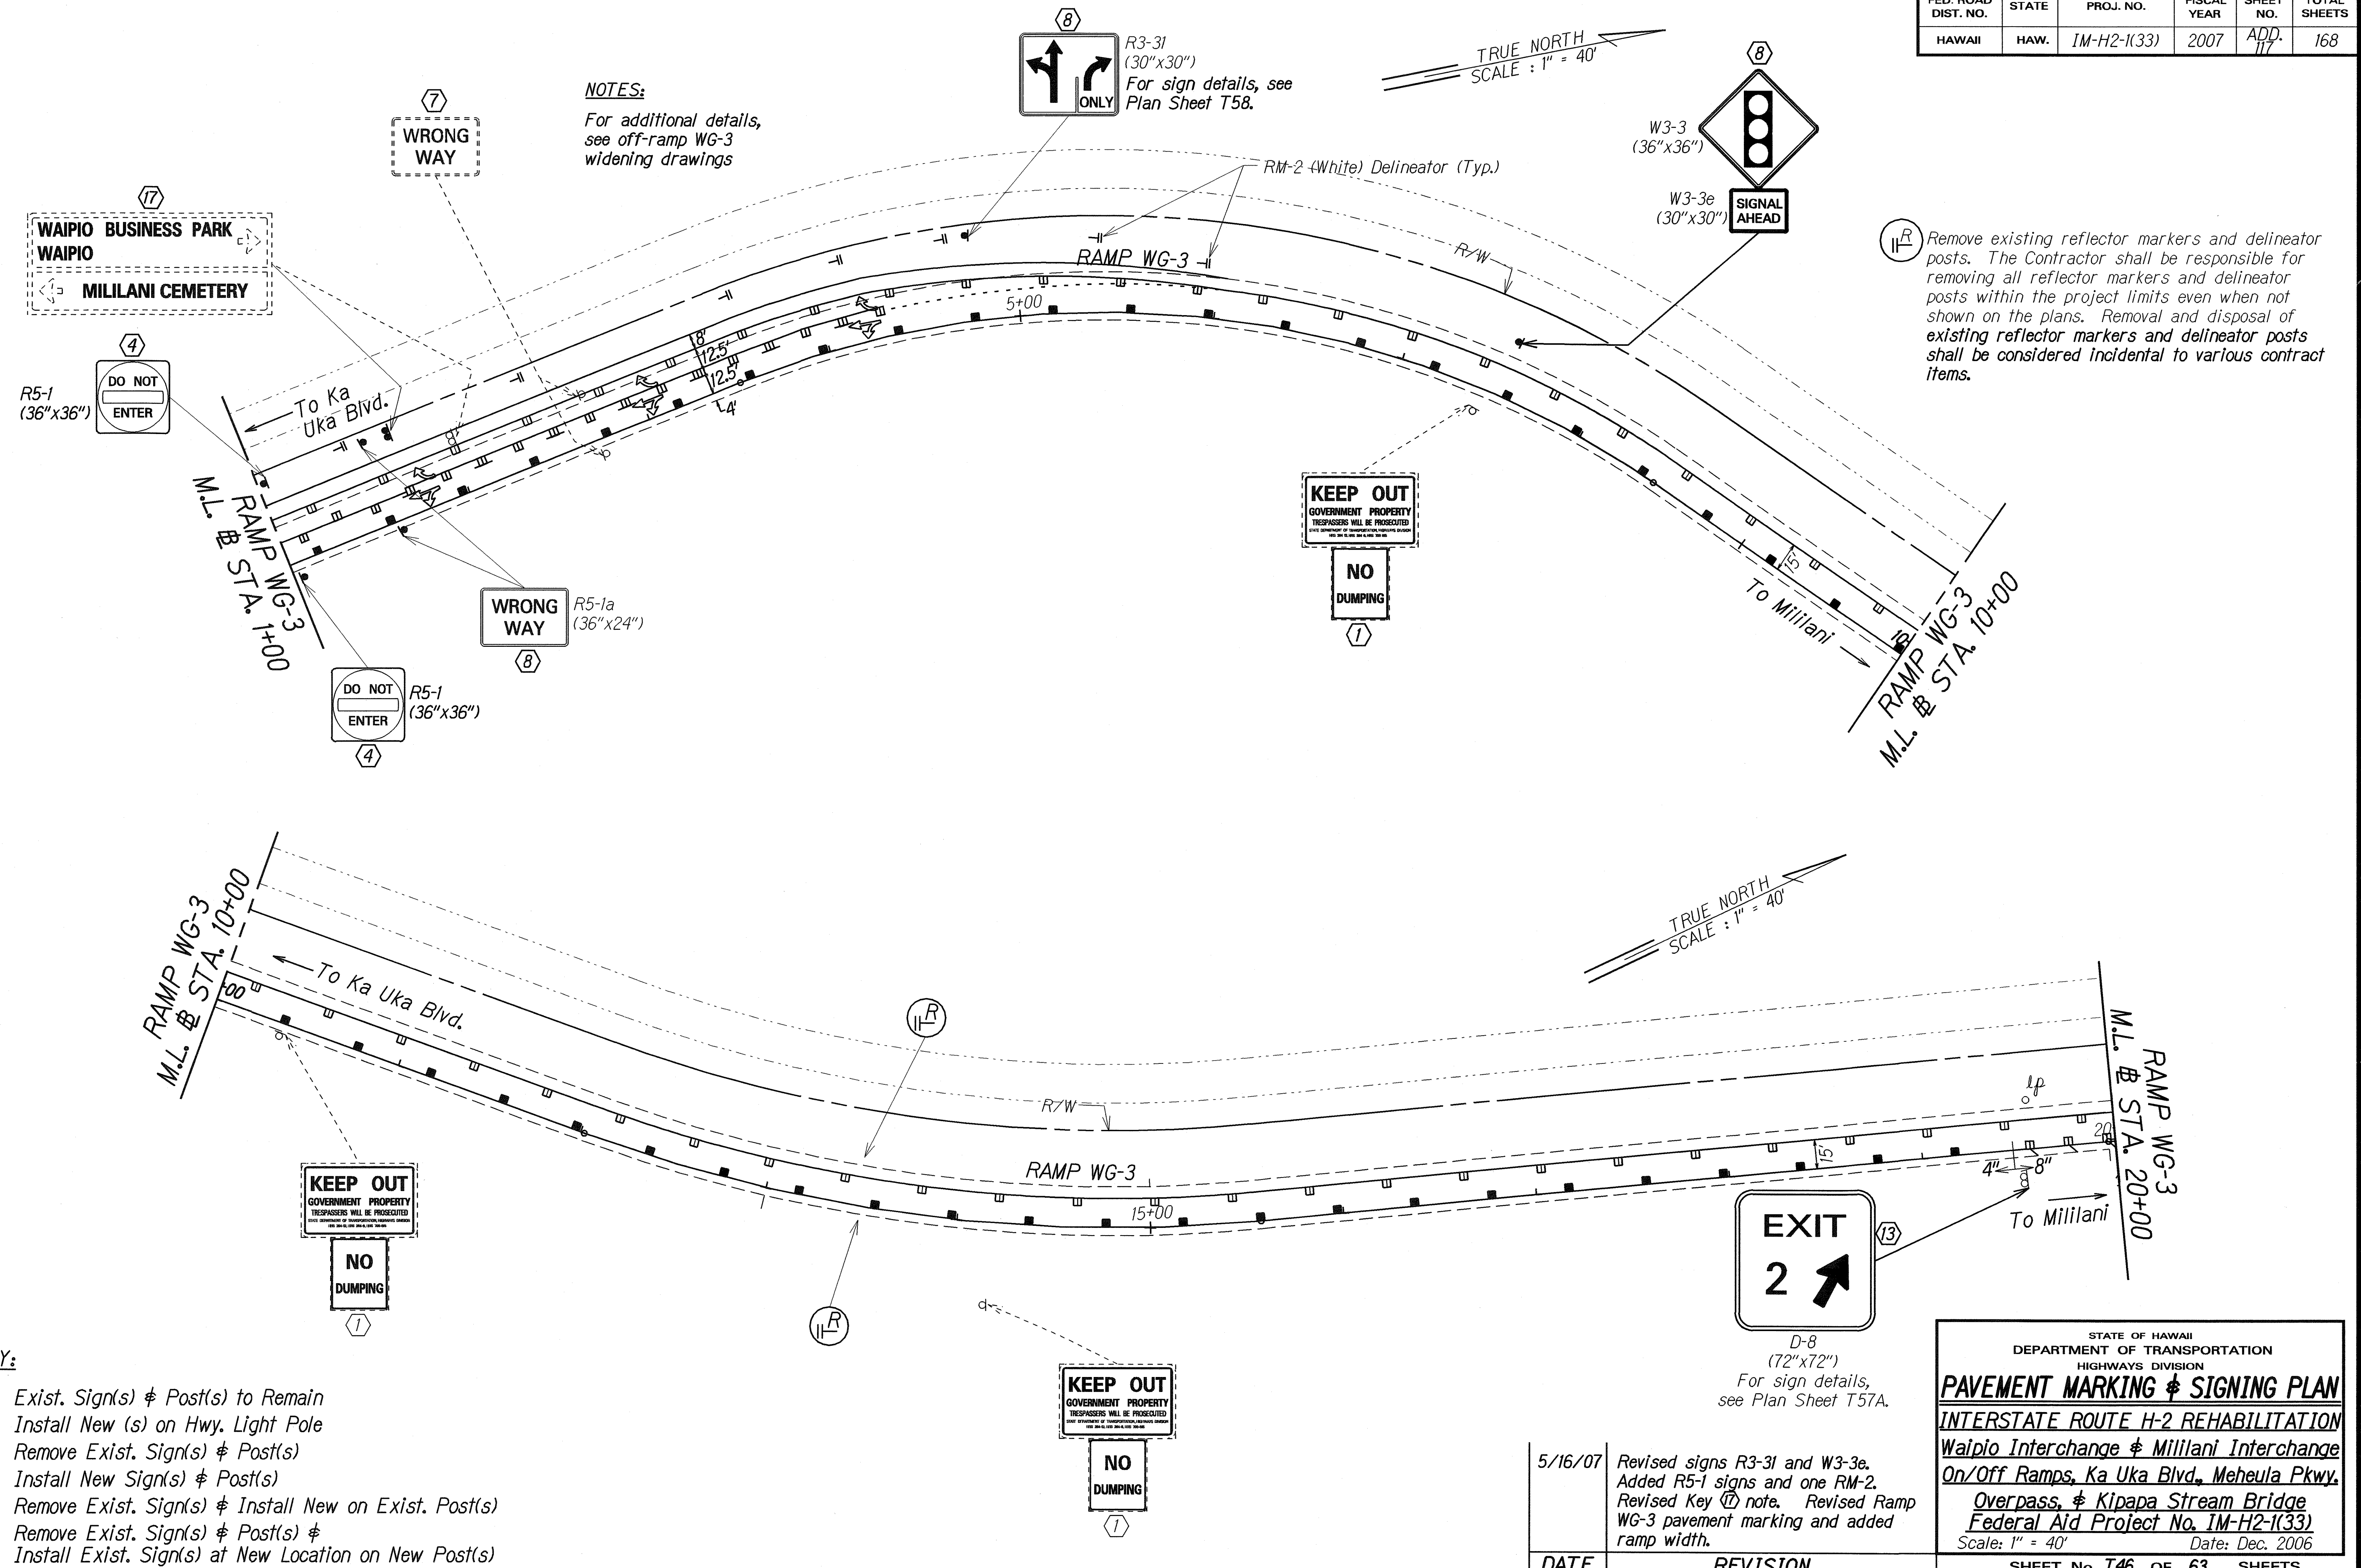


SURVEY PLOTTED BY	DATE
DRAWN BY	
DESIGNED BY	
QUANTITIES BY	
CHECKED BY	
ORIGINAL PLAN	
NOTE BOOK	
1022mg	
10/2/2004	

5/16/07	Revised signs R3-31 and W3-3e. Added R5-1 signs and one RM-2. Revised Key ⑮ note. Revised Ramp WG-3 pavement marking and added ramp width.
DATE	REVISION

STATE OF HAWAII DEPARTMENT OF TRANSPORTATION HIGHWAYS DIVISION
PAVEMENT MARKING & SIGNING PLAN
INTERSTATE ROUTE H-2 REHABILITATION
Waipio Interchange & Millilani Interchange
On/Off Ramps, Ka Uka Blvd., Meheula Pkwy.
Overpass, & Kipapa Stream Bridge
Federal Aid Project No. IM-H2-1(33)
Scale: 1" = 40' Date: Dec. 2006
SHEET No. T46 OF 63 SHEETS

FED. ROAD DIST. NO.	STATE	FED. AID PROJ. NO.	FISCAL YEAR	SHEET NO.	TOTAL SHEETS
HAWAII	HAW.	IM-H2-1(33)	2007	118	168

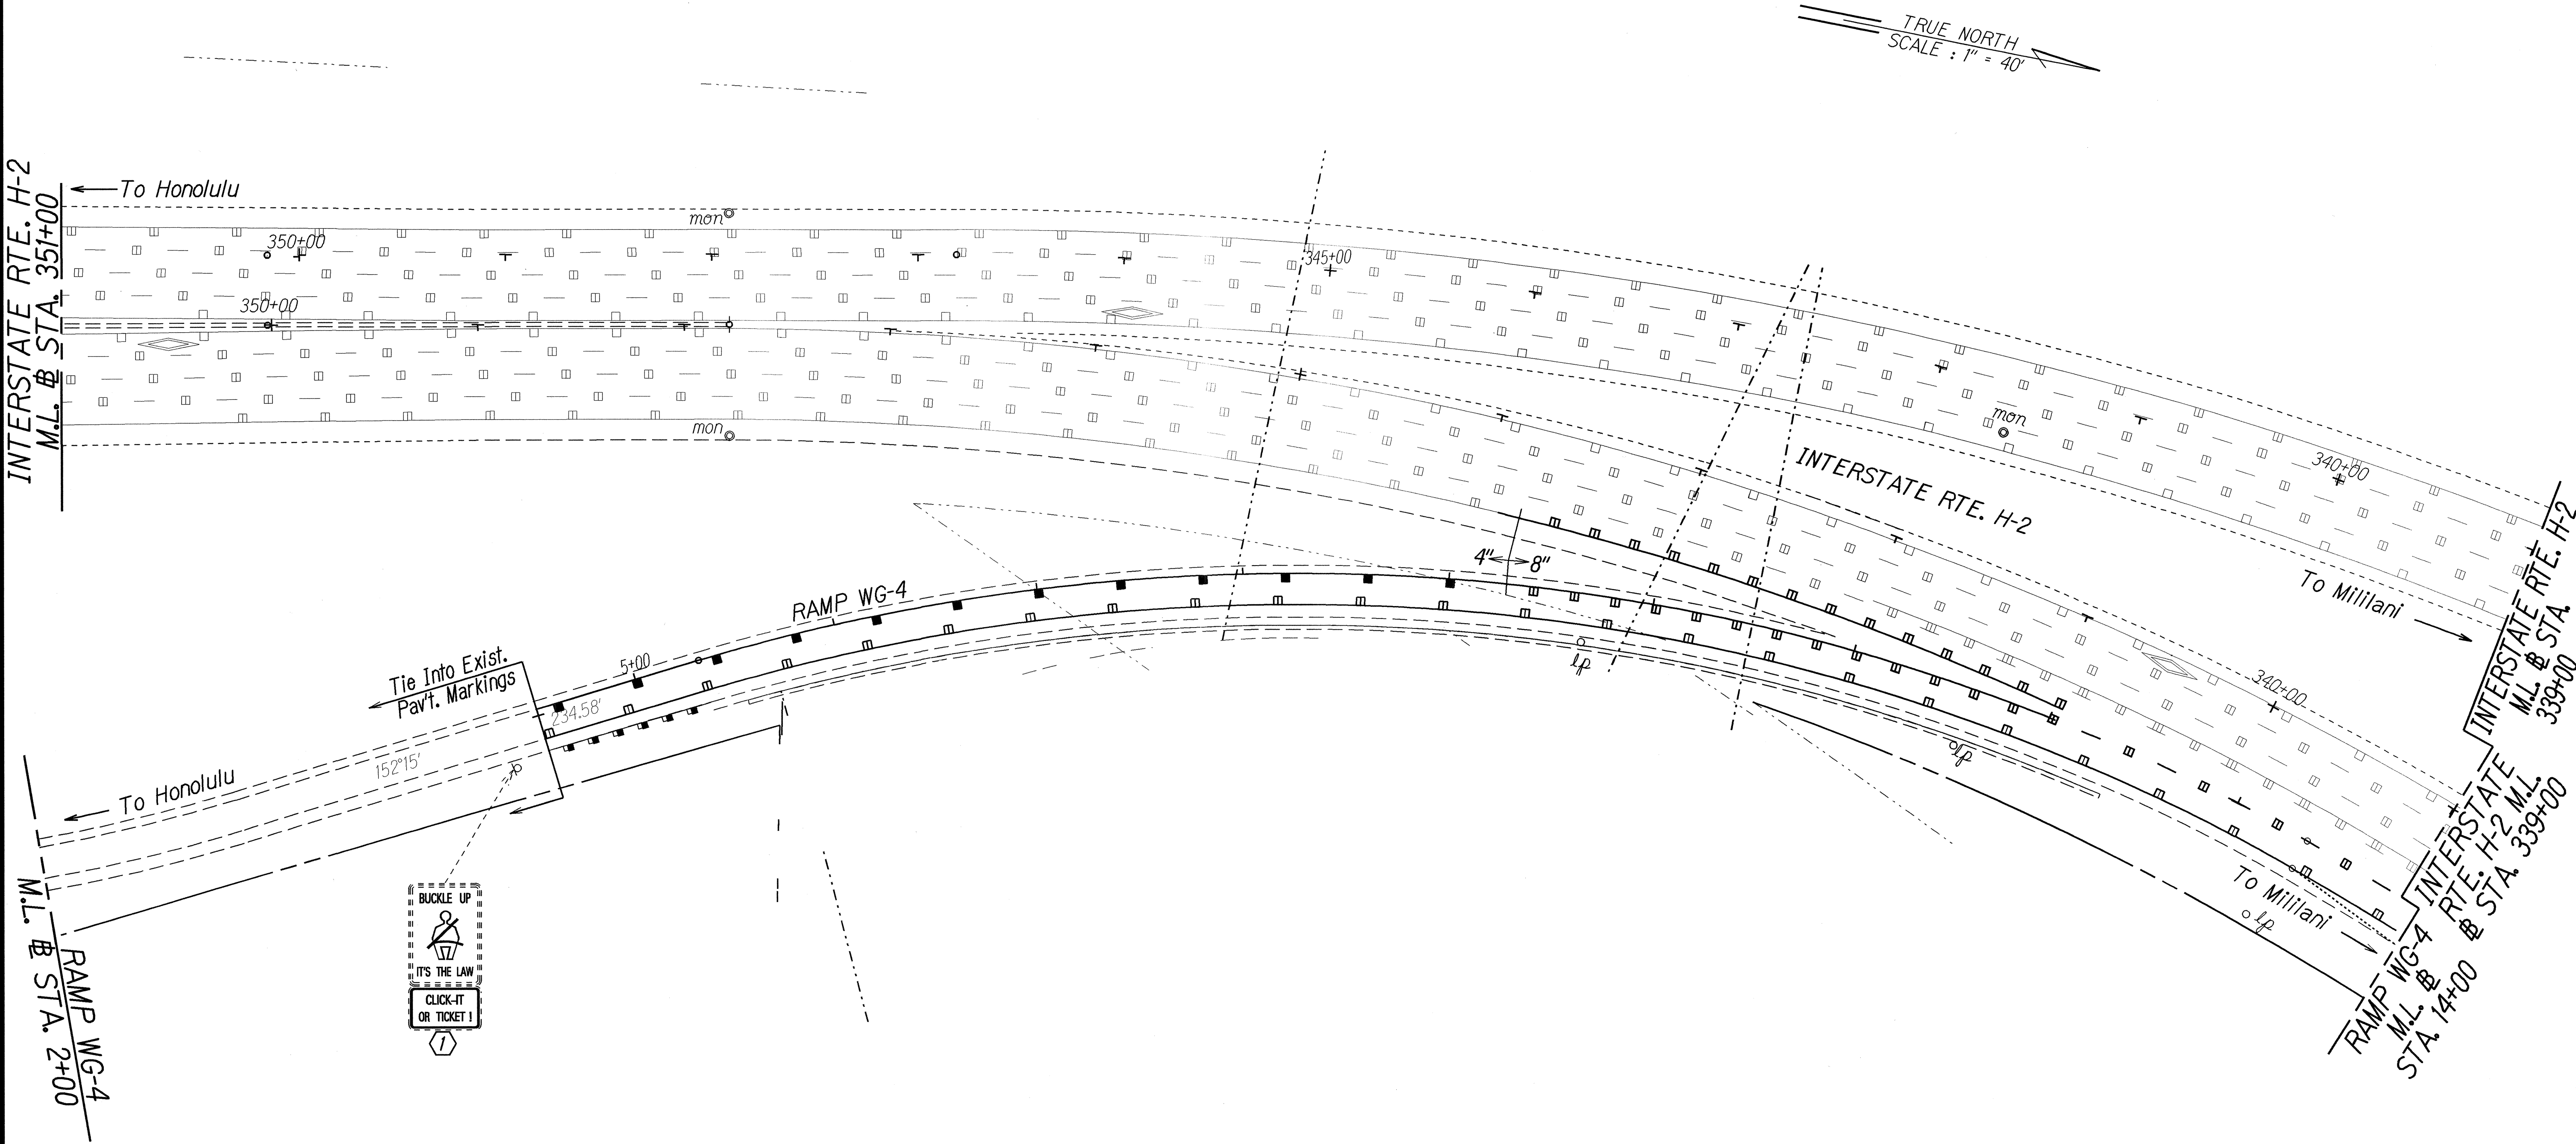

ORIGINAL PLAN	SURVEY PLOTTED BY	DATE
	DRAWN BY <i>M. L. L.</i>	
	DESIGNED BY <i>HW-10</i>	
	CHECKED BY	
NOTE BOOK	NOTED BY <i>HW-10</i>	DATE <i>12/20/06</i>
	CHECKED BY	DATE


KEY:
 □ Exist. Sign(s) & Post(s) to Remain

STATE OF HAWAII
DEPARTMENT OF TRANSPORTATION
HIGHWAYS DIVISION

PAVEMENT MARKING & SIGNING PLAN
INTERSTATE ROUTE H-2 REHABILITATION
Waipio Interchange & Mililani Interchange
On/Off Ramps, Ka Uka Blvd., Meheula Pkwy.
Overpass, & Kipapa Stream Bridge
Federal Aid Project No. IM-H2-1(33)
Scale: 1" = 40' Date: Dec. 2006

SHEET No. 747 OF 63 SHEETS

FED. ROAD DIST. NO.	STATE	FED. AID PROJ. NO.	FISCAL YEAR	SHEET NO.	TOTAL SHEETS
HAWAII	HAW.	IM-H2-1(33)	2007	ADD. 119	168

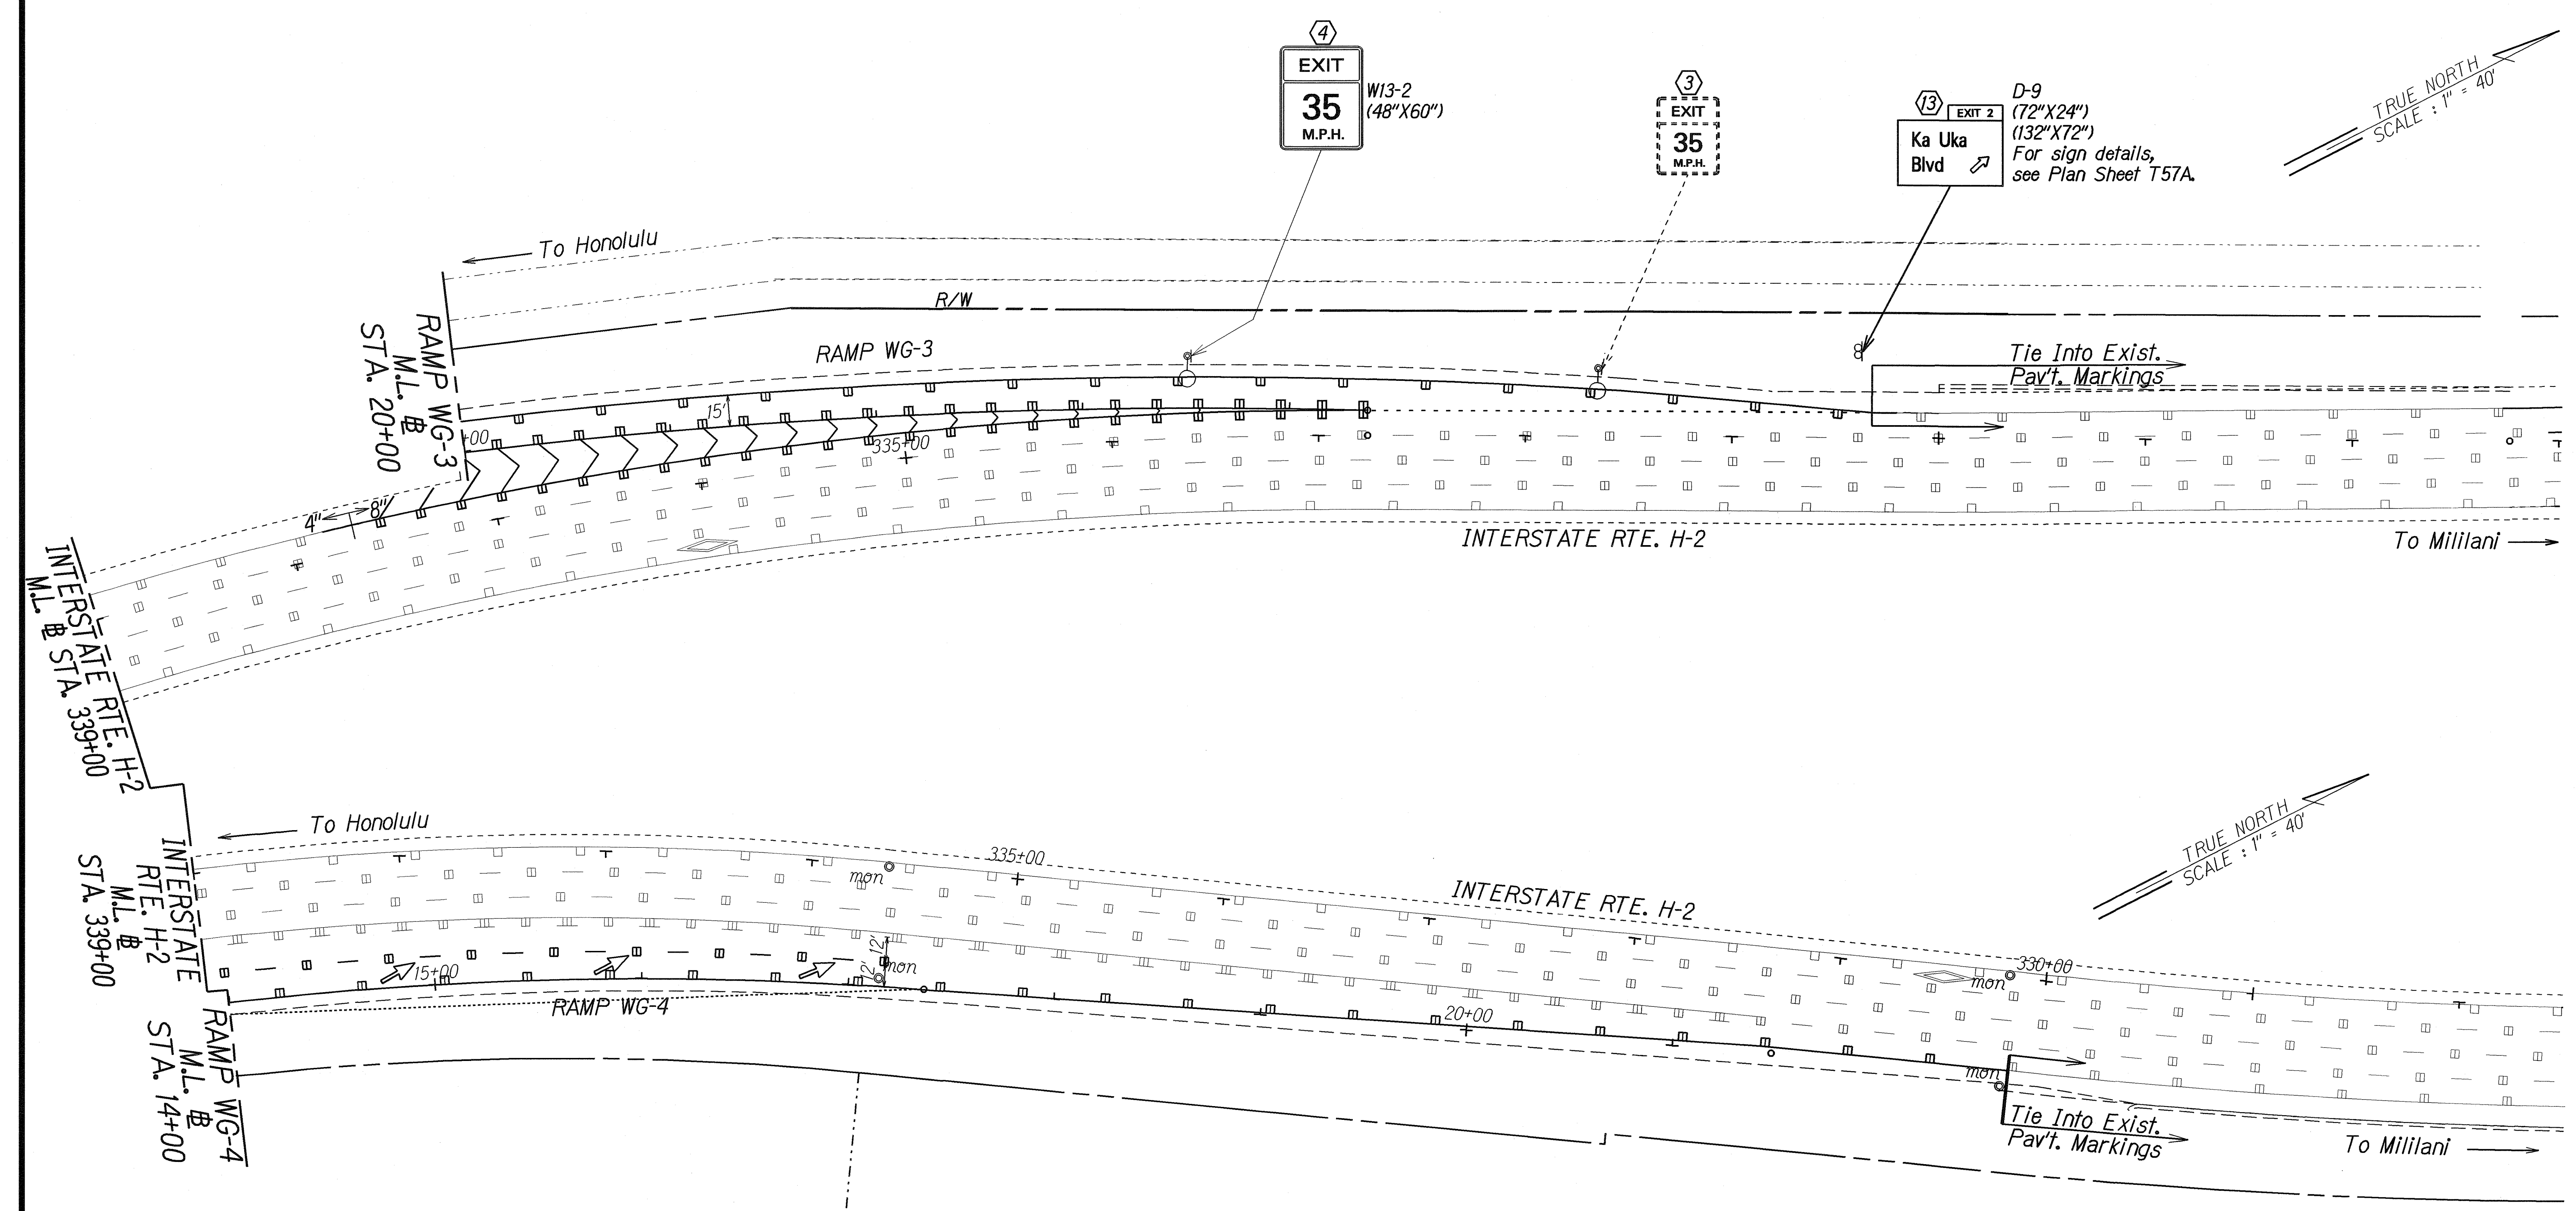

KEY:

- ③ Remove Exist. Sign(s) on Hwy. Light Pole
- ④ Install New Sign(s) on Hwy. Light Pole
- ⑬ Remove Exist. Sign(s) & Install New on Exist. Post(s)

SURVEY PLOTTED BY	DATE
DRAWN BY	
DESIGNED BY	
QUANTITIES BY	
CHECKED BY	

5/16/07	Revised sign W13-3 to W13-2. Added label to "Ka Uka Blvd" sign. Added ramp widths.
DATE	REVISION

STATE OF HAWAII
DEPARTMENT OF TRANSPORTATION
HIGHWAYS DIVISION

PAVEMENT MARKING & SIGNING PLAN

INTERSTATE ROUTE H-2 REHABILITATION

Waipio Interchange & Mililani Interchange

On/Off Ramps, Ka Uka Blvd., Meheula Pkwy.


Overpass, & Kipapa Stream Bridge

Federal Aid Project No. IM-H2-1(33)

Scale: 1" = 40' Date: Dec. 2006

SHEET No. T48 OF 63 SHEETS

FED. ROAD DIST. NO.	STATE	FED. AID PROJ. NO.	FISCAL YEAR	SHEET NO.	TOTAL SHEETS
HAWAII	HAW.	IM-H2-1(33)	2007	ADD. 120	168

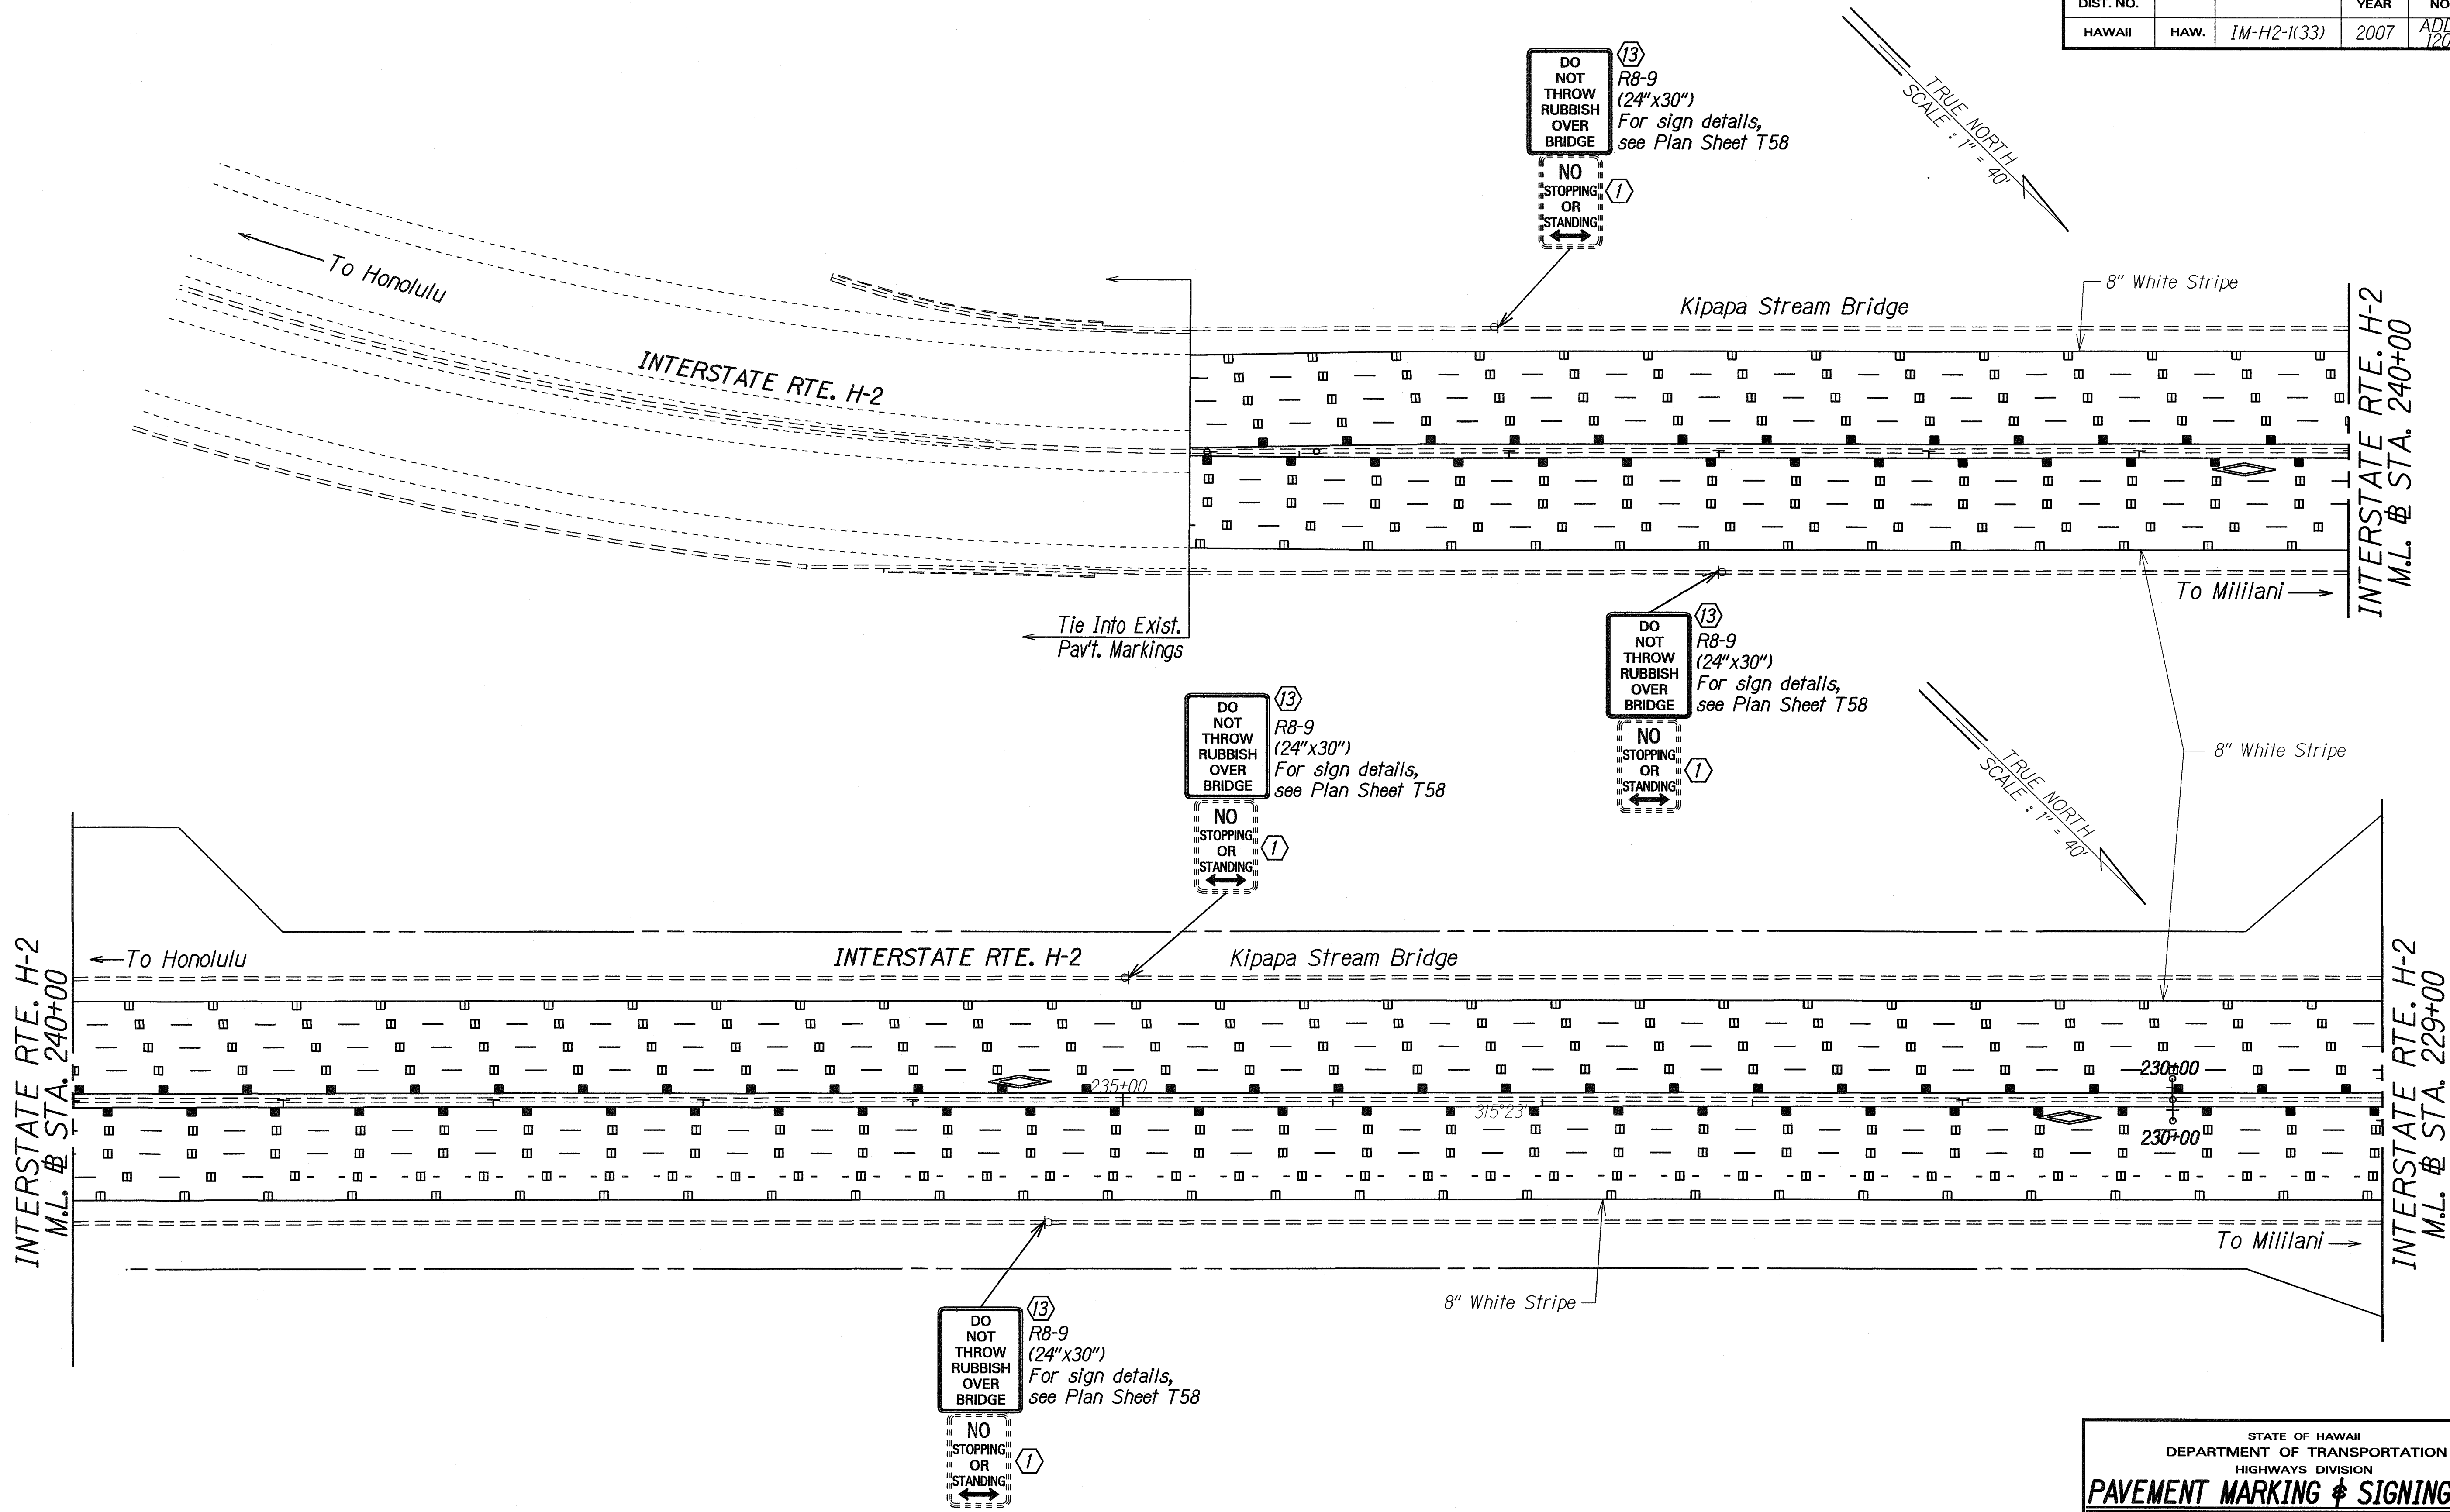

KEY:

- ① Exist. Sign(s) & Post(s) to Remain
- ⑬ Remove Exist. Sign(s) & Install New on Exist. Post(s)

SURVEY PLOTTED BY	DATE
DRAWN BY	
DESIGNED BY	
QUANTITIES BY	
CHECKED BY	

5/16/07	Revised sign R8-9 Plan Sheet No. and leader lines for signs.
DATE	REVISION

STATE OF HAWAII
DEPARTMENT OF TRANSPORTATION
HIGHWAYS DIVISION

PAVEMENT MARKING & SIGNING PLAN

INTERSTATE ROUTE H-2 REHABILITATION

Waipio Interchange & Mililani Interchange

On/Off Ramps, Ka Uka Blvd., Meheula Pkwy.


Overpass, & Kipapa Stream Bridge

Federal Aid Project No. IM-H2-1(33)

Scale: 1" = 40' Date: Dec. 2006

SHEET No. T49 OF 63 SHEETS

FED. ROAD DIST. NO.	STATE	FED. AID PROJ. NO.	FISCAL YEAR	SHEET NO.	TOTAL SHEETS
HAWAII	HAW.	IM-H2-1(33)	2007	ADD. 121	168

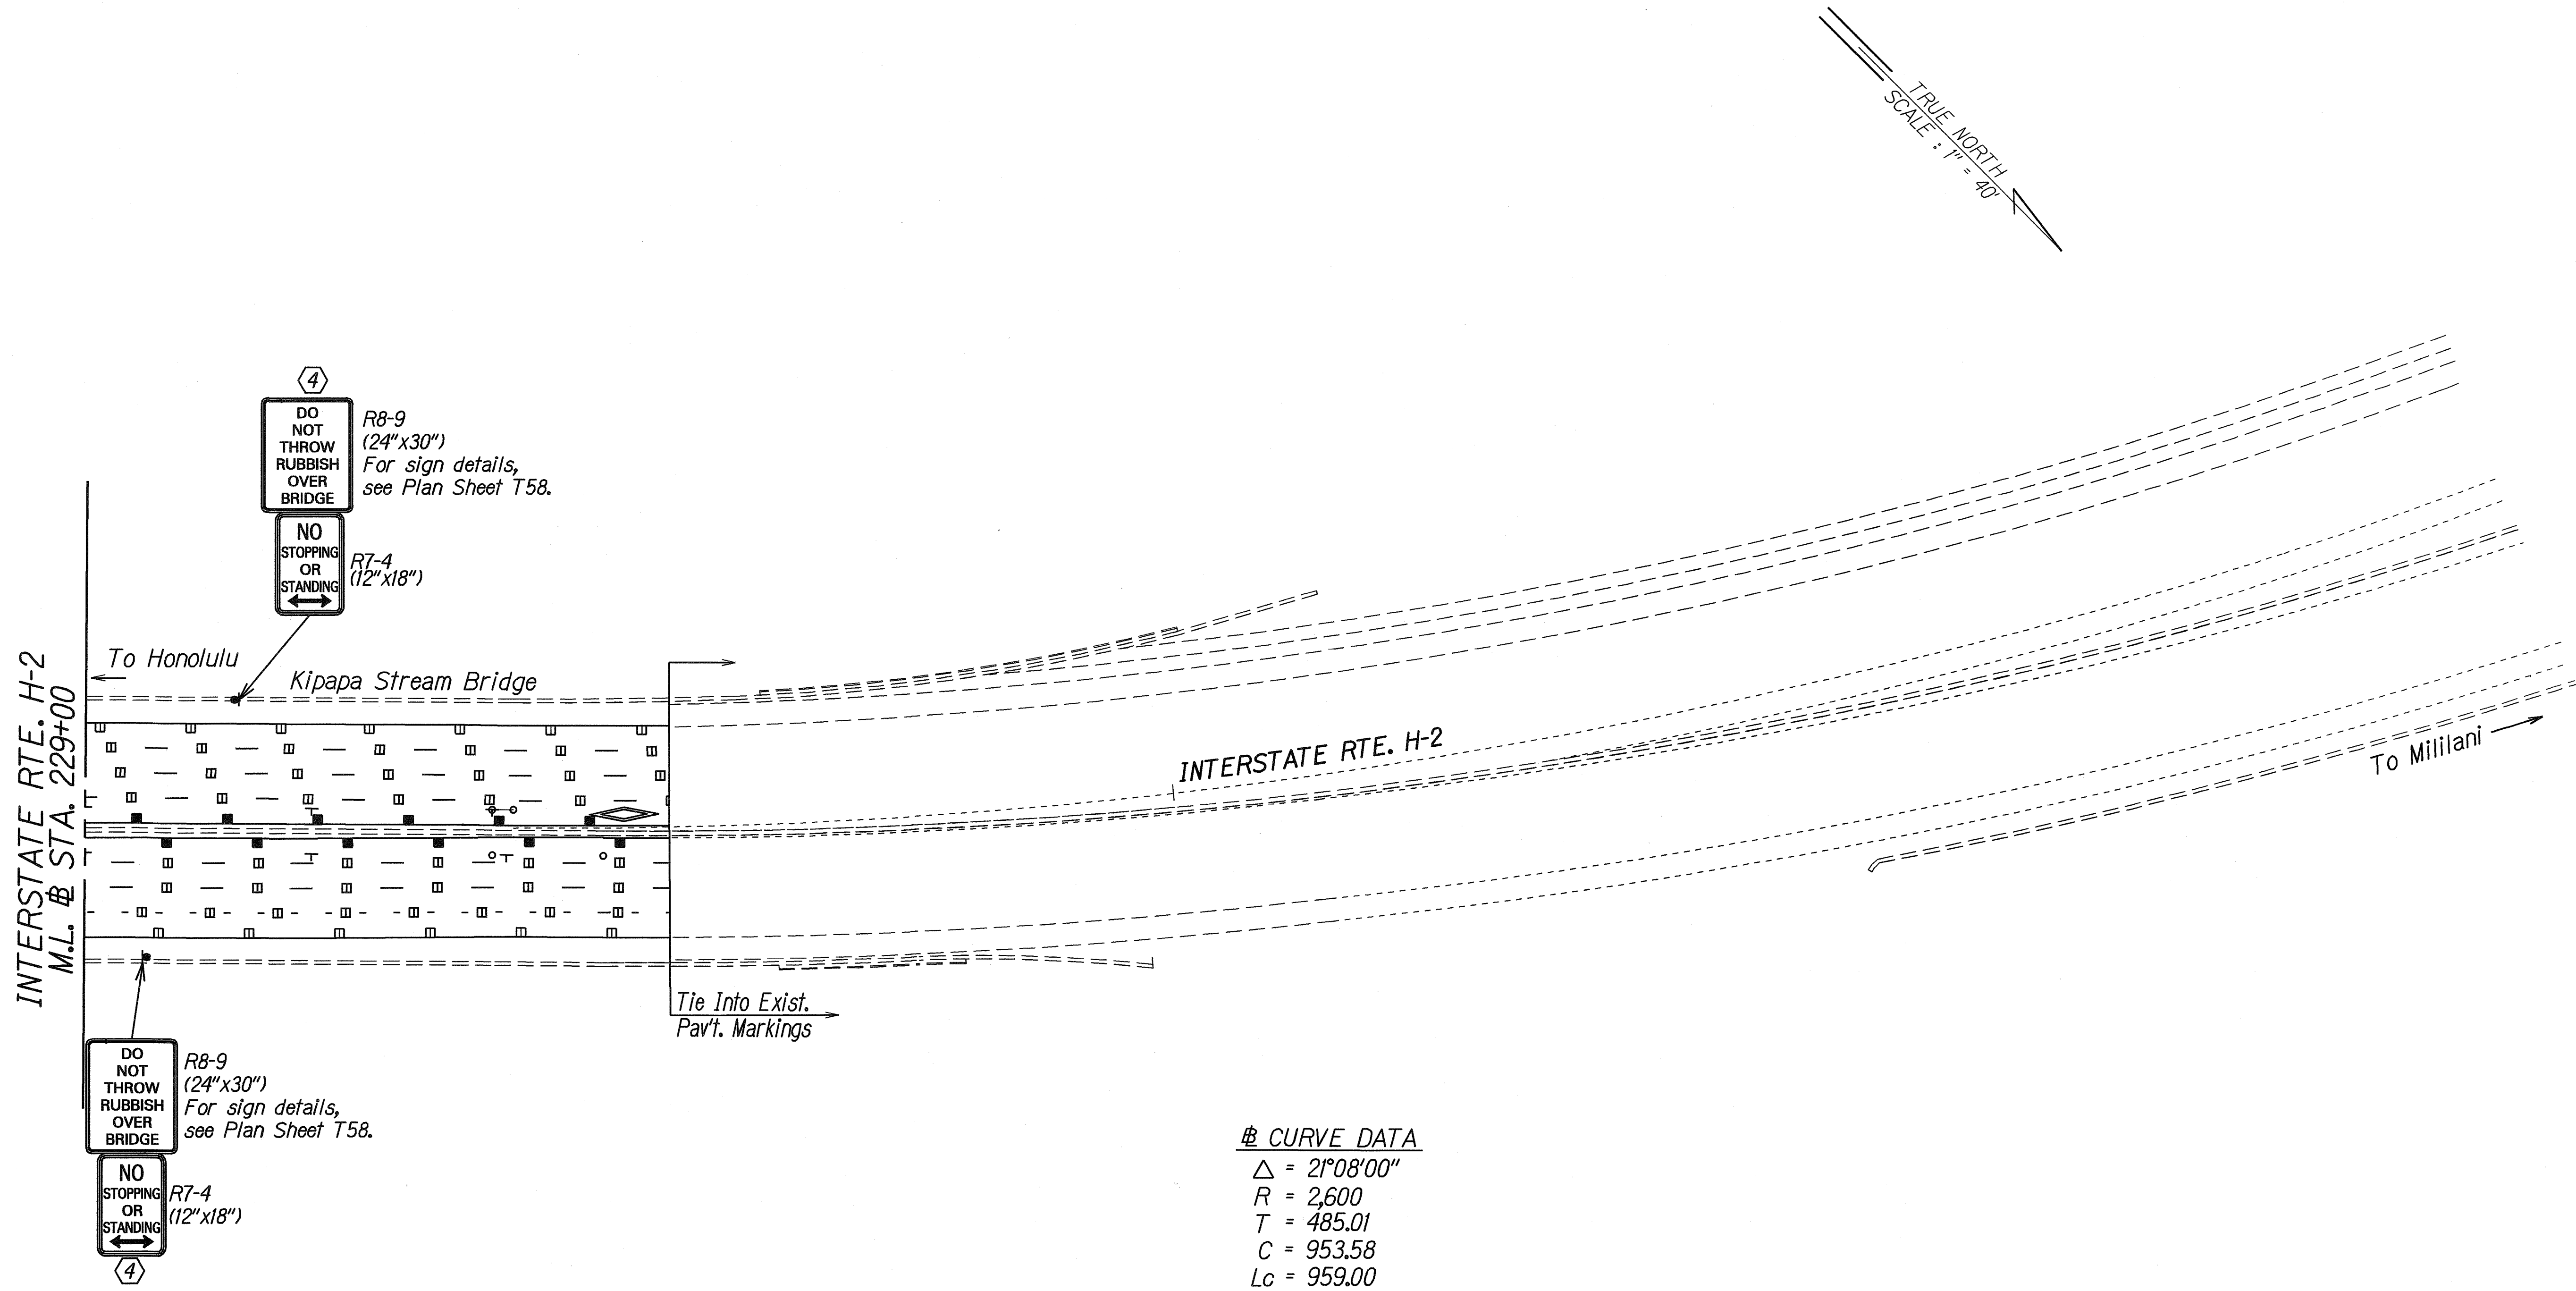

SURVEY PLOTTED BY	DATE
DRAWN BY	
DESIGNED BY	
QUANTITIES BY	
CHECKED BY	
ORIGINAL PLAN	
NOTE BOOK	
10/2/06	
No. 10/2/06	

KEY:
 ④ Install New Sign(s) on Highway Light Pole

5/16/07	Replaced Key ③ with Key ④. Revised sign R8-9 Plan Sheet No. Added dimensions for sign R7-4.
DATE	REVISION

STATE OF HAWAII
DEPARTMENT OF TRANSPORTATION
HIGHWAYS DIVISION


PAVEMENT MARKING & SIGNING PLAN
INTERSTATE ROUTE H-2 REHABILITATION
Waipio Interchange & Mililani Interchange
On/Off Ramps, Ka Uka Blvd., Meheula Pkwy.
Overpass, & Kipapa Stream Bridge
Federal Aid Project No. IM-H2-1(33)
Scale: 1" = 40' Date: Dec. 2006

SHEET No. T50 OF 63 SHEETS

FED. ROAD DIST. NO.	STATE	FED. AID PROJ. NO.	FISCAL YEAR	SHEET NO.	TOTAL SHEETS
HAWAII	HAW.	IM-H2-1(33)	2007		168

KEY:

- ① Exist. Sign(s) & Post(s) to Remain
- ⑬ Remove Exist. Sign(s) & Install New on Exist. Post(s)
- ⑭ Install New Sign(s) on Exist. Post(s)
- ⑯ Install New Reflector Marker(s) on Exist. Post(s)

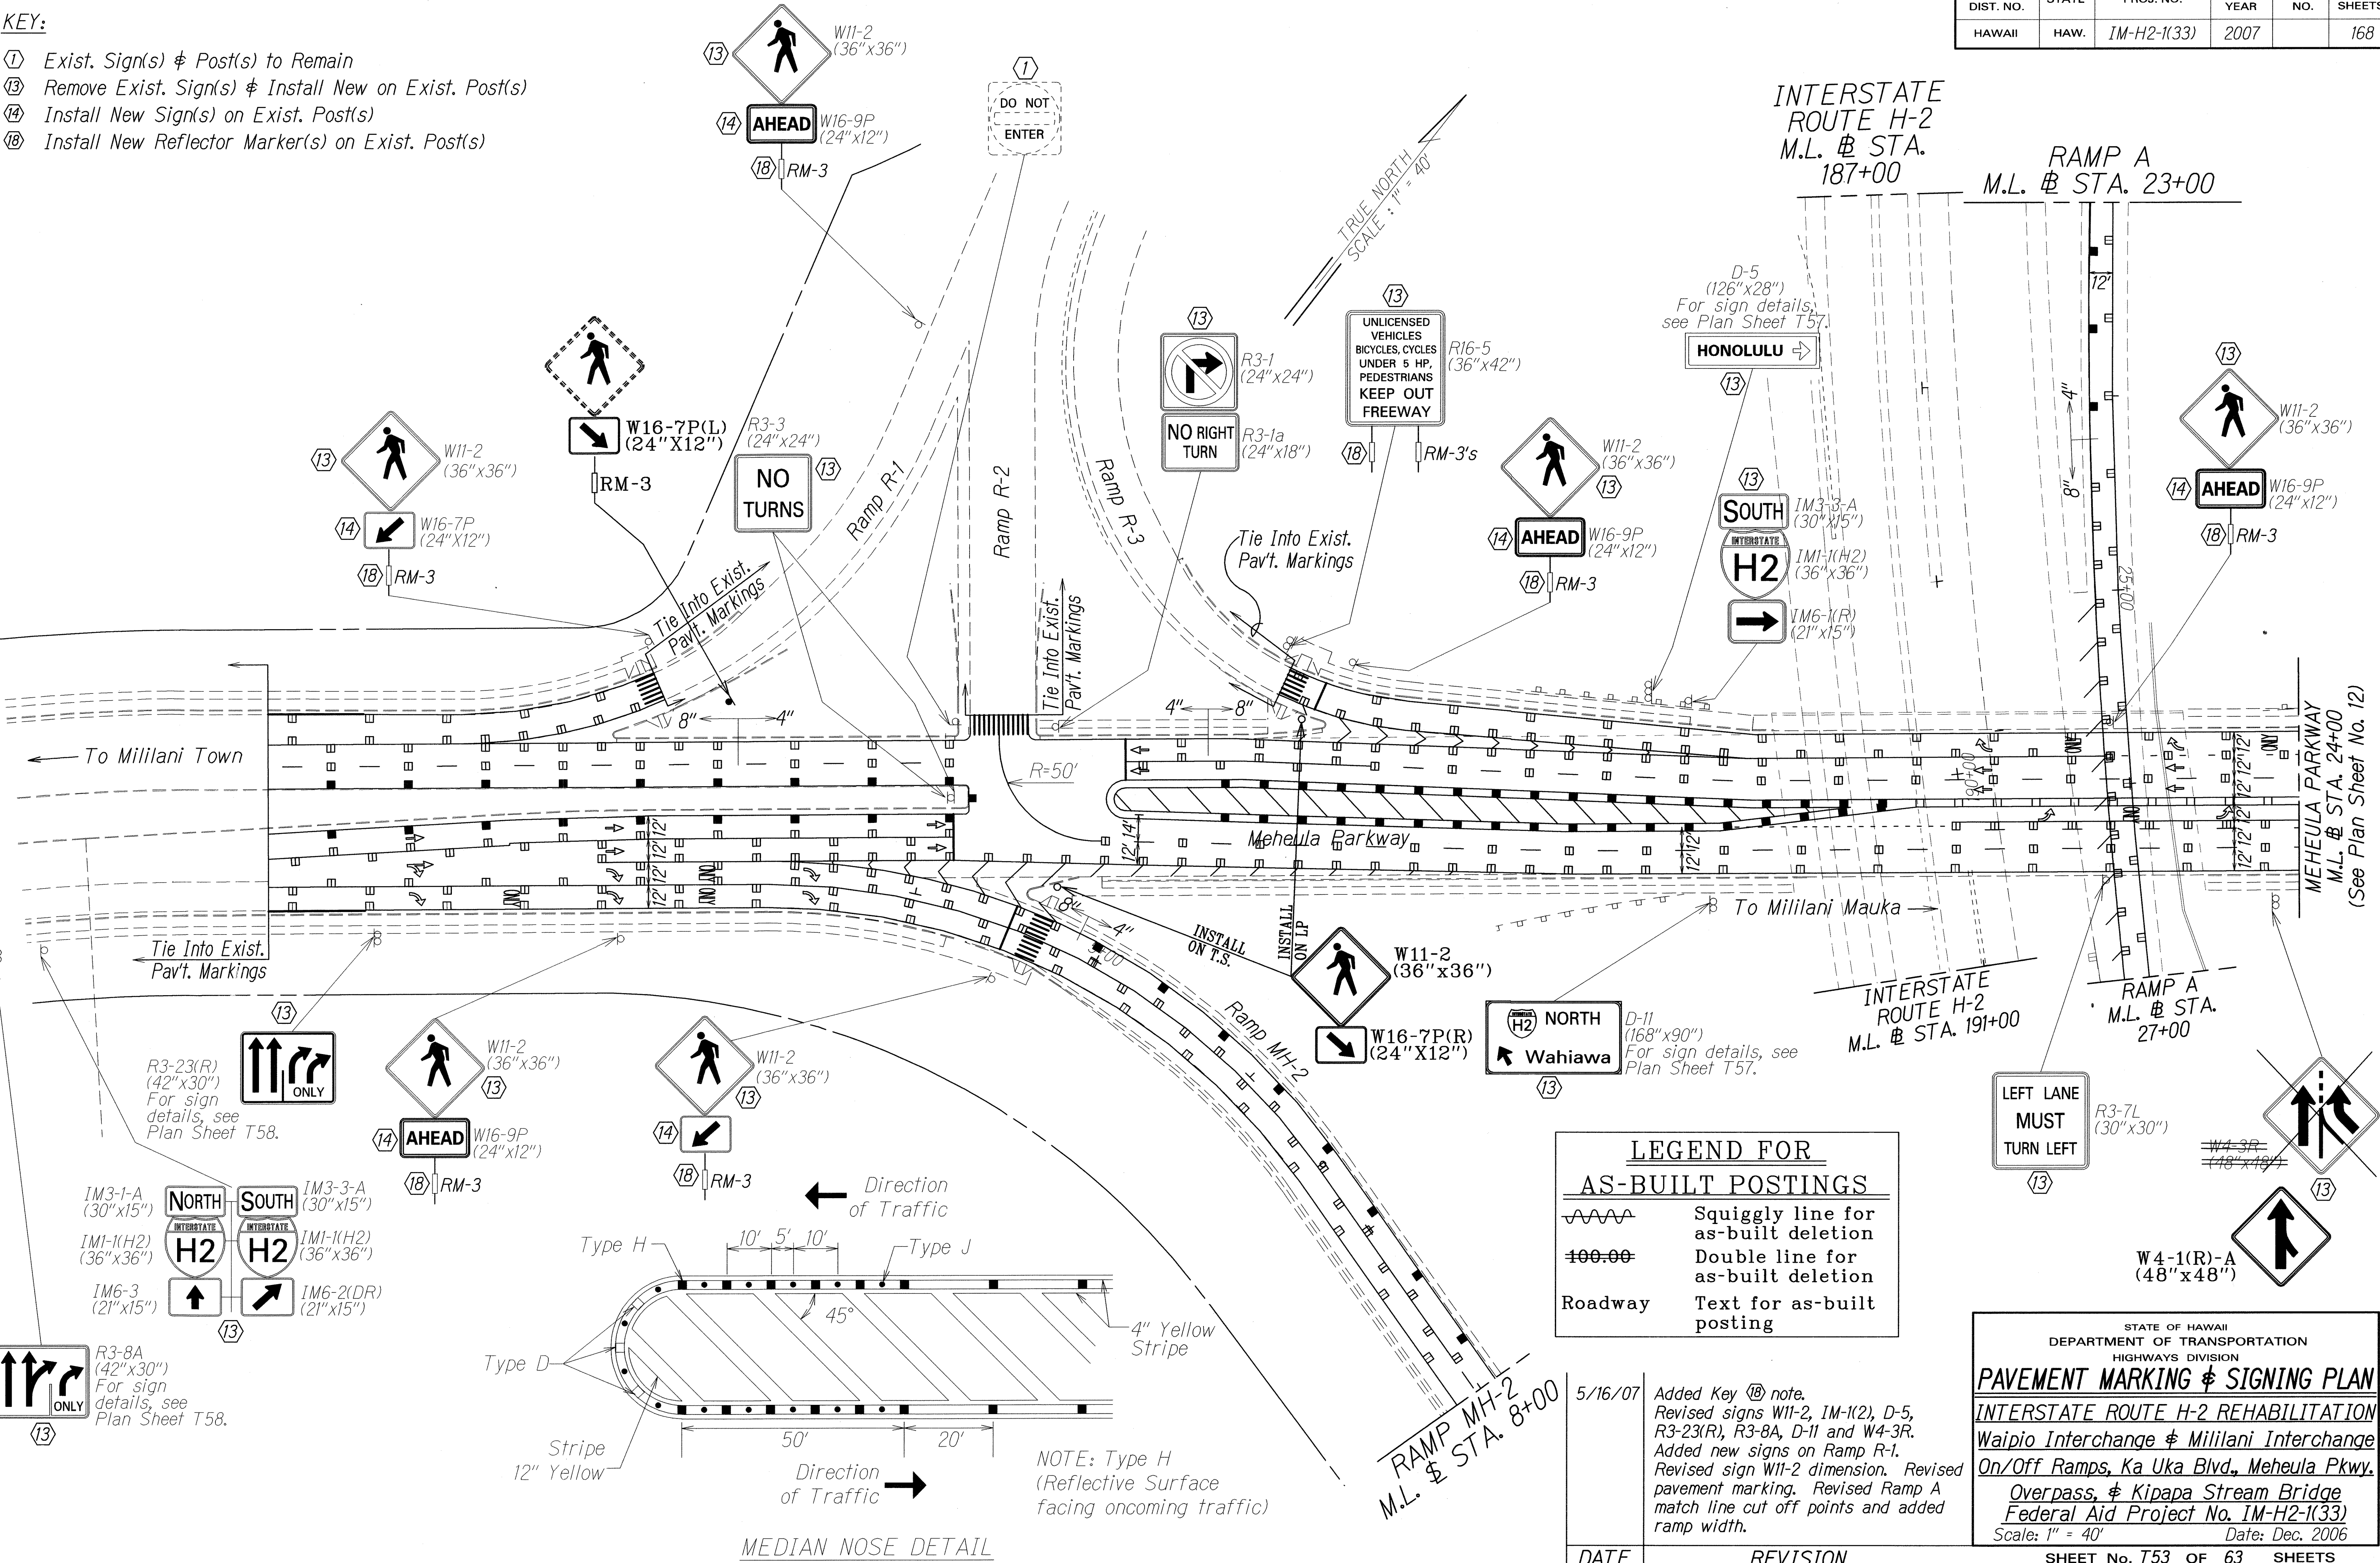

SURVEY PLOTTED BY	DATE
DRAWN BY	
TRACED BY	
QUANTITIES BY	
CHECKED BY	
ORIGINAL PLAN	
NOTE BOOK	
1/2" = 40'	
4/12/07	


LEGEND FOR AS-BUILT POSTINGS	
	Squiggly line for as-built deletion
	Double line for as-built deletion
Roadway	Text for as-built posting

5/16/07	Added Key ⑯ note. Revised signs W11-2, IM-1(2), D-5, R3-23(R), R3-8A, D-11 and W4-3R. Added new signs on Ramp R-1. Revised sign W11-2 dimension. Revised pavement marking. Revised Ramp A match line cut off points and added ramp width.
---------	---

STATE OF HAWAII DEPARTMENT OF TRANSPORTATION HIGHWAYS DIVISION
PAVEMENT MARKING & SIGNING PLAN
INTERSTATE ROUTE H-2 REHABILITATION
Waipio Interchange & Mililani Interchange
On/Off Ramps, Ka Uka Blvd., Meheula Pkwy.
Overpass, & Kipapa Stream Bridge
Federal Aid Project No. IM-H2-1(33)
Scale: 1" = 40' Date: Dec. 2006
SHEET No. T53 OF 63 SHEETS

ADD. 125

FED. ROAD DIST. NO.	STATE	FED. AID PROJ. NO.	FISCAL YEAR	SHEET NO.	TOTAL SHEETS
HAWAII	HAW.	IM-H2-1(33)	2007	ADD. 127	168

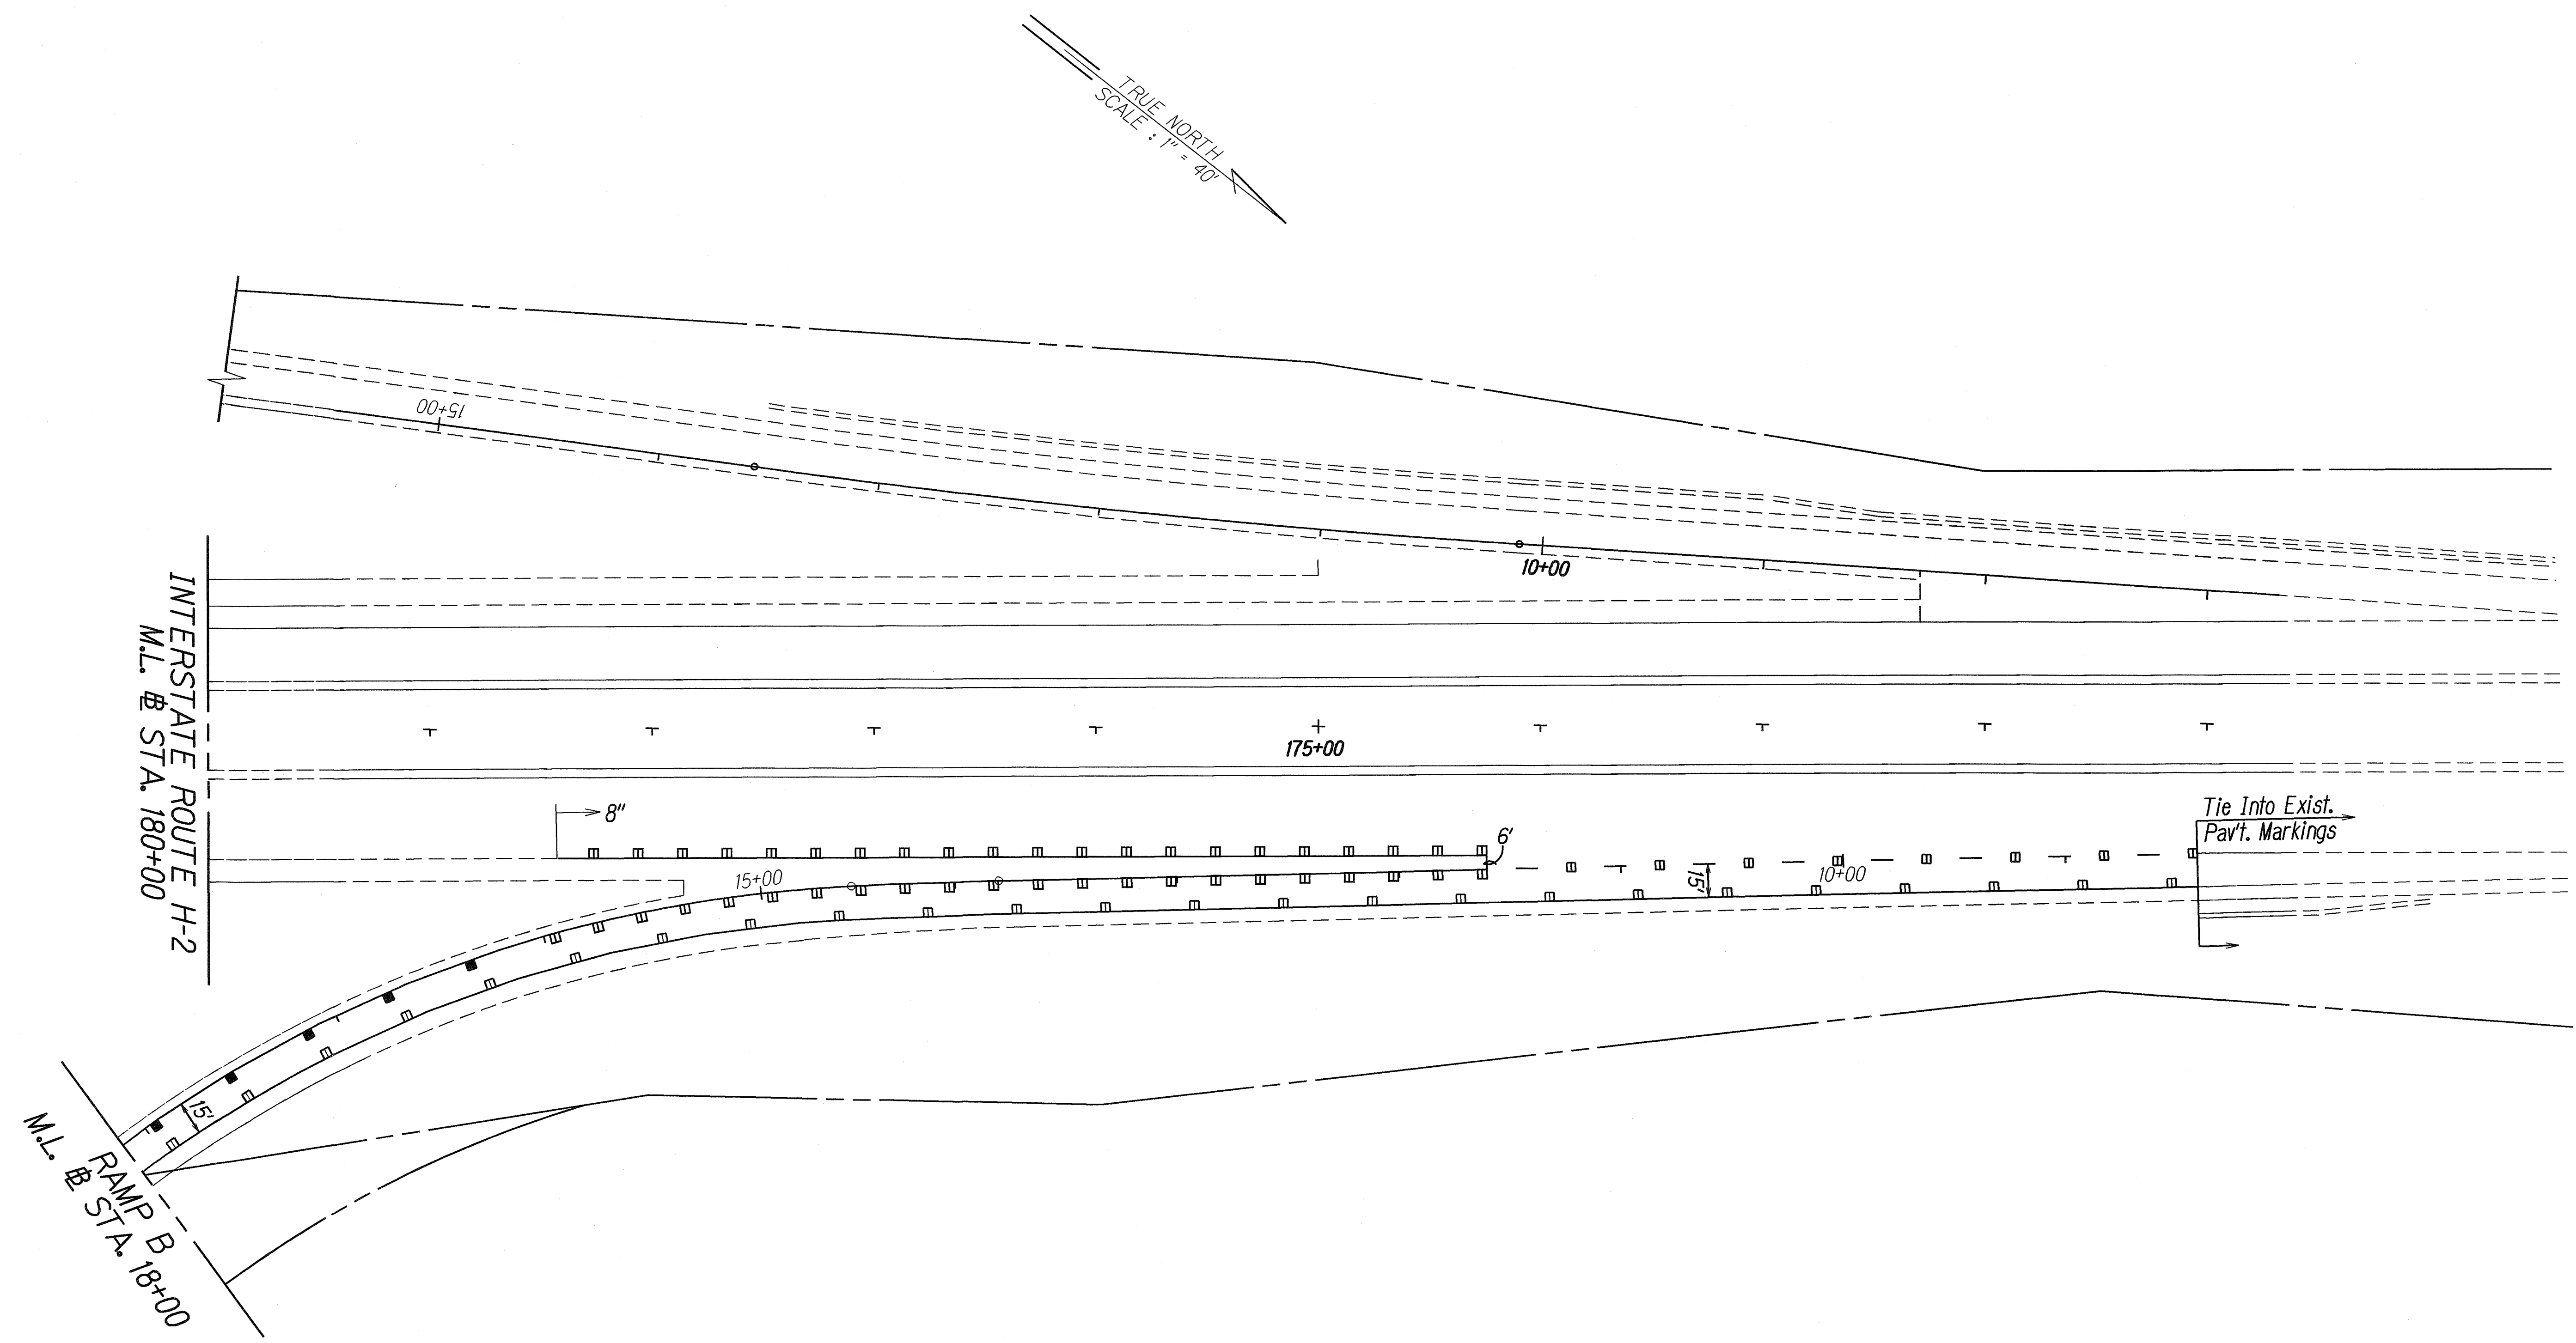

ORIGINAL PLAN	SURVEY PLOTTED BY	DATE
NOTE BOOK	DESIGNED BY	
	QUANTITIES BY	
	CHECKED BY	

5/16/07	Removed duplicate @ Sta. 15+00 on Ramp B.
DATE	REVISION

STATE OF HAWAII
DEPARTMENT OF TRANSPORTATION
HIGHWAYS DIVISION

PAVEMENT MARKING & SIGNING PLAN
INTERSTATE ROUTE H-2 REHABILITATION
Waipio Interchange & Mililani Interchange
On/Off Ramps, Ka Uka Blvd., Meheula Pkwy.
Overpass, & Kipapa Stream Bridge
Federal Aid Project No. IM-H2-1(33)
Scale: 1" = 40' Date: Dec. 2006

SHEET No. T56 OF 63 SHEETS