
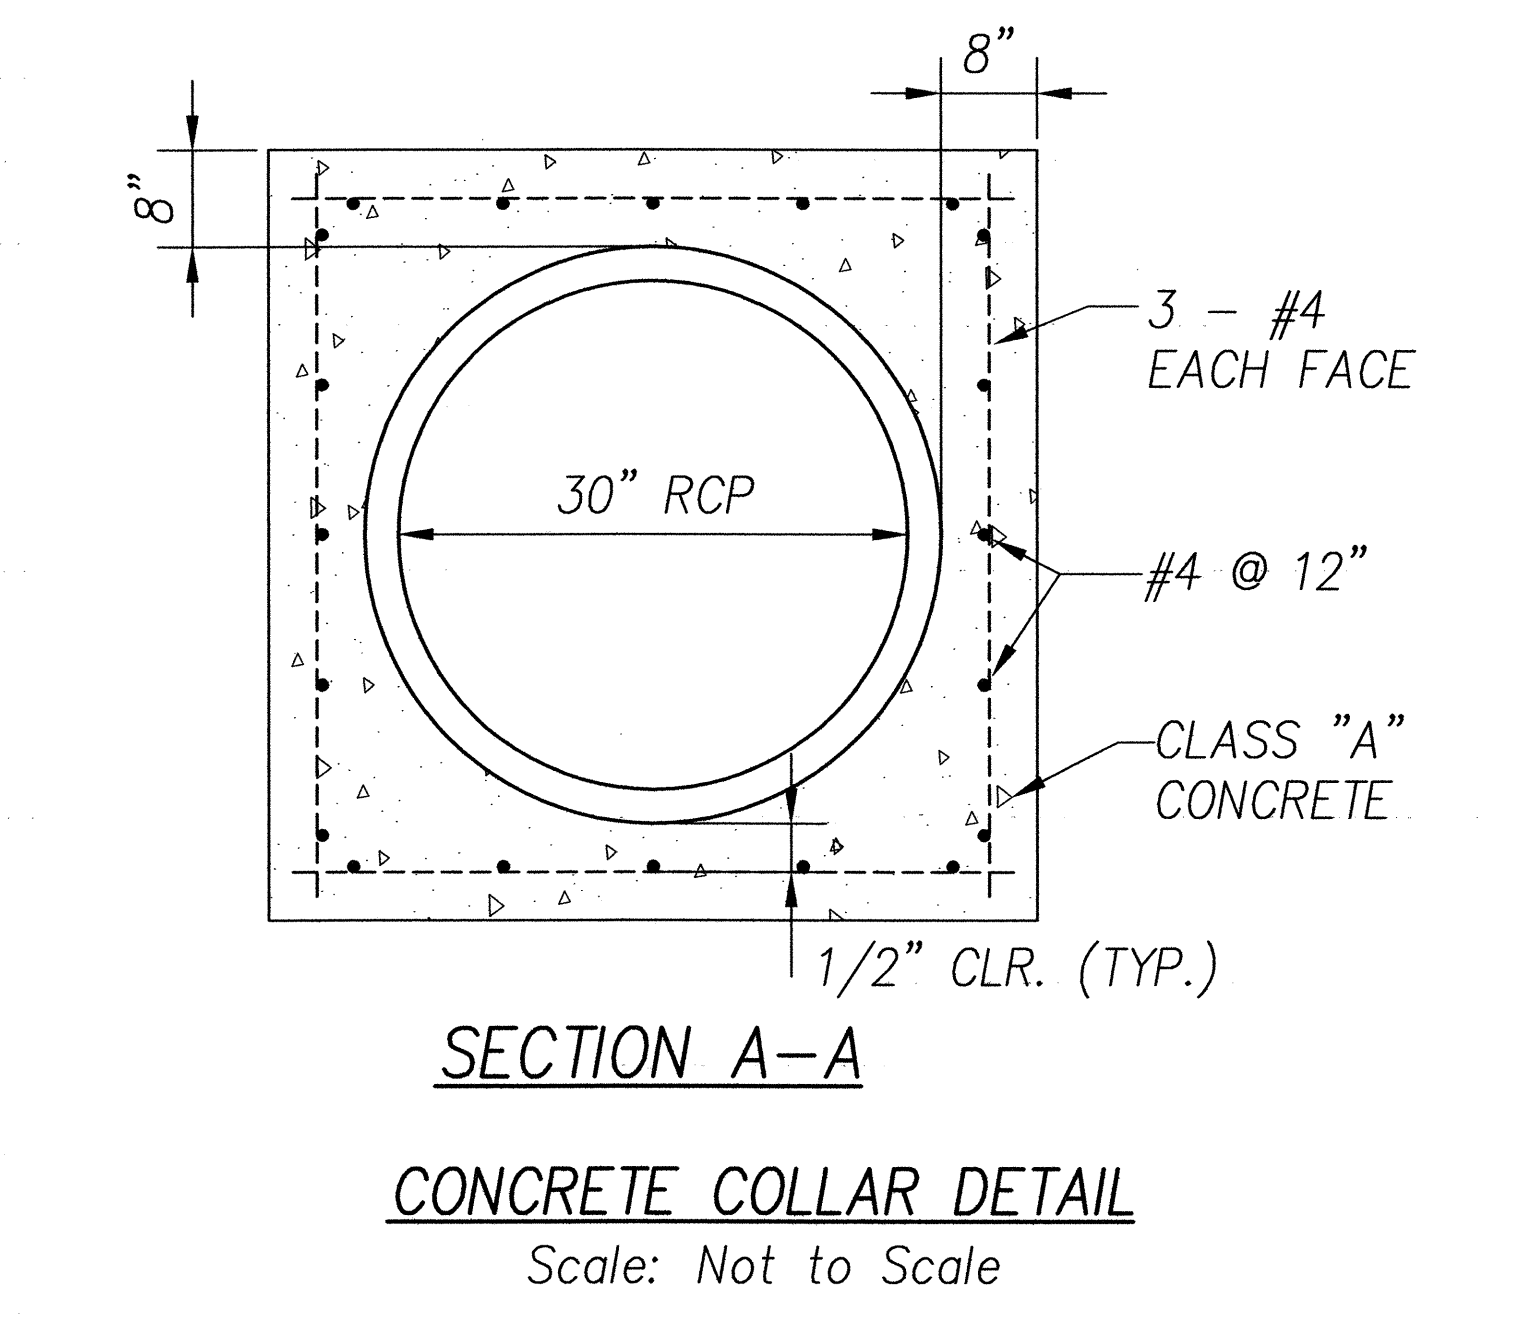
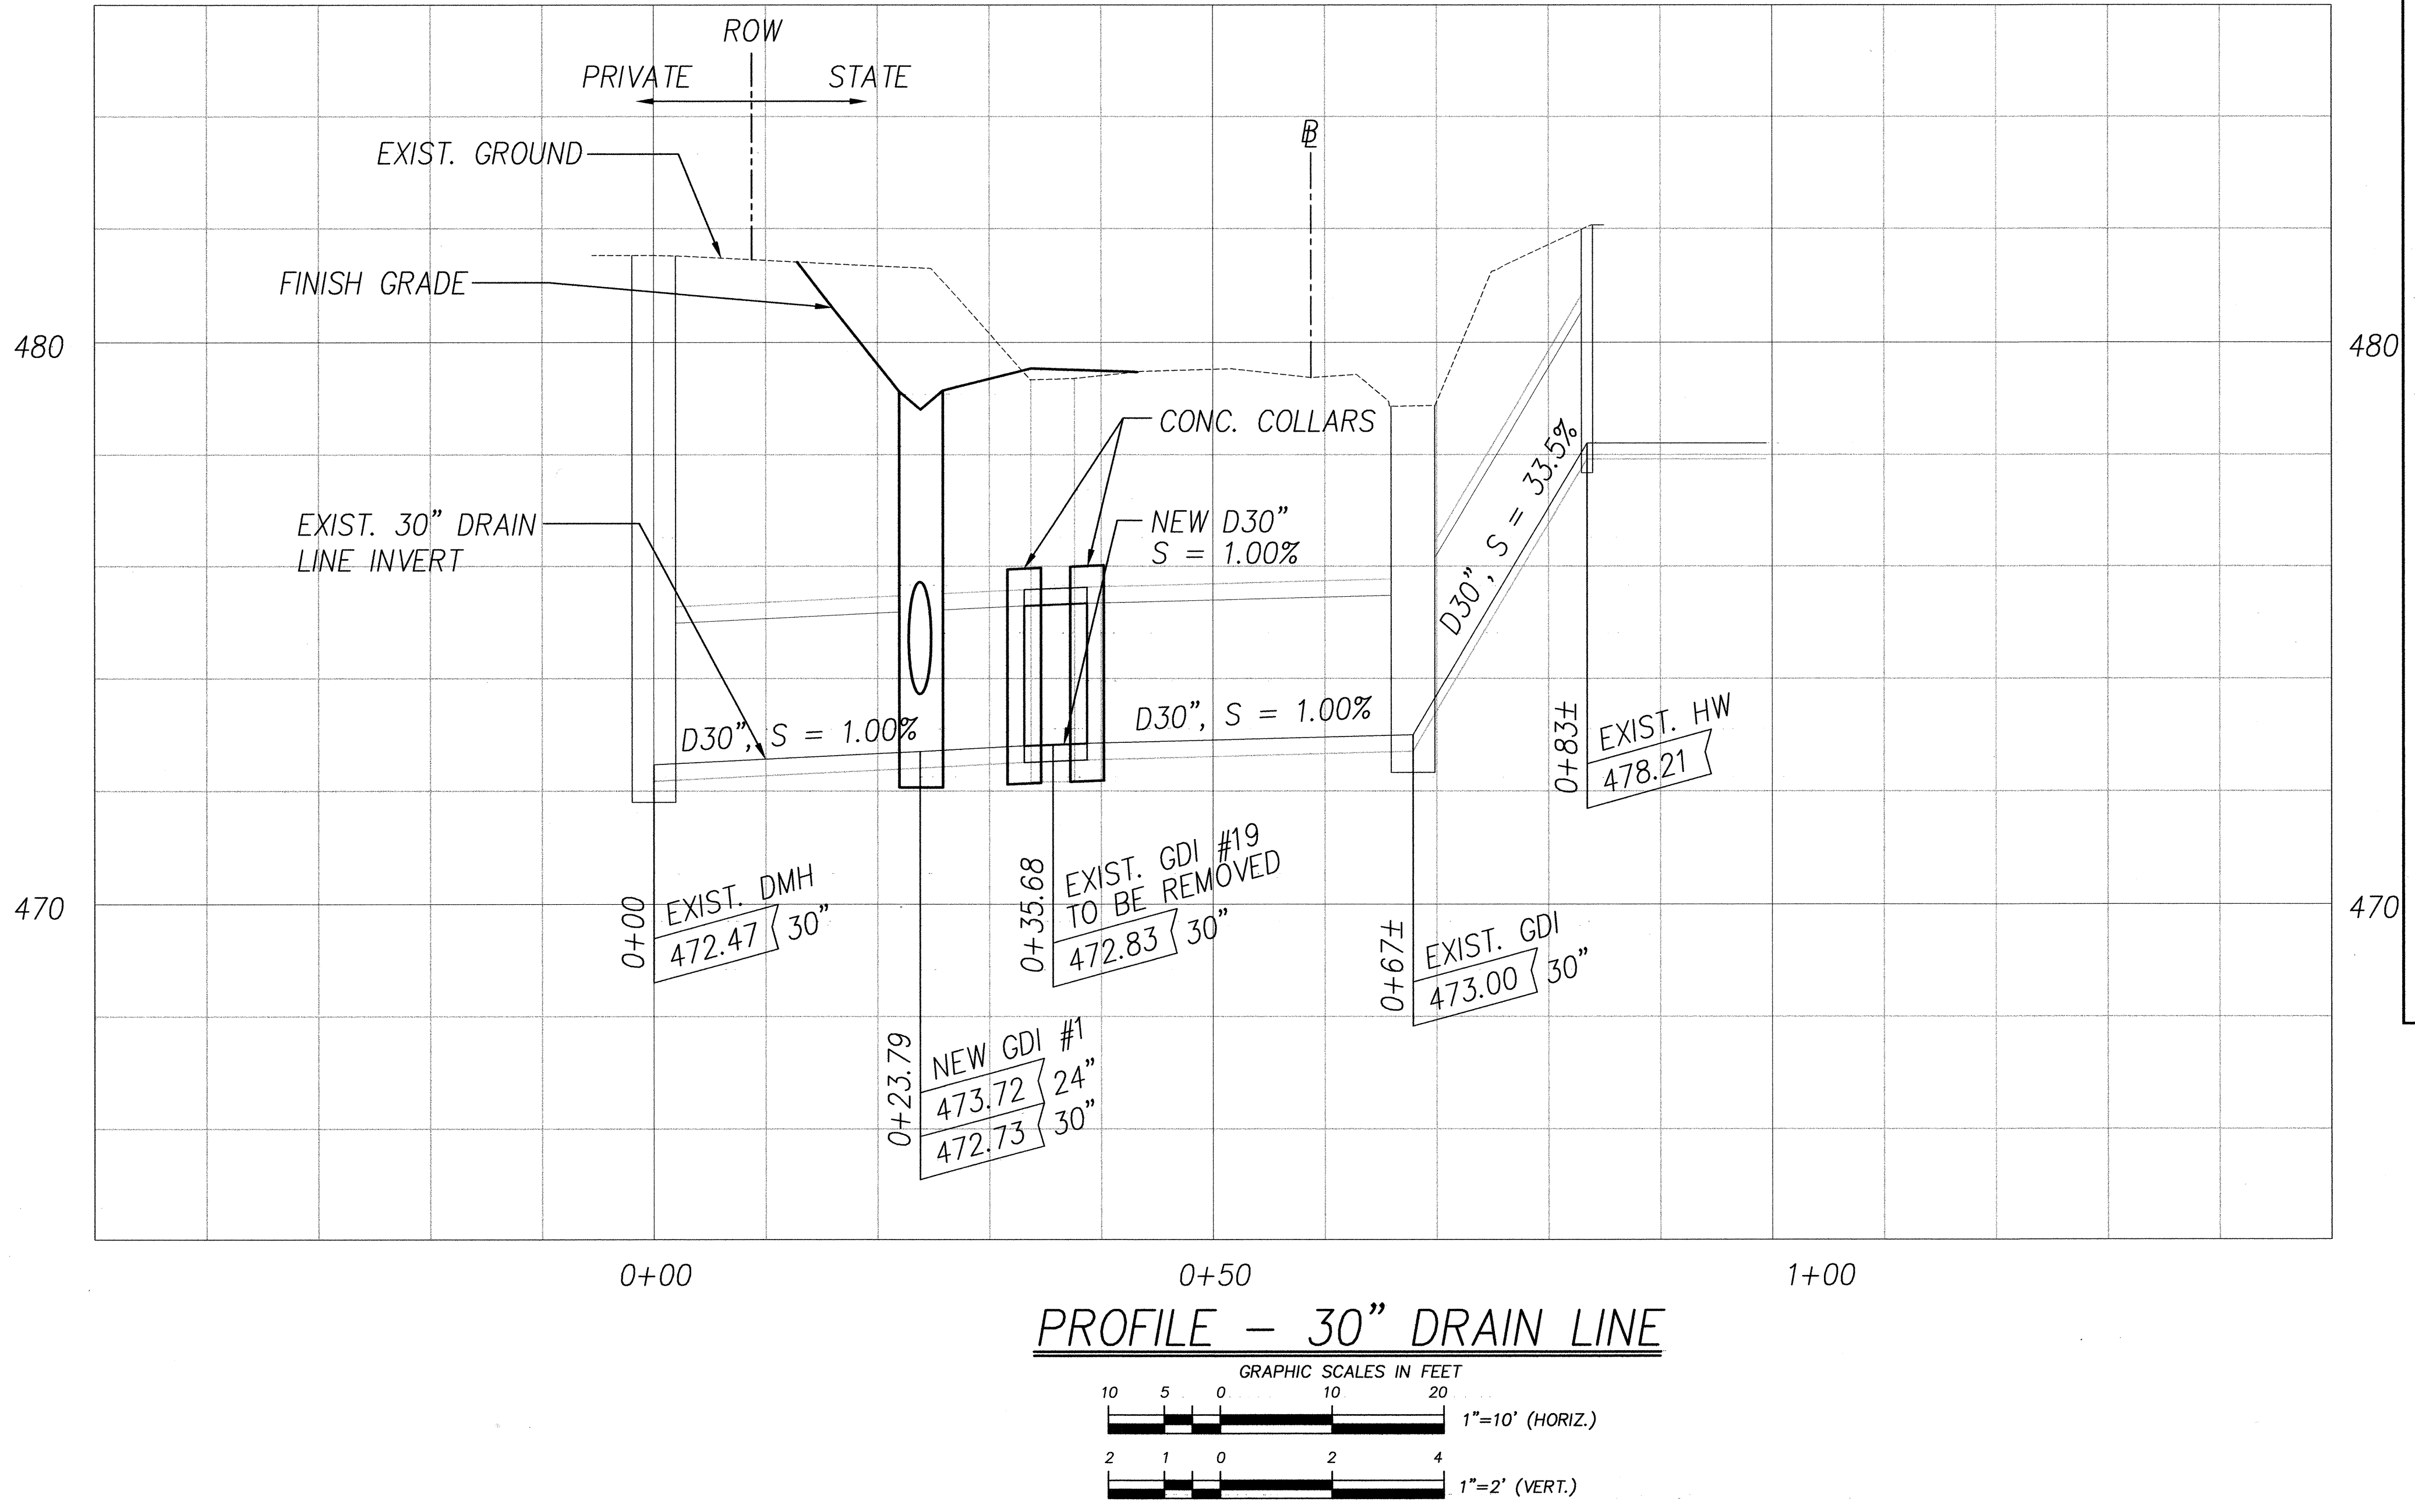
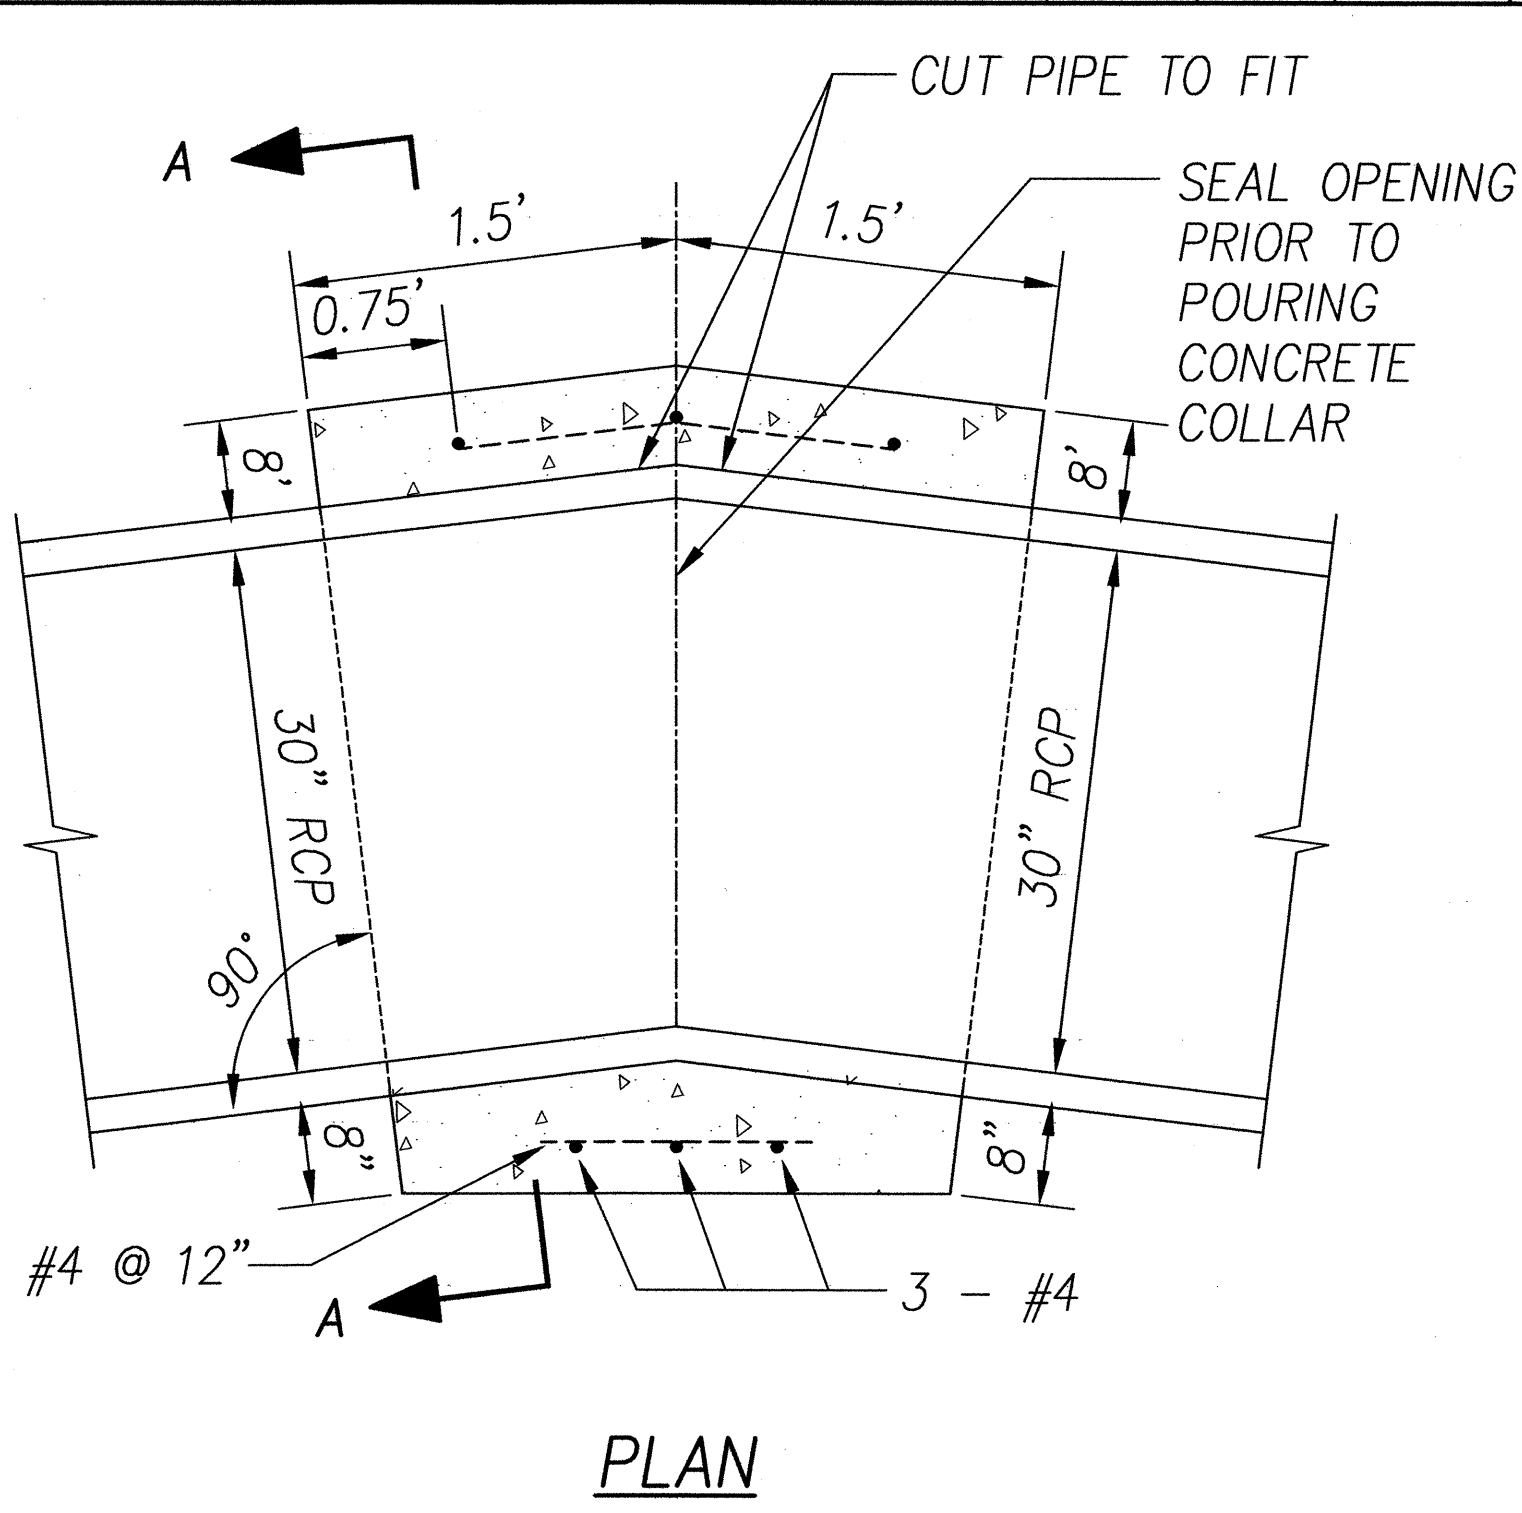


FED. ROAD DIST. NO.	STATE	PROJ. NO.	FISCAL YEAR	SHEET NO.	TOTAL SHEETS
HAWAII	HAW.	IM-H2-1(33)	2007	64	168

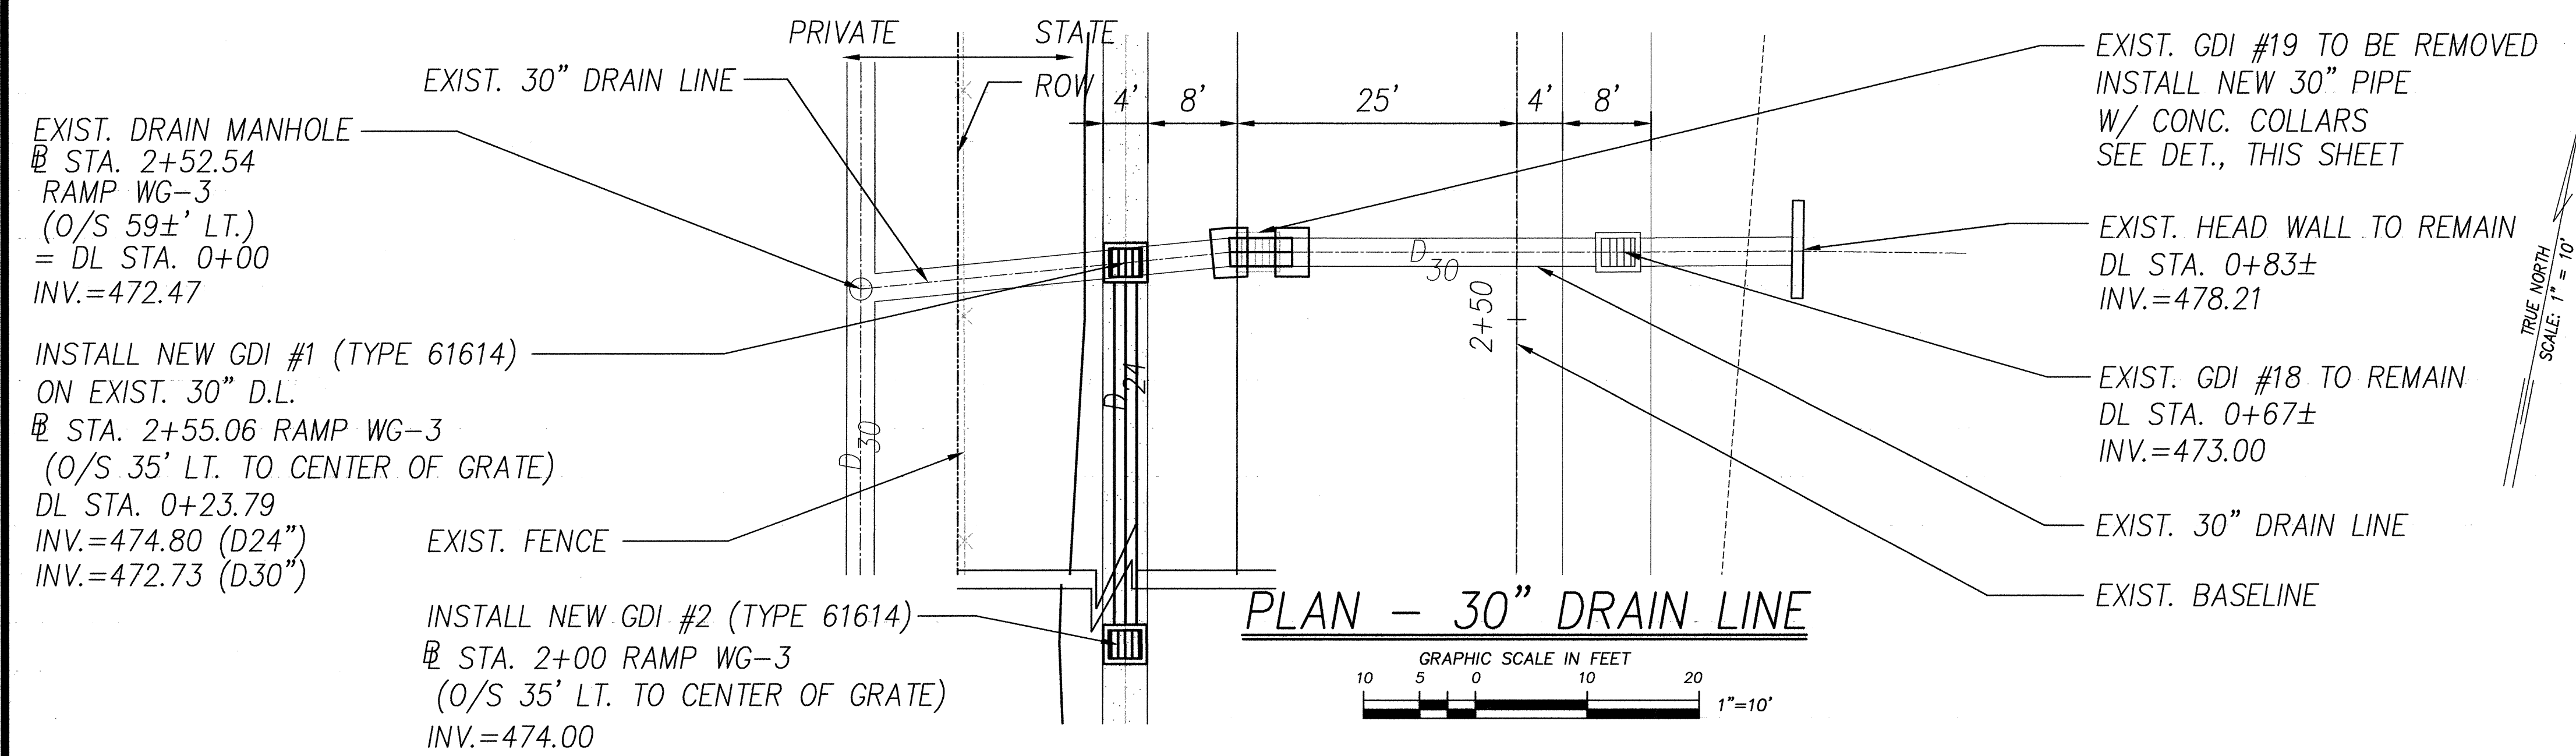

SURVEY PLOTTED BY	DATE
DRAWN BY	
TRACED BY	
CHECKED BY	
NOTED BY	
QUANTITIES BY	
CHECKED BY	
ORIGINAL PLAN	
NOTE BOOK	
No.	

KENNETH O. MAGI
LICENSED PROFESSIONAL ENGINEER
No. 3265-C
HAWAII, U.S.A.
SIGNATURE
APRIL 30, 2008
EXPIRATION DATE OF LICENSE
THIS WORK WAS PREPARED BY ME OR UNDER MY SUPERVISION

STATE OF HAWAII
DEPARTMENT OF TRANSPORTATION
HIGHWAYS DIVISION
PLAN & PROFILE - 30" DRAIN LINE
WAIPIO INTERCHANGE, RAMP WG-3
INTERSTATE ROUTE H-2 REHABILITATION
Waipio Interchange and Mililani Interchange
On/Off Ramps, Ka Uka Boulevard and
Meheula Parkway Overpasses, & Kipapa Stream Bridge
Federal Aid Project No. IM-H2-1(33)
SCALE: AS NOTED DATE: NOVEMBER 2006
SHEET No. 1 OF 1 SHEETS