


FED. ROAD DIST. NO.	STATE	FED. AID PROJ. NO.	FISCAL YEAR	SHEET NO.	TOTAL SHEETS
HAWAII	HAW.	1M-H2-1(33)	2007	ADD. 43	168

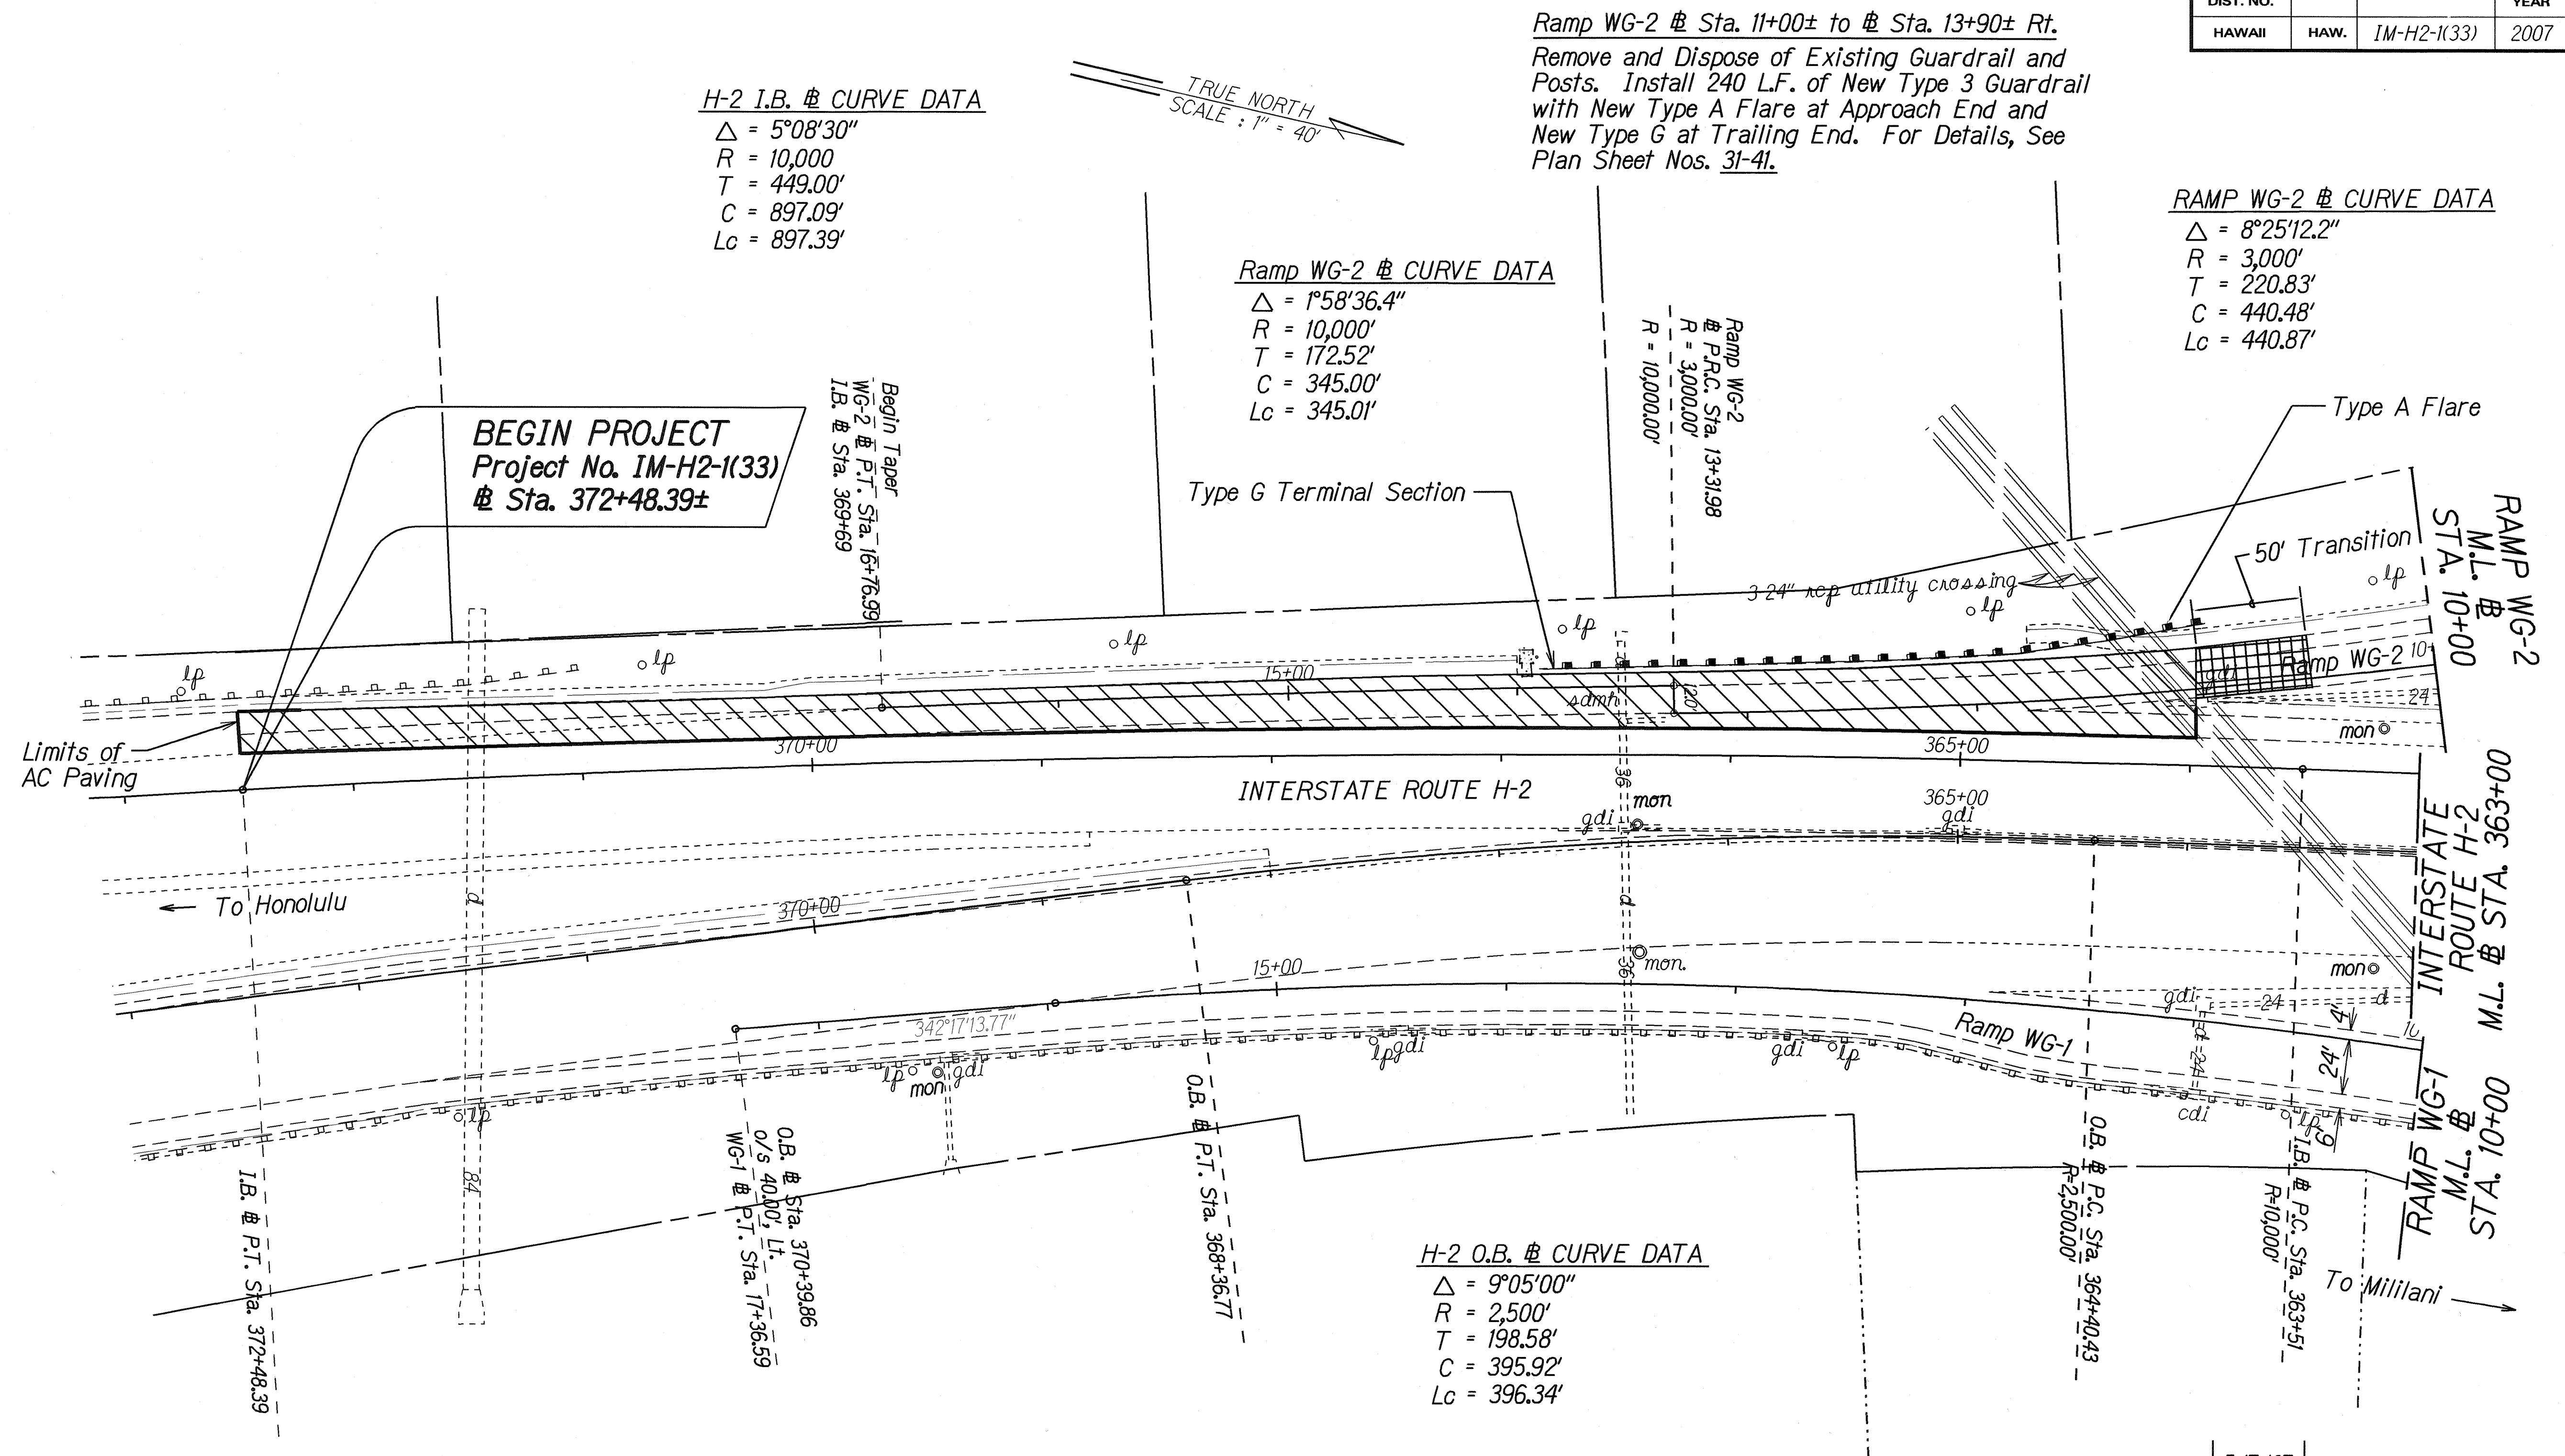

5/7/07	Moved transition area, revised pavement work at on-ramp.
--------	--


DATE	REVISION
STATE OF HAWAII DEPARTMENT OF TRANSPORTATION HIGHWAYS DIVISION WAIPIO INTERCHANGE ROADWAY PLANS INTERSTATE ROUTE H-2 REHABILITATION Waipio Interchange and Millilani Interchange On/Off Ramps, Ka Uka Boulevard and Meheula Parkway Overpasses, & Kipapa Stream Bridge Federal Aid Project No. 1M-H2-1(33) Scale: 1" = 40' Date: December, 2006	

SHEET No. 1 OF 17 SHEETS

ADD. 43

DATE	_____
SURVEY PLANNED BY	_____
DESIGNED BY	_____
TRACED BY	_____
QUANTITIES BY	_____
CHECKED BY	_____
ORIGINAL PLAN	_____
NOTE BOOK	_____

FED. ROAD DIST. NO.	STATE	FED. AID PROJ. NO.	FISCAL YEAR	SHEET NO.	TOTAL SHEETS
HAWAII	HAW.	IM-H2-1(33)	2007	44	168

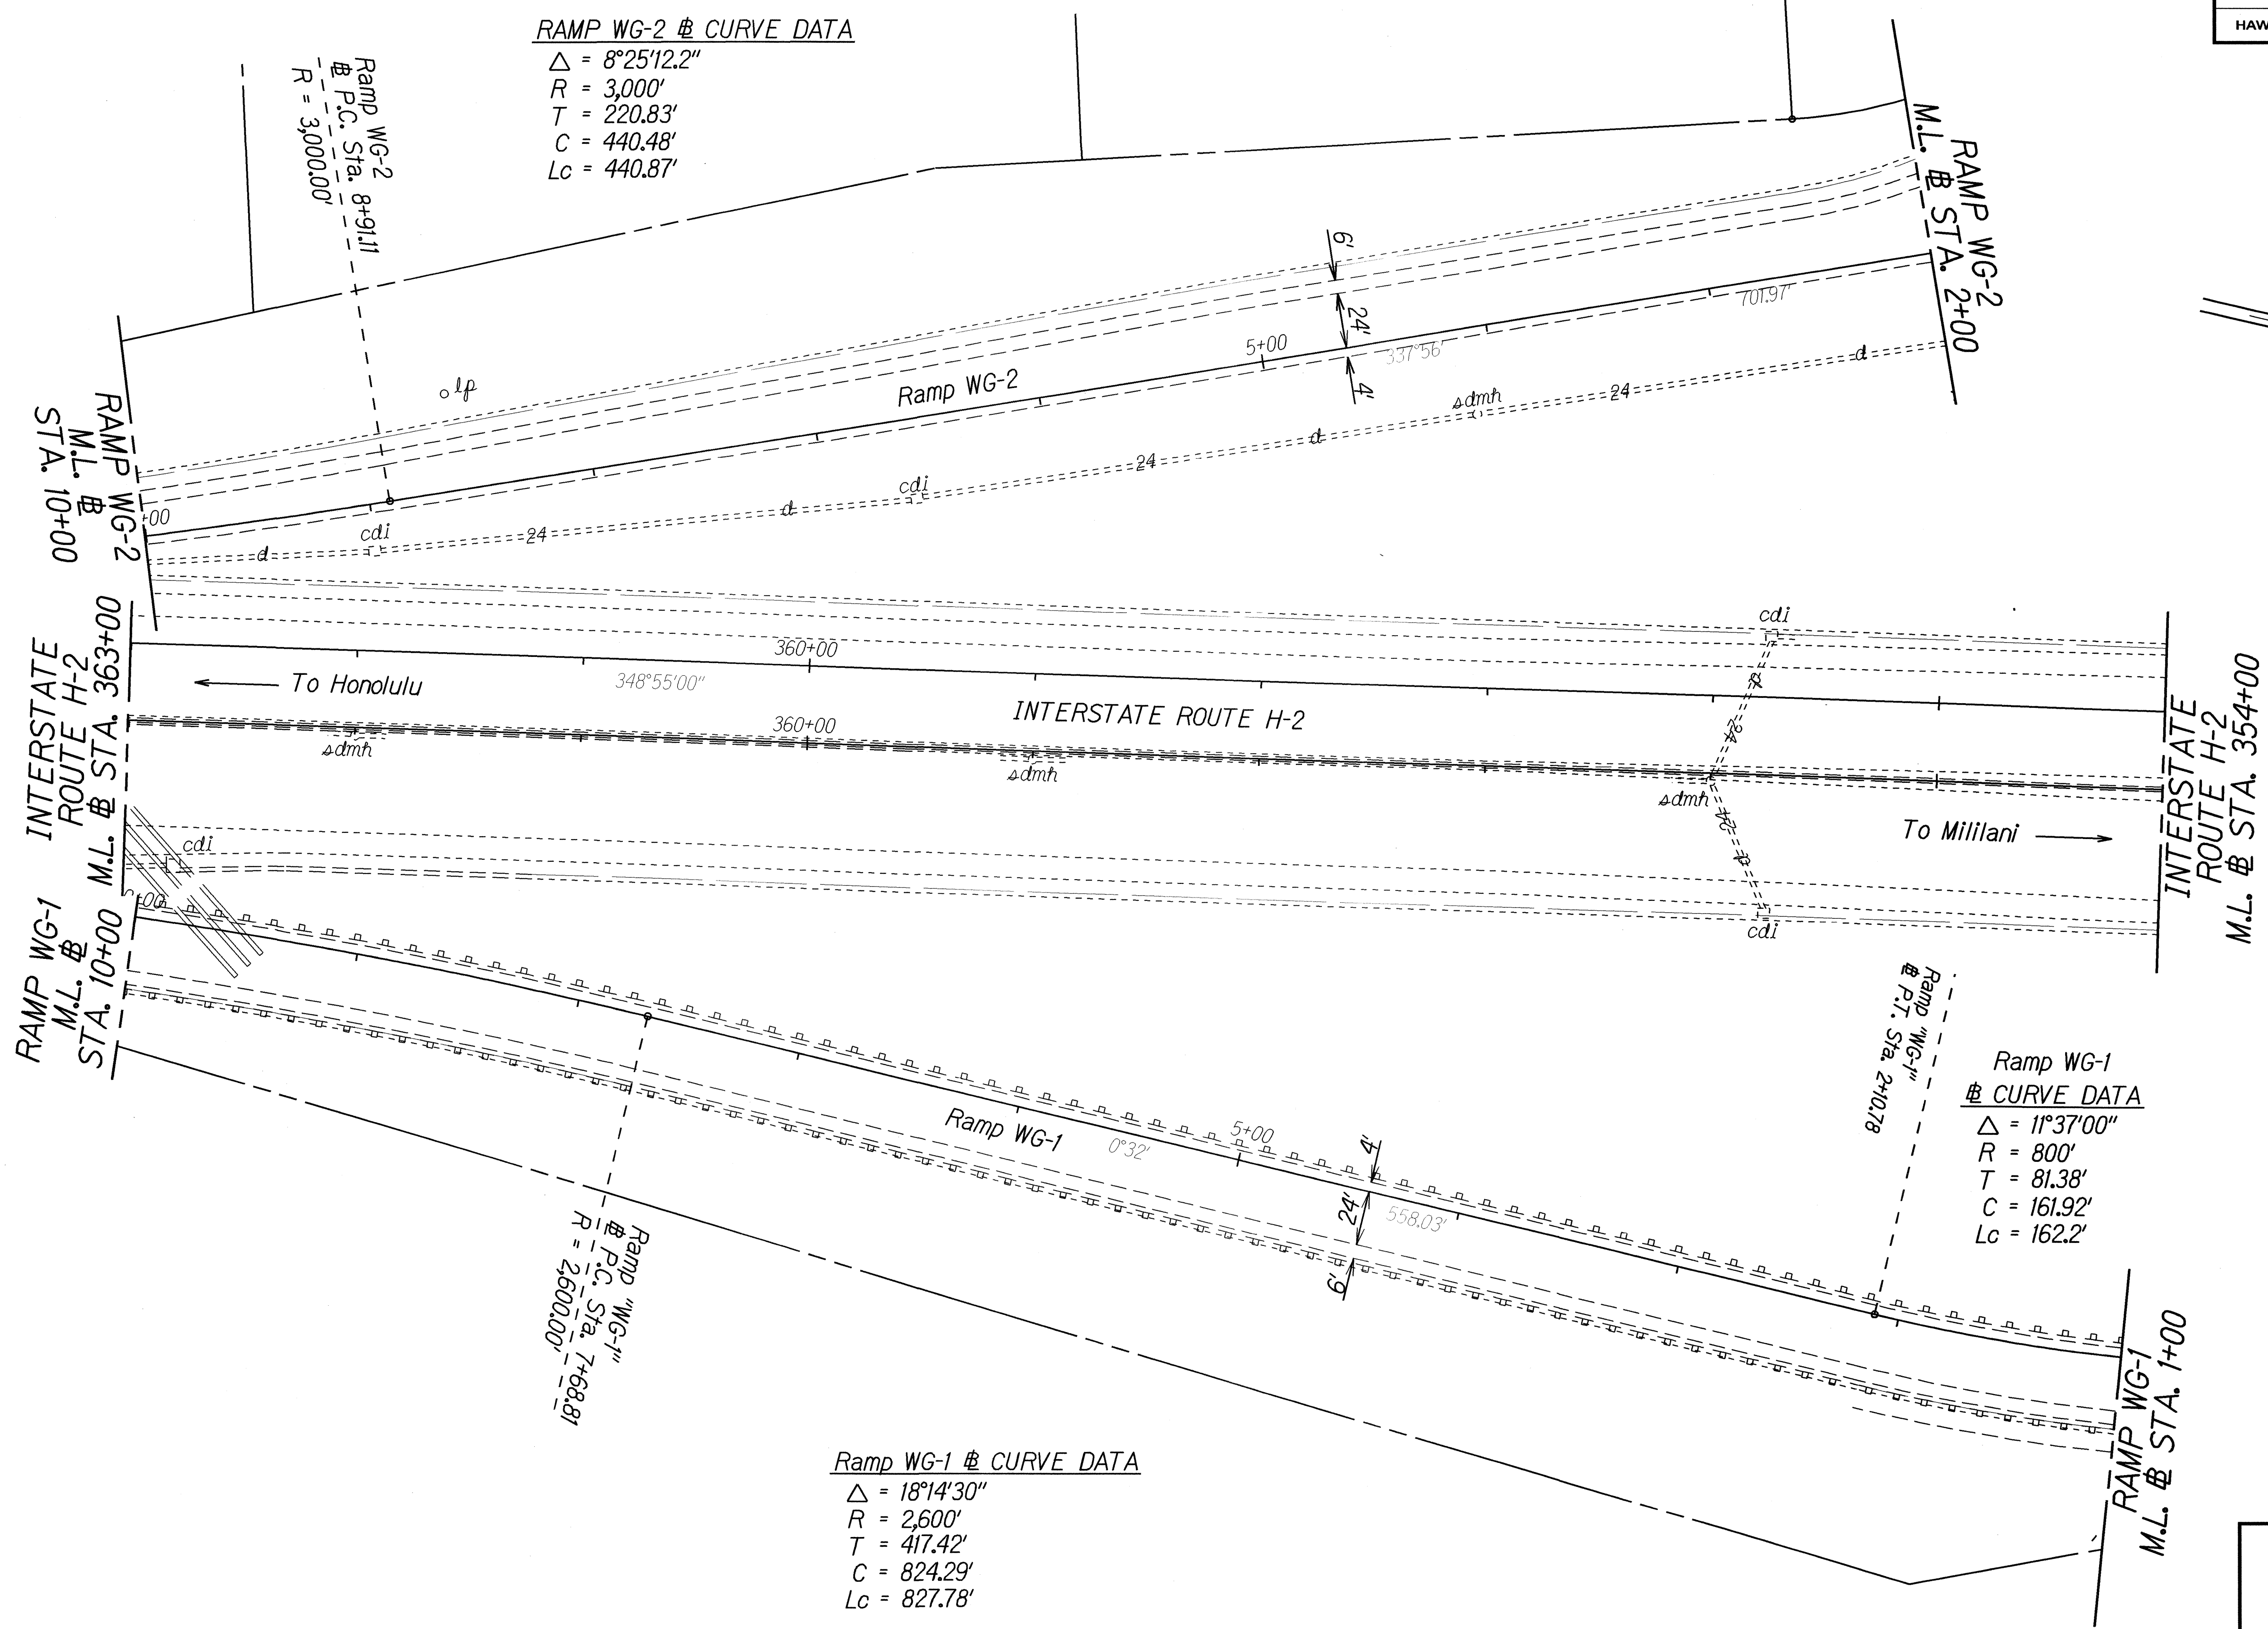

RAMP WG-2 & CURVE DATA
 $\Delta = 8^{\circ}25'12.2''$
 $R = 3,000'$
 $T = 220.83'$
 $C = 440.48'$
 $Lc = 440.87'$

Ramp WG-1 & CURVE DATA
 $\Delta = 11^{\circ}37'00''$
 $R = 800'$
 $T = 81.38'$
 $C = 161.92'$
 $Lc = 162.2'$


Ramp WG-1 & CURVE DATA
 $\Delta = 18^{\circ}14'30''$
 $R = 2,600'$
 $T = 417.42'$
 $C = 824.29'$
 $Lc = 827.78'$

ORIGINAL PLAN	SURVEY PLOTTED BY	DATE
NOTE BOOK	DESIGNED BY	
	QUANTITIES BY	
	CHECKED BY	

STATE OF HAWAII
DEPARTMENT OF TRANSPORTATION
HIGHWAYS DIVISION
WAIPIO INTERCHANGE
ROADWAY PLANS
INTERSTATE ROUTE H-2 REHABILITATION
Waipio Interchange and Millilani Interchange
On/Off Ramps, Ka Uka Boulevard and
Meheula Parkway Overpasses, & Kipapa Stream Bridge
Federal Aid Project No. IM-H2-1(33)
Scale: 1" = 40' Date: December, 2006

FED. ROAD DIST. NO.	STATE	FED. AID PROJ. NO.	FISCAL YEAR	SHEET NO.	TOTAL SHEETS
HAWAII	HAW.	IM-H2-1(33)	2006	45	168

Ramp WG-3 @ Sta. 6+05± Lt. to Ramp WG-3 @ Sta. 6+05± Lt.
Install New Right Turn Lane.
For Details, See Plan Sheet Nos. 42, and 49-51.

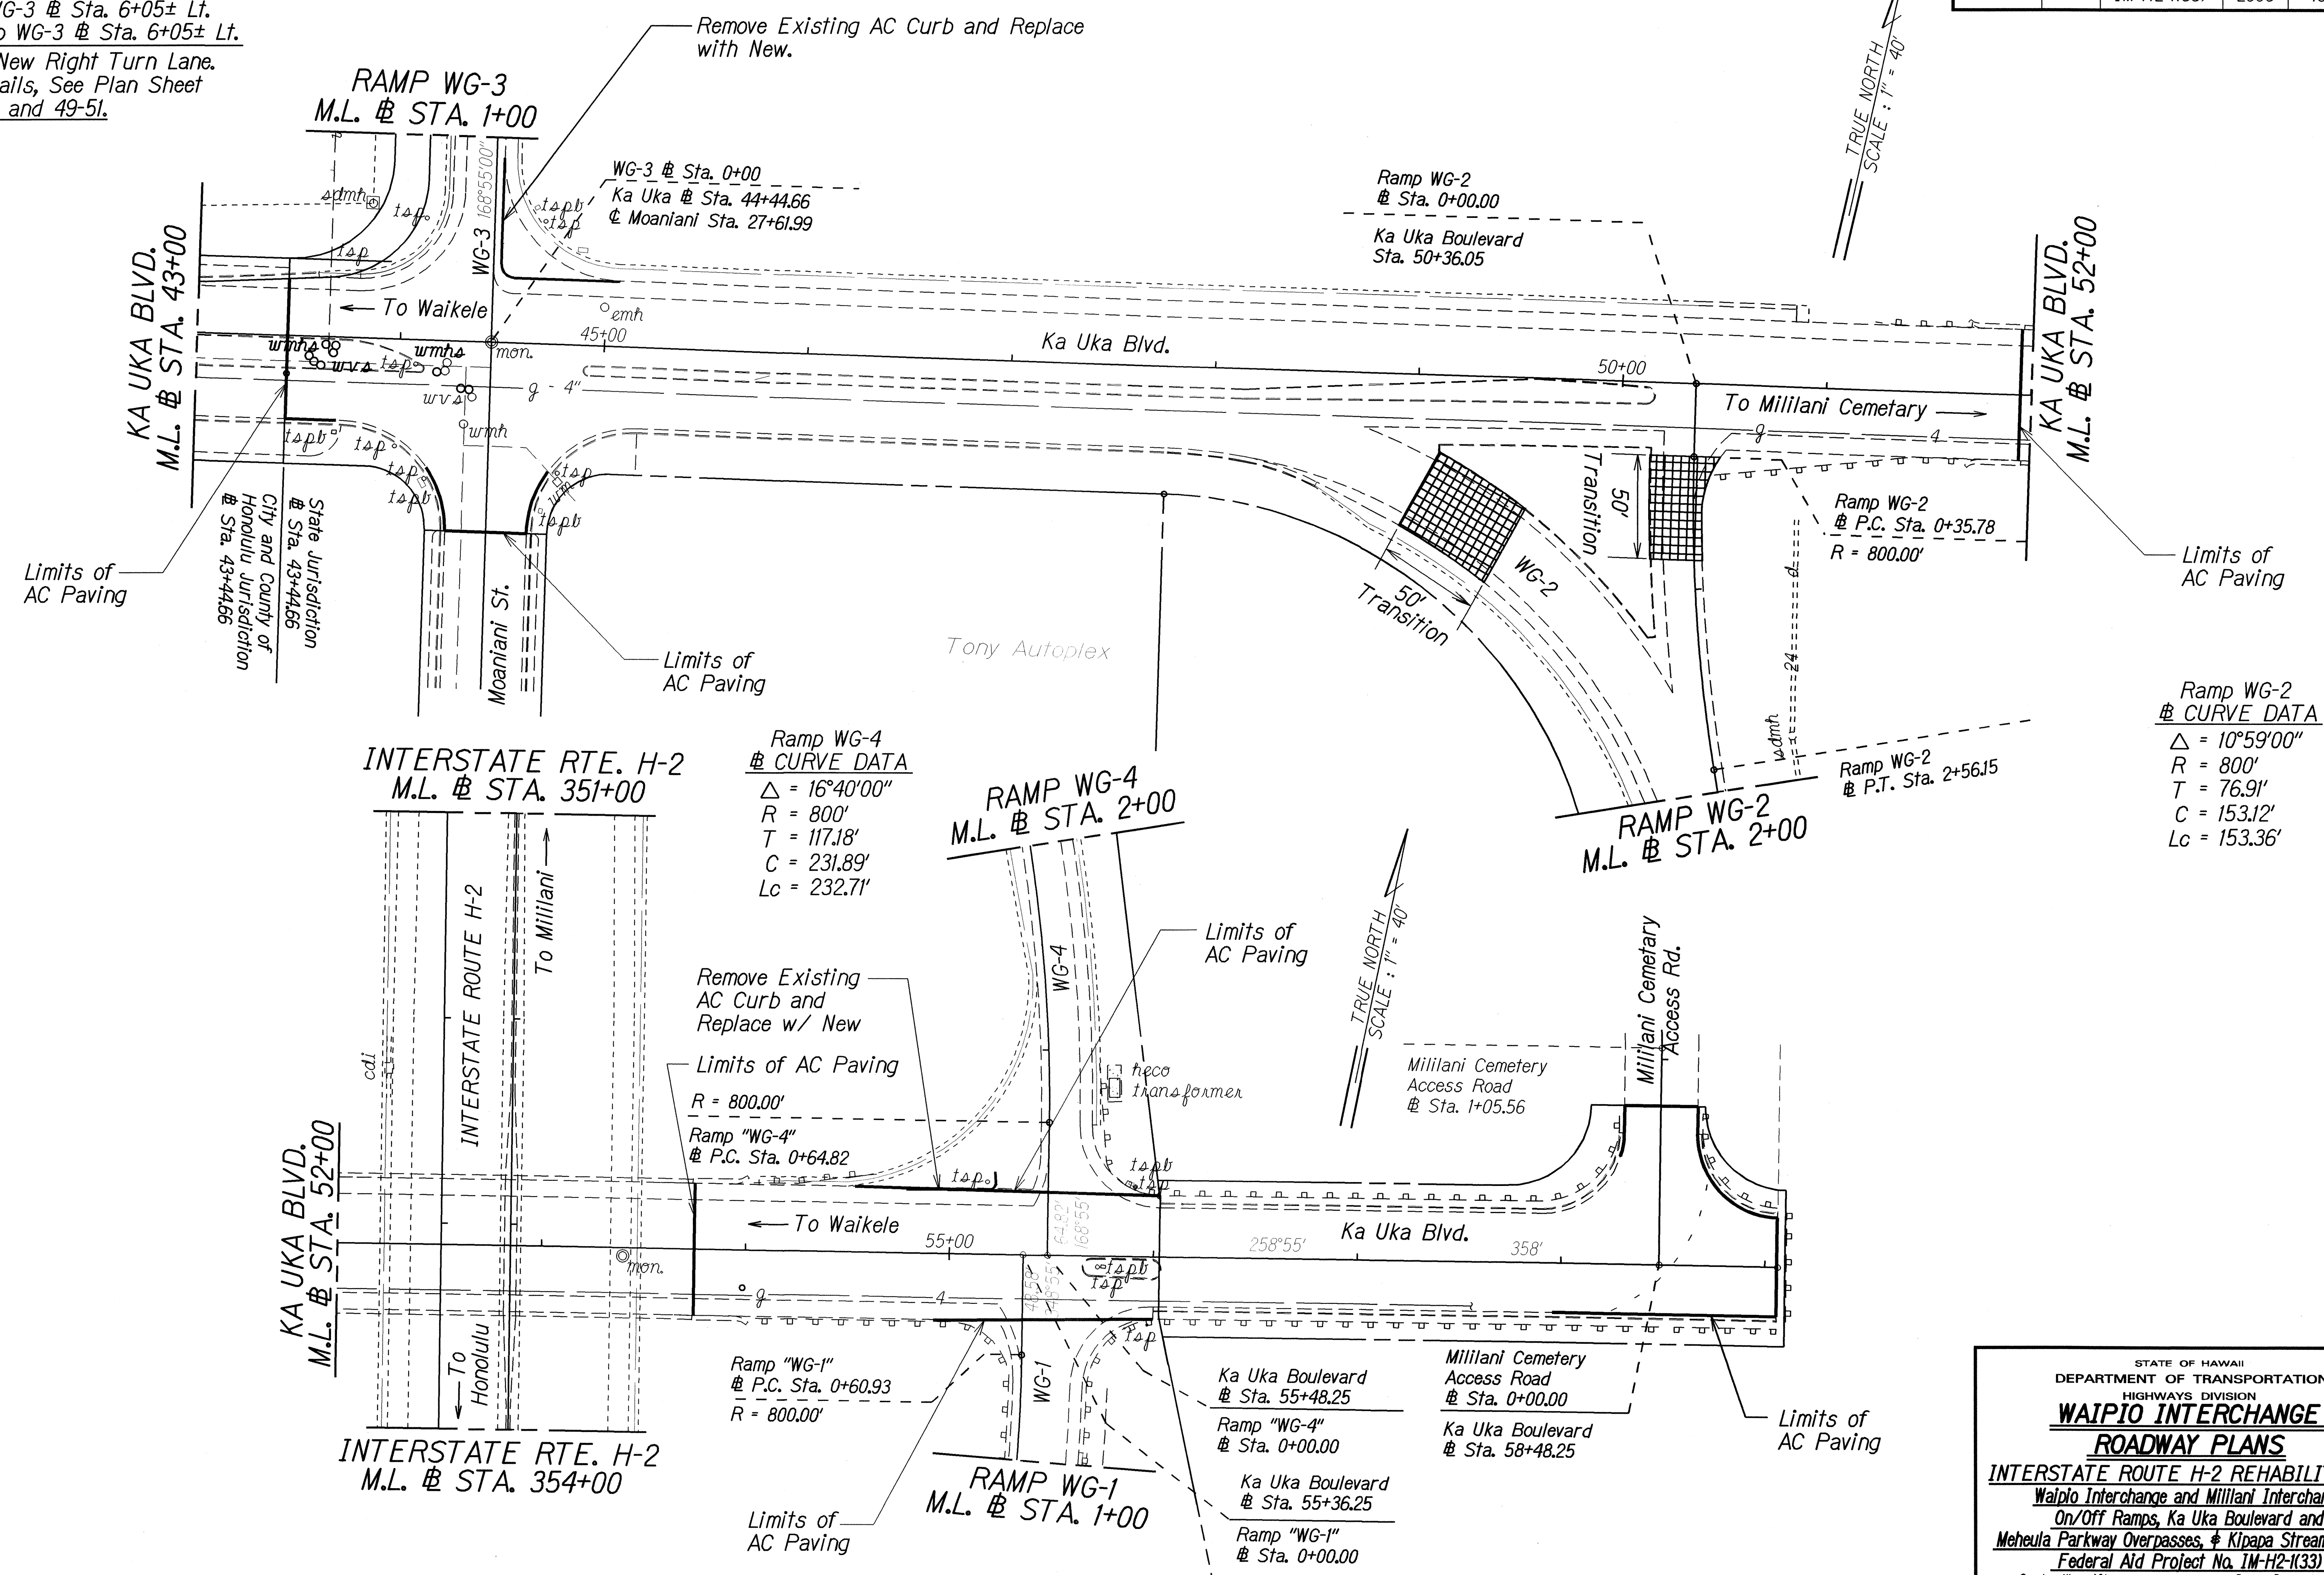

DESIGNED BY	DATE
DRAWN BY	
CHECKED BY	
NOTED BY	
DATE	



STATE OF HAWAII
DEPARTMENT OF TRANSPORTATION
HIGHWAYS DIVISION

WAIPIO INTERCHANGE
ROADWAY PLANS
INTERSTATE ROUTE H-2 REHABILITATION
Waipio Interchange and Millilani Interchange
On/Off Ramps, Ka Uka Boulevard and
Meheula Parkway Overpasses, & Kipapa Stream Bridge
Federal Aid Project No. IM-H2-1(33)
Scale: 1" = 40' Date: December, 2006

SHEET No. 3 OF 17 SHEETS

FED. ROAD DIST. NO.	STATE	FED. AID PROJ. NO.	FISCAL YEAR	SHEET NO.	TOTAL SHEETS
HAWAII	HAW.	IM-H2-1(33)	2006	ADD. 46	168

Ka Uka Blvd. @ Sta. 43+60± Lt.
to Ramp WG-3 @ Sta. 6+05± Lt.
Install New Right Turn Lane.
For Details, See Plan Sheet
Nos. 42, and 49-51.

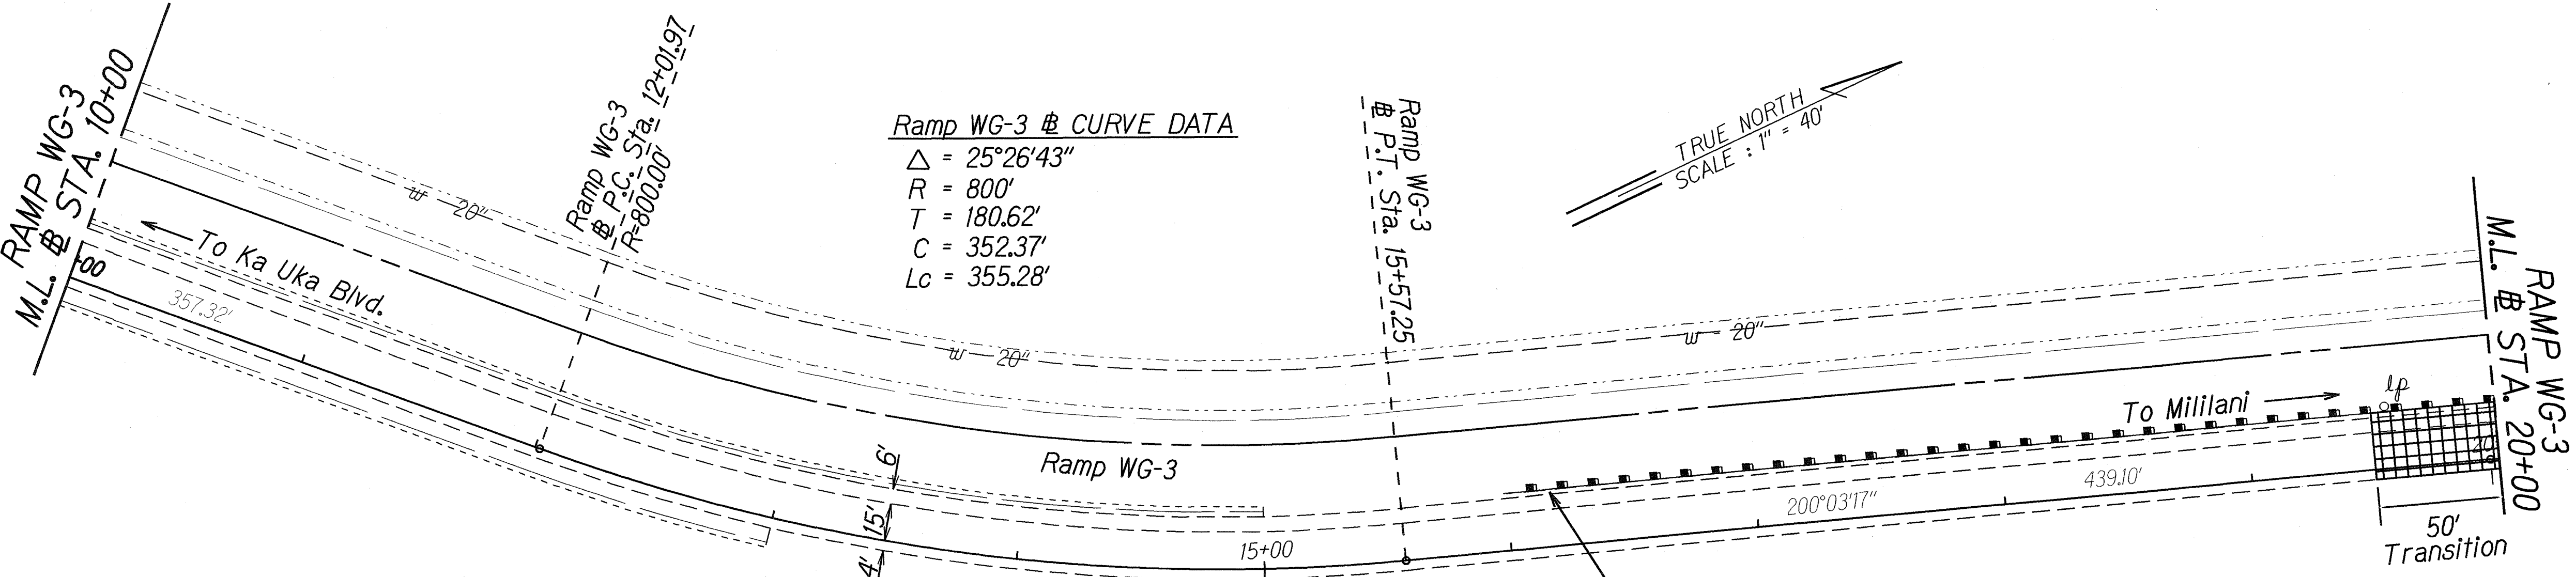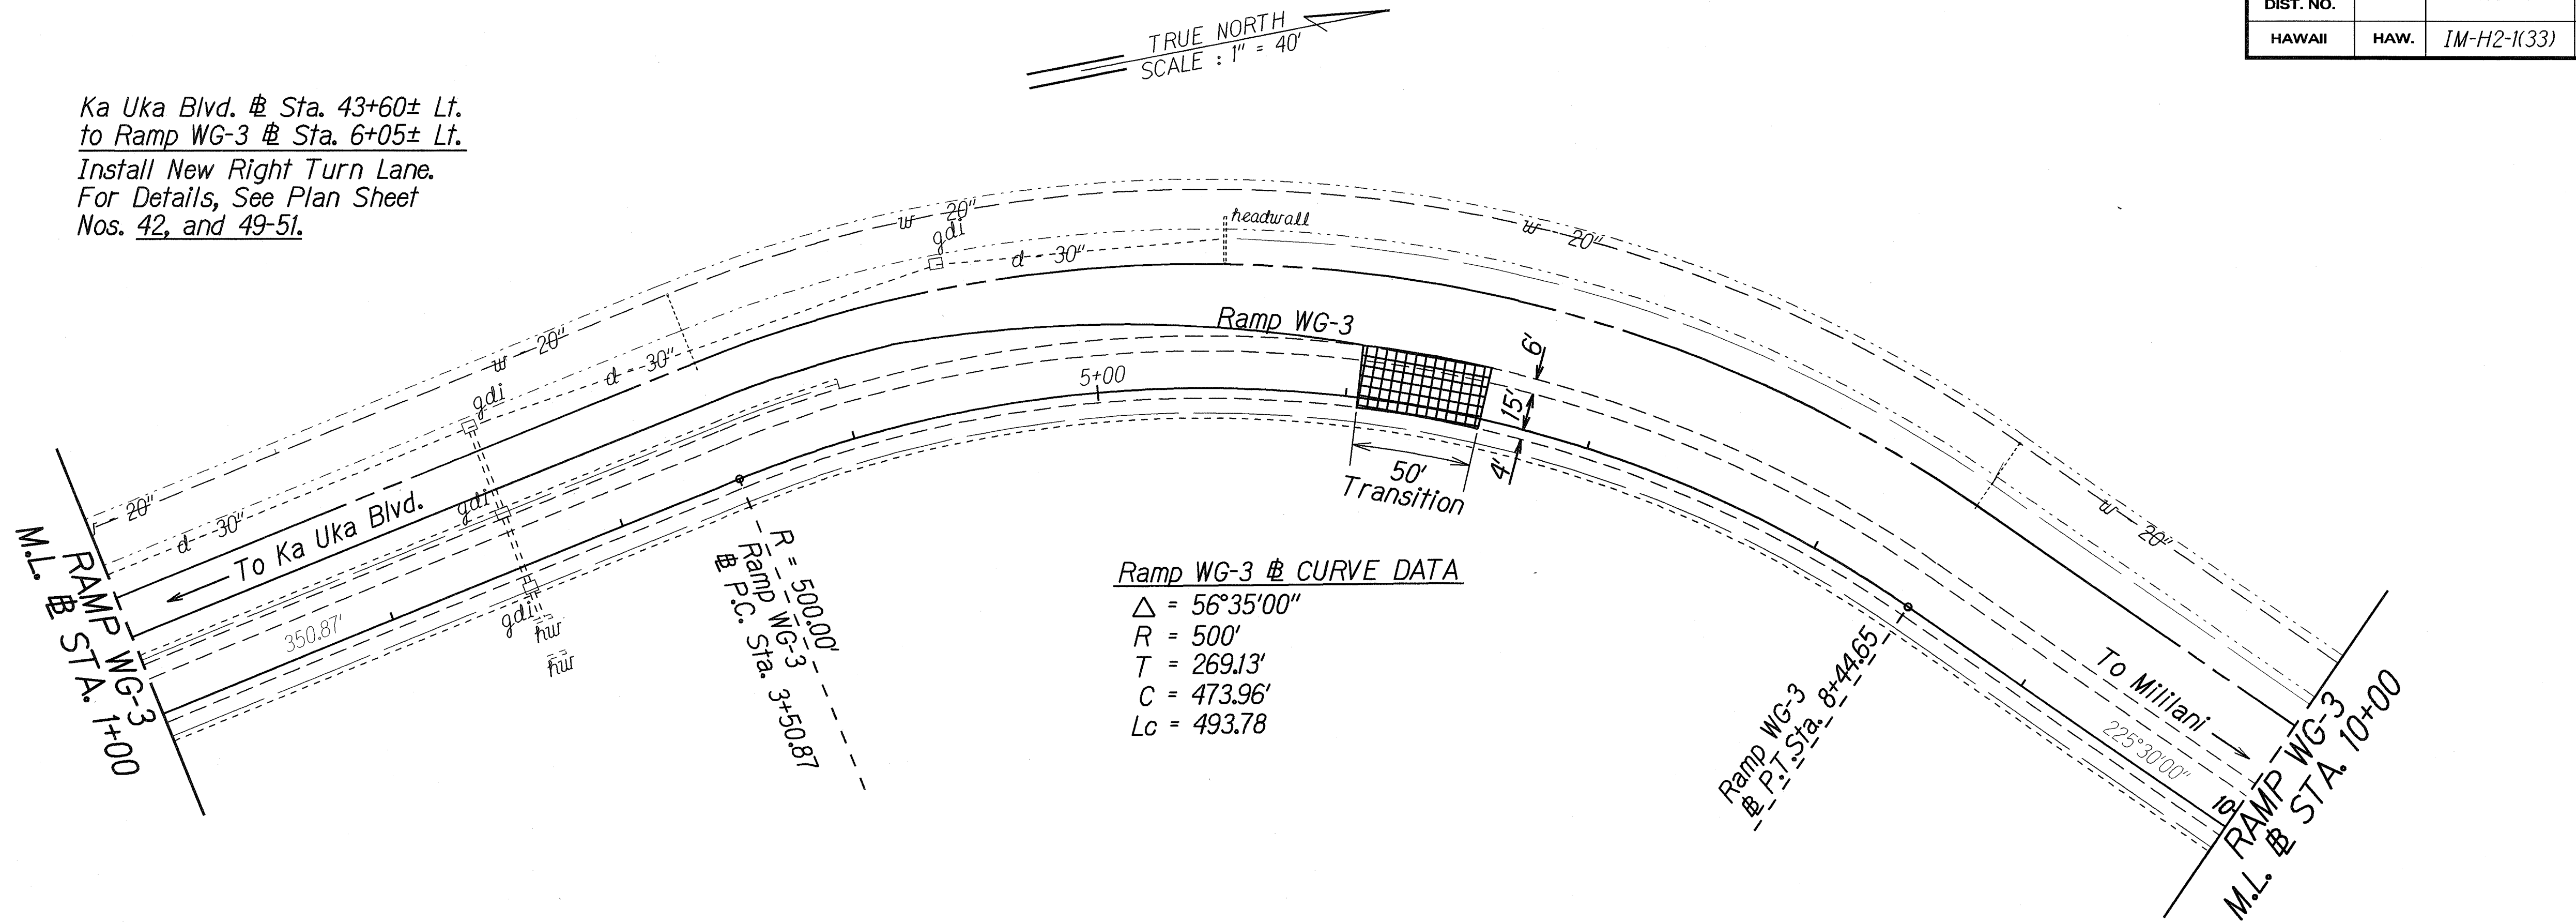

Ramp WG-3 @ Sta. 16+00± Lt. to Route H-2 @ Sta. 329+66± Rt.
Remove and Dispose of Existing Guardrail and Posts. Install
1105 L.F. of New Type 3 Guardrail with New Type G at Trailing
End and New FLEAT-350 at Approach End.
For Details, See Plan Sheet Nos. 31-41.

Type G Terminal Section

5/07/07	Added transition area, revised pavement work at on-ramp
DATE	REVISION


STATE OF HAWAII
DEPARTMENT OF TRANSPORTATION
HIGHWAYS DIVISION
WAIPIO INTERCHANGE
ROADWAY PLANS
INTERSTATE ROUTE H-2 REHABILITATION
Waipio Interchange and Mililani Interchange
On/Off Ramps, Ka Uka Boulevard and
Meheula Parkway Overpasses, & Kipapa Stream Bridge
Federal Aid Project No. IM-H2-1(33)
Scale: 1\" = 40' Date: December, 2006

SHEET No. 4 OF 17 SHEETS

ADD. 46

ORIGINAL PLAN	SURVEY PLOTTED BY	DATE
NOTE BOOK	DRAWN BY	
	CHECKED BY	
	DESIGNED BY	
	QUANTITIES BY	
	CHECKED BY	

FED. ROAD DIST. NO.	STATE	FED. AID PROJ. N.O.	FISCAL YEAR	SHEET NO.	TOTAL SHEETS
HAWAII	HAW.	1M-H2-1(33)	2007	ADD. 47	168

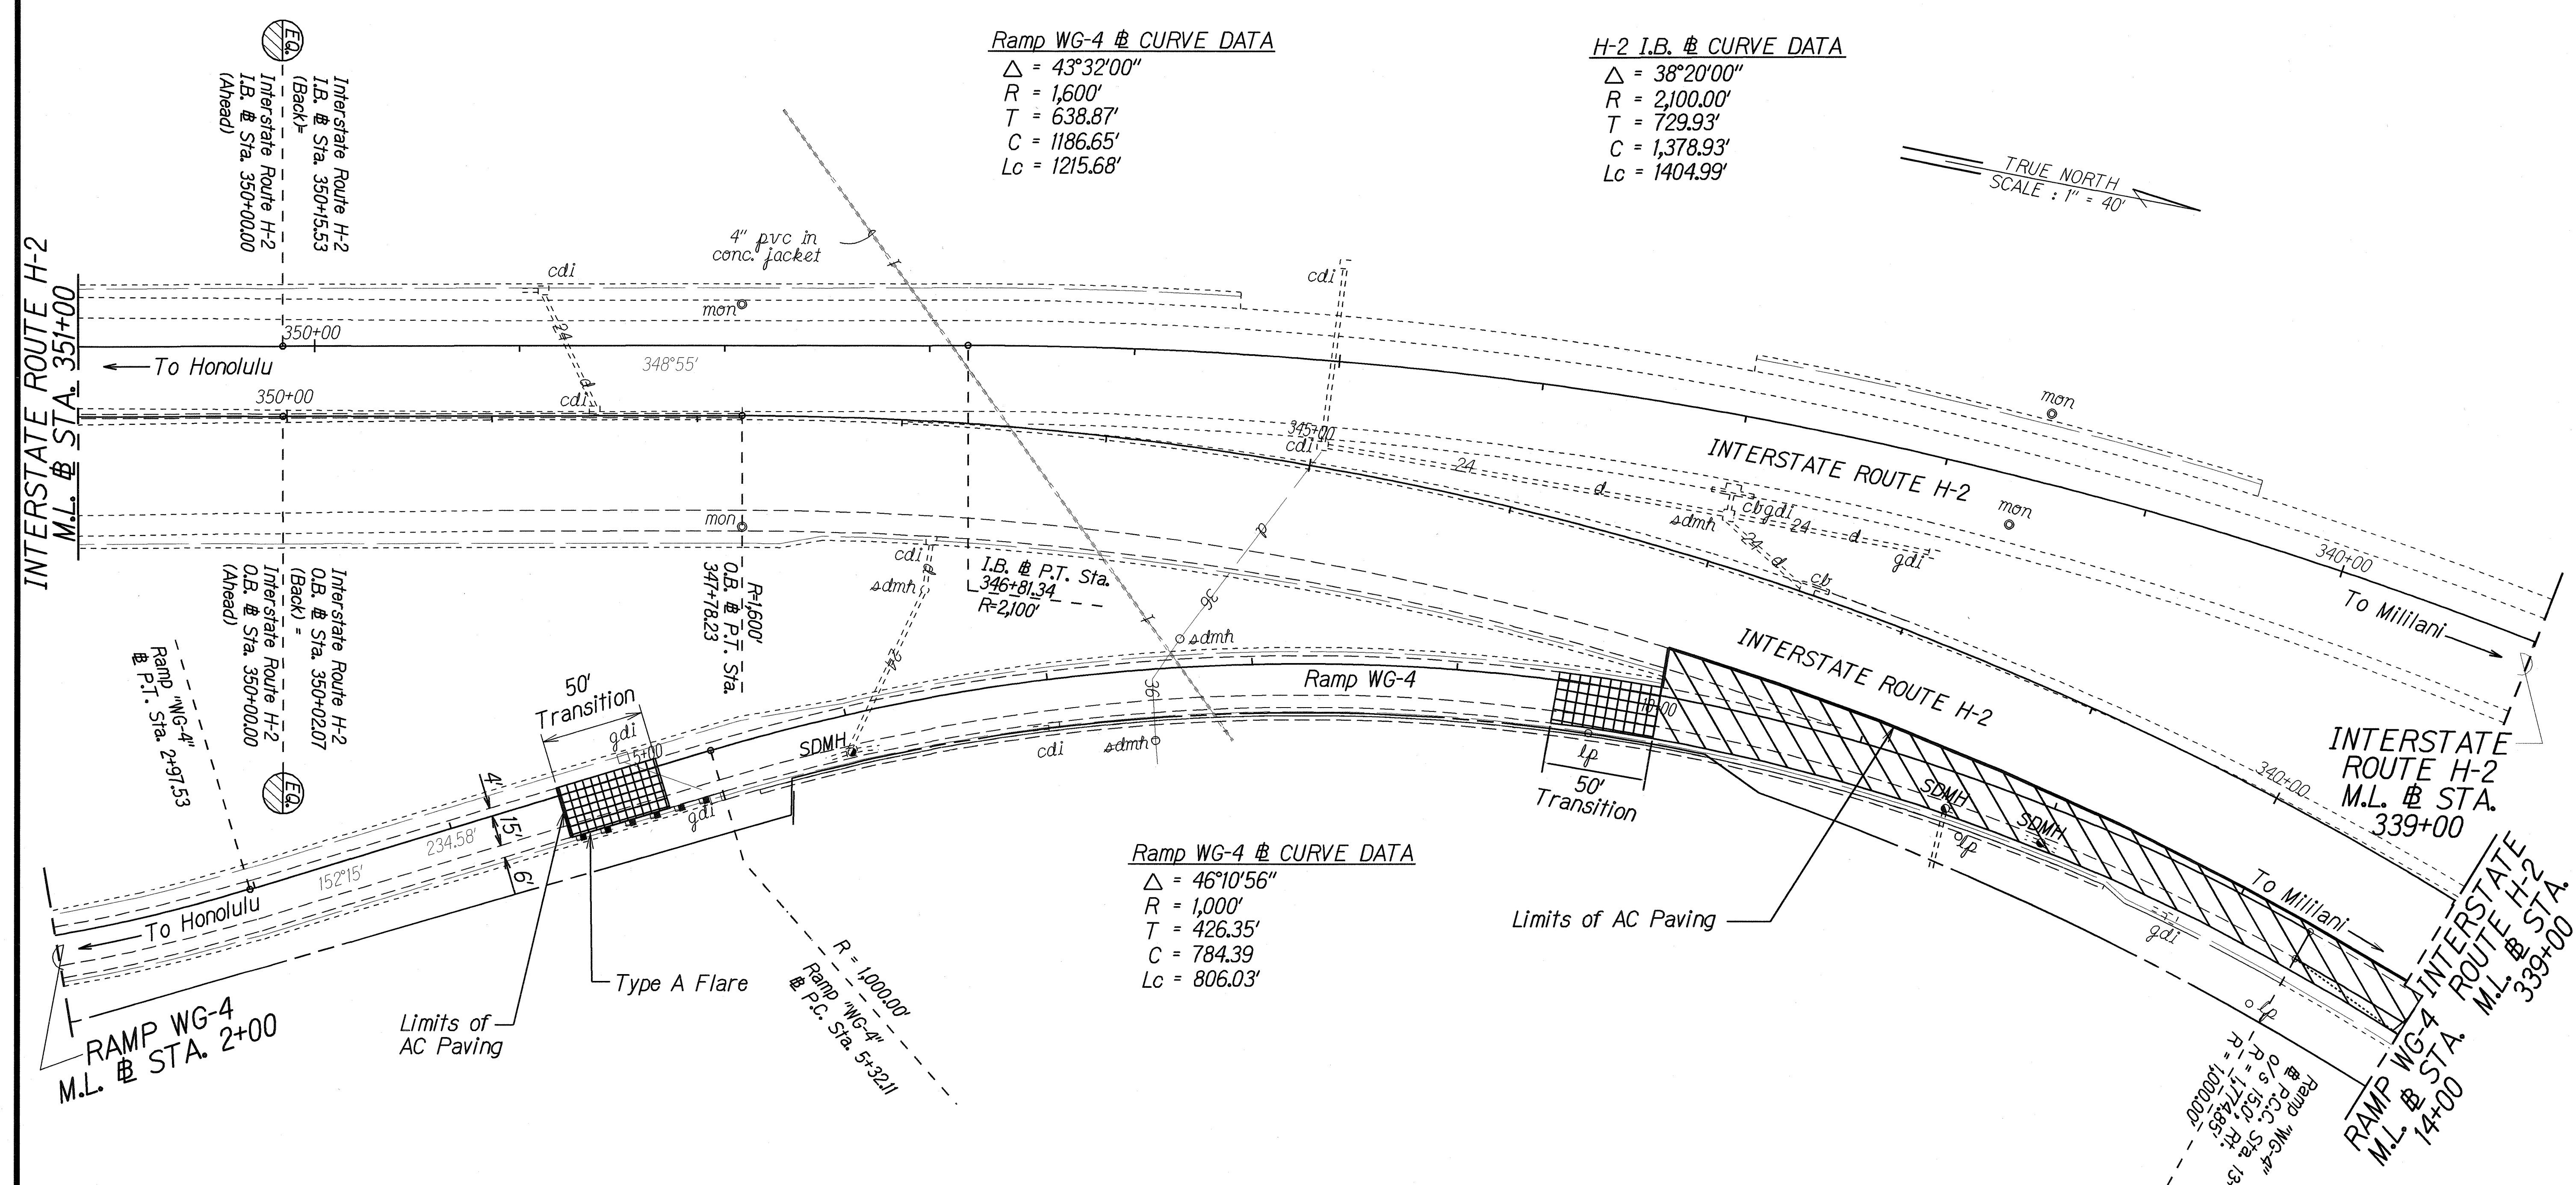

DATE	5/08/07
DESIGNED BY	ADD. 47
DRAWN BY	ADD. 47
CHECKED BY	ADD. 47
IN CHARGE	ADD. 47
NOTE BOOK	ADD. 47
ORIGINAL PLAN	ADD. 47

5/08/07	Added transition area, revised pavement work at on-ramp.
DATE	REVISION
STATE OF HAWAII DEPARTMENT OF TRANSPORTATION HIGHWAYS DIVISION WAIPIO INTERCHANGE ROADWAY PLANS INTERSTATE ROUTE H-2 REHABILITATION Waipio Interchange and Milliani Interchange On/Off Ramps, Ka Uka Boulevard and Meheula Parkway Overpasses, Kipapa Stream Bridge Federal Aid Project No. 1M-H2-1(33) Scale: 1" = 40' Date: December, 2006	
SHEET No. 5 OF 17 SHEETS	



FED. ROAD DIST. NO.	STATE	FED. AID PROJ. NO.	FISCAL YEAR	SHEET NO.	TOTAL SHEETS
HAWAII	HAW.	1M-H2-1(33)	2007	ADD. 48	168

H-2 I.B. & CURVE DATA

$\Delta = 38^{\circ}20'00''$
 $R = 2,100.00'$
 $T = 729.93'$
 $C = 1,378.93'$
 $L_c = 1404.99'$

Ramp WG-3 & CURVE DATA

$\Delta = 8^{\circ}25'52''$
 $R = 3,000'$
 $T = 221.13'$
 $C = 441.06'$
 $L_c = 441.45'$

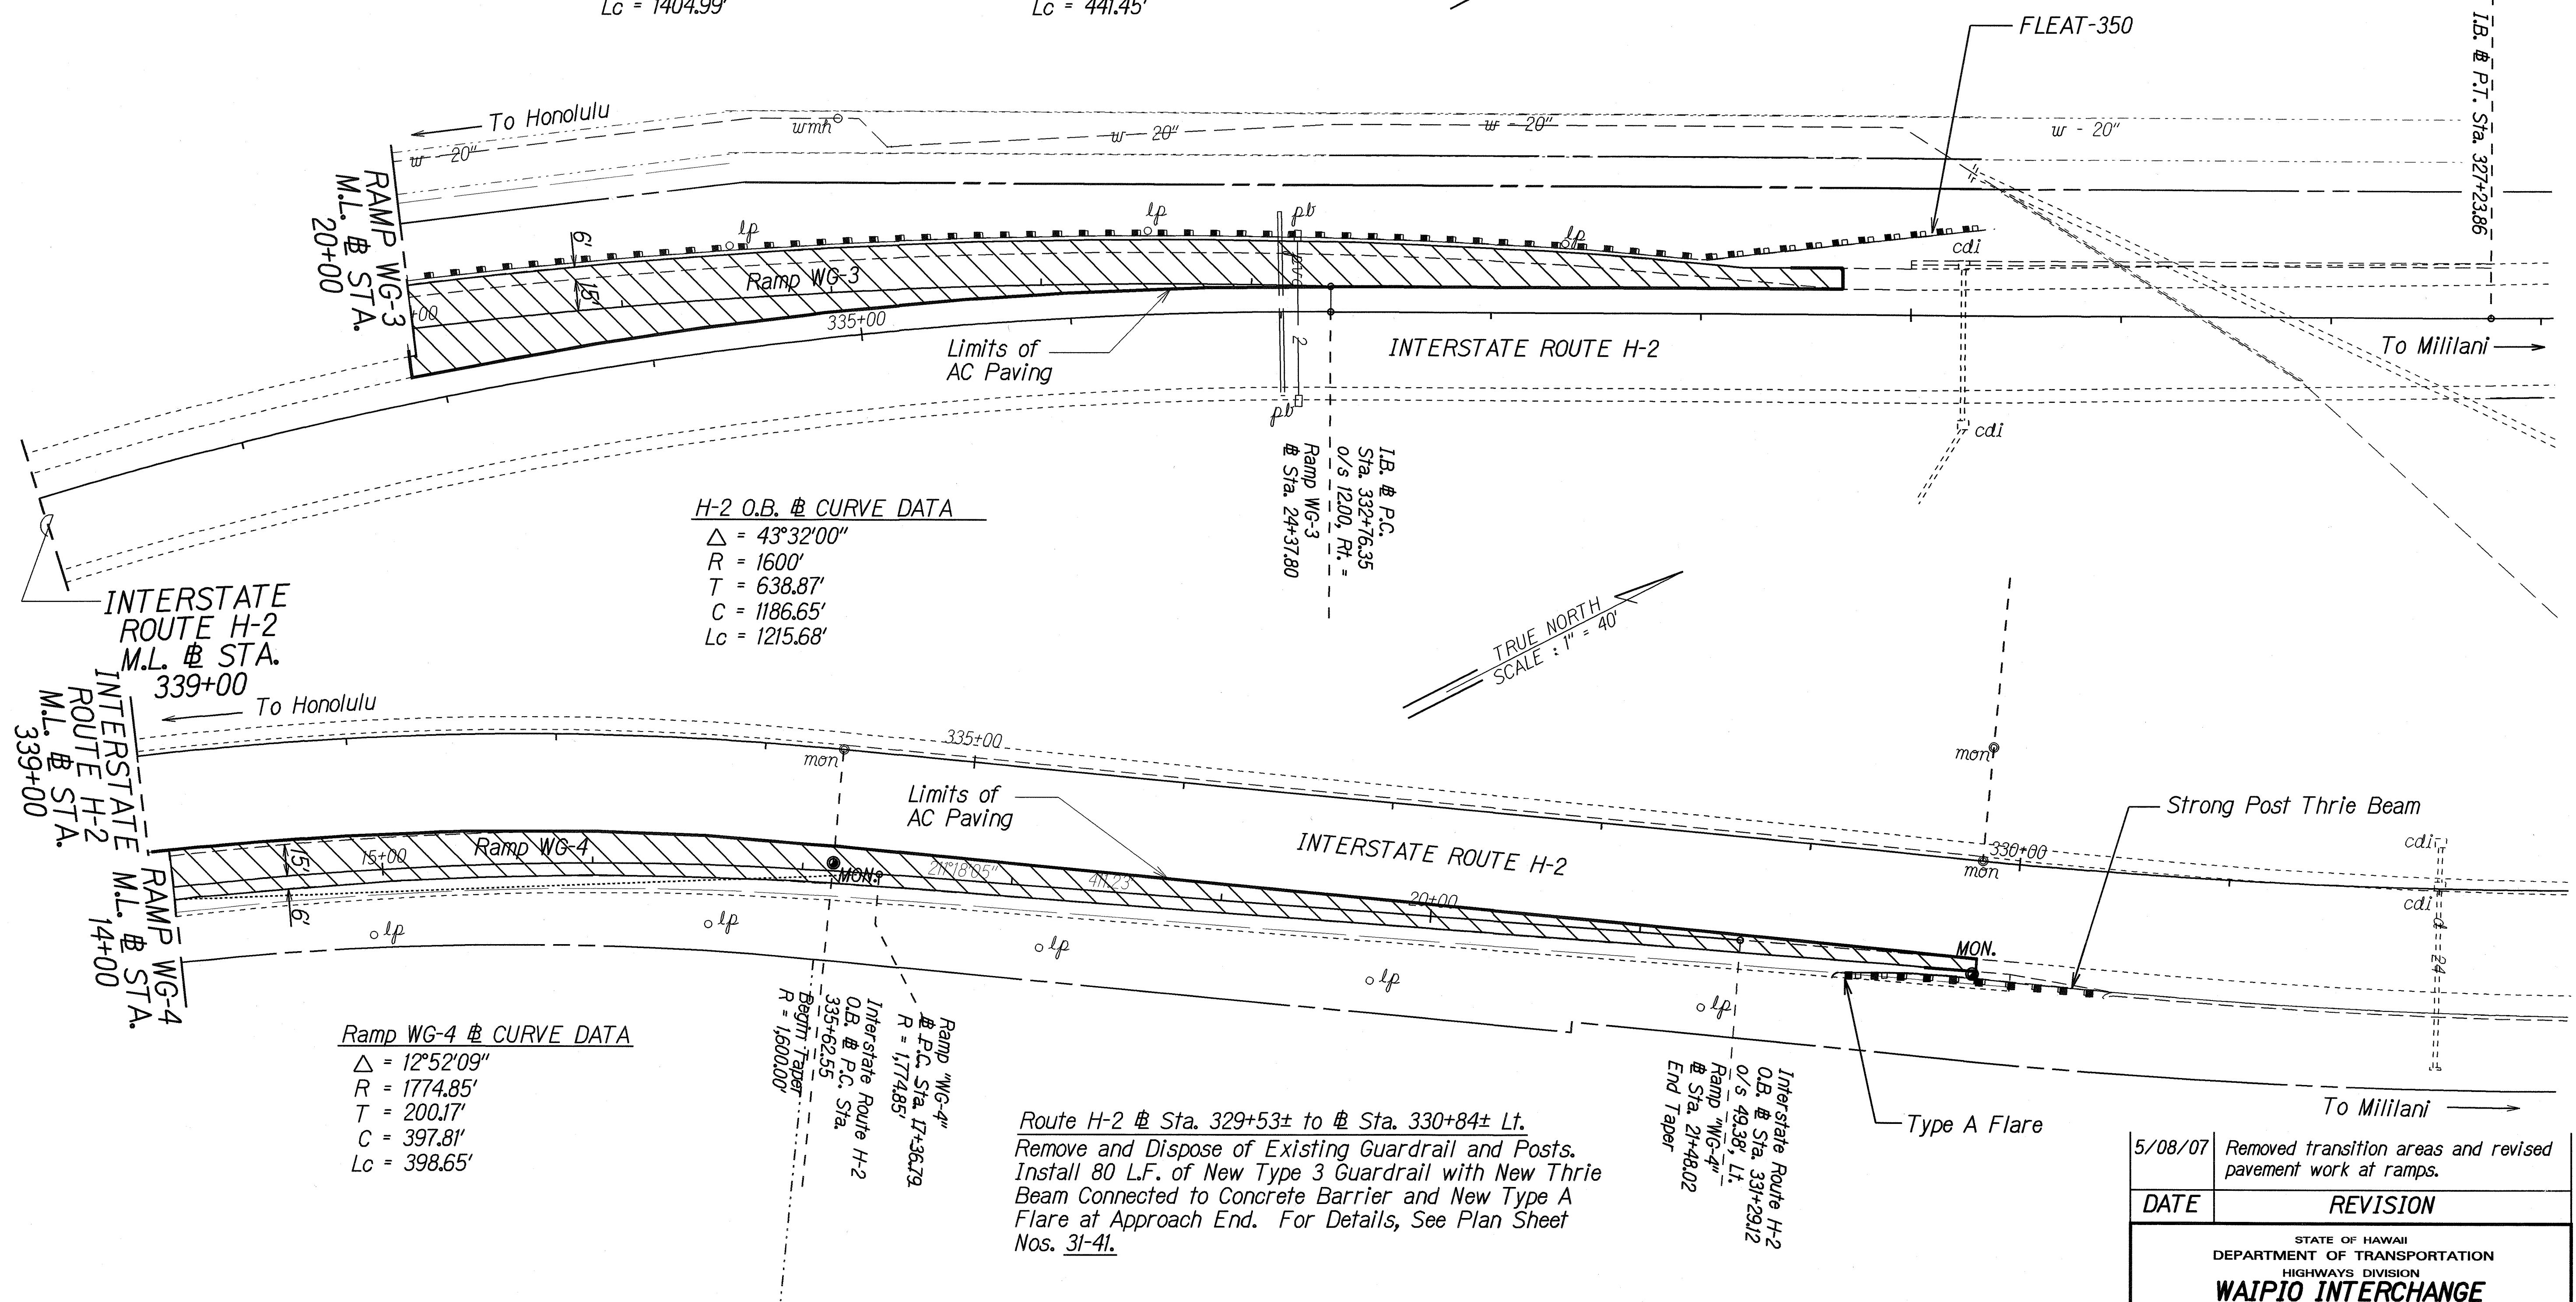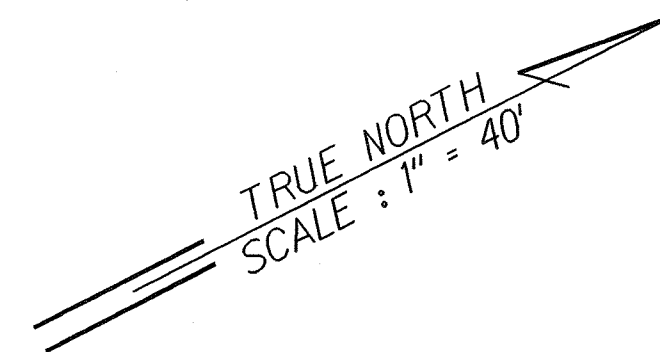


Route H-2 @ Sta. 329+53± to @ Sta. 330+84± Lt.
 Remove and Dispose of Existing Guardrail and Posts.
 Install 80 L.F. of New Type 3 Guardrail with New Thrie
 Beam Connected to Concrete Barrier and New Type A
 Flare at Approach End. For Details, See Plan Sheet
 Nos. 31-41.

5/08/07	Removed transition areas and revised pavement work at ramps.
DATE	REVISION
STATE OF HAWAII DEPARTMENT OF TRANSPORTATION HIGHWAYS DIVISION WAIPIO INTERCHANGE ROADWAY PLANS INTERSTATE ROUTE H-2 REHABILITATION Waipio Interchange and Mililani Interchange On/Off Ramps, Ka Uka Boulevard and Meheula Parkway Overpasses, & Kipapa Stream Bridge Federal Aid Project No. 1M-H2-1(33) Scale: 1" = 40' Date: December, 2006	
SHEET No. 6 OF 17 SHEETS	

DATE	_____
SURVEY PLOTTED BY	_____
DRIVEN BY	_____
DESIGNED BY	_____
QUANTITIES BY	_____
NOTE BOOK	_____
PLAN	_____
No.	_____

FED. ROAD DIST. NO.	STATE	PROJ. NO.	FISCAL YEAR	SHEET NO.	TOTAL SHEETS
HAWAII	HAW.	IM-H2-1(33)	2007	49	168

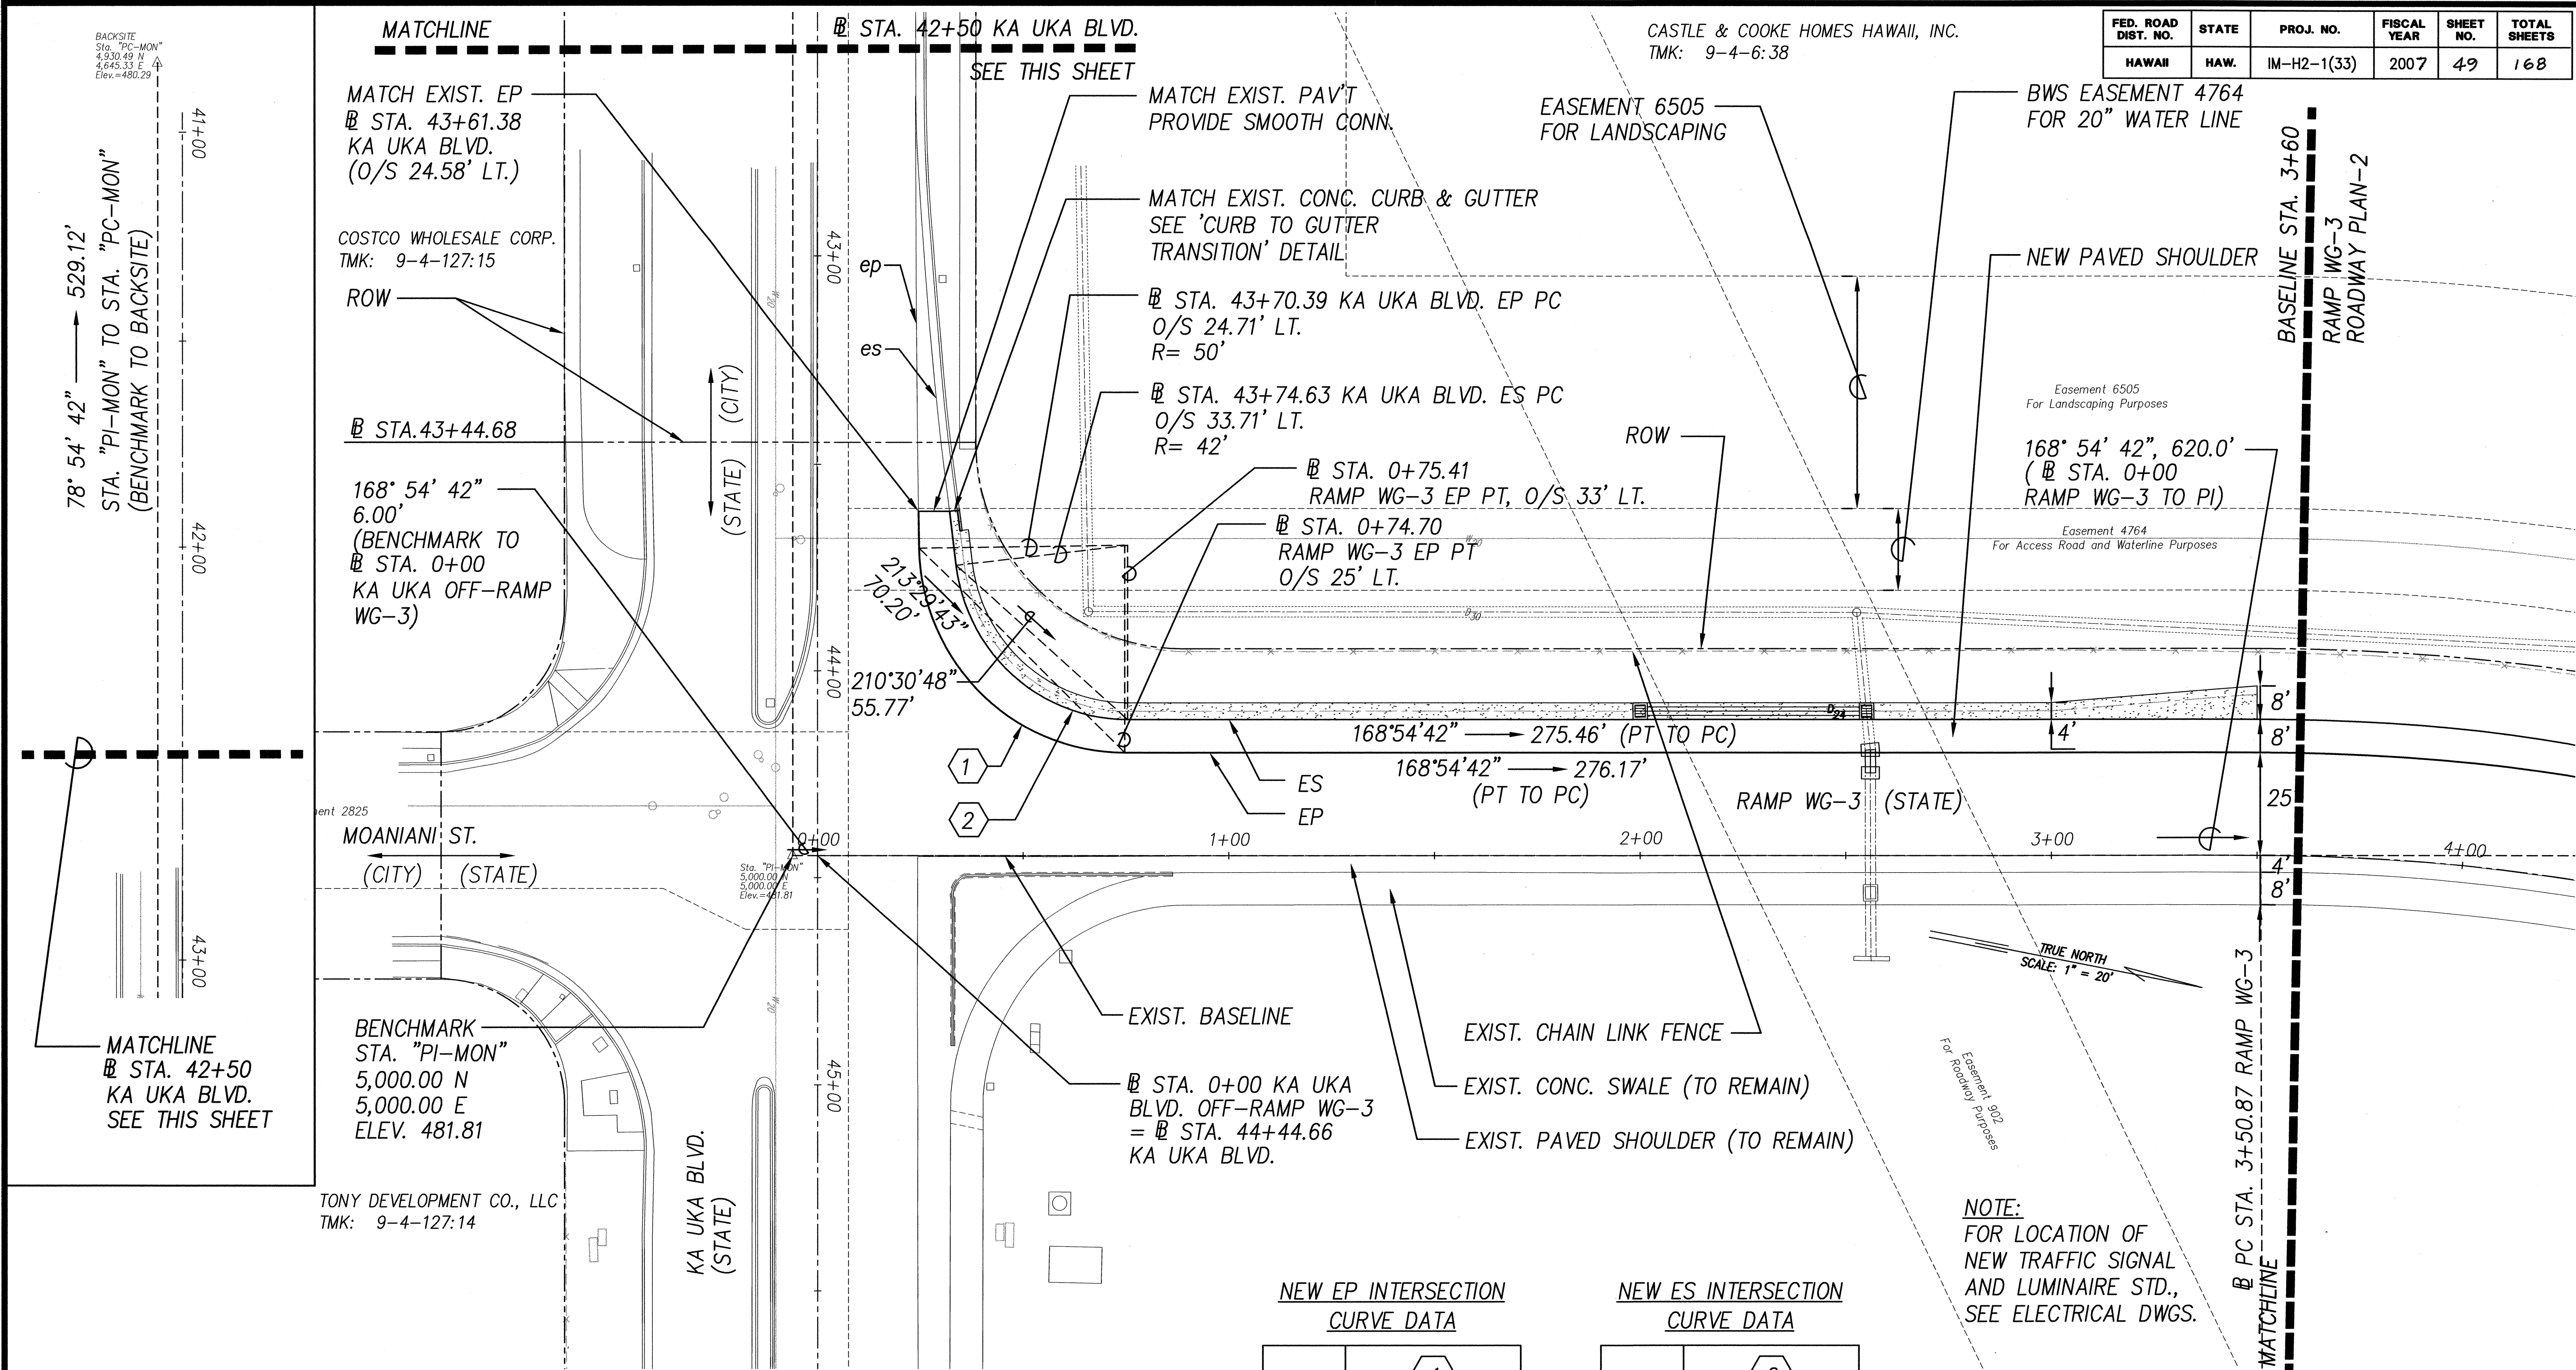

BACKSITE
Sta. "PC-MON"
4,330.49 N
4,645.33 E
Elev. = 480.29

78° 54' 42" → 529.12'
STA. "PI-MON" TO STA. "PC-MON"
(BENCHMARK TO BACKSITE)

MATCHLINE
STA. 42+50
KA UKA BLVD.
SEE THIS SHEET

MATCH EXIST. EP
STA. 43+61.38
KA UKA BLVD.
(O/S 24.58' LT.)

COSTCO WHOLESALE CORP.
TMK: 9-4-127:15

ROW

STA. 43+44.68

168° 54' 42"
6.00'
(BENCHMARK TO
STA. 0+00
KA UKA OFF-RAMP
WG-3)

MATCHLINE
STA. 42+50
KA UKA BLVD.
SEE THIS SHEET

MATCH EXIST. PAV'T
PROVIDE SMOOTH CONN.

MATCH EXIST. CONC. CURB & GUTTER
SEE 'CURB TO GUTTER
TRANSITION' DETAIL

STA. 43+70.39 KA UKA BLVD. EP PC
O/S 24.71' LT.
R= 50'

STA. 43+74.63 KA UKA BLVD. ES PC
O/S 33.71' LT.
R= 42'

STA. 0+75.41
RAMP WG-3 EP PT, O/S 33' LT.

STA. 0+74.70
RAMP WG-3 EP PT
O/S 25' LT.

213° 23' 43"
70.20'

210° 30' 48"
55.77'

168° 54' 42" → 275.46' (PT TO PC)

168° 54' 42" → 276.17' (PT TO PC)

ES
EP

1+00 2+00 3+00 4+00

MOANIANI ST.
(CITY) (STATE)

BENCHMARK
STA. "PI-MON"
5,000.00 N
5,000.00 E
ELEV. 481.81

KA UKA BLVD.
(STATE)

EXIST. BASELINE

STA. 0+00 KA UKA
BLVD. OFF-RAMP WG-3
= STA. 44+44.66
KA UKA BLVD.

EXIST. CHAIN LINK FENCE

EXIST. CONC. SWALE (TO REMAIN)

EXIST. PAVED SHOULDER (TO REMAIN)

CASTLE & COOKE HOMES HAWAII, INC.
TMK: 9-4-6:38

EASEMENT 6505
FOR LANDSCAPING

BWS EASEMENT 4764
FOR 20" WATER LINE

NEW PAVED SHOULDER

Easement 6505
For Landscaping Purposes

168° 54' 42", 620.0'
(STA. 0+00
RAMP WG-3 TO PI)

Easement 4764
For Access Road and Waterline Purposes

RAMP WG-3 (STATE)


TRUE NORTH
SCALE: 1" = 20'

Easement 902
For Roadway Purposes

NOTE:
FOR LOCATION OF
NEW TRAFFIC SIGNAL
AND LUMINAIRE STD.,
SEE ELECTRICAL DWGS.

PC STA. 3+50.87 RAMP WG-3

MATCHLINE

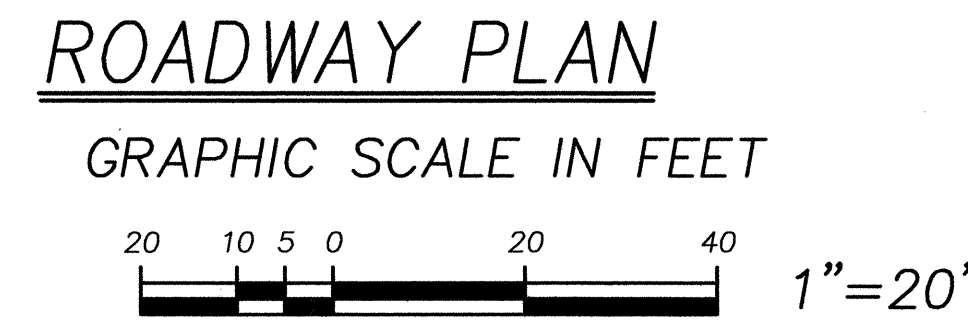

NEW EP INTERSECTION
CURVE DATA

	1
△	89° 10' 02.44"
△/2	44° 35' 01.22"
R	50'
T	49.28'
C	70.20'
L	77.81'

NEW ES INTERSECTION
CURVE DATA

	2
△	83° 12' 11.15"
△/2	41° 36' 05.57"
R	42'
T	37.29'
C	55.77'
L	60.99'

KENNETH O. NAGAI
LICENSED
PROFESSIONAL
ENGINEER
No. 3265-C
HAWAII, U.S.A.

SIGNATURE

APRIL 30, 2008

EXPIRATION DATE OF LICENSE

THIS WORK WAS PREPARED BY ME OR
UNDER MY SUPERVISION

STATE OF HAWAII
DEPARTMENT OF TRANSPORTATION
HIGHWAYS DIVISION


ROADWAY PLAN - 1
WAIPIO INTERCHANGE, RAMP WG-3

INTERSTATE ROUTE H-2 REHABILITATION
Waipio Interchange and Mililani Interchange
On/Off Ramps, Ka Uka Boulevard and
Meheula Parkway Overpasses, & Kipapa Stream Bridge
Federal Aid Project No. IM-H2-1(33)
SCALE: 1"=20' DATE: NOVEMBER 2006

SHEET No. 7 OF 17 SHEETS

SURVEY PLOTTED BY	DATE
DRAWN BY	
TRACED BY	
CHECKED BY	
ORIGINAL PLAN	
NOTE BOOK	
No.	

FED. ROAD DIST. NO.	STATE	PROJ. NO.	FISCAL YEAR	SHEET NO.	TOTAL SHEETS
HAWAII	HAW.	IM-H2-1(33)	2007	50	168

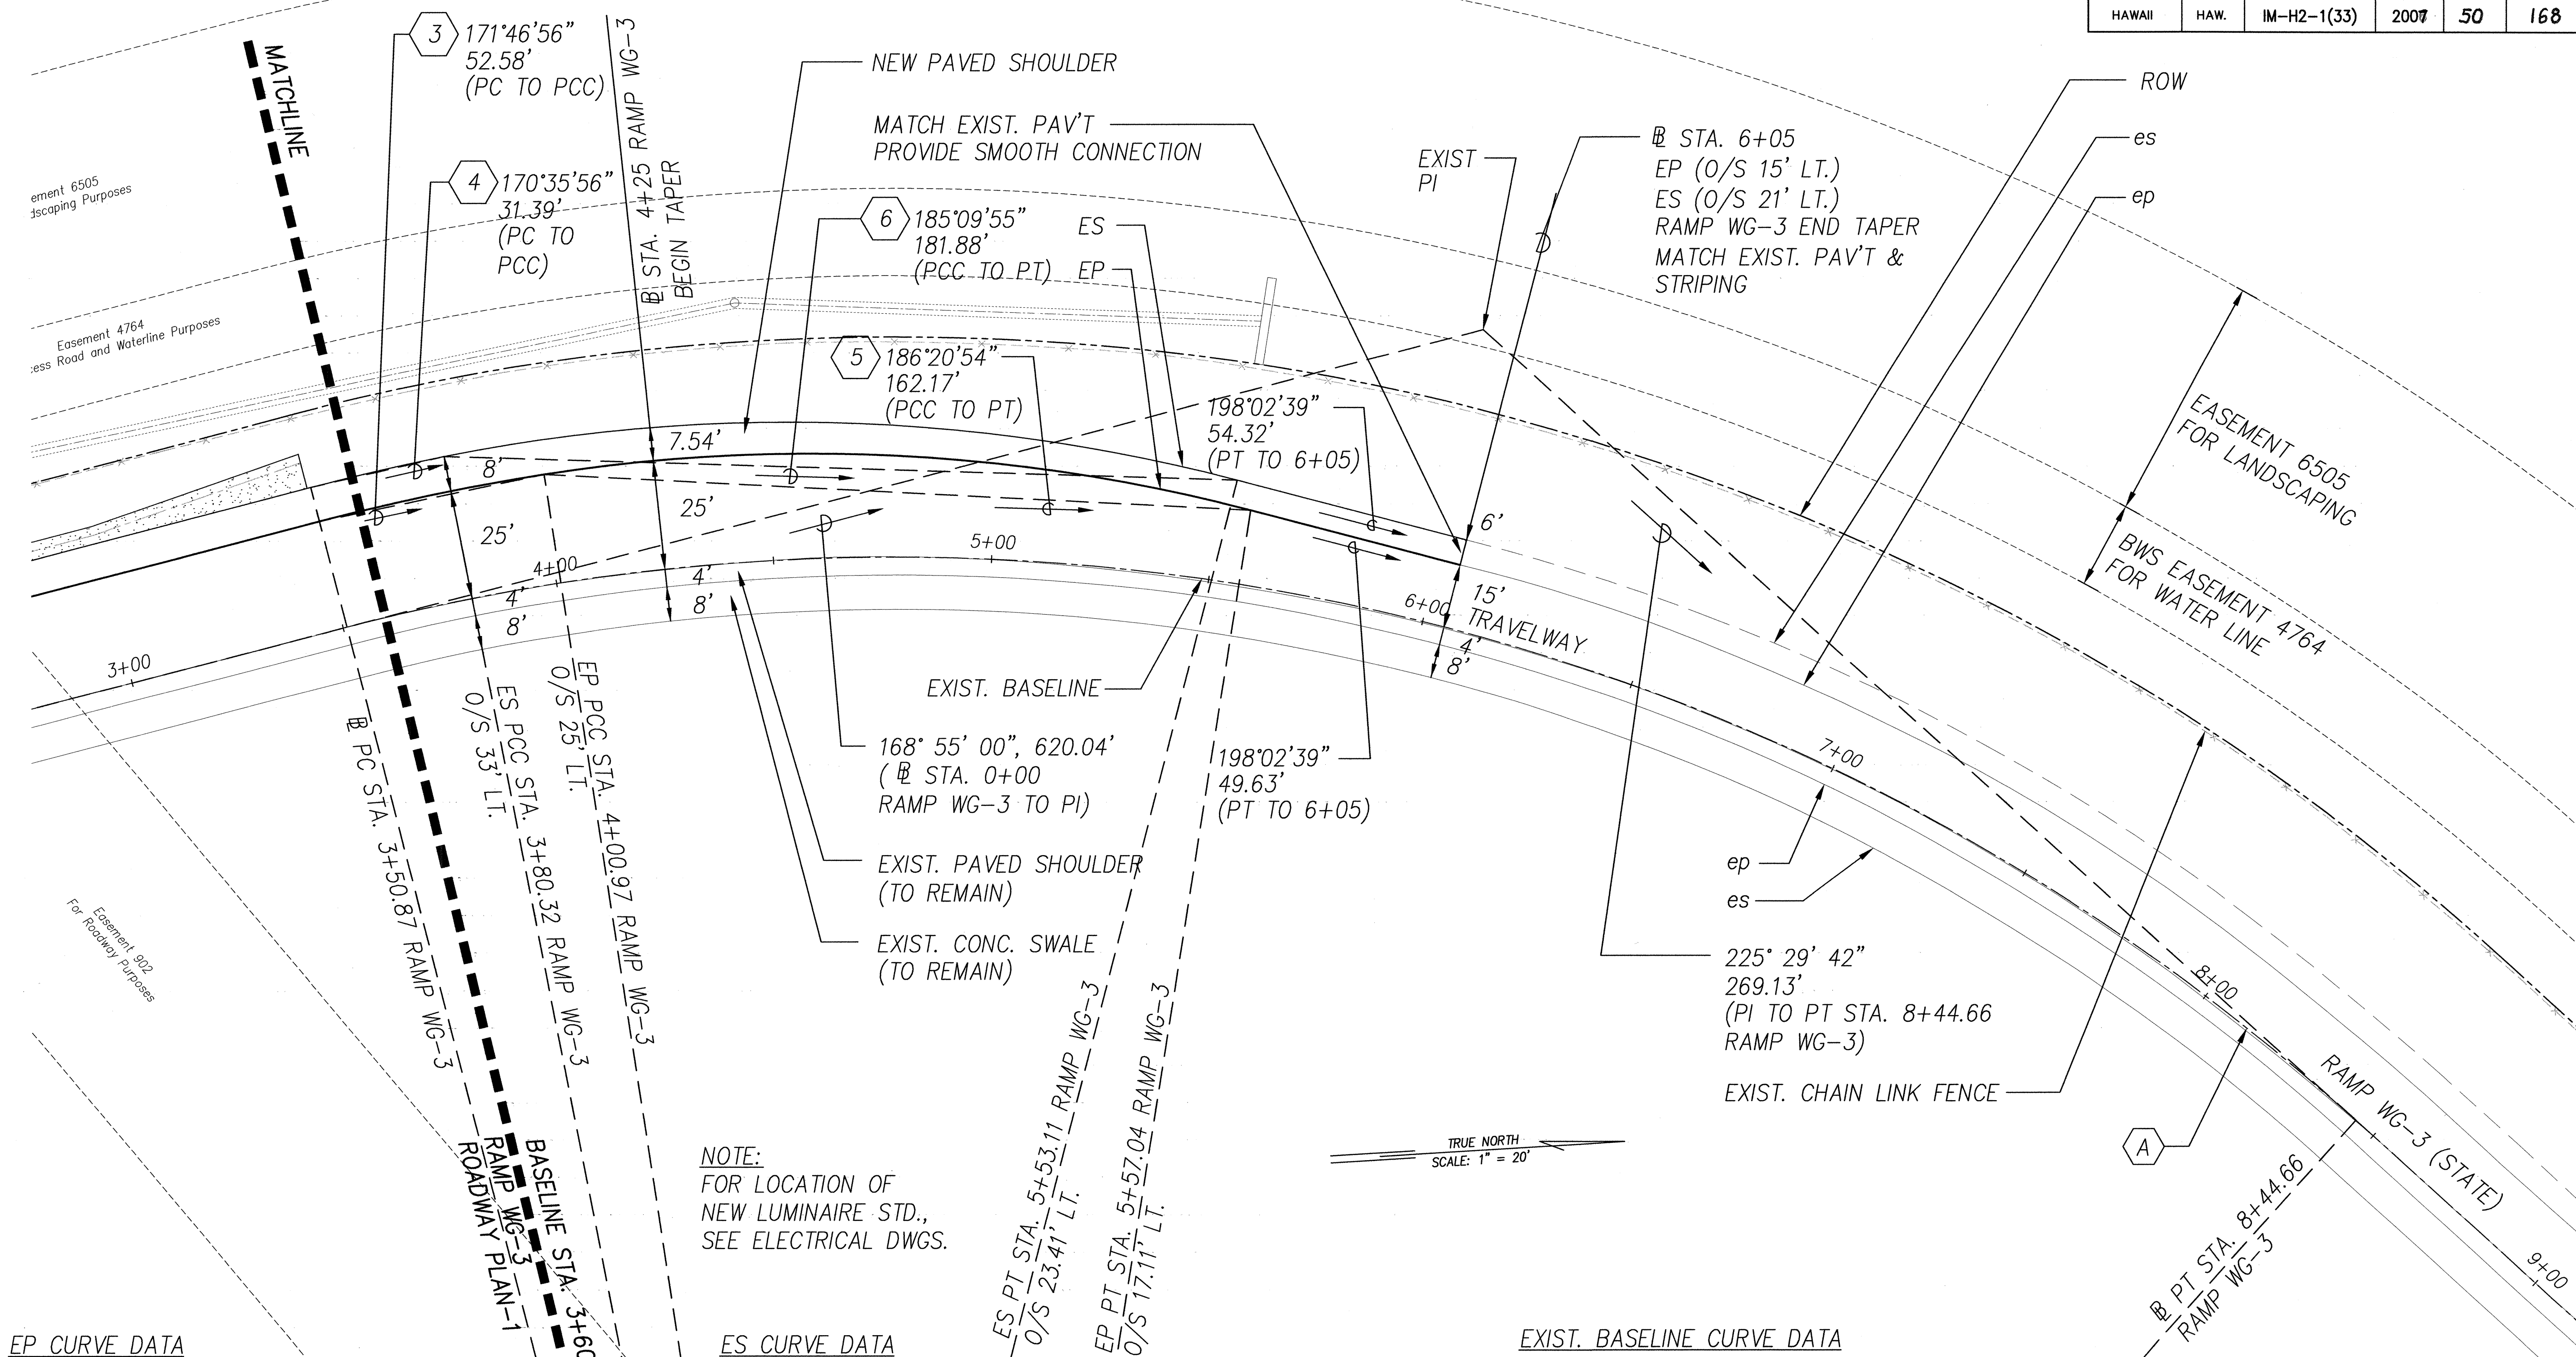


EP CURVE DATA

	3	5
△	05° 44' 27.76"	23° 23' 29.27"
△/2	02° 52' 13.88"	11° 41' 44.63"
R	525'	400'
T	26.32'	82.80'
C	52.58'	162.17'
L	52.61'	163.30'

ES CURVE DATA

	4	6
△	03° 22' 28.60"	25° 45' 28.44"
△/2	01° 41' 14.30"	11° 41' 44.63"
R	533'	408'
T	15.70'	93.29'
C	31.39'	181.88'
L	31.39'	183.42'

ROADWAY PLAN

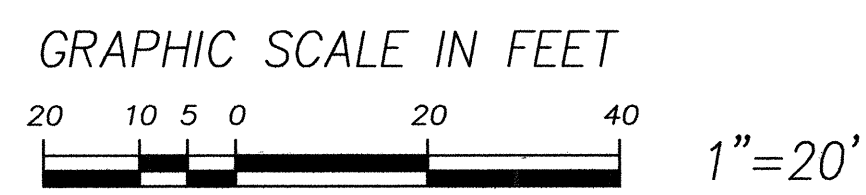

EXIST. BASELINE CURVE DATA

	A
△	56° 35' 00"
△/2	28° 17' 30"
R	500'
T	269.13'
C	473.96'
L	493.78'

KENNETH O. NAGAI
 LICENSED PROFESSIONAL ENGINEER
 No. 3265-C
 HAWAII, U.S.A.
 APRIL 30, 2008
 EXPIRATION DATE OF LICENSE
 THIS WORK WAS PREPARED BY ME OR UNDER MY SUPERVISION


STATE OF HAWAII
DEPARTMENT OF TRANSPORTATION
HIGHWAYS DIVISION

ROADWAY PLAN - 2
WAIPIO INTERCHANGE, RAMP WG-3

INTERSTATE ROUTE H-2 REHABILITATION
Waipio Interchange and Mililani Interchange
On/Off Ramps, Ka Uka Boulevard and
Meheula Parkway Overpasses, & Kipapa Stream Bridge
Federal Aid Project No. IM-H2-1(33)
SCALE: 1"=20' DATE: NOVEMBER 2006

SURVEY PLOTTED BY	DATE
DRAWN BY	
CHECKED BY	
NOTED BY	
QUANTITIES BY	
CHECKED BY	
ORIGINAL PLAN	No.

FED. ROAD DIST. NO.	STATE	PROJ. NO.	FISCAL YEAR	SHEET NO.	TOTAL SHEETS
HAWAII	HAW.	IM-H2-1(33)	2007	51	168

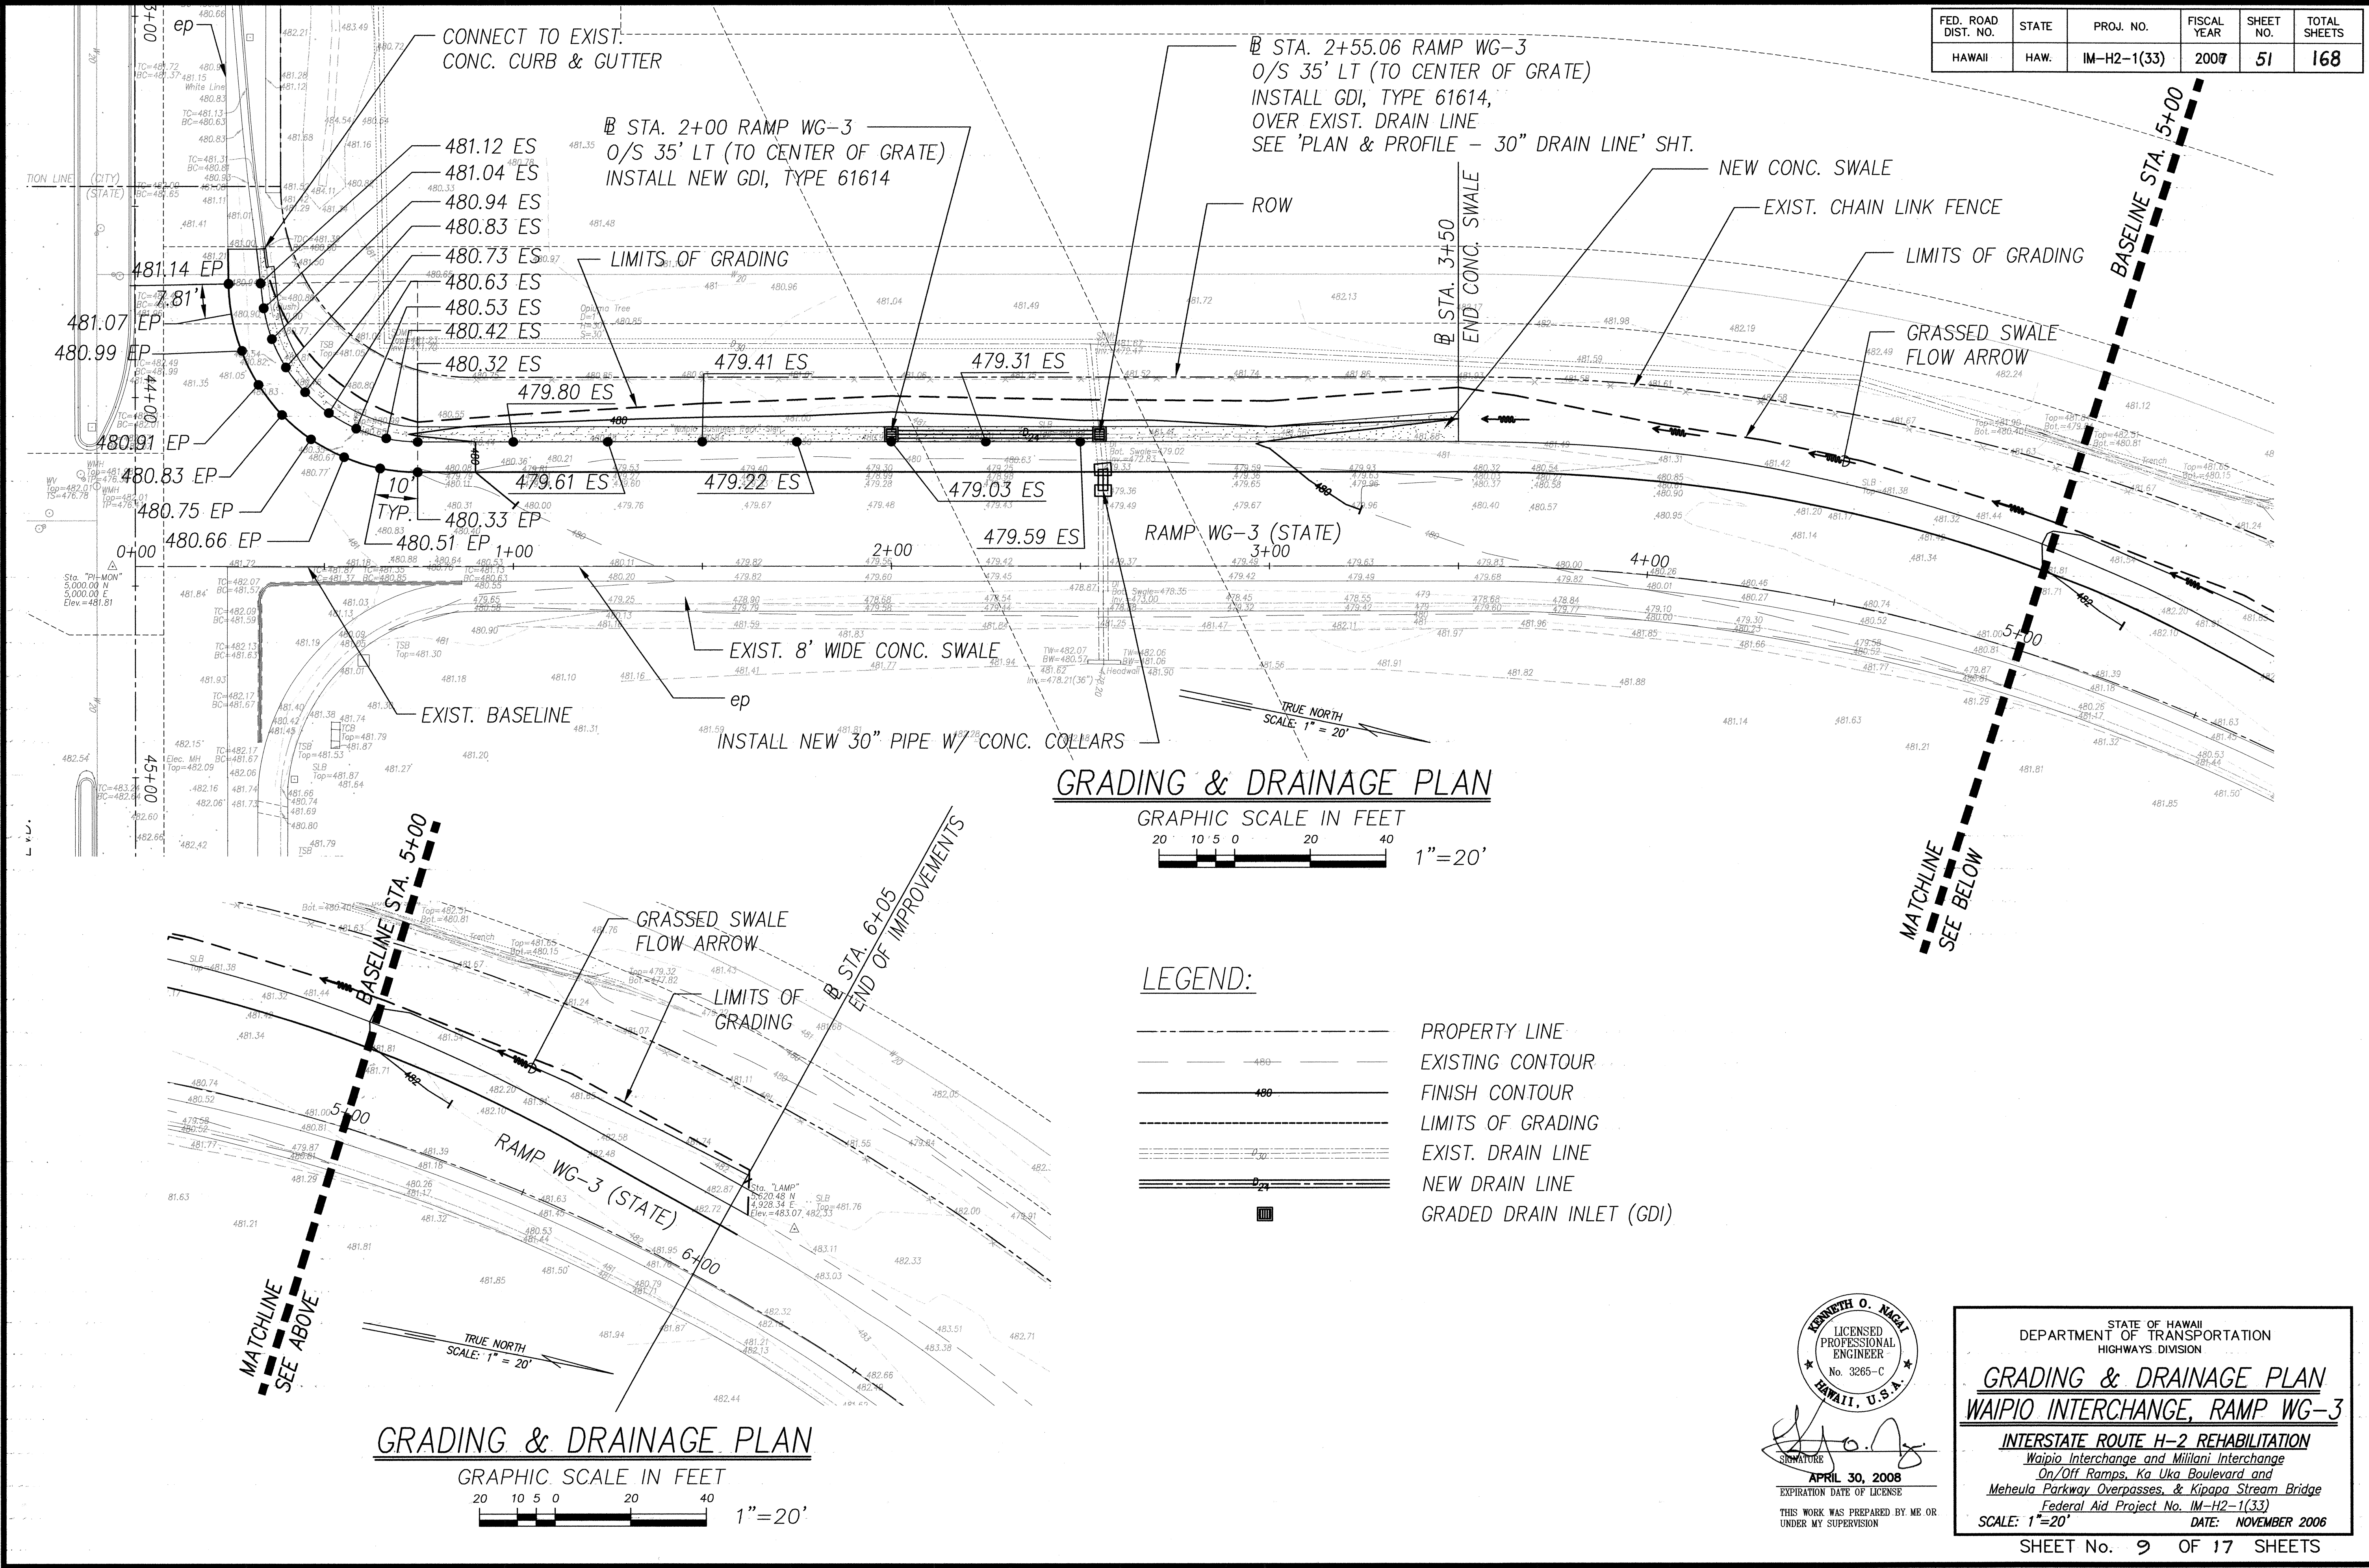


ORIGINAL PLAN	SURVEY PLOTTED BY	DATE
	DRAWN BY	
	TRACED BY	
	NOTED BY	
NOTE BOOK	QUANTITIES BY	
	CHECKED BY	
No.		

FED. ROAD DIST. NO.	STATE	FED. AID PROJ. NO.	FISCAL YEAR	SHEET NO.	TOTAL SHEETS
HAWAII	HAW.	IM-H2-1(33)	2007	52	168

Route H-2 @ Sta. 246+30± to @ Sta. 246+80 Rt.

Remove existing AC overlay down to concrete pavement. Replace with new AC pavement, Mix No. IV to provide a smooth surface with adjacent PCC pavement. Should the depression exceed 3 inches, the low spots shall be filled with AC such that the final layer will be relatively uniform in thickness.

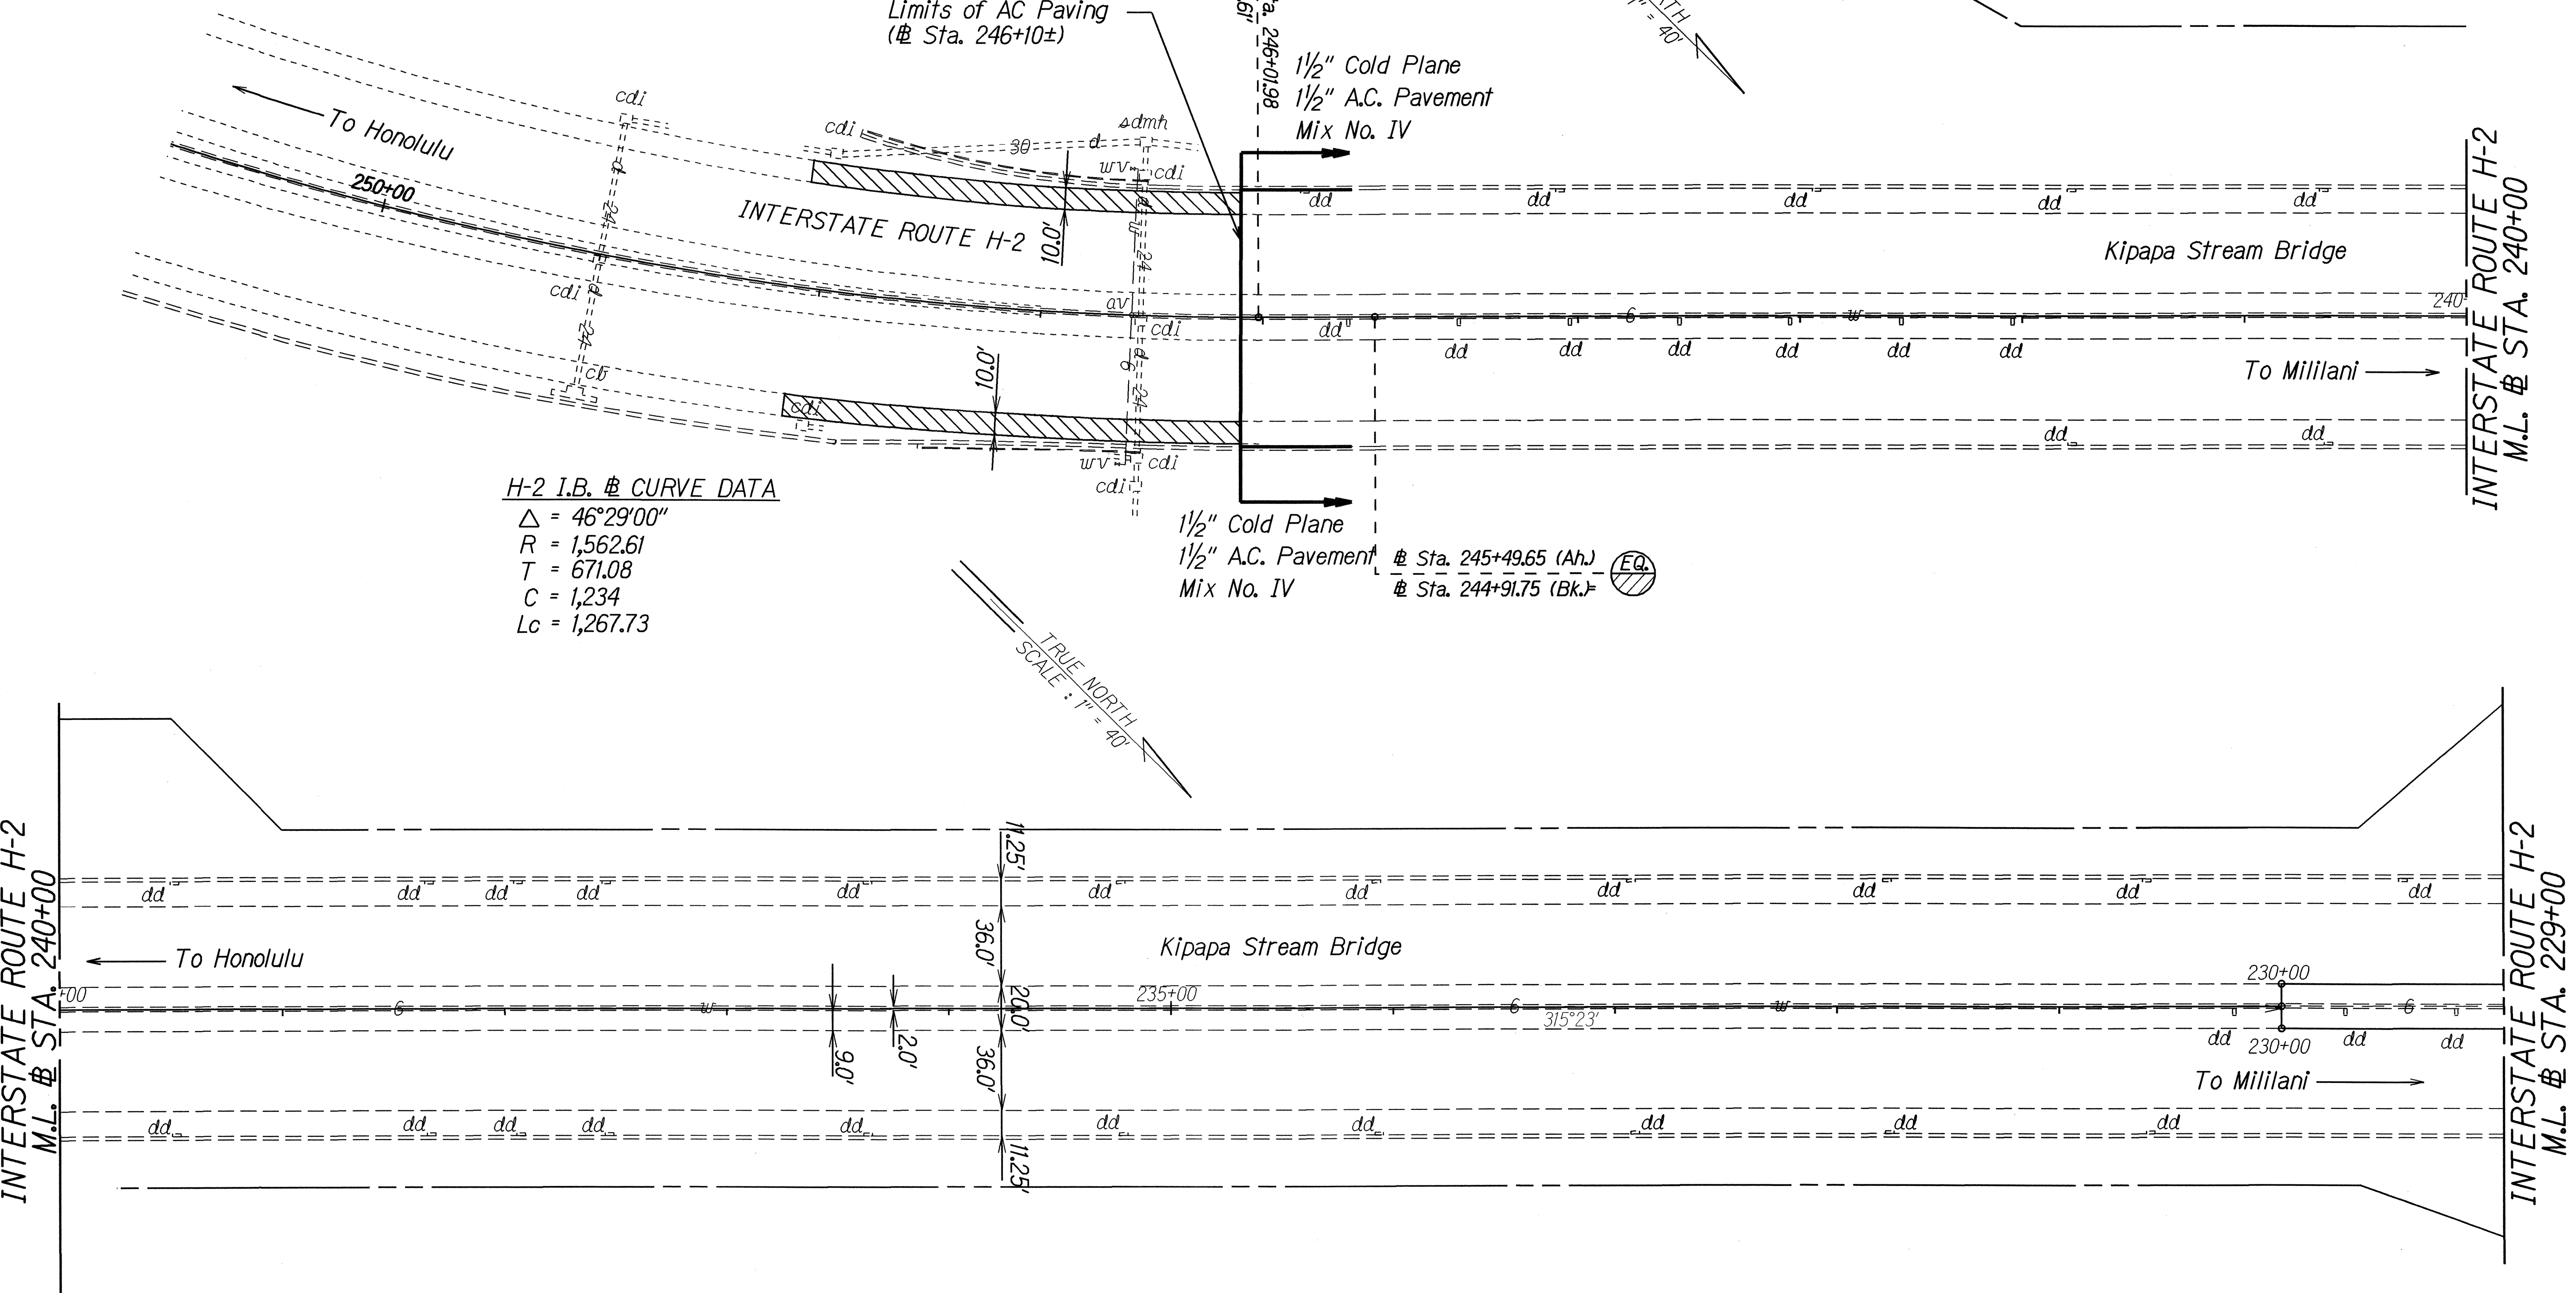

H-2 I.B. @ CURVE DATA

$\Delta = 46^{\circ}29'00''$
 $R = 1,562.61$
 $T = 671.08$
 $C = 1,234$
 $L_c = 1,267.73$

Note: Contractor to verify thickness of asphalt concrete pavement on existing concrete deck. Do not cold plane the concrete deck. Contractor to repair any damage to the concrete deck and reinforcement at no cost to the State.

STATE OF HAWAII
DEPARTMENT OF TRANSPORTATION
HIGHWAYS DIVISION

KIPAPA STREAM BRIDGE

ROADWAY PLANS


INTERSTATE ROUTE H-2 REHABILITATION

Waipio Interchange and Millilani Interchange
On/Off Ramps, Ka Uka Boulevard and
Meheula Parkway Overpasses, # Kipapa Stream Bridge
Federal Aid Project No. IM-H2-1(33)

Scale: 1" = 40' Date: December, 2006

SHEET No. 10 OF 17 SHEETS

FED. ROAD DIST. NO.	STATE	FED. AID PROJ. NO.	FISCAL YEAR	SHEET NO.	TOTAL SHEETS
HAWAII	HAW.	1M-H2-1(33)	2007	53	168

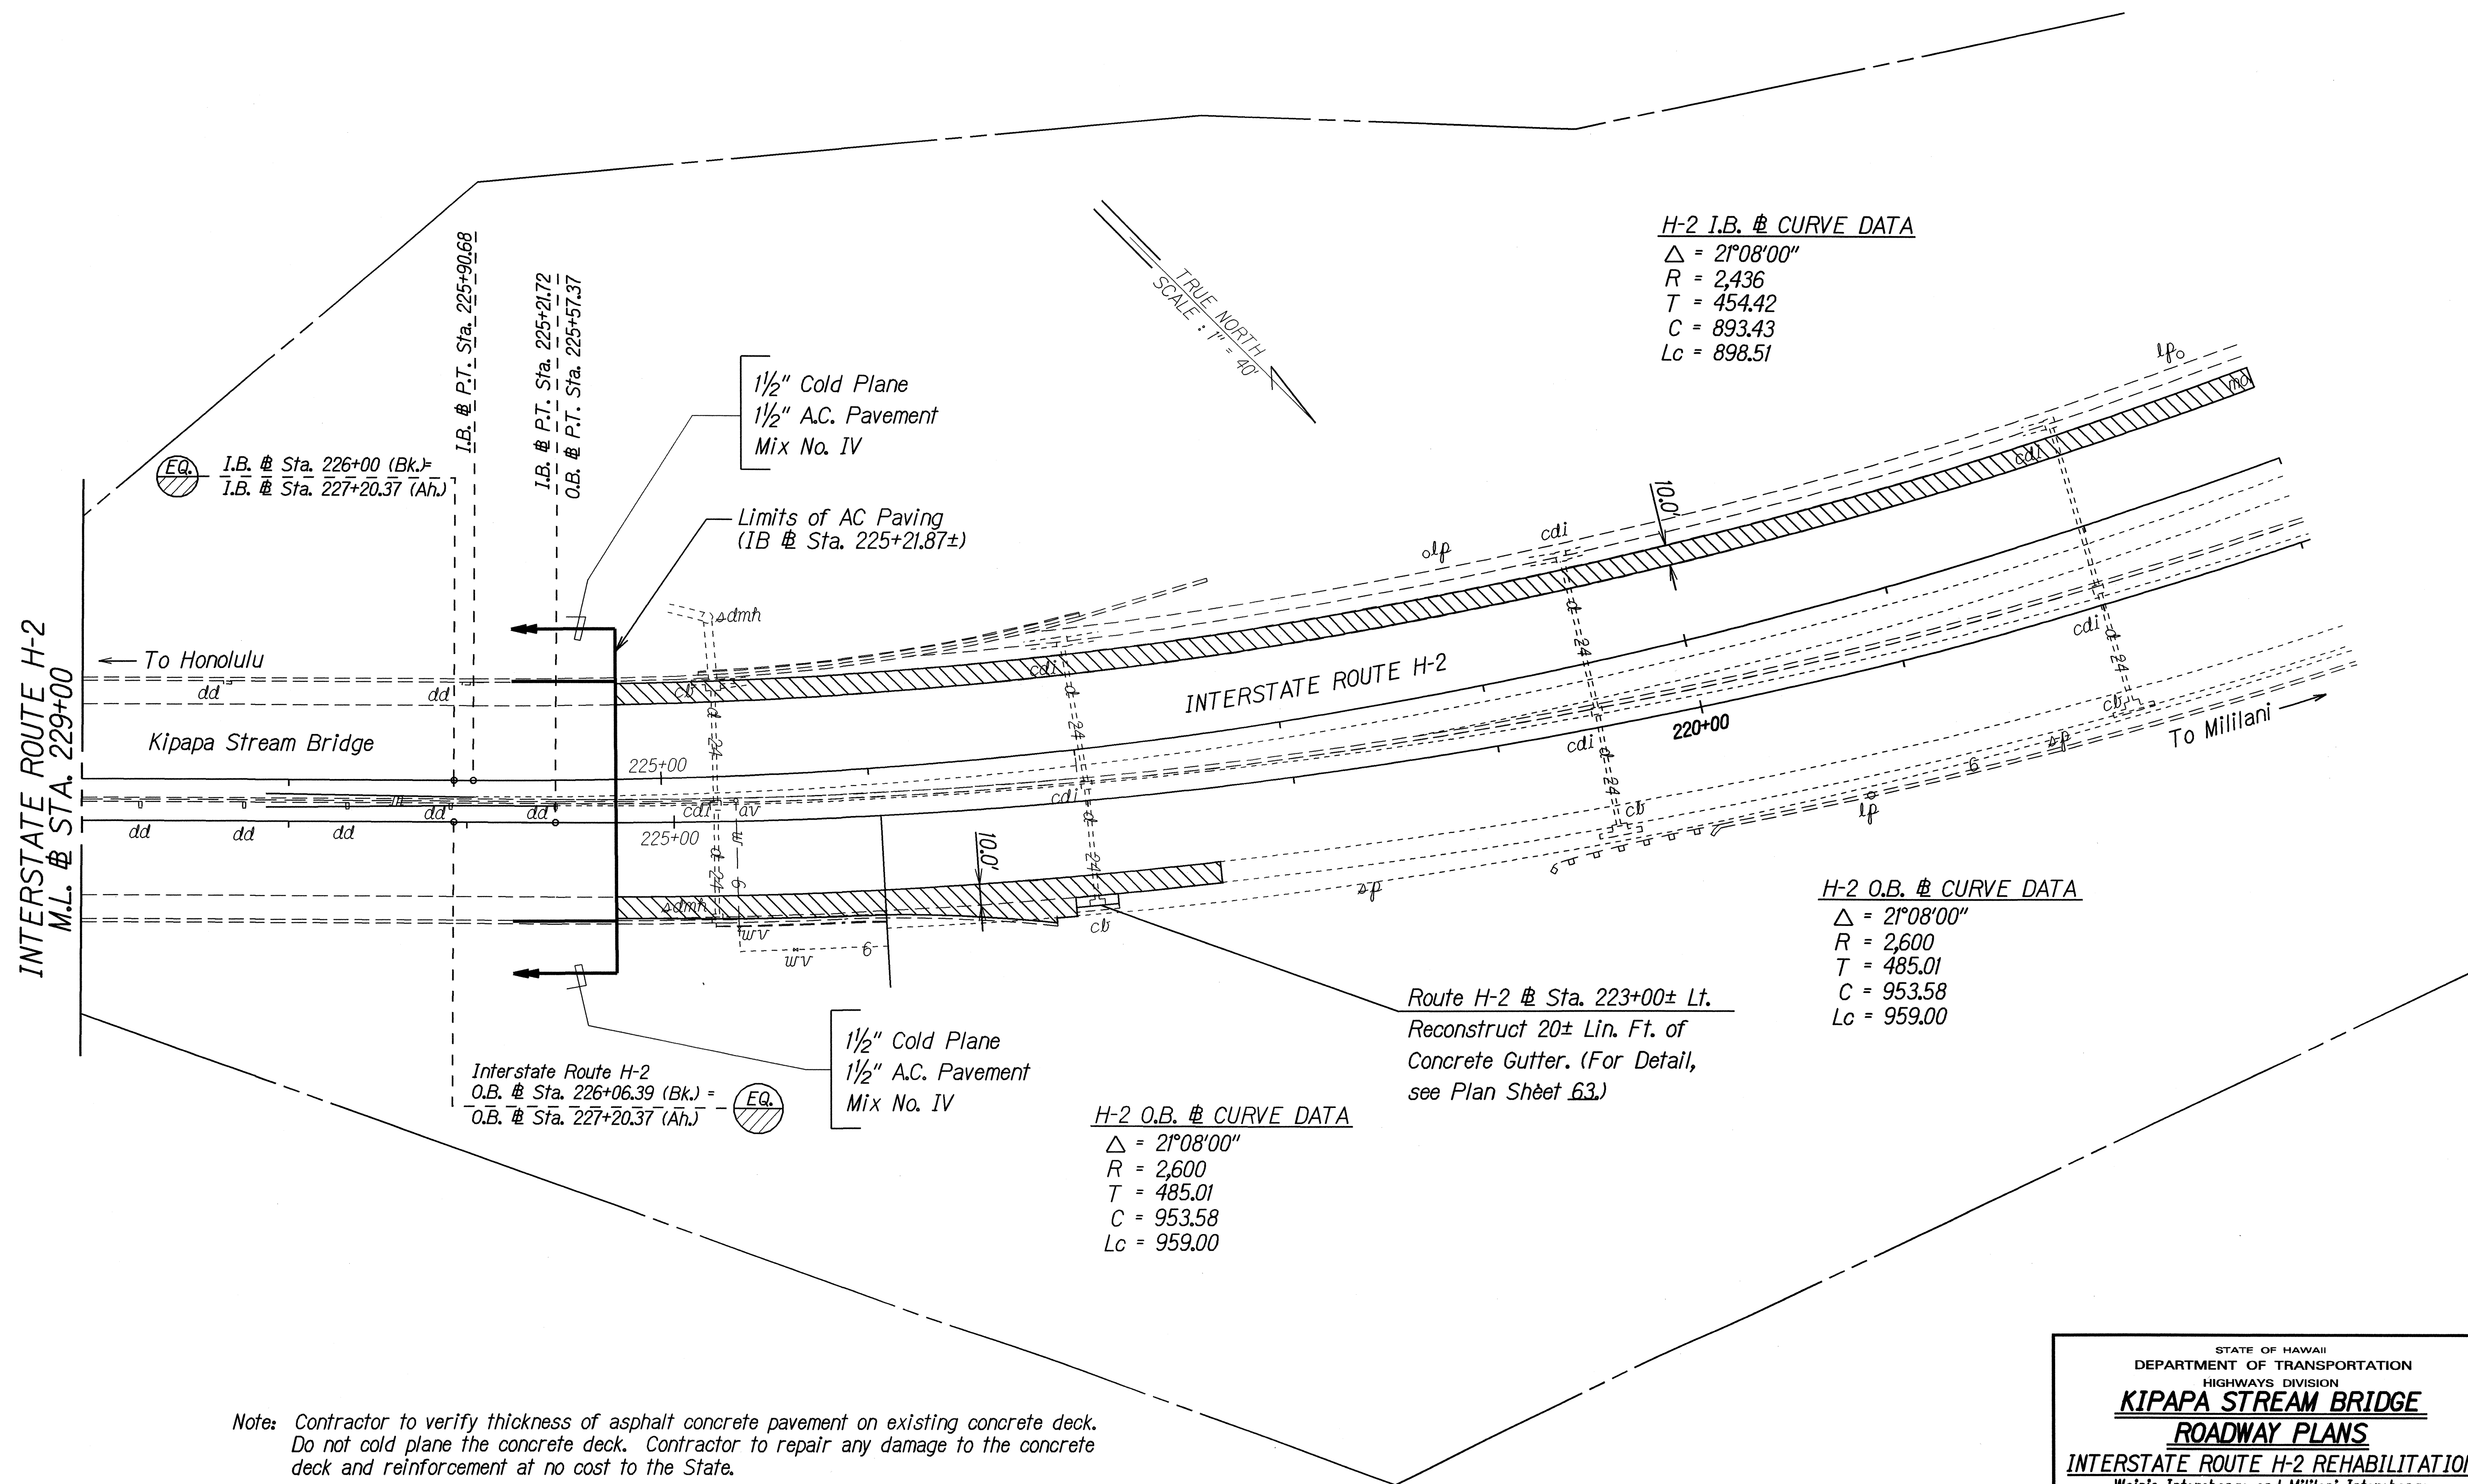

STATE OF HAWAII
 DEPARTMENT OF TRANSPORTATION
 HIGHWAYS DIVISION


KIPAPA STREAM BRIDGE
ROADWAY PLANS

INTERSTATE ROUTE H-2 REHABILITATION
 Waipio Interchange and Millilani Interchange
 On/Off Ramps, Ka Uka Boulevard and
 Meheula Parkway Overpasses, Kipapa Stream Bridge
 Federal Aid Project No. 1M-H2-1(33)

Scale: 1" = 40' Date: December, 2006

SHEET No. 11 OF 17 SHEETS

FED. ROAD DIST. NO.	STATE	FED. AID PROJ. NO.	FISCAL YEAR	SHEET NO.	TOTAL SHEETS
HAWAII	HAW.	IM-H2-1(33)	2007	54	168

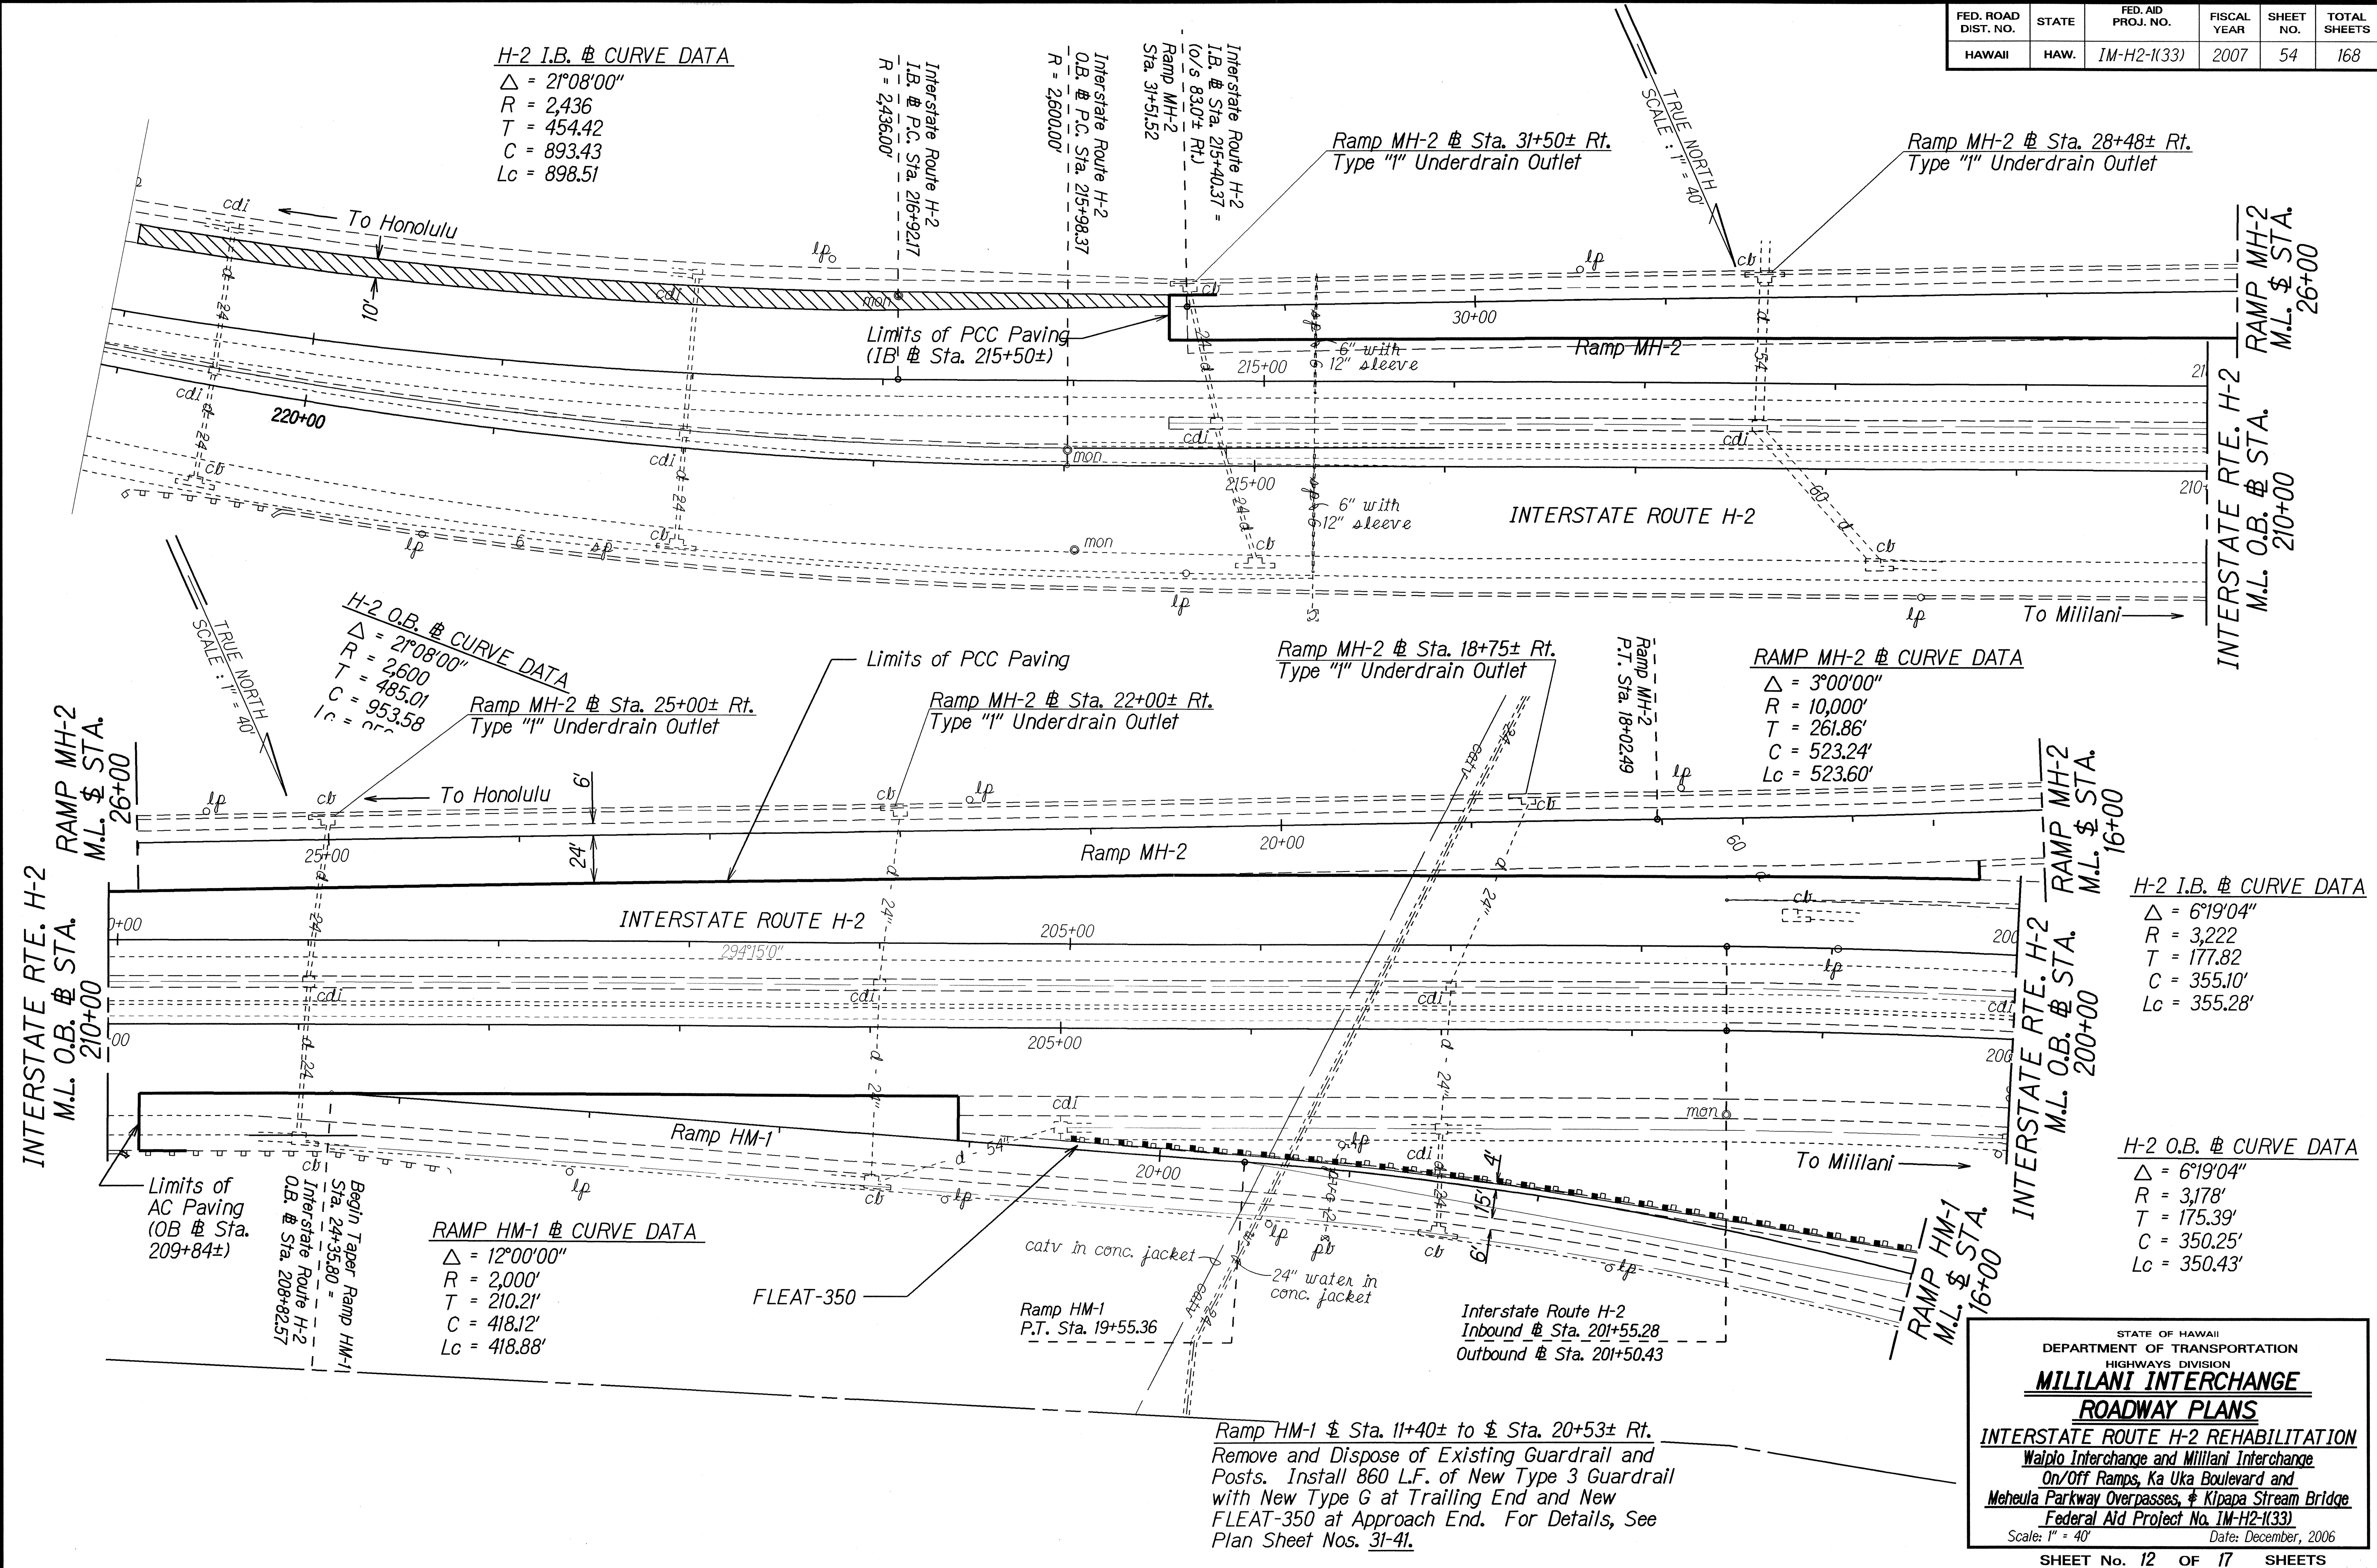


ORIGINAL PLAN	DATE
DESIGNED BY	
CHECKED BY	
NOTED BY	
DATE	

FED. ROAD DIST. NO.	STATE	FED. AID PROJ. NO.	FISCAL YEAR	SHEET NO.	TOTAL SHEETS
HAWAII	HAW.	IM-H2-1(33)	2007	56	168

INTERSTATE
ROUTE H-2
M.L. @ STA.
187+00 (See
Plan Sheet
No. 13)

RAMP A
M.L. @ STA. 23+00
(See Plan Sheet
No. 13)

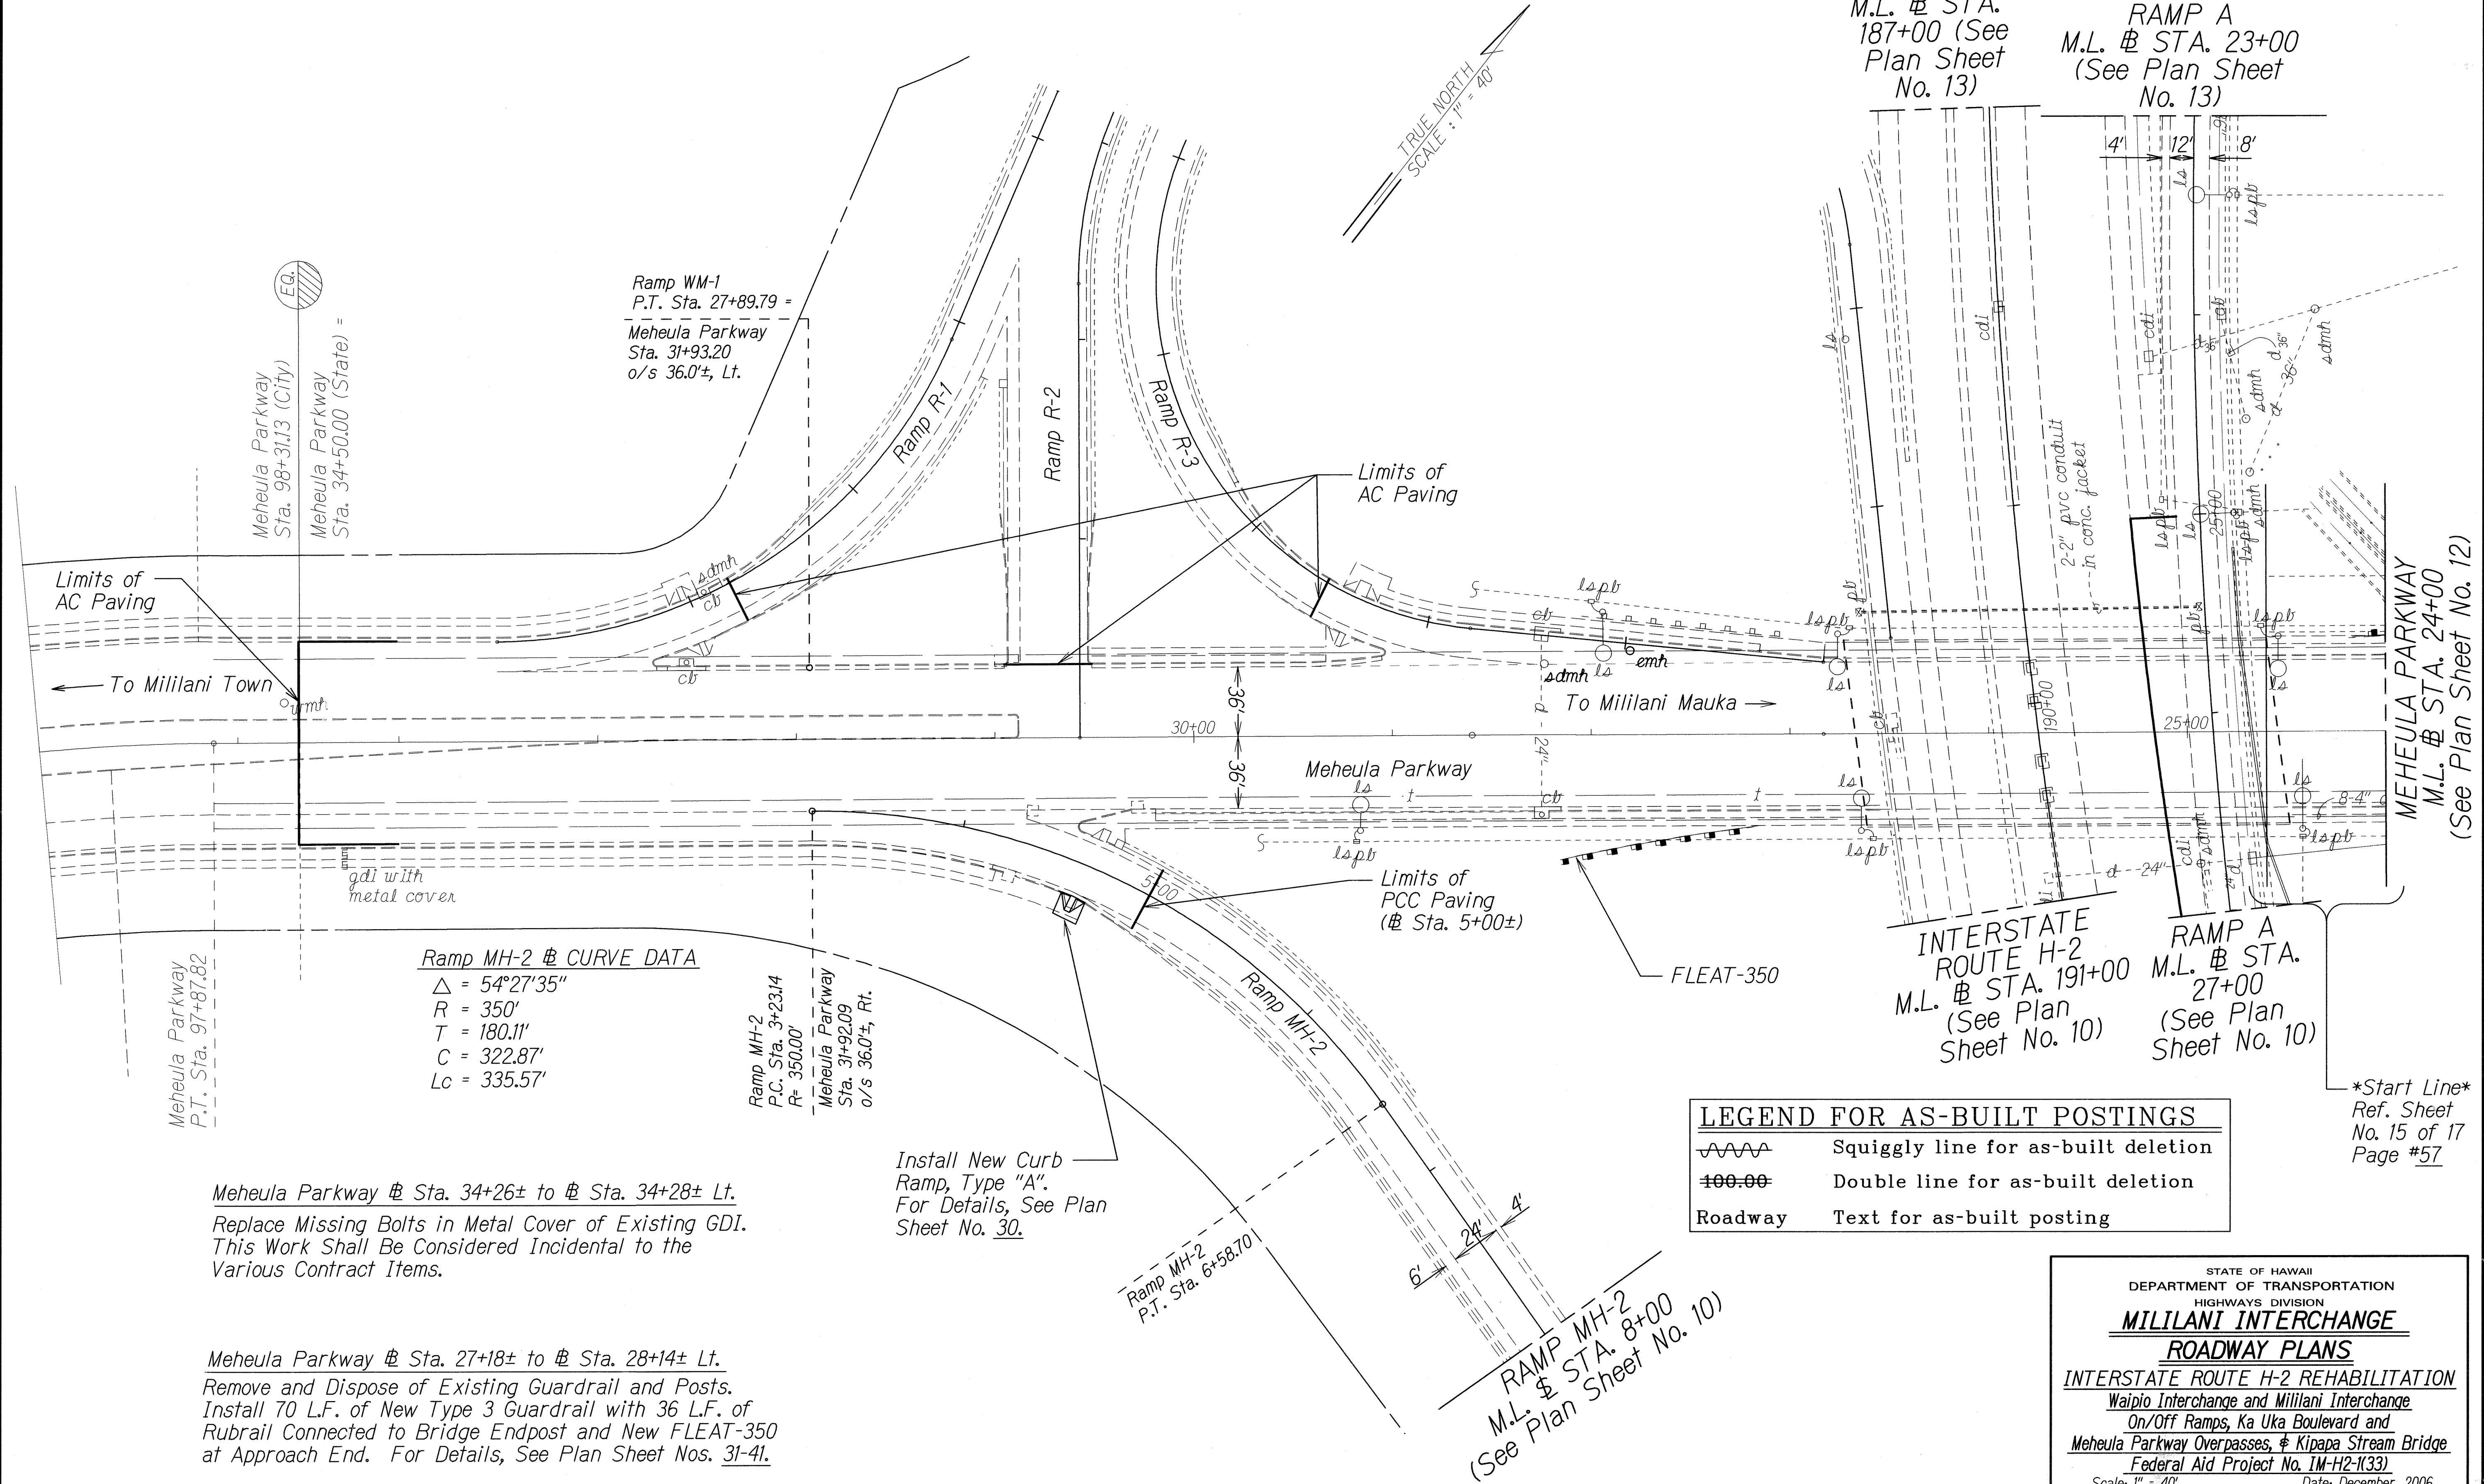

ORIGINAL PLAN	SURVEY PLOTTED BY	DATE
NOTE BOOK	DRAWN BY	
	DESIGNED BY	
	CHECKED BY	
		

LEGEND FOR AS-BUILT POSTINGS	
	Squiggly line for as-built deletion
	Double line for as-built deletion
Roadway	Text for as-built posting

STATE OF HAWAII

DEPARTMENT OF TRANSPORTATION

HIGHWAYS DIVISION

MILILANI INTERCHANGE

ROADWAY PLANS

INTERSTATE ROUTE H-2 REHABILITATION

Waipio Interchange and Mililani Interchange

On/Off Ramps, Ka Uka Boulevard and

Meheula Parkway Overpasses, & Kipapa Stream Bridge

Federal Aid Project No. IM-H2-1(33)

Scale: 1" = 40'

Date: December, 2006

SHEET No. 14 OF 17 SHEETS

FED. ROAD DIST. NO.	STATE	FED. AID PROJ. NO.	FISCAL YEAR	SHEET NO.	TOTAL SHEETS
HAWAII	HAW.	IM-H2-1(33)	2007	58	168

INTERSTATE ROUTE H-2
M.L. # STA. 180+00
(See Plan Sheet No. 14)

RAMP B
M.L. # STA. 18+00
(See Plan Sheet No. 14)

Ramp B
CURVE DATA
 $\Delta = 51^{\circ}19'50.7''$
 $R = 317'$
 $T = 152.33'$
 $C = 274.60'$
 $Lc = 284.00'$

Ramp A
CURVE DATA
 $\Delta = 177^{\circ}00'14.5''$
 $R = 260'$
 $T = 9,942.32$
 $C = 519.82'$
 $Lc = 803.22$

Ramp A
CURVE DATA
 $\Delta = 1^{\circ}47'25.8''$
 $R = 3,200'$
 $T = 480.91'$
 $C = 0.000$
 $Lc = 951.15'$

Ramp "A"
P.C.C. Sta. 21+99.46
 $R = 260.00'$
 $R = 3,200.00'$

Interstate Route H-2
P.T. Sta. 186+16.95

INTERSTATE ROUTE H-2
M.L. # STA. 187+00
(See Plan Sheet No. 11)

RAMP A
M.L. # STA. 23+00
(See Plan Sheet No. 11)

RAMP A
M.L. # STA. 14+50
(See Plan Sheet No. 12)

RAMP B
M.L. # STA. 25+50
(See Plan Sheet No. 12)


STATE OF HAWAII
DEPARTMENT OF TRANSPORTATION
HIGHWAYS DIVISION

MILILANI INTERCHANGE
ROADWAY PLANS
INTERSTATE ROUTE H-2 REHABILITATION
Waipio Interchange and Mililani Interchange
On/Off Ramps, Ka Uka Boulevard and
Meheula Parkway Overpasses, # Kipapa Stream Bridge
Federal Aid Project No. IM-H2-1(33)
Scale: 1" = 40'
Date: December, 2006

SHEET No. 16 OF 17 SHEETS

ORIGINAL PLAN	DATE
SURVEY PLOTTED BY	
DESIGNED BY	
TRACED BY	
NOTE BOOK	
QUANTITIES BY	
CHECKED BY	

FED. ROAD DIST. NO.	STATE	FED. AID PROJ. NO.	FISCAL YEAR	SHEET NO.	TOTAL SHEETS
HAWAII	HAW.	IM-H2-1(33)	2007	59	168

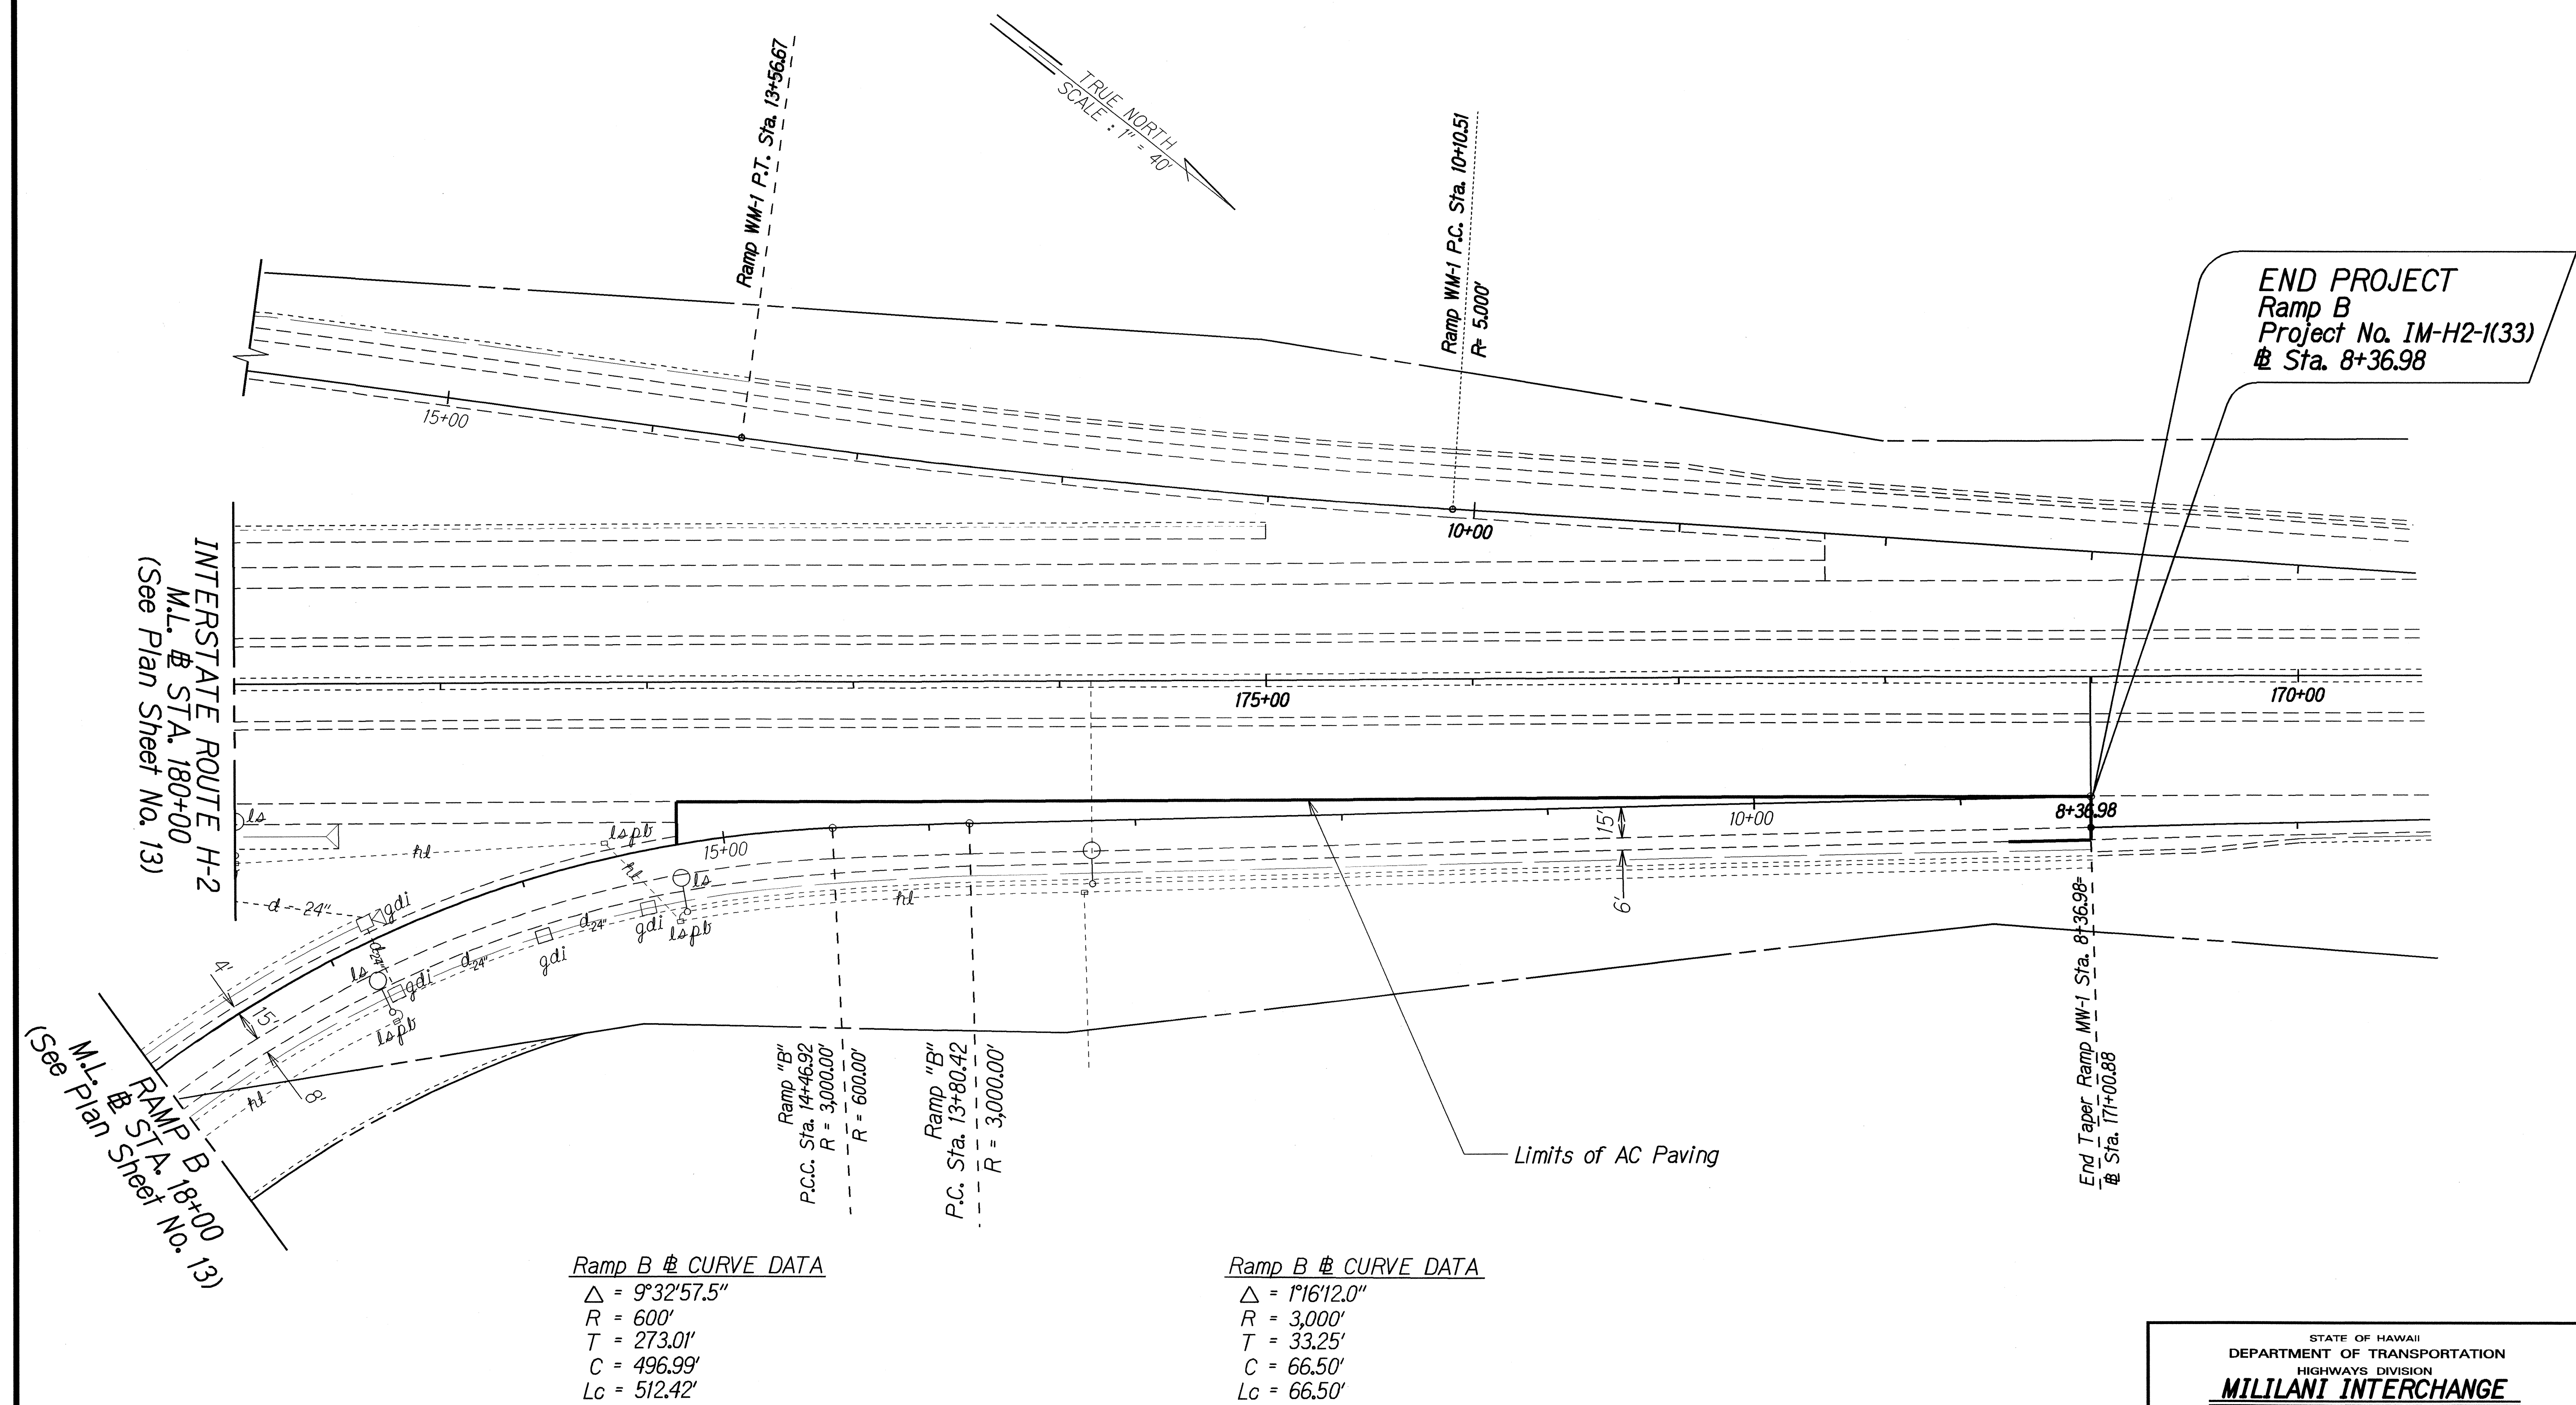

Ramp B @ CURVE DATA
 $\Delta = 9^{\circ}32'57.5''$
 $R = 600'$
 $T = 273.01'$
 $C = 496.99'$
 $Lc = 512.42'$

Ramp B @ CURVE DATA
 $\Delta = 1^{\circ}16'12.0''$
 $R = 3,000'$
 $T = 33.25'$
 $C = 66.50'$
 $Lc = 66.50'$

ORIGINAL PLAN	DATE
DESIGNED BY	
TRACED BY	
QUANTITIES BY	
CHECKED BY	

STATE OF HAWAII
DEPARTMENT OF TRANSPORTATION
HIGHWAYS DIVISION
MILILANI INTERCHANGE
ROADWAY PLANS
INTERSTATE ROUTE H-2 REHABILITATION
Waipio Interchange and Mililani Interchange
On/Off Ramps, Ka Uka Boulevard and
Meheula Parkway Overpasses, & Kipapa Stream Bridge
Federal Aid Project No. IM-H2-1(33)
Scale: 1" = 40' Date: December, 2006
SHEET No. 17 OF 17 SHEETS