



FED. ROAD DIST. NO.	STATE	PROJ. NO.	FISCAL YEAR	SHEET NO.	TOTAL SHEETS
HAWAII	HAW.	H2A/G-02-05M	2014	21	30

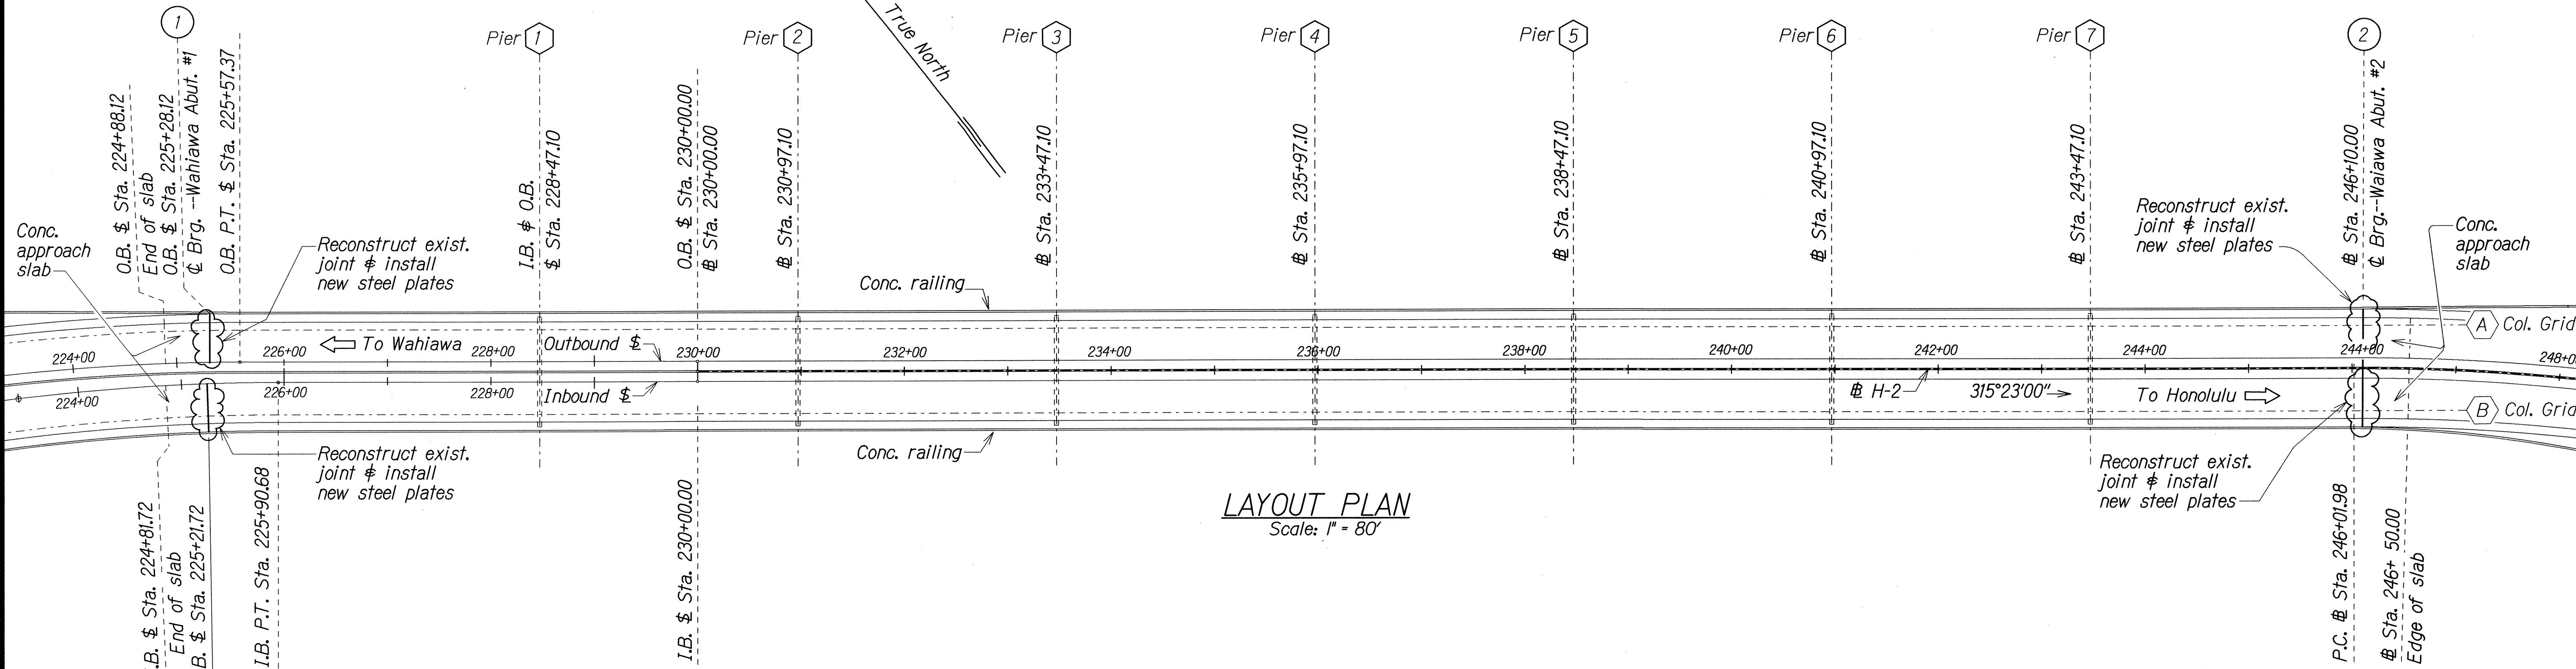

LAYOUT PLAN  
Scale: 1" = 80'

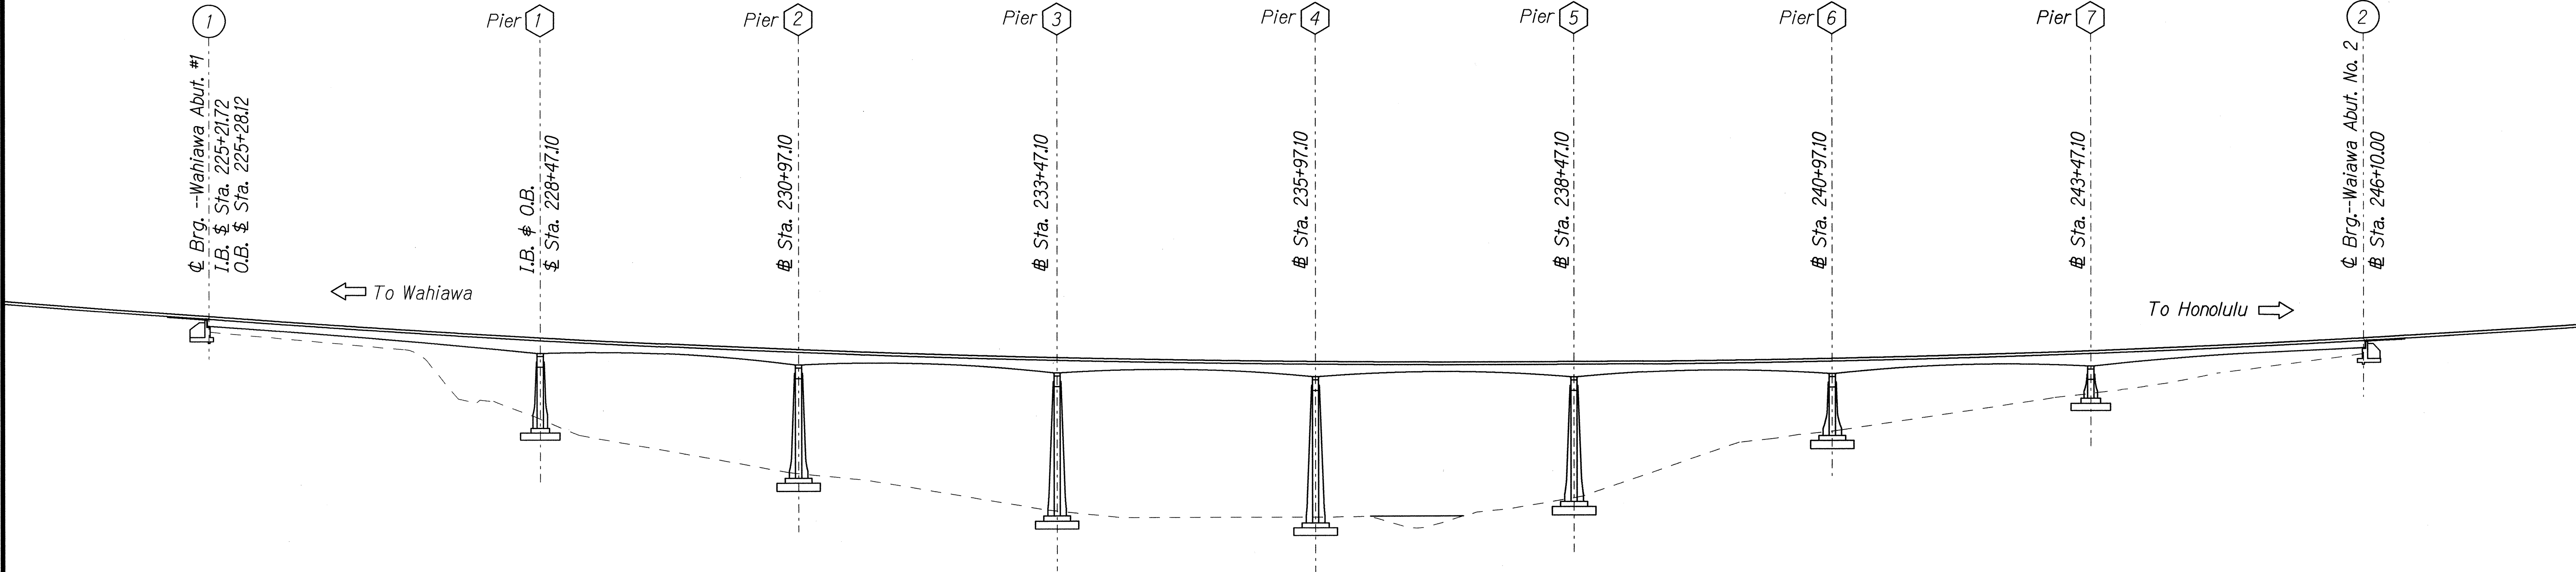

LONGITUDINAL SECTION  
Scale: 1" = 80'

# KIPAPA STREAM BRIDGE


STATE OF HAWAII  
DEPARTMENT OF TRANSPORTATION  
HIGHWAYS DIVISION

**KIPAPA STREAM BRIDGE**  
LAYOUT PLAN and LONGITUDINAL SECTION  
INTERSTATE ROUTE H-2 JOINT REPAIR  
WAIAWA INTERCHANGE to WAHIAWA INTERCHANGE  
Project No. H2A/G-02-05M


Scale: As Noted Date: Aug. 2013

SHEET No. Q16 OF 22 SHEETS

FED. ROAD DIST. NO.	STATE	PROJ. NO.	FISCAL YEAR	SHEET NO.	TOTAL SHEETS
HAWAII	HAW.	H2A/G-02-05M	2014	22	30

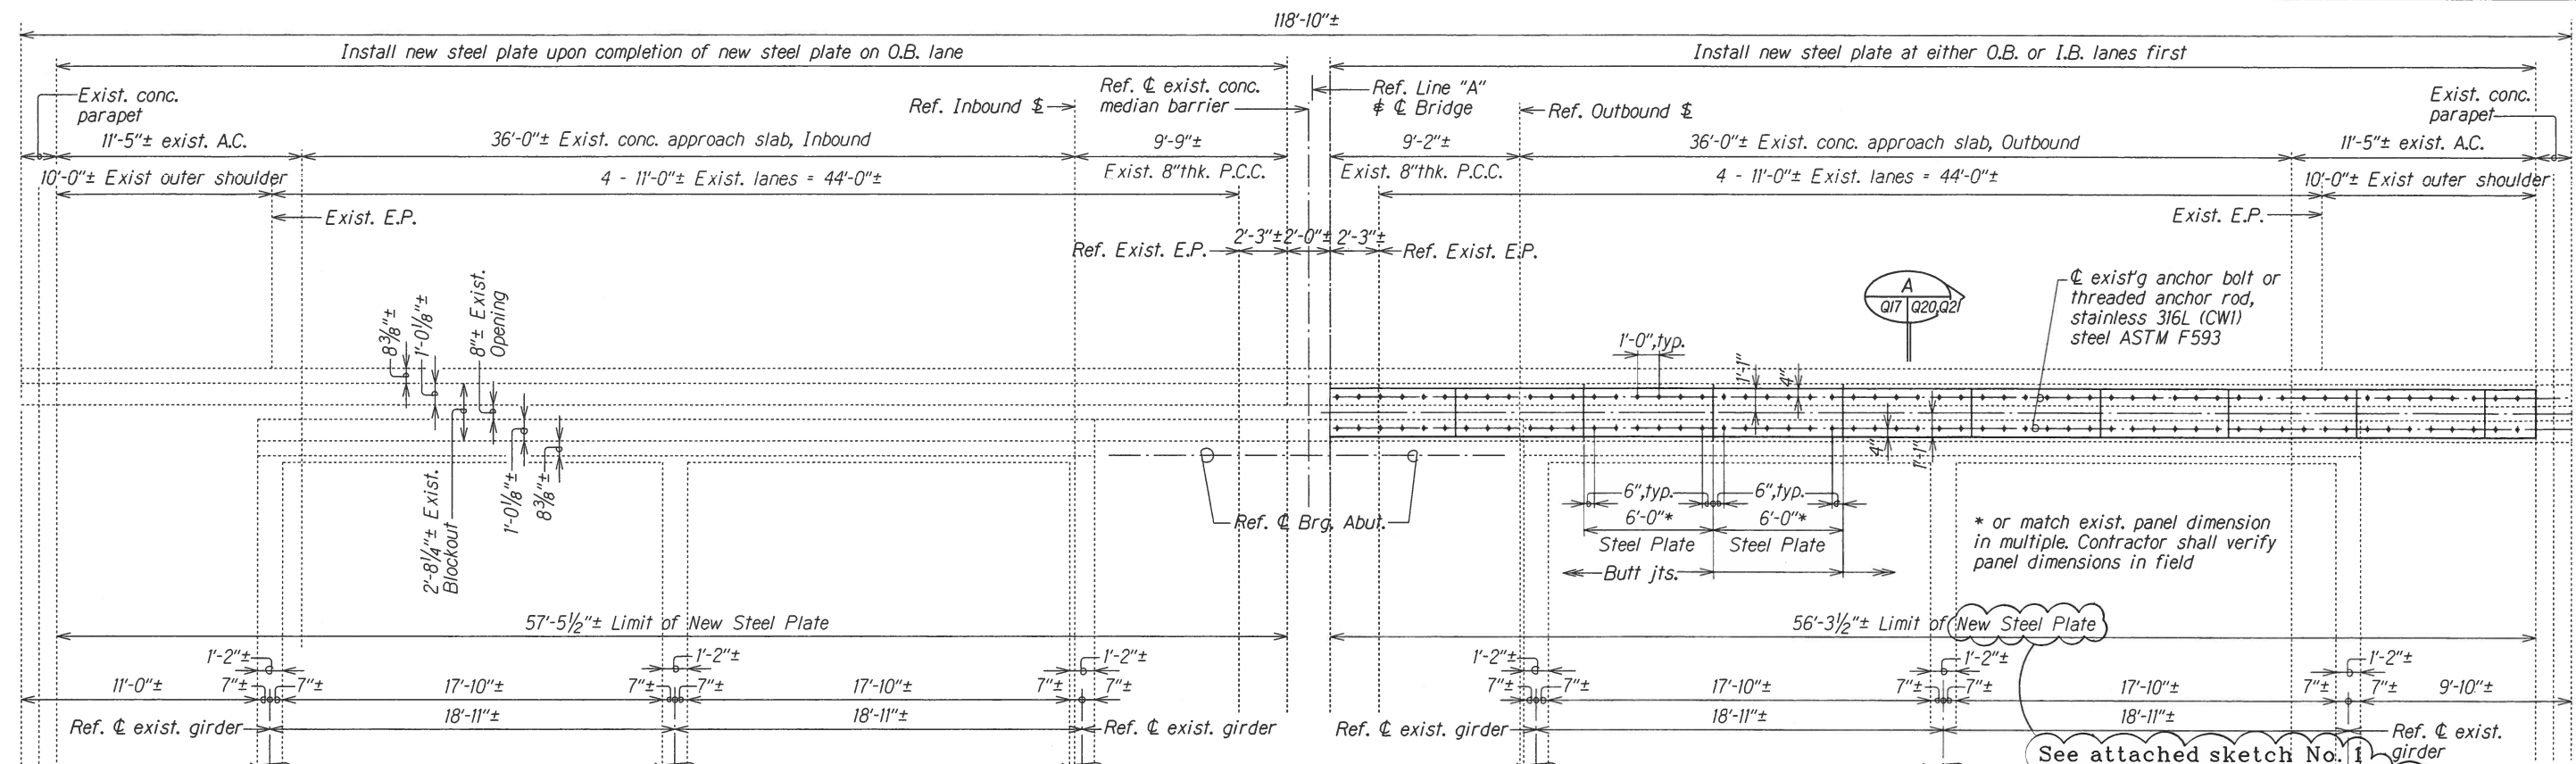

PLAN--NEW STEEL PLATE at ABUTMENT NO. 1 (Inbound and Outbound), Abutment No. 2 Similar

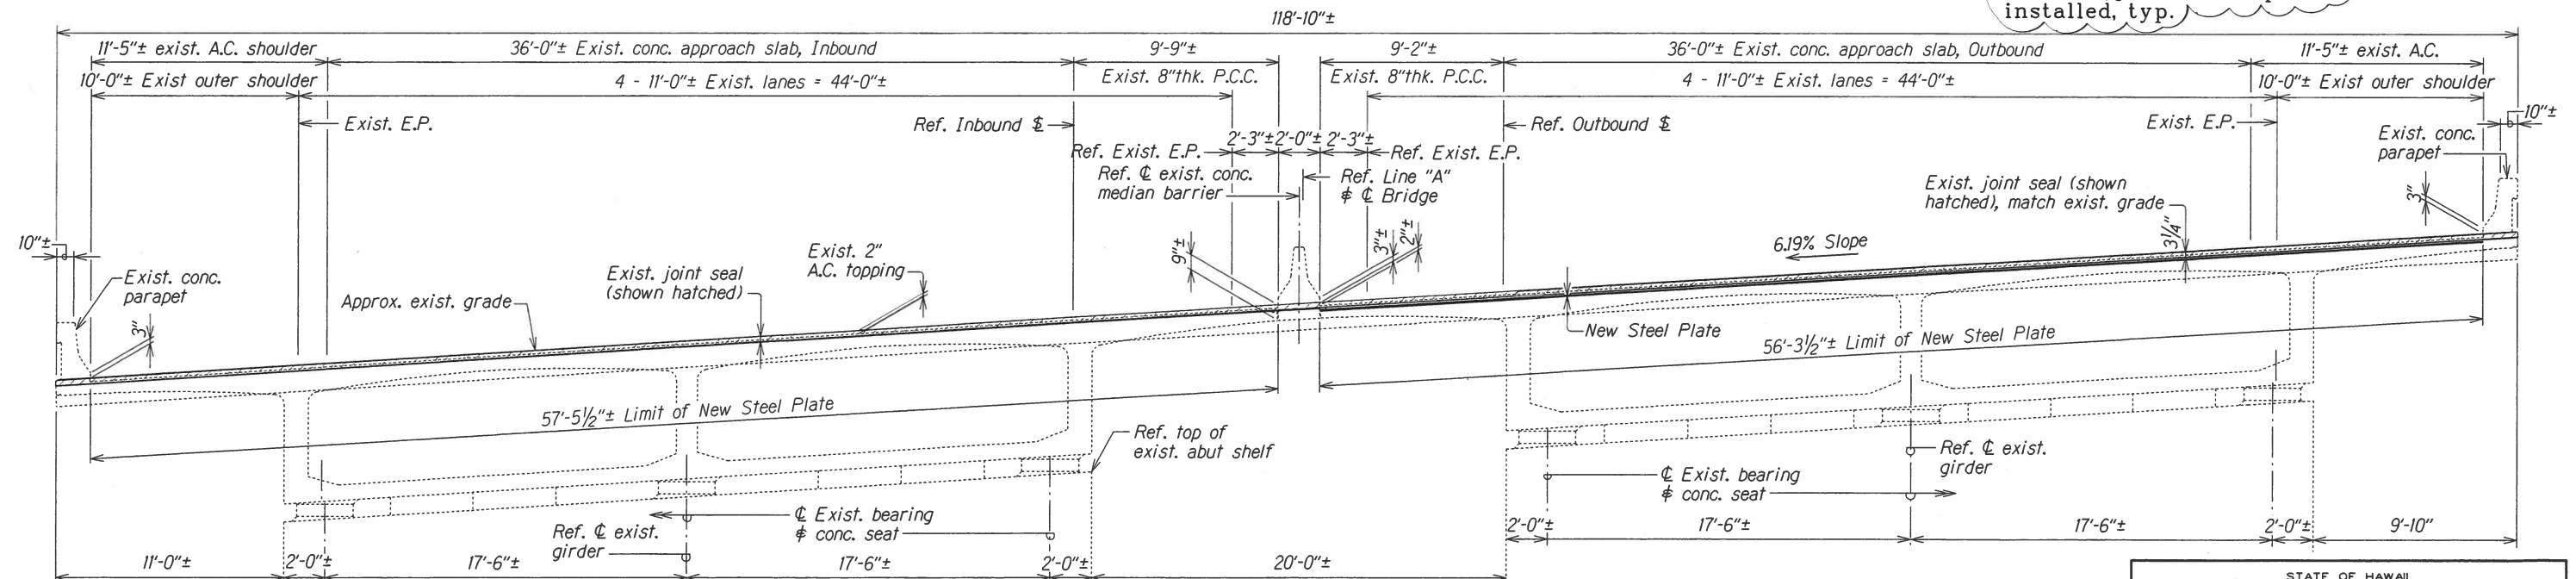

ELEVATION--EXPANSION JOINT SEAL at ABUTMENT NO. 1 (Inbound and Outbound), Abutment No. 2 Similar, Opposite

# KIPAPA STREAM BRIDGE

Scale: 1/4" = 1'-0"

LEGEND FOR AS-BUILT POSTINGS	
	Squiggly line for as-built deletion
	Double line for as-built deletion
Roadway	Text for as-built posting


STATE OF HAWAII DEPARTMENT OF TRANSPORTATION HIGHWAYS DIVISION	
KIPAPA STREAM BRIDGE	
PLAN & ELEVATION--EXPANSION JOINT SEAL at ABUTMENT NOS. 1 & 2	
INTERSTATE ROUTE H-2 JOINT REPAIR	
WAIKAWA INTERCHANGE to WAIKAWA INTERCHANGE	
Project No. H2A/G-02-05M	
Scale: As Noted	Date: Aug. 2013

SHEET No. Q17 OF 22 SHEETS

"AS-BUILT"

22

FED. ROAD DIST. NO.	STATE	PROJ. NO.	FISCAL YEAR	SHEET NO.	TOTAL SHEETS
HAWAII	HAW.	H2A/G-02-05M	2014	23	30

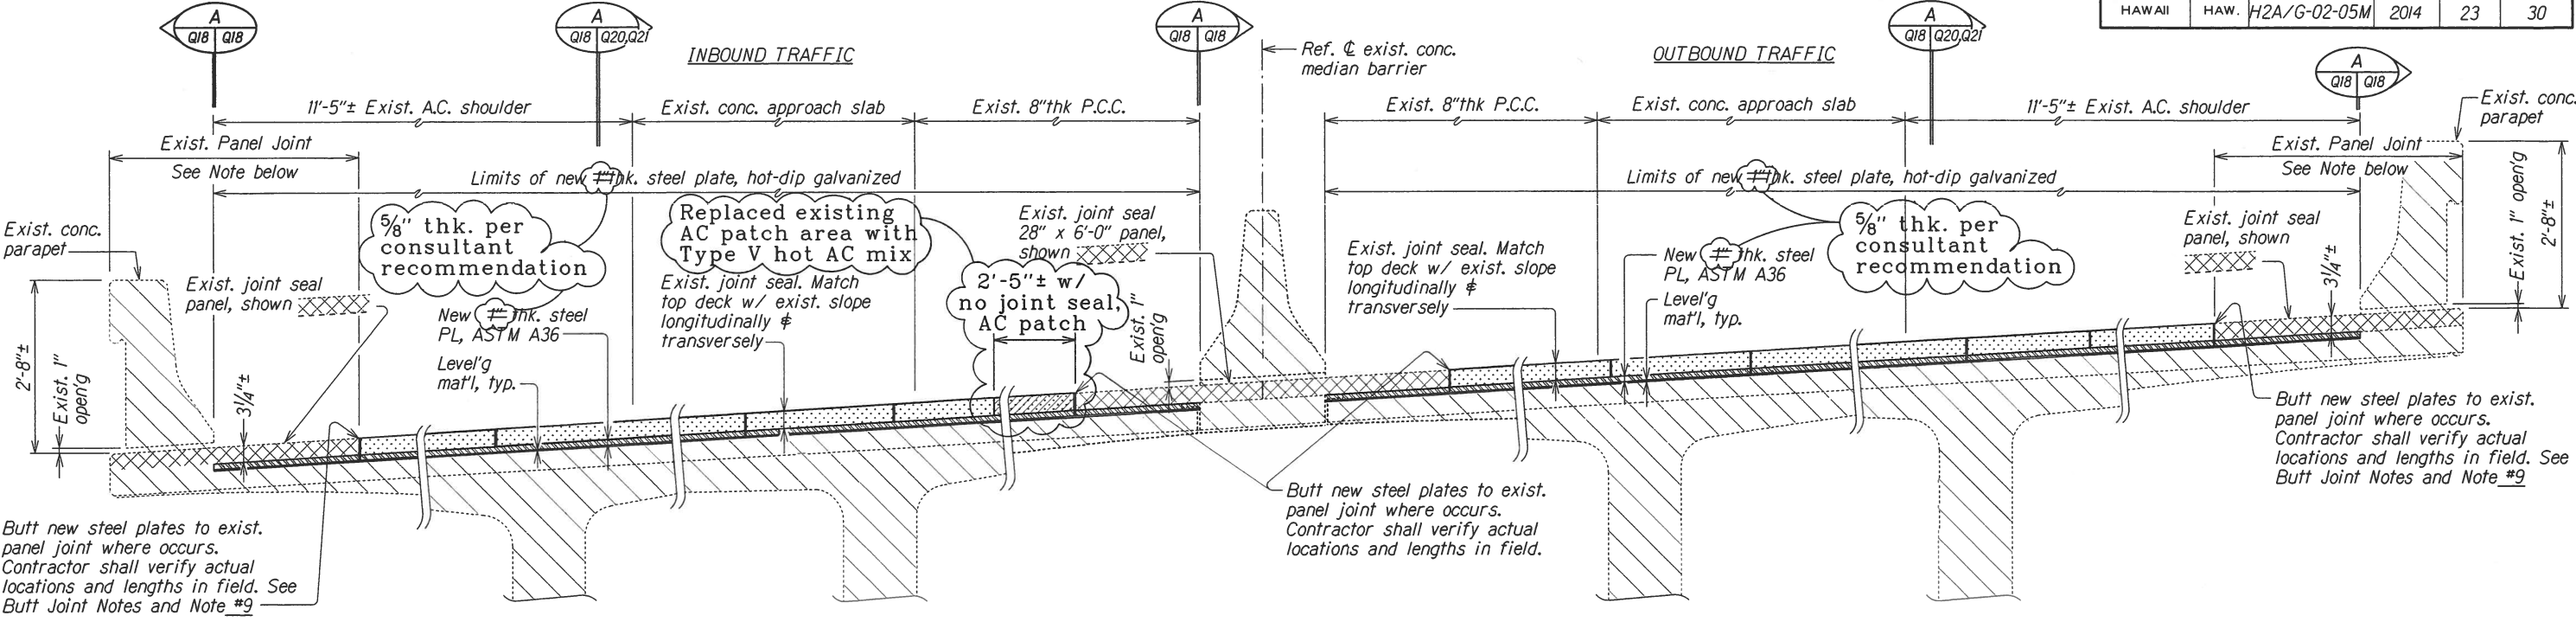


TYPICAL SECTION THRU EXPANSION JOINT at ABUTMENT NO. 1  
Inbound and Outbound (Abutment No. 2 Similar)  
Scale: 3/4" = 1'-0"

BUTT JOINT NOTES:

1. Provide watertight condition per manufacturer's specifications at each existing panel joint.
2. The Contractor shall provide traffic control plans to direct public traffic for lane closures throughout the completion of work. See Special Provisions, Section 645, for suggested lane closure timetable.
3. All existing reinforcing bars shall be cleaned of rust, concrete, etc. before new concrete is poured. Cleaning of existing reinforcing bars shall be incidental and shall not be paid for separately.
4. All voids below existing P.C.C. shall be filled with concrete. No vehicles shall pass over until the concrete has been poured above existing bed course material and has gained a strength of  $f'_c = 3,000$  p.s.i.. The new concrete shall be poured to the depth as shown in the plan and shall not form "cold joint".
5. Provide shoring as necessary to support and prevent undermining of existing bed course material.
6. No vehicles shall cross over existing joint seal upon removal of existing concrete until it has adequately supported and stabilized.

NOTES:

6. The existing seal's finish grade shall match and maintain the grade of the existing roadway in both longitudinal and transverse directions.
7. See "Special Provisions" for material specifications and construction requirements.
8. Probe and locate existing reinforcing bars and adjust saw-cut depth accordingly.
9. The Contractor shall complete installation of new steel plate in each traffic lane prior to commencing with removal of existing concrete in other traffic lane. Removal of existing concrete in two traffic lanes may be done concurrently only if it can be completed within a scheduled lane-closure time frame.
10. Under cut existing bars one inch (1") into existing concrete, where existing reinforcing bars are cut.
11. Cut existing anchor bolts flush with or below concrete surface. Do not apply heat to cut bolts.
12. The Contractor shall verify in field all dimensions for accuracy, changes in field conditions, etc. prior to commencing with work, and notify the Engineer in advance of any discrepancies or omissions from the contract plans.

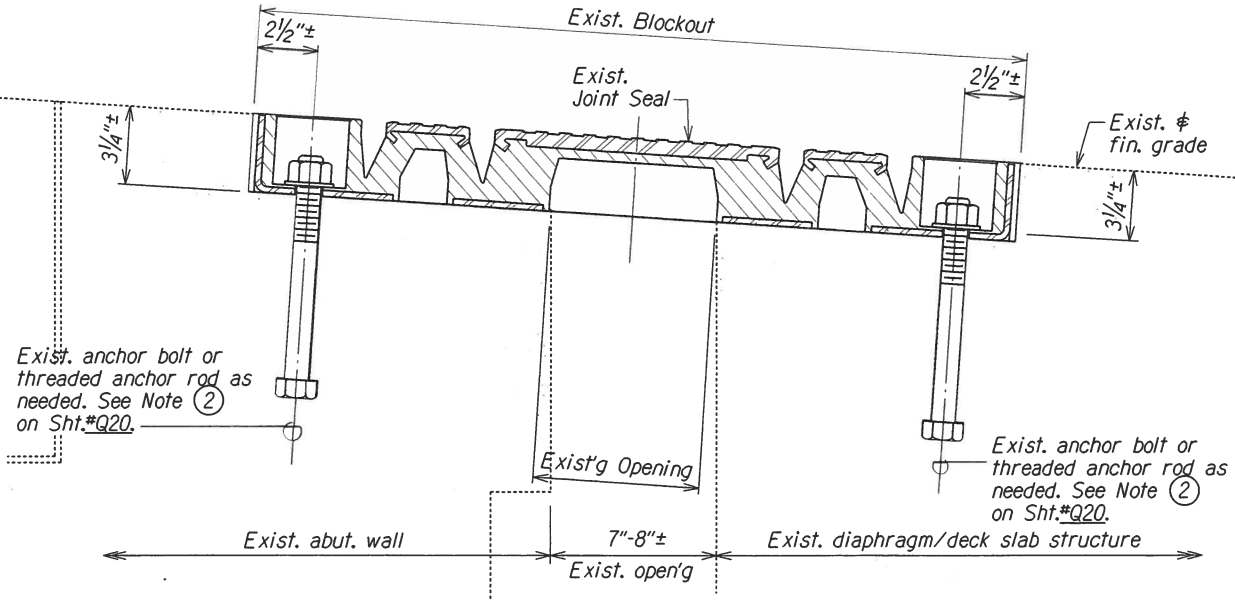

SECTION  
BENEATH CONCRETE PARAPET and MEDIAN BARRIER ONLY  
Not to Scale

ORIGINAL PLAN	SURVEY PLOTTED BY	DATE
NOTE BOOK	DRAWN BY	
QUANTITIES BY	DESIGNED BY	
CHECKED BY	APPROVED BY	

LEGEND FOR AS-BUILT POSTINGS	
	Squiggly line for as-built deletion
	Double line for as-built deletion
Roadway	Text for as-built posting


STATE OF HAWAII  
DEPARTMENT OF TRANSPORTATION  
HIGHWAYS DIVISION

**KIPAPA STREAM BRIDGE**  
TYPICAL SECTION THRU EXPANSION JOINT  
at ABUTMENT NO. 1 (Inbound & Outbound)  
INTERSTATE ROUTE H-2 JOINT REPAIR  
WAIKAWA INTERCHANGE to WAIKAWA INTERCHANGE  
Project No. H2A/G-02-05M

Scale: As Noted
Date: Aug. 2008

SHEET No. Q18 OF 22 SHEETS

FED. ROAD DIST. NO.	STATE	PROJ. NO.	FISCAL YEAR	SHEET NO.	TOTAL SHEETS
HAWAII	HAW.	H2A/G-02-05M	2014	23	30

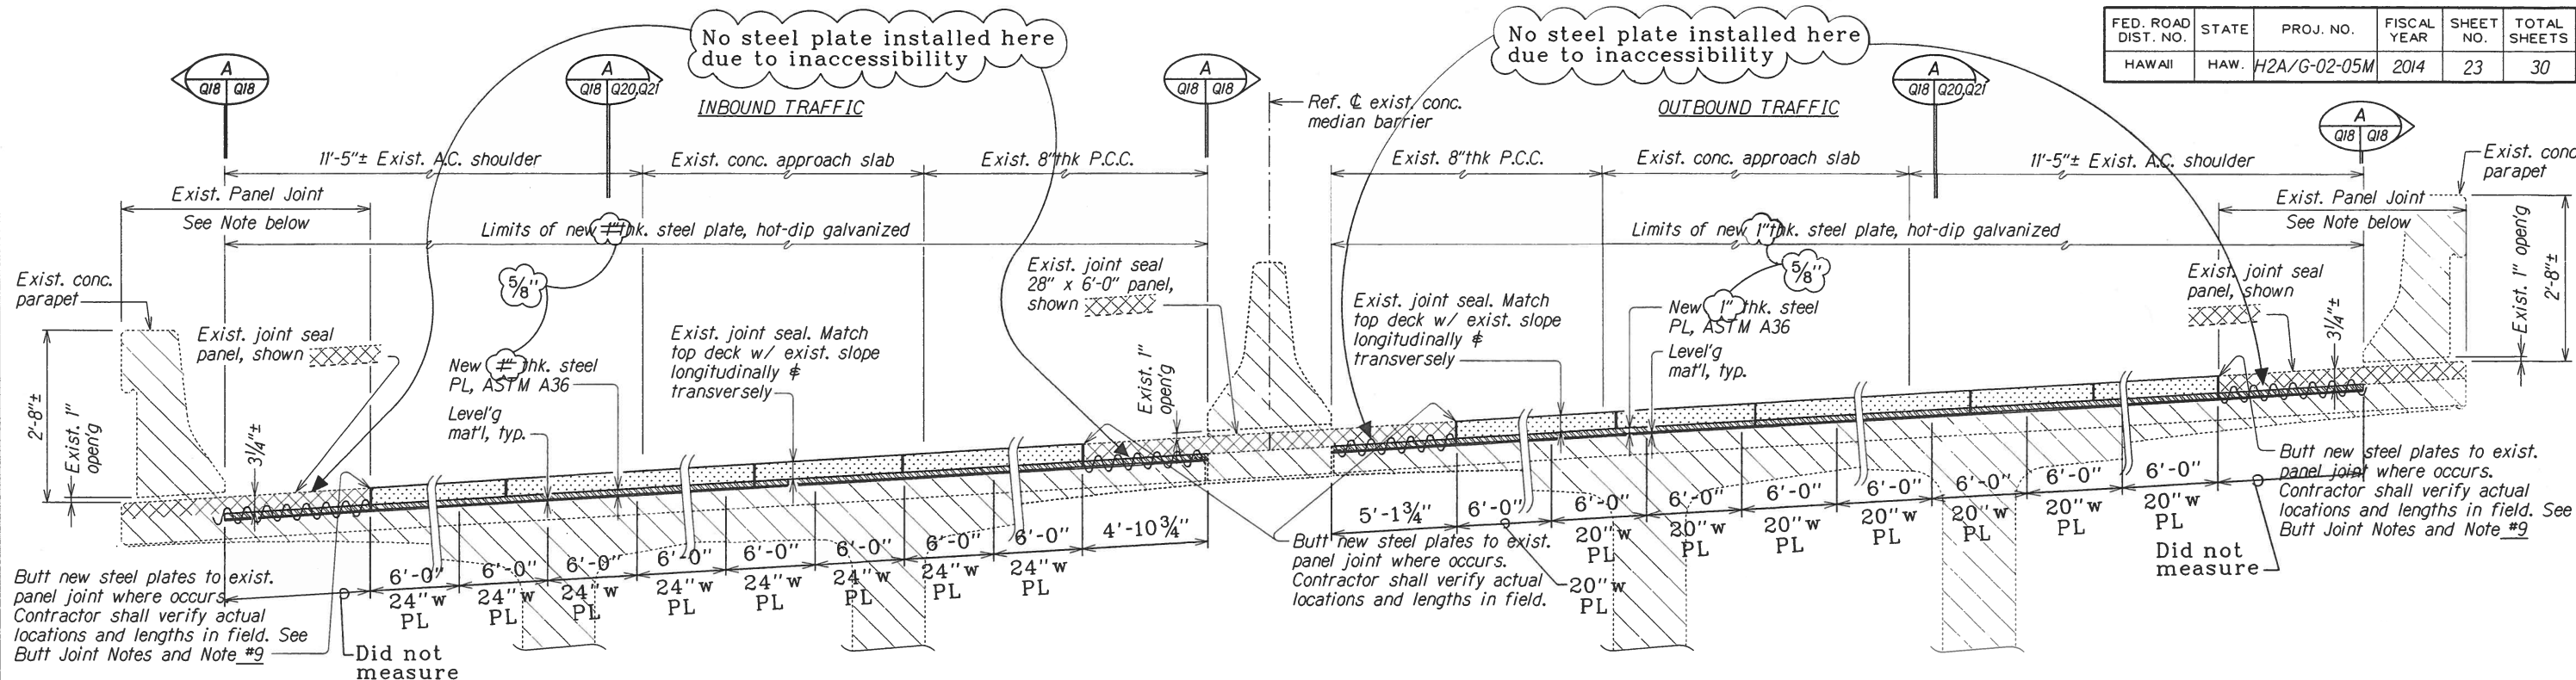

TYPICAL SECTION THRU EXPANSION JOINT at ABUTMENT NO. 1  
Inbound and Outbound (Abutment No. 2 Similar)  
Scale: 3/4" = 1'-0"  
Abutment No. 1 is North Abutment


### BUTT JOINT NOTES:

1. Provide watertight condition per manufacturer's specifications at each existing panel joint.

### NOTES:

1. The Contractor shall provide traffic control plans to direct public traffic for lane closures throughout the completion of work. See Special Provisions, Section 645, for suggested lane closure timetable.
2. All existing reinforcing bars shall be cleaned of rust, concrete, etc. before new concrete is poured. Cleaning of existing reinforcing bars shall be incidental and shall not be paid for separately.
3. All voids below existing P.C.C. shall be filled with concrete. No vehicles shall pass over until the concrete has been poured above existing bed course material and has gained a strength of  $f'_c = 3,000$  p.s.i.. The new concrete shall be poured to the depth as shown in the plan and shall not form "cold joint".
4. Provide shoring as necessary to support and prevent undermining of existing bed course material.
5. No vehicles shall cross over existing joint seal upon removal of existing concrete until it has adequately supported and stabilized.

6. The existing seal's finish grade shall match and maintain the grade of the existing roadway in both longitudinal and transverse directions.
7. See "Special Provisions" for material specifications and construction requirements.
8. Probe and locate existing reinforcing bars and adjust saw-cut depth accordingly.
9. The Contractor shall complete installation of new steel plate in each traffic lane prior to commencing with removal of existing concrete in other traffic lane. Removal of existing concrete in two traffic lanes may be done concurrently only if it can be completed within a scheduled lane-closure time frame.
10. Under cut existing bars one inch (1") into existing concrete, where existing reinforcing bars are cut.
11. Cut existing anchor bolts flush with or below concrete surface. Do not apply heat to cut bolts.
12. The Contractor shall verify in field all dimensions for accuracy, changes in field conditions, etc. prior to commencing with work, and notify the Engineer in advance of any discrepancies or omissions from the contract plans.

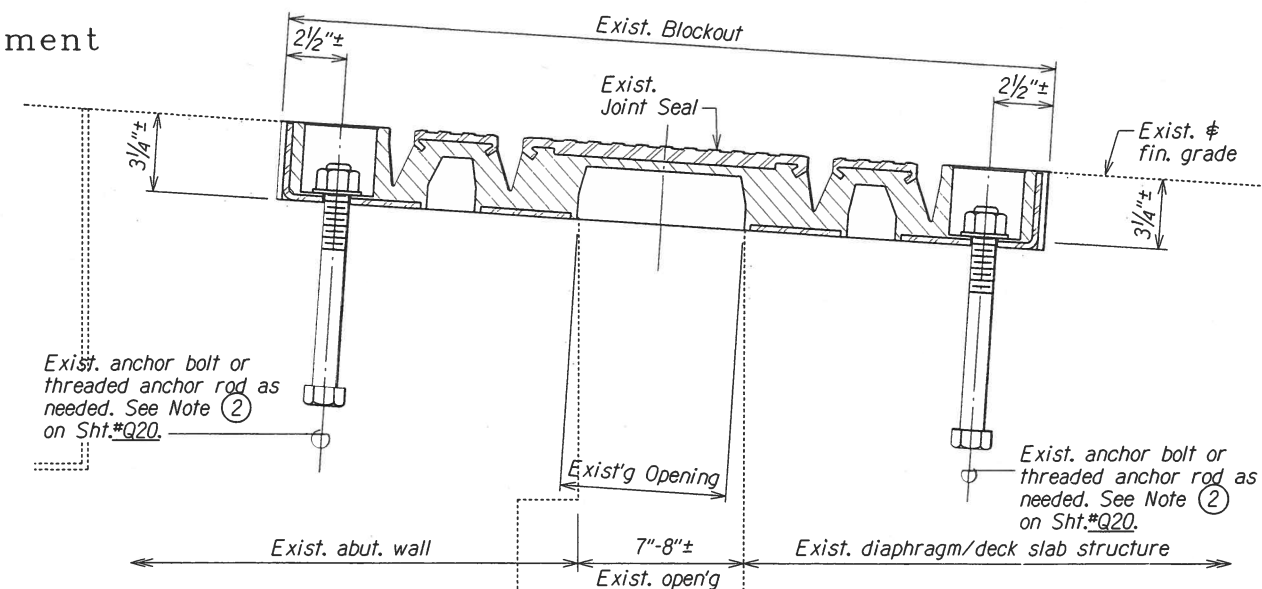

SECTION  
BENEATH CONCRETE PARAPET and MEDIAN BARRIER ONLY  
Not to Scale


SURVEY PLOTTED BY	DATE
DRAWN BY	
CHECKED BY	
NOTE BOOK	
QUANTITIES BY	
CHECKED BY	

LEGEND FOR AS-BUILT POSTINGS	
	Squiggly line for as-built deletion
	Double line for as-built deletion
Roadway	Text for as-built posting

STATE OF HAWAII  
DEPARTMENT OF TRANSPORTATION  
HIGHWAYS DIVISION  
**KIPAPA STREAM BRIDGE**  
TYPICAL SECTION THRU EXPANSION JOINT  
at ABUTMENT NO. 1 (Inbound & Outbound)  
INTERSTATE ROUTE H-2 JOINT REPAIR  
WAIKAWA INTERCHANGE to WAIKAWA INTERCHANGE  
Project No. H2A/G-02-05M  
Scale: As Noted Date: Aug. 2008  
SHEET No. Q18A OF 22 SHEETS



FED. ROAD DIST. NO.	STATE	PROJ. NO.	FISCAL YEAR	SHEET NO.	TOTAL SHEETS
HAWAII	HAW.	H2A/G-02-05M	2014	23	30

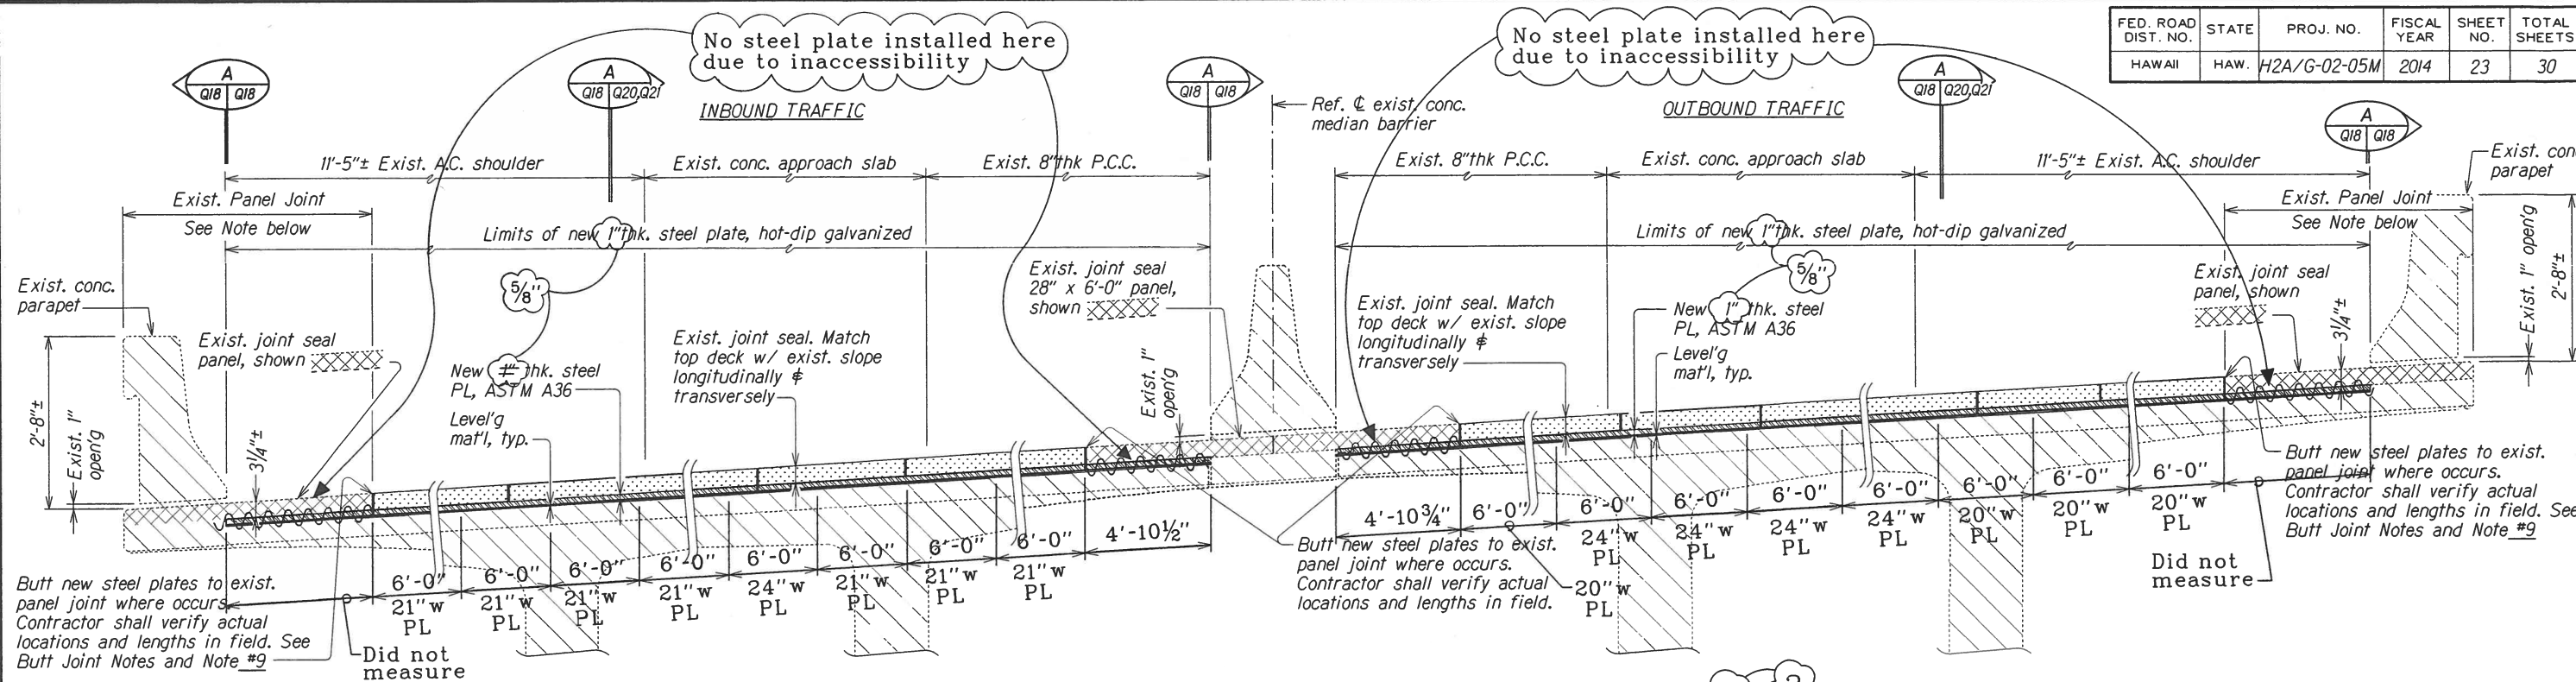

**TYPICAL SECTION THRU EXPANSION JOINT at ABUTMENT NO. 2**  
 Inbound and Outbound (Abutment No. 2 Similar)  
 Scale: 3/4" = 1'-0"  
 Abutment No. 2 is South Abutment


### BUTT JOINT NOTES:

1. Provide watertight condition per manufacturer's specifications at each existing panel joint.

### NOTES:

1. The Contractor shall provide traffic control plans to direct public traffic for lane closures throughout the completion of work. See Special Provisions, Section 645, for suggested lane closure timetable.
2. All existing reinforcing bars shall be cleaned of rust, concrete, etc. before new concrete is poured. Cleaning of existing reinforcing bars shall be incidental and shall not be paid for separately.
3. All voids below existing P.C.C. shall be filled with concrete. No vehicles shall pass over until the concrete has been poured above existing bed course material and has gained a strength of  $f_c = 3,000$  p.s.i.. The new concrete shall be poured to the depth as shown in the plan and shall not form "cold joint".
4. Provide shoring as necessary to support and prevent undermining of existing bed course material.
5. No vehicles shall cross over existing joint seal upon removal of existing concrete until it has adequately supported and stabilized.

6. The existing seal's finish grade shall match and maintain the grade of the existing roadway in both longitudinal and transverse directions.
7. See "Special Provisions" for material specifications and construction requirements.
8. Probe and locate existing reinforcing bars and adjust saw-cut depth accordingly.
9. The Contractor shall complete installation of new steel plate in each traffic lane prior to commencing with removal of existing concrete in other traffic lane. Removal of existing concrete in two traffic lanes may be done concurrently only if it can be completed within a scheduled lane-closure time frame.
10. Under cut existing bars one inch (1") into existing concrete, where existing reinforcing bars are cut.
11. Cut existing anchor bolts flush with or below concrete surface. Do not apply heat to cut bolts.
12. The Contractor shall verify in field all dimensions for accuracy, changes in field conditions, etc. prior to commencing with work, and notify the Engineer in advance of any discrepancies or omissions from the contract plans.

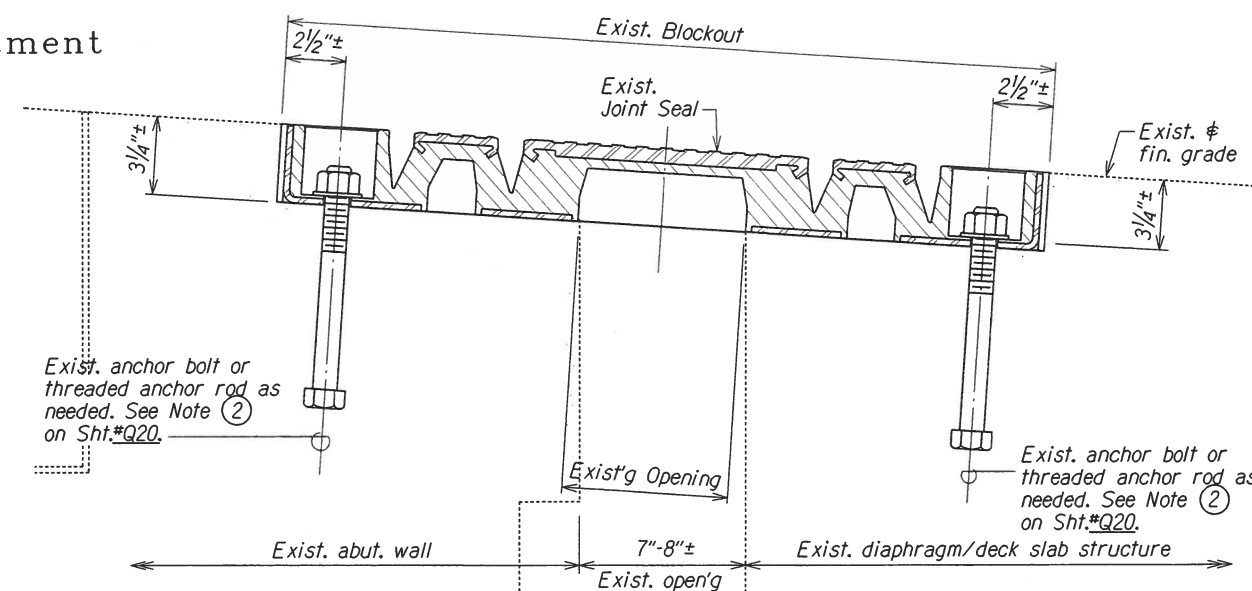

**SECTION**  
 BENEATH CONCRETE PARAPET and MEDIAN BARRIER ONLY  
 Not to Scale

LEGEND FOR AS-BUILT POSTINGS	
	Squiggly line for as-built deletion
	Double line for as-built deletion
Roadway	Text for as-built posting

STATE OF HAWAII

DEPARTMENT OF TRANSPORTATION

HIGHWAYS DIVISION

KIPAPA STREAM BRIDGE

TYPICAL SECTION THRU EXPANSION JOINT

at ABUTMENT NO. 2 (Inbound & Outbound)

INTERSTATE ROUTE H-2 JOINT REPAIR

WAIKAWA INTERCHANGE to WAIKAWA INTERCHANGE

Project No. H2A/G-02-05M


Scale: As Noted

Date: Aug. 2008


SHEET No. Q18B OF 22 SHEETS

23 S-2


FED. ROAD DIST. NO.	STATE	PROJ. NO.	FISCAL YEAR	SHEET NO.	TOTAL SHEETS
HAWAII	HAW.	H2A/G-02-05M	2014	24	30

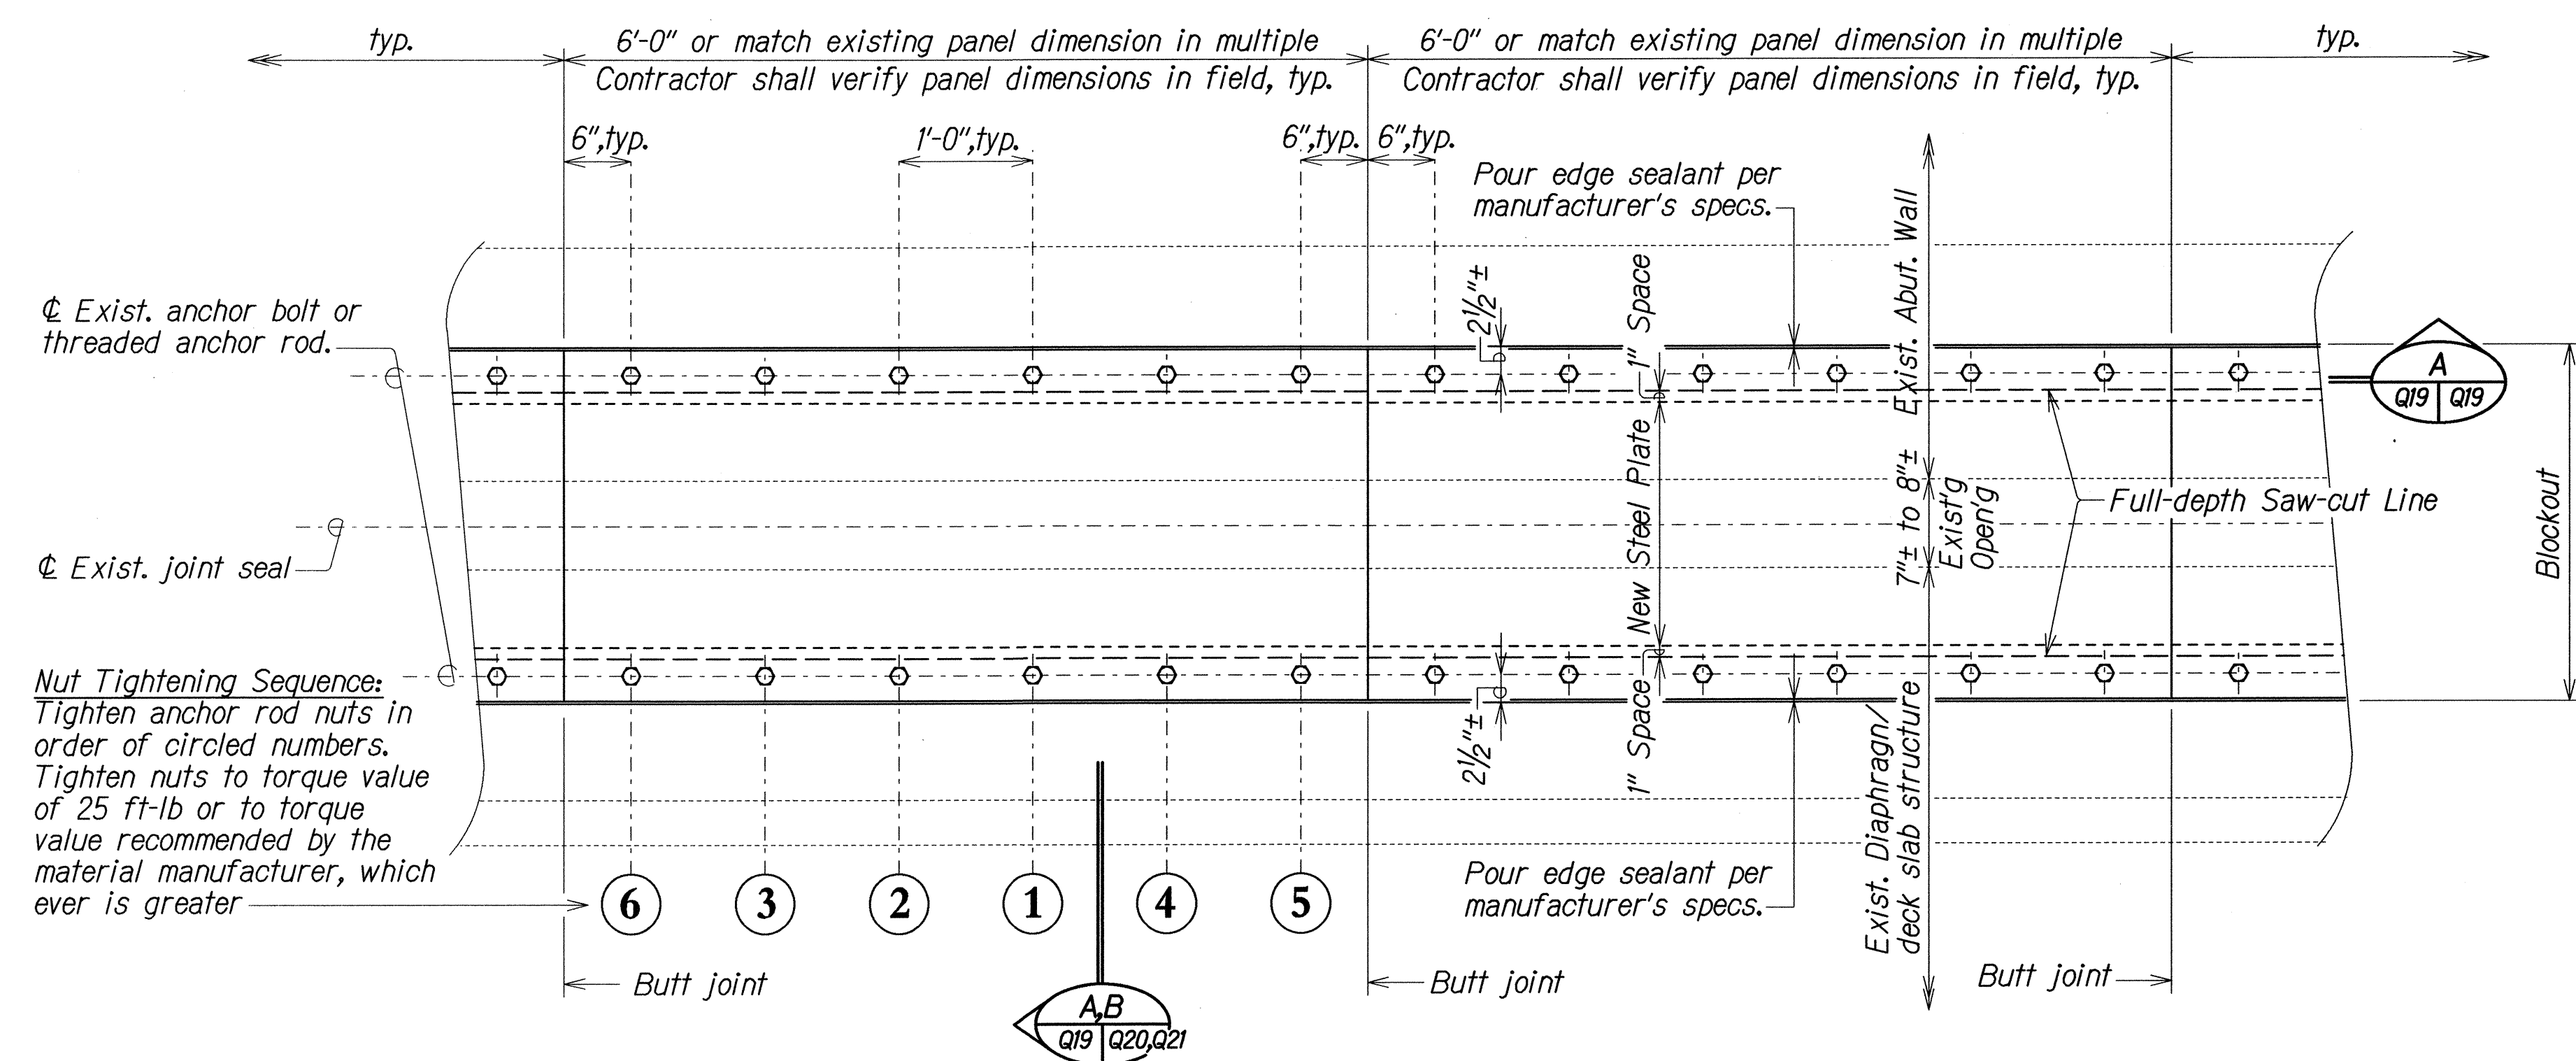

**PARTIAL PLAN**  
**EXISTING JOINT BLOCKOUT 31" to 36" or GREATER THAN 36"**

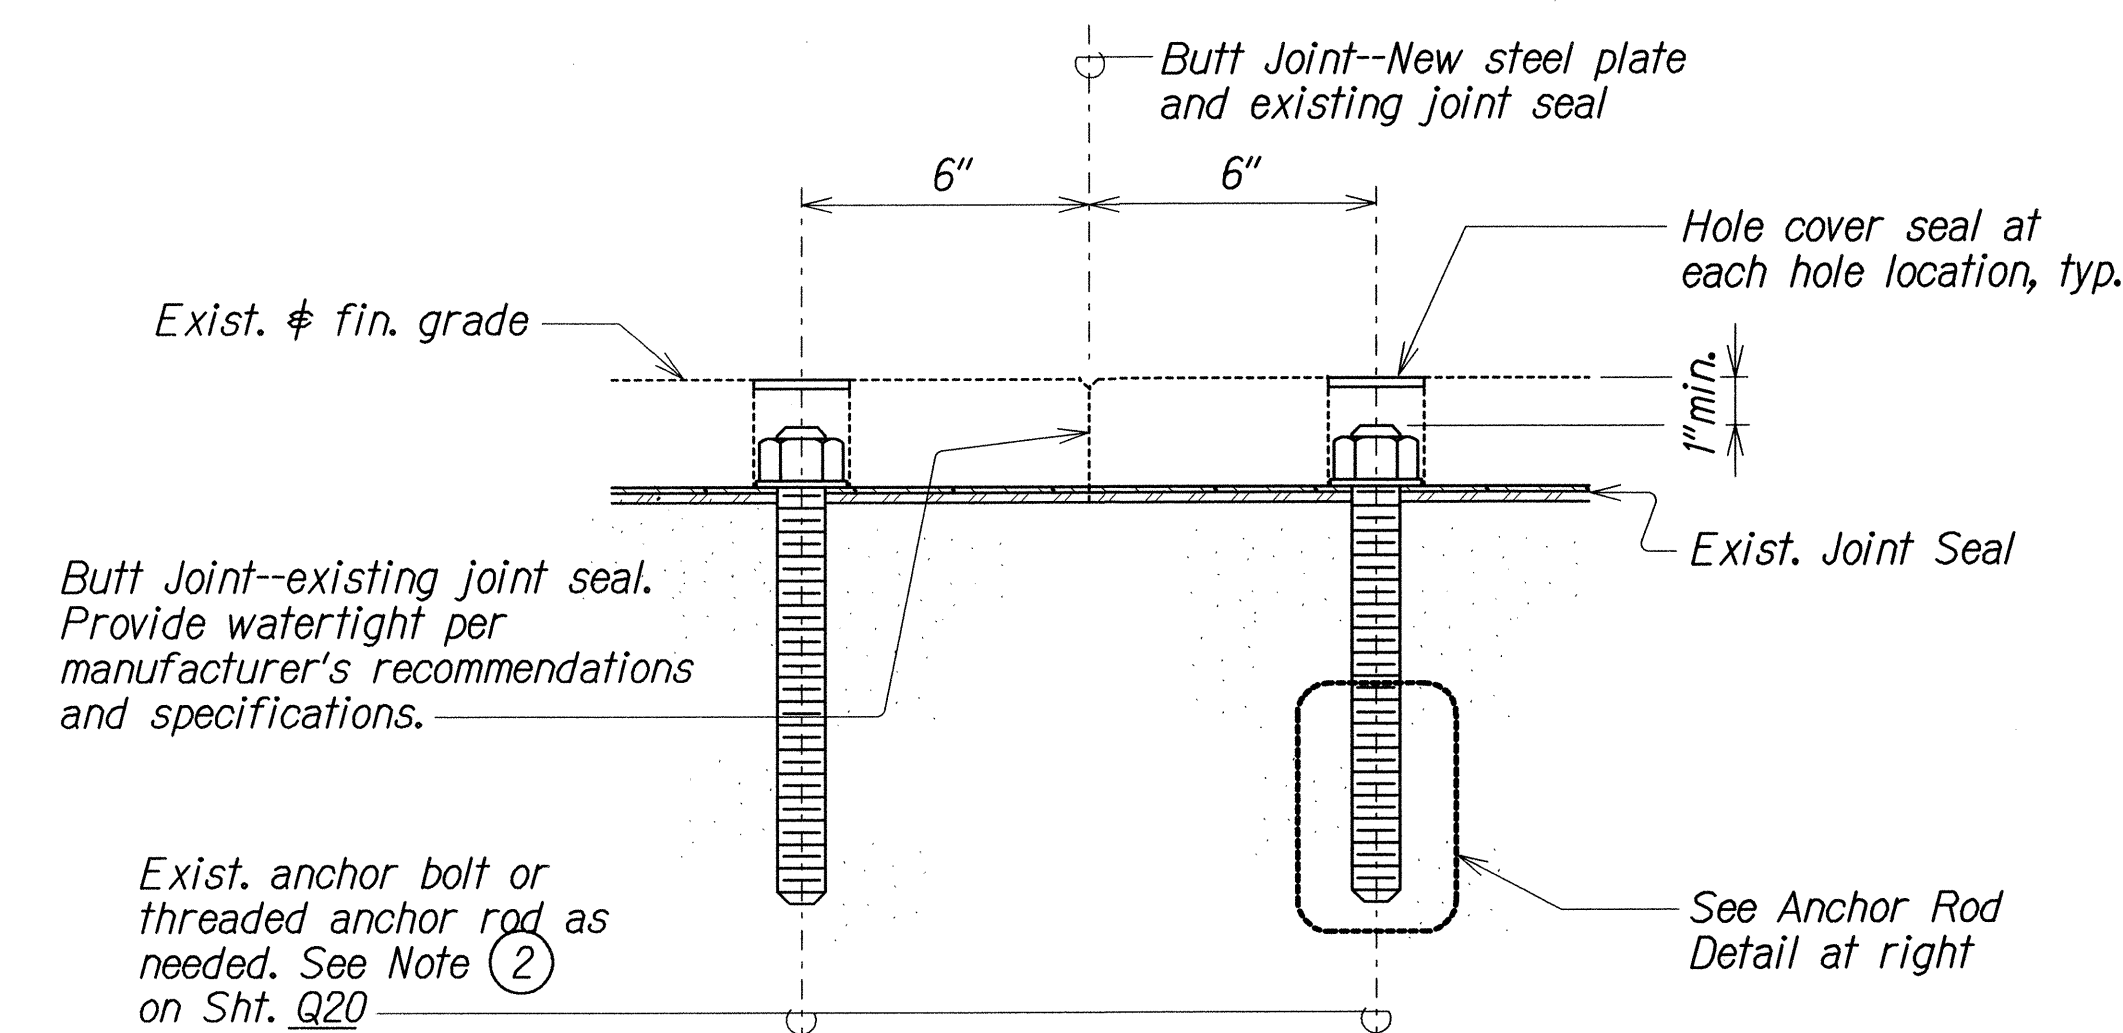

**SECTION**  
 Not to Scale

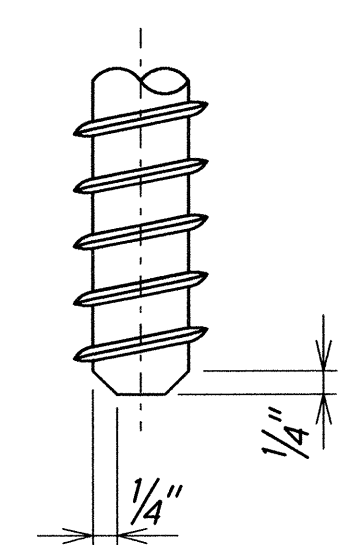

**POST ANCHOR ROD DETAIL**  
 Not to Scale

ORIGINAL PLAN	SURVEY PLOTTED BY	DATE
NOTE BOOK	DRAWN BY	
	CHECKED BY	
	QUANTITIES BY	
	DESIGNED BY	
	NOTED BY	
	REVIEWED BY	
	APPROVED BY	
	DATE	

STATE OF HAWAII  
DEPARTMENT OF TRANSPORTATION  
HIGHWAYS DIVISION


**KIPAPA STREAM BRIDGE**  
**PARTIAL PLANS - EXISTING JOINT BLOCKOUTS**  
**31" to 36" & GREATER THAN 36"**  
**INTERSTATE ROUTE H-2 JOINT REPAIR**  
**WAIKAWA INTERCHANGE to WAIKAWA INTERCHANGE**  
**Project No. H2A/G-02-05M**

Scale: As Noted  
Date: Aug, 2013







FED. ROAD DIST. NO.	STATE	PROJ. NO.	FISCAL YEAR	SHEET NO.	TOTAL SHEETS
HAWAII	HAW.	H2A/G-02-05M	2014	26	30

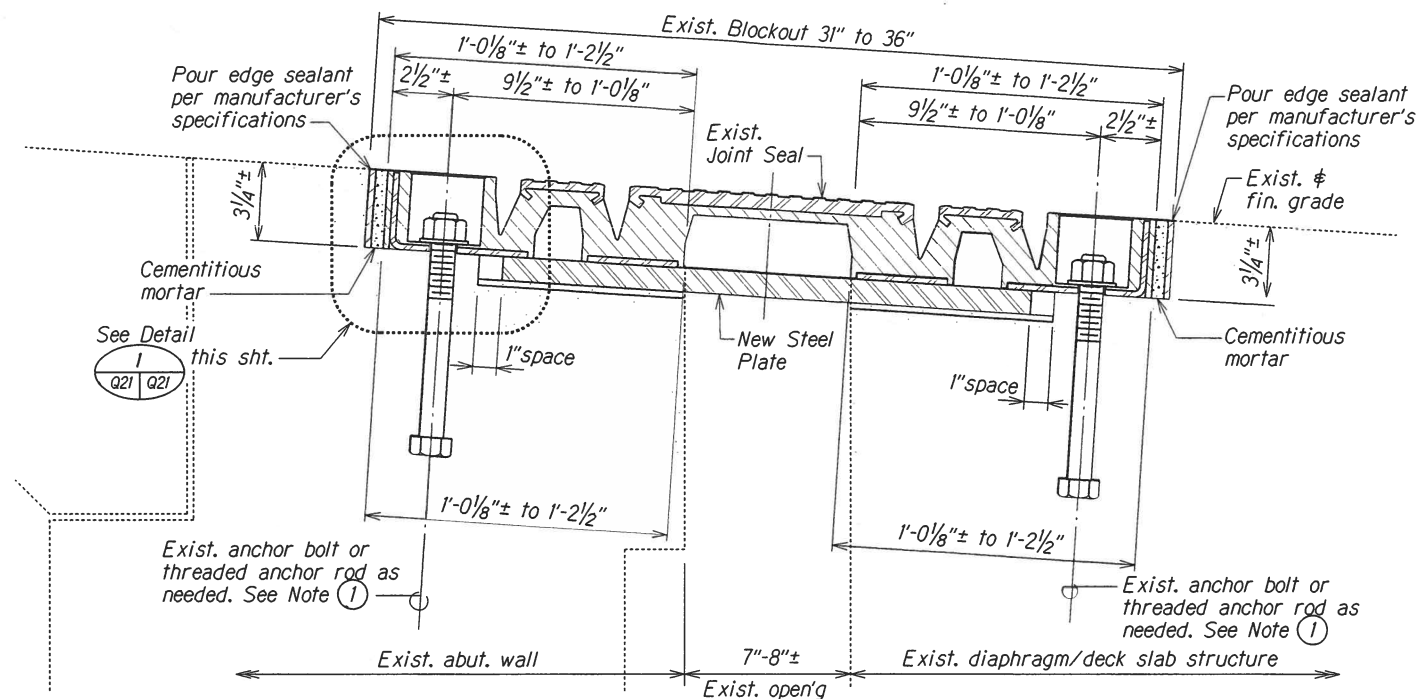

**TYPICAL SECTION**  
**EXISTING JOINT BLOCKOUT 31" to 36"**  
Not to Scale

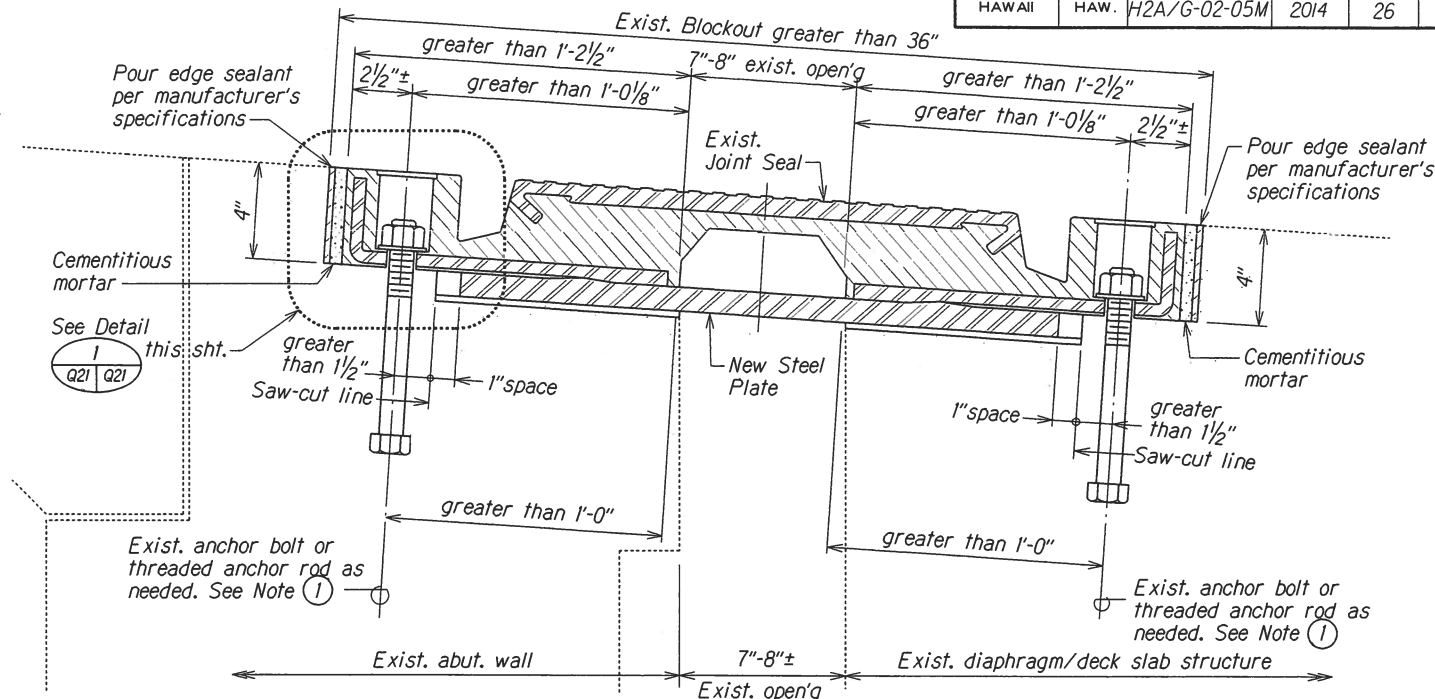


**TYPICAL SECTION**  
**EXISTING JOINT BLOCKOUT GREATER THAN 36"**  
Not to Scale

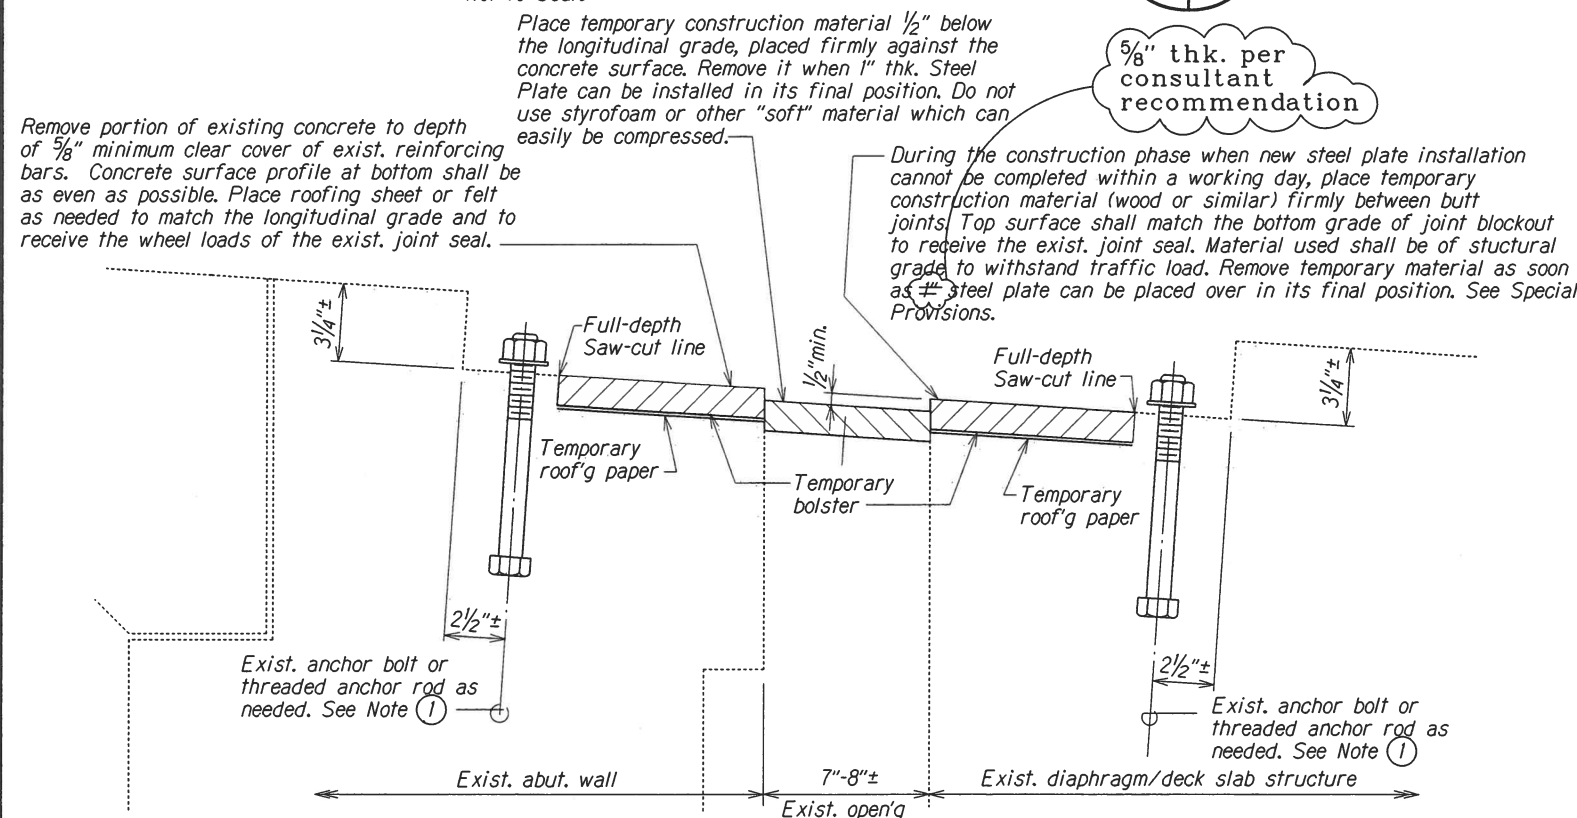

**TYPICAL SECTION**  
**TEMPORARY BOLSTER for EXISTING JOINT SEAL**  
Not to Scale

### NOTES:

1. Threaded adhesive anchor rod, stainless 316L (CW2) steel ASTM F593 w/nut & washer. Drill holes into concrete normal to plane of concrete surface. Drilled hole diameter for adhesive anchor rod shall be that specified by the material manufacturer, e.g. (D + 1/16"). See Special Provisions
2. Replace damaged or worn-out existing anchor bolts with threaded anchor rods. Tighten anchor nuts to manufacturer-recommended torque value.
3. Concrete stratum at bottom of concrete removal must be free of loose concrete and must be roughened. Roughened surface should be prepared in even amplitude and close pattern.
4. Upon completion of removal of portion of concrete and whenever steel plate installation cannot be completed within a working day, place temporary bolster for allowing traffic loads over the existing joint seal. Bolster must be placed to bear traffic loads. Full contact shall be made between bolster and existing joint seal system. Insert roofing felt between bolster and concrete wherever needed. See Special Provisions.
5. Steel plate and leveling material shall be placed as soon as concrete removal is completed. The existing joint seal system shall be securely fastened and shall not leave space between steel plate and existing joint seal. Tightening of anchor nut shall not create any uplift of existing joint seal.
6. Upon completion of steel plate installation in each traffic lane, the Contractor shall test the repaired joint seal for smooth passage, riding comfort and level of wheel impact between existing joint system and steel plate or load-bearing concrete surfaces. The Contractor shall correct any defects to the satisfaction of the Engineer.

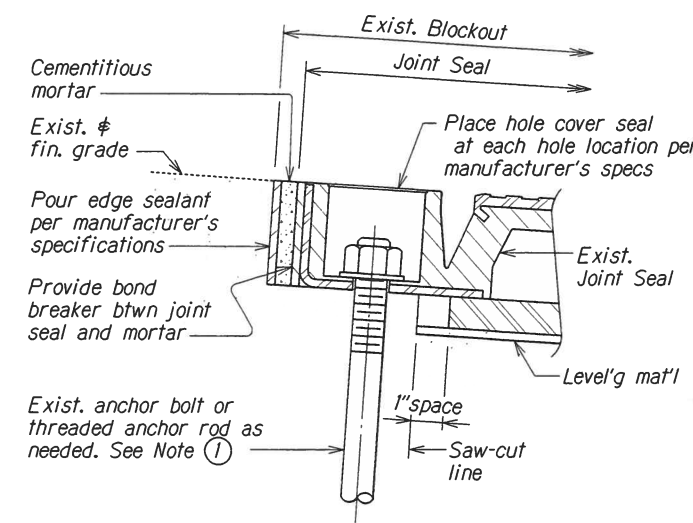

**DETAIL**  
Not to Scale

### LEGEND FOR AS-BUILT POSTINGS

~~~~~	Squiggly line for as-built deletion
==	Double line for as-built deletion
Roadway	Text for as-built posting

STATE OF HAWAII  
DEPARTMENT OF TRANSPORTATION  
HIGHWAYS DIVISION

**KIPAPA STREAM BRIDGE**

**TYPICAL REPAIR DETAILS at EXISTING JOINT BLOCKOUTS, 31" to 36" & GREATER THAN 36"**

**INTERSTATE ROUTE H-2 JOINT REPAIR**

**WAIKAWA INTERCHANGE to WAIKAWA INTERCHANGE**

**Project No. H2A/G-02-05M**

Scale: As Noted Date: Aug, 2013

SHEET No. Q21 OF 22 SHEETS

### TYPICAL REPAIR DETAILS at EXISTING JOINT BLOCKOUTS, 31" to 36" and GREATER THAN 36"

"AS-BUILT"