

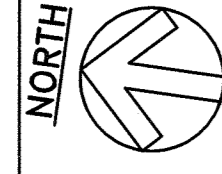


FED. ROAD DIST. NO.	STATE	PROJ. NO.	FISCAL YEAR	SHEET NO.	TOTAL SHEETS
HAWAII	HAW.	HWY-0-03-05MR	2008	13	38

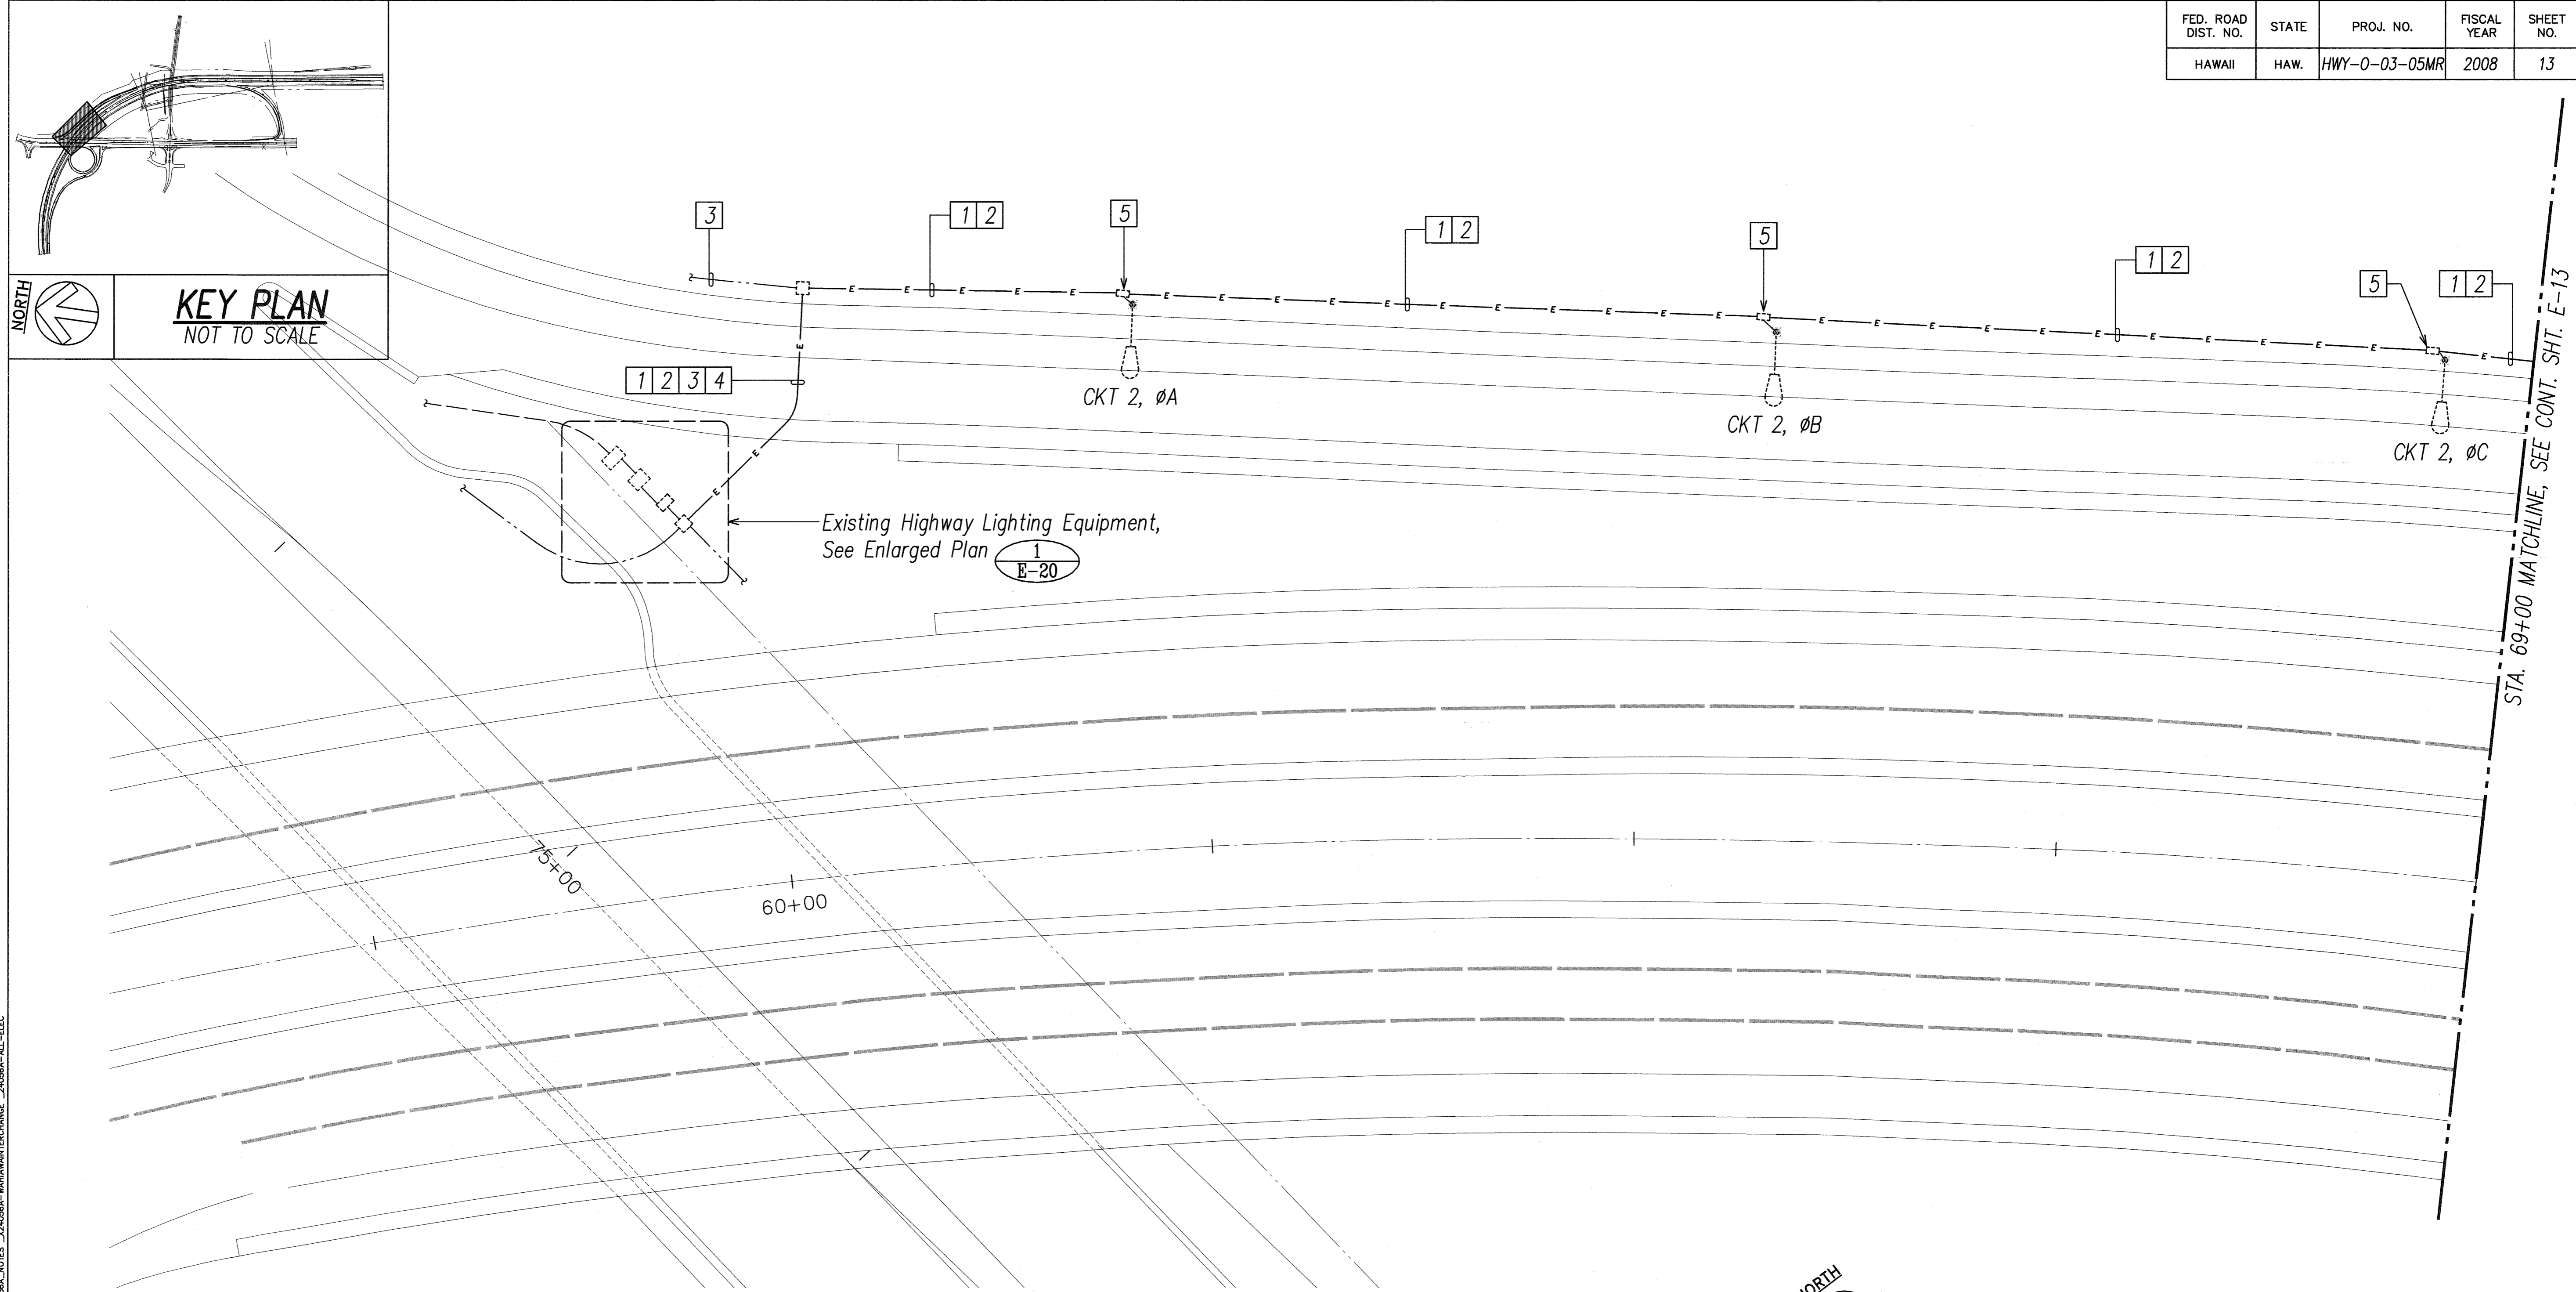

KEY PLAN
NOT TO SCALE

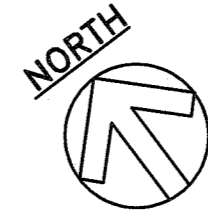

PARTIAL HIGHWAY LIGHTING NEW WORK PLAN I
SCALE: 1"=20'

NEW WORK PLAN NOTES

- 1 New Circuit No. 1: Existing 2" Conduit with New Conductors. See Existing Highway Lighting System Diagrams with Modifications on Sheets E-26 and E-27 for Conductor Sizes.
- 2 New Circuit No. 2: Existing 2" Conduit with New Conductors. See Existing Highway Lighting System Diagrams with Modifications on Sheets E-26 and E-27 for Conductor Sizes.
- 3 Existing Circuit No. 4 to Remain.
- 4 Existing Spare 2" Conduit.
- 5 Existing Highway Light Standard Circuit to be Reconnected to New Circuit in Existing Pullbox.
- 6 Existing Circuit No. 3 to Remain.
- 7 New Junction Box, 18" SQ. x 8"D, NEMA 4X, Type 315 Stainless Steel, with Tamperproof Screws to Secure Junction Box Cover; Mounted to Existing Concrete Barrier per Structural Details. See Structural Sheet S-1.
- 8 New Circuit NO. 1: New 2" Galvanized Rigid Steel Conduit with PVC Coating, to Adjacent Junction Box; Surface Mounted on Existing Concrete Barrier per Structural Details. See Structural Sheet S-1.
- 9 New Circuit NO. 2: New 2" Galvanized Rigid Steel Conduit with PVC Coating, to Adjacent Junction Box; Surface Mounted on Existing Concrete Barrier per Structural Details. See Structural Sheet S-1.
- 10 Provide Galvanized Rigid Steel Conduit to Liquidtite Flexible Metal Conduit Transition Across Existing Bridge Expansion Joint as Required to Allow for Movement of Bridge Structure Without Damaging Conduit Installation.
- 11 Existing Highway Sign Light Circuit to Remain and be Reconnected to New Lighting Circuit, to Maintain Existing Circuit Continuity.

ORIGINAL PLAN	DATE
DESIGNED BY	
TRACED BY	
NOTED BY	
QUANTITIES BY	
CHECKED BY	
NO.	



LAST SAVE: 06/03/07 @ 06:56:30 BY: AM PL01 SC 1=20
 Z:\ADDP\PROJECTS\040566\012_240566_NEW HWY PLAN_1.DWG: XHP-REV _240566A_KEYPLAN _240566A_MATCHLINE_CHANGE _240566A-ALL-ELEC

RONALD N. S. HO & ASSOCIATES, INC.
 Electrical Engineers

 Andrew I. Miyasato
 05.22.08
 THIS WORK WAS PREPARED BY ME OR UNDER MY SUPERVISION
 04.30.2008
 EXPIRATION DATE OF THE LICENSE

STATE OF HAWAII
 DEPARTMENT OF TRANSPORTATION
 HIGHWAYS DIVISION
PARTIAL HIGHWAY LIGHTING
NEW WORK PLAN I
 H-2 RAIL LIGHT REPLACEMENT,
 VICINITY OF WAHIAWA OFF RAMP
 Project No. HWY-0-03-05MR
 Scale: AS NOTED Date: MAY 2008
 SHEET No. E-12 OF 35 SHEETS

FED. ROAD DIST. NO.	STATE	PROJ. NO.	FISCAL YEAR	SHEET NO.	TOTAL SHEETS
HAWAII	HAW.	HWY-0-03-05MR	2008	14	38

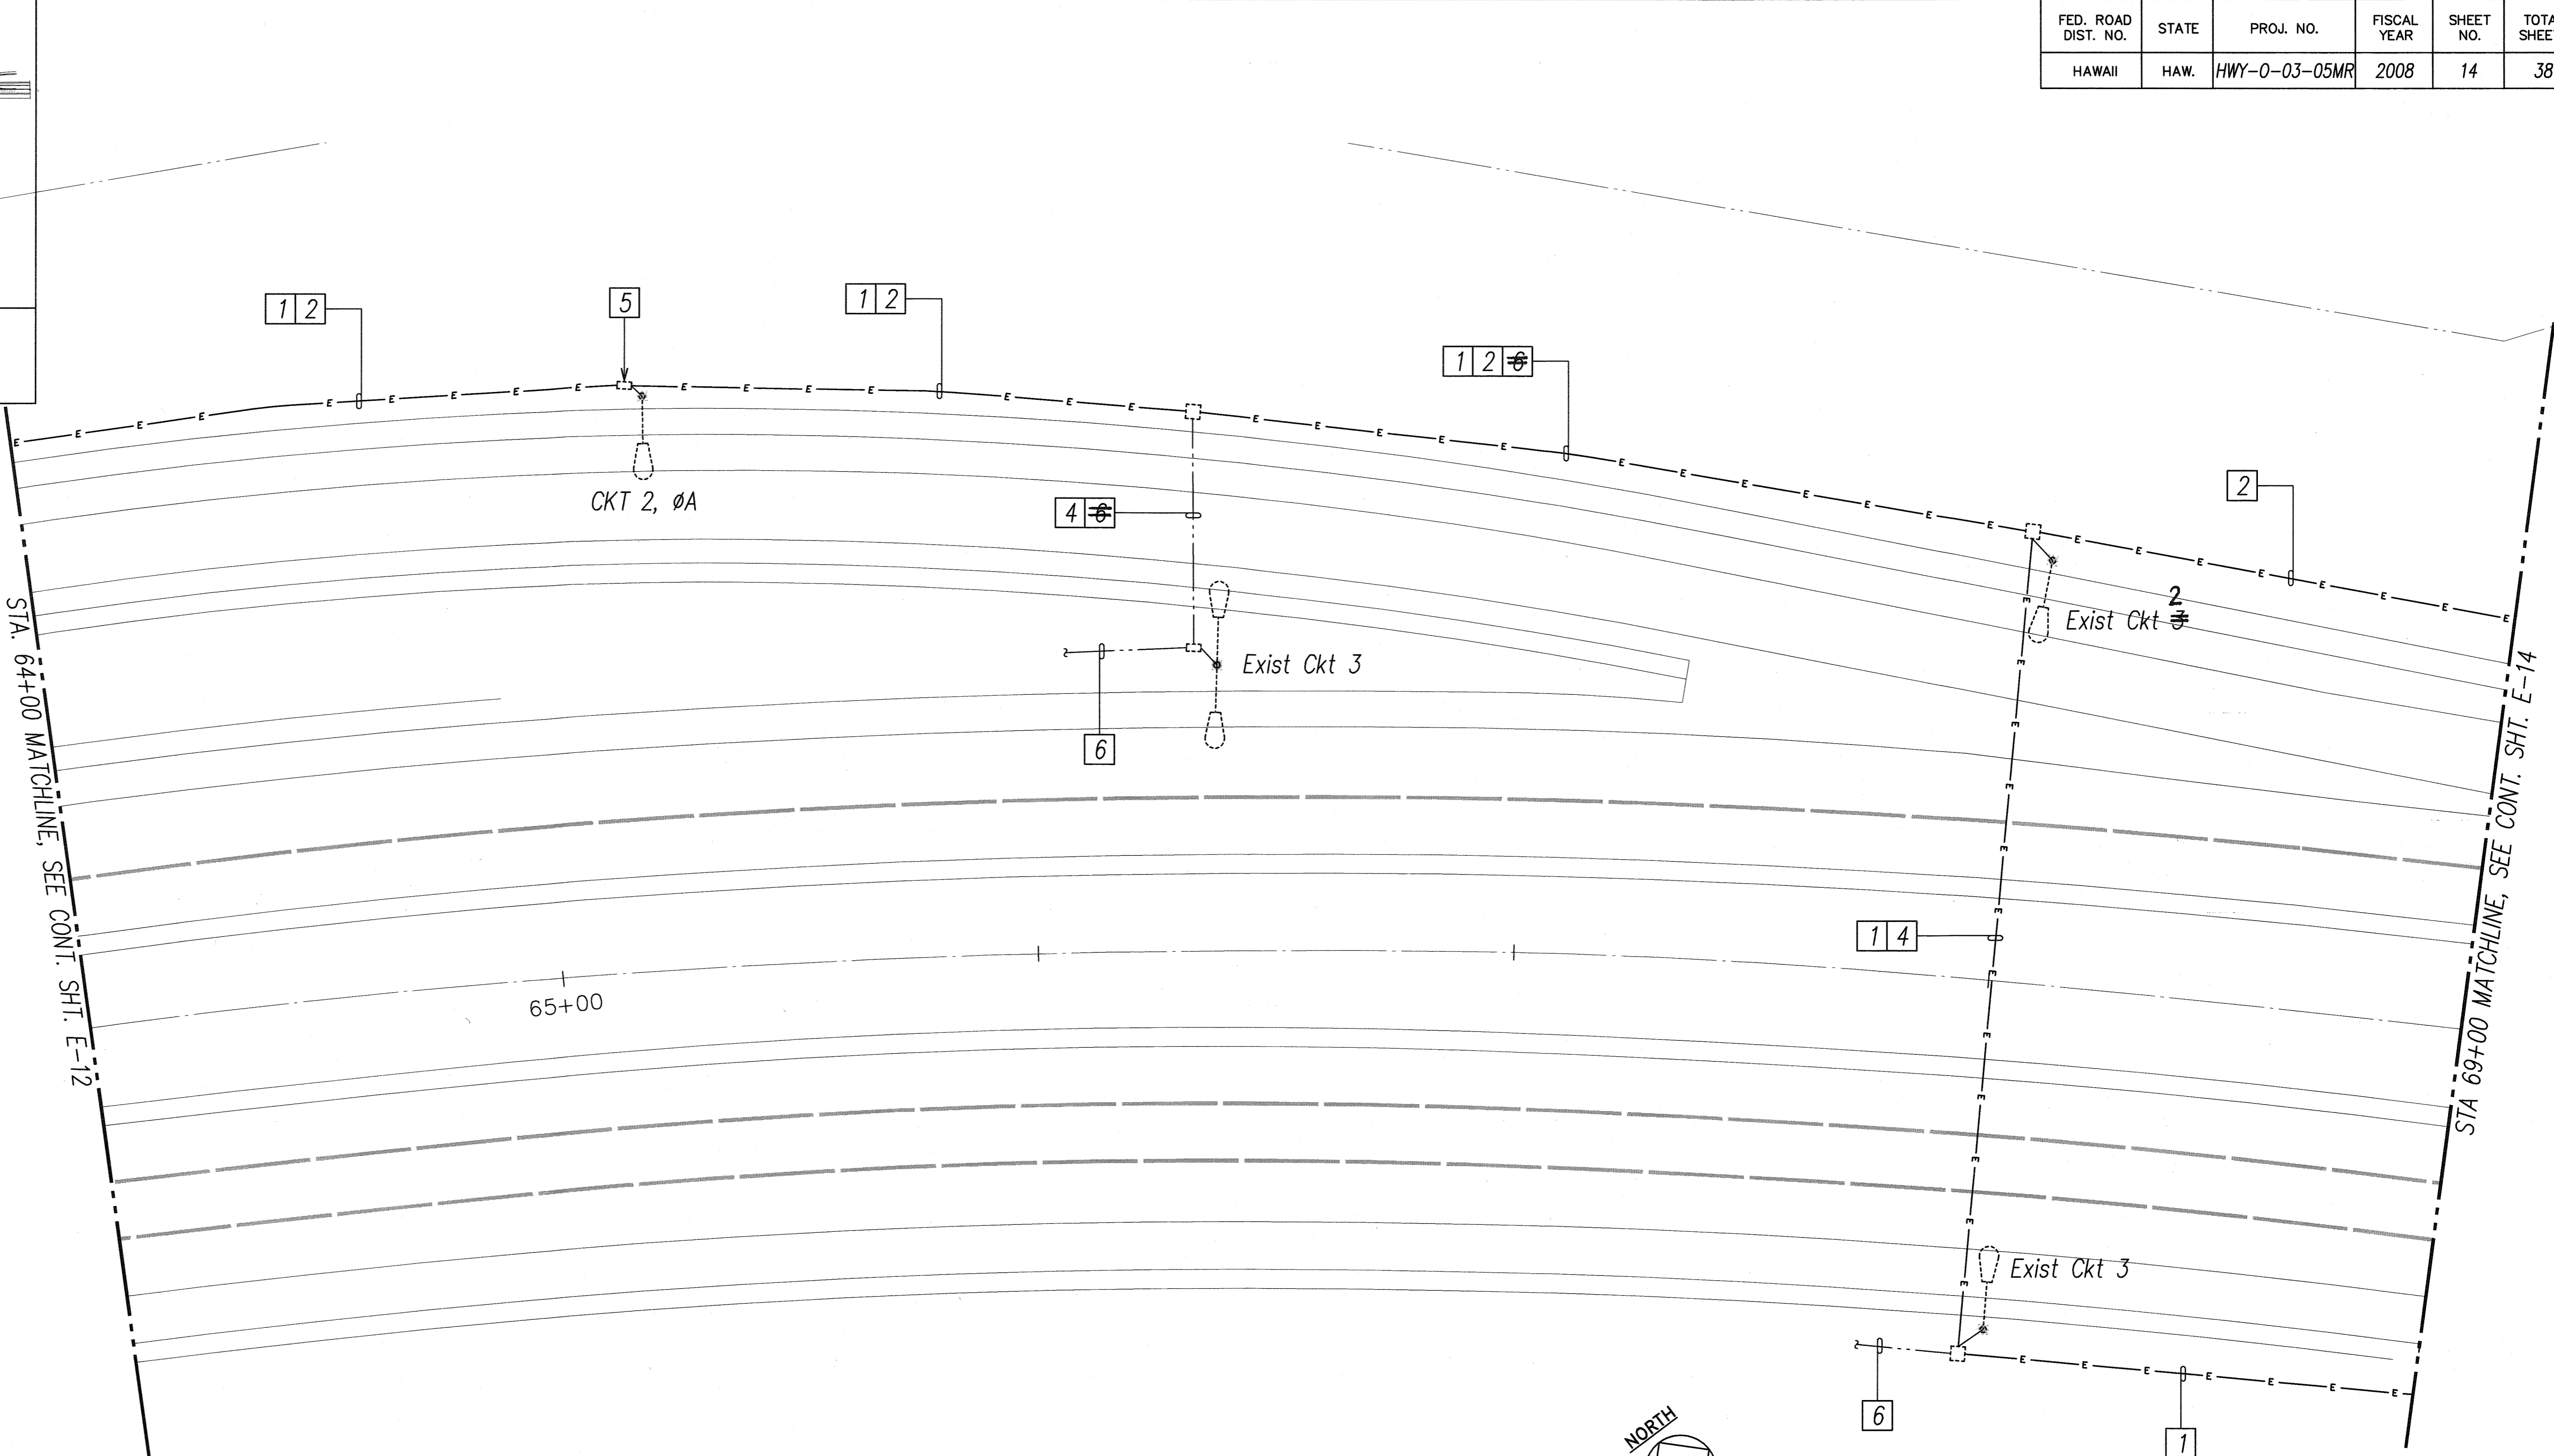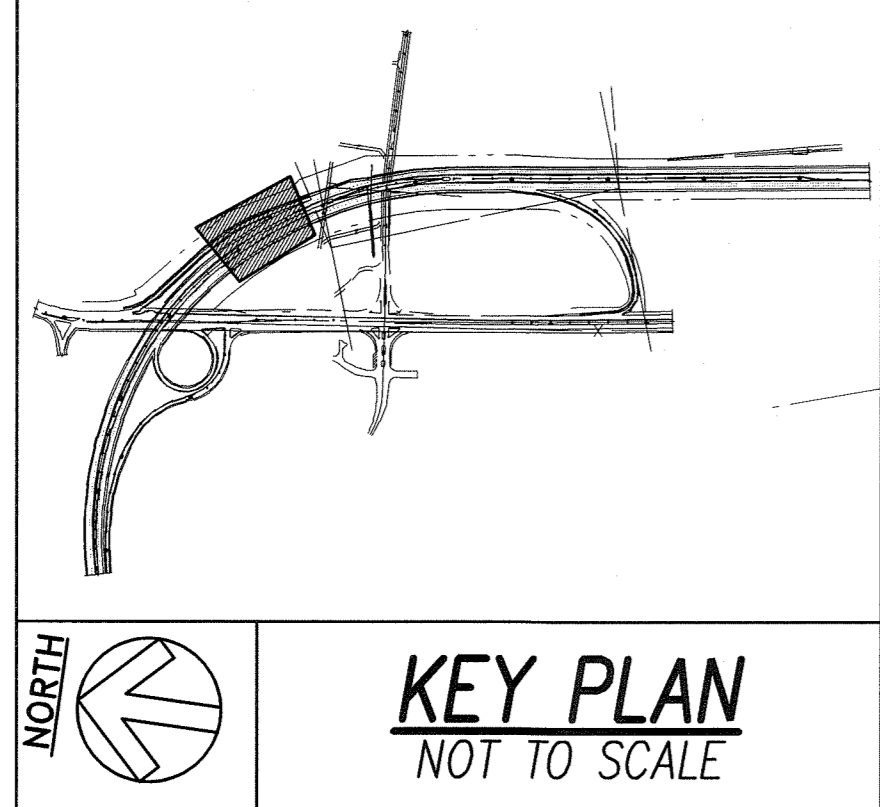

NEW WORK PLAN NOTES

- 1 New Circuit No. 1: Existing 2" Conduit with New Conductors. See Existing Highway Lighting System Diagrams with Modifications on Sheets E-26 and E-27 for Conductor Sizes.
- 2 New Circuit No. 2: Existing 2" Conduit with New Conductors. See Existing Highway Lighting System Diagrams with Modifications on Sheets E-26 and E-27 for Conductor Sizes.
- 3 Existing Circuit No. 4 to Remain.
- 4 Existing Spare 2" Conduit.
- 5 Existing Highway Light Standard Circuit to be Reconnected to New Circuit in Existing Pullbox.

- 6 Existing Circuit No. 3 to Remain.
- 7 New Junction Box, 18" SQ. x 8"D, NEMA 4X, Type 315 Stainless Steel, with Tamperproof Screws to Secure Junction Box Cover; Mounted to Existing Concrete Barrier per Structural Details. See Structural Sheet S-1.
- 8 New Circuit NO. 1: New 2" Galvanized Rigid Steel Conduit with PVC Coating, to Adjacent Junction Box; Surface Mounted on Existing Concrete Barrier per Structural Details. See Structural Sheet S-1.

- 9 New Circuit NO. 2: New 2" Galvanized Rigid Steel Conduit with PVC Coating, to Adjacent Junction Box; Surface Mounted on Existing Concrete Barrier per Structural Details. See Structural Sheet S-1.
- 10 Provide Galvanized Rigid Steel Conduit to Liquidtite Flexible Metal Conduit Transition Across Existing Bridge Expansion Joint as Required to Allow for Movement of Bridge Structure Without Damaging Conduit Installation.
- 11 Existing Highway Sign Light Circuit to Remain and be Reconnected to New Lighting Circuit, to Maintain Existing Circuit Continuity.

PARTIAL HIGHWAY LIGHTING NEW WORK PLAN II
SCALE: 1"=20'

SURVEY PLOTTED BY	DATE
DRAWN BY	
TRACED BY	
DESIGNED BY	
QUANTITIES BY	
CHECKED BY	
No.	



LAST SAVE: 06/03/07 @ 08:56:53 BY: AM PL07 SC: 1:20
 Z:\CAD\PROJECTS\24056A\03_24056A_03_24056A_NEW Hwy plan II.dwg
 XREFS: X12-REV_24056A_UC1PLAN_24056A_NOTES_24056A-WAHIAWAINTERCHANGE_24056A-ALL-EGC

RONALD N. S. HO & ASSOCIATES, INC.
Electrical Engineers
ANDREW L. AMAYSTO
LICENSED PROFESSIONAL ENGINEER
No. 4340-E
HAWAII, U.S.A.
05/2008
THIS WORK WAS PREPARED BY ME OR UNDER MY SUPERVISION
04.30.2008
EXPIRATION DATE OF THE LICENSE

STATE OF HAWAII
DEPARTMENT OF TRANSPORTATION
HIGHWAYS DIVISION
PARTIAL HIGHWAY LIGHTING
NEW WORK PLAN II
H-2 RAIL LIGHT REPLACEMENT,
VICINITY OF WAHIAWA OFF RAMP
Project No. HWY-0-03-05MR
Scale: AS NOTED Date: MAY 2008
SHEET No. E-13 OF 35 SHEETS

"AS-BUILT"

FED. ROAD DIST. NO.	STATE	PROJ. NO.	FISCAL YEAR	SHEET NO.	TOTAL SHEETS
HAWAII	HAW.	HWY-0-03-05MR	2008	17	38

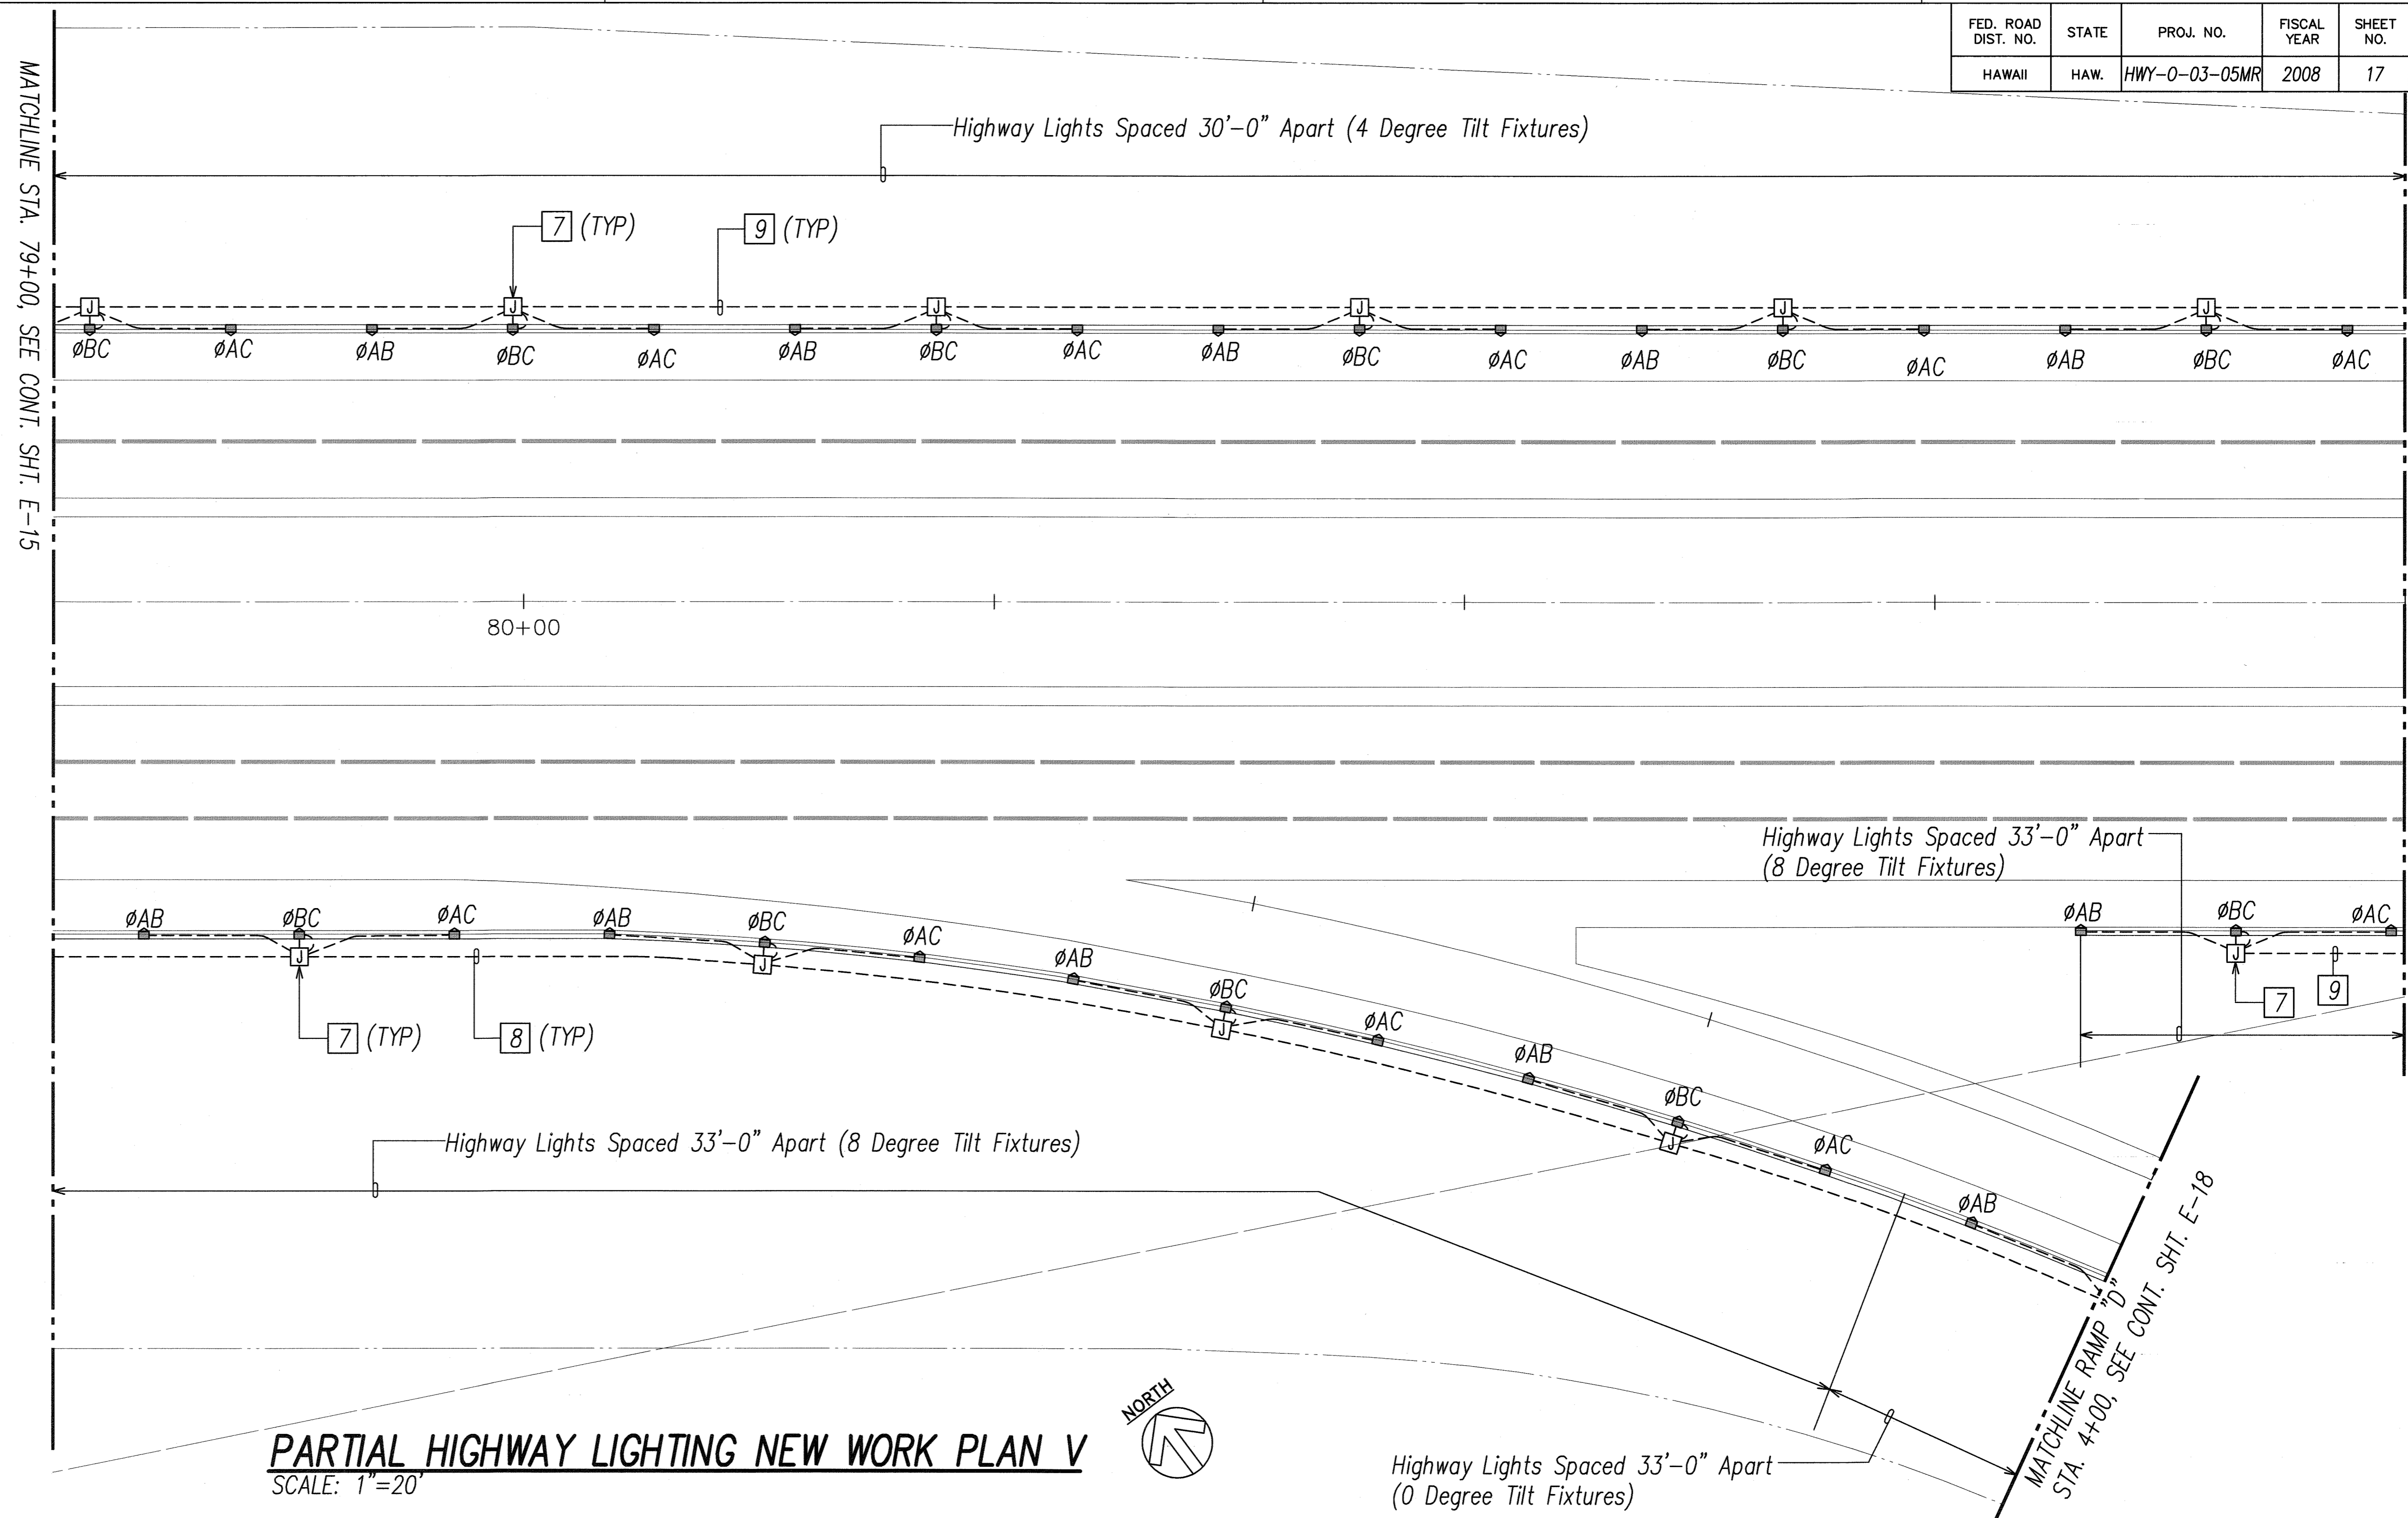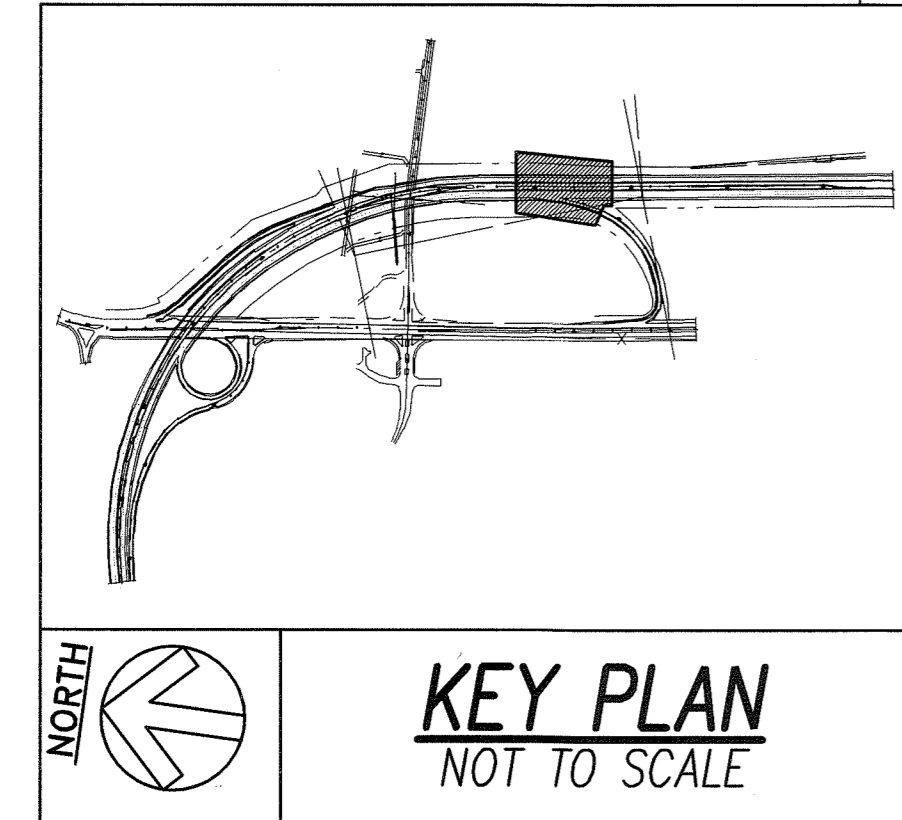

NEW WORK PLAN NOTES

- 1 New Circuit No. 1: Existing 2" Conduit with New Conductors. See Existing Highway Lighting System Diagrams with Modifications on Sheets E-26 and E-27 for Conductor Sizes.
- 2 New Circuit No. 2: Existing 2" Conduit with New Conductors. See Existing Highway Lighting System Diagrams with Modifications on Sheets E-26 and E-27 for Conductor Sizes.
- 3 Existing Circuit No. 4 to Remain.
- 4 Existing Spare 2" Conduit.
- 5 Existing Highway Light Standard Circuit to be Reconnected to New Circuit in Existing Pullbox.
- 6 Existing Circuit No. 3 to Remain.
- 7 New Junction Box, 18" SQ. x 8"D, NEMA 4X, Type 315 Stainless Steel, with Tamperproof Screws to Secure Junction Box Cover; Mounted to Existing Concrete Barrier per Structural Details. See Structural Sheet S-1.
- 8 New Circuit NO. 1: New 2" Galvanized Rigid Steel Conduit with PVC Coating, to Adjacent Junction Box; Surface Mounted on Existing Concrete Barrier per Structural Details. See Structural Sheet S-1.
- 9 New Circuit NO. 2: New 2" Galvanized Rigid Steel Conduit with PVC Coating, to Adjacent Junction Box; Surface Mounted on Existing Concrete Barrier per Structural Details. See Structural Sheet S-1.
- 10 Provide Galvanized Rigid Conduit to Liquidtite Flexible Metal Conduit Transition Across Existing Bridge Expansion Joint as Required to Allow for Movement of Bridge Structure Without Damaging Conduit Installation.
- 11 Existing Highway Sign Light Circuit to Remain and be Reconnected to New Lighting Circuit, to Maintain Existing Circuit Continuity.

DATE	_____
SURVEY PLOTTED BY	_____
PLAN DRAWN BY	_____
TRACED BY	_____
DESIGNED BY	_____
QUANTITIES BY	_____
CHECKED BY	_____
No.	_____



LAST SAVE: 05/03/07 @ 05:56:57 BY: AM PLT SC 1=20
 Z:\CAD\PROJECTS\24056A\016_24056A_new Hwy plan V.XREFS: X12-REV_24056A_KCPLAN_24056A_NOTES_24056A-WAHIAWAINTERCHANGE_24056A-ALL-ELEC

RONALD N. S. HO & ASSOCIATES, INC.
 Electrical Engineers

 Andrew I. Miyasato
 05-22-08
 THIS WORK WAS PREPARED BY ME OR UNDER MY SUPERVISION
 04.30.2008
 EXPIRATION DATE OF THE LICENSE

STATE OF HAWAII
 DEPARTMENT OF TRANSPORTATION
 HIGHWAYS DIVISION
PARTIAL HIGHWAY LIGHTING
NEW WORK PLAN V
 H-2 RAIL LIGHT REPLACEMENT,
 VICINITY OF WAHIAWA OFF RAMP
 Project No. HWY-0-03-05MR
 Scale: AS NOTED Date: MAY 2008
 SHEET No. E-16 OF 35 SHEETS

FED. ROAD DIST. NO.	STATE	PROJ. NO.	FISCAL YEAR	SHEET NO.	TOTAL SHEETS
HAWAII	HAW.	HWY-0-03-05MR	2008	18	38

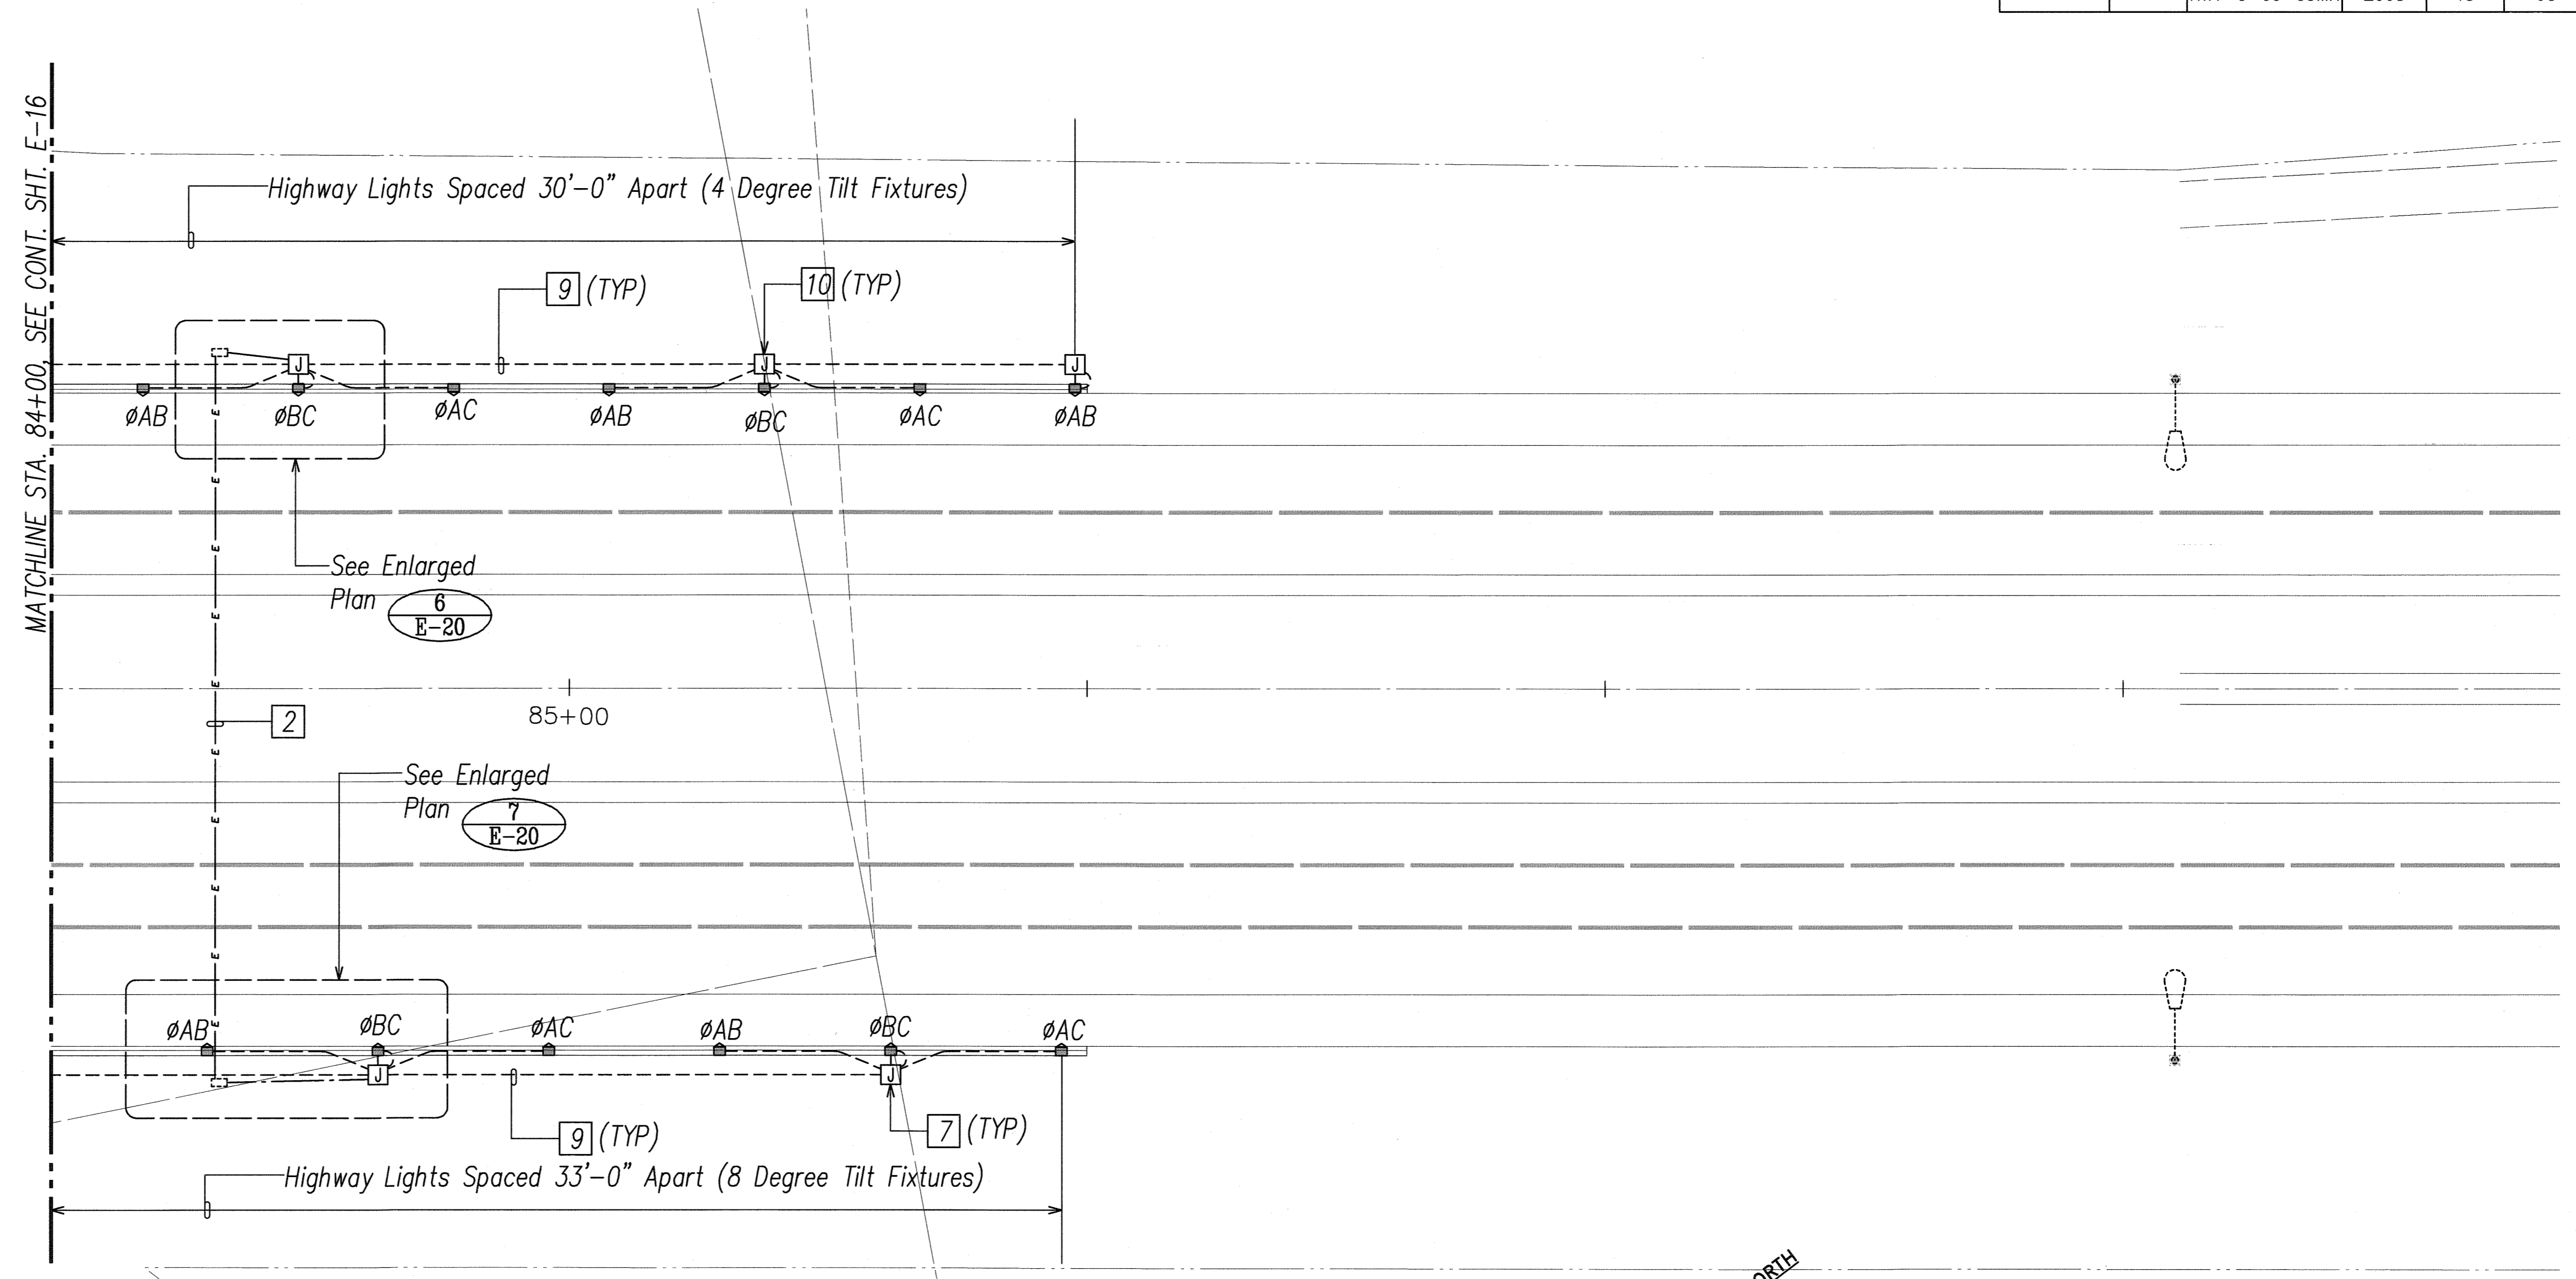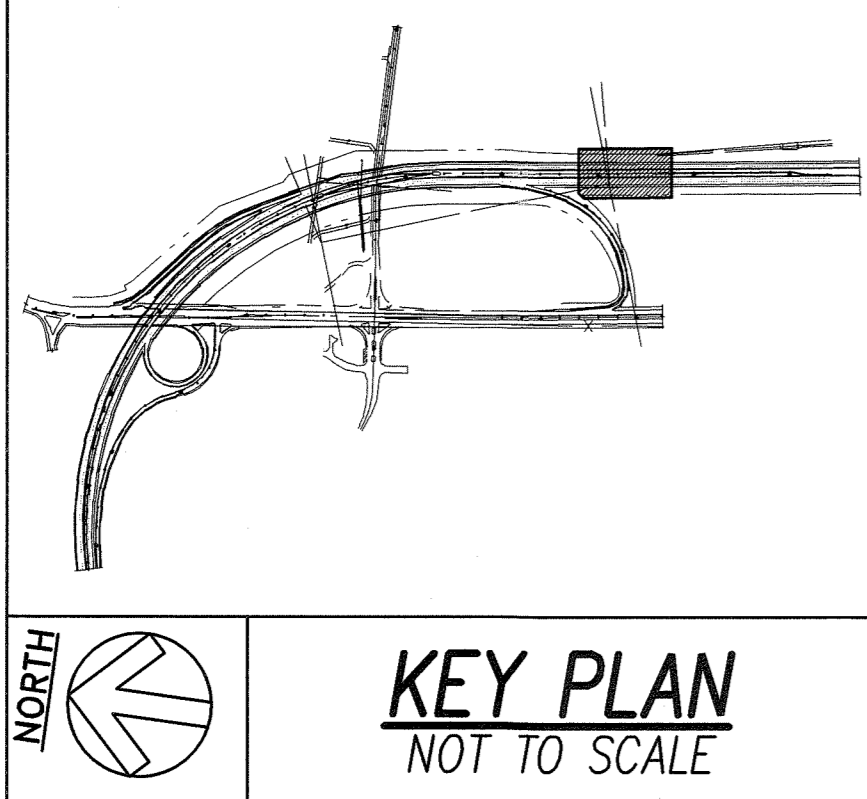


PARTIAL HIGHWAY LIGHTING NEW WORK PLAN VI
SCALE: 1"=20'

NEW WORK PLAN NOTES

- | | |
|--|--|
| <p>1 New Circuit No. 1: Existing 2" Conduit with New Conductors. See Existing Highway Lighting System Diagrams with Modifications on Sheets E-26 and E-27 for Conductor Sizes.</p> <p>2 New Circuit No. 2: Existing 2" Conduit with New Conductors. See Existing Highway Lighting System Diagrams with Modifications on Sheets E-26 and E-27 for Conductor Sizes.</p> <p>3 Existing Circuit No. 4 to Remain.</p> <p>4 Existing Spare 2" Conduit.</p> <p>5 Existing Highway Light Standard Circuit to be Reconnected to New Circuit in Existing Pullbox.</p> <p>6 Existing Circuit No. 3 to Remain.</p> <p>7 New Junction Box, 18" SQ. x 8"D, NEMA 4X, Type 315 Stainless Steel, with Tamperproof Screws to Secure Junction Box Cover; Mounted to Existing Concrete Barrier per Structural Details. See Structural Sheet S-1.</p> | <p>8 New Circuit NO. 1: New 2" Galvanized Rigid Steel Conduit with PVC Coating, to Adjacent Junction Box; Surface Mounted on Existing Concrete Barrier per Structural Details. See Structural Sheet S-1.</p> <p>9 New Circuit NO. 2: New 2" Galvanized Rigid Steel Conduit with PVC Coating, to Adjacent Junction Box; Surface Mounted on Existing Concrete Barrier per Structural Details. See Structural Sheet S-1.</p> <p>10 Provide Galvanized Rigid Steel Conduit to Liquidtight Flexible Metal Conduit Transition Across Existing Bridge Expansion Joint as Required to Allow for Movement of Bridge Structure Without Damaging Conduit Installation.</p> <p>11 Existing Highway Sign Light Circuit to Remain and be Reconnected to New Lighting Circuit, to Maintain Existing Circuit Continuity.</p> |
|--|--|

ORIGINAL PLAN	DATE
TRACED BY	
DESIGNED BY	
QUANTITIES BY	
CHECKED BY	
NO.	

LAST SAVE: 05/03/07 @ 08:52:26 BY: AM PL07 SC 1=20
 Z:\CAD\PROJECTS\24056A\07_24056A.dwg V.1 XREFS: X12-REV_24056A.JECP.LIN_24056A_NOTES_24056A-WAHIAWAINTERCHANGE_24056A-ALL-ELEC

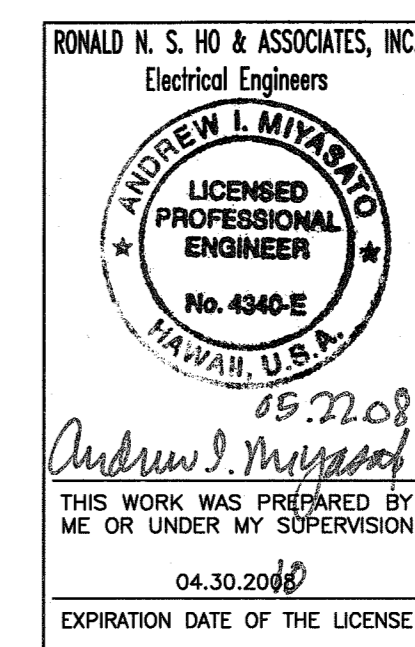

STATE OF HAWAII
DEPARTMENT OF TRANSPORTATION
HIGHWAYS DIVISION

**PARTIAL HIGHWAY LIGHTING
NEW WORK PLAN VI**

H-2 RAIL LIGHT REPLACEMENT,
VICINITY OF WAHIAWA OFF RAMP

Project No. HWY-0-03-05MR
Scale: AS NOTED Date: MAY 2008

SHEET No. E-17 OF 35 SHEETS

