


FED. ROAD DIST. NO.	STATE	PROJ. NO.	FISCAL YEAR	SHEET NO.	TOTAL SHEETS
HAWAII	HAW.	HWY-0-03-10M	2011	31	59

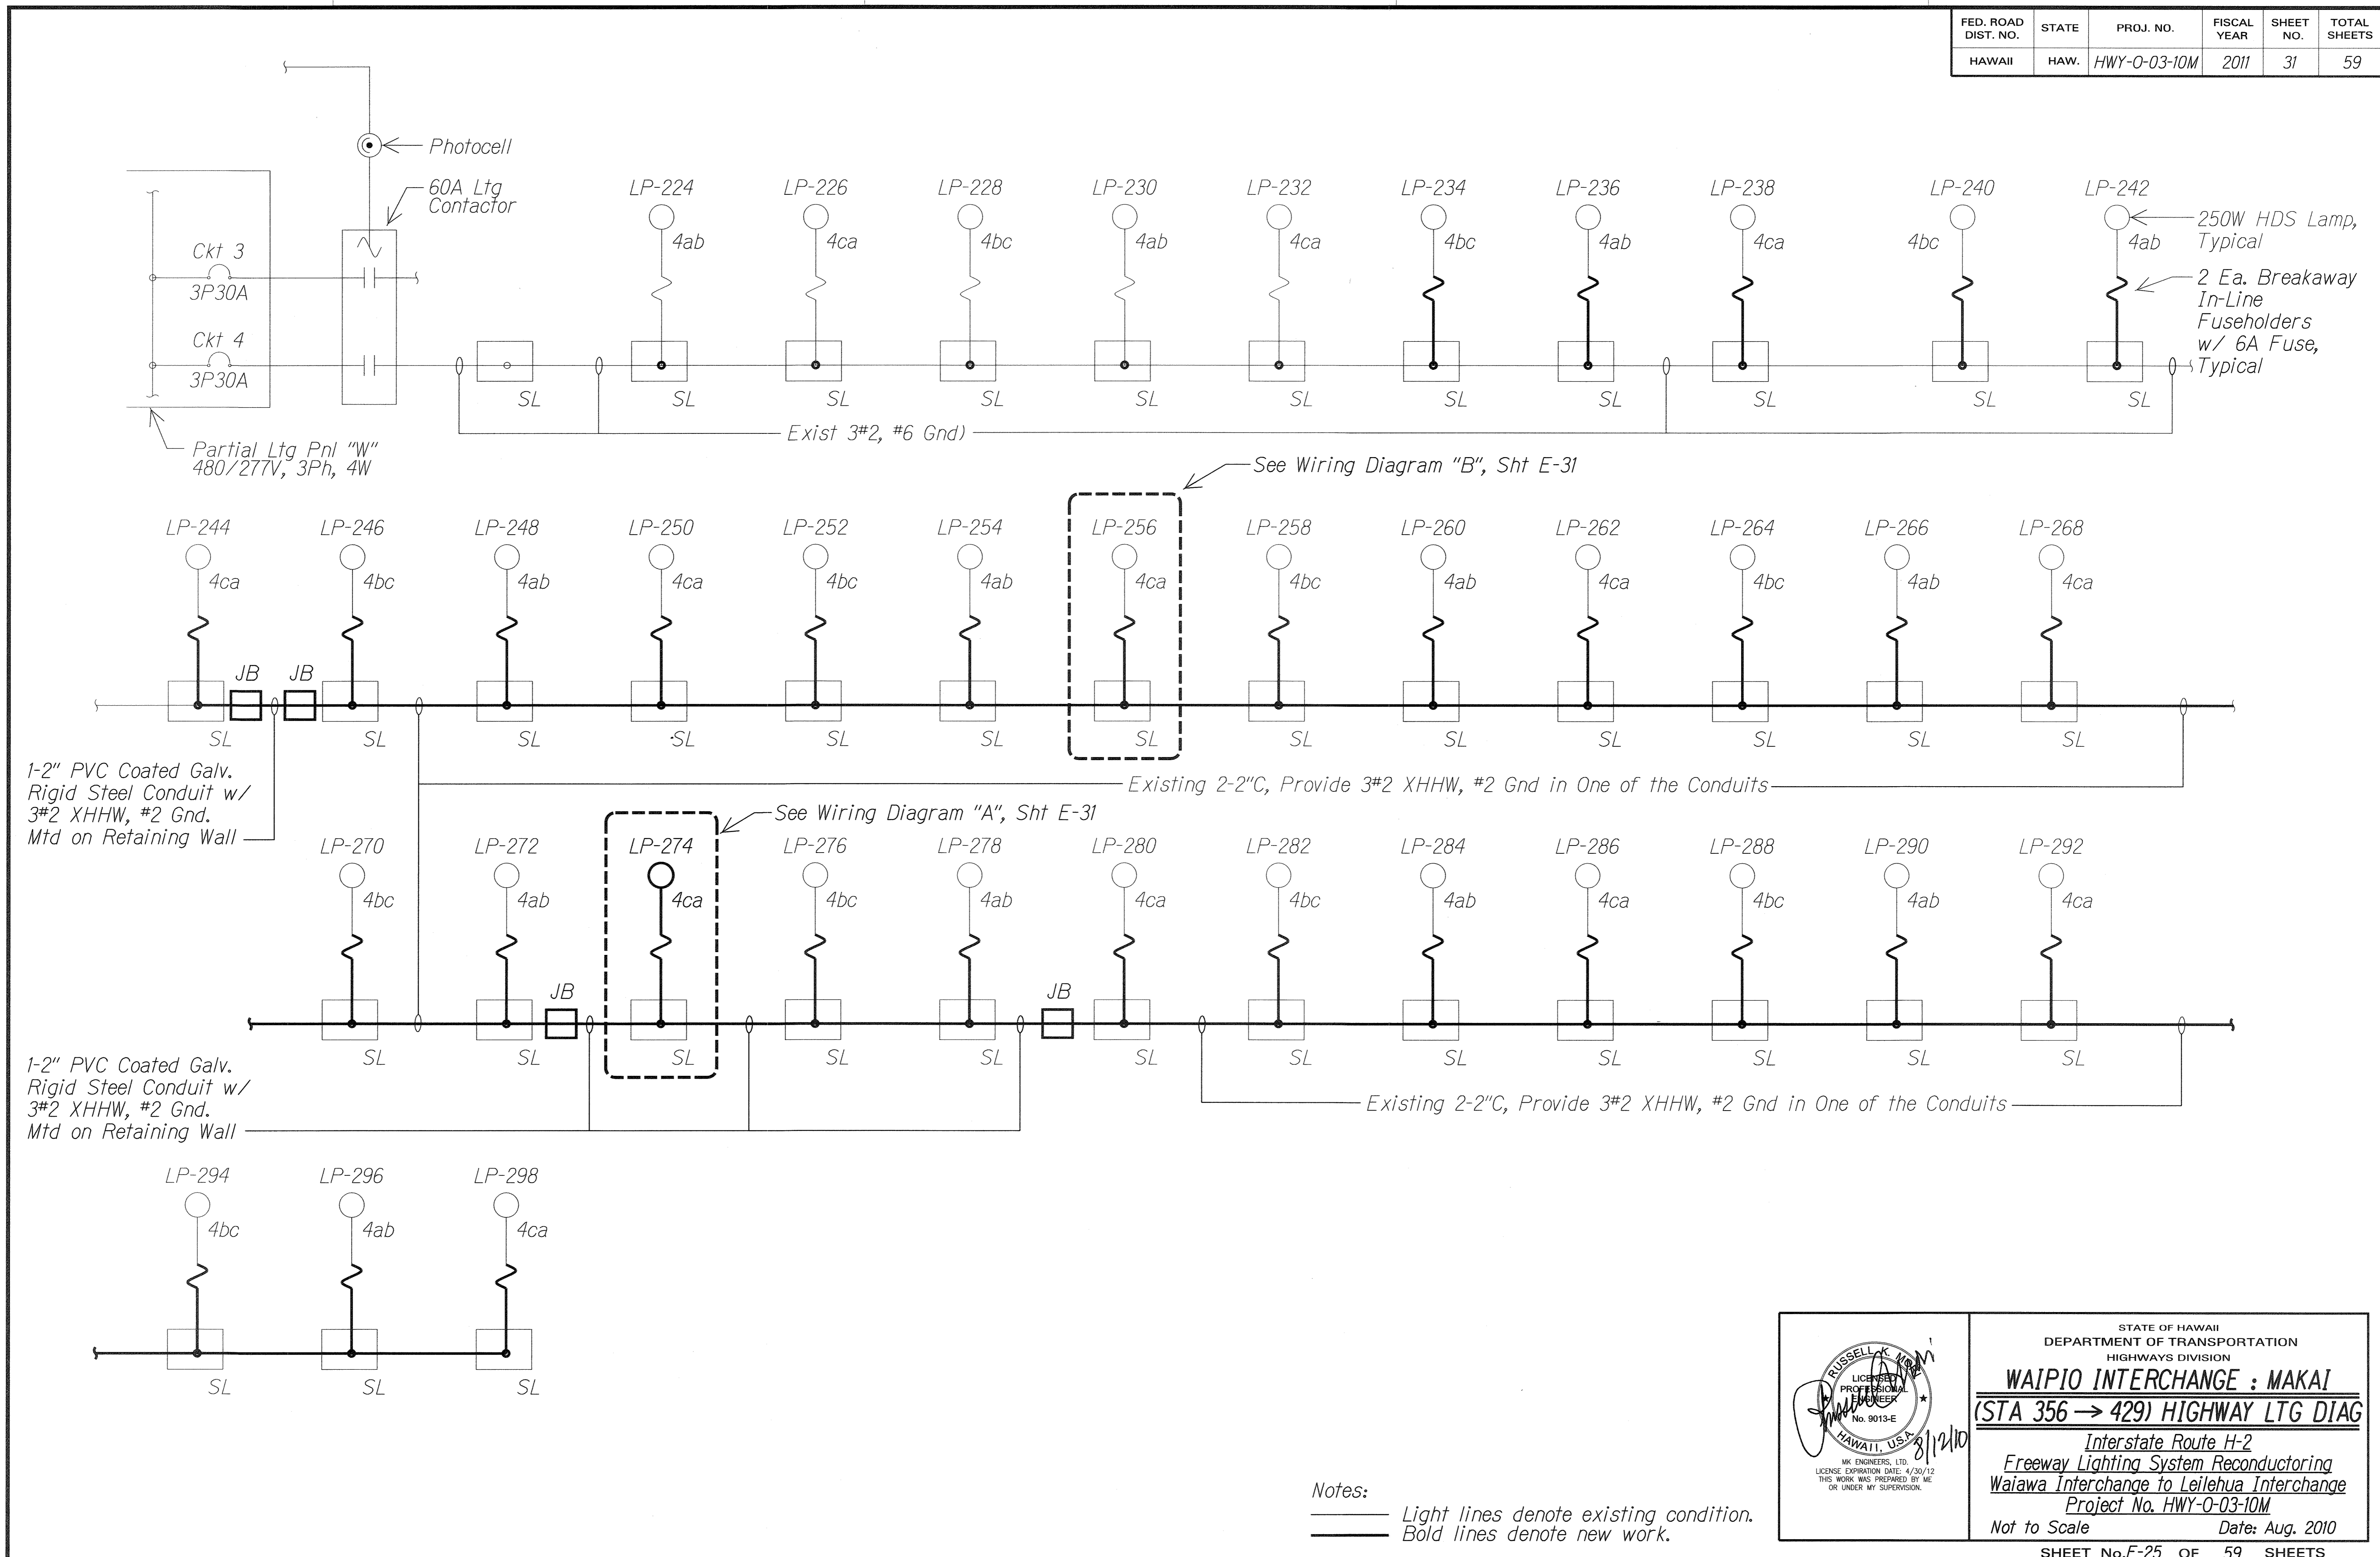

SURVEY PLOTTED BY	DATE
DRAWN BY	
DESIGNED BY	
NOTE BOOK	
QUANTITIES BY	
CHECKED BY	
N.	

Notes:
 — Light lines denote existing condition.
 — Bold lines denote new work.

STATE OF HAWAII
 DEPARTMENT OF TRANSPORTATION
 HIGHWAYS DIVISION

WAIPIO INTERCHANGE : MAKAI
 (STA 356 → 429) HIGHWAY LTG DIAG


Interstate Route H-2
 Freeway Lighting System Reconductoring
 Waiawa Interchange to Leilehua Interchange
 Project No. HWY-0-03-10M

Not to Scale Date: Aug. 2010

SHEET No. E-25 OF 59 SHEETS

10205-E25-1tg-01ag.dgn 8/12/2010 12:17:40 PM

FED. ROAD DIST. NO.	STATE	PROJ. NO.	FISCAL YEAR	SHEET NO.	TOTAL SHEETS
HAWAII	HAW.	HWY-0-03-10M	2011	32	59

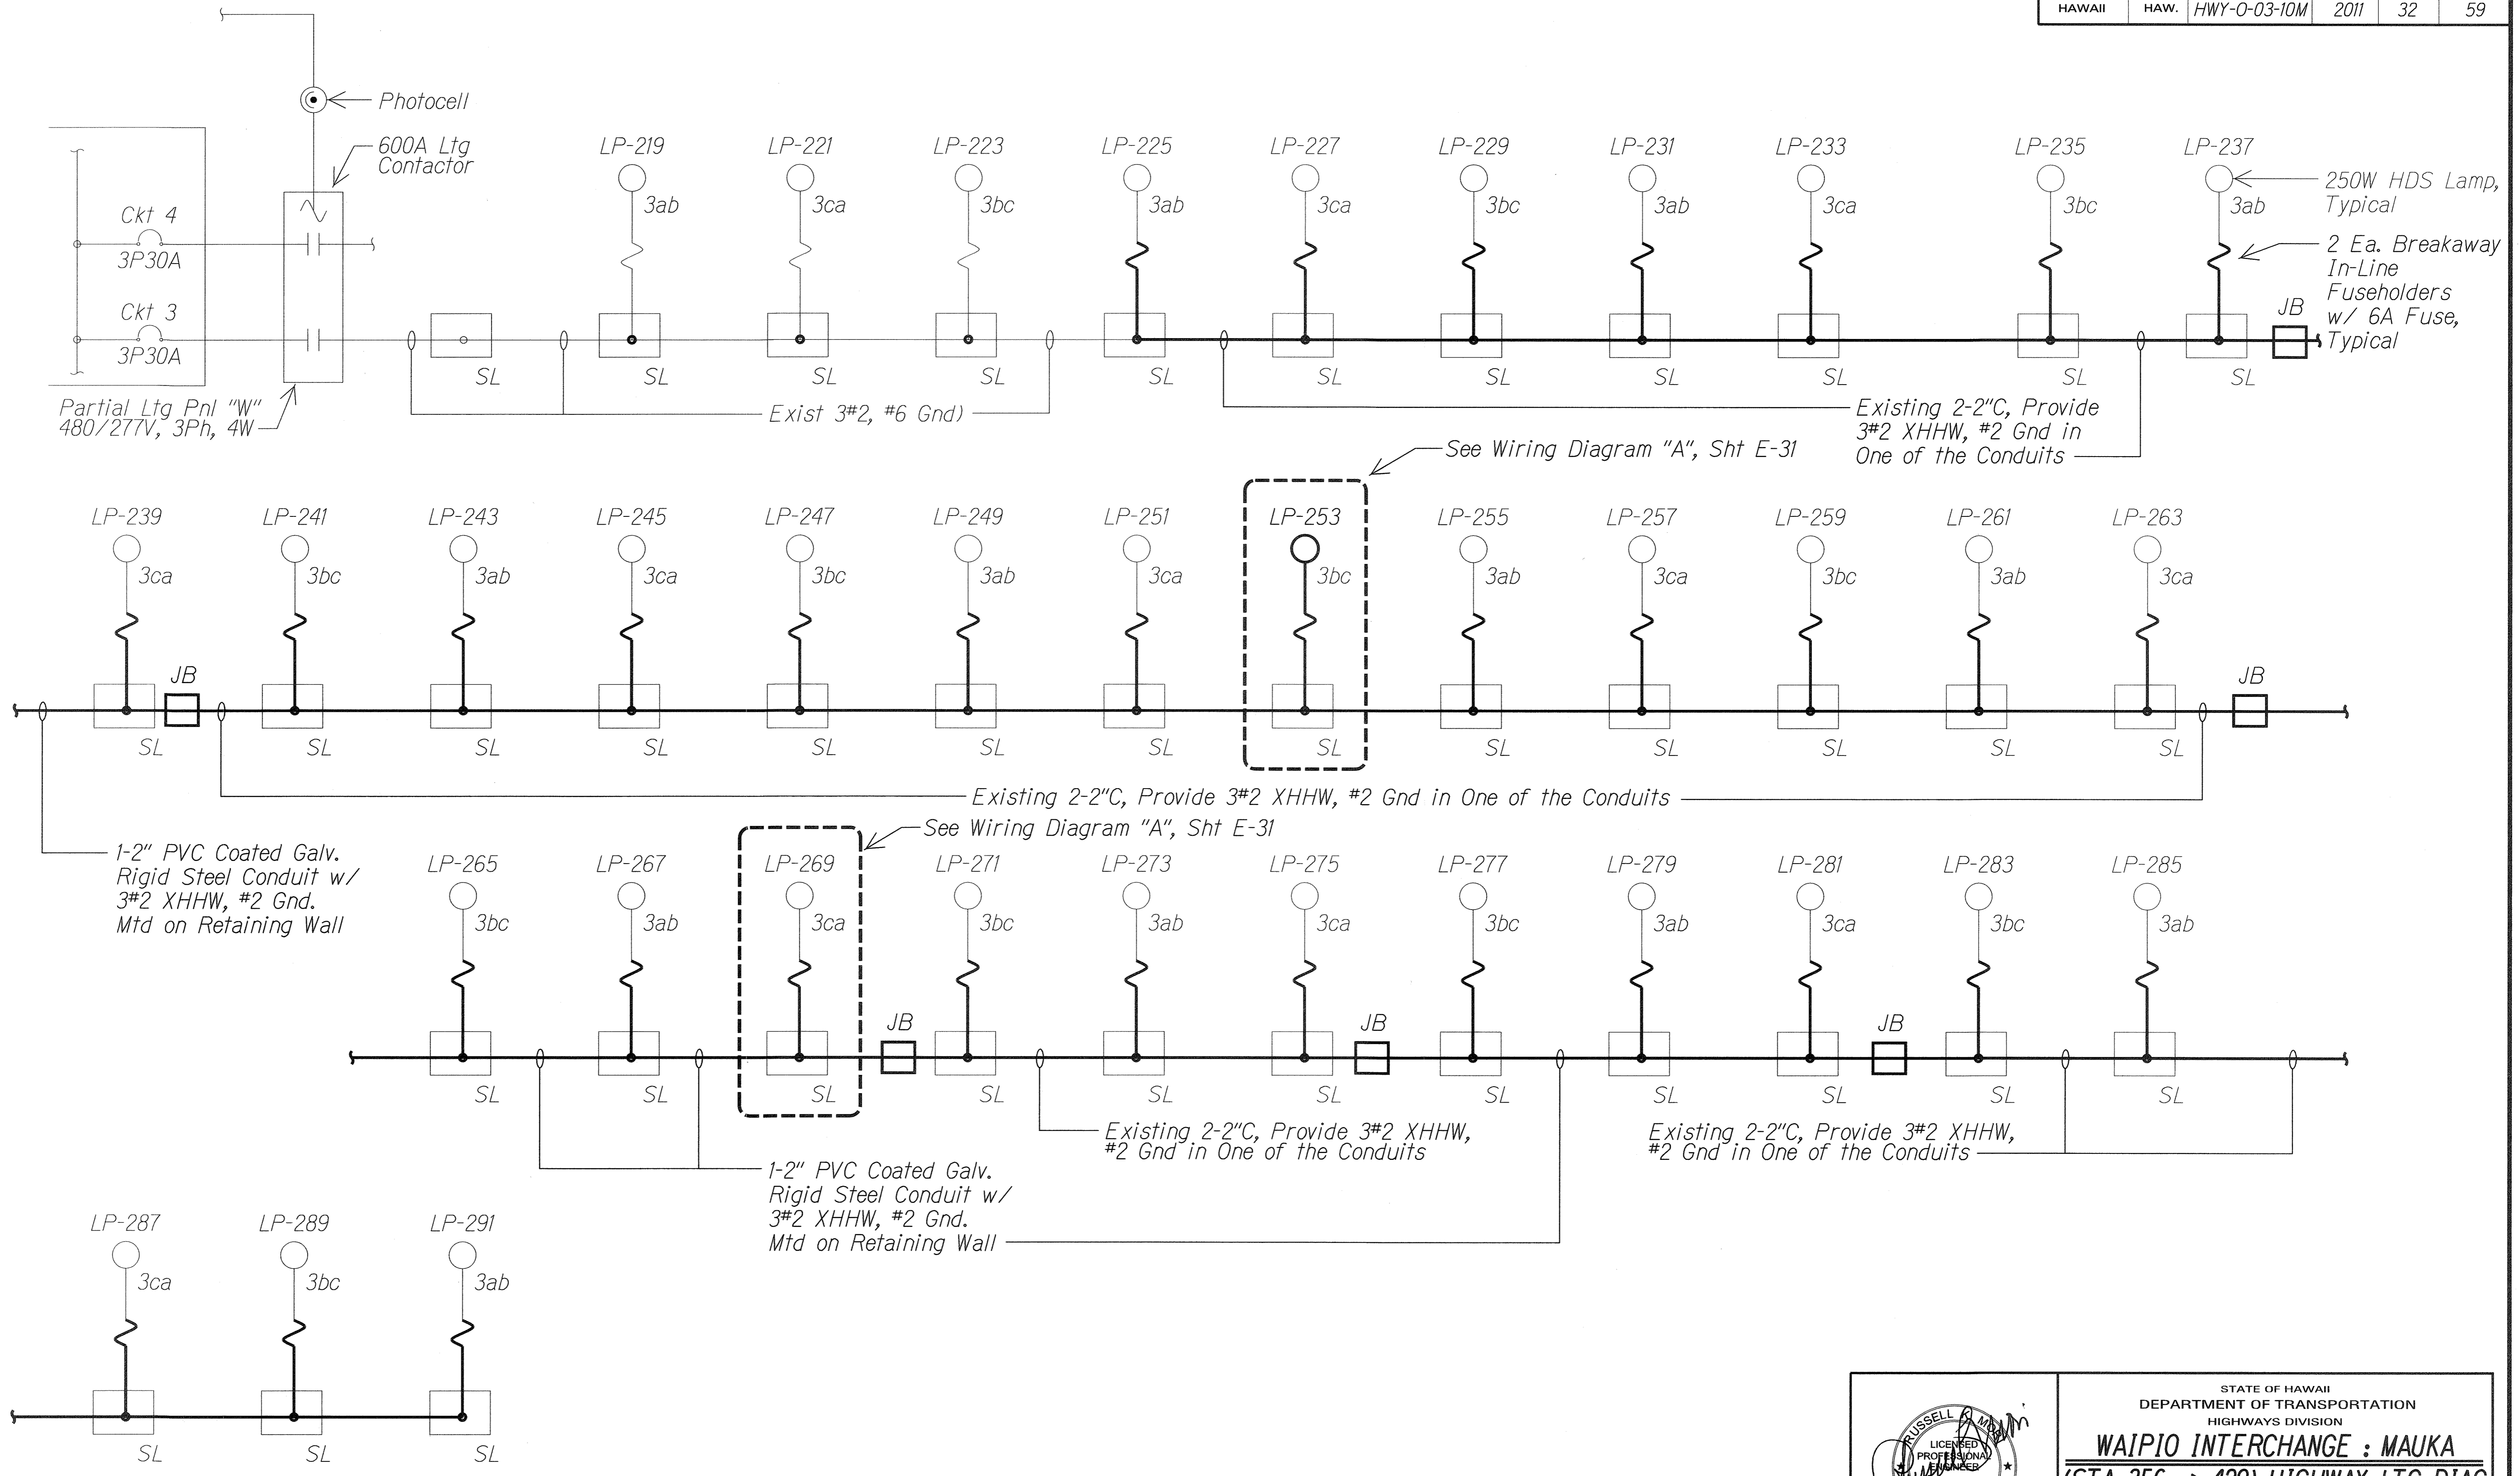

DATE
SURVEY PLOTTED BY
DRAWN BY
CHECKED BY
NOTE BOOK
QUANTITIES BY
CHECKED BY
N.

Notes:
 ——— Light lines denote existing condition.
 ——— Bold lines denote new work.

STATE OF HAWAII
 DEPARTMENT OF TRANSPORTATION
 HIGHWAYS DIVISION

WAIPIO INTERCHANGE : MAUKA
 (STA 356 → 429) HIGHWAY LTG DIAG


Interstate Route H-2
 Freeway Lighting System Reconductoring
 Waiawa Interchange to Leilehua Interchange
 Project No. HWY-0-03-10M

Not to Scale Date: Aug. 2010

SHEET No. E-26 OF 59 SHEETS

10202-E26-11g-01diag.dgn 8/12/2010 12:17:16 PM

FED. ROAD DIST. NO.	STATE	PROJ. NO.	FISCAL YEAR	SHEET NO.	TOTAL SHEETS
HAWAII	HAW.	HWY-0-03-10M	2011	33	59

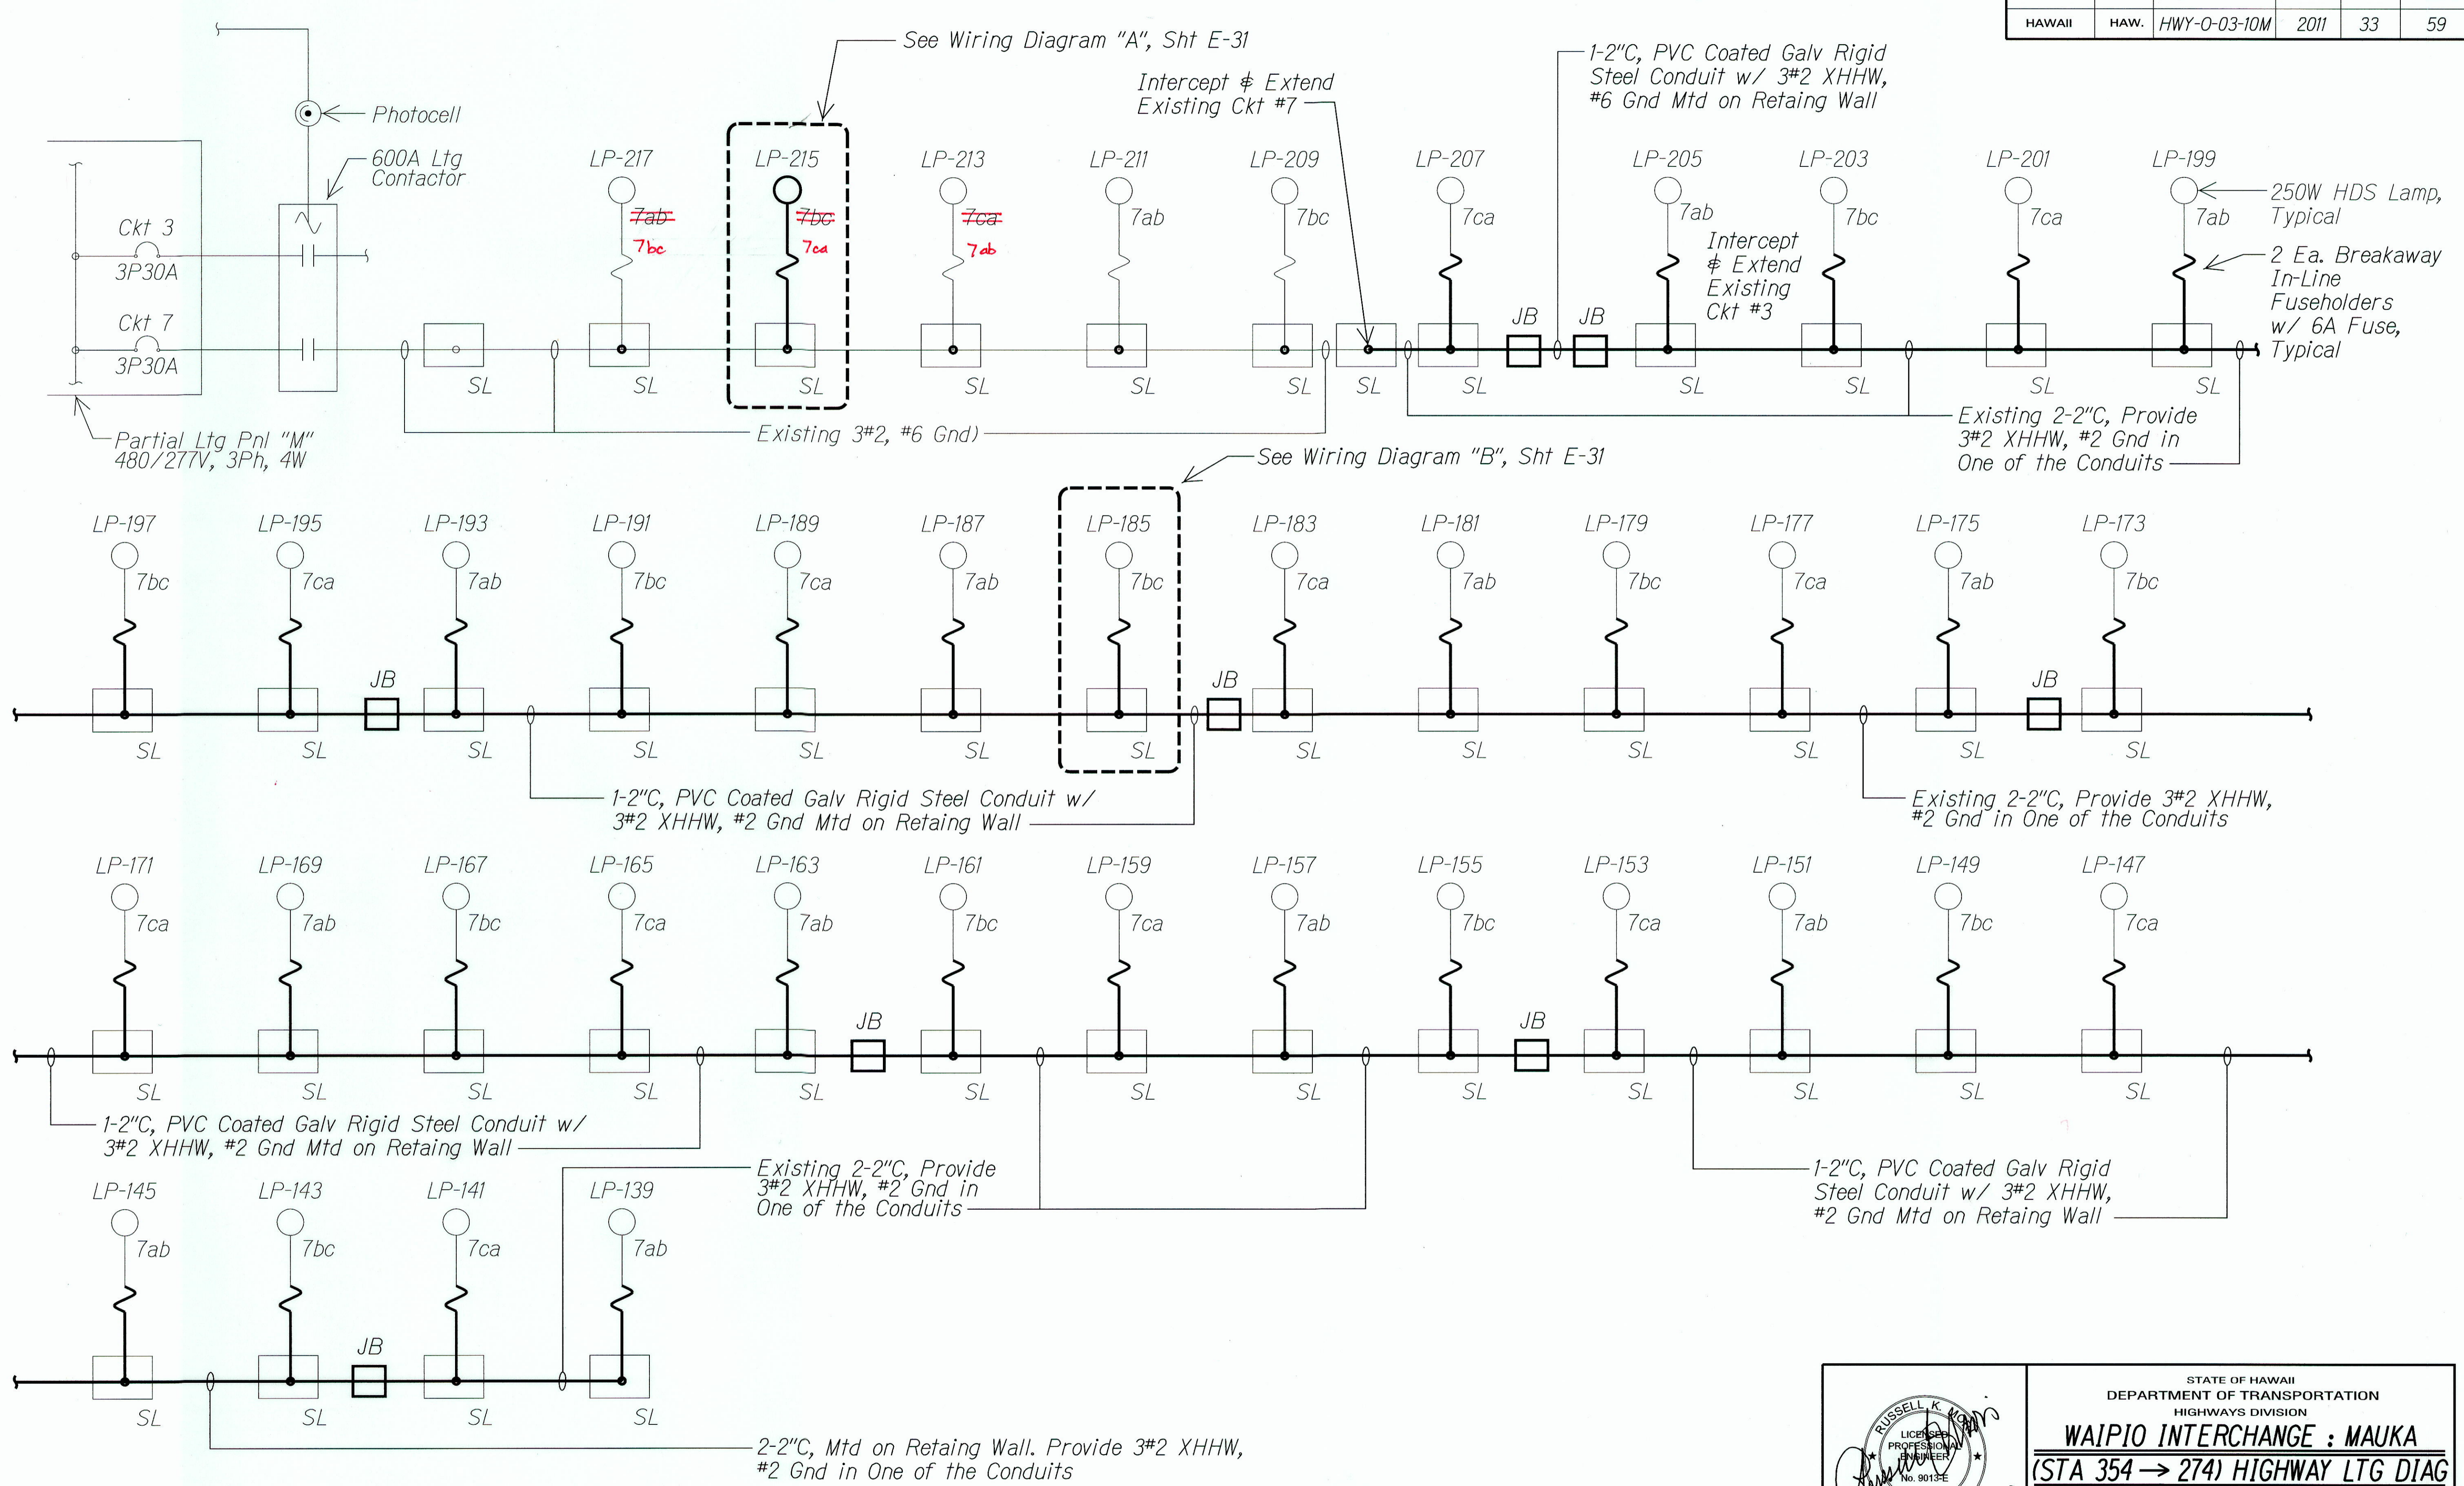

SURVEY PLOTTED BY	DATE
DRAWN BY	
TRACED BY	
NOTE BOOK	
CHECKED BY	

Notes:
 — Light lines denote existing condition.
 — Bold lines denote new work.

STATE OF HAWAII
 DEPARTMENT OF TRANSPORTATION
 HIGHWAYS DIVISION

WAIPIO INTERCHANGE : MAUKA
 (STA 354 → 274) HIGHWAY LTG DIAG


Interstate Route H-2
 Freeway Lighting System Reconductoring
 Waiawa Interchange to Leilehua Interchange
 Project No. HWY-0-03-10M

Not to Scale Date: Aug. 2010

"AS-BUILT"


10202-E27-1lg-d189.dgn, 8/12/2010 12:16:49 PM

FED. ROAD DIST. NO.	STATE	PROJ. NO.	FISCAL YEAR	SHEET NO.	TOTAL SHEETS
HAWAII	HAW.	HWY-0-03-10M	2011	34	59

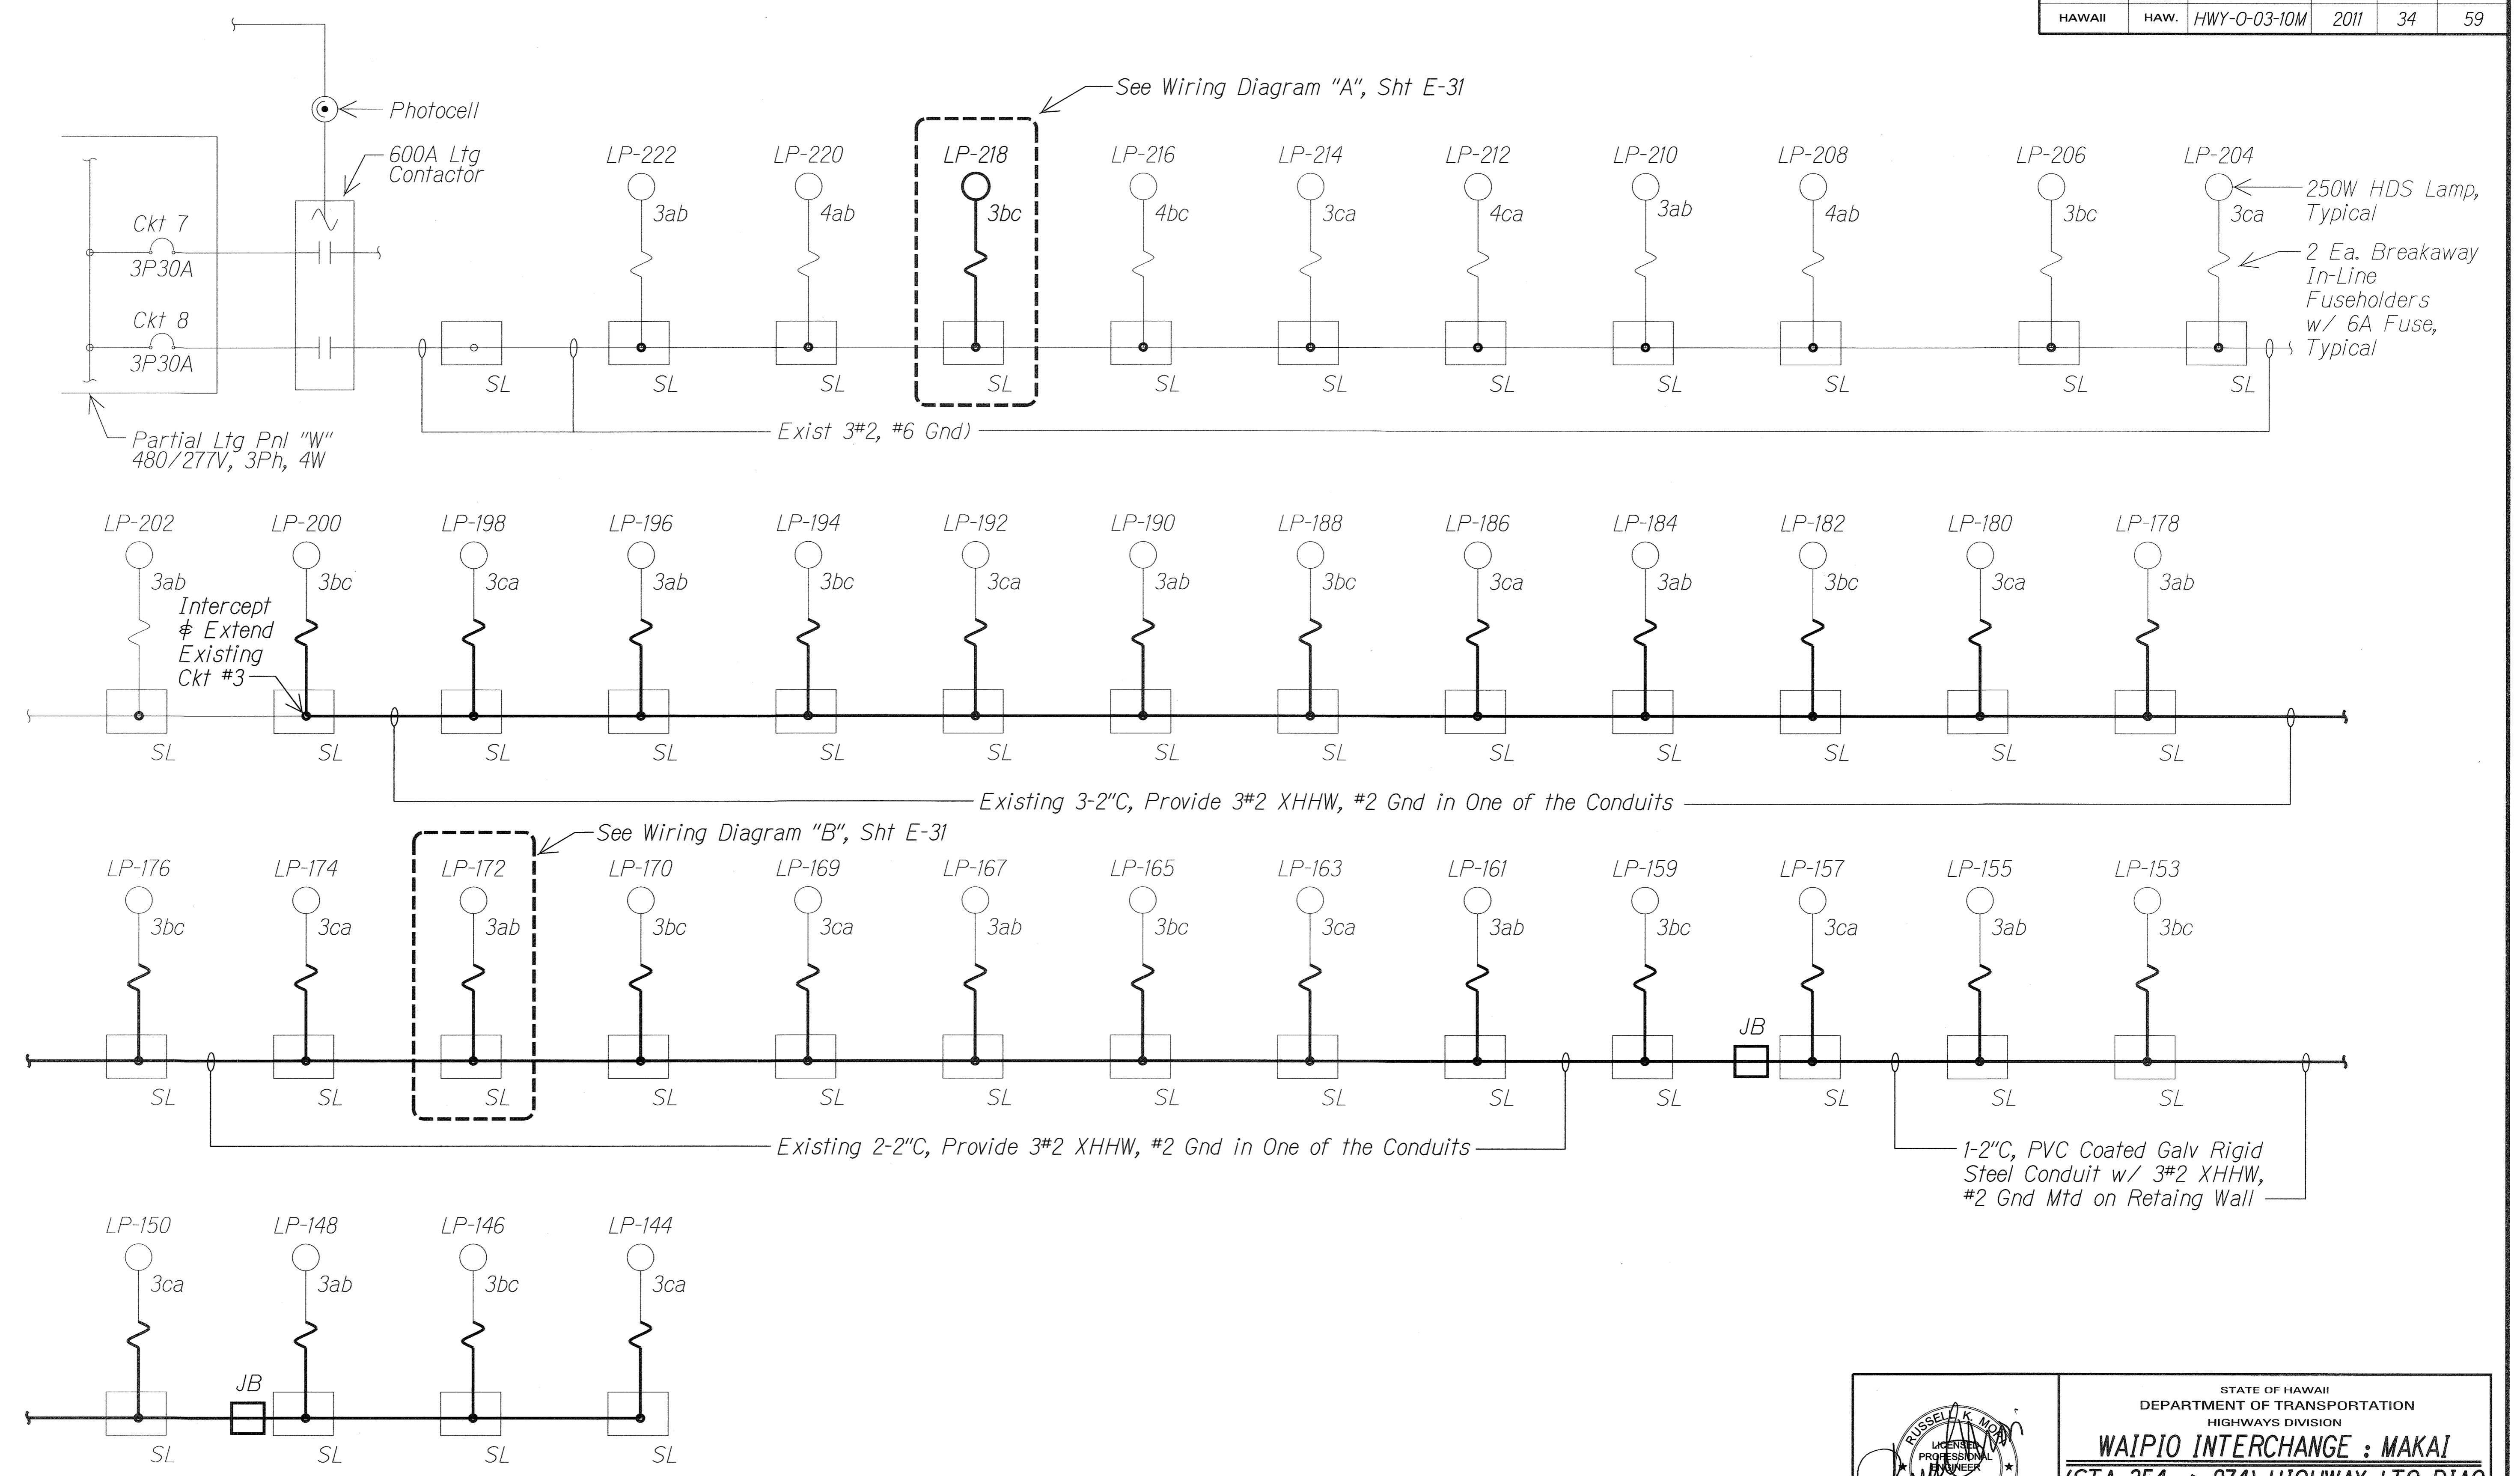

SURVEY PLOTTED BY	DATE
DRAWN BY	
DESIGNED BY	
NOTE BOOK	
CHECKED BY	


Notes:
 — Light lines denote existing condition.
 — Bold lines denote new work.

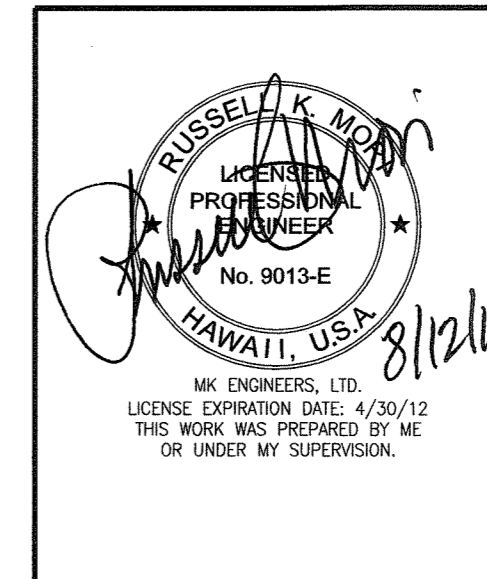

STATE OF HAWAII
 DEPARTMENT OF TRANSPORTATION
 HIGHWAYS DIVISION
WAIPIO INTERCHANGE : MAKAI
(STA 354 → 274) HIGHWAY LTG DIAG
 Interstate Route H-2
 Freeway Lighting System Reconductoring
 Waiawa Interchange to Leilehua Interchange
 Project No. HWY-0-03-10M
 Not to Scale Date: Aug. 2010
 SHEET No.E-28 OF 59 SHEETS

10202-E28-ltg-diag.dgn 8/12/2010 12:16:25 PM

FED. ROAD DIST. NO.	STATE	PROJ. NO.	FISCAL YEAR	SHEET NO.	TOTAL SHEETS
HAWAII	HAW.	HWY-0-03-10M	2011	35	59

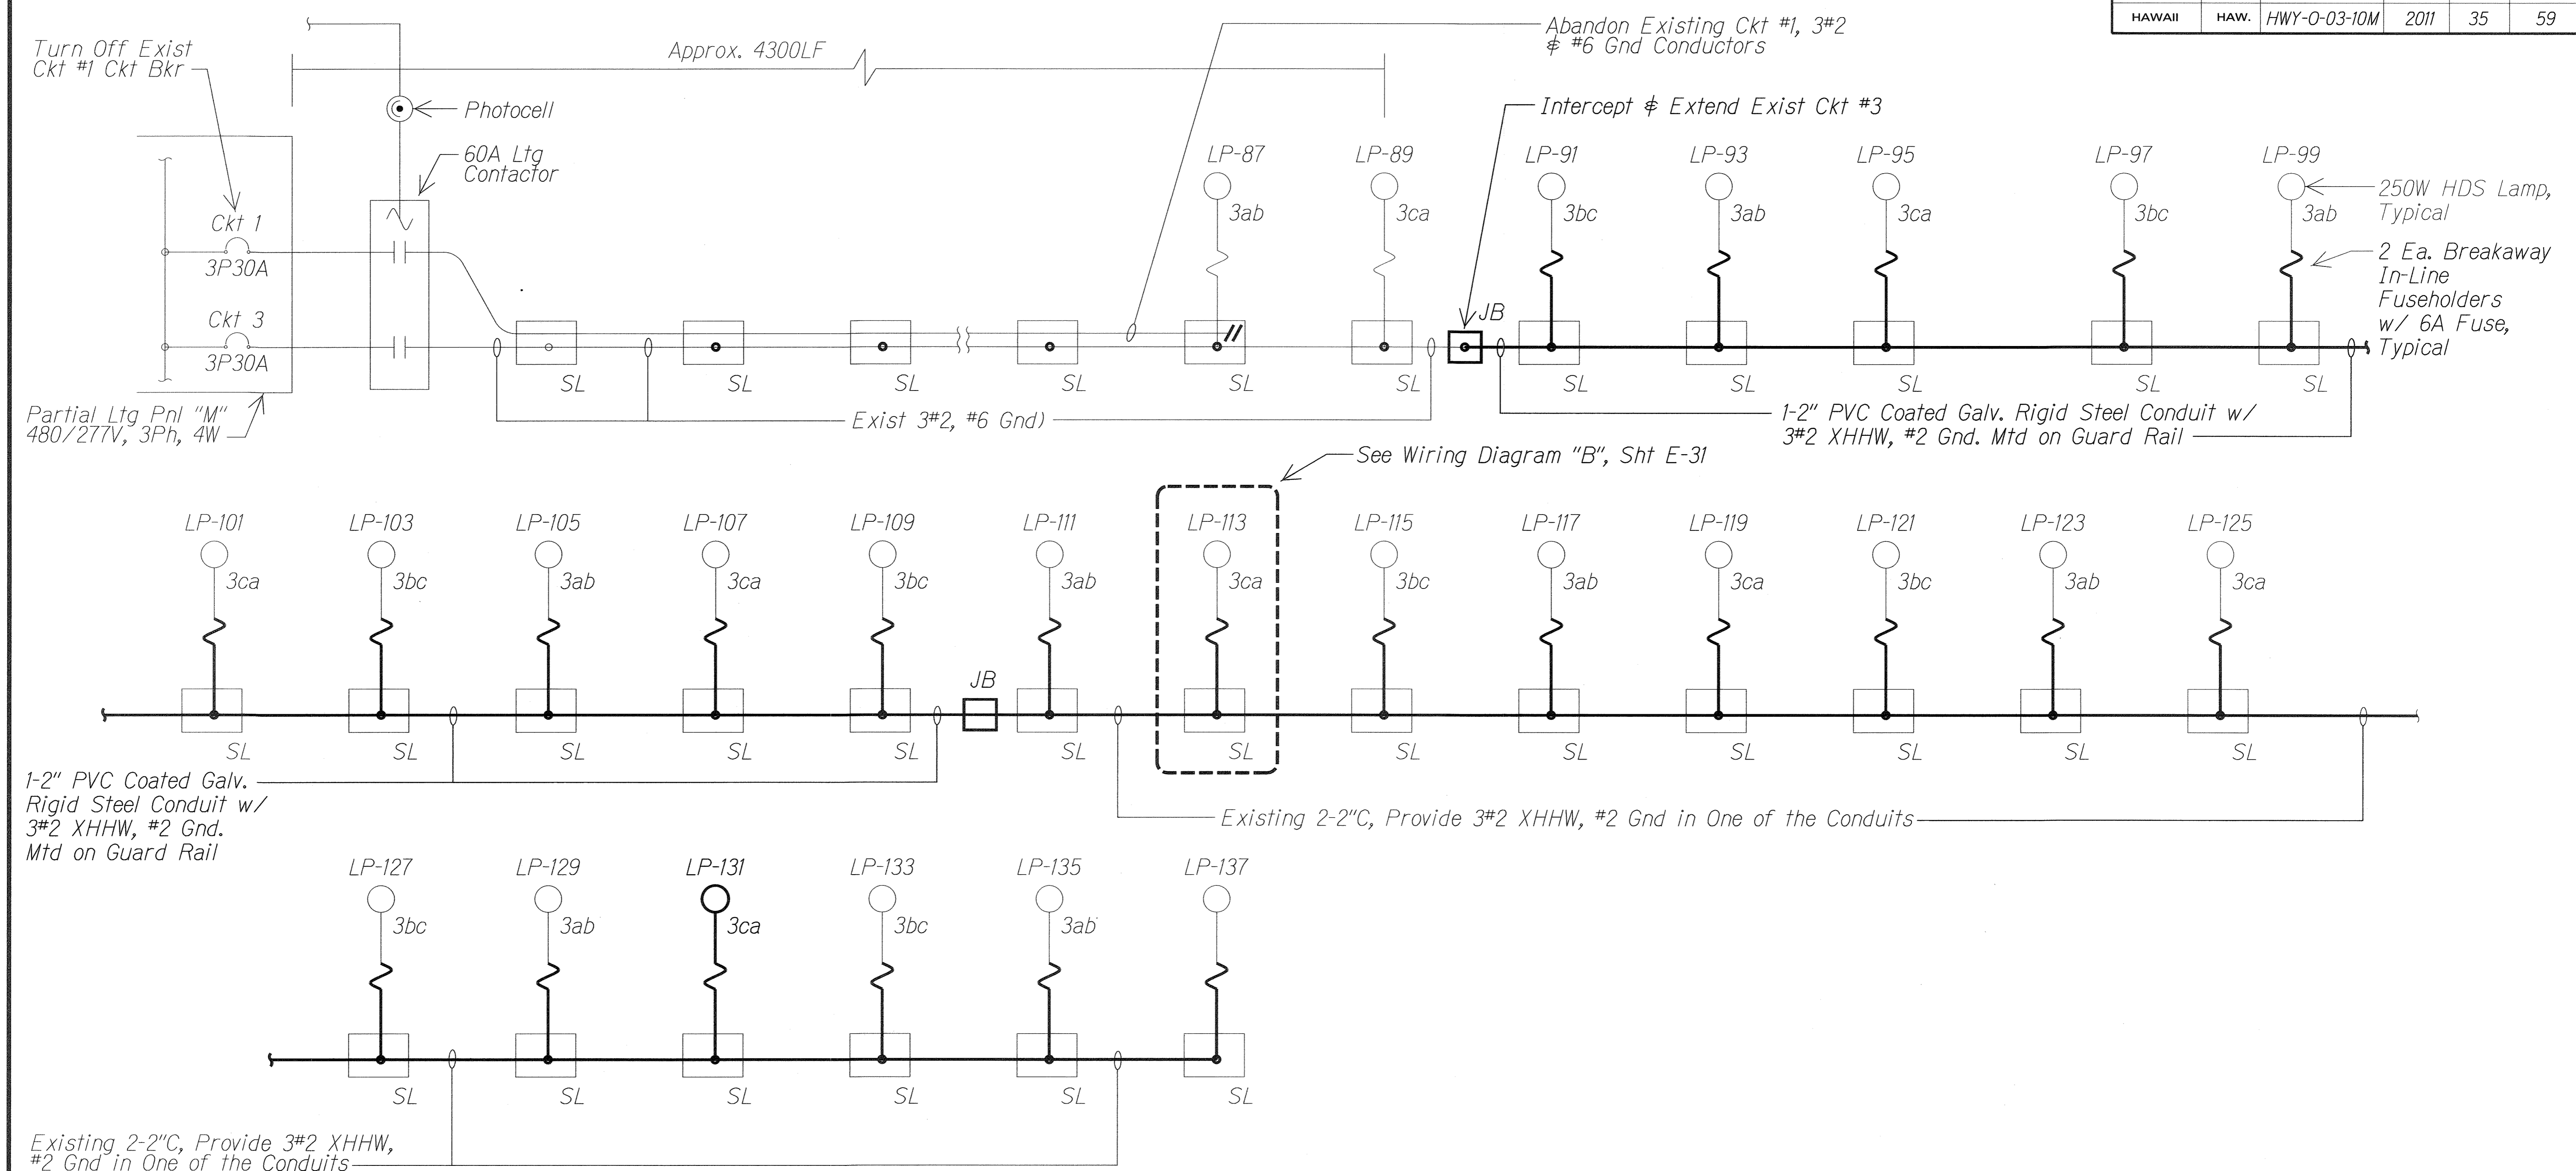

SURVEY PLOTTED BY	DATE
DRAWN BY	
DESIGNED BY	
NOTE BOOK	
QUANTITIES BY	
CHECKED BY	
N.	

Notes:
 ——— Light lines denote existing condition.
 ——— Bold lines denote new work.

STATE OF HAWAII
 DEPARTMENT OF TRANSPORTATION
 HIGHWAYS DIVISION


MILILANI INTERCHANGE : MAUKA
(STA 225 → 276) HIGHWAY LTG DIAG

Interstate Route H-2
Freeway Lighting System Reconductoring
Waiawa Interchange to Leilehua Interchange
Project No. HWY-0-03-10M

Not to Scale Date: Aug. 2010

SHEET No. E-29 OF 59 SHEETS

FED. ROAD DIST. NO.	STATE	PROJ. NO.	FISCAL YEAR	SHEET NO.	TOTAL SHEETS
HAWAII	HAW.	HWY-0-03-10M	2011	36	59

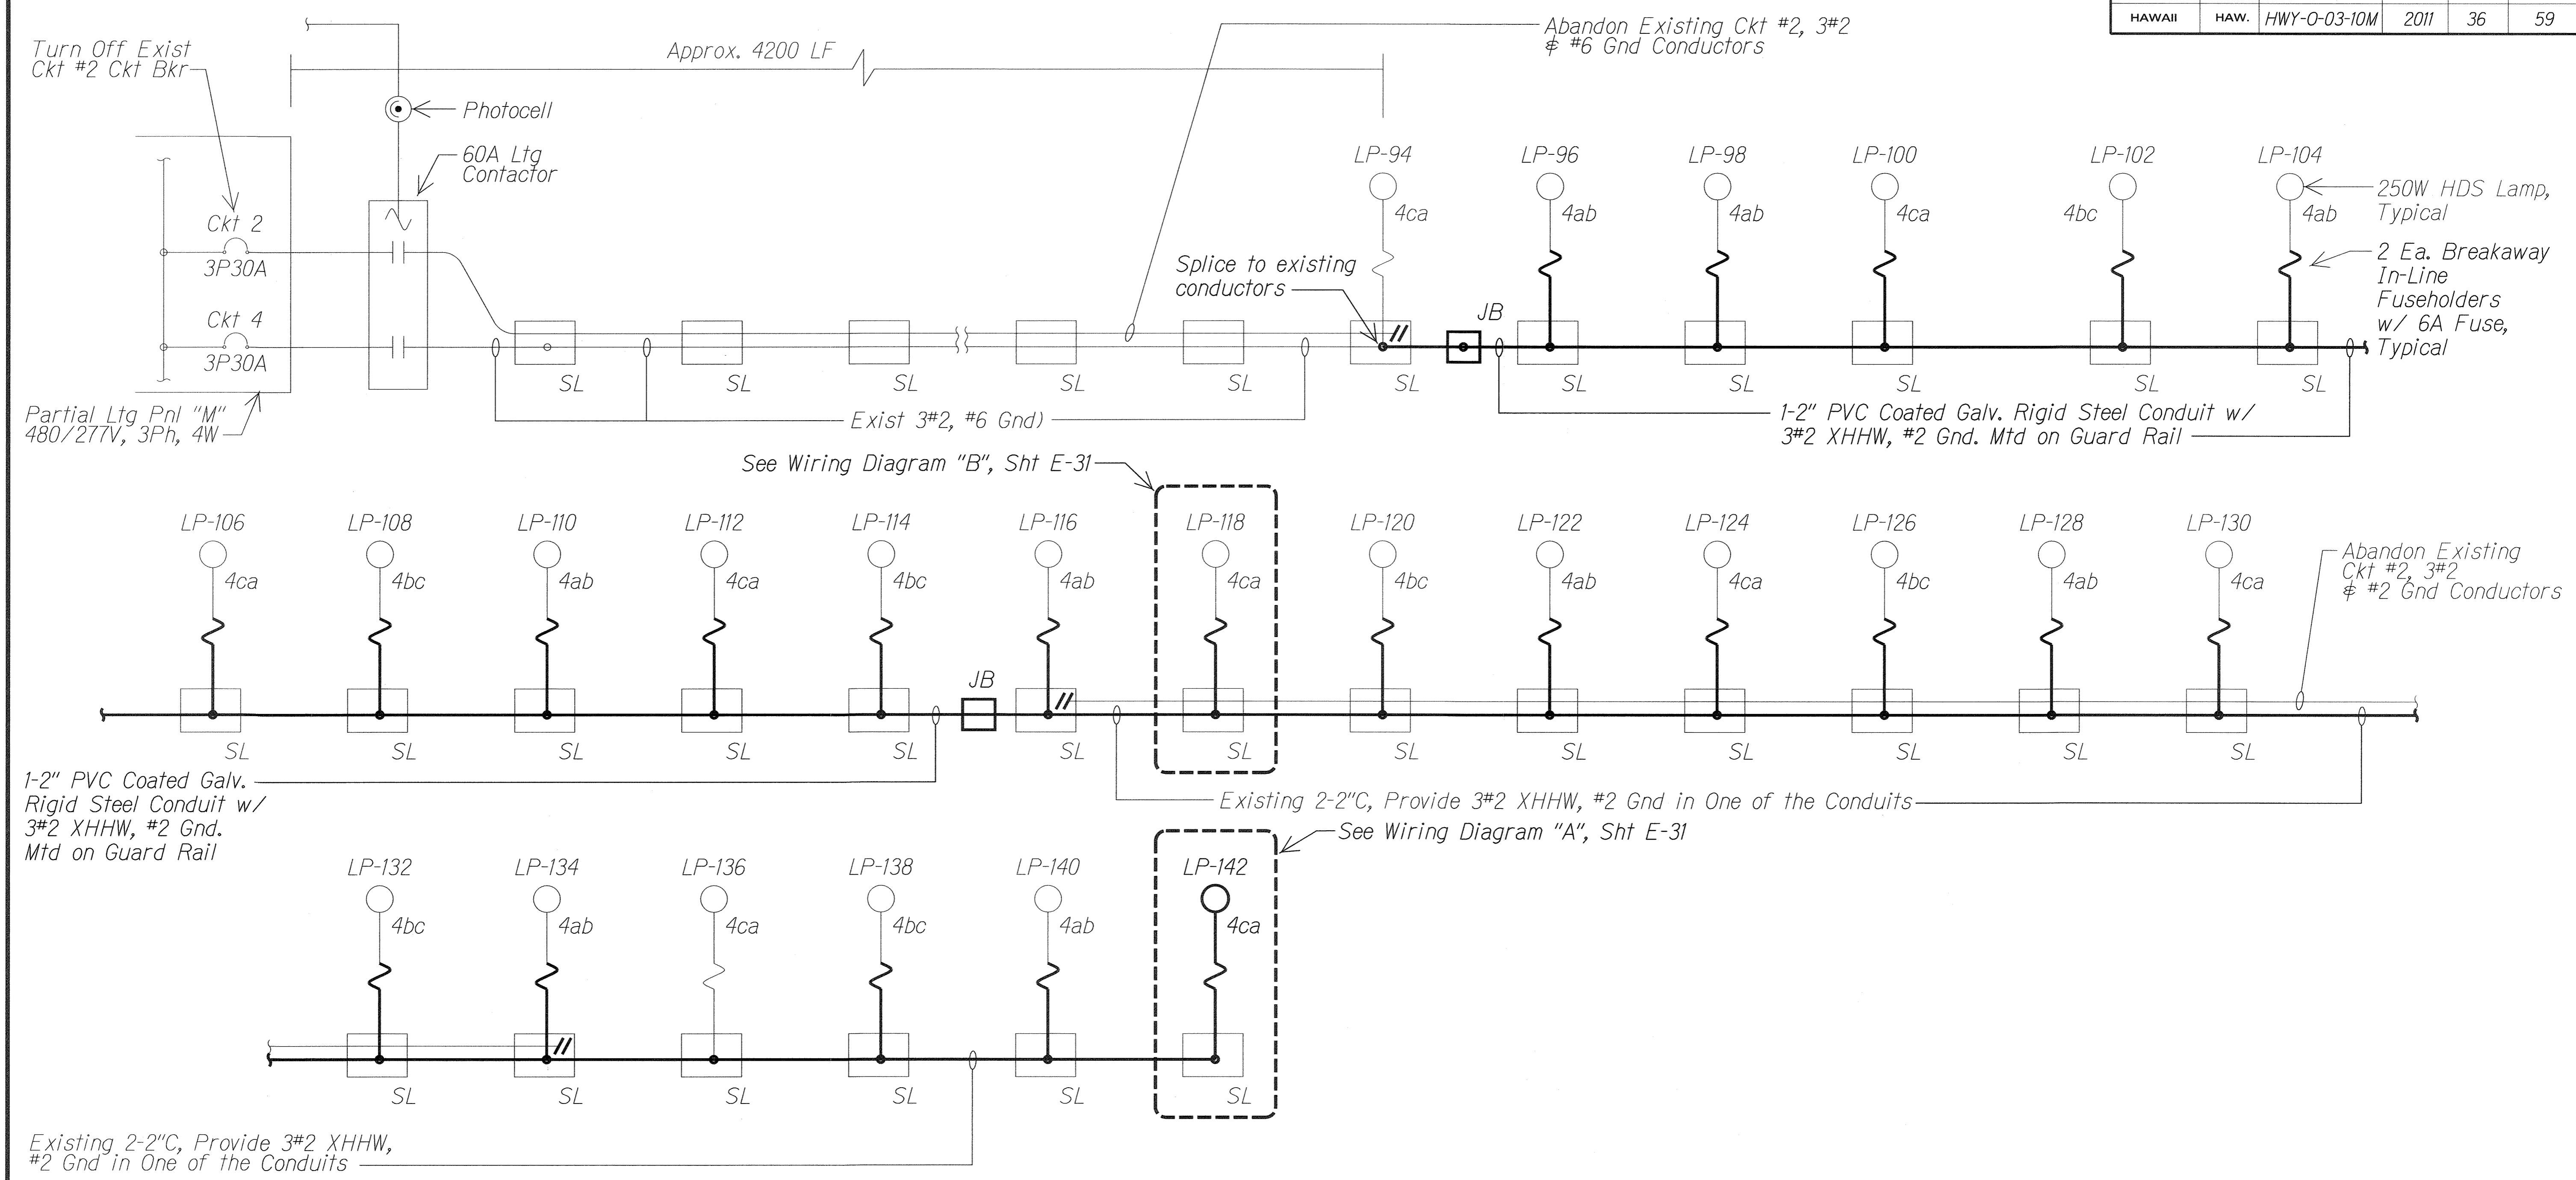

DATE	_____
SURVEY PLOTTED BY	_____
DRAWN BY	_____
DESIGNED BY	_____
NOTE BOOK	_____
QUANTITIES BY	_____
CHECKED BY	_____
N.	_____

Notes:
 ——— Light lines denote existing condition.
 ——— Bold lines denote new work.

STATE OF HAWAII
 DEPARTMENT OF TRANSPORTATION
 HIGHWAYS DIVISION

MILILANI INTERCHANGE : MAKAI
(STA 225 → 276) HIGHWAY LTG DIAG

Interstate Route H-2
 Freeway Lighting System Reconductoring
 Waiawa Interchange to Leilehua Interchange
 Project No. HWY-0-03-10M

Not to Scale Date: Aug. 2010

SHEET No. E-30 OF 59 SHEETS