

STATE OF HAWAII
DEPARTMENT OF TRANSPORTATION
HIGHWAYS DIVISION

HONOLULU, HAWAII

PLANS FOR


"AS BUILT"

MOANALUA ROAD
PLANT ESTABLISHMENT

FEDERAL AID PROJECT NO. F-078-1(22)

DISTRICT OF HONOLULU
ISLAND OF OAHU

FED. ROAD DIST. NO.	STATE	FED. AID PROJ. NO.	FISCAL YEAR	SHEET NO.	TOTAL SHEETS
HAWAII	HAW.	F-078-1(22)	1980	1	1

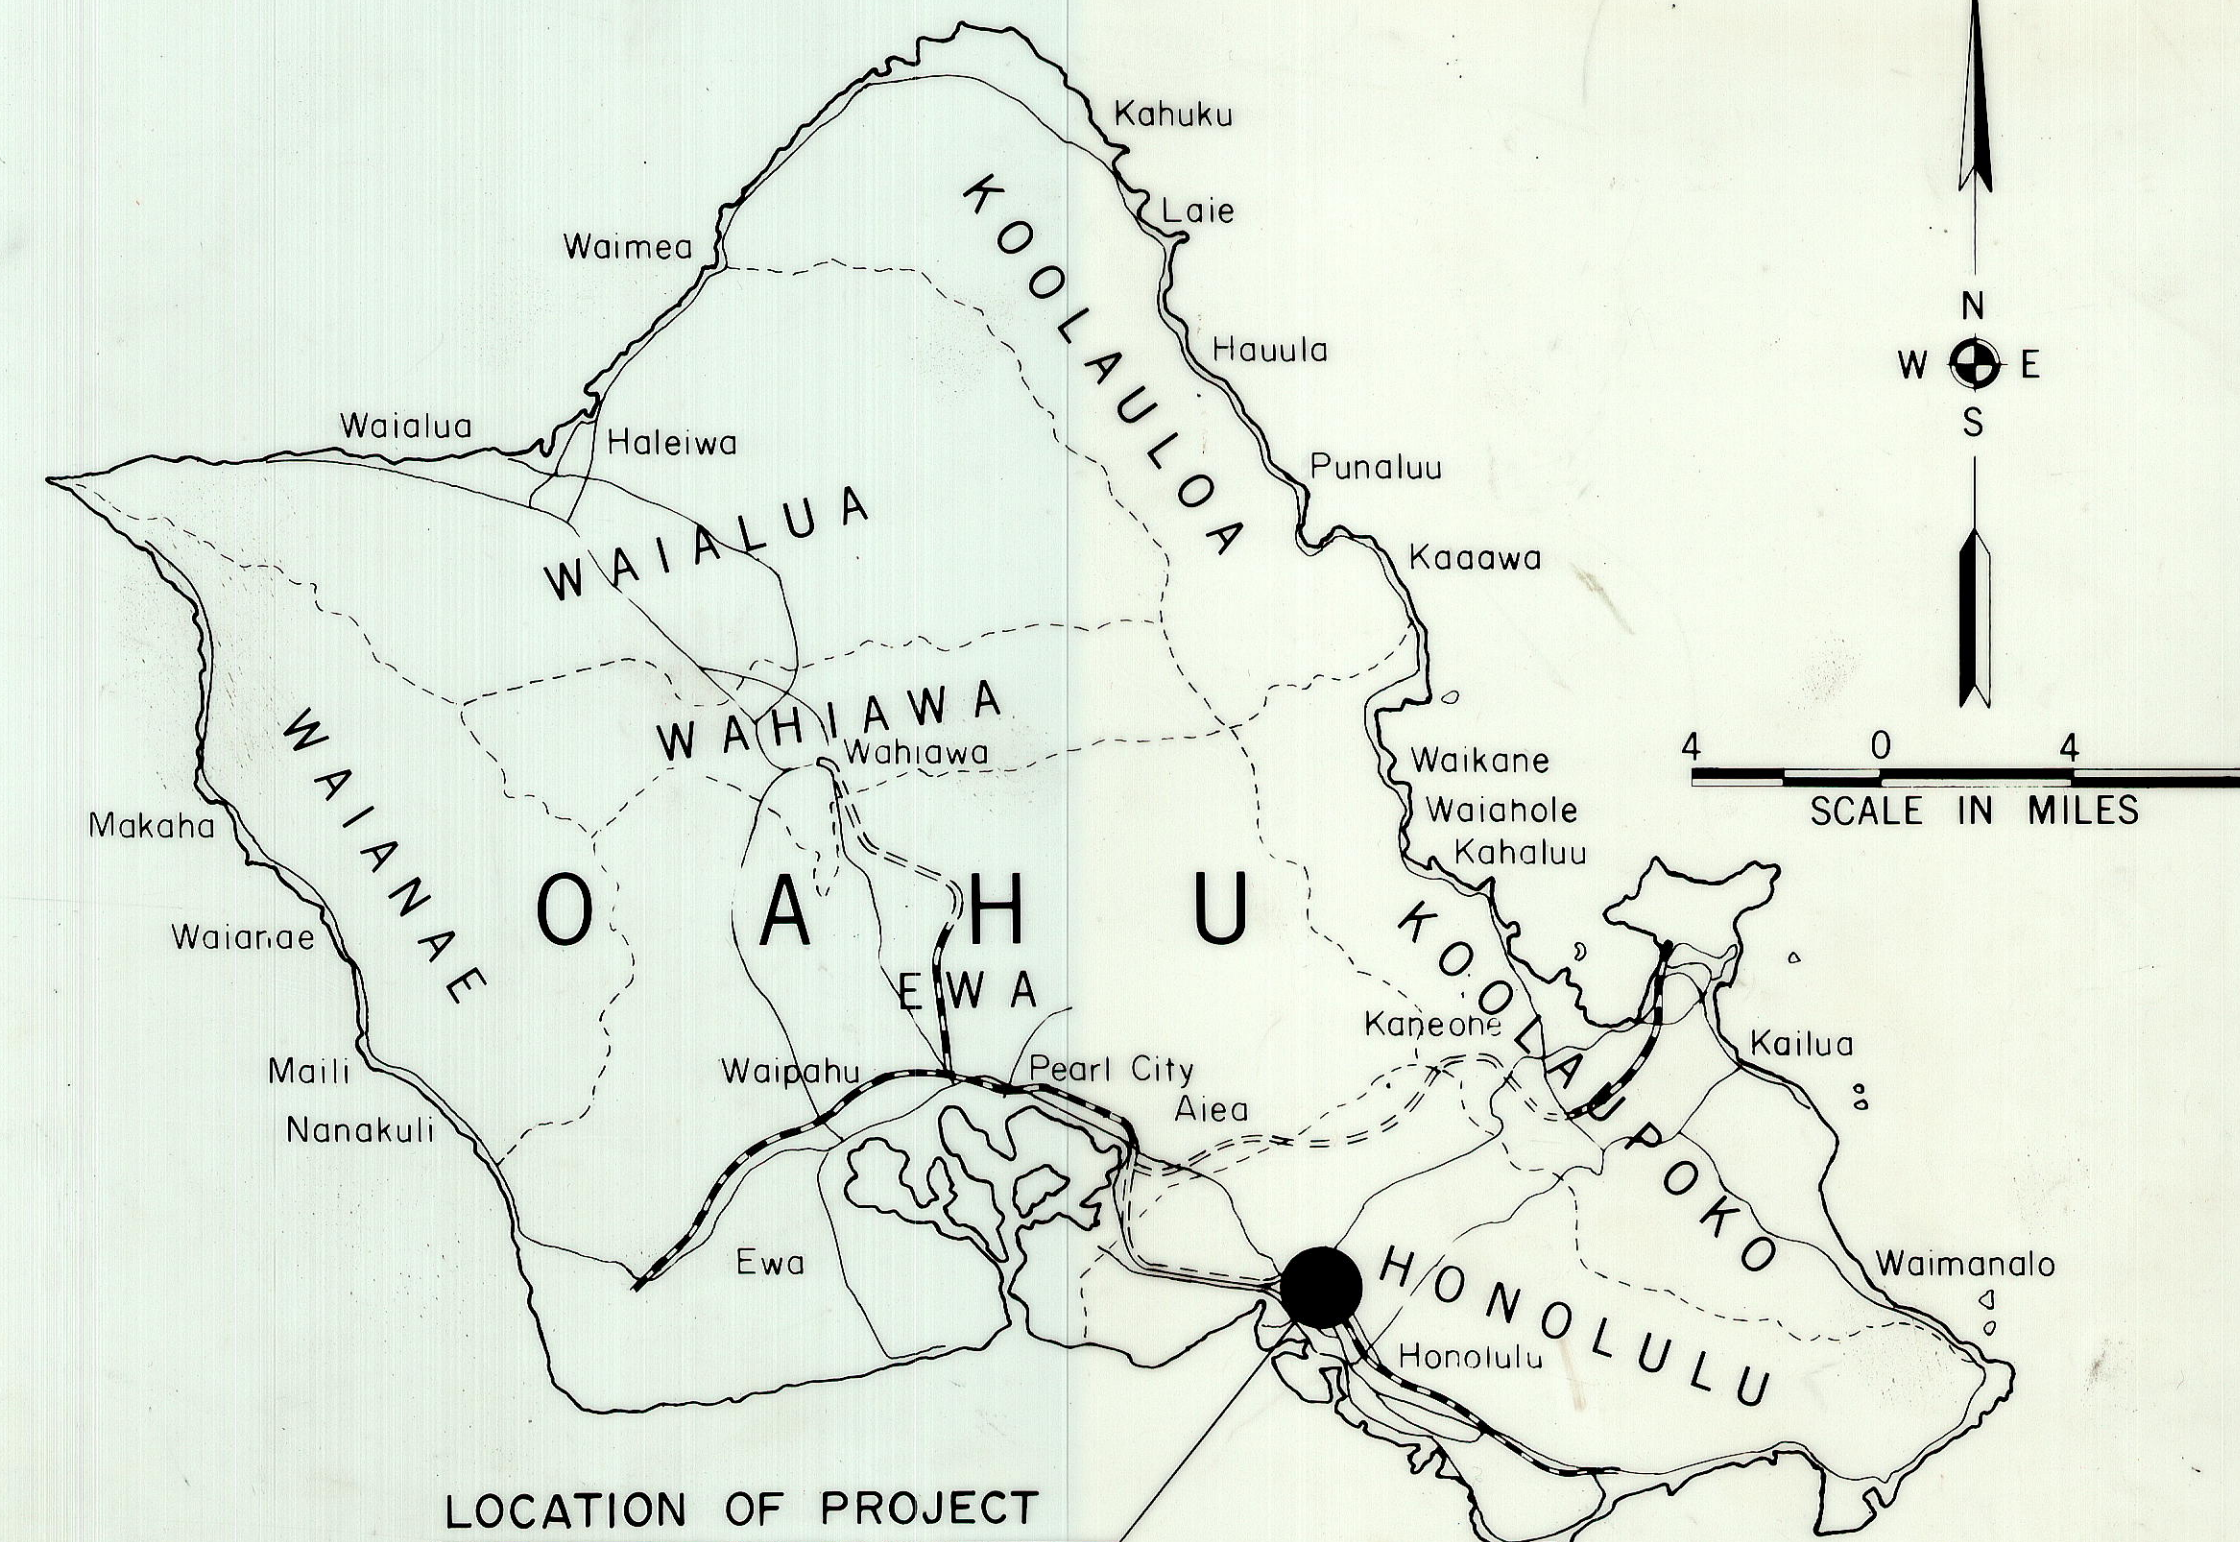

LOCATION OF PROJECT
F.A. Proj. No. F-078-1(22)


— Federal Aid Interstate Projects Previously Constructed or Under Construction

DESIGN DESIGNATION

CURRENT ADT (1979). 44,100
DESIGN ADT. 73,900
DHV 7,840
D 60/40
T 5%
V 60 M.P.H.
CONTROL OF ACCESS . FULL

NO CHANGES WERE MADE DURING
CONSTRUCTION ON THIS PLAN.

Michael Domingo 9/7/82
RESIDENT ENGINEER DATE

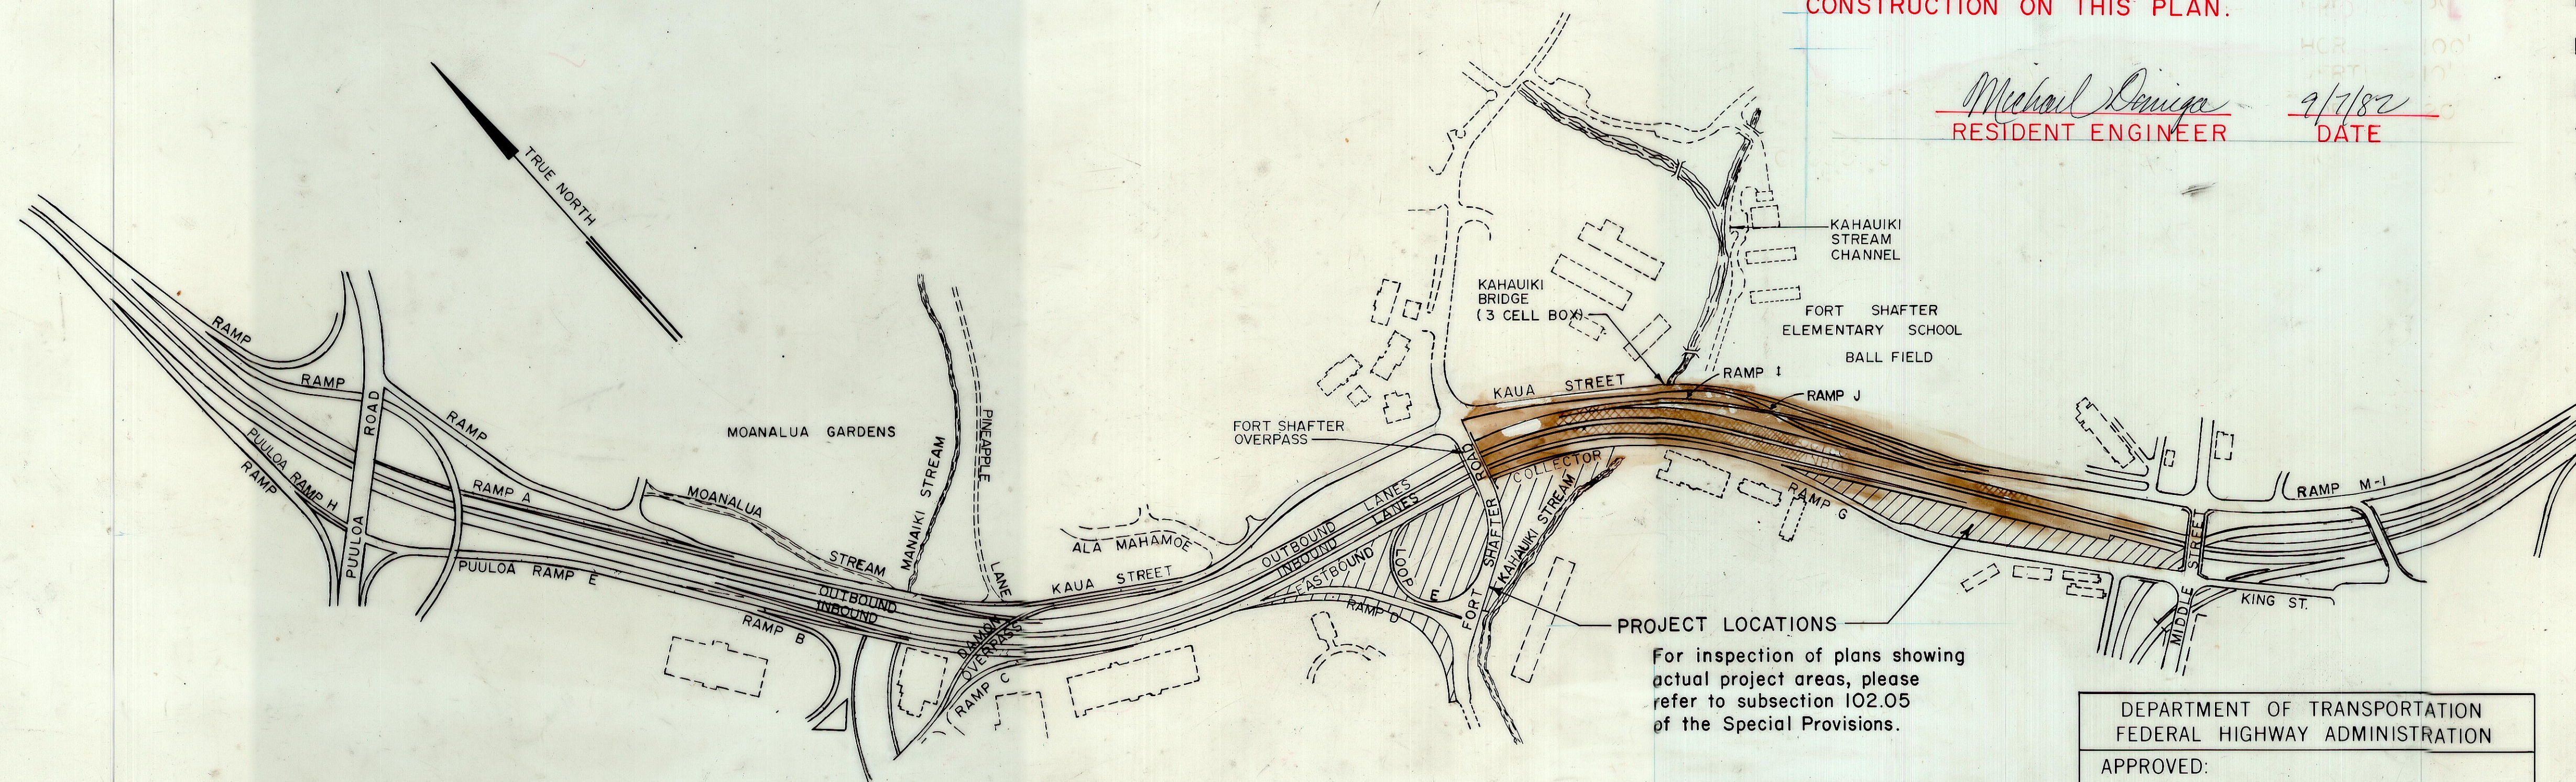

PROJECT LOCATIONS
For inspection of plans showing
actual project areas, please
refer to subsection 102.05
of the Special Provisions.

LAYOUT PLAN
SCALE: 1" = 325'

DEPARTMENT OF TRANSPORTATION
FEDERAL HIGHWAY ADMINISTRATION
APPROVED:
Faith Uegawa Jan 11/80
DIVISION ADMINISTRATOR DATE

DEPARTMENT OF TRANSPORTATION
STATE OF HAWAII
APPROVED:
James R. Canas 1/4/80
DIR. OF TRANSPORTATION DATE