

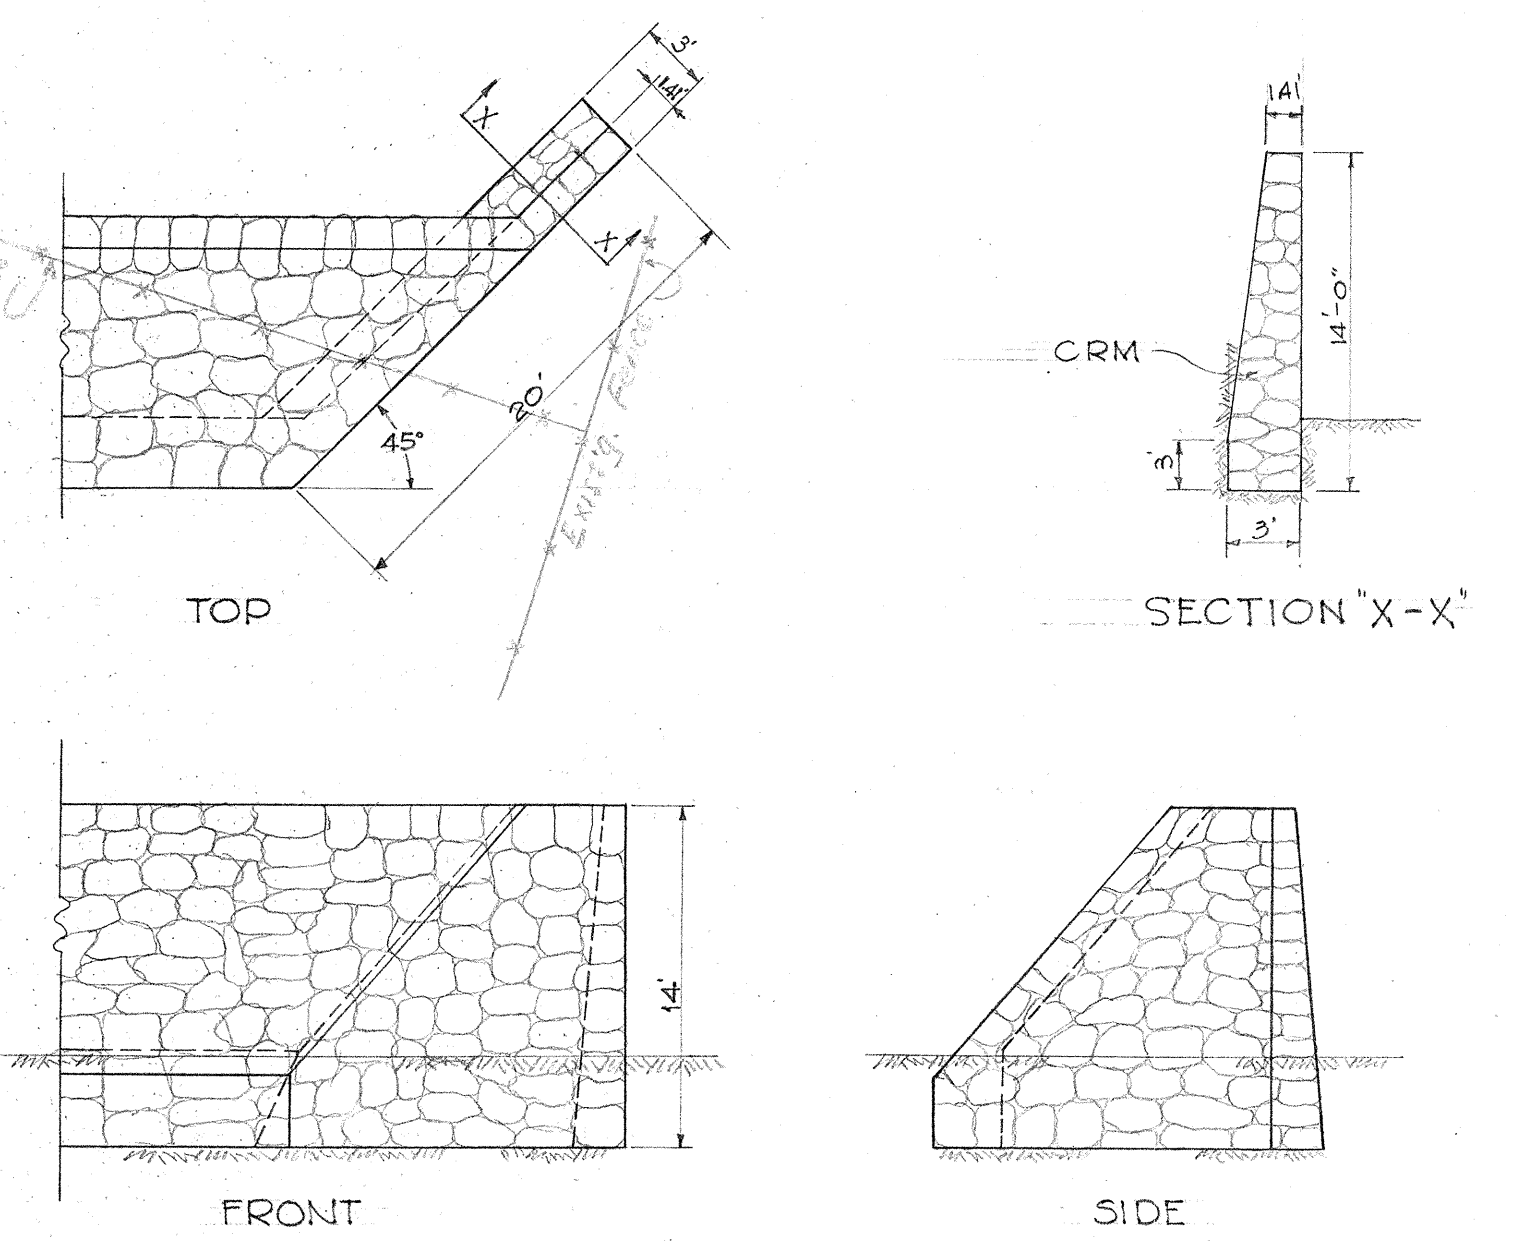
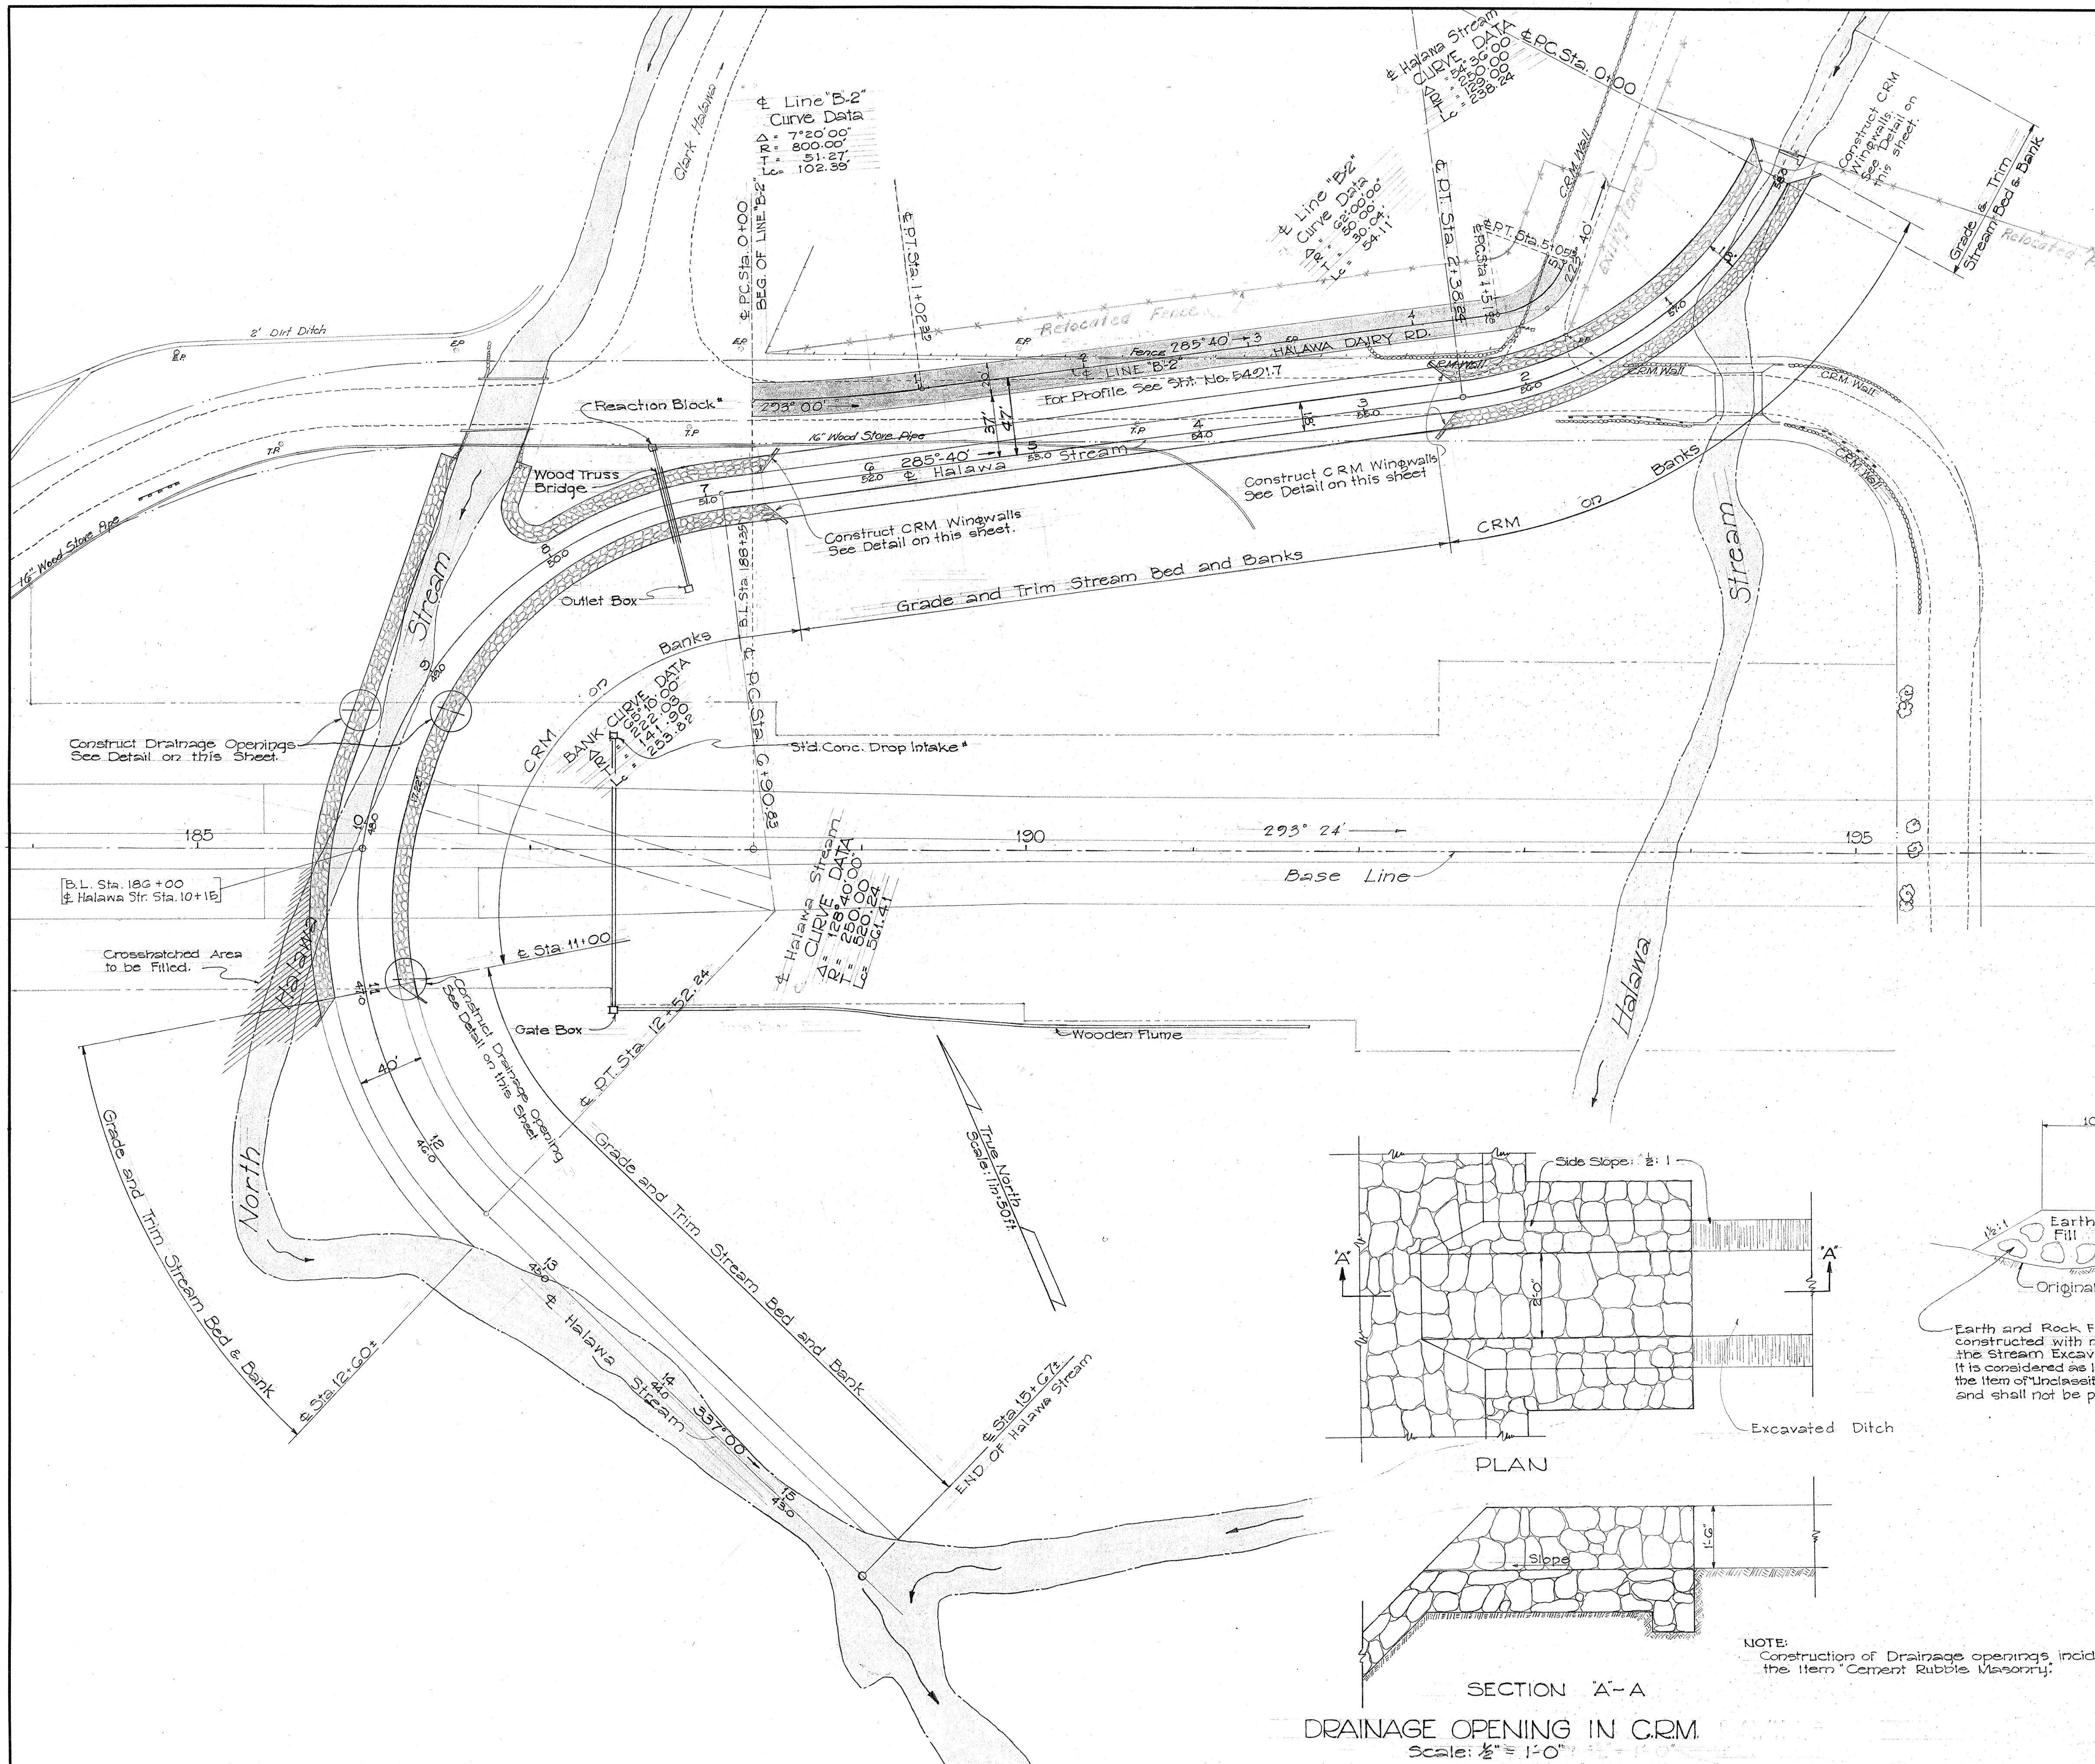


| FED. ROAD DIST. NO. | STATE | FED. AID PROJ. NO. | FISCAL YEAR | SHEET NO. | TOTAL SHEETS |
|---------------------|-------|--------------------|-------------|-----------|--------------|
| HAWAII              | HAW.  | 5219(4)            | 1952        | 45        | 102          |

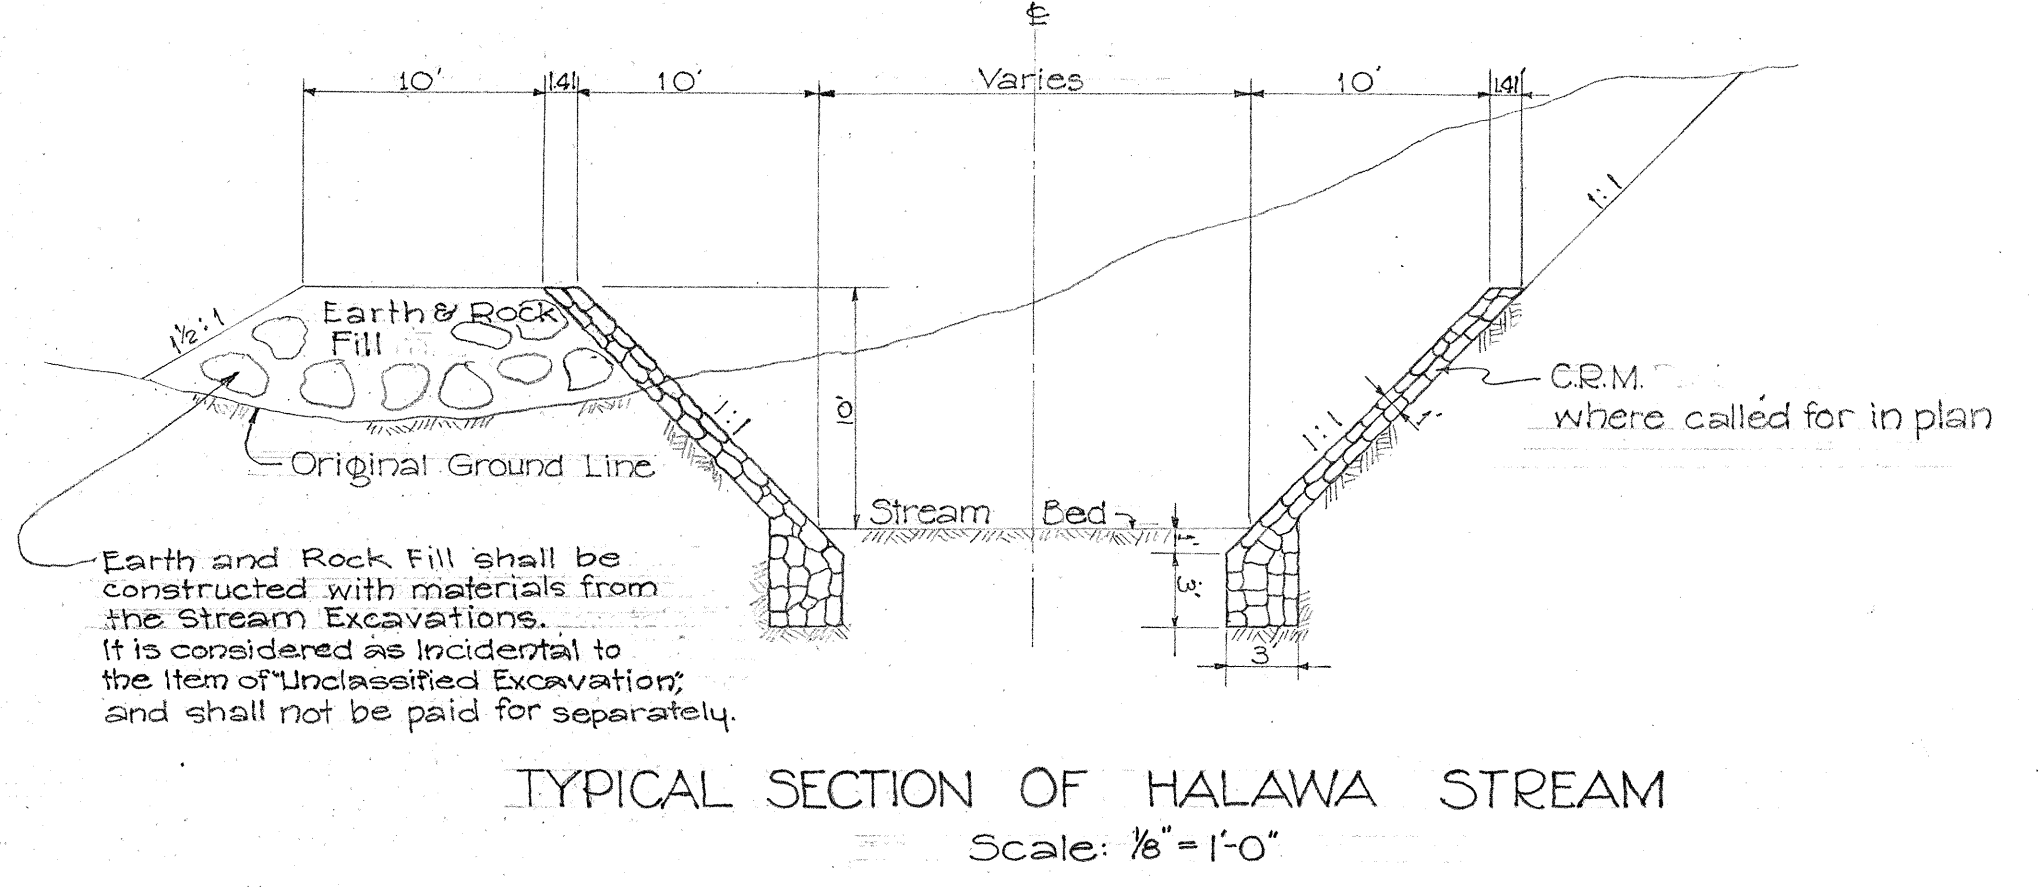

NOTE:  
For Profile of South Halawa Stream, See Sht. No. 5491.15

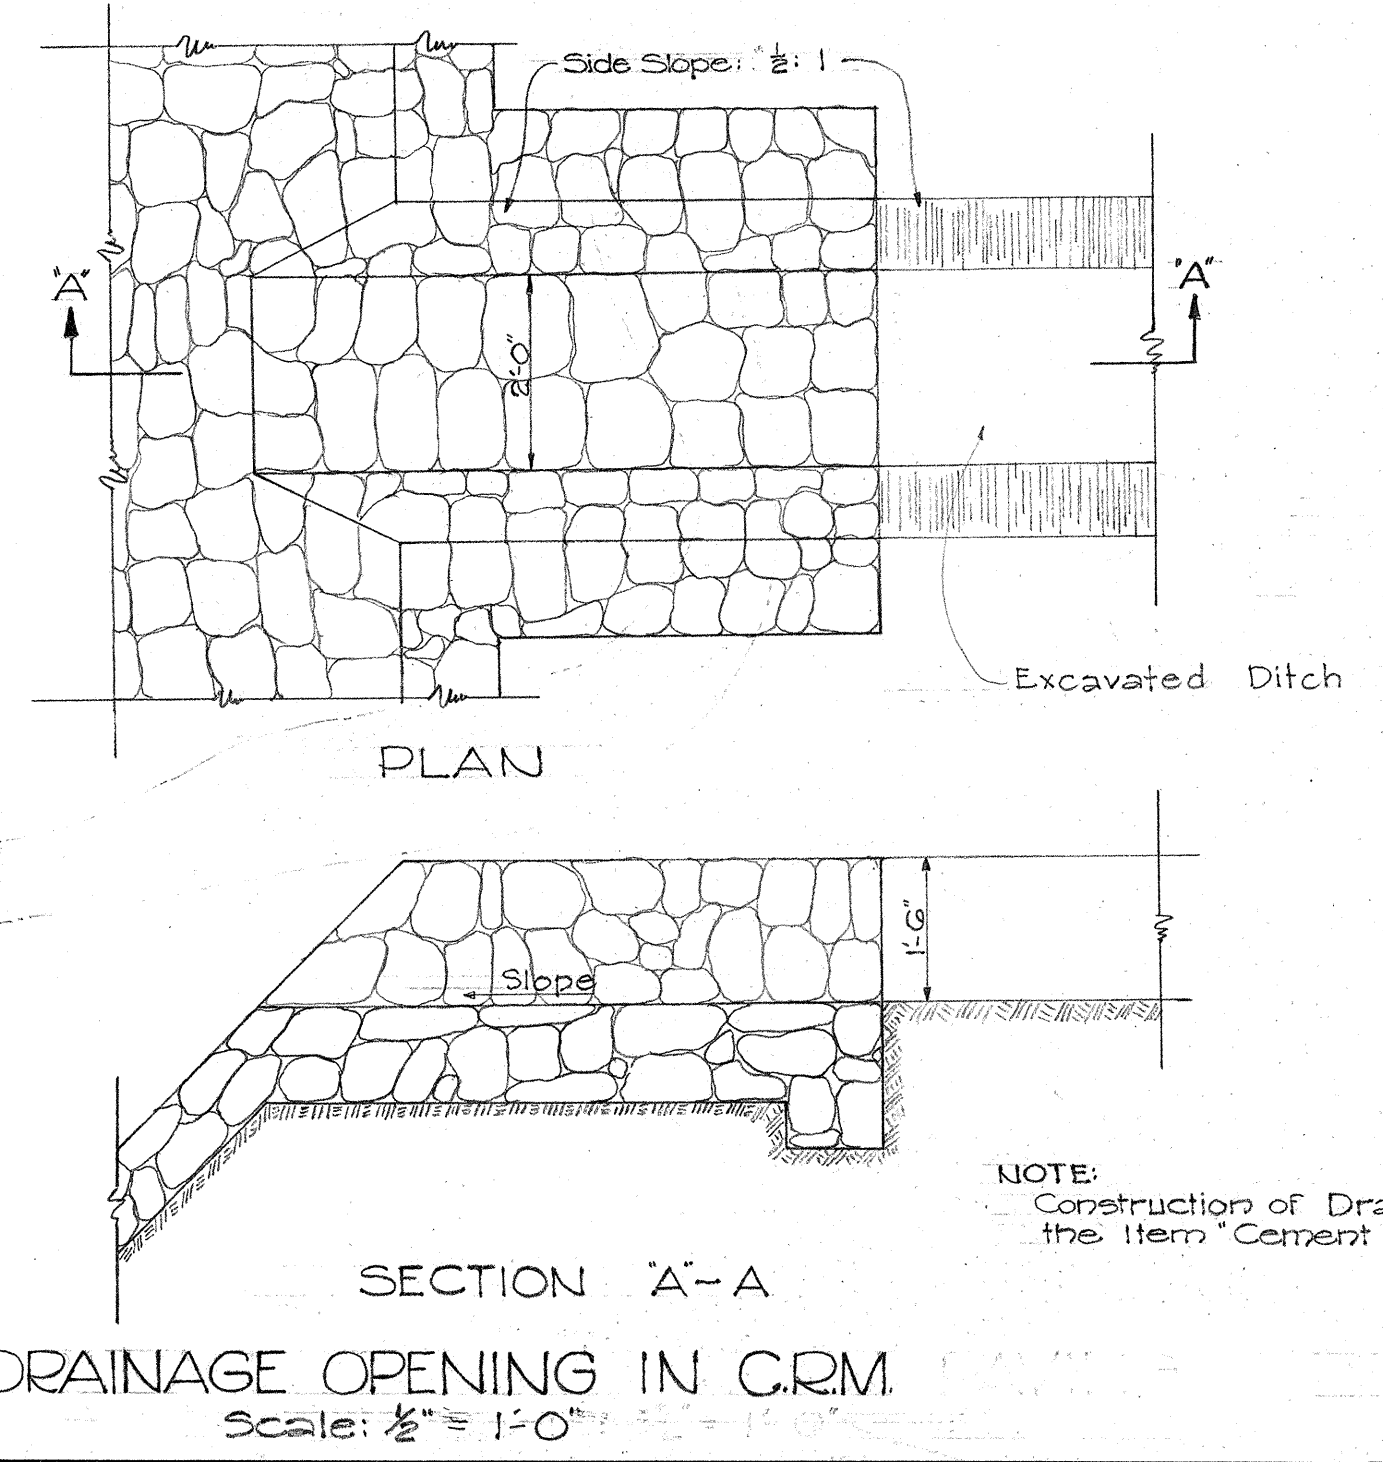

TERRITORIAL HIGHWAY DEPARTMENT  
TERRITORY OF HAWAII  
STREAM REALIGNMENT  
SOUTH HALAWA STREAM  
MOANALUA ROAD  
PROJECT NO. S 219 (4)  
Scale: As Indicated February, 1952



