

INDEX TO DRAWINGS	
SHEET NO.	DESCRIPTION
1	TITLE SHEET
2 - 3	TYPICAL SECTIONS
4 - 16	PLAN & PROFILE
17 - 24	DETAIL PLAN OF INTERSECTIONS
25 - 30	RELOCATION OF 42 INCH WATER MAIN
31 - 38	TRAFFIC SIGNS & PAVEMENT MARKINGS
39 - 43	HALAWA BRIDGE PLANS
44	WOOD TRUSS BRIDGE & IRRIGATION DETAILS
45 - 46	STREAM REALIGNMENT
47 - 48	SPECIAL DETAILS
49 - 51	STANDARD DETAILS
52 - 109	CROSS SECTIONS


FED. ROAD DIST. NO.	STATE	FED. AID PROJ. NO.	FISCAL YEAR	SHEET NO.	TOTAL SHEETS
HAWAII	HAW.	S 219(4)	1952	1	109

TERRITORY OF HAWAII
TERRITORIAL HIGHWAY DEPARTMENT
HONOLULU, OAHU, T. H.

PLANS OF MOANALUA ROAD FEDERAL AID SECONDARY PROJECT NO. S 219 (4) EWA & HONOLULU DISTRICTS, ISLAND OF OAHU

CONVENTIONAL SIGNS	
Base Line or Centerline	125
Boundary Lines	OF
Fences (Named)	
Existing Roadways	
Circular Culvert	
Box Culvert	
Bridge	
Telephone Pole	
Electric Power Pole	
Water Main	W ₂ W ₂ (W ₄ & Etc.)
Storm Drain	SD ₁₂ SD ₁₂ (40 & 24 Etc.)
Concrete Drop Inlet	
Standard Catch Basin	
Standard Manhole	
Sewer Manhole	
Telephone Manhole	
Fire Hydrant	
Tree (Large, named)	
Railroad	


SCALES	
PLAN	1 INCH = 50 FEET
PROFILE	HOR. 1 INCH = 50 FEET VER. 1 INCH = 10 FEET
CROSS SECTION	HOR. 1 INCH = 10 FEET VER. 1 INCH = 10 FEET

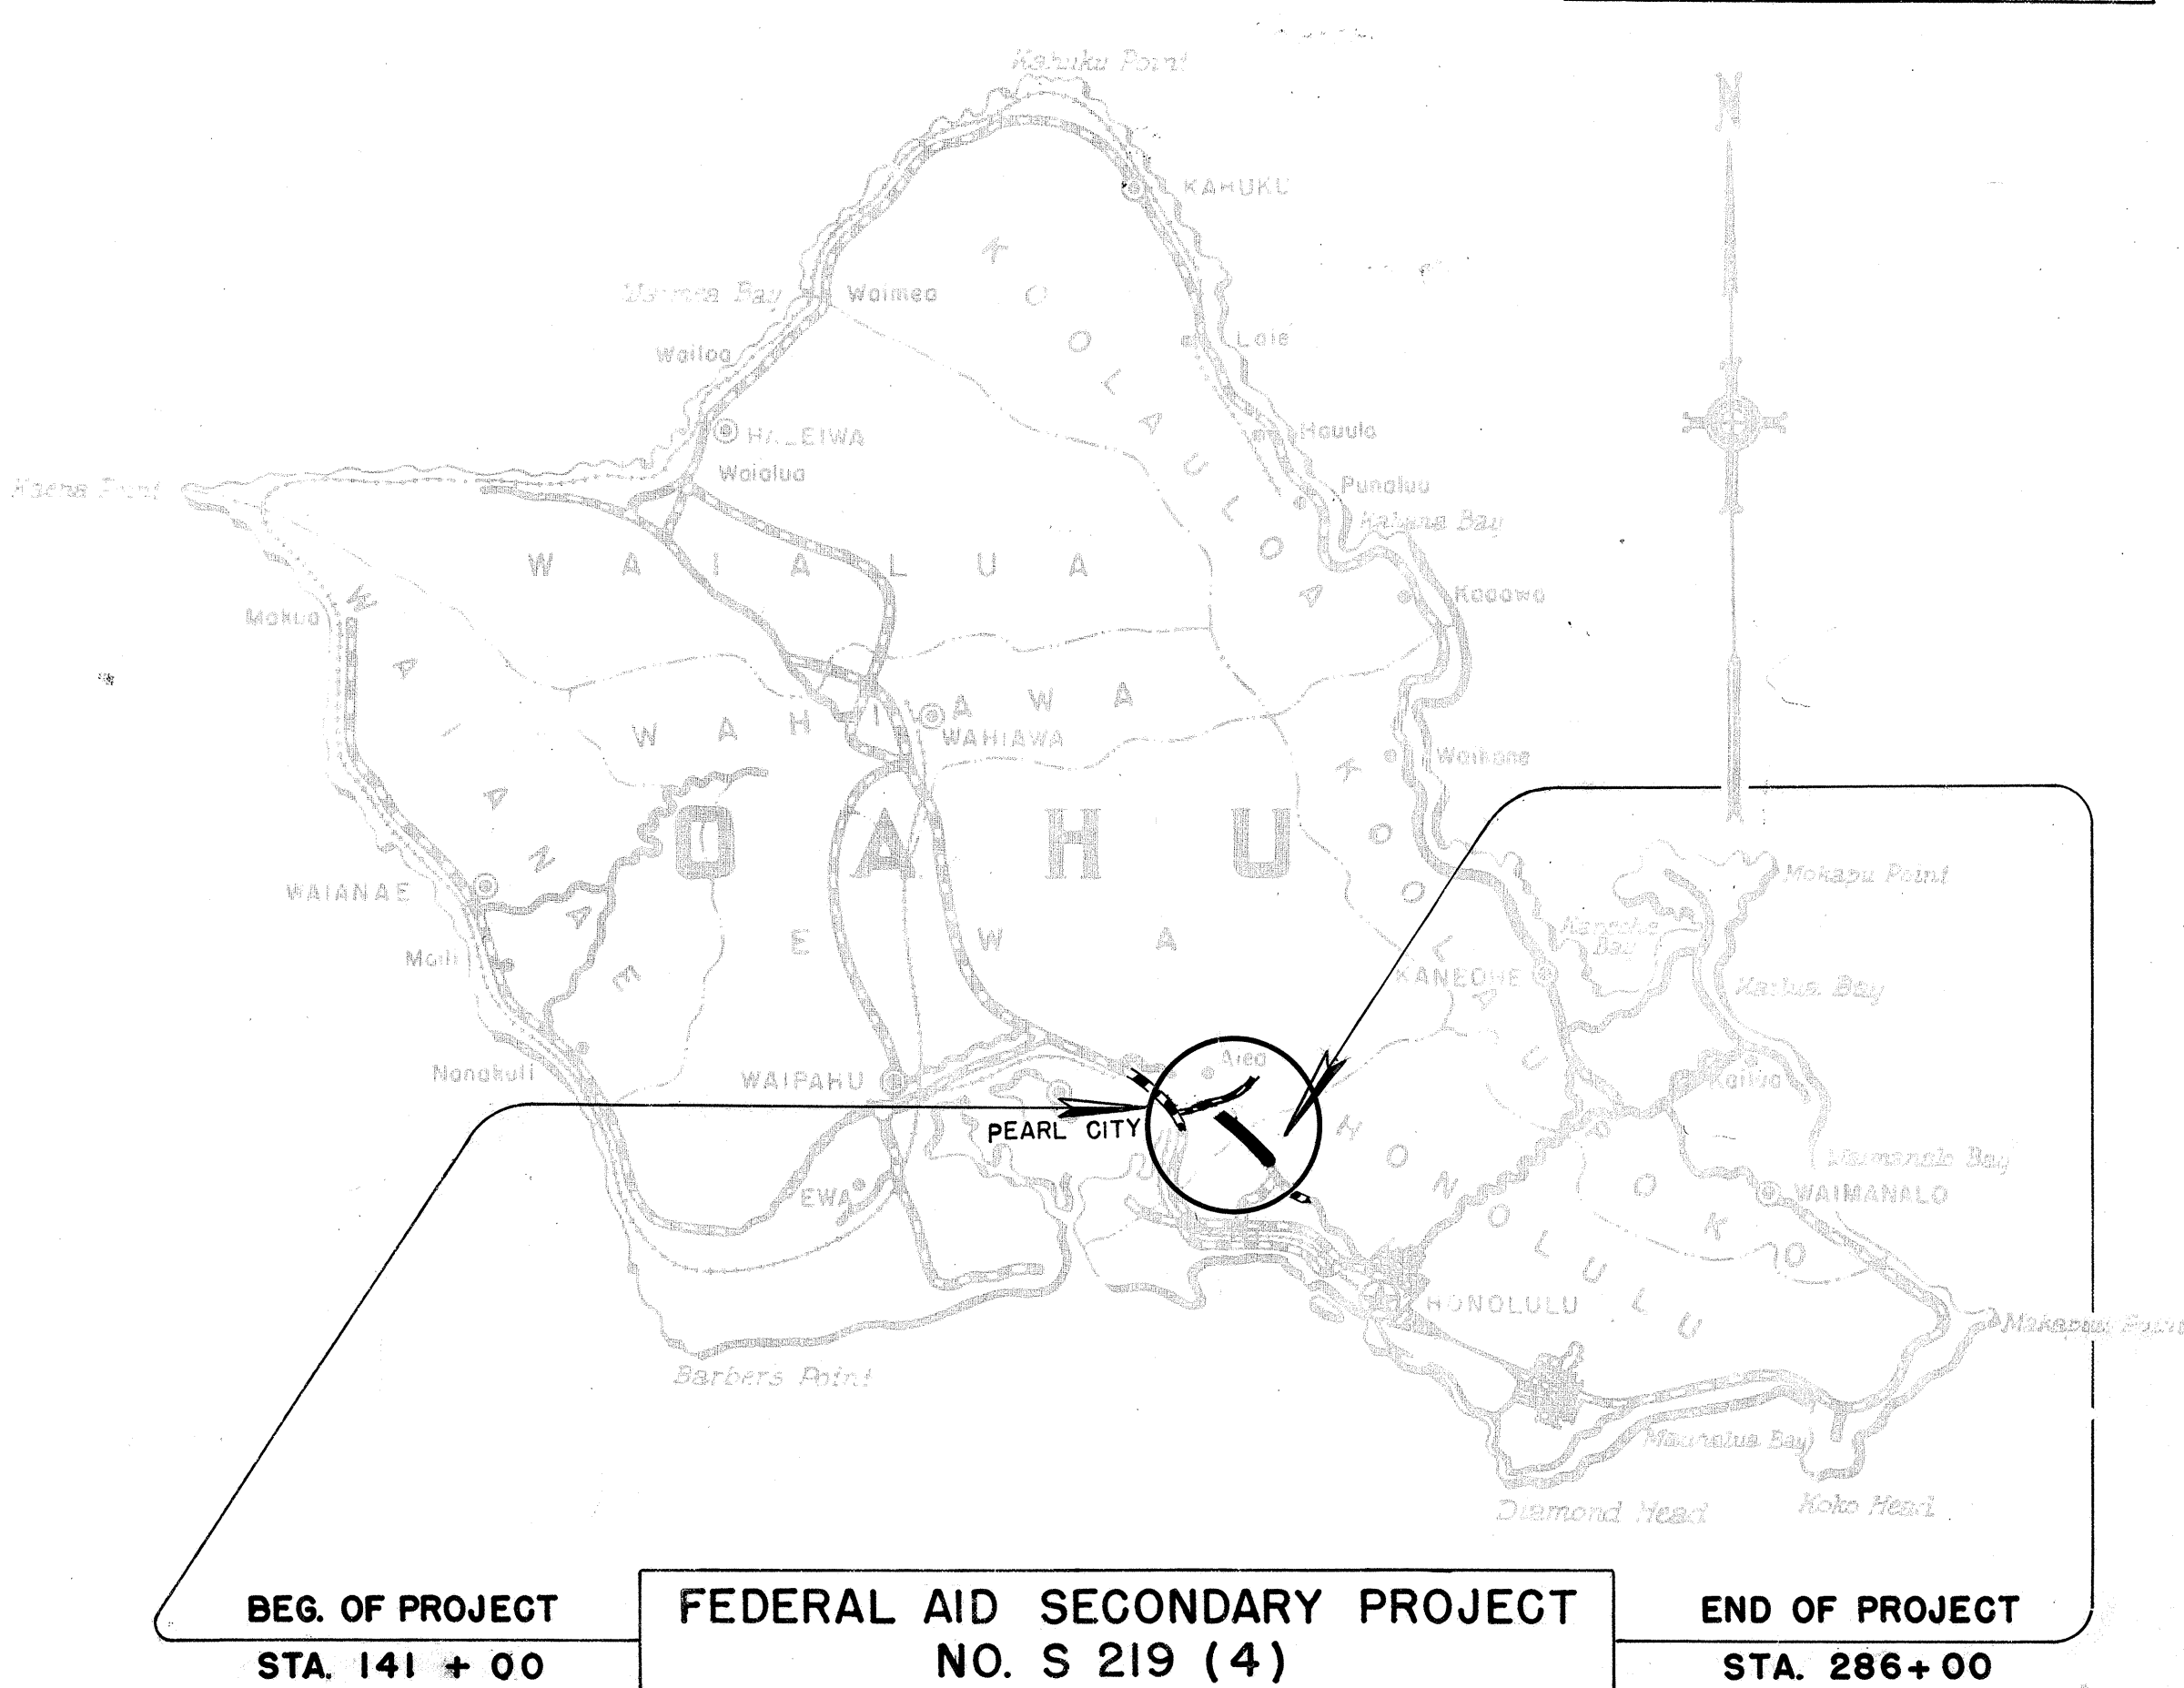

Federal Aid Projects Previously Constructed Or Under Construction

NOTE: ALL CHANGES MADE DURING CONSTRUCTION
HAVE BEEN SHOWN IN RED ON THESE
SHEETS AND ARE CHECKED BY

George Shikano
PROJECT ENGINEER
12/2/54
DATE

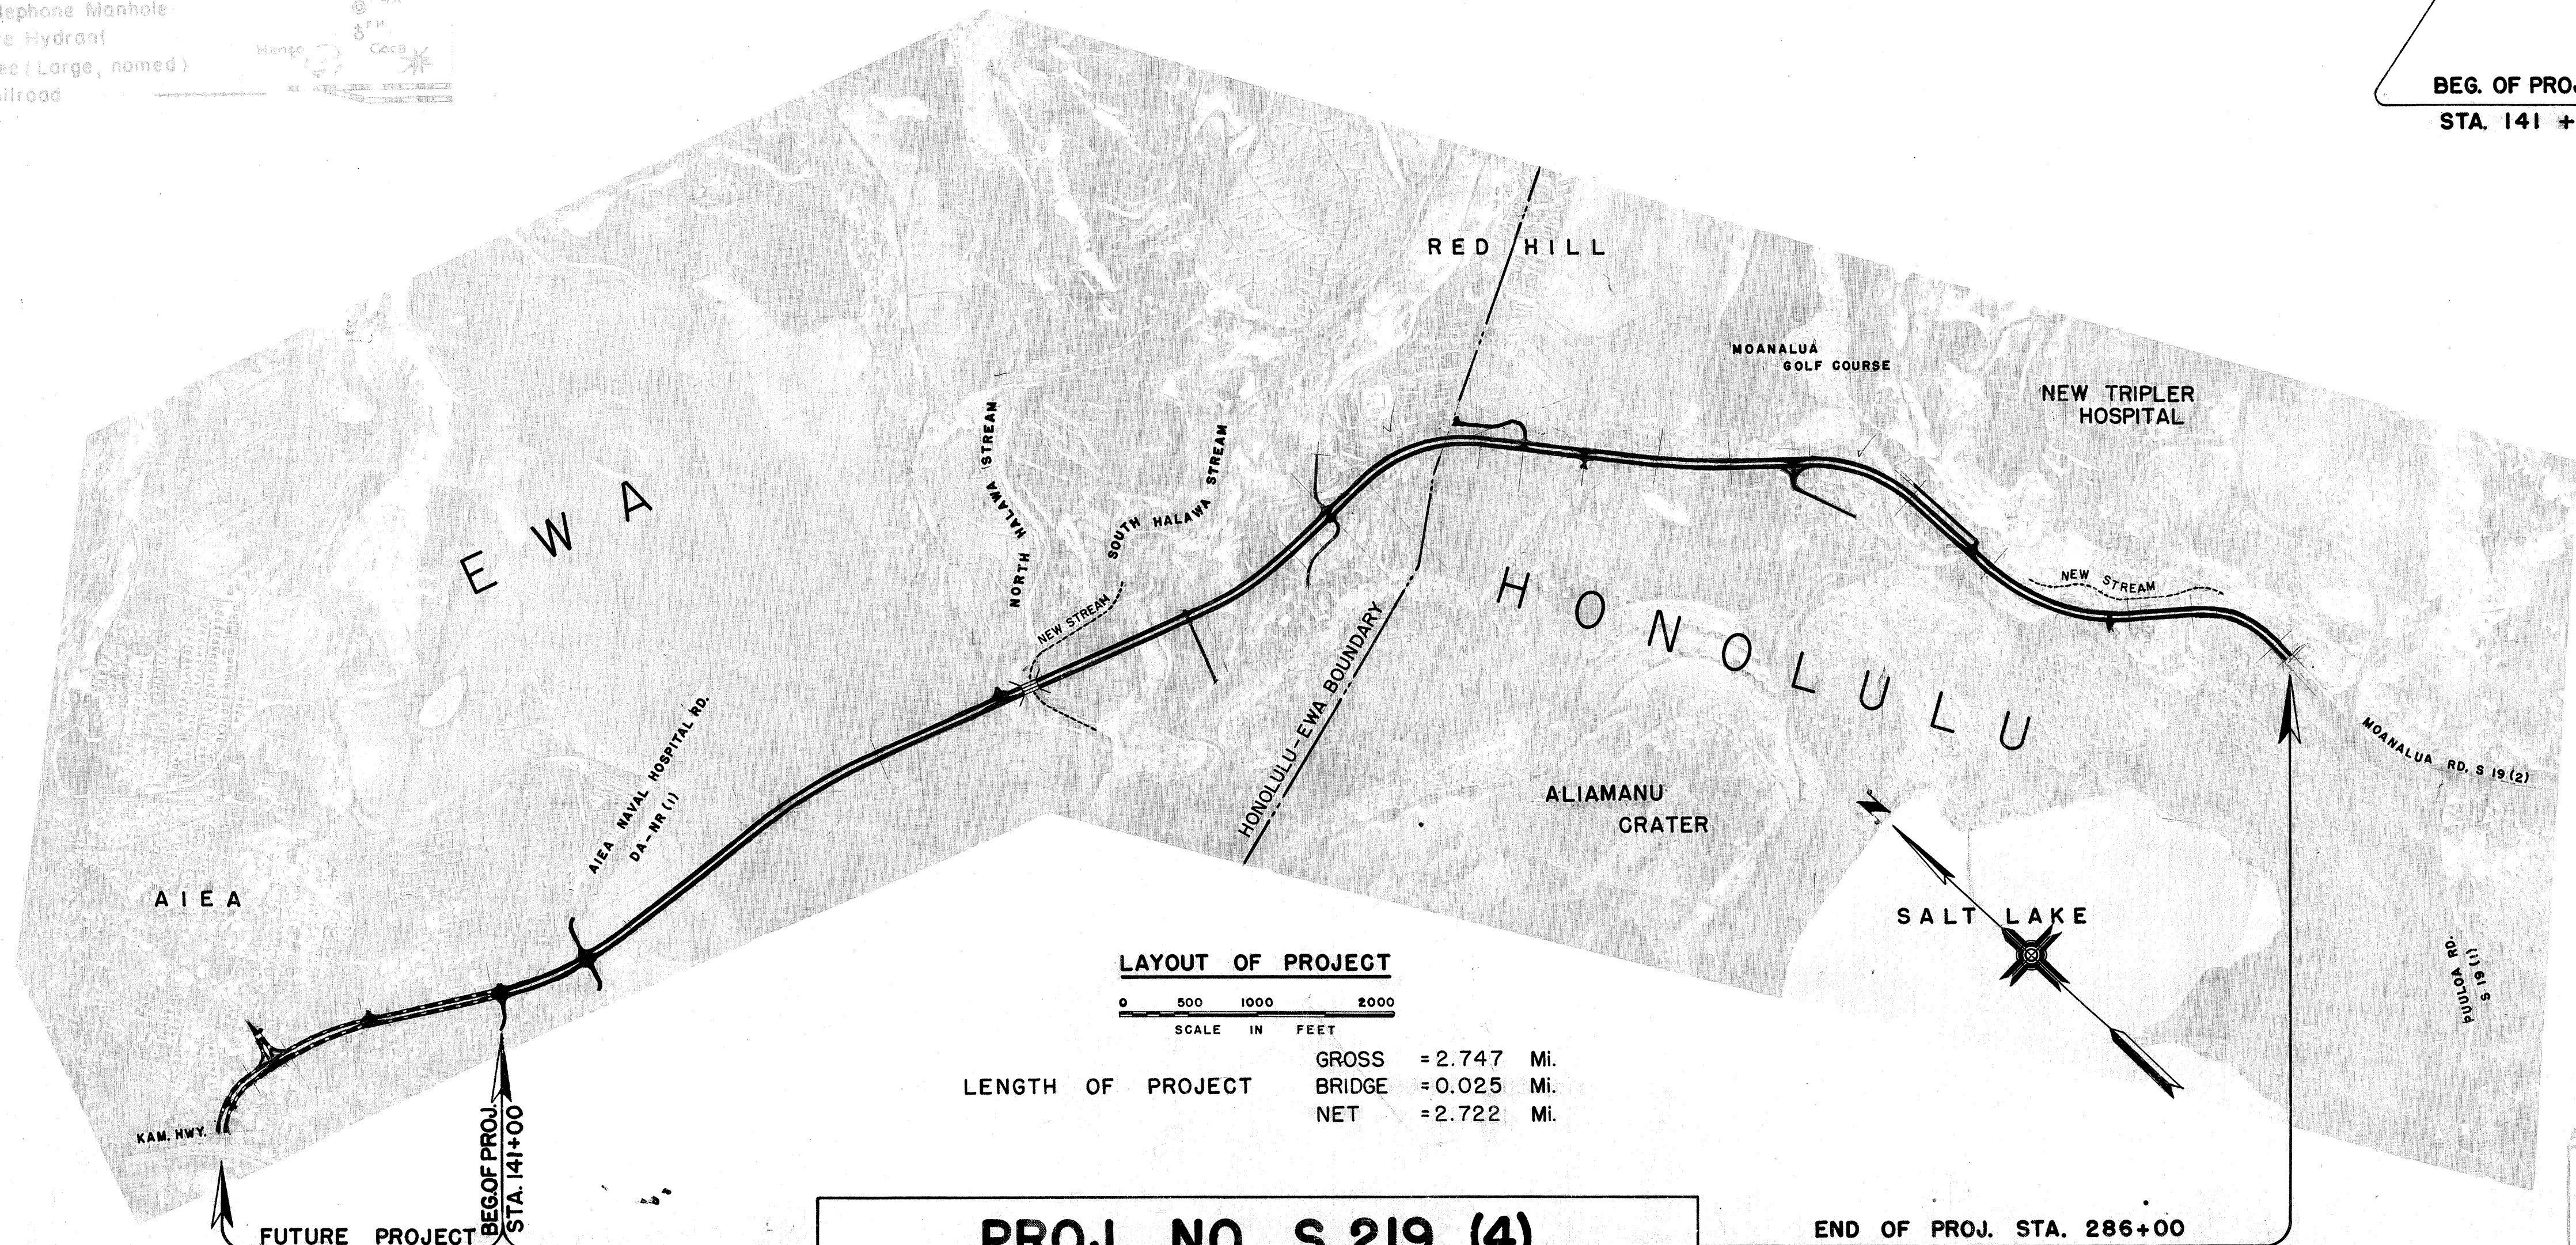

LAYOUT OF PROJECT	
0	500 1000 2000
SCALE	IN FEET

LENGTH OF PROJECT	GROSS	= 2.747	Mi.
	BRIDGE	= 0.025	Mi.
	NET	= 2.722	Mi.

APPROVED *Don Bell* DATE 10-16-52
TERRITORIAL HIGHWAY ENGINEER

DEPARTMENT OF COMMERCE BUREAU OF PUBLIC ROADS	
RECOMMENDED FOR APPROVAL:	
DISTRICT ENGINEER	DATE
APPROVED:	
DIVISION ENGINEER	DATE