




TYPICAL SECTION ON TANGENTS
Scale: 1/4" = 1'-0"

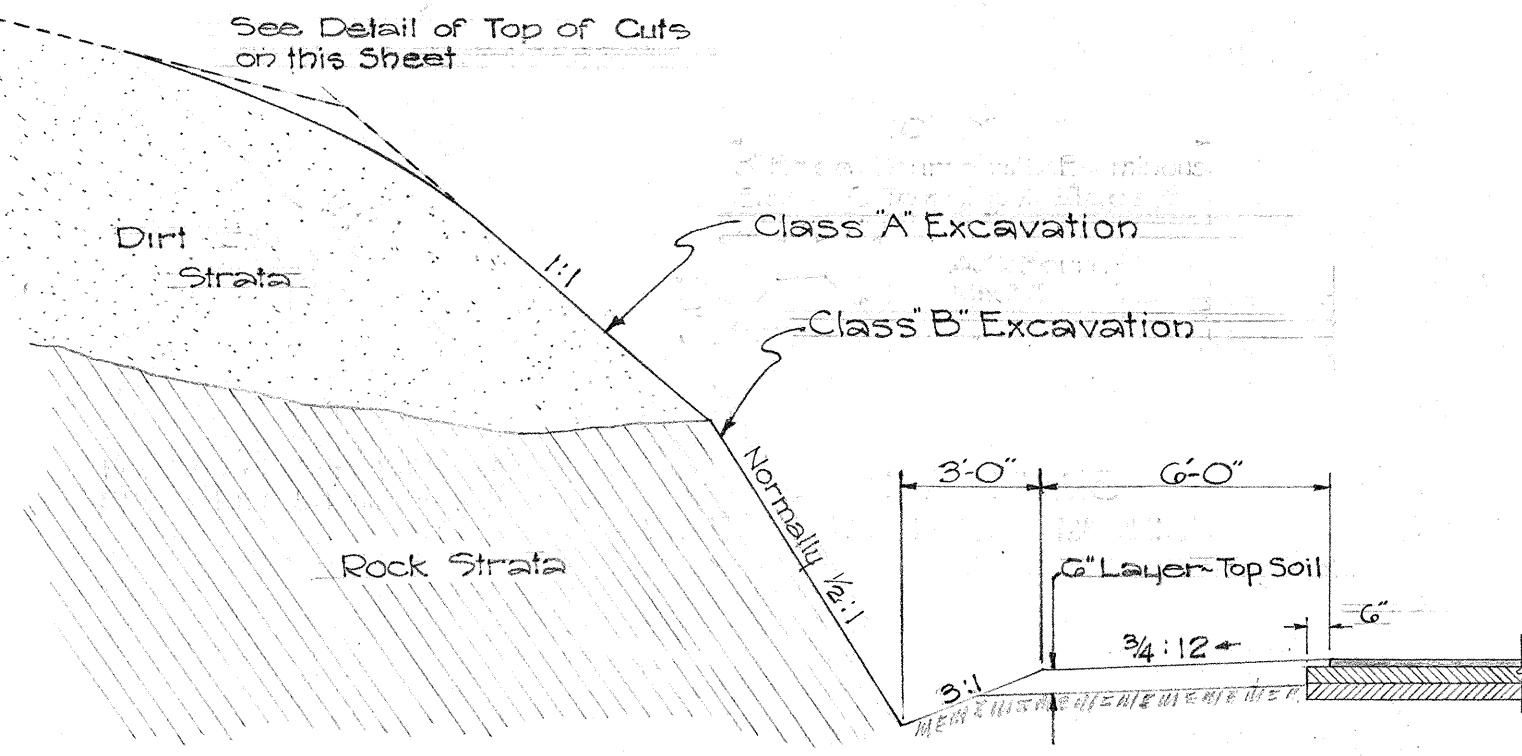


TYPICAL CUT SECTION IN DIRT AND ROCK
Scale: 1/4" = 1'-0"

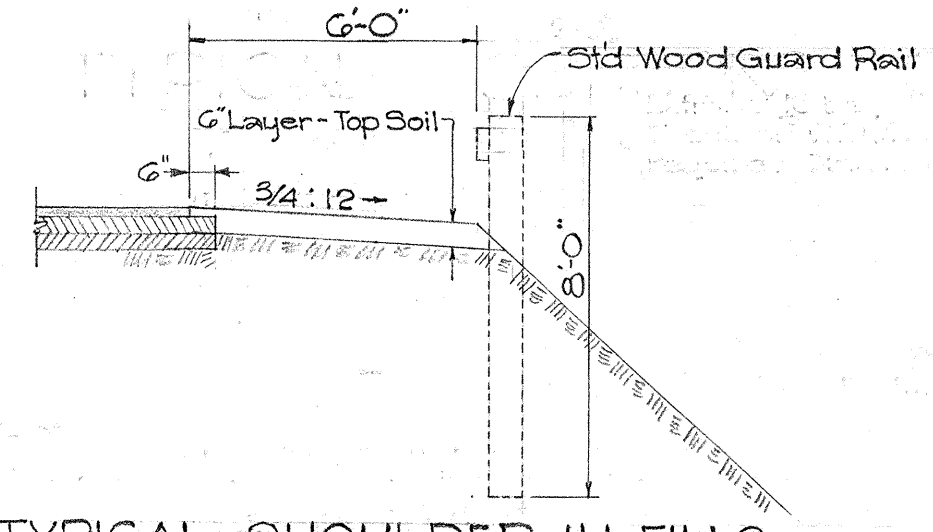


TYPICAL SHOULDER IN FILLS
Scale: 1/4" = 1'-0"

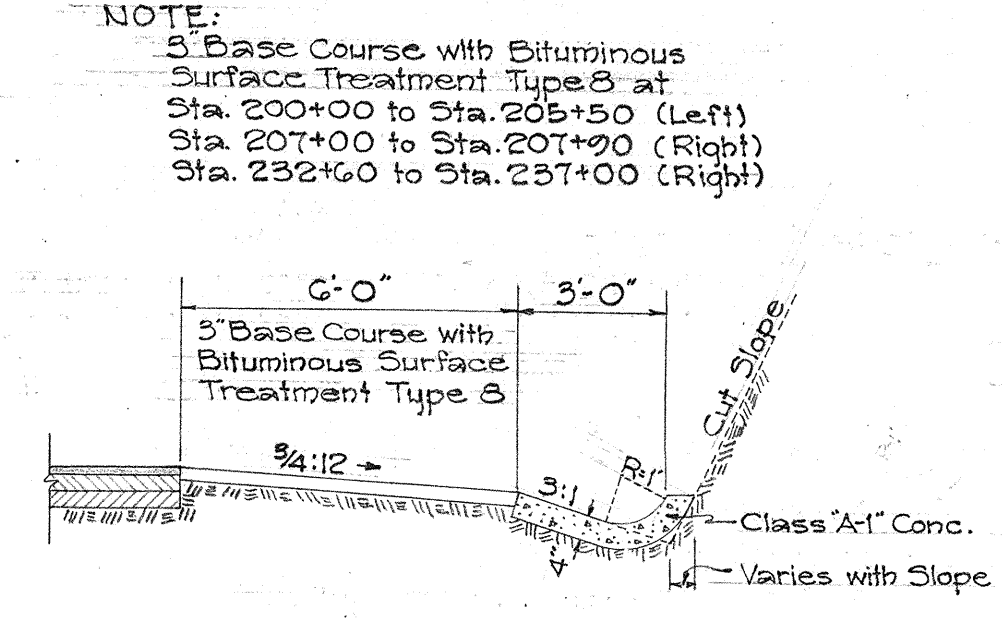


TYPICAL SHOULDER IN CUTS WITH TYPE 'A' CONC. GUTTER
Scale: 1/4" = 1'-0"

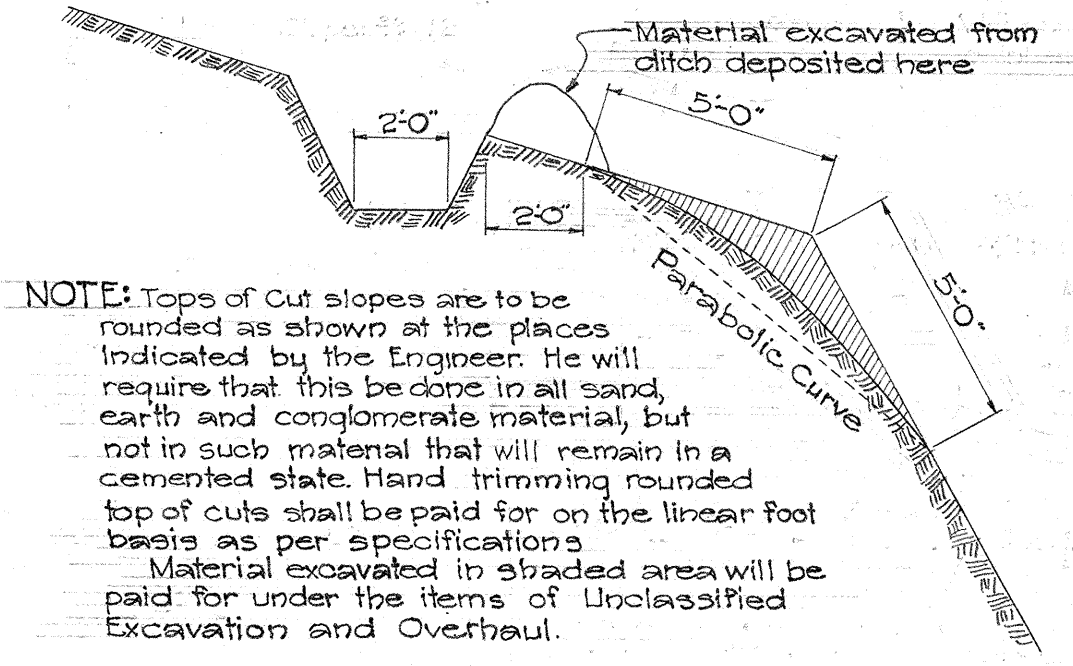


FURROW DITCH AT TOP OF CUT
Scale: 1/4" = 1'-0"

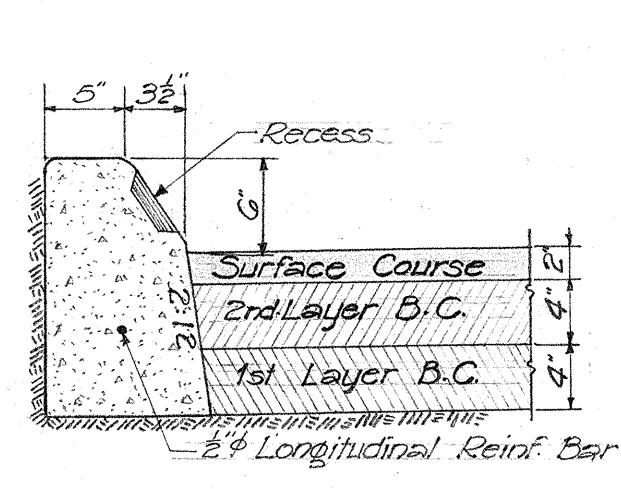


TYPE 'A' & 'B' CURB
Scale: 1" = 1'-0"

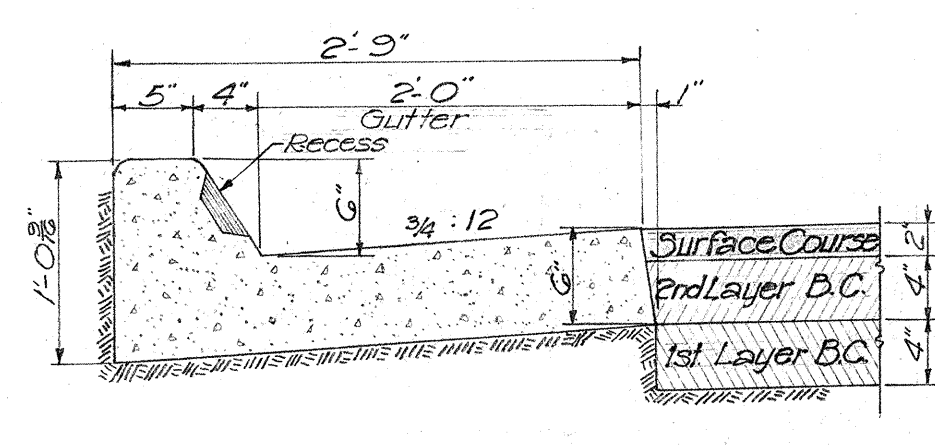


TYPE 'AG' & 'BG' CURB & GUTTER
Scale: 1" = 1'-0"

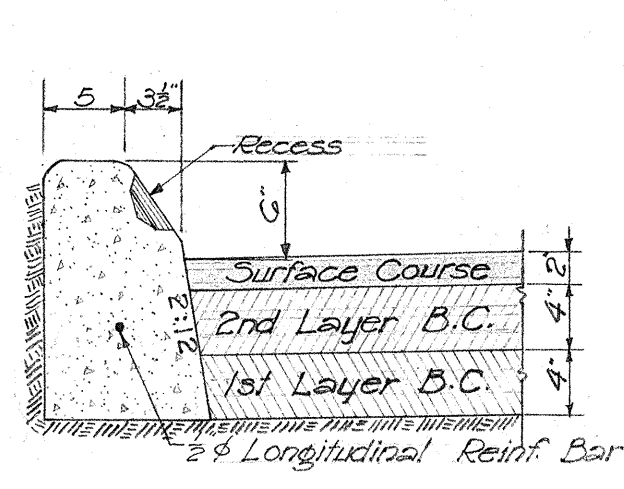


TYPE 'C' CURB
Scale: 1" = 1'-0"

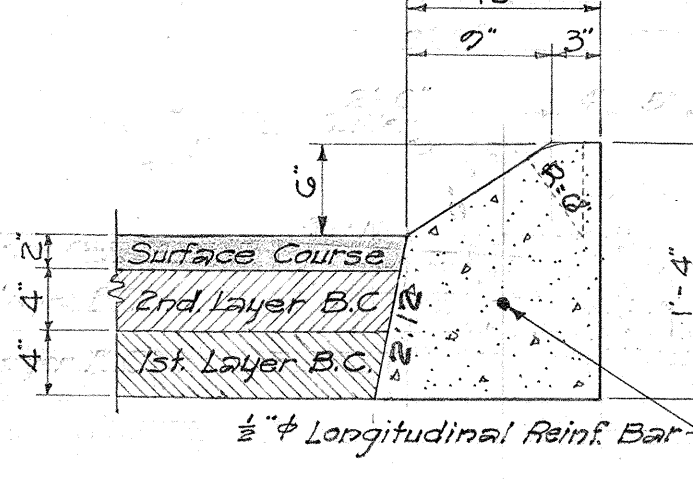


TYPE 'E' CURB
Scale: 1" = 1'-0"

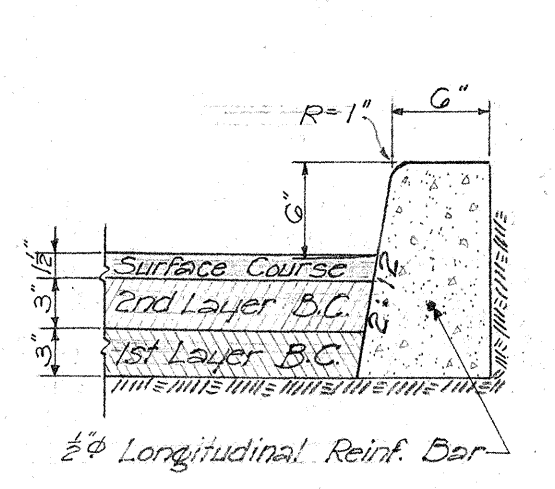

TYPE 'D-1' CURB
Scale: 1" = 1'-0"

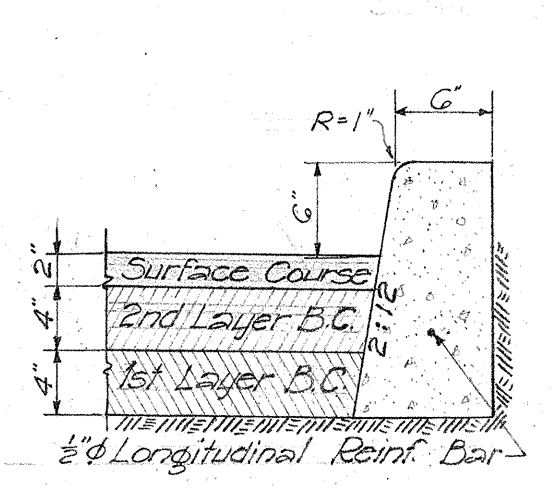


TYPE 'D-2' CURB
Scale: 1" = 1'-0"

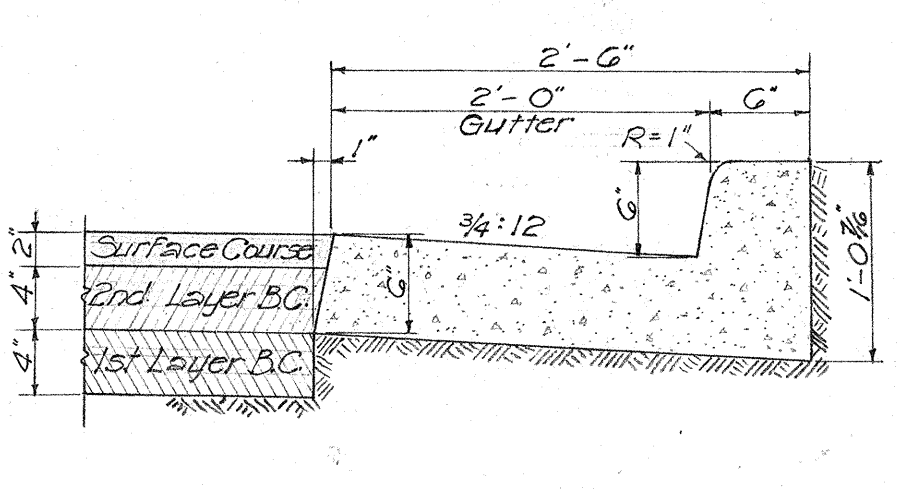


TYPE 'DG' CURB & GUTTER
Scale: 1" = 1'-0"

NOTE:
Types 'AG', 'BG', 'CG' & 'DG' Concrete Curbs and Gutters shall be poured monolithically.
Types 'A', 'B' & 'C' Concrete Curbs and Types 'AG', 'BG' & 'CG' Concrete Curbs and Gutters occur at Medial Strips and Traffic Islands.
Shaded Area in Curbs shall be painted with approved white laquer (one coat).
All Concrete Curbs and Gutters shown herein shall be of Class 'A-1' Concrete and Cast in Place.
Where Catch Basins are to be constructed in median strips the face of conc. curbs adjacent to the catch basins shall have transition of not less than 10 feet. Top slab of conc. catch basin shall be sloped to the finished grades of sidewalk, shoulder or median strip.

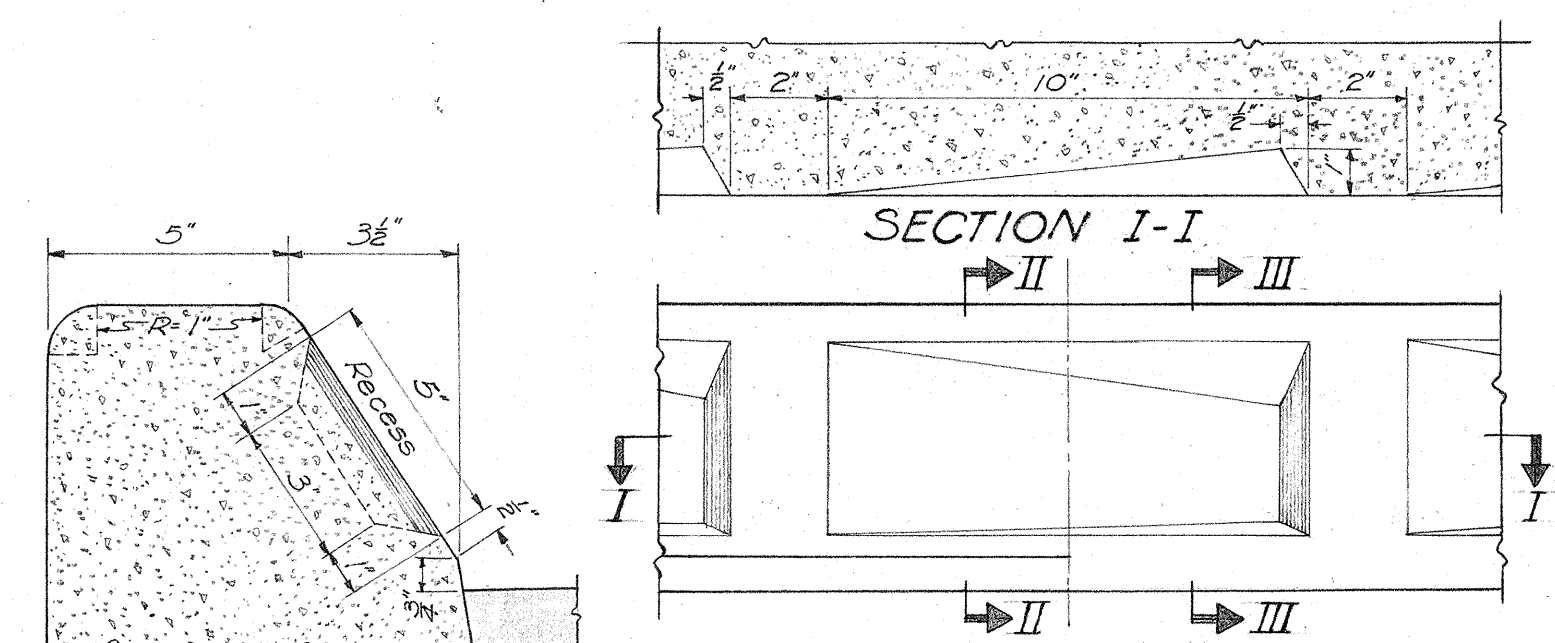


SECTION II-II
TYPE 'A' & 'B' CURB
Scale: 3" = 1'-0"

THIS TYPE AND SPACING OF RECESSES SHALL BE USED FOR TYPE 'A' CURB & TYPE 'AG' CURB & GUTTER

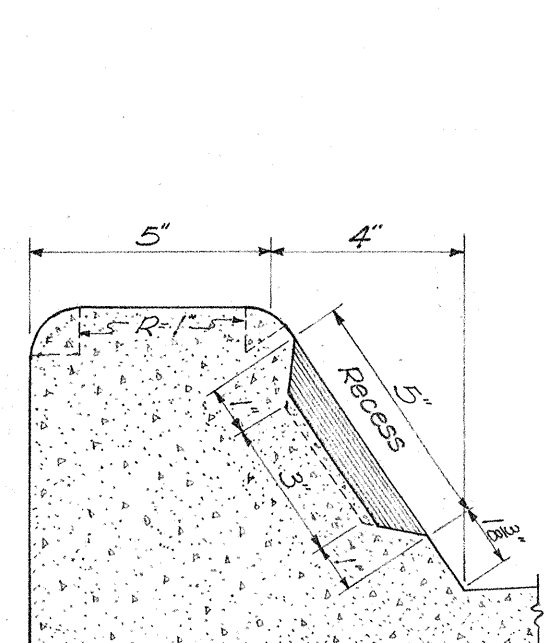


SECTION III-III
TYPE 'AG' & 'BG' CURB
Scale: 3" = 1'-0"

THIS TYPE AND SPACING OF RECESSES SHALL BE USED FOR TYPE 'B' CURB & TYPE 'BG' CURB & GUTTER

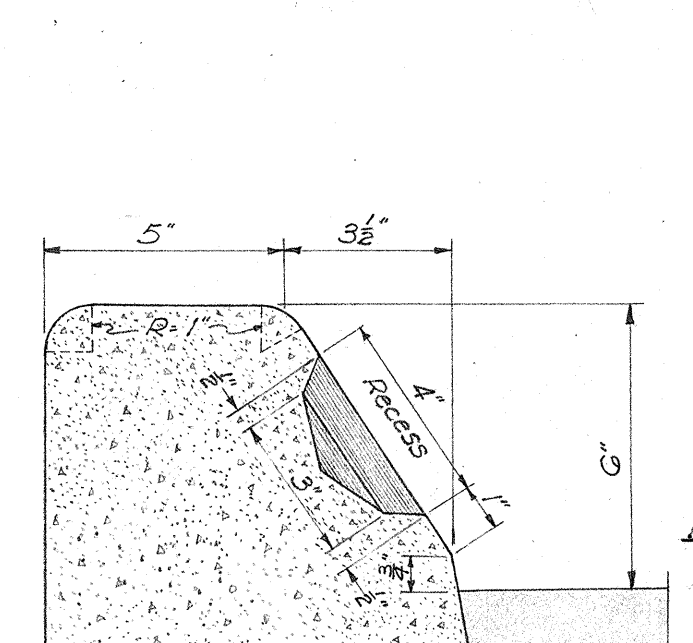


SECTION V-V
TYPE 'C' CURB
Scale: 3" = 1'-0"

THIS TYPE AND SPACING OF RECESSES SHALL BE USED FOR TYPE 'C' CURB & TYPE 'CG' CURB & GUTTER

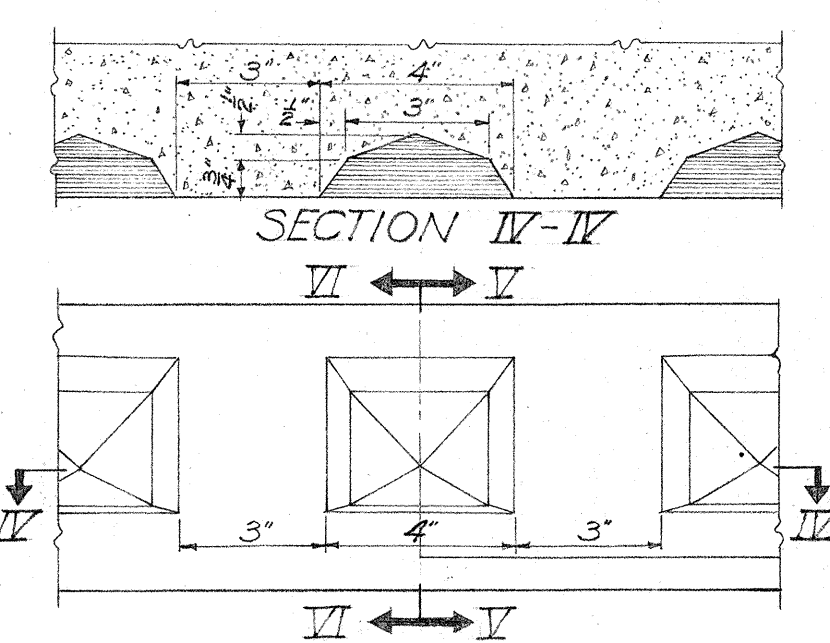

SECTION IV-IV
TYPE 'E' CURB
Scale: 3" = 1'-0"

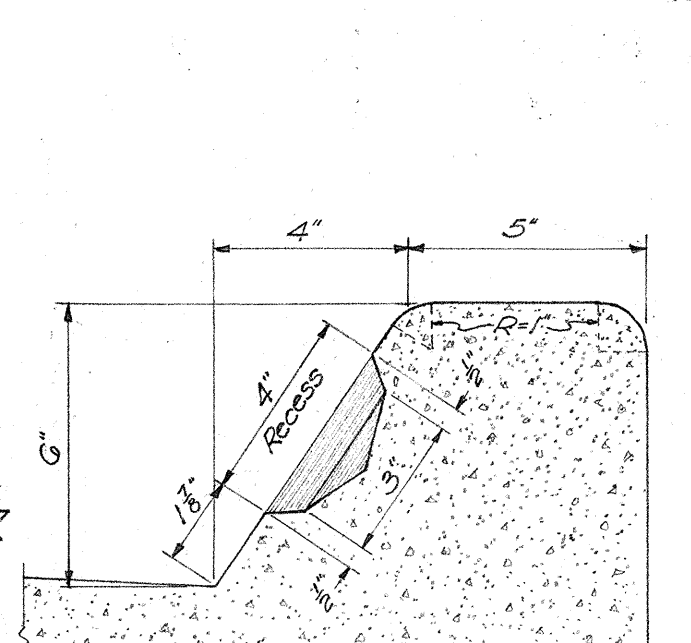


SECTION VI-VI
TYPE 'D-1' CURB
Scale: 3" = 1'-0"

THIS TYPE AND SPACING OF RECESSES SHALL BE USED FOR TYPE 'D-1' CURB & TYPE 'D-2' CURB


TERRITORIAL HIGHWAY DEPARTMENT
TERRITORY OF HAWAII
TYPICAL SECTIONS
MOANALUA ROAD
PROJECT NO. S 217 (4)
Scale: As Indicated February 1952

SURVEY PLOTTED BY: _____
 DESIGN BY: _____
 TRACED BY: _____
 QUANTITIES BY: _____
 CHECKED BY: _____
 ORIGINAL PLAN NO. _____
 NOTE BOOK NO. _____


Revised 11-21-52

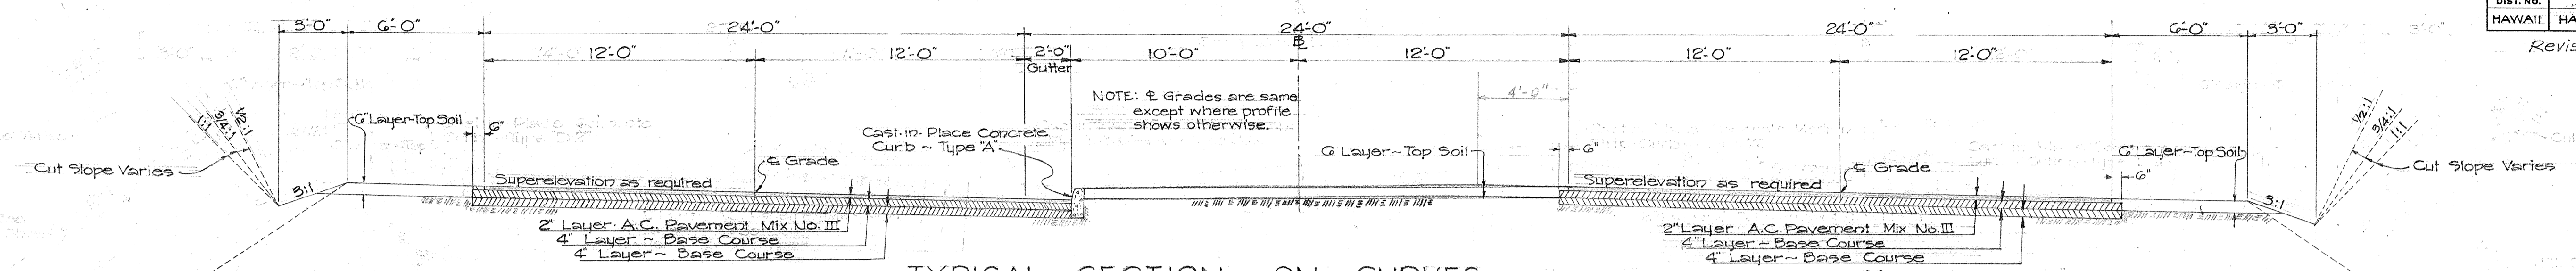

TYPICAL SECTION ON CURVES - From Sta. 141+54.93 to 151+20.20; 256+01.15 to 240+01.15; 246+10.23 to 253+42.22; 275+75.22 to 285+00.22. Scale: 1/4" = 1'-0"

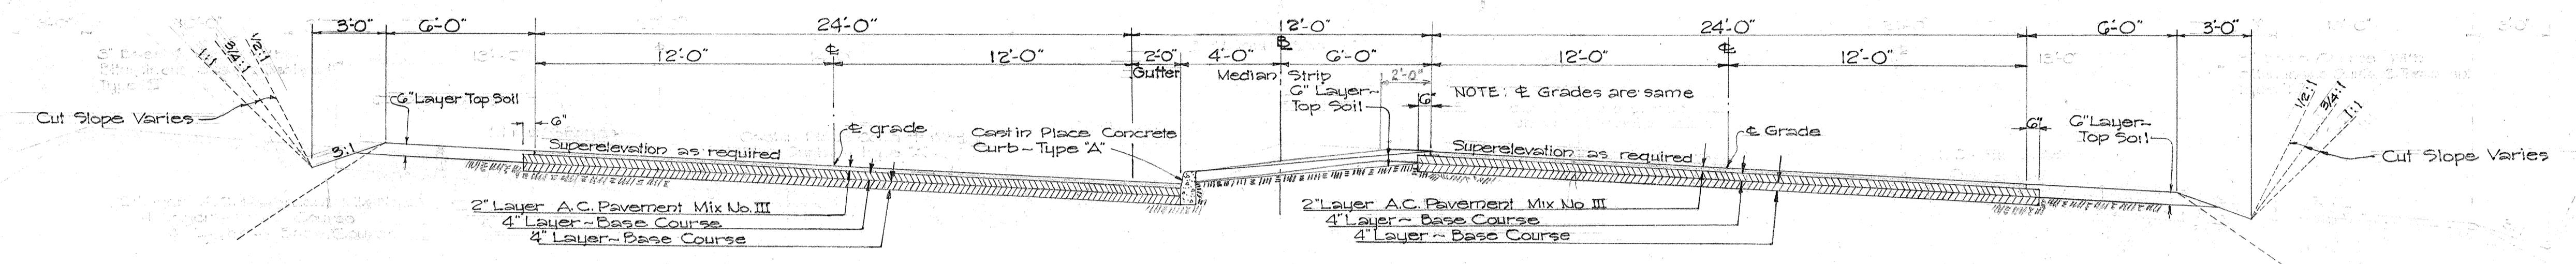


TYPICAL SECTION ON CURVES - From Sta. 162+36.28 to 172+62.23; 178+78.42 to 207+33.23; 260+34.22 to 272+37.12. Scale: 1/4" = 1'-0"

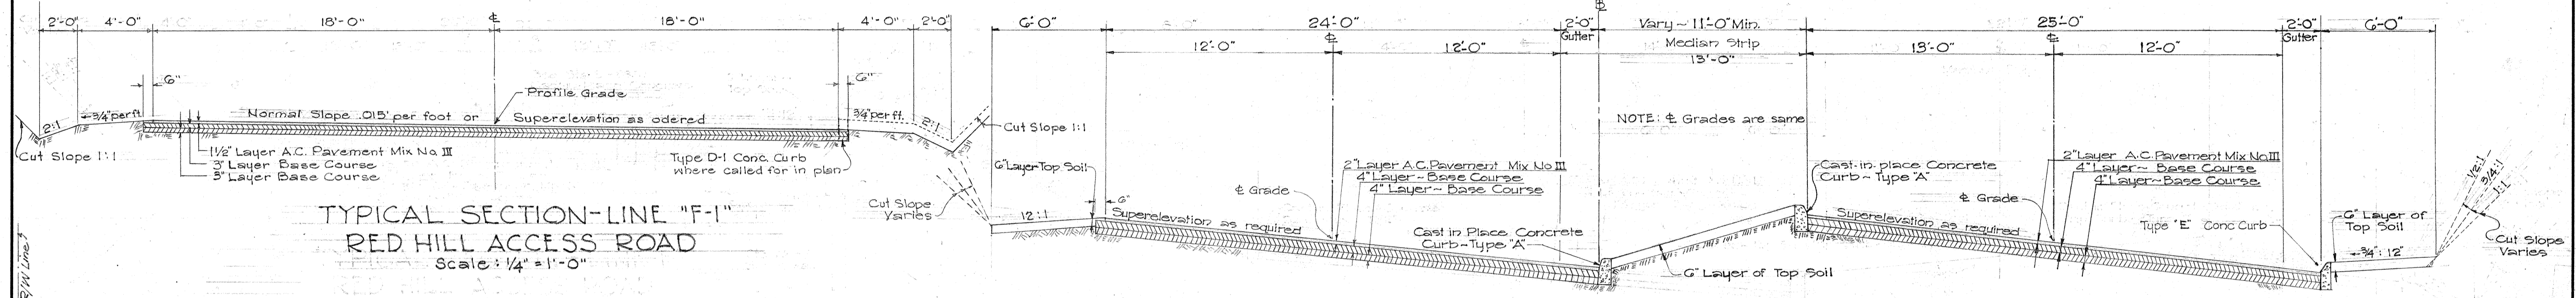


TYPICAL SECTION-LINE "F-1" RED HILL ACCESS ROAD Scale: 1/4" = 1'-0"

TYPICAL SECTION ~ STA. 211+50± TO STA. 224+00± Scale: 1/4" = 1'-0"

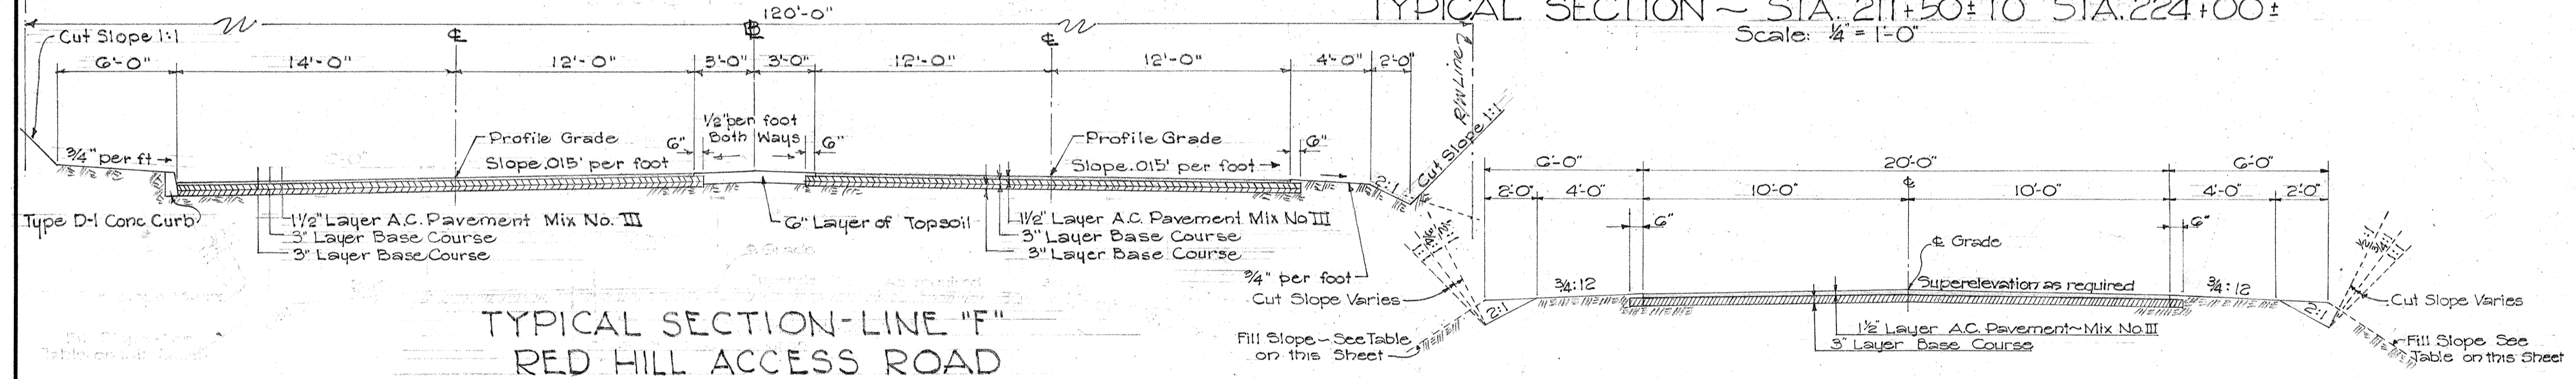


TYPICAL SECTION-LINE "F" RED HILL ACCESS ROAD Scale: 3/16" = 1'-0"


TYPICAL SECTION ~ 20' SIDEROADS Scale: 1/4" = 1'-0"

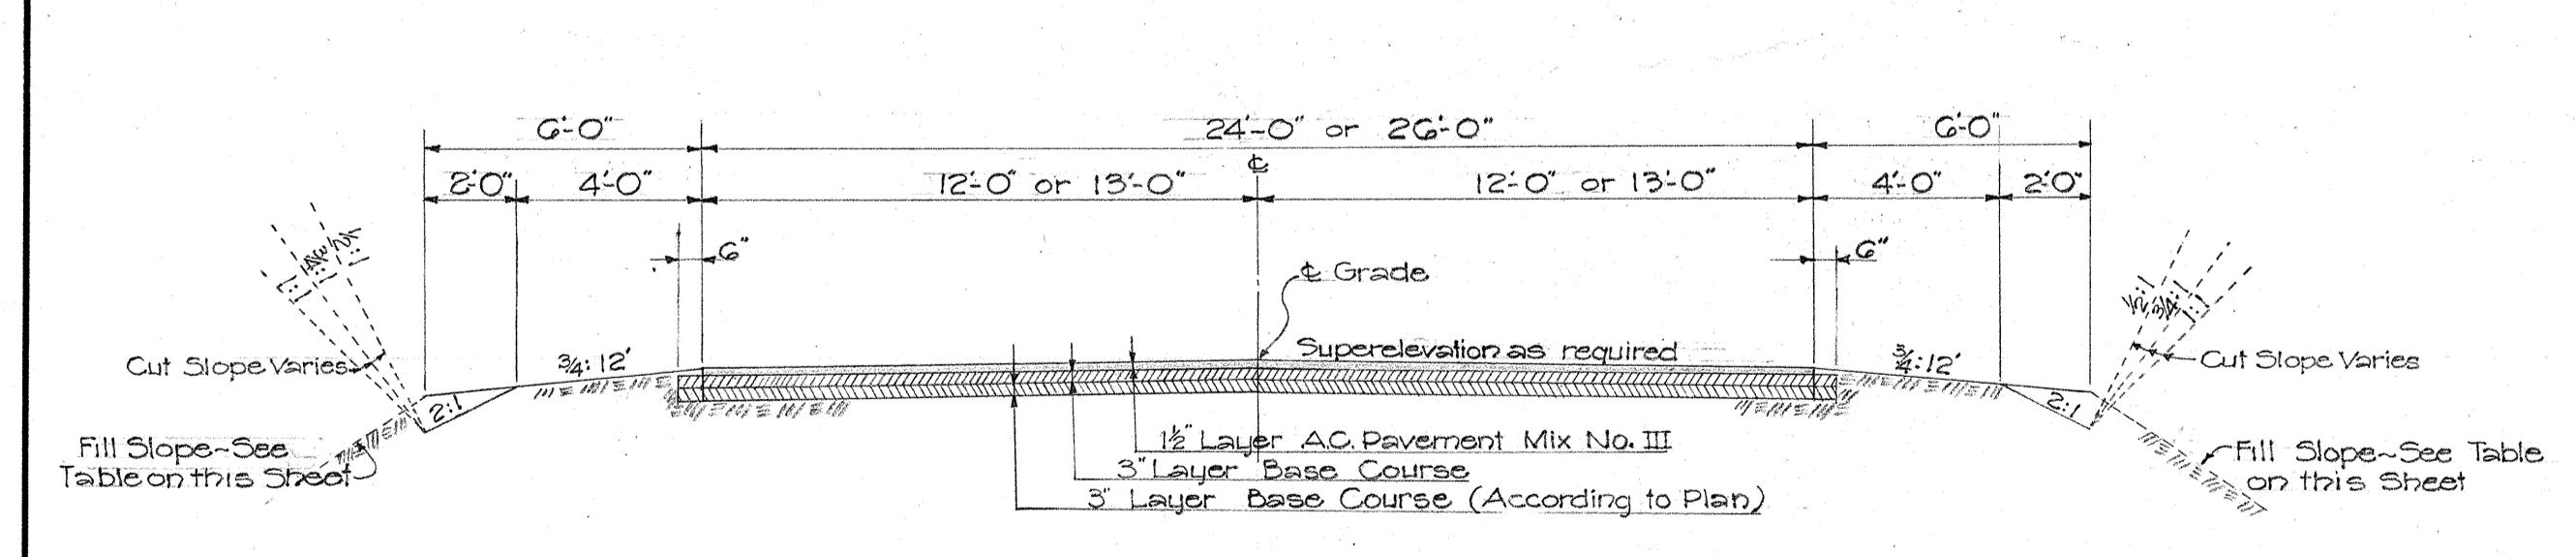

TYPICAL SECTION ~ 24' & 26' SIDEROADS Scale: 1/4" = 1'-0"

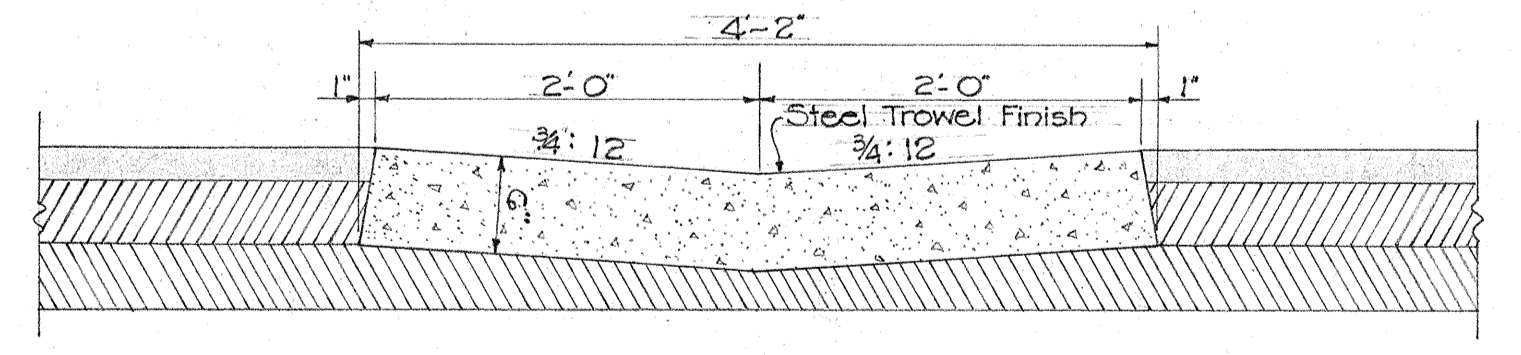

DETAIL OF TYPE "B" CONC. GUTTER Scale: 1" = 1'-0"

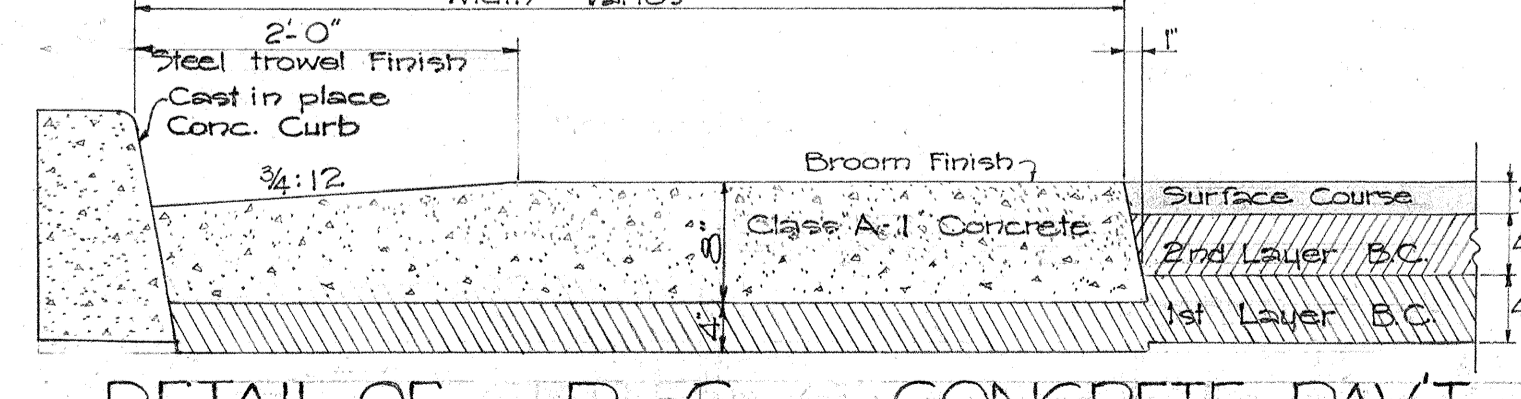

DETAIL OF P.C. CONCRETE PAVT. Scale: 1" = 1'-0"

GENERAL NOTES
 Asphalt Concrete Pavement shall be 2" or 1 1/2" thick when fully compacted, laid in one course: Surface course using Mix No. III.
 Prime Coat: Slow Curing Liquid Asphalt for Prime Coat shall be applied to the surface of the Base Course at the rate of 0.35 gal. per sq. yd. before placing Surface Course.
 Portland Cement Concrete Pavement shall not be reinforced with bars or wire mesh except where bar reinforcement is required by the Engineer for protection of sub-structures. No longitudinal Contact Joints are permitted - pavement shall be paved full width. "Weakened Plane Joints" shall be installed on approximately 30 ft. centers. No "Expansion Joints" are required.
 Excavation: All excavation in dirt shall be Class A Excavation. All excavation in rock shall be Class B Excavation. Cut Slopes are 1:1 in dirt cuts and 1/2:1 or 3/4:1 in rock cuts. The Engineer reserves the right to change the slopes shown in the Cross Sections. Base Course shall be laid in layers not exceeding 4" in thickness or as shown on Typical Section.

NAME	LOCATION	BASE COURSE	PAVEMENT WIDTH	THICKNESS
Argonaut Ave.	B.L. Sta 141+73	3"	22'-0"	1 1/2"
Naval Hosp. Road	B.L. Sta 141+73 & B.L. Sta 148+20	6"	26'-0"	1 1/2"
Makalapa Ave	B.L. Sta 148+20	6"	26'-0"	1 1/2"
Plantation Rd.	B.L. Sta. 155+00 & B.L. Sta. 175+50	B.C. 4" STONE 8"	18'-0"	PC Conc. 8"
Powder Magazine	B.L. Sta. 183+25	6"	As Shown	1 1/2"
Halawa Crater	and along Halawa Stream	6"	As Shown	1 1/2"
Halawa Dairy	Halawa Stream	3"	20'-0"	1 1/2"
U.S. Navy Property	B.L. Sta. 198+00	6"	26'-0"	1 1/2"
U.S. Navy Property	B.L. Sta. 210+00	6"	26'-0"	1 1/2"
Red Hill Access Rd.	B.L. Sta. 226+00	6"	50' Divid.	1 1/2"
North Access at B.L. Sta. 210+00	To 2100-6'	6"	As Shown in Plan	1 1/2"
	From 2100-3'		20'-0"	1 1/2"
Army Unkld. Com. Post	B.L. Sta. 230+50	6"	26'-0"	1 1/2"
Allumani Crater Rd.	B.L. Sta. 245+00	6"	26'-0"	1 1/2"
Moanalua Golf Cse Rd.	B.L. Sta. 252+75	3"	20'-0"	1 1/2"
All others			As shown on Plan	1 1/2"

Height of Fill	Slope
Up to 3'	4:1
3 to 6'	2:1
Over 6'	1 1/2:1

TERRITORIAL HIGHWAY DEPARTMENT
 TERRITORY OF HAWAII
 TYPICAL SECTIONS
 MOANALUA ROAD
 PROJECT NO. S 219 (4)
 Scale: As Indicated February 1952

SURVEY PLOTTED BY DATE
 DESIGNED BY
 DRAWN BY
 NOTE BOOK NO.
 QUANTITIES CHECKED BY
 CHECKED BY

STEEL SCHEDULE

FED. ROAD DIST. NO.	STATE	FED. AID PROJ. NO.	FISCAL YEAR	SHEET NO.	TOTAL SHEETS
HAWAII	HAW.	5219(4)	1952	44	110

MK	DESCRIPTION	Location	Size	Length	No. of Bars in Ea. Unit	No. of Units	Total No. of Bars	Total Length	Wt. Per Ft.	Total Weight	
4-8		Footings Bent #1 & 2		19'-3"	19	4	76	1,463			
4-7	Straight	"		2'-6"	4	16	64	160.0			
4-6	"	"		7'-6"	4	16	64	480.			
4-31	"	"		3'-4"	6	16	96	320.0			
8-3	"	"		41'-6"	16	4	64	2,656			
5-5		"		25'-0"	13	16	208	5,200			
9-3		"		8'-0"	6	16	96	768			
10-1	Straight	"		7'-6"	6	16	96	720			
			#4					2,423.668		1,619	
			5					5,200.1043		5,424	
			8					2,656.267		7,092	
			9					768.34		2,611	
			10					720.4303		3,098	
	TOTAL FOOTING BENT NOS. 1 & 2										19,844. #
4-31	Straight	Bent 1 & 2		3'-4"	6	16	96	320			
4-7	"	"		2'-6"	4	16	64	160			
11-14		"									
		F-1 & F-8		28'-3"	10	4	40	1,130			
		F-2 & F-7		28'-5"	10	4	40	1,136.7			
		F-3 & F-6		28'-6 1/2"	10	4	40	1,141.7			
		F-4 & F-5		28'-8 1/2"	10	4	40	1,148.3			
11-15		Bent 1 & 2									
		F-1 & F-8		27'-2"	4	4	16	434.7			
		F-2 & F-7		27'-4"	4	4	16	437.3			
		F-3 & F-6		27'-5 1/2"	4	4	16	439.3			
		F-4 & F-5		27'-7 1/2"	4	4	16	442.			
11-13	Straight	Bent 1 & 2		15'-0"	14	16	224	3,360			

MK	DESCRIPTION	Location	Size	Length	No. of Bars in Ea. Unit	No. of Units	Total No. of Bars	Total Length	Wt. Per Ft.	Total Weight
4-9		Bent 1 & 2		25'-2"	9	16	144	3,624		
4-10		"		13'-8"	17	16	272	3,717.3		
11-1		Frame		137'-3"	2	8	16	2,196		
11-2		"		113'-2"	2	8	16	1,810.7		
11-3		"		134'-8"	2	8	16	2,154.7		
11-4		"		126'-6"	2	8	16	2,024		
11-5		"		118'-6"	2	8	16	1,896		
11-6		"		22'-0"	4	8	32	704.		
11-7		"		13'-4 1/2"	4	8	32	428		
4-29		"		15'-6"	66	8	528	8,184		
4-30		"		17'-1 1/2" Ave.	50	8	400	6,850		
11-8	Straight	"		48'-0"	4	8	32	1,536		
11-9	"	"		104'-0"	2	8	16	1,664		
11-10	"	"		96'-0"	2	8	16	1,536		
11-16	"	"		8'-0"	4	8	32	256		
4-25	"	"		29'-0"	2	8	16	464		
4-40	"	"		16'-0"	4	8	32	512		
4-4		"		12'-7"	33	8	264	3,322		
4-91		Trans. Bm A		12'-9 1/2"	18	4	72	921		
9-1		"		42'-8 1/2"	3	4	12	512.5		
9-2	Straight	"		33'-9"	3	4	12	405		
7-1	"	Trans. Bm B		38'-2"	3	4	12	458		
7-2	"	"		33'-2"	3	4	12	398		
4-92		"		12'-7"	18	4	72	906		
7-4		End Beam		40'-8 1/2"	6	4	24	977		
4-13		"		12'-9 1/2"	22	4	88	1,125.7		
4-14	Straight	"		9'-2"	4	8	32	293.3		
4-11	"	"		39'-0"	4	4	16	624		
4-12	"	"		39'-0"	4	4	16	624		

MK	DESCRIPTION	Location	Size	Length	No. of Bars in Ea. Unit	No. of Units	Total No. of Bars	Total Length	Wt. Per Ft.	Total Weight	
4-15		Wing		8'-10" Ave.	5	8	40	353.3			
4-16		"		8'-11" Ave.	5	8	40	323.3			
4-20		"		4'-10"	10	8	80	386.7			
4-21	Straight	"		5'-2"	4	8	32	165.3			
4-17	"	"		5'-6" Ave.	12	8	96	528			
5-12		Slab		39'-2"	127	2	254	9,948.3			
5-15	Straight	"		3'-6"	3	8	24	84			
5-4	"	"		38'-2"	127	2	254	9,694.3			
5-13	"	"		33'-6"	127	2	254	8,509			
5-10	<u>133'-8" + 4-1'-3" laps</u>				138'-8"	21	2	42	5,824		
8-1		"		47'-10 1/2"	14	4	56	2,679.8			
8-2	Straight	"		18'-0"	14	4	56	1,008			
4-28	"	"		46'-0"	17	2	34	1,564			
4-27	"	"		8'-0"	18	4	72	576			
4-23	"	"		3'-6"	3	8	24	84			
4-24	"	"		5'-0"	2	8	16	80			
4-22	"	Wing		4'-0"	8	4	32	128			
			#4					35,835.9.668		23,938	
			5					34,059.6.1043		35,524	
			7					1,833.2044		3,747	
			8					3,687.8.267		9,846	
			9					917.5.34		3,120	
			11					25,875.4.5313		137,476	
	TOTAL SUPERSTRUCTURE										213,651. #
	GRAND TOTAL										233,495. #

CONTRACTOR'S NOTE

This steel schedule is subordinate to details shown on the plans. In case of discrepancy between steel list and detail drawings the latter shall govern.

The Territorial Highway Dept. does not assume responsibility for any errors that may occur in the steel schedule. Contractor shall check steel before placing order.

All stirrup dimensions are to inside of stirrups; all other dimensions are figured to center line of bars.

TERRITORIAL HIGHWAY DEPARTMENT
TERRITORY OF HAWAII

HALAWA BRIDGE

STA. 185+38 TO STA. 186+72

MOANALLIA ROAD S219(4)

APRIL 1951

SHEET No. 1 OF 1 SHEETS

5491.3F


DESIGNED BY _____
 DRAWN BY _____
 CHECKED BY _____
 DATE _____
 ORIGINAL PLAN _____
 NOTE BOOK _____
 QUANTITIES CHECKED BY _____
 CHECKED BY _____
 No. _____

NO. 122 ANTIWEIGHT TRACING CLOTH
M. & E. CO., N. Y.

FED. ROAD DIST. NO.	STATE	FED. AID PROJ. NO.	FISCAL YEAR	SHEET NO.	TOTAL SHEETS
HAWAII	HAW	S 219(4)	1952		

PLAN	BY	DATE
SURVEYED		
ALIGNED		
NOTED		
RT. OF WAY CHECKED		
NO.		

PLAN	BY	DATE
SURVEYED		
ALIGNED		
NOTED		
RT. OF WAY CHECKED		
NO.		

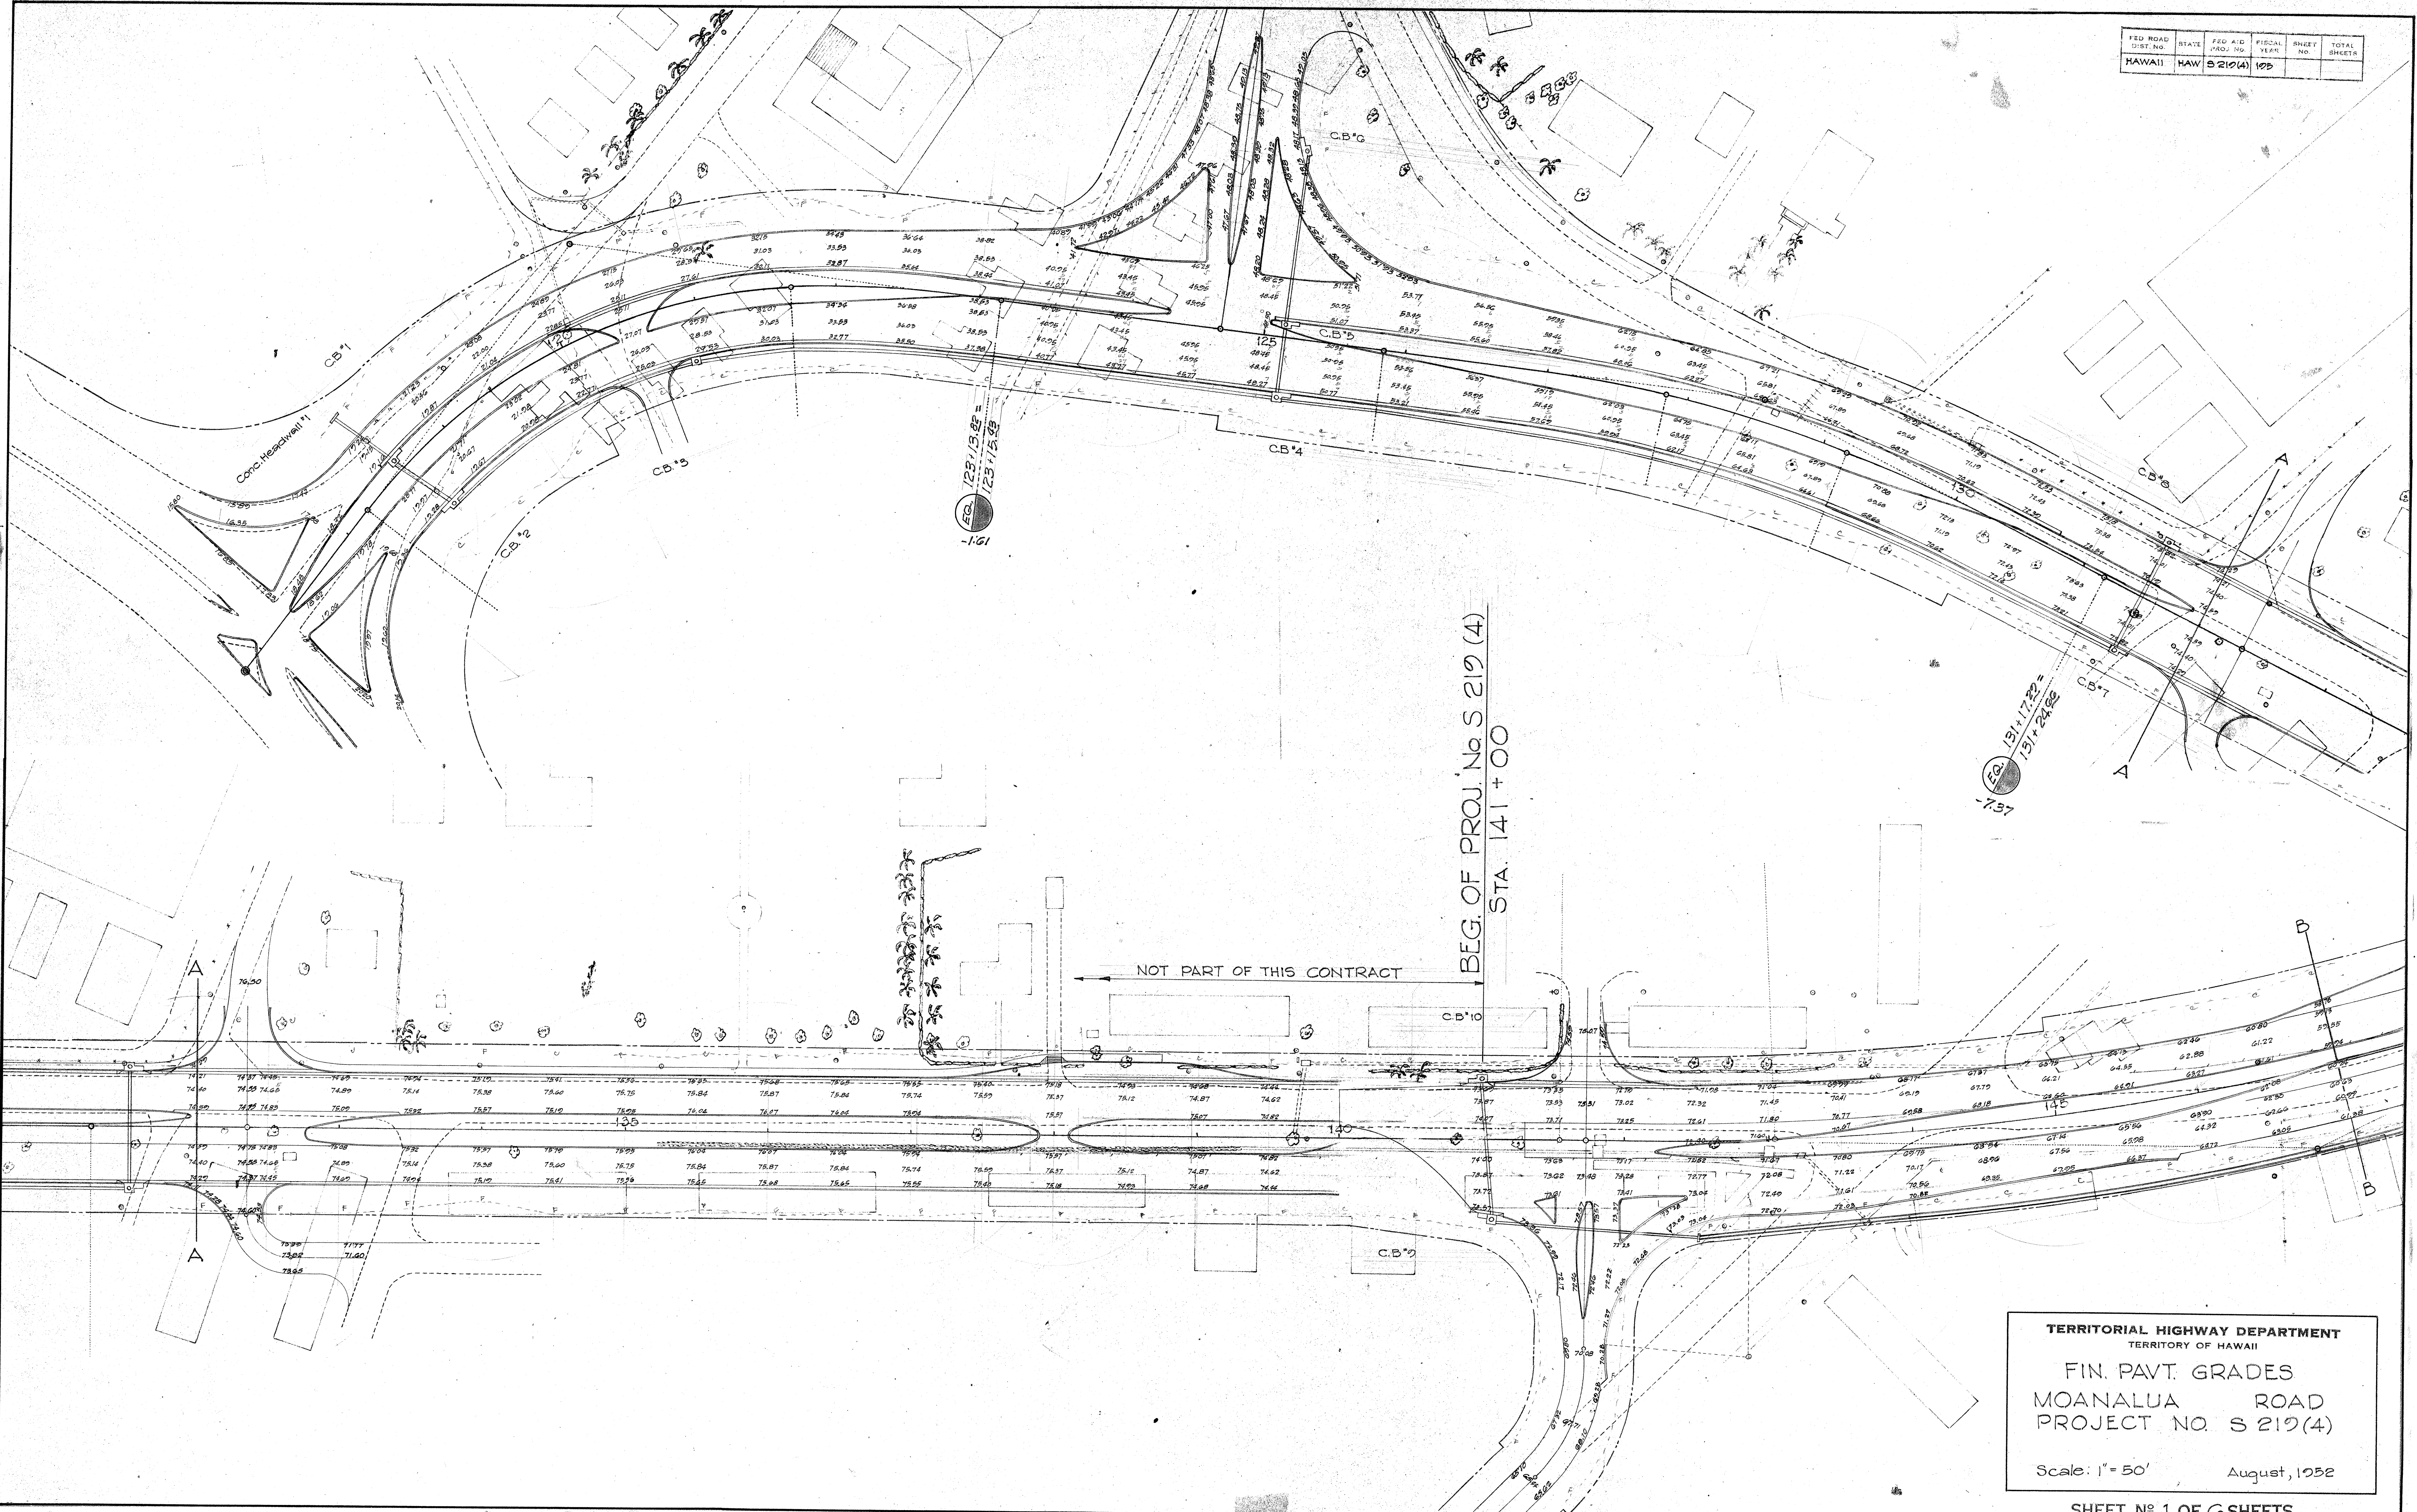

BEG. OF PROJ. No S 219 (4)
STA. 141+00

NOT PART OF THIS CONTRACT


TERRITORIAL HIGHWAY DEPARTMENT
TERRITORY OF HAWAII
FIN. PAVT. GRADES
MOANALUA ROAD
PROJECT NO. S 219(4)
Scale: 1" = 50' August, 1952

SHEET No 1 OF 6 SHEETS
5491.3G

FED. ROAD DIST. NO.	STATE	FED. AID PROJ. NO.	FISC. YR.	SHEET NO.	TOTAL SHEETS
HAWAII	HAW.	8210(4)	105		

PLAN	DATE
SURVEYED	
ALIGNED	
NOTE BOOK	
RT. OF WAY CHECKED	
NO.	


PLAN	DATE
COURSES	
PLOTTED	
NOTE BOOK	
RT. OF WAY CHECKED	
NO.	

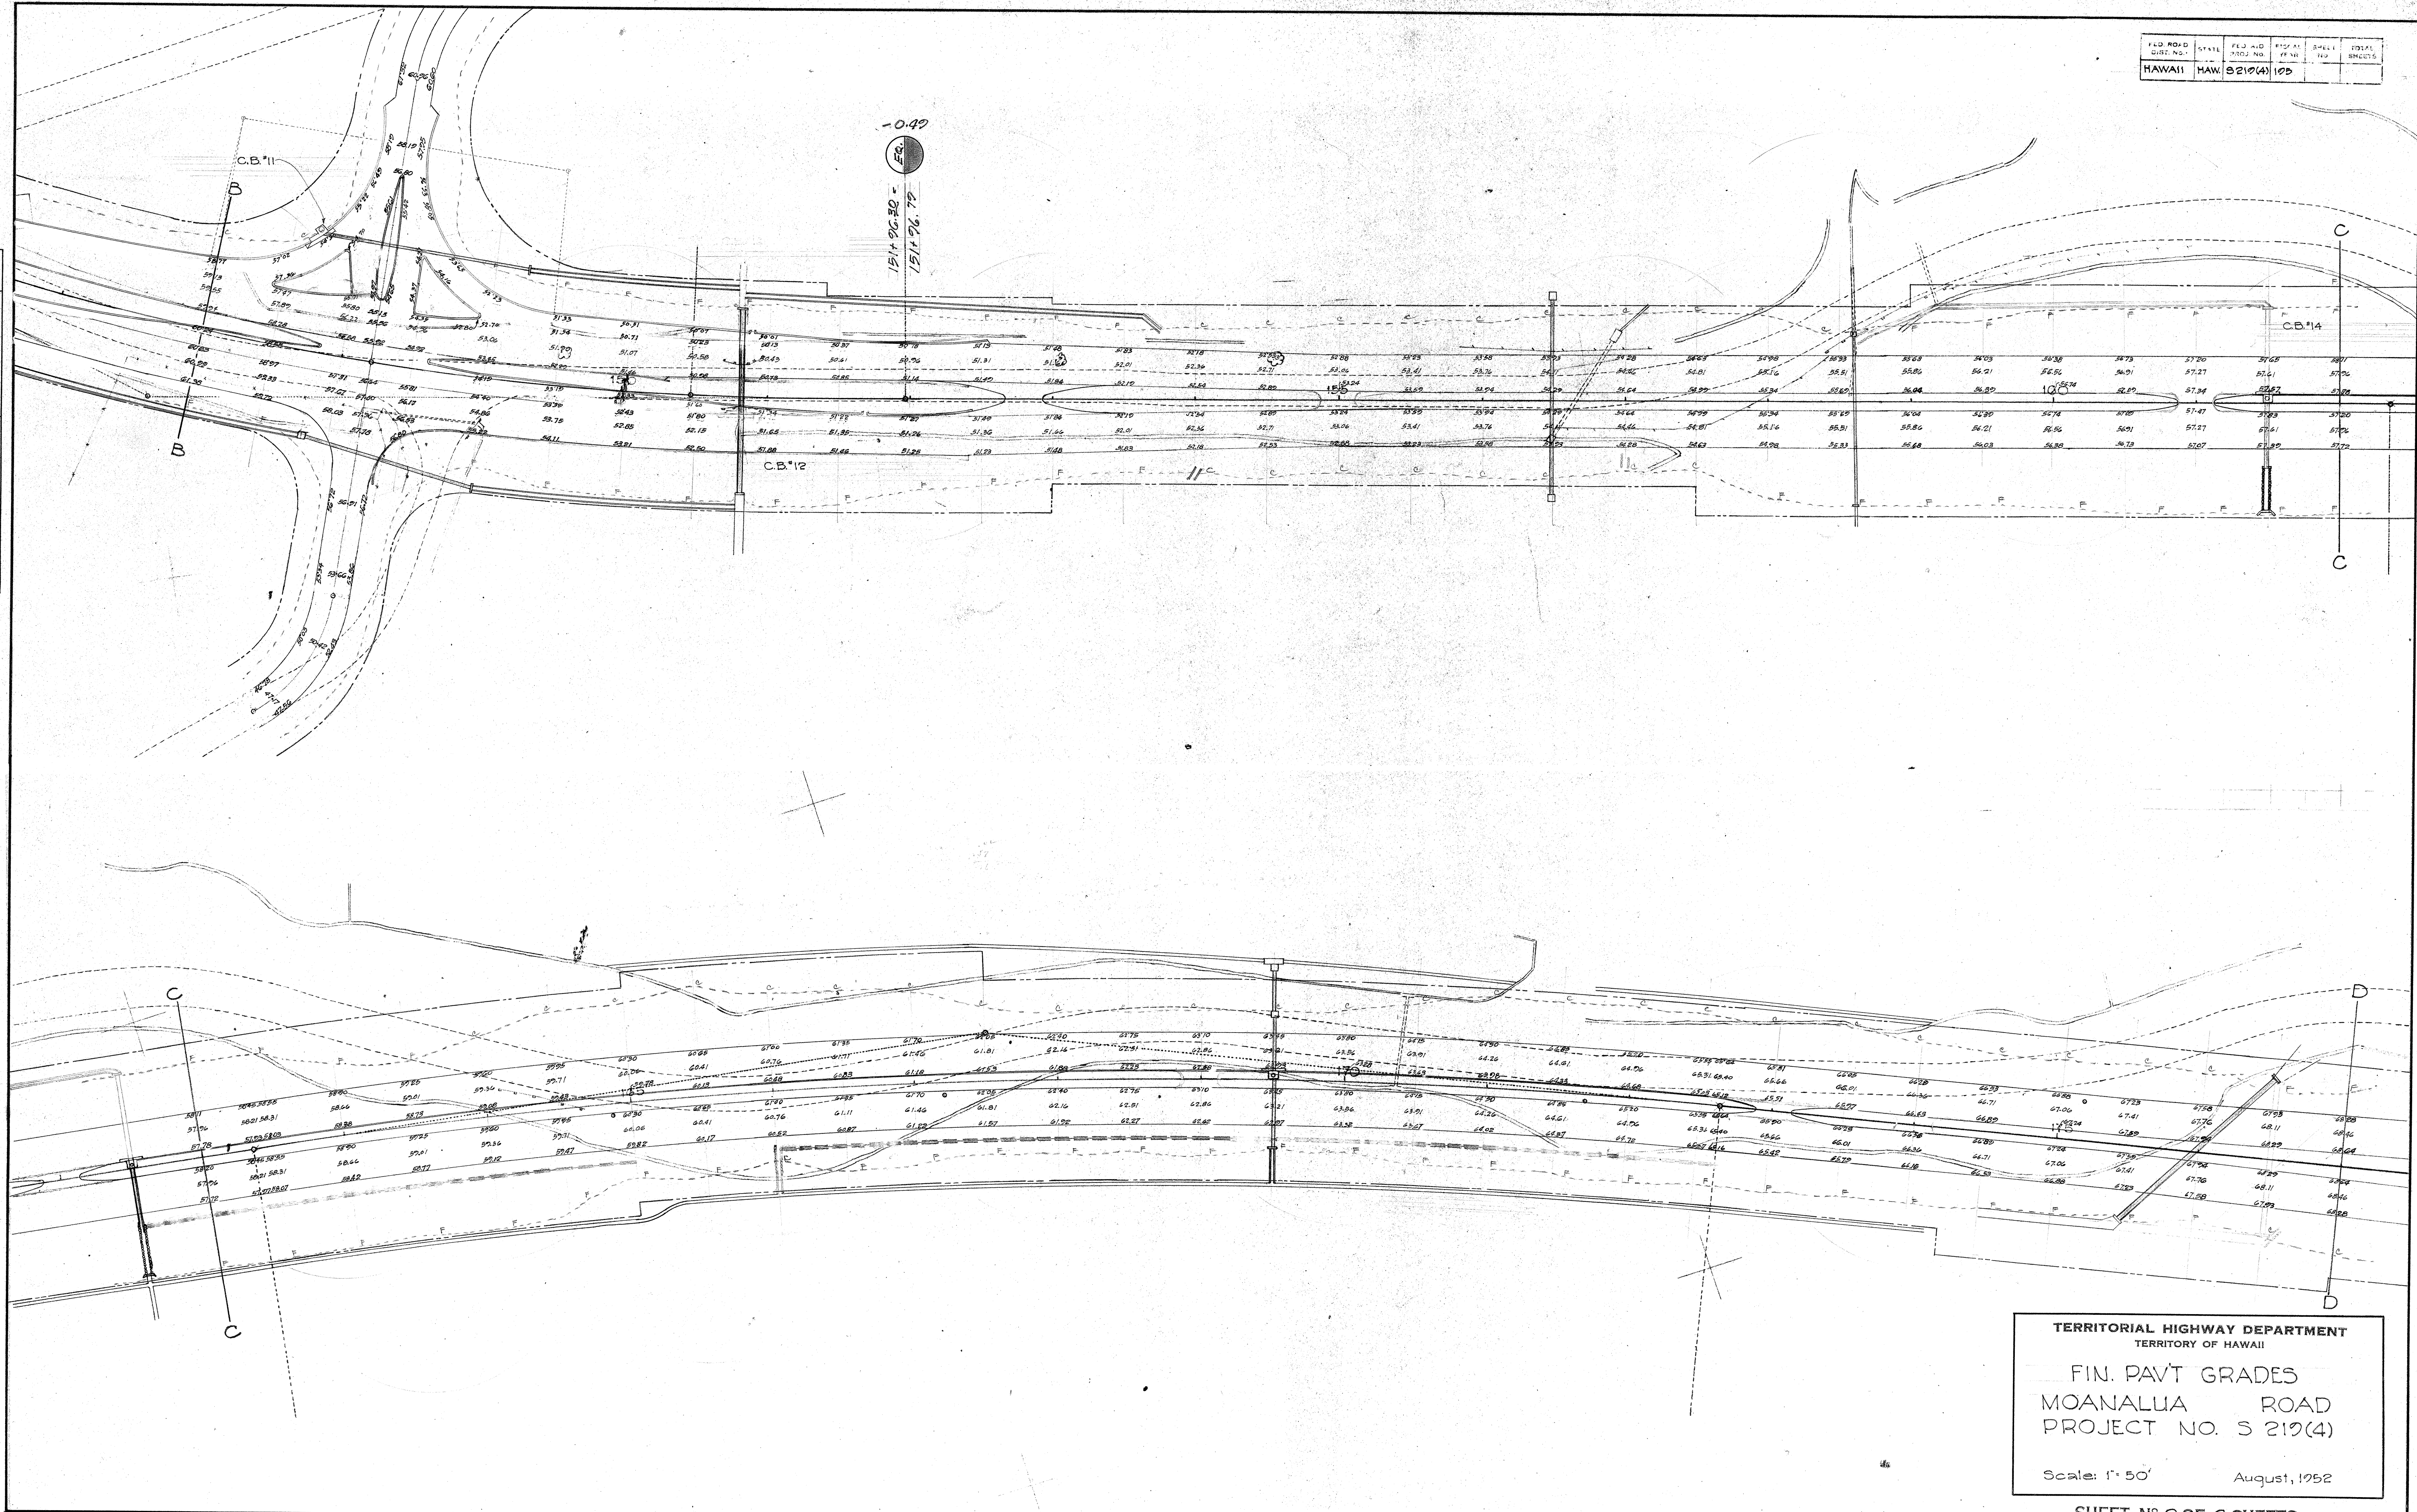

TERRITORIAL HIGHWAY DEPARTMENT
 TERRITORY OF HAWAII
 FIN. PAV'T GRADES
 MOANALUA ROAD
 PROJECT NO. S 210(4)
 Scale: 1" = 50'
 August, 1952

DATE	
BY	
DESIGNED	
PLOTTED	
NOTE BOOK ALIGNMENT CHECKED	
RT. OF WAY CHECKED	
NO.	

DATE	
BY	
DESIGNED	
PLOTTED	
NOTE BOOK ALIGNMENT CHECKED	
RT. OF WAY CHECKED	
NO.	

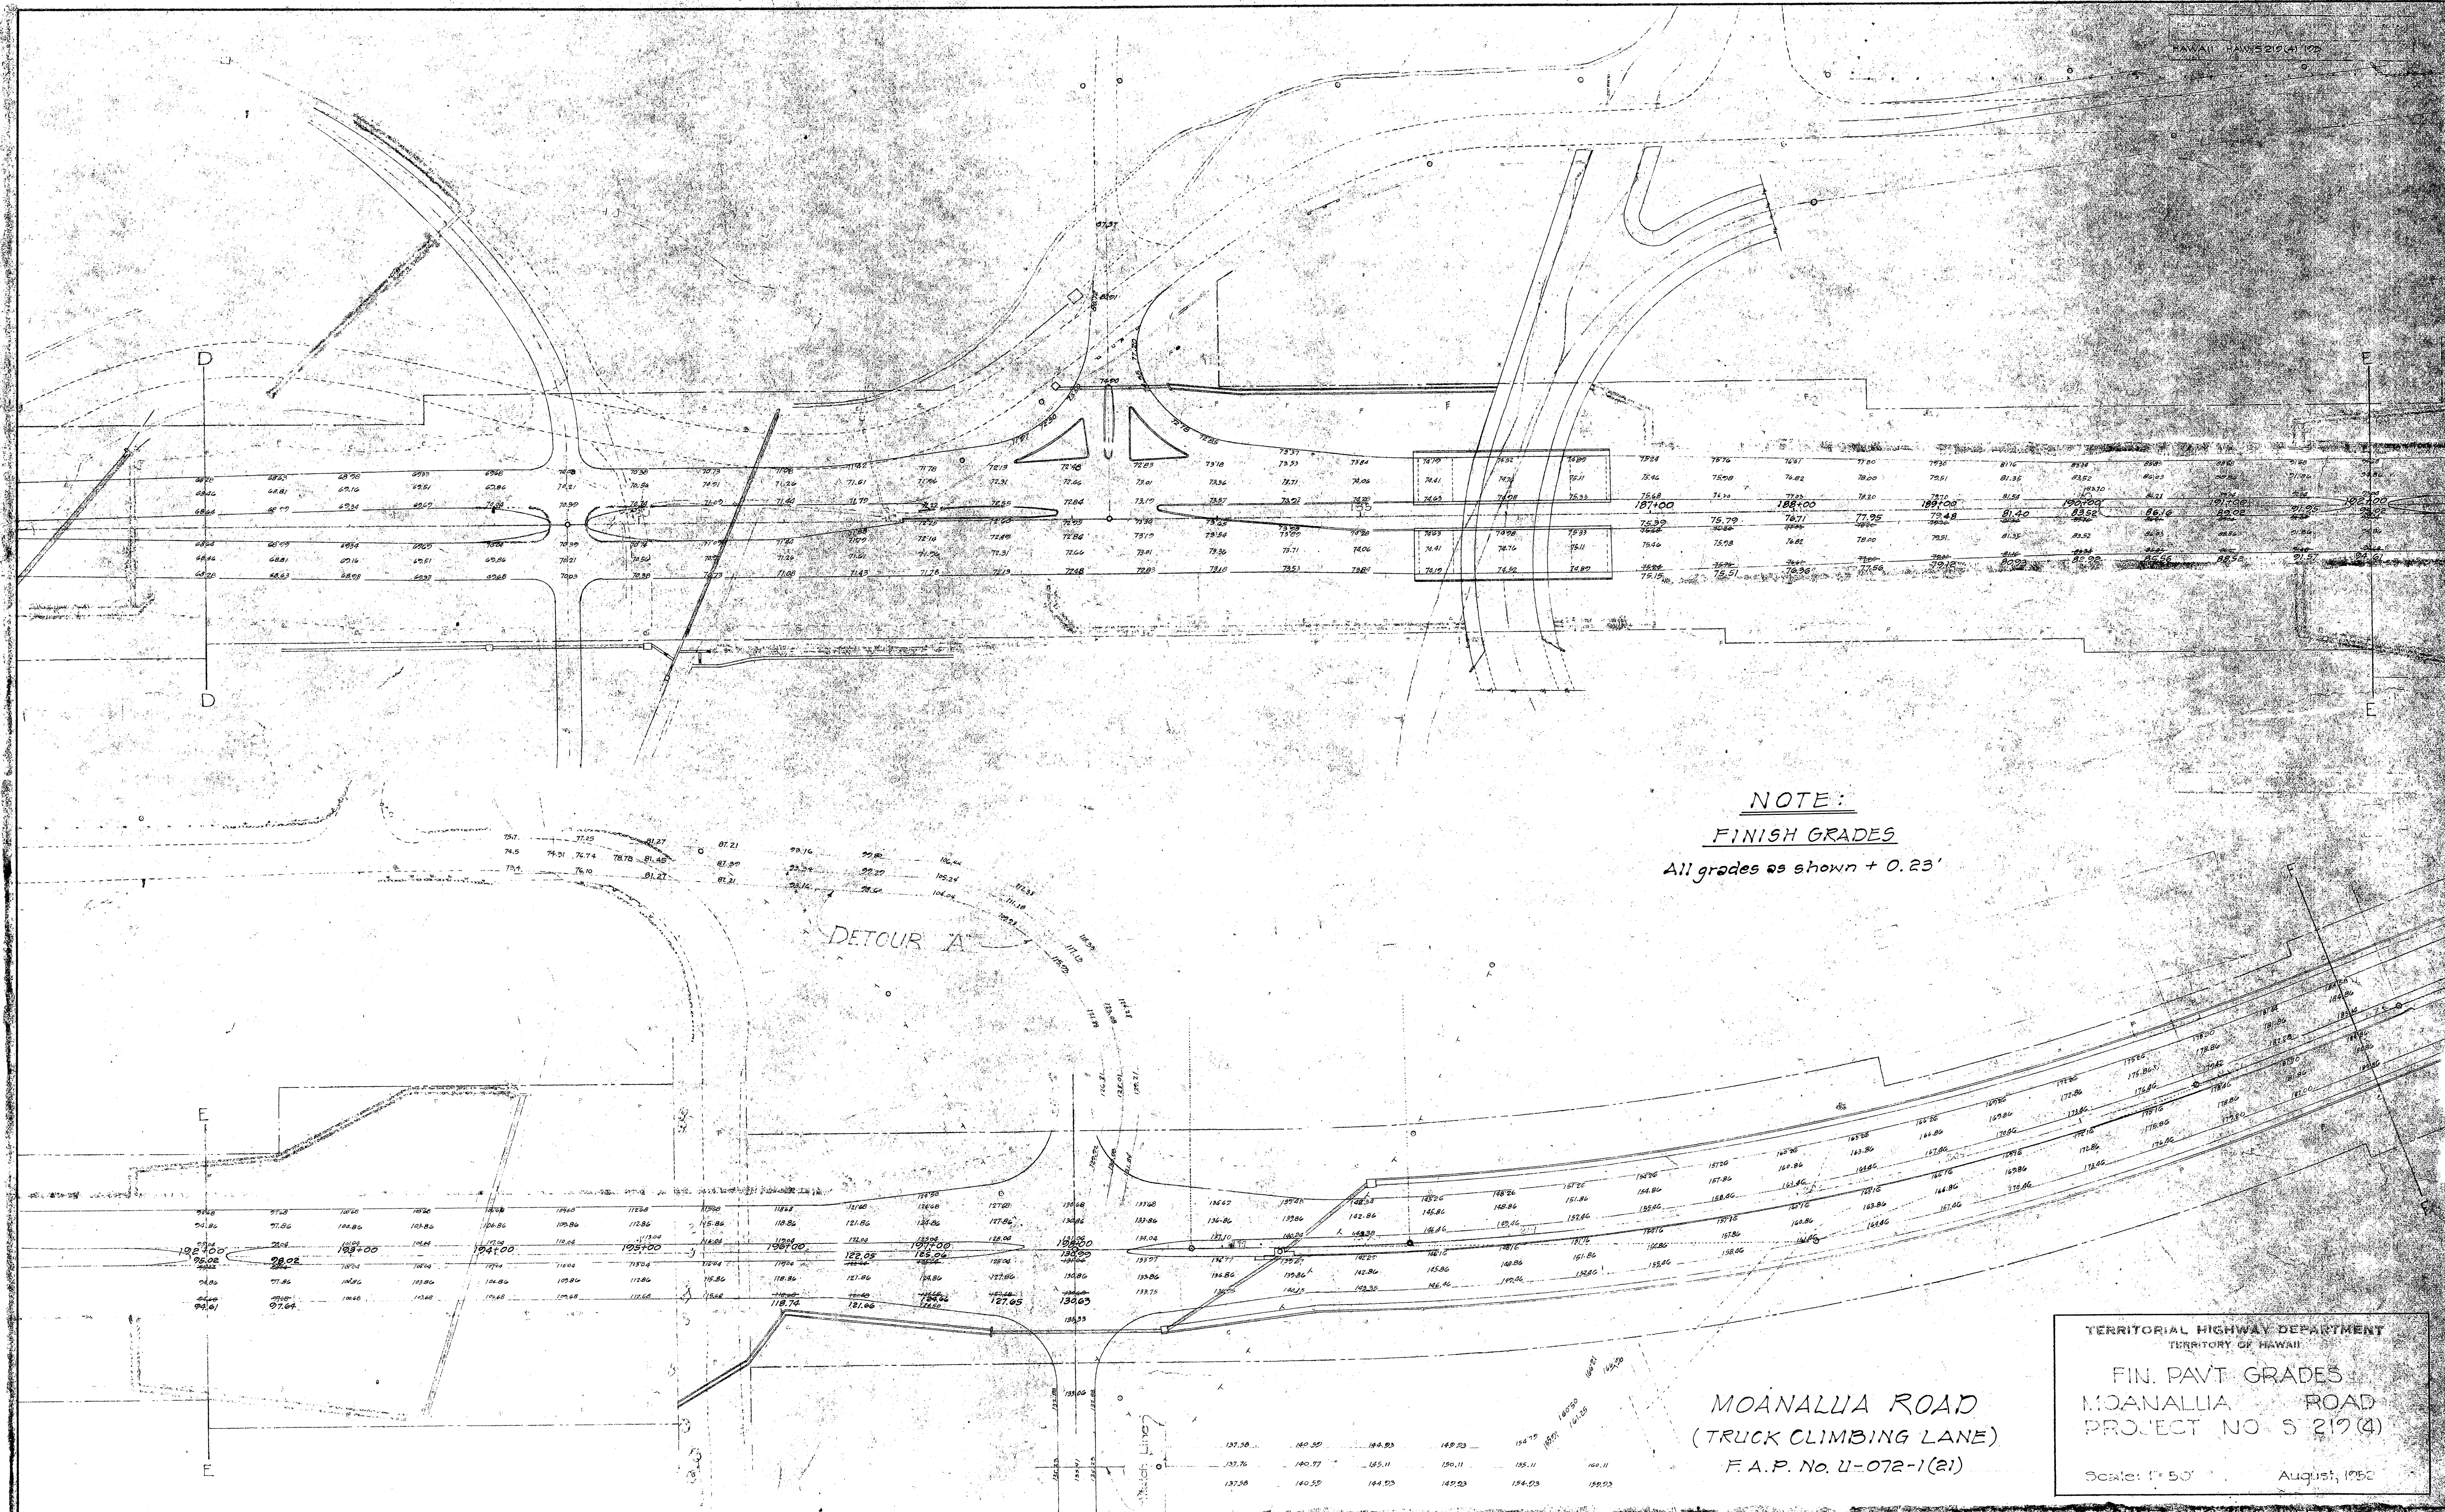

NOTE:
FINISH GRADES
 All grades as shown + 0.23'


MOANALUA ROAD
 (TRUCK CLIMBING LANE)
 F.A.P. No. U-072-1(21)

TERRITORIAL HIGHWAY DEPARTMENT
 TERRITORY OF HAWAII

FIN. PAVT GRADES
 MOANALUA ROAD
 PROJECT NO S 219(4)

Scale: 1" = 50' August, 1952

FED. ROAD DIST. NO.	STATE	FED. AID PROJ. NO.	FISCAL YEAR	SHEET NO.	TOTAL SHEETS

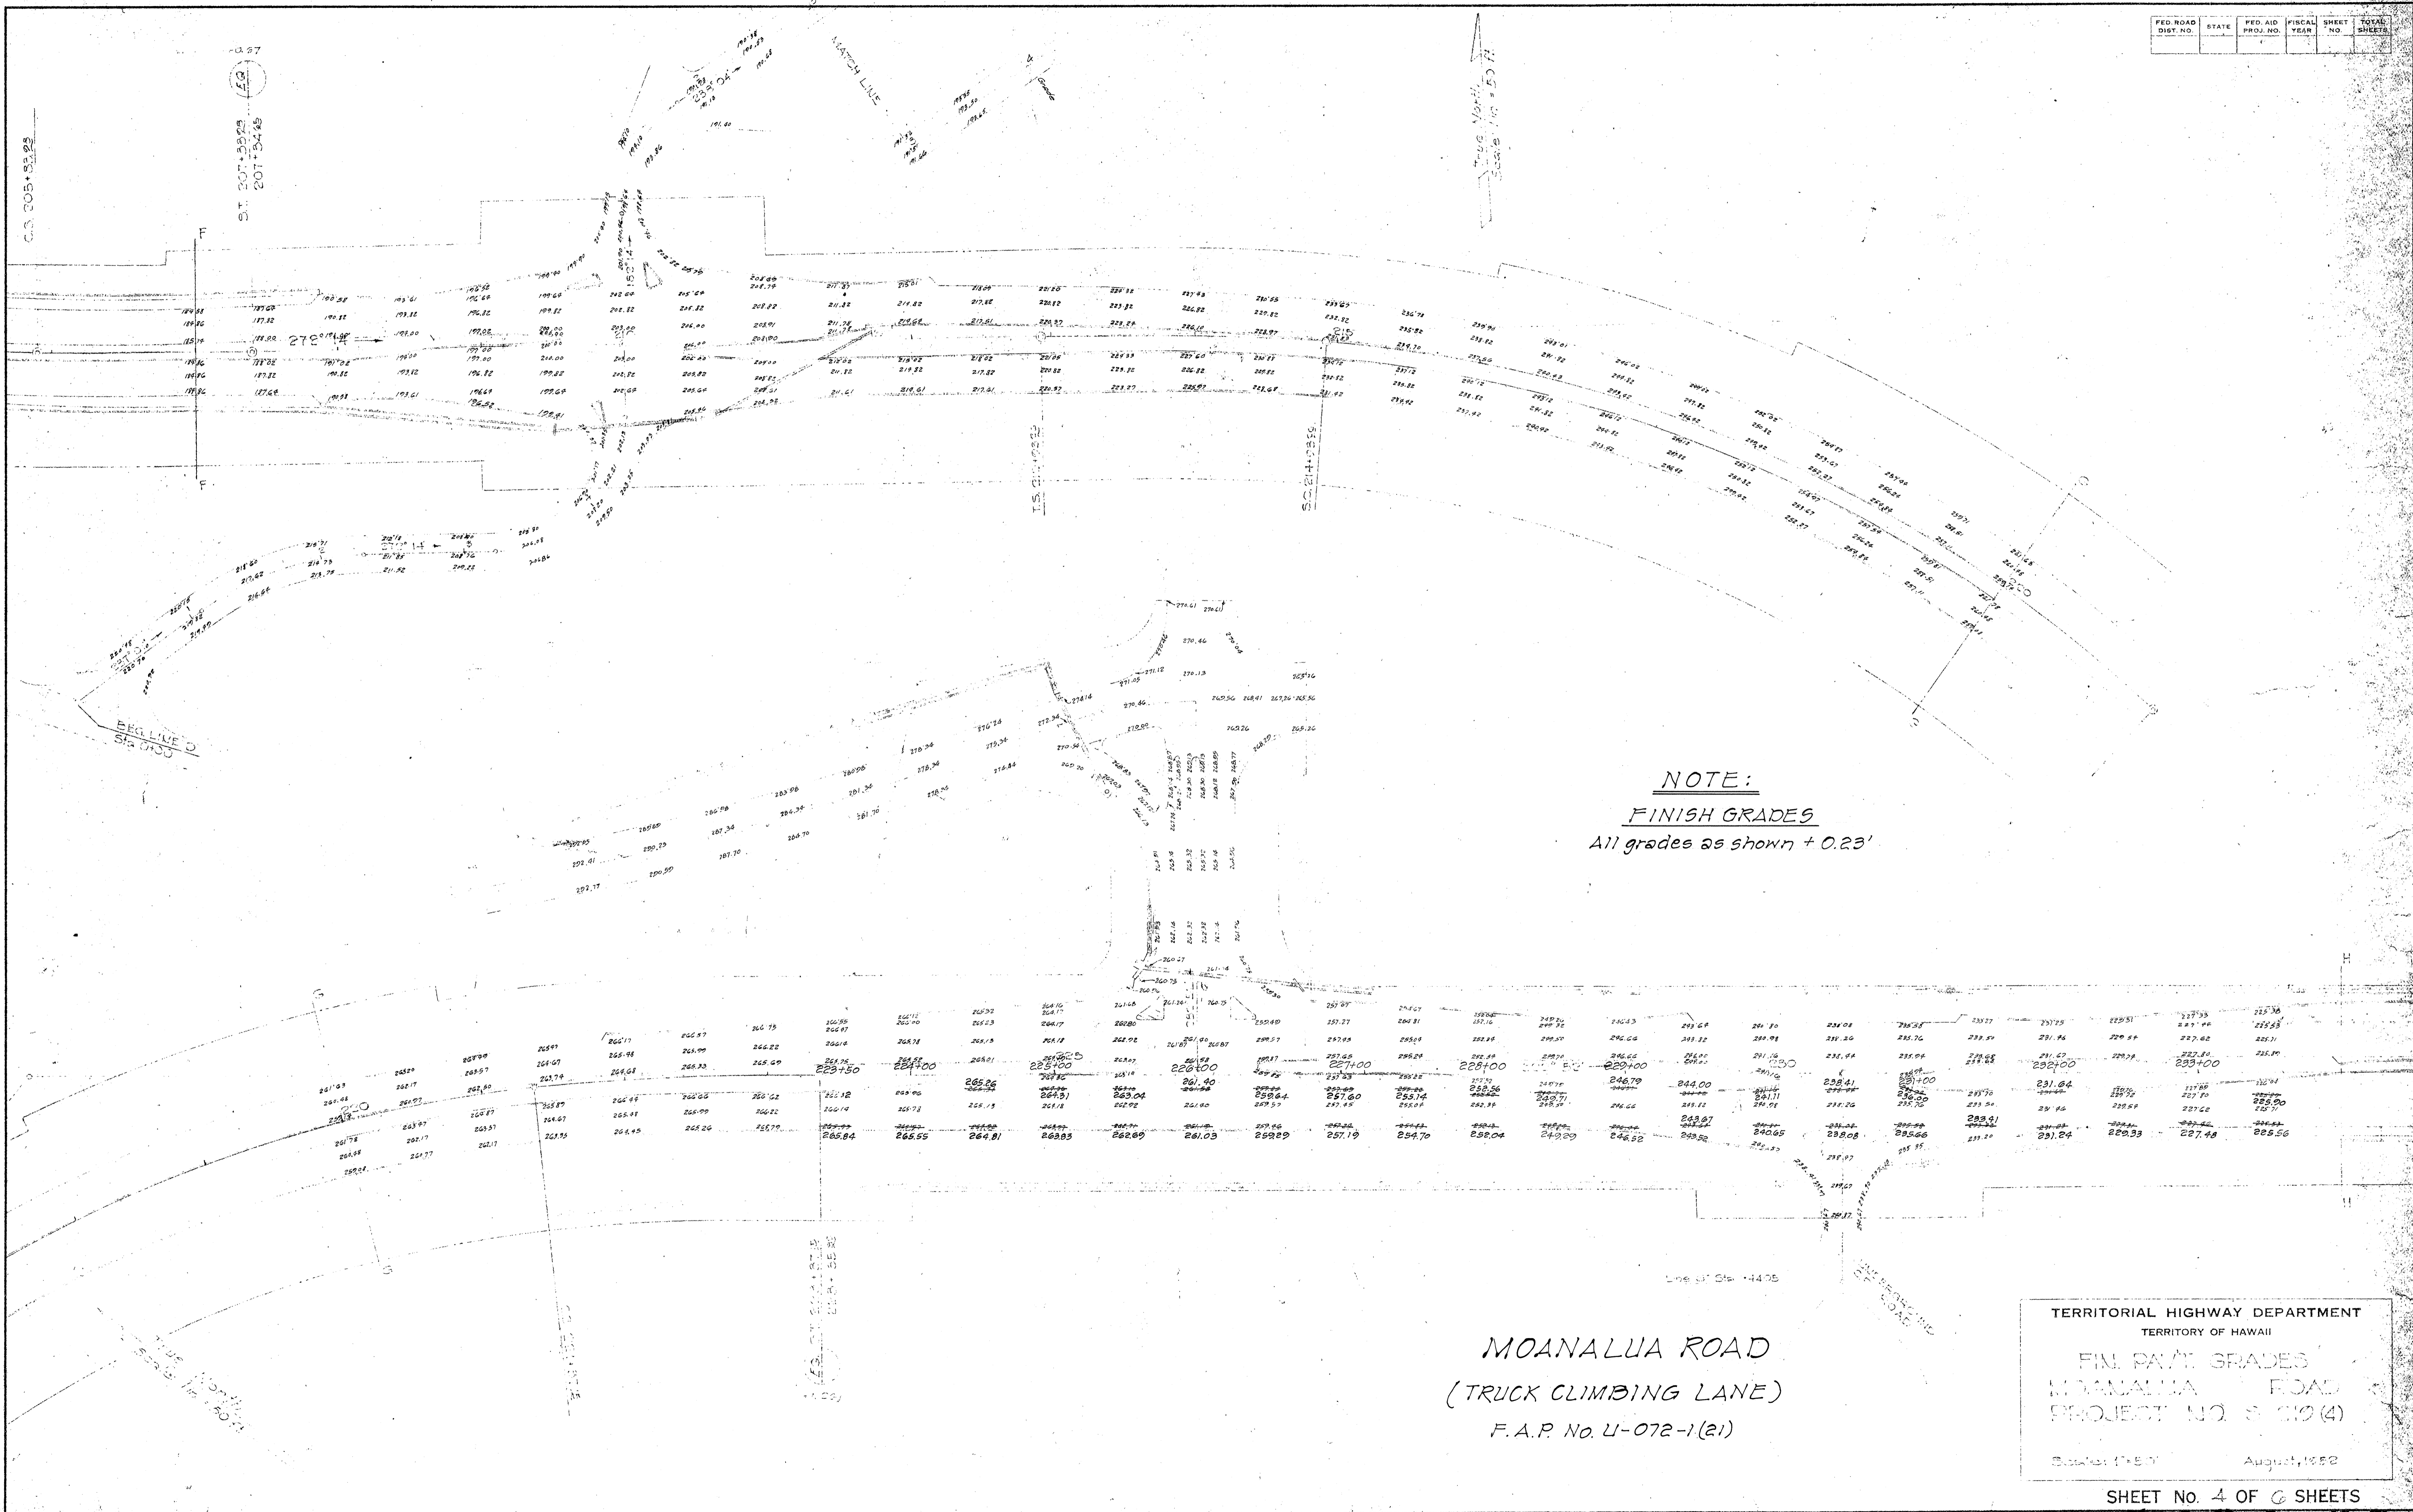

NOTE:
FINISH GRADES
 All grades as shown + 0.23'

SURVEY PLOTTED BY _____ DATE _____
 DESIGNED BY _____
 TRACED BY _____
 QUANTITIES BY _____
 CHECKED BY _____

ORIGINAL PLAN No. _____
 NOTE BOOK No. _____

MOANALUA ROAD
(TRUCK CLIMBING LANE)
 F.A.P. No. U-072-1(21)

TERRITORIAL HIGHWAY DEPARTMENT
 TERRITORY OF HAWAII
 FIN. PAVT. GRADES
 MOANALUA ROAD
 PROJECT NO. S-110(4)
 Scale: 1" = 50' August, 1952

SHEET NO. 4 OF 6 SHEETS

5491.33


FED. ROAD DIST. NO.	STATE	FED. AID PROJ. NO.	FISCAL YEAR	SHEET NO.	TOTAL SHEETS
HAWAII	HAW.	S 219(4)	1952		

DATE	BY

SURVEYED
 PLOTTED
 ALIGNMENT CHECKED
 RT. OF WAY CHECKED
 PLAN NO.

DATE	BY

SURVEYED
 PLOTTED
 ALIGNMENT CHECKED
 RT. OF WAY CHECKED
 PLAN NO.

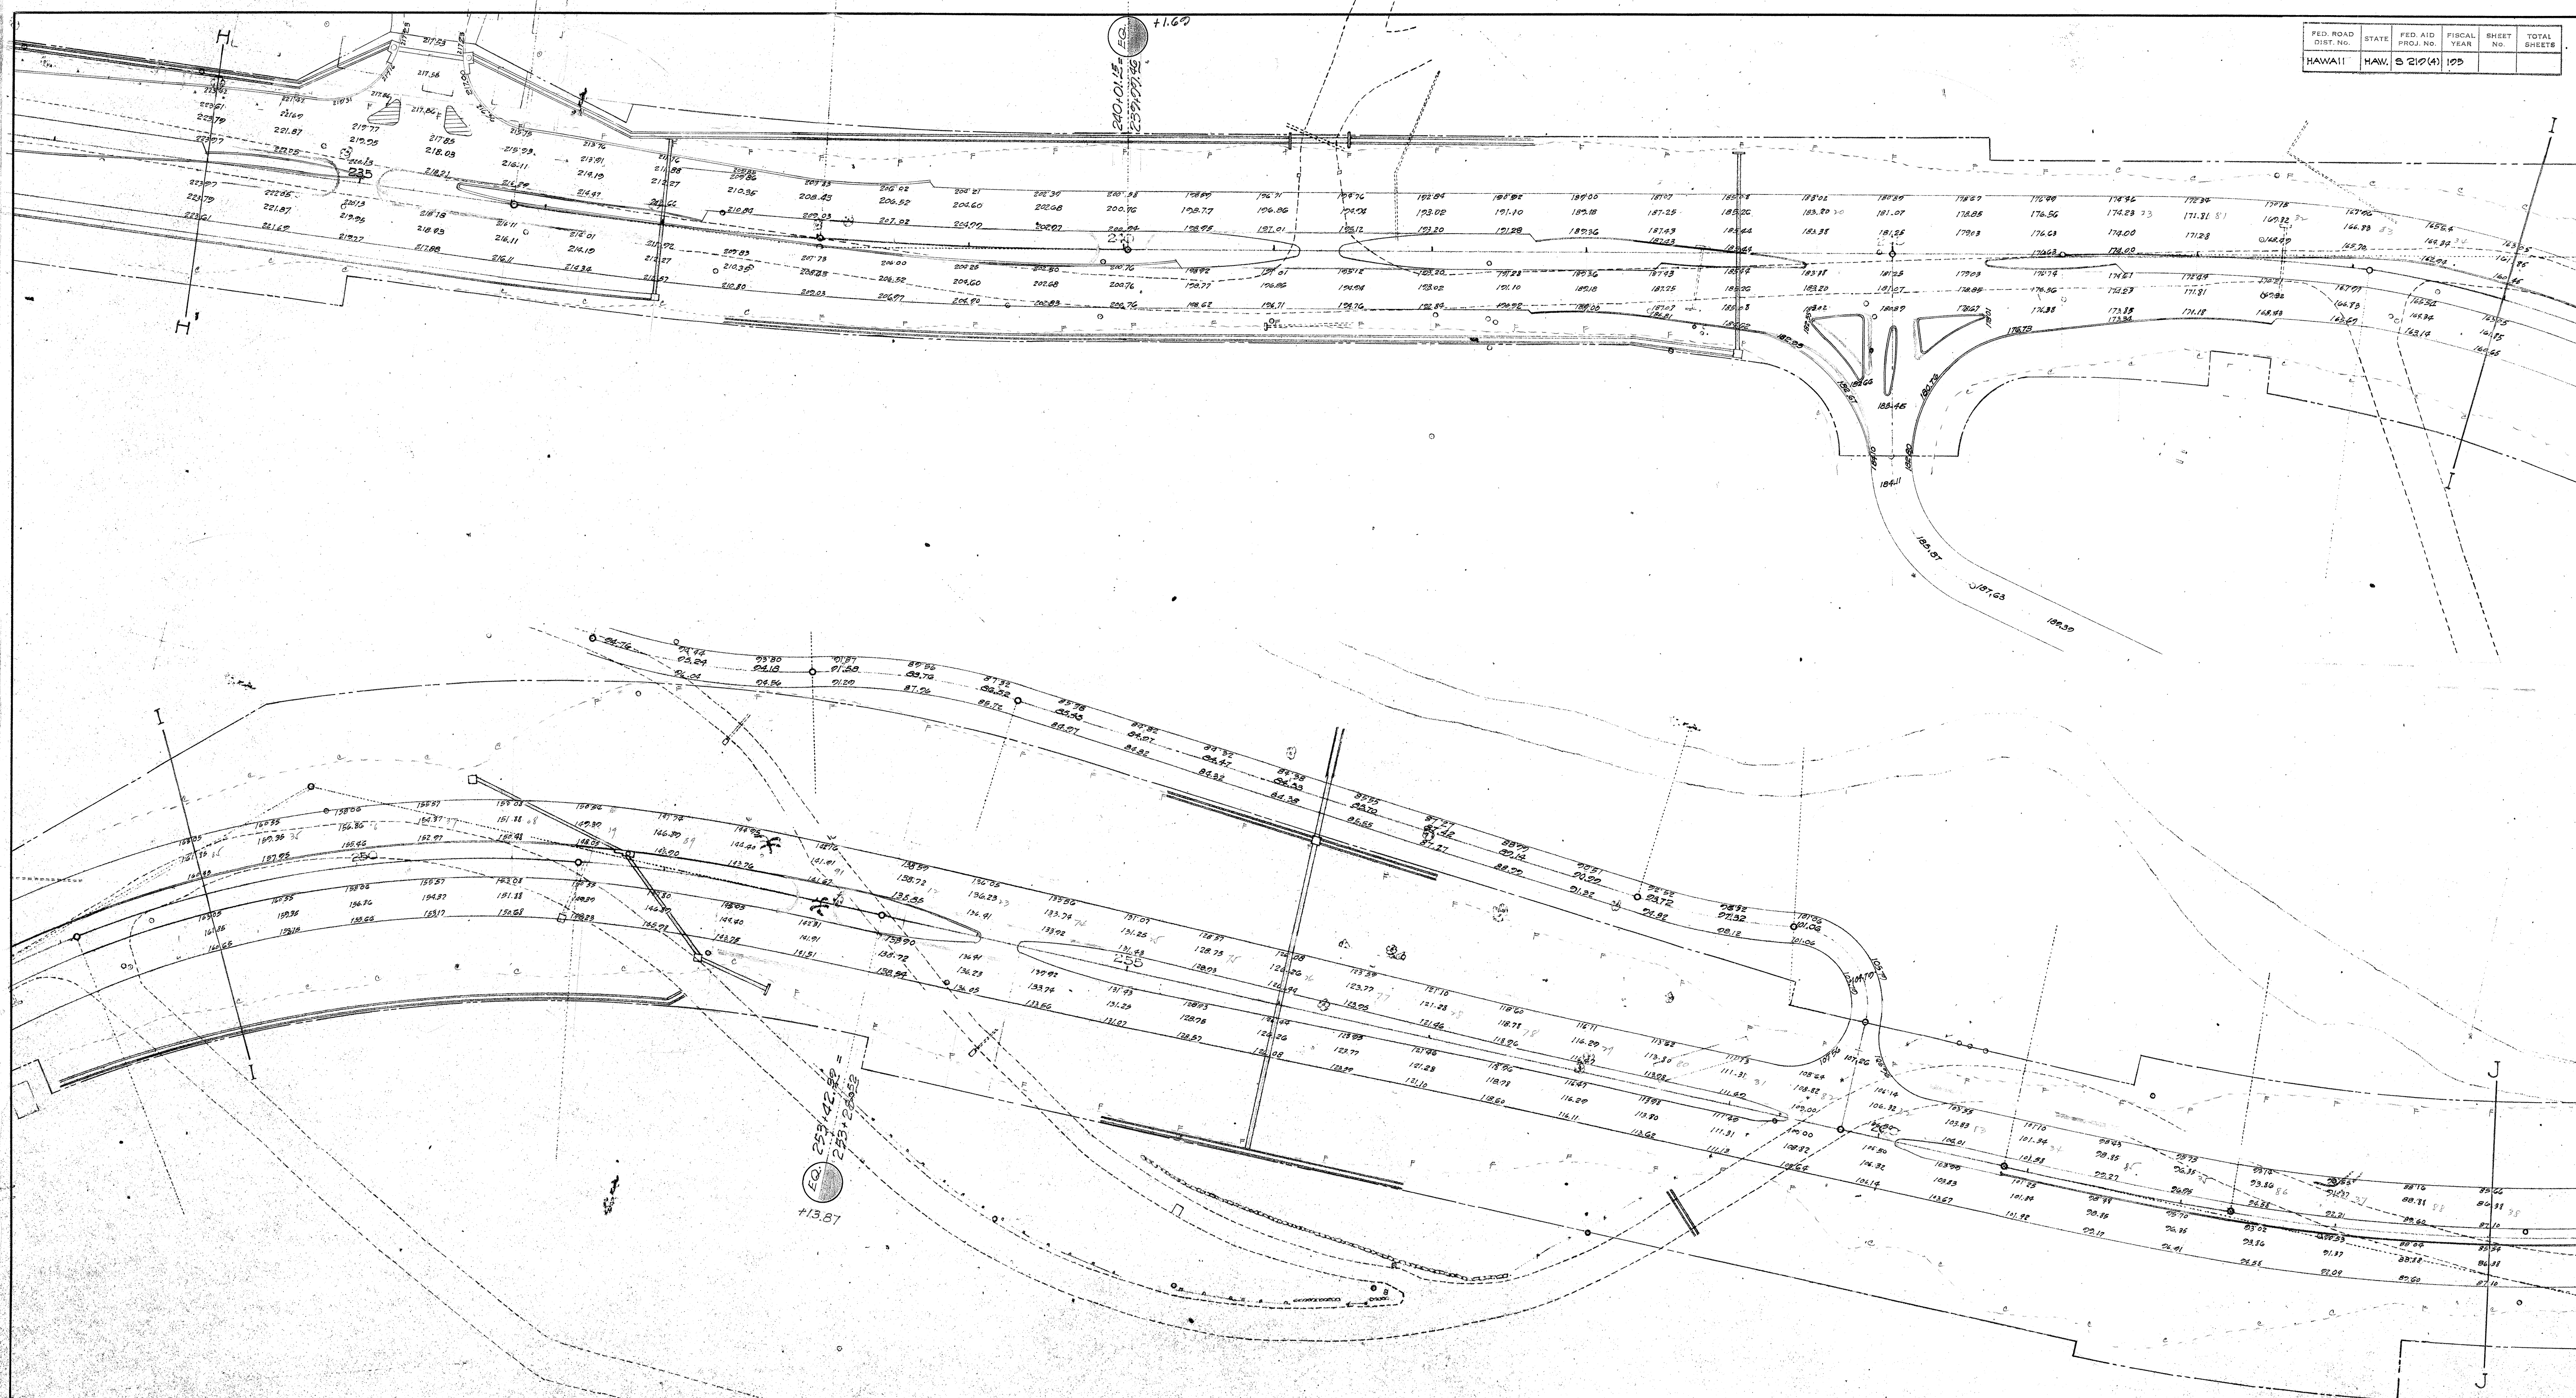

TERRITORIAL HIGHWAY DEPARTMENT
 TERRITORY OF HAWAII
 FIN PAVT GRADES
 MOANALIA ROAD
 PROJ. NO. S 219 (4)
 Scale: 1" = 50'
 August, 1952


SHEET N° 5 OF 6 SHEETS

5491.3K

FED. ROAD DIST. NO.	STATE	FED. AID PROJ. NO.	FISCAL YEAR	SHEET NO.	TOTAL SHEETS
HAWAII	HAW.	S 219(4)	1952		

PLAN	DATE
SURVEYED	
ALIGNED	
CHECKED	
NO. _____	

PLAN	DATE
SURVEYED	
ALIGNED	
CHECKED	
NO. _____	

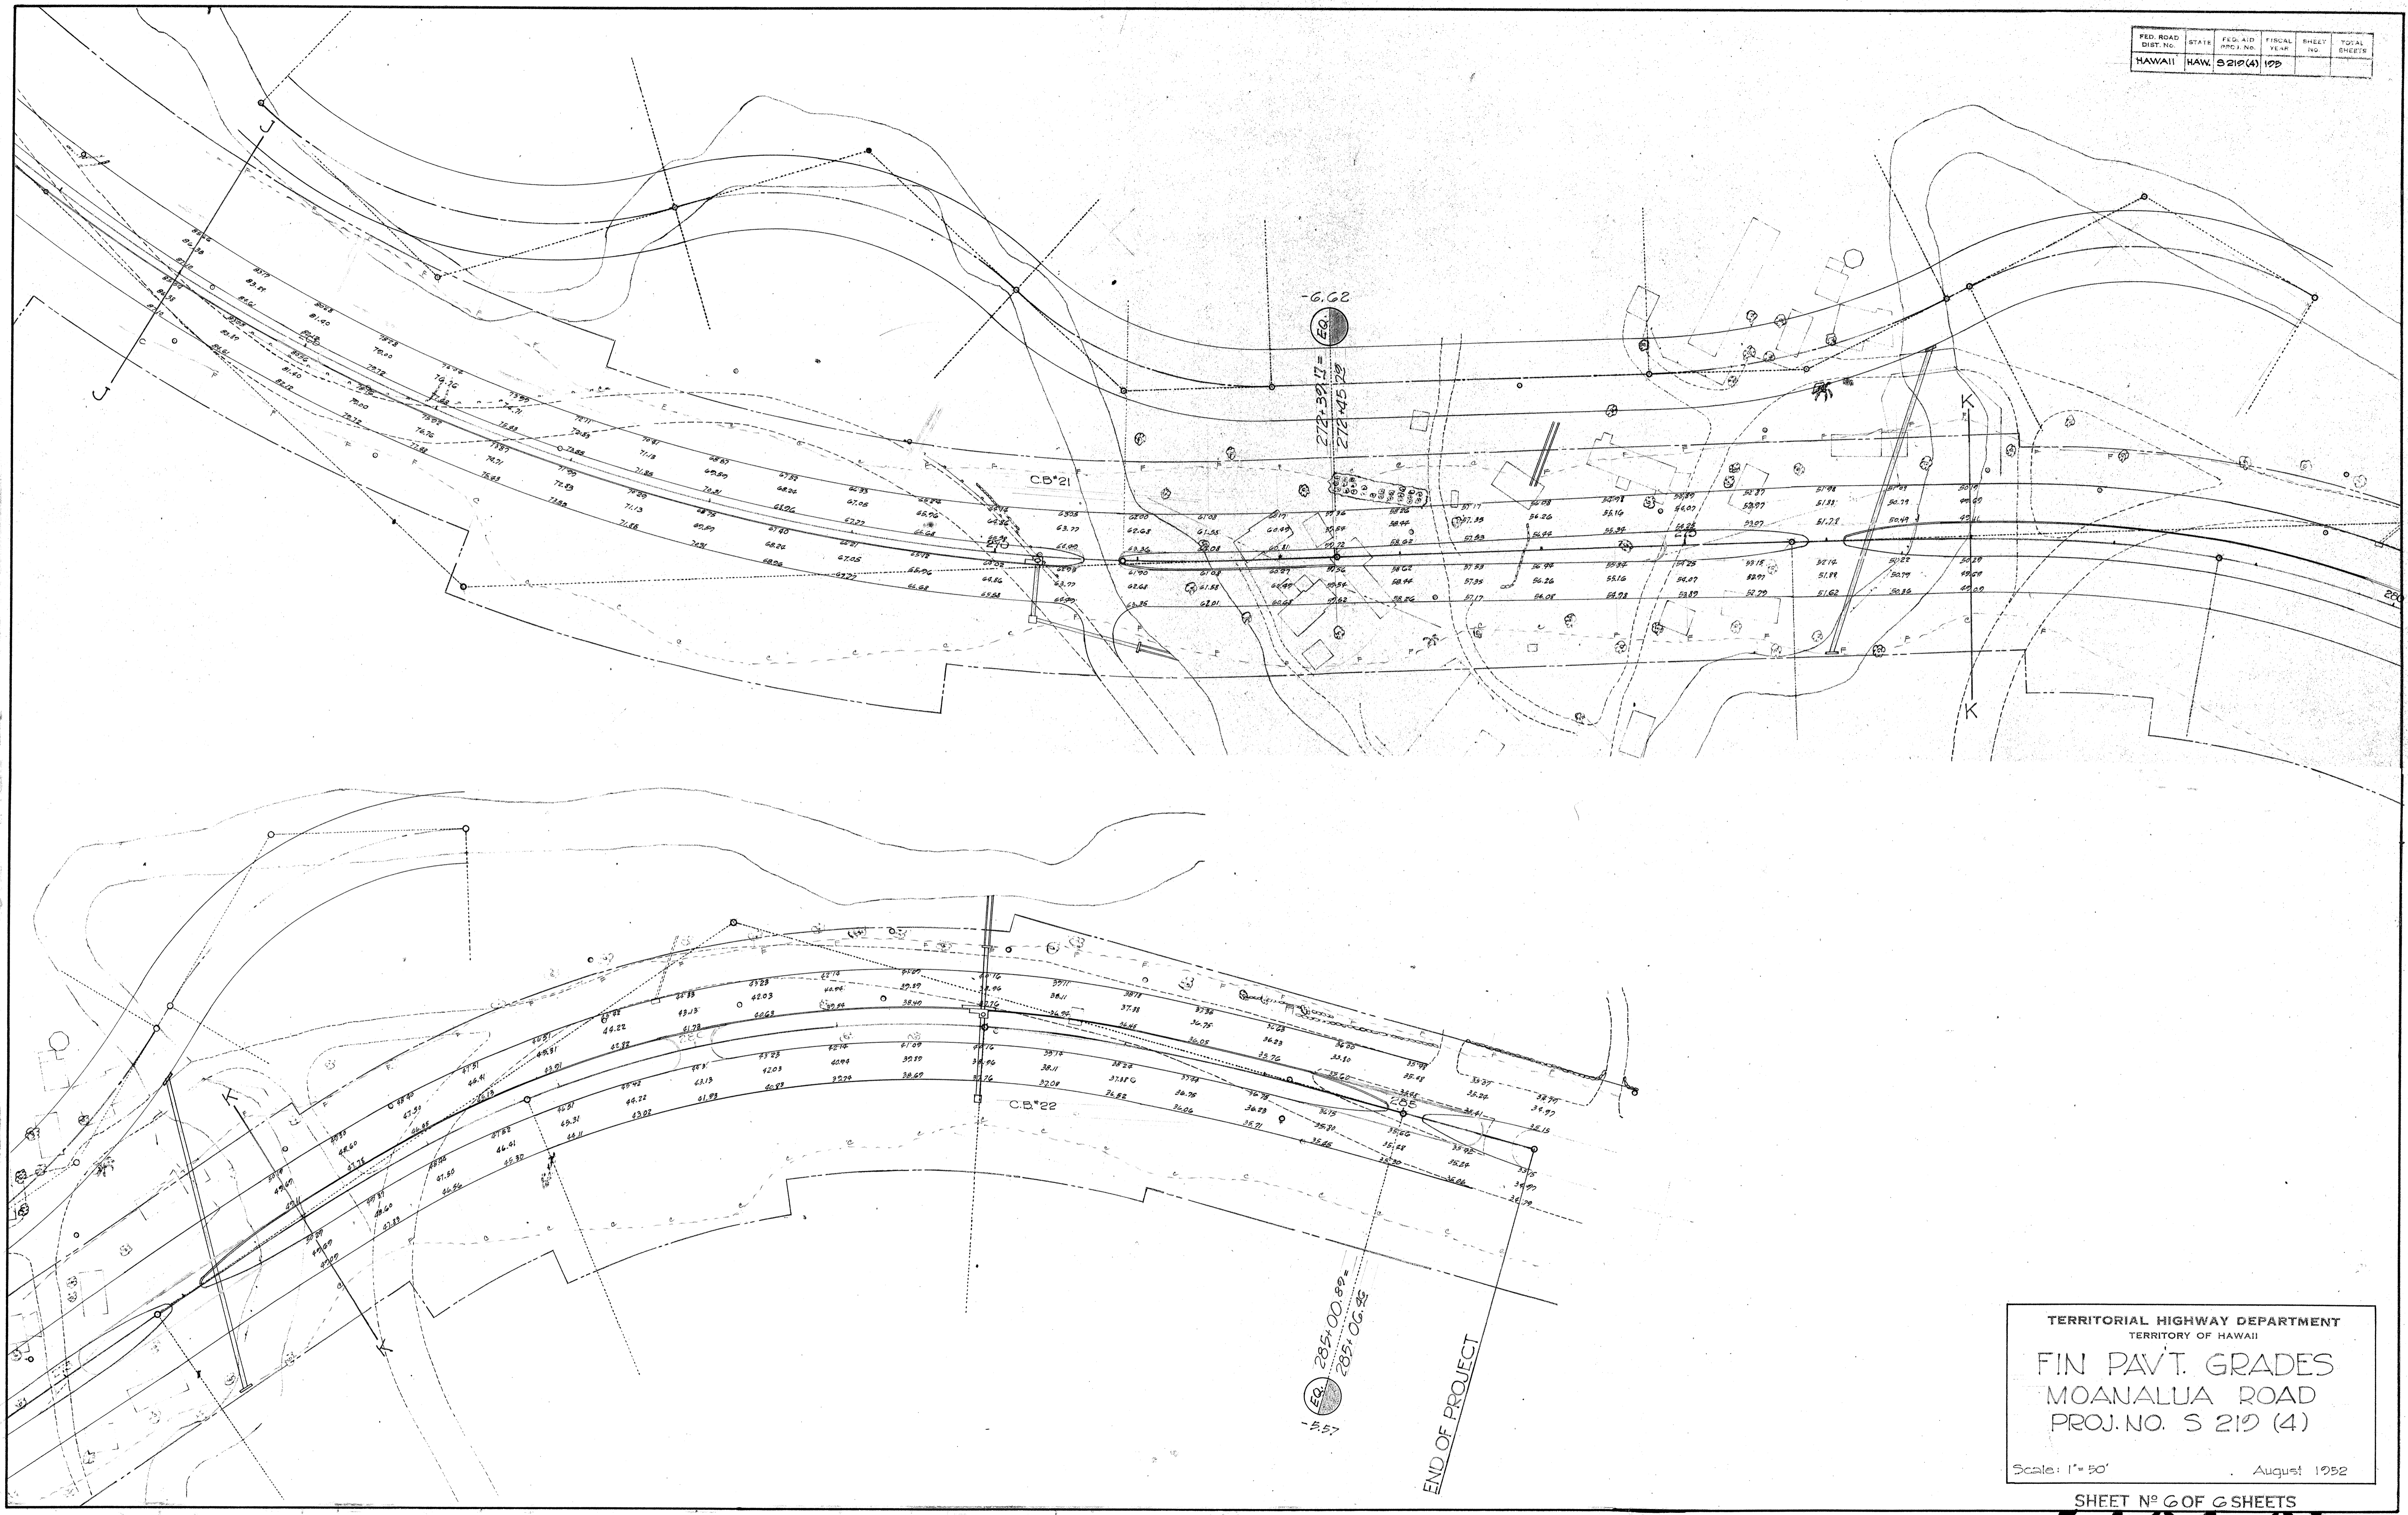

TERRITORIAL HIGHWAY DEPARTMENT
 TERRITORY OF HAWAII
 FIN PAVT. GRADES
 MOANALUA ROAD
 PROJ. NO. S 219 (4)
 Scale: 1" = 50' August 1952

SHEET N° 6 OF 6 SHEETS

5491.31