

INDEX TO DRAWINGS	
SHEET NO.	DESCRIPTION
1	TITLE SHEET

FED. ROAD DIST. NO.	STATE	FED. AID PROJ. NO.	FISCAL YEAR	SHEET NO.	TOTAL SHEETS
HAWAII	HAW.	WDR18(2)	1952	1	1

TERRITORY OF HAWAII
TERRITORIAL HIGHWAY DEPARTMENT
HONOLULU, OAHU, T. H.

PLANS OF REHABILITATION OF A PORTION OF MOANALUA ROAD

WAR DAMAGE REHABILITATION PROJECT NO. WDR 18 (2)


EWA & HONOLULU DISTRICTS, ISLAND OF OAHU

CONVENTIONAL SIGNS


Base Line or Centerline	— 125 —
Boundary Lines	— — or — —
Fences (Named)	— — — — —
Existing Roadways	— — — — —
Circular Culvert	— — — — —
Box Culvert	— — — — —
Bridge	— — — — —
Telephone Pole	⊙ T.P.
Electric Power Pole	⊙ E.P.P.
Water Main	— W ₂ — W ₂ (W 4 8 12, Etc.)
Storm Drain	— SD ₁₂ — SD ₁₂ (SD 18 24, Etc.)
Concrete Drop Intake	— C.D.I. —
Standard Catch Basin	— — — — —
Standard Manhole	⊙ M.H.
Sewer Manhole	⊙ S.M.H.
Telephone Manhole	⊙ T.M.H.
Fire Hydrant	⊙ F.H.
Tree (Large, named)	Manoa Coco
Railroad	— — — — —

SCALES

PLAN	1 INCH = 50 FEET
PROFILE	HOR.	1 INCH = 50 FEET
	VER.	1 INCH = 10 FEET
CROSS SECTION	HOR.	1 INCH = 10 FEET
	VER.	1 INCH = 10 FEET

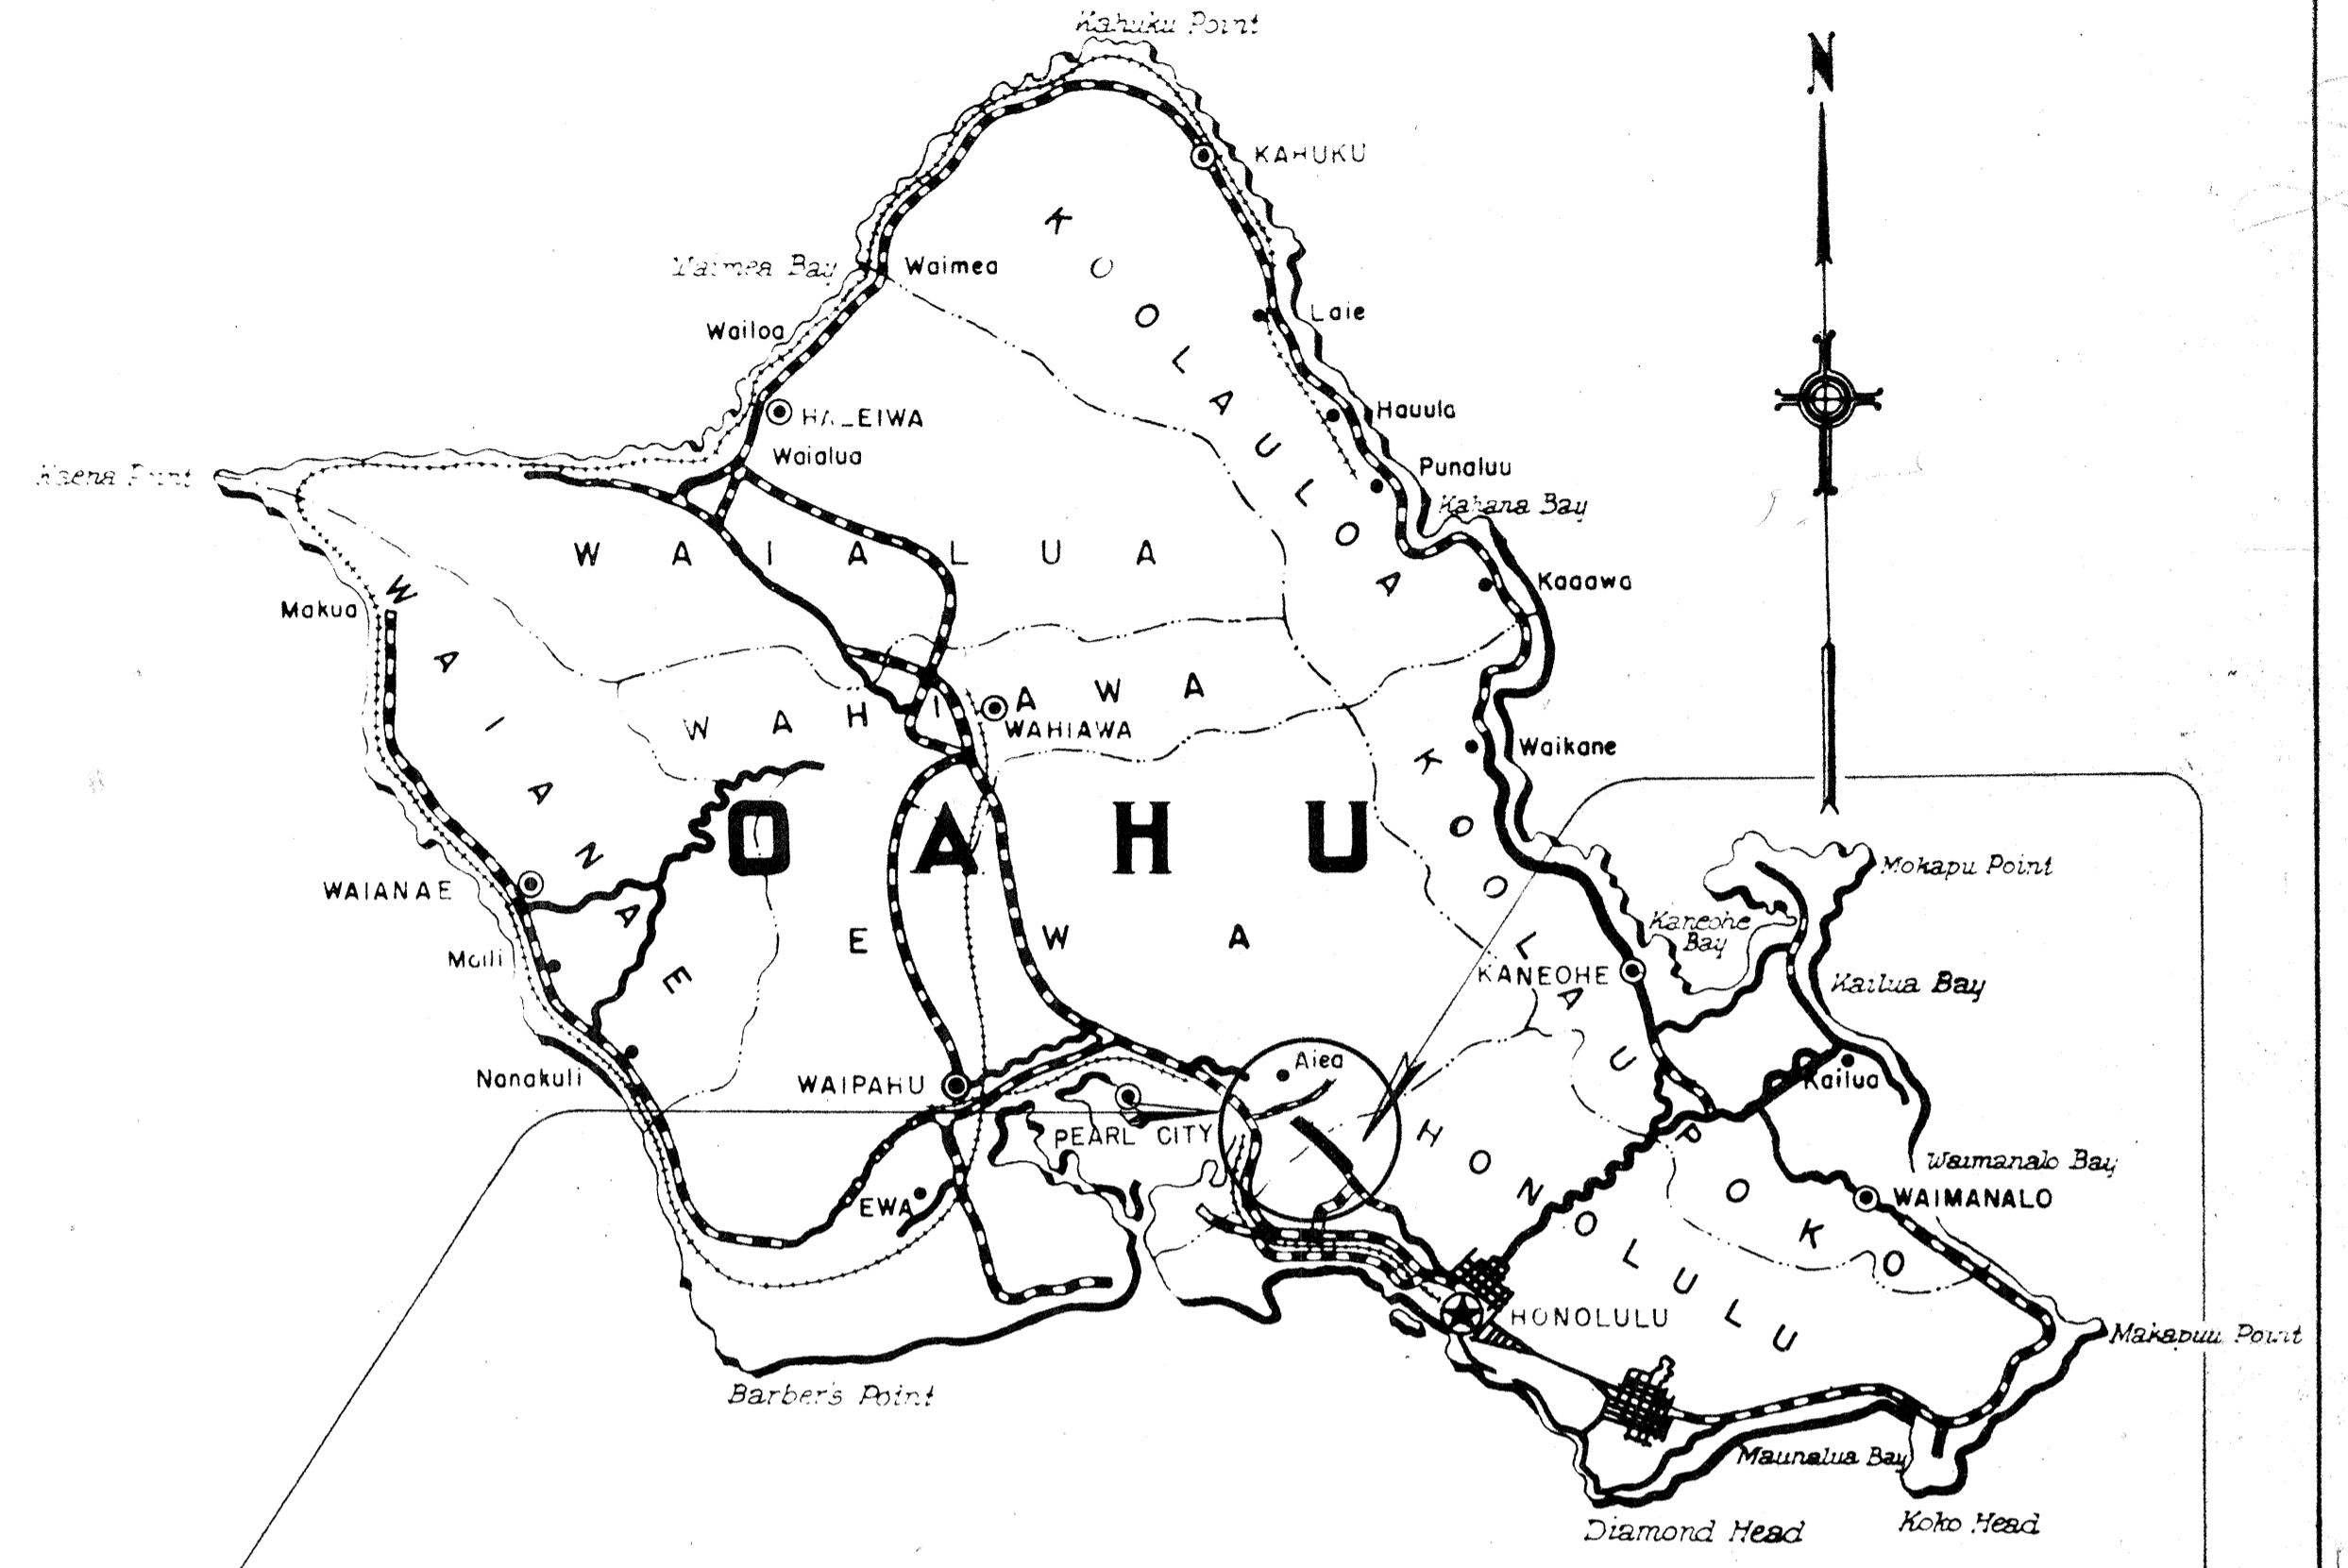

BEG. OF PROJECT **WAR DAMAGE REHABILITATION PROJECT** **END OF PROJECT**
 STA. 141 + 00 **NO. WDR 18 (2)** STA. 178 + 00
 Federal Aid Projects Previously Constructed Or Under Construction

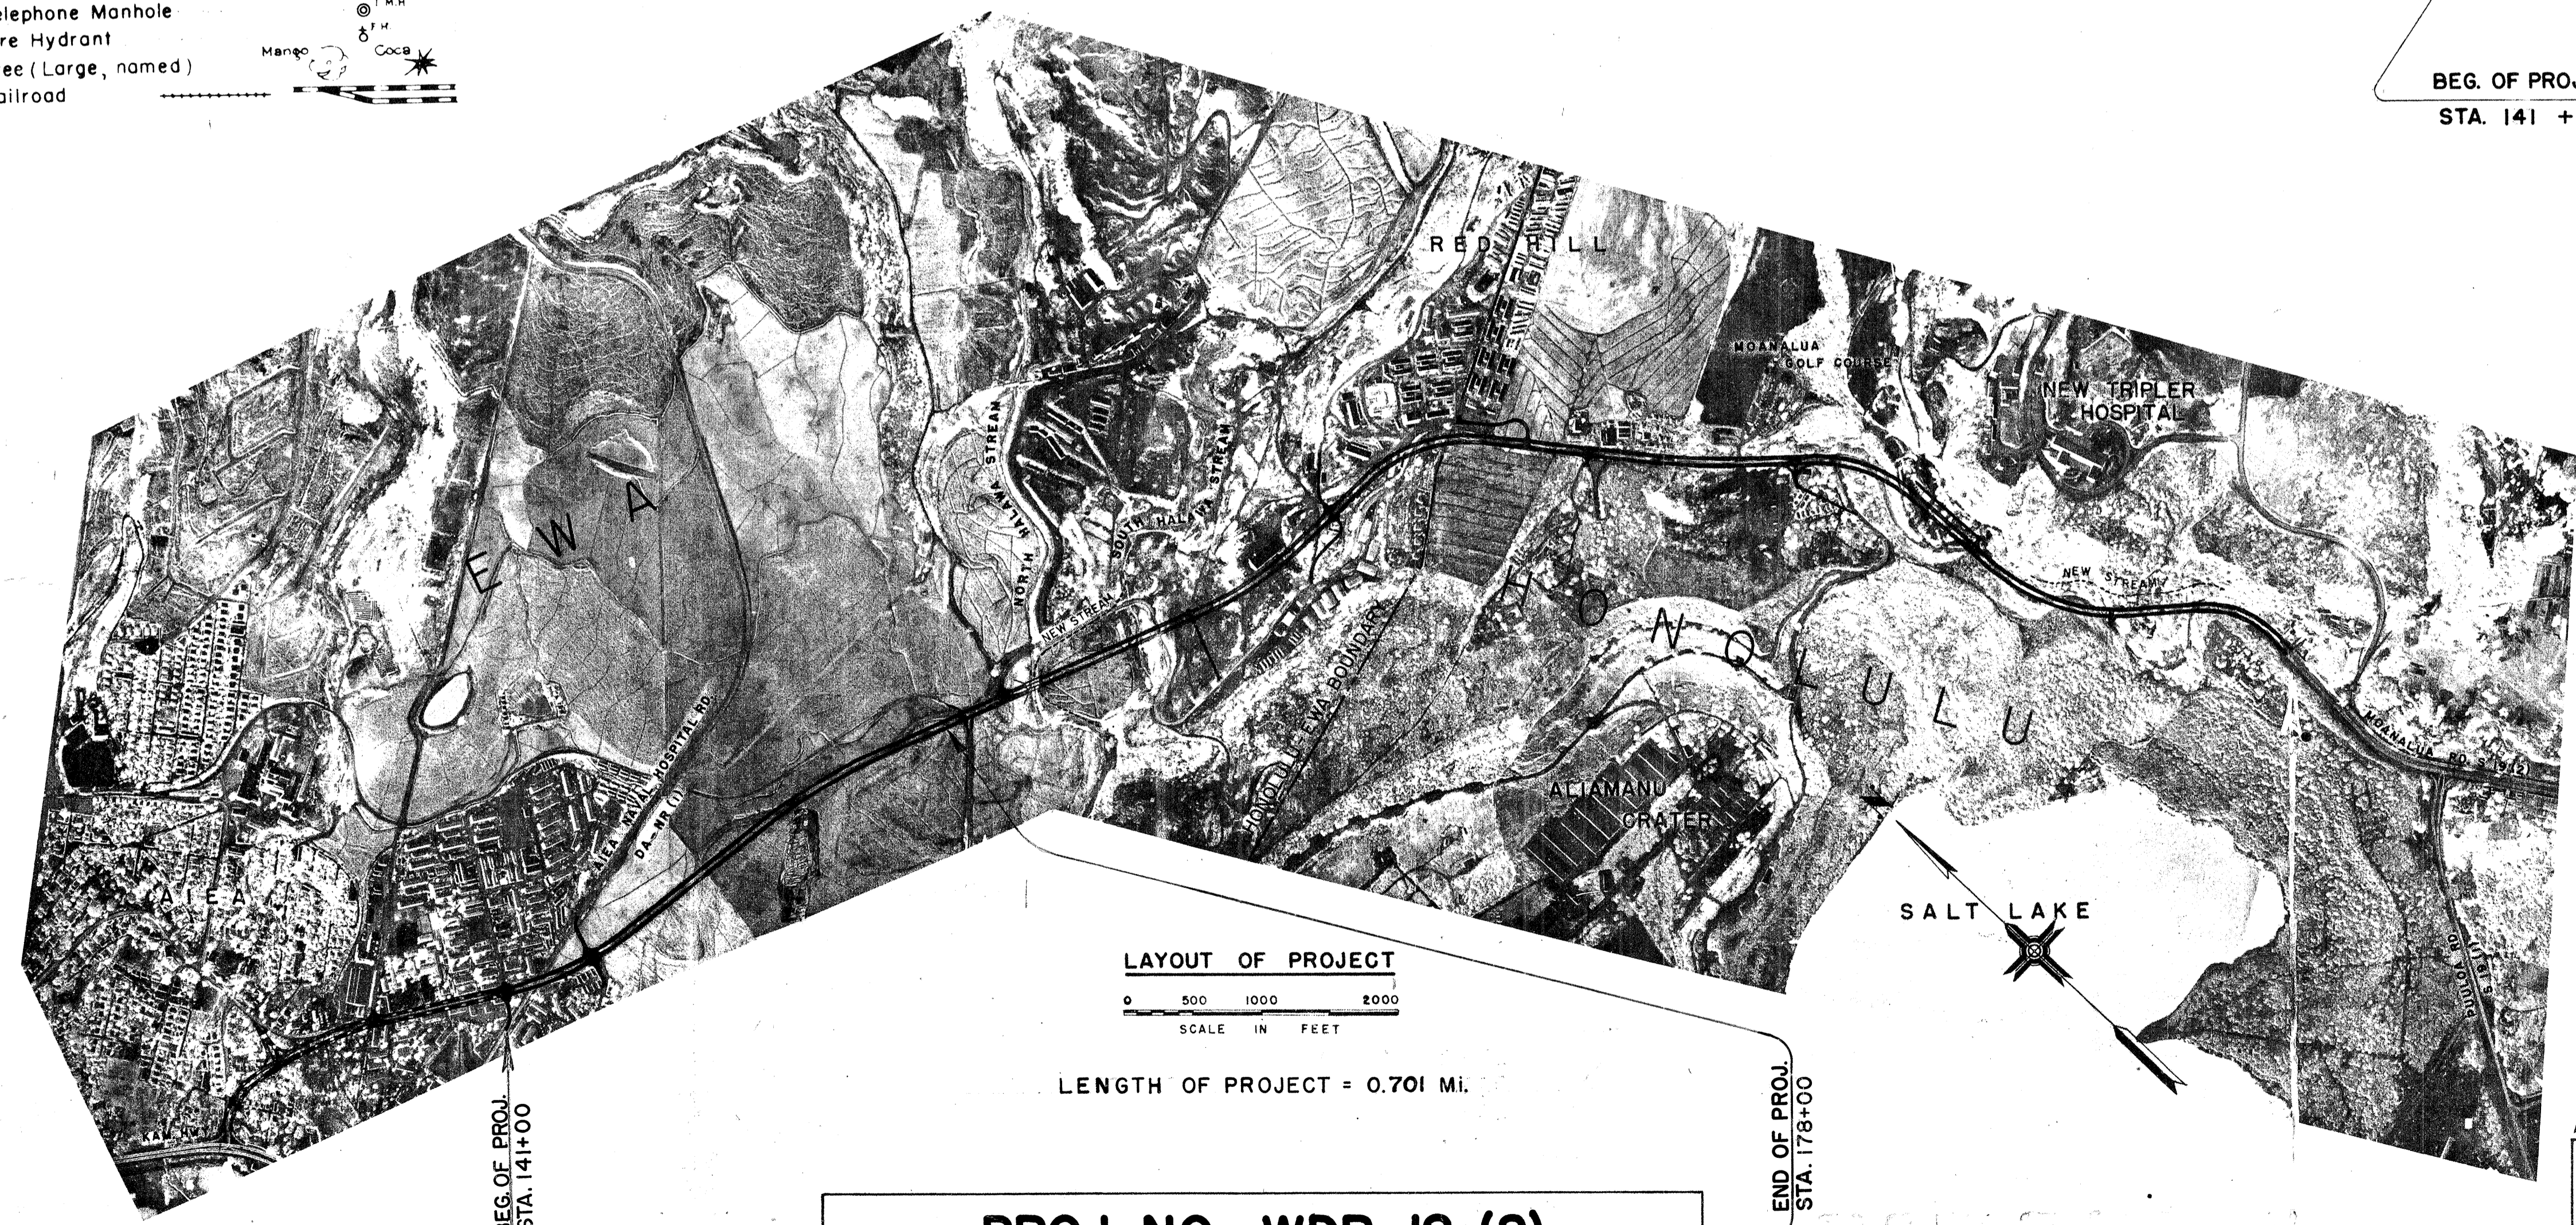

DATE _____
 SURVEY PLOTTED BY _____
 ORIGINAL DESIGNED BY _____
 PLAN TRACED BY _____
 NOTED BY _____
 CHECKED BY _____

APPROVED _____ DATE 10-16-52
 TERRITORIAL HIGHWAY ENGINEER

DEPARTMENT OF COMMERCE
 BUREAU OF PUBLIC ROADS
 RECOMMENDED FOR APPROVAL:

DISTRICT ENGINEER	DATE
DIVISION ENGINEER	DATE

PROJ. NO. WDR 18 (2)

5606.1