


FED. ROAD DIST. NO.	STATE	FED. AID PROJ. NO.	FISCAL YEAR	SHEET NO.	TOTAL SHEETS
HAWAII	HAW	5219(6)	1954	27	31

DATE	BY	FINAL SURVEY	NO.
		SURVEYED	
		NOTE BOOK	
		TEMP. PLATE	
		AREAS CHECKED	


DATE	BY	ORIGINAL SURVEY	NO.
		SURVEYED	
		NOTE BOOK	
		TEMP. PLATE	
		AREAS CHECKED	

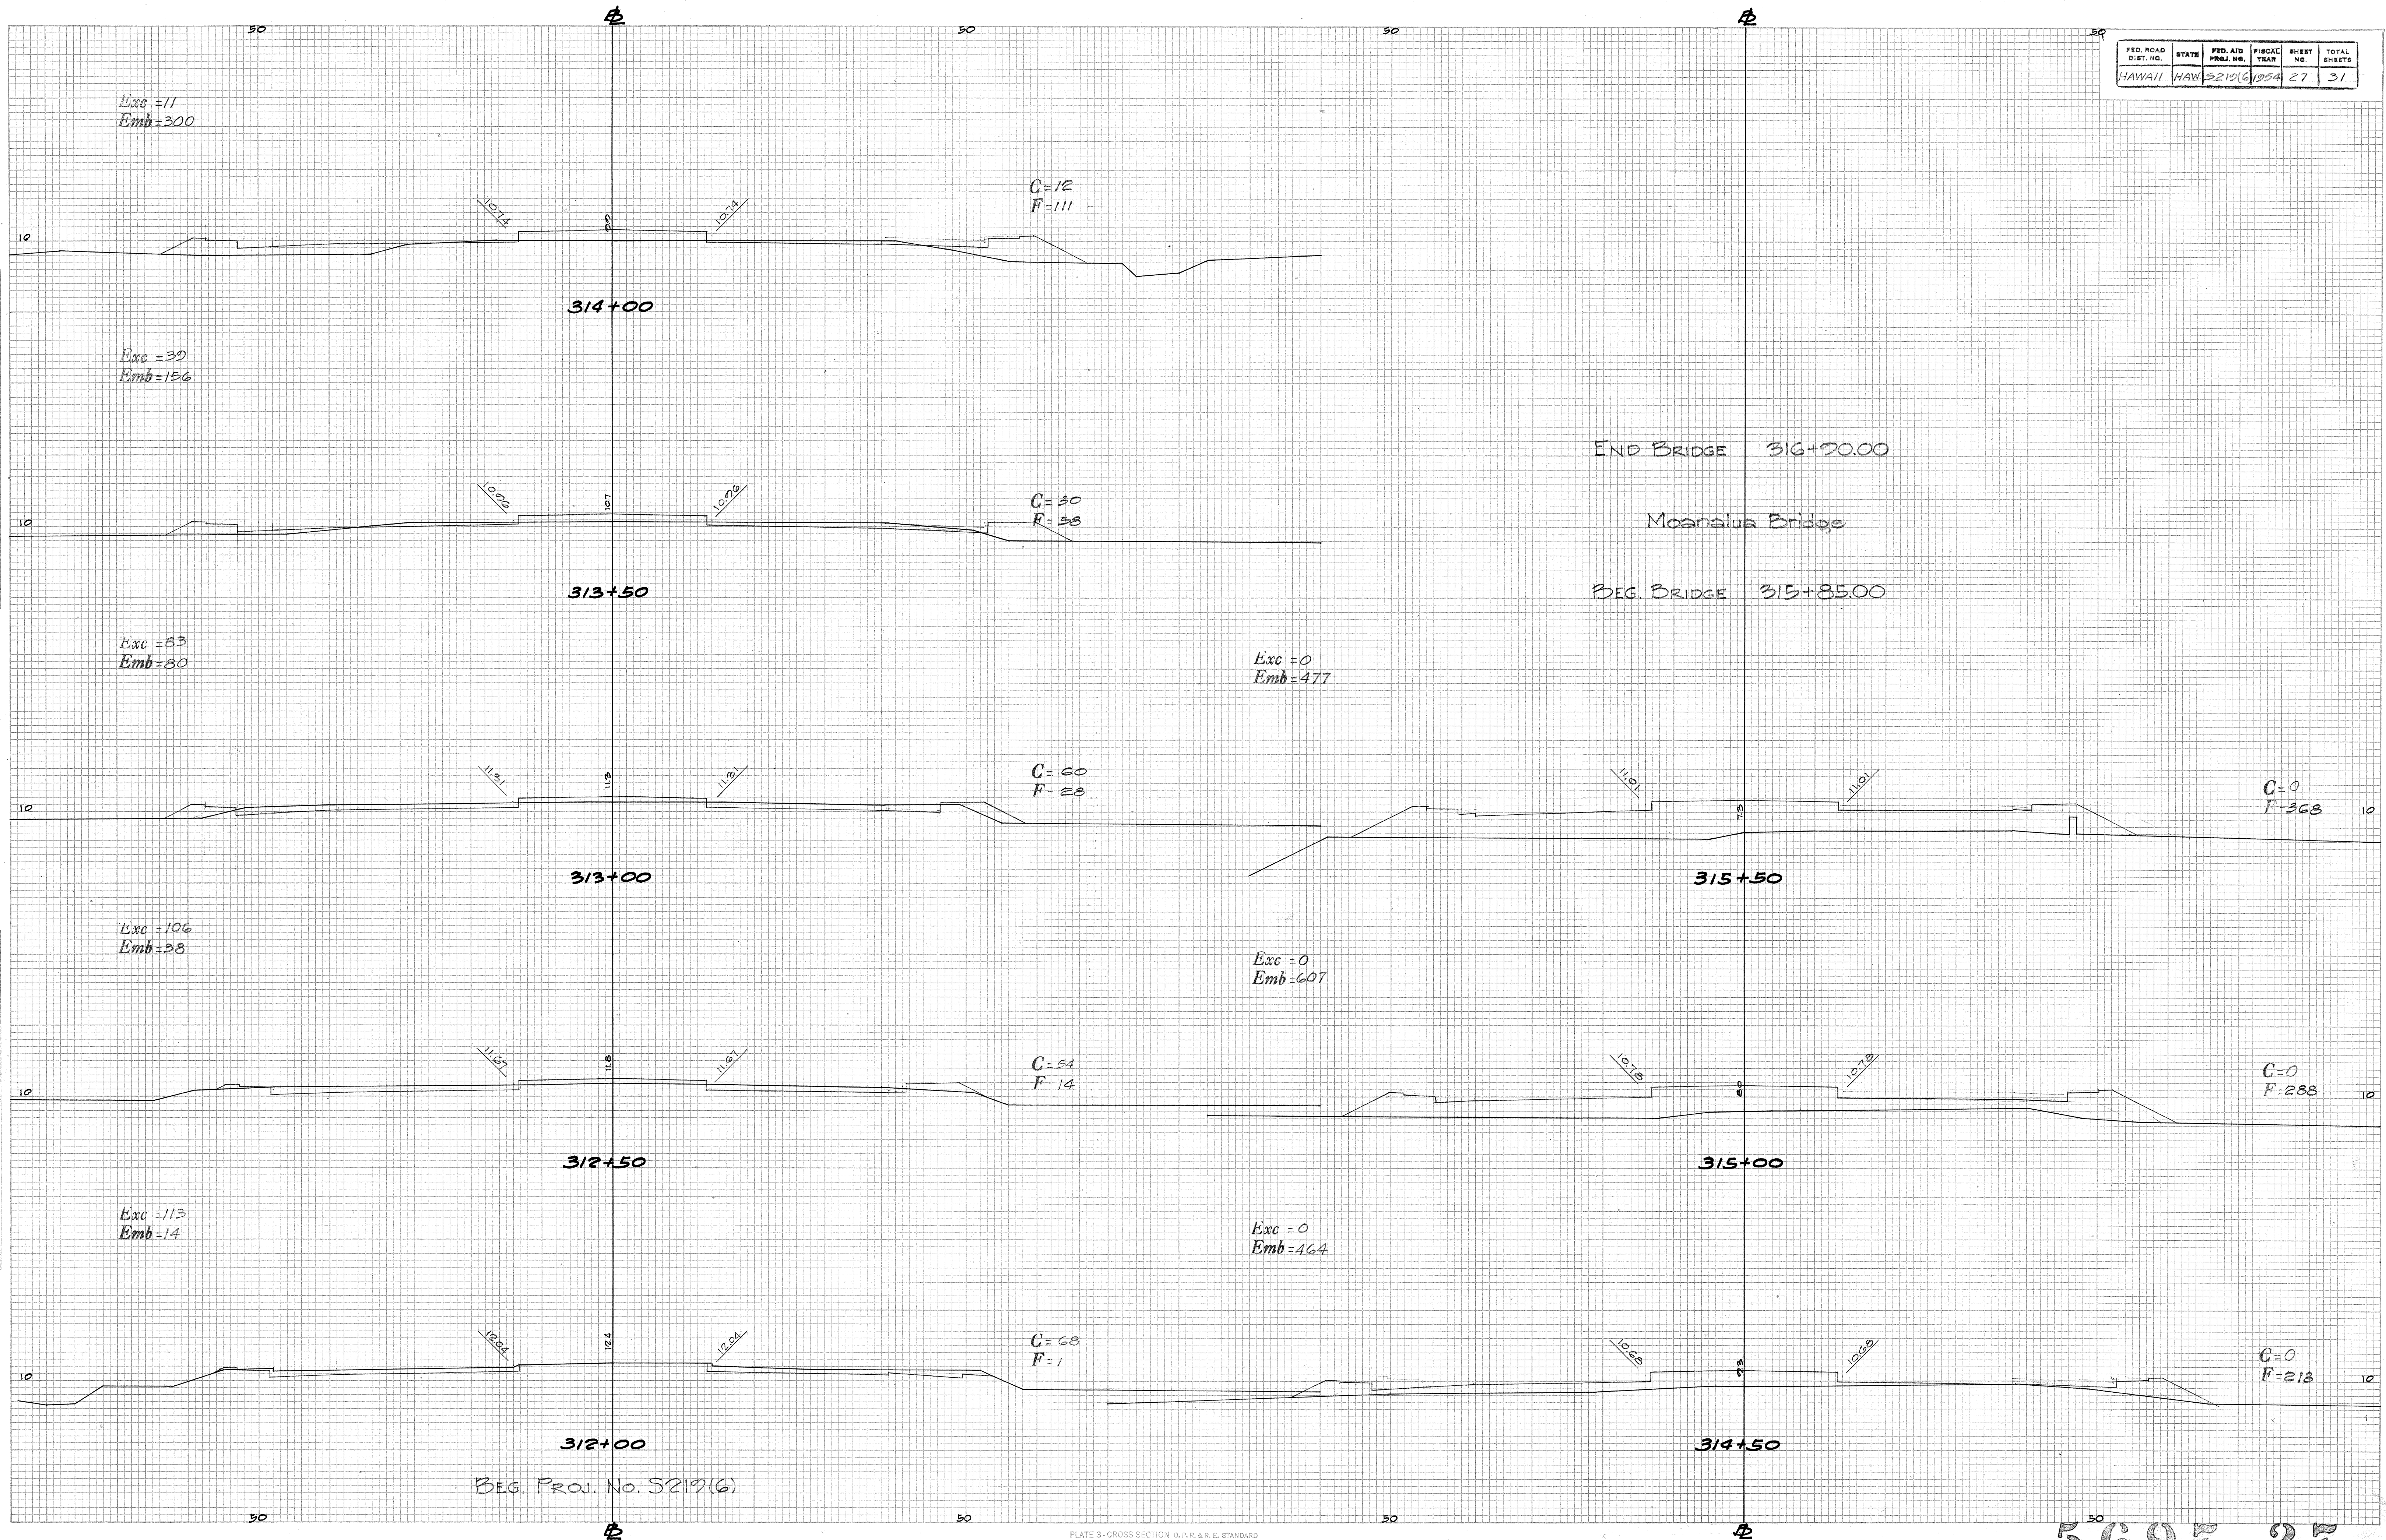

FED. ROAD DIST. NO.	STATE	FED. AID PROJ. NO.	FISCAL YEAR	SHEET NO.	TOTAL SHEETS
HAWAII	HAW	52196	1954	28	31

FINAL SURVEY	DATE	BY
SURVEYED		
PLOTTED		
TEMP. PLATE		
NOTE BOOK		
AREAS CHECKED		
NO.		

ORIGINAL SURVEY	DATE	BY
SURVEYED		
PLOTTED		
TEMP. PLATE		
NOTE BOOK		
AREAS CHECKED		
NO.		

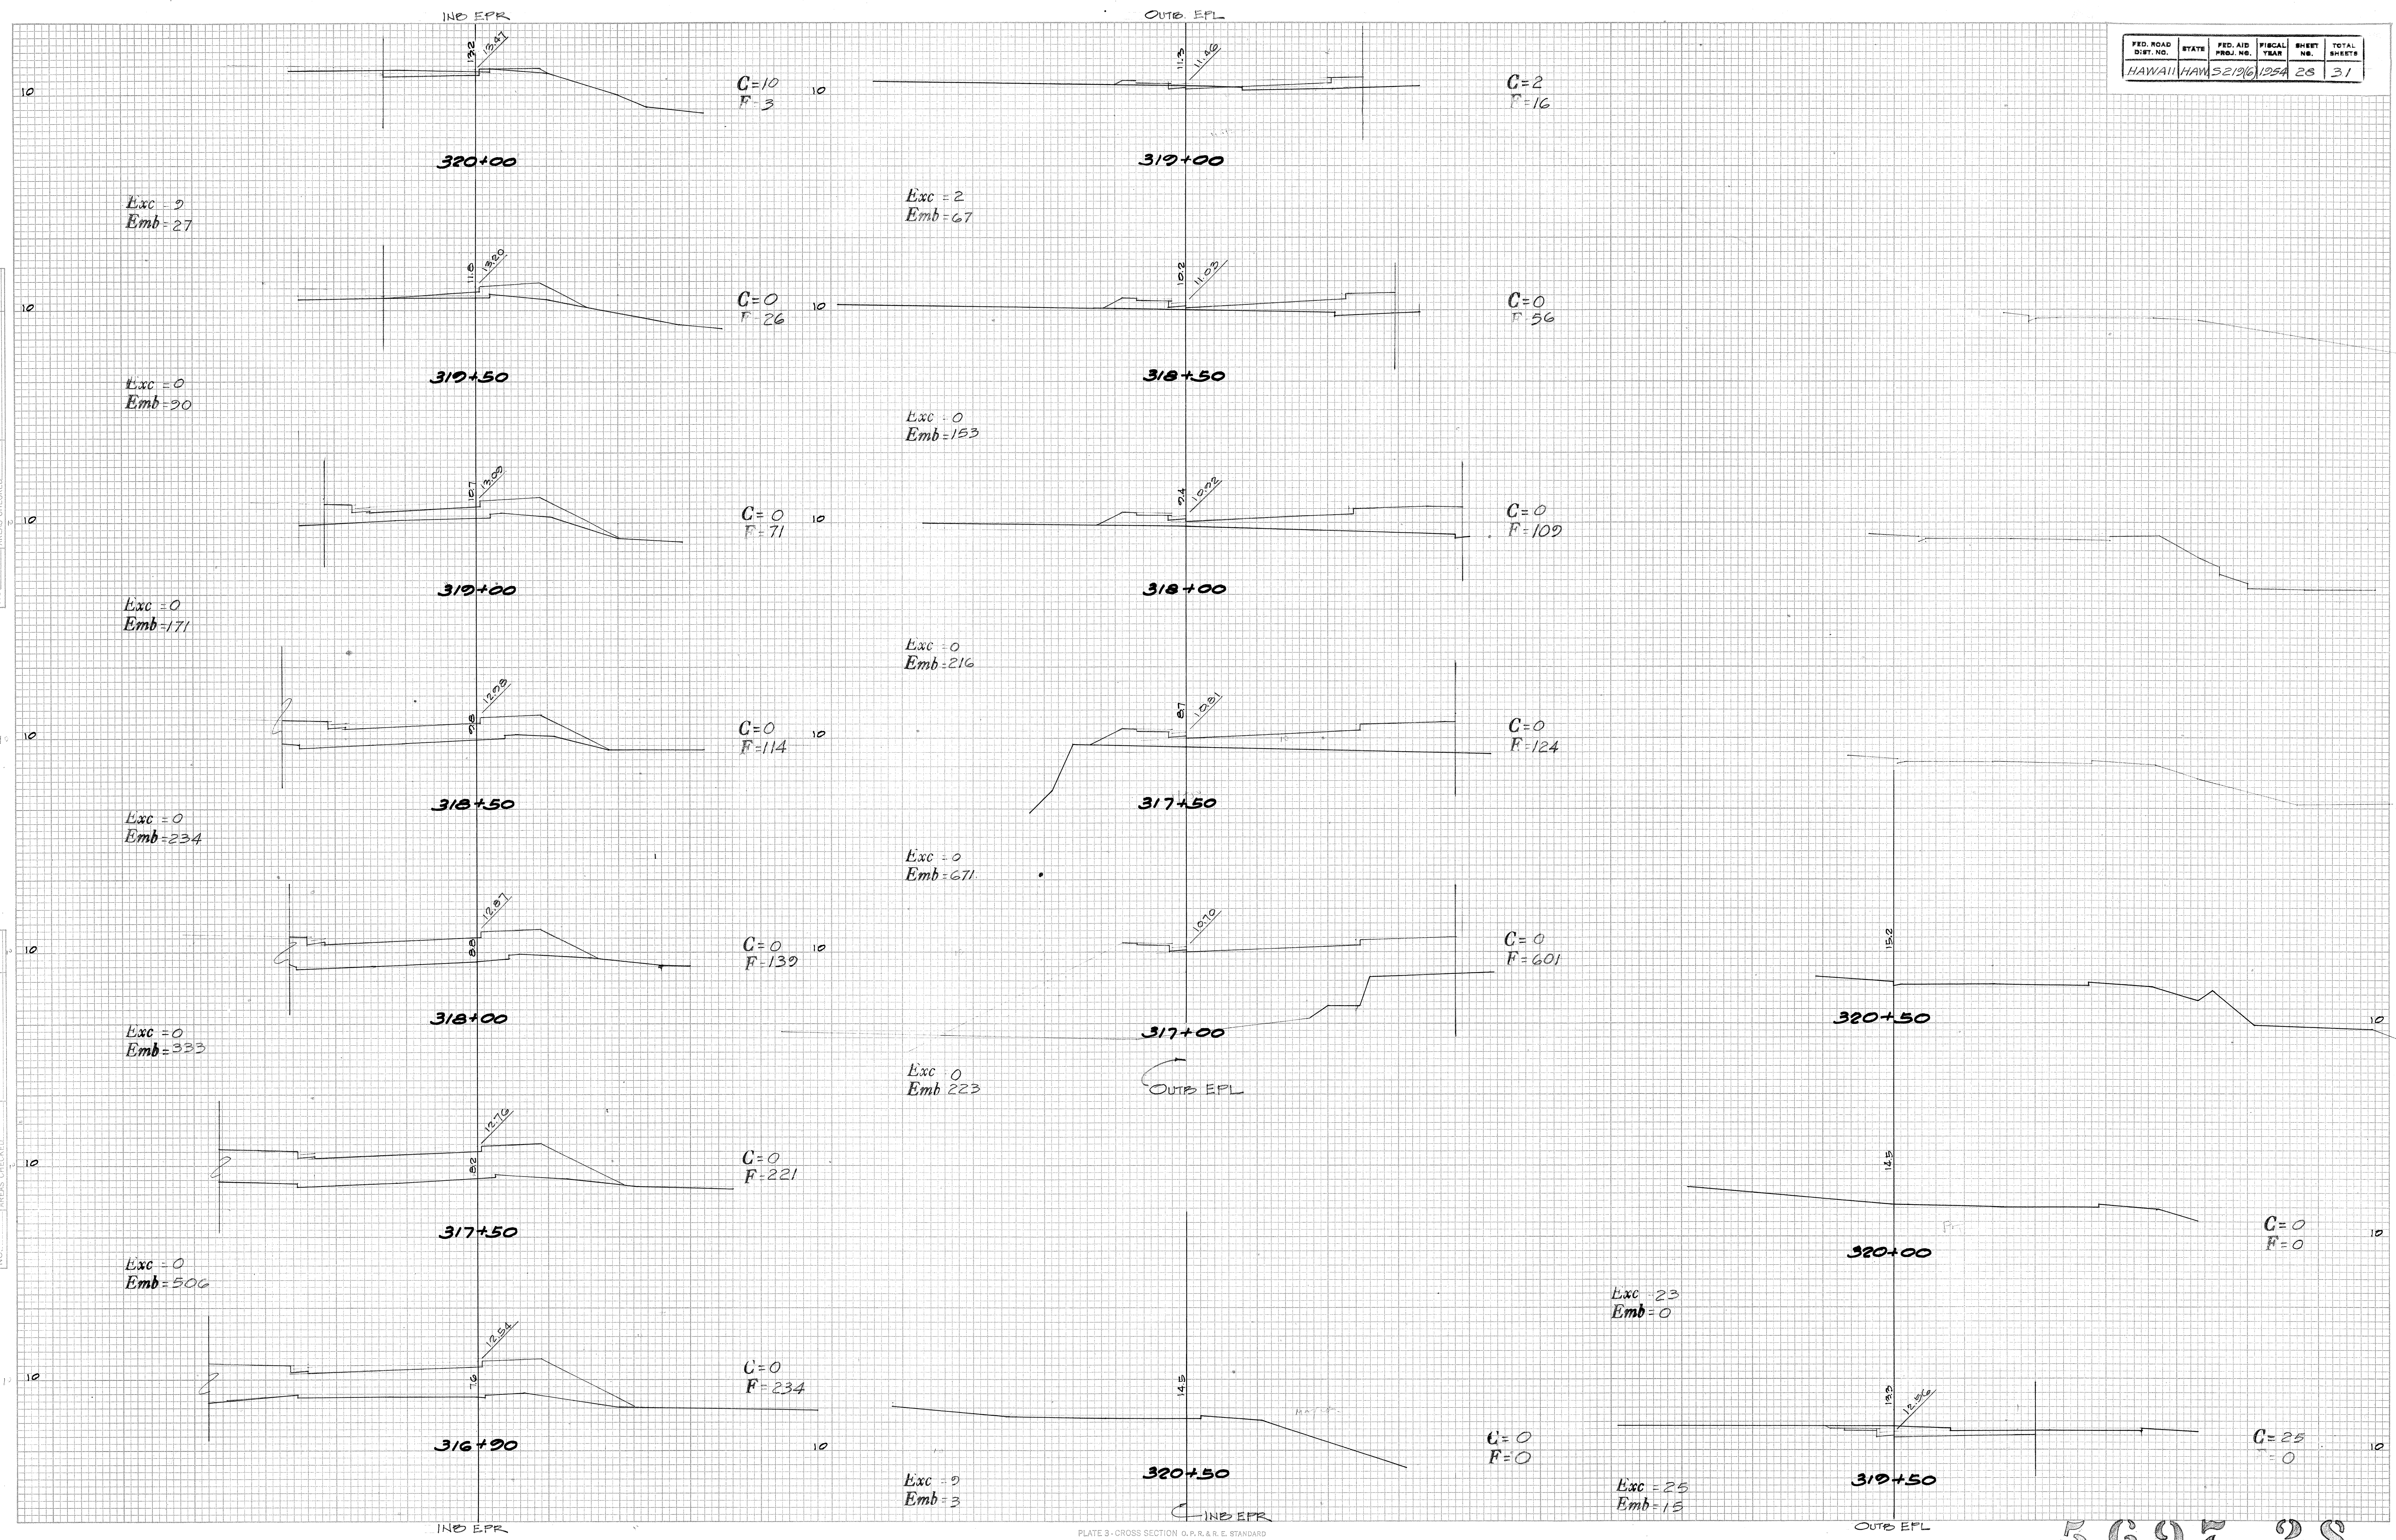


5697.28

FED. ROAD DIST. NO.	STATE	FED. AID PROJ. NO.	FISCAL YEAR	SHEET NO.	TOTAL SHEETS
HAWAII	HAW	5219(6)	1954	29	31


FINAL SURVEY	DATE
NOTE BOOK NO.	
NO.	
SURVEYED BY	
REMARKS	
AREAS CHECKED	

ORIGINAL SURVEY	DATE
NOTE BOOK NO.	
NO.	
SURVEYED BY	
REMARKS	
AREAS CHECKED	


Exc = 151
Emb = 106

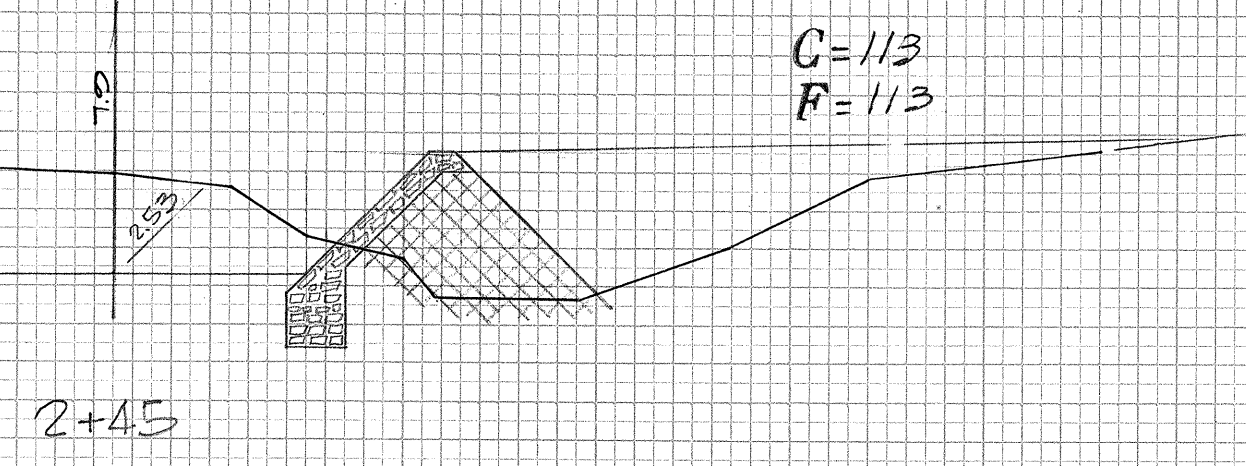


Exc = 688
Emb = 277

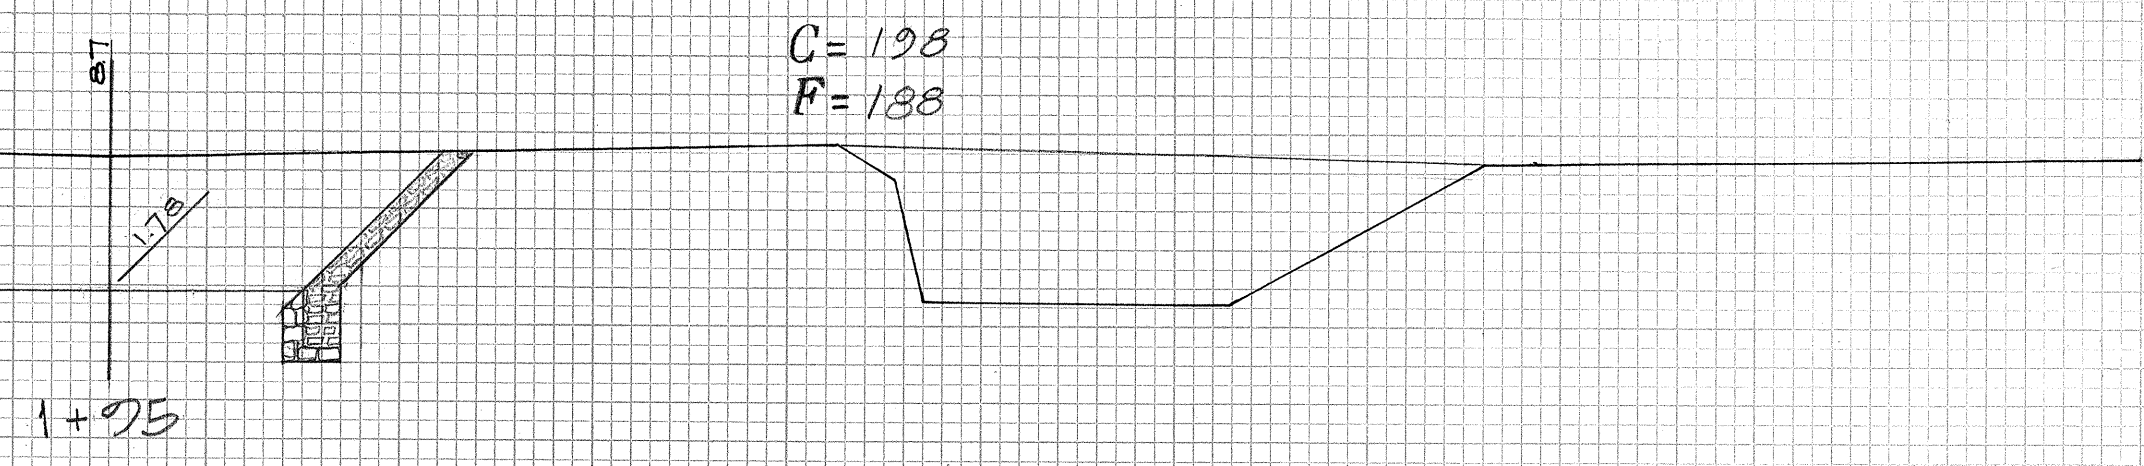


Exc = 367
Emb = 411

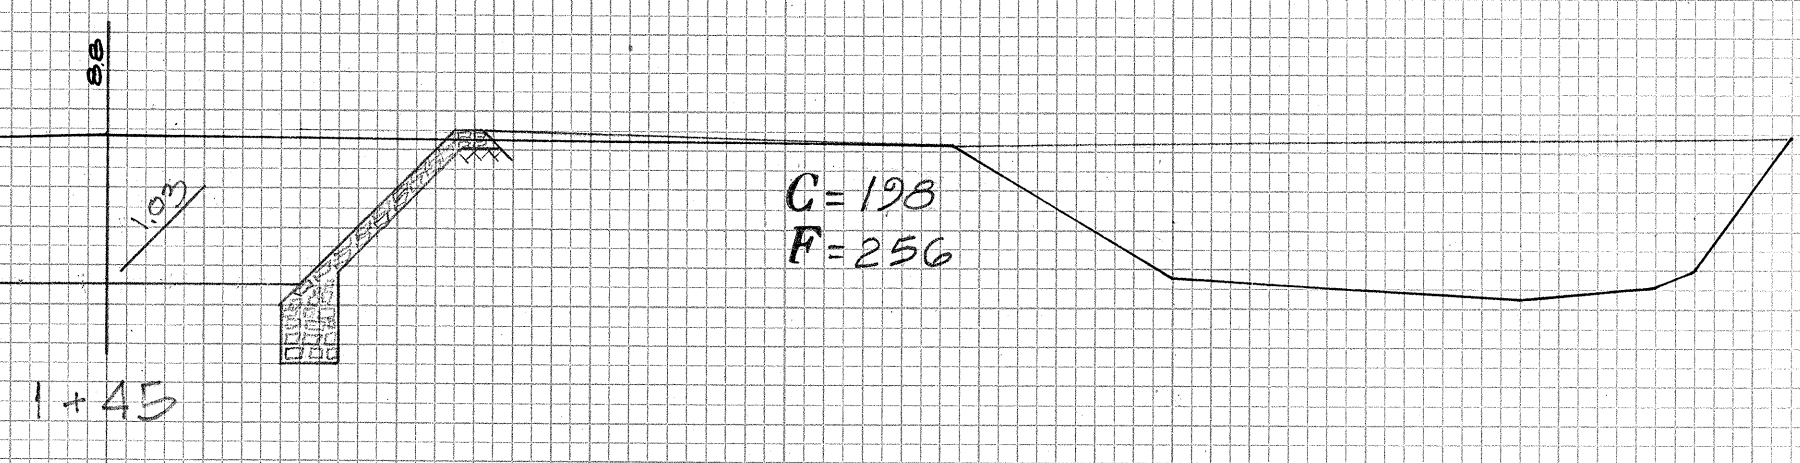


Exc = 184
Emb = 355

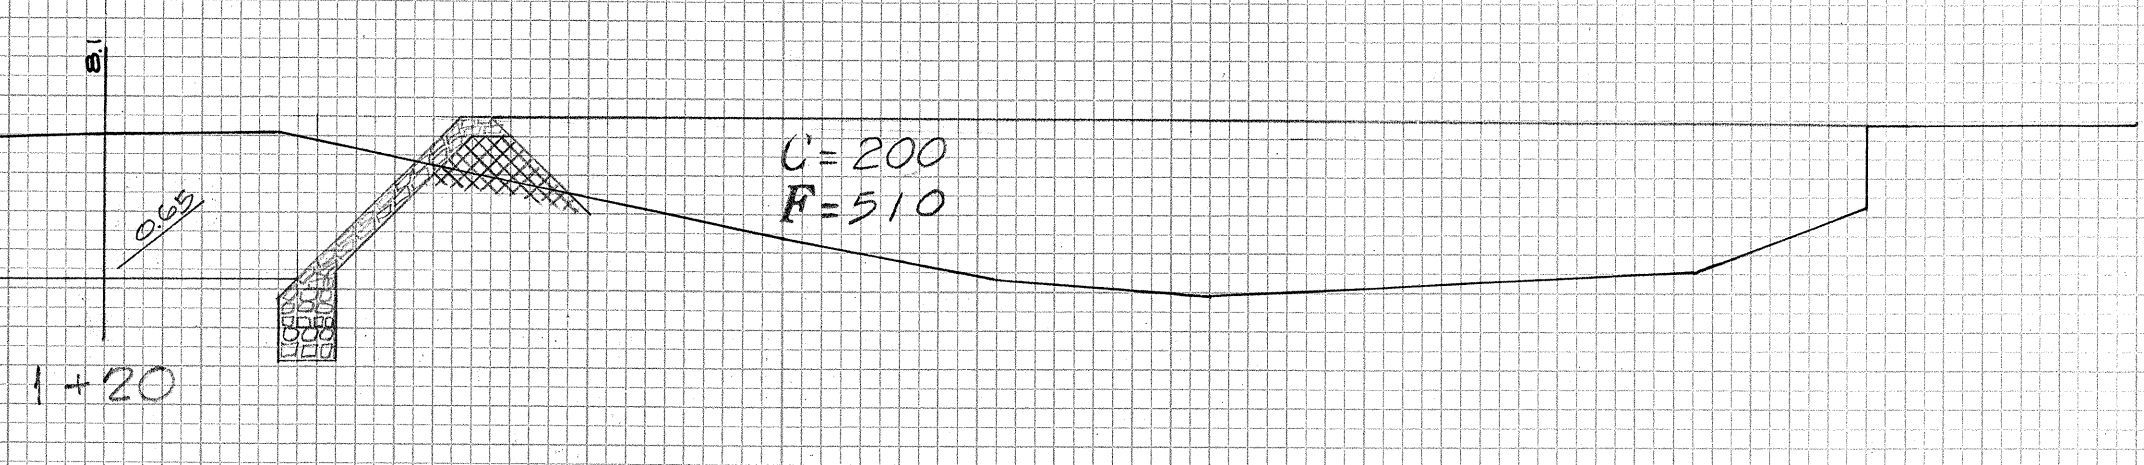

Exc = 93
Emb = 628

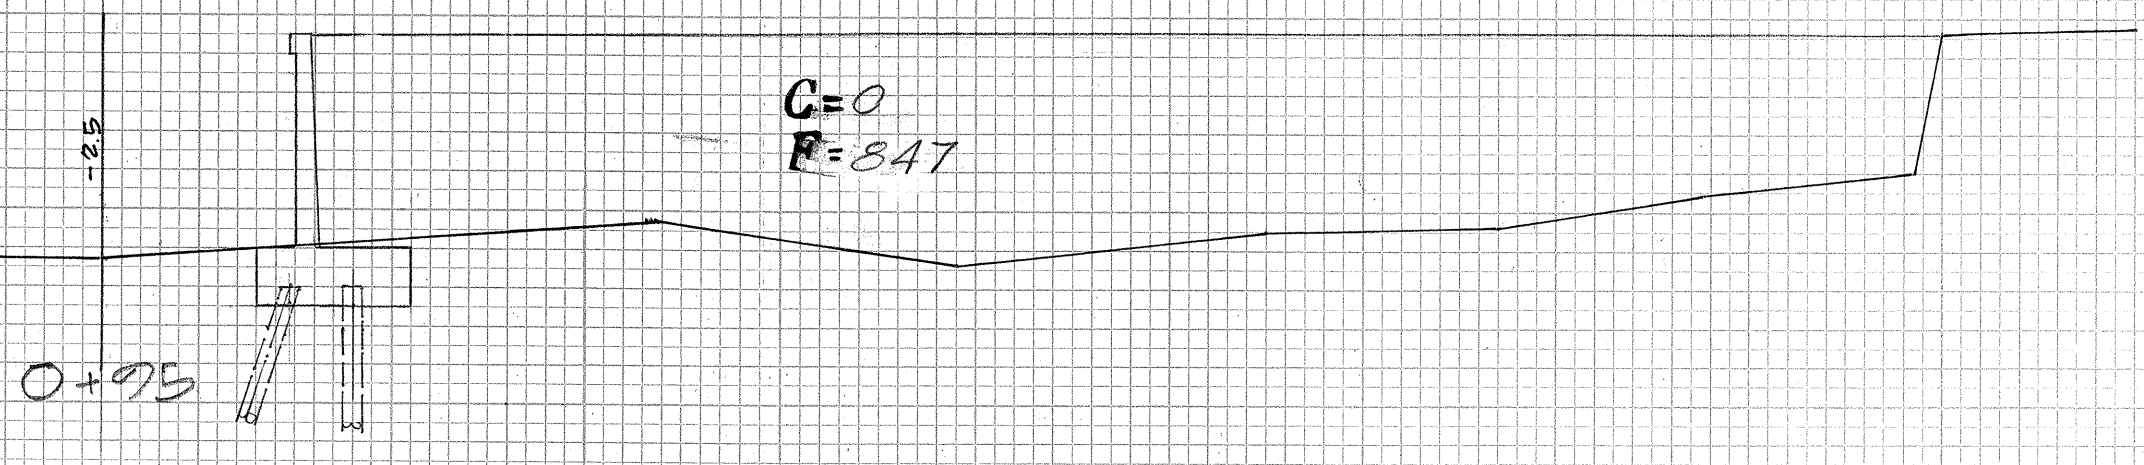


Exc = 0
Emb = 1042

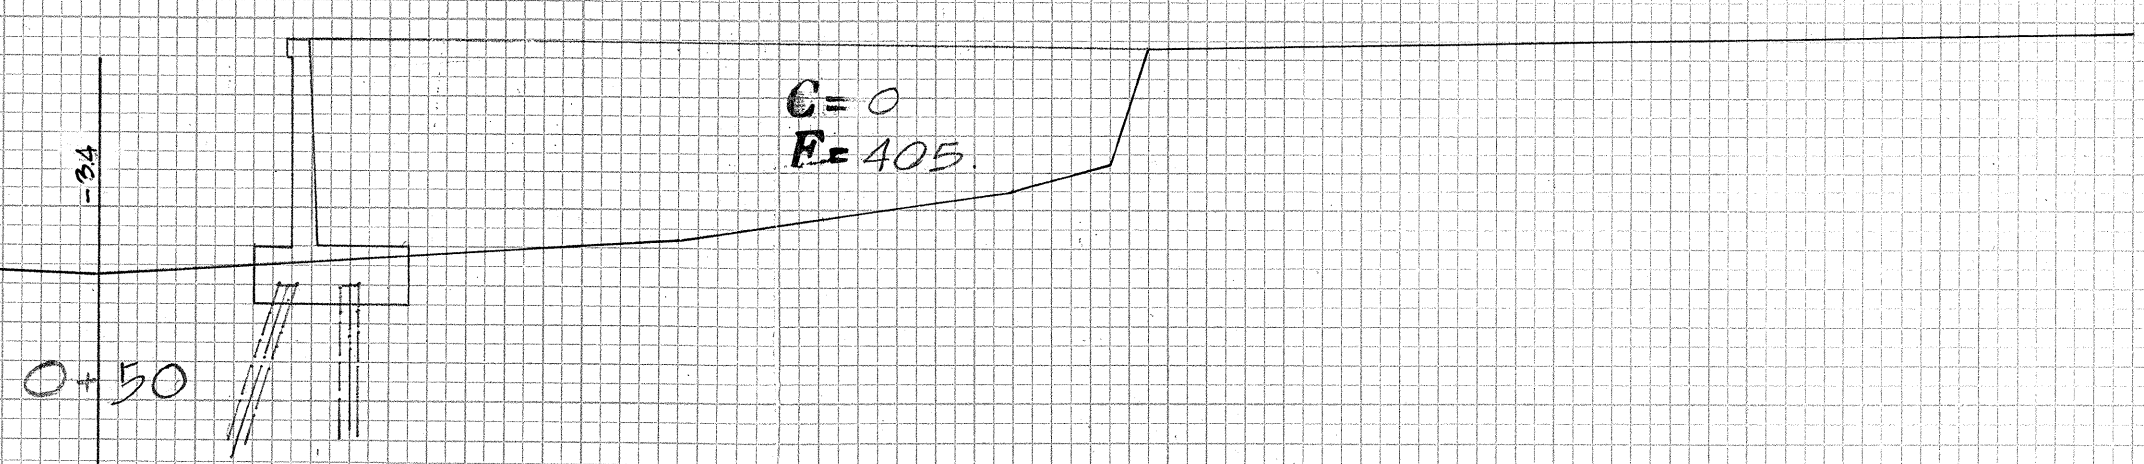

NEW CHANNEL

Exc = 20
Emb = 0

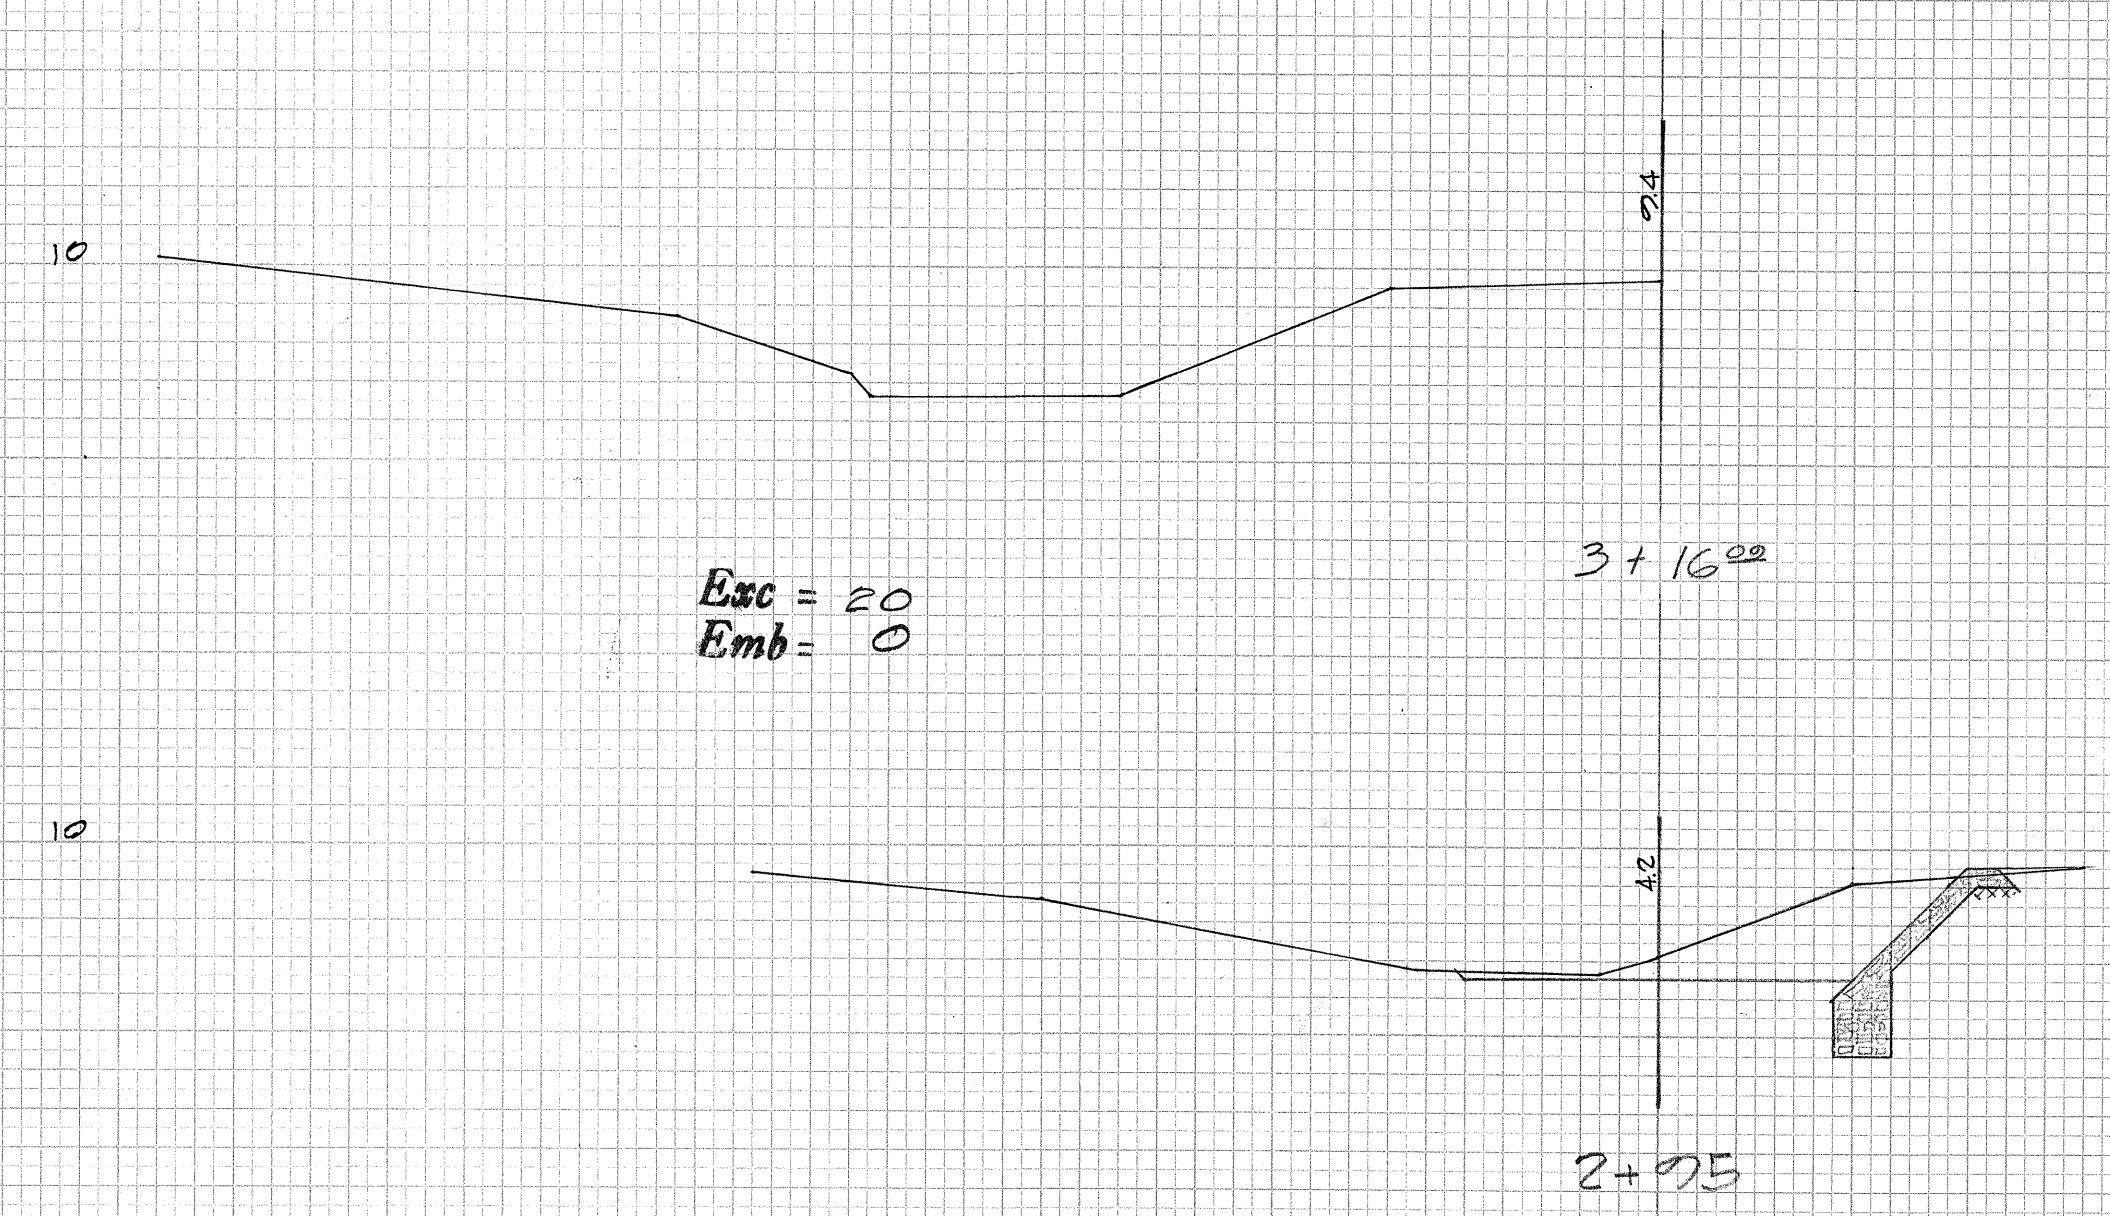

C=50
F=1

NEW CHANNEL


MANAIKI STREAM REALIGNMENT

5697.29

FED. ROAD DIST. NO.	STATE	FED. AID PROJ. NO.	FISCAL YEAR	SHEET NO.	TOTAL SHEETS
HAWAII	HAWAII	52196	1954	30	31

FINAL SURVEY NO.	DATE
	BY
	SURVEYED
	NOTE BOOK
	TEMPLATE
	AREAS CHECKED

ORIGINAL SURVEY NO.	DATE
	BY
	SURVEYED
	NOTE BOOK
	TEMPLATE
	AREAS CHECKED

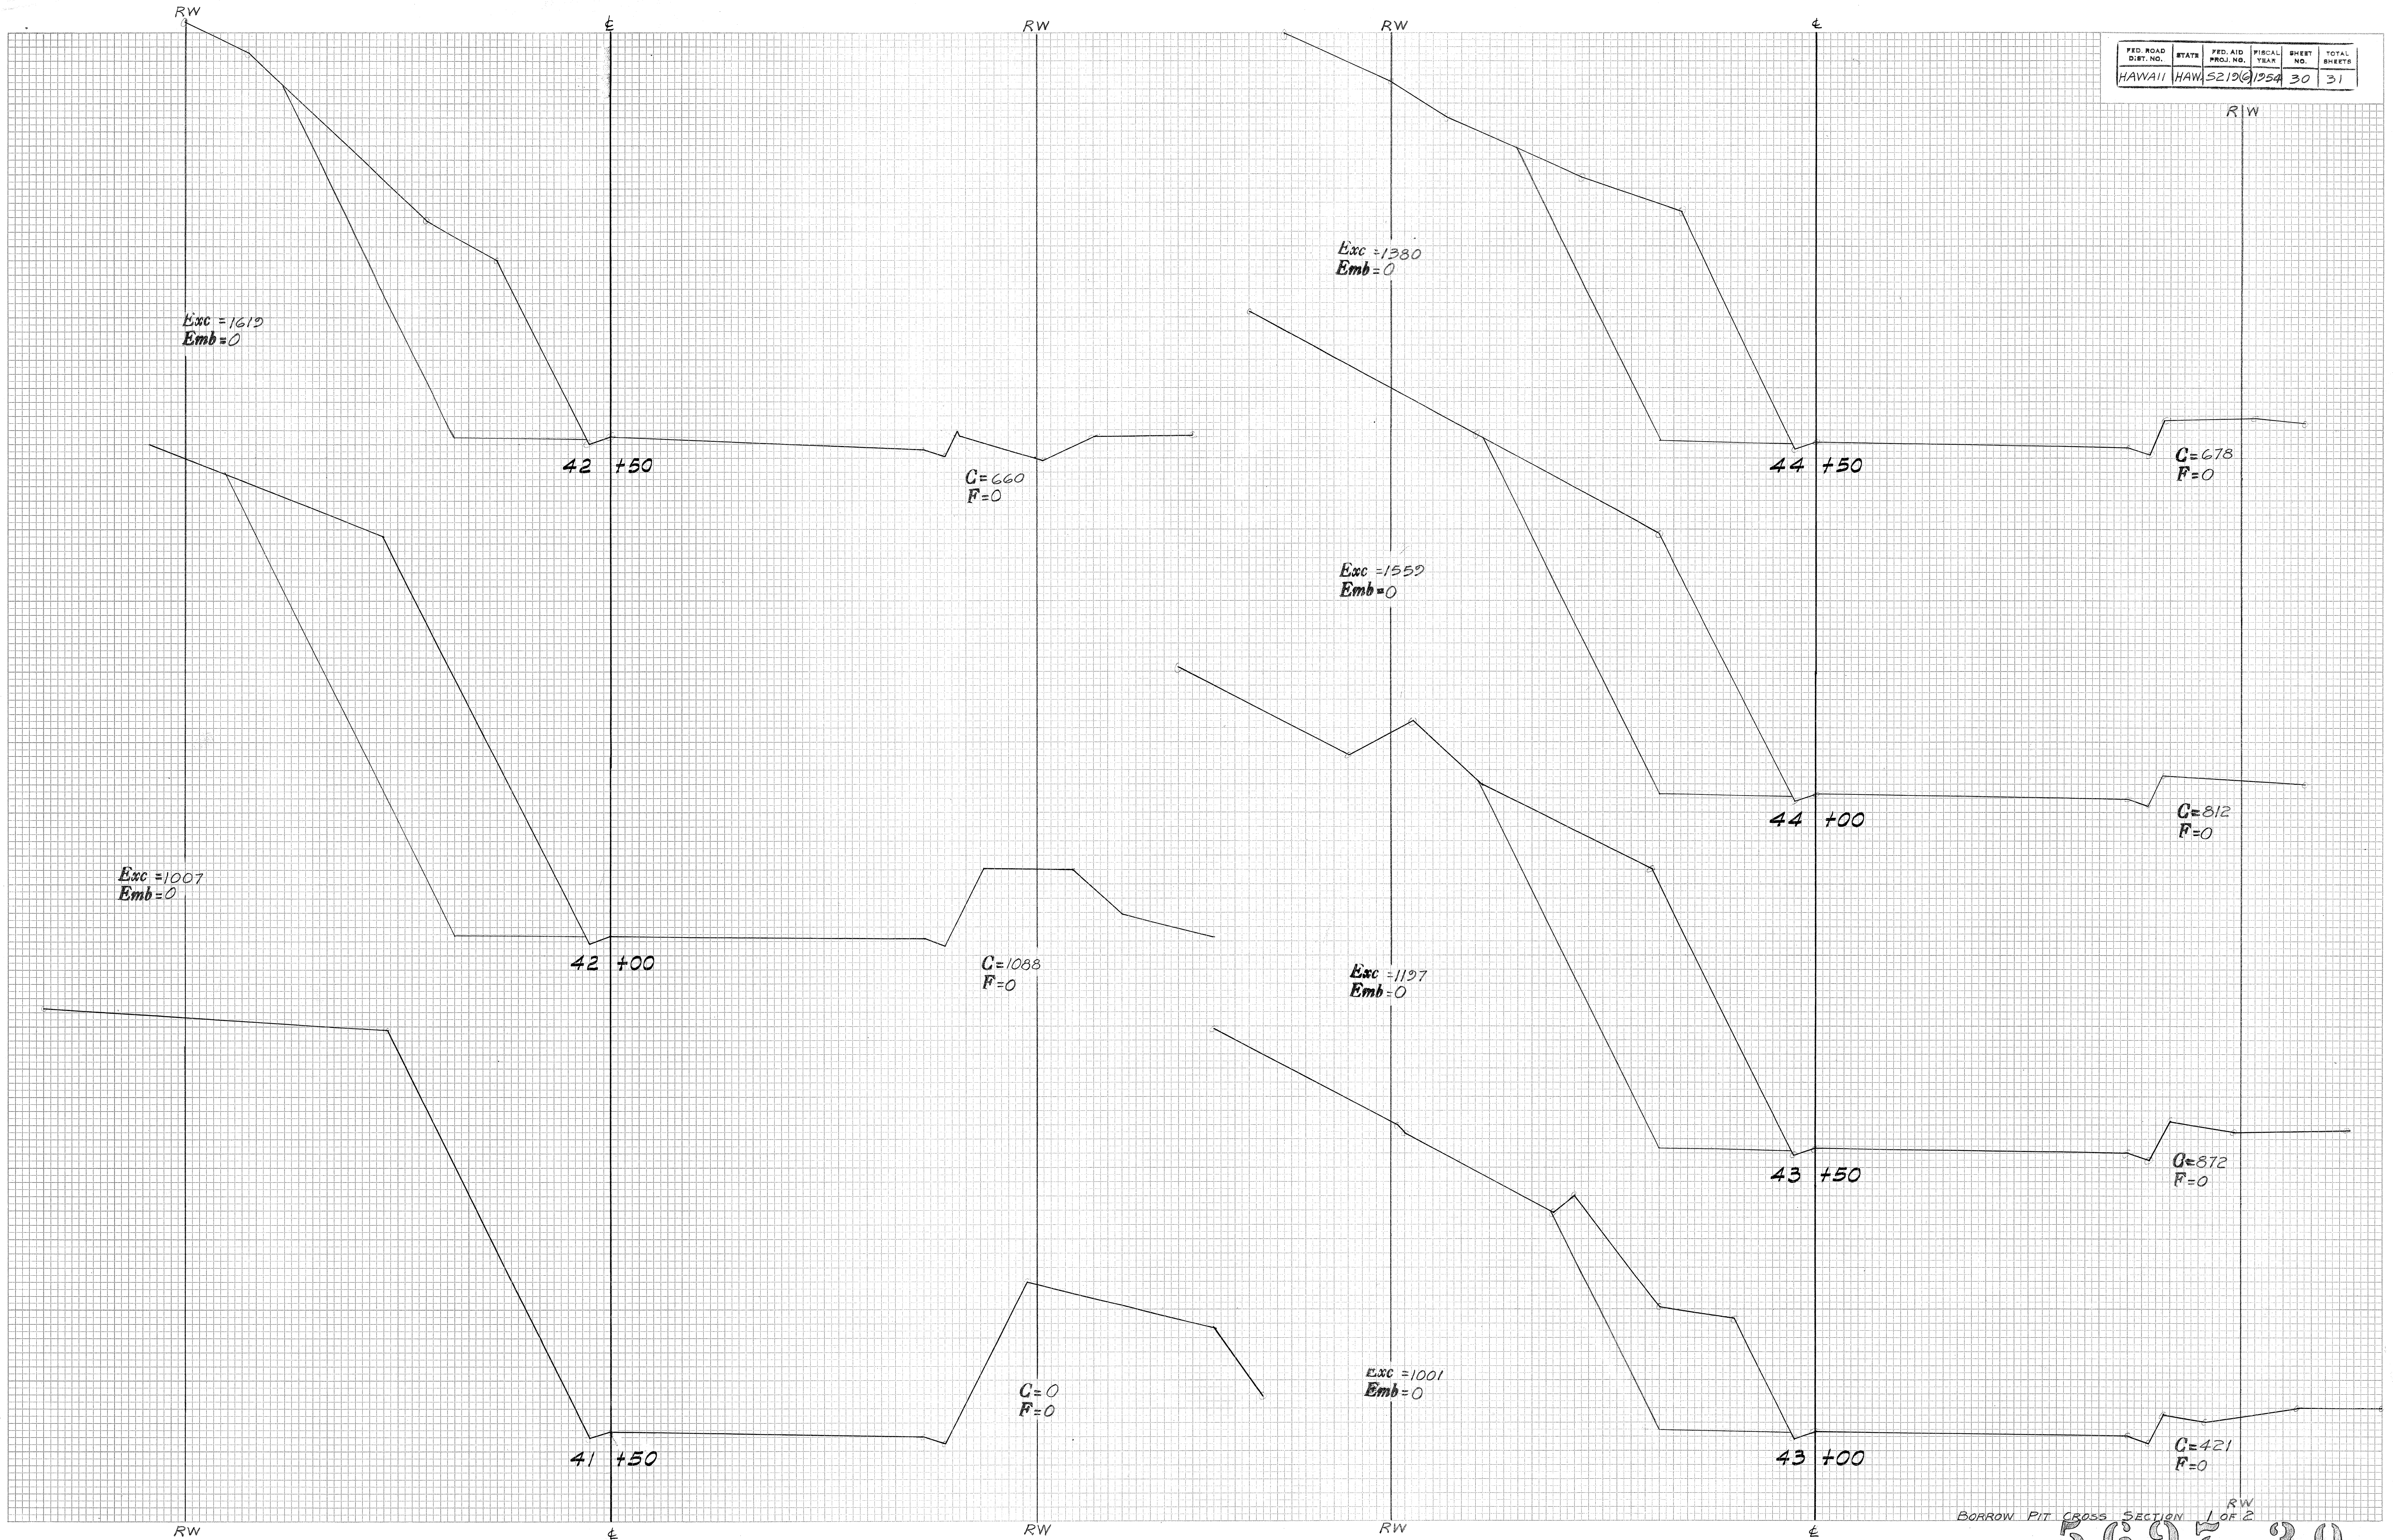

BORROW PIT CROSS SECTION 1 OF 2

5697.30

FINAL SURVEY NO.	SURVEYED, PLOTTED, TEMPLATE, AREA CHECKED	BY	DATE

ORIGINAL SURVEY NO.	SURVEYED, PLOTTED, TEMPLATE, AREA CHECKED	BY	DATE

