


**GENERAL NOTES**  
**ASPHALT CONCRETE PAVEMENT** - shall be 2" thick when fully compacted, laid in one course. Use Mix No. III.  
**BASE COURSE** - shall be Waterbound Macadam Base Course 8" compacted thickness laid in two 4" layers.  
**PORTLAND CEMENT CONCRETE PAVT.** - shall be 6" thick without reinforcement. No longitudinal "Contact Joints" are permitted. Pavement shall be laid full width. "Weakened Plane Joints" shall be installed on approximately 30 ft. centers. No "Expansion Joints" are required.

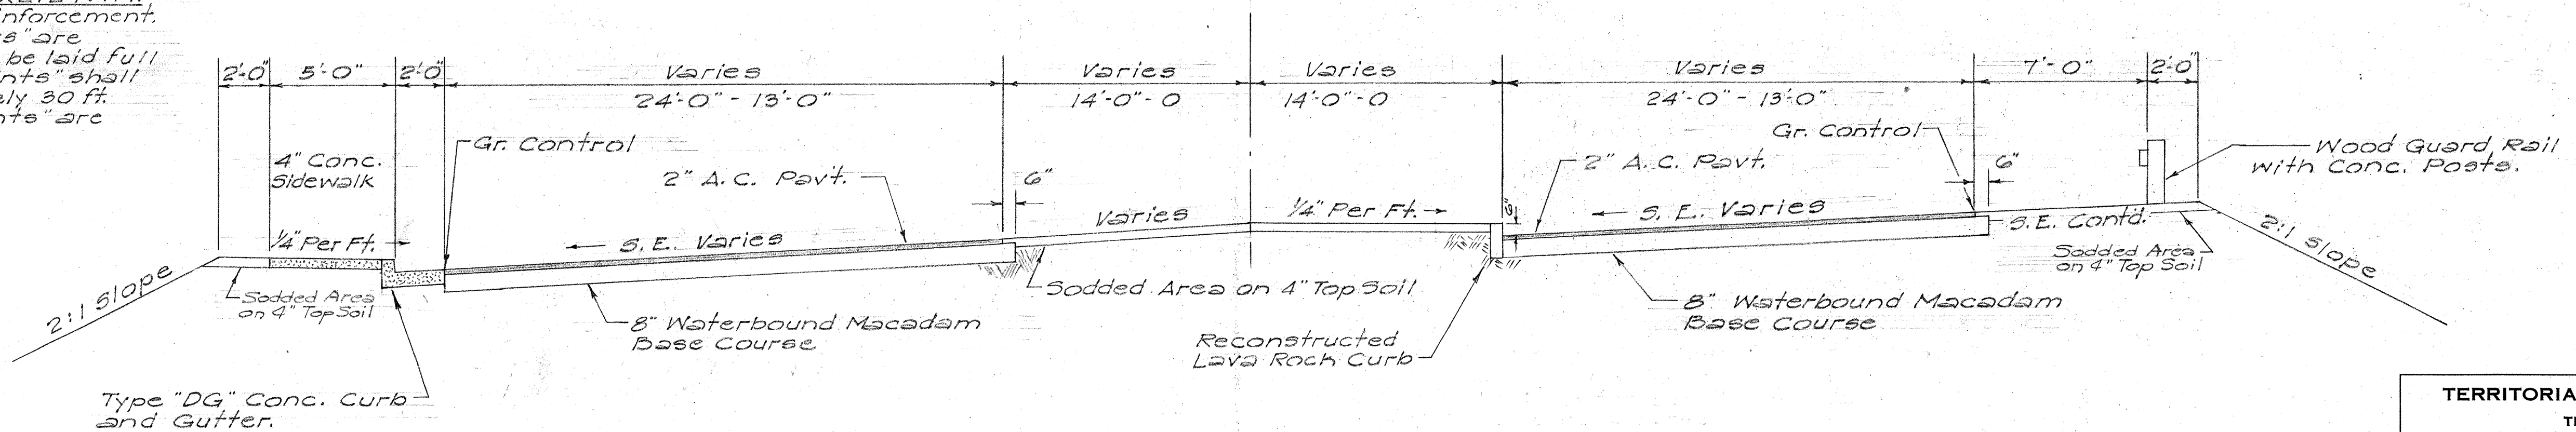

TERRITORIAL HIGHWAY DEPARTMENT  
TERRITORY OF HAWAII

**TYPICAL SECTIONS**  
MOANALUA ROAD  
PROJ. NO. 5219(6)  
Scale: As Noted March 1954

SHEET No. 1 OF 1 SHEETS

5697.2

DATE  
DESIGNED BY  
DRAWN BY  
CHECKED BY  
NO.