


FED. ROAD DIST. No.	STATE	FED. AID PROJ. No.	FISCAL YEAR	SHEET No.	TOTAL SHEETS
HAWAII	HAWAII	50780(1)	1958	19	109

Unit 2

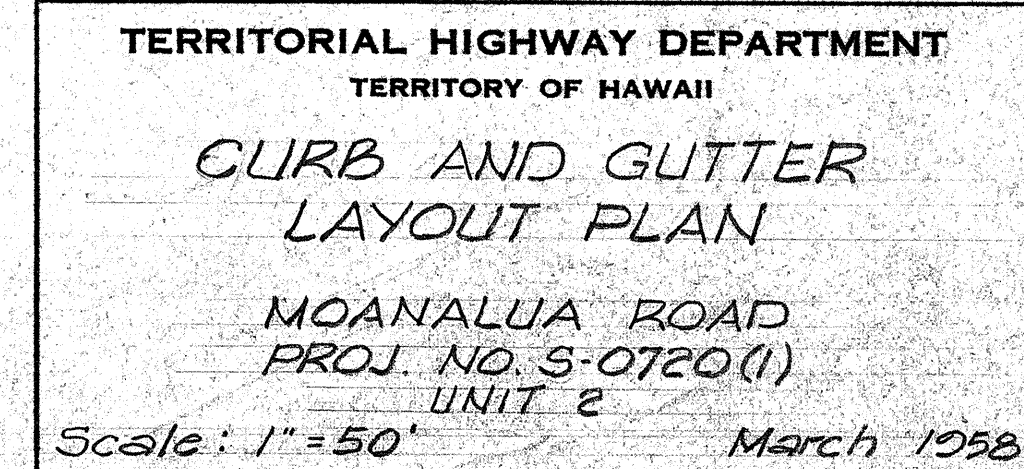


5444.19

10

FED. ROAD DIST. NO.	STATE	FED. AID PROJ. NO.	FISCAL YEAR	SHEET No.	TOTAL SHEETS
HAWAII	HAW	S-0720	1958	20	109
Unit 2					

SURVEY PLOTTED BY	DATE
DESIGNED BY	
DRAWN BY	
QUANTITIES BY	
NOTE BOOK	
CHECKED BY	
No.	

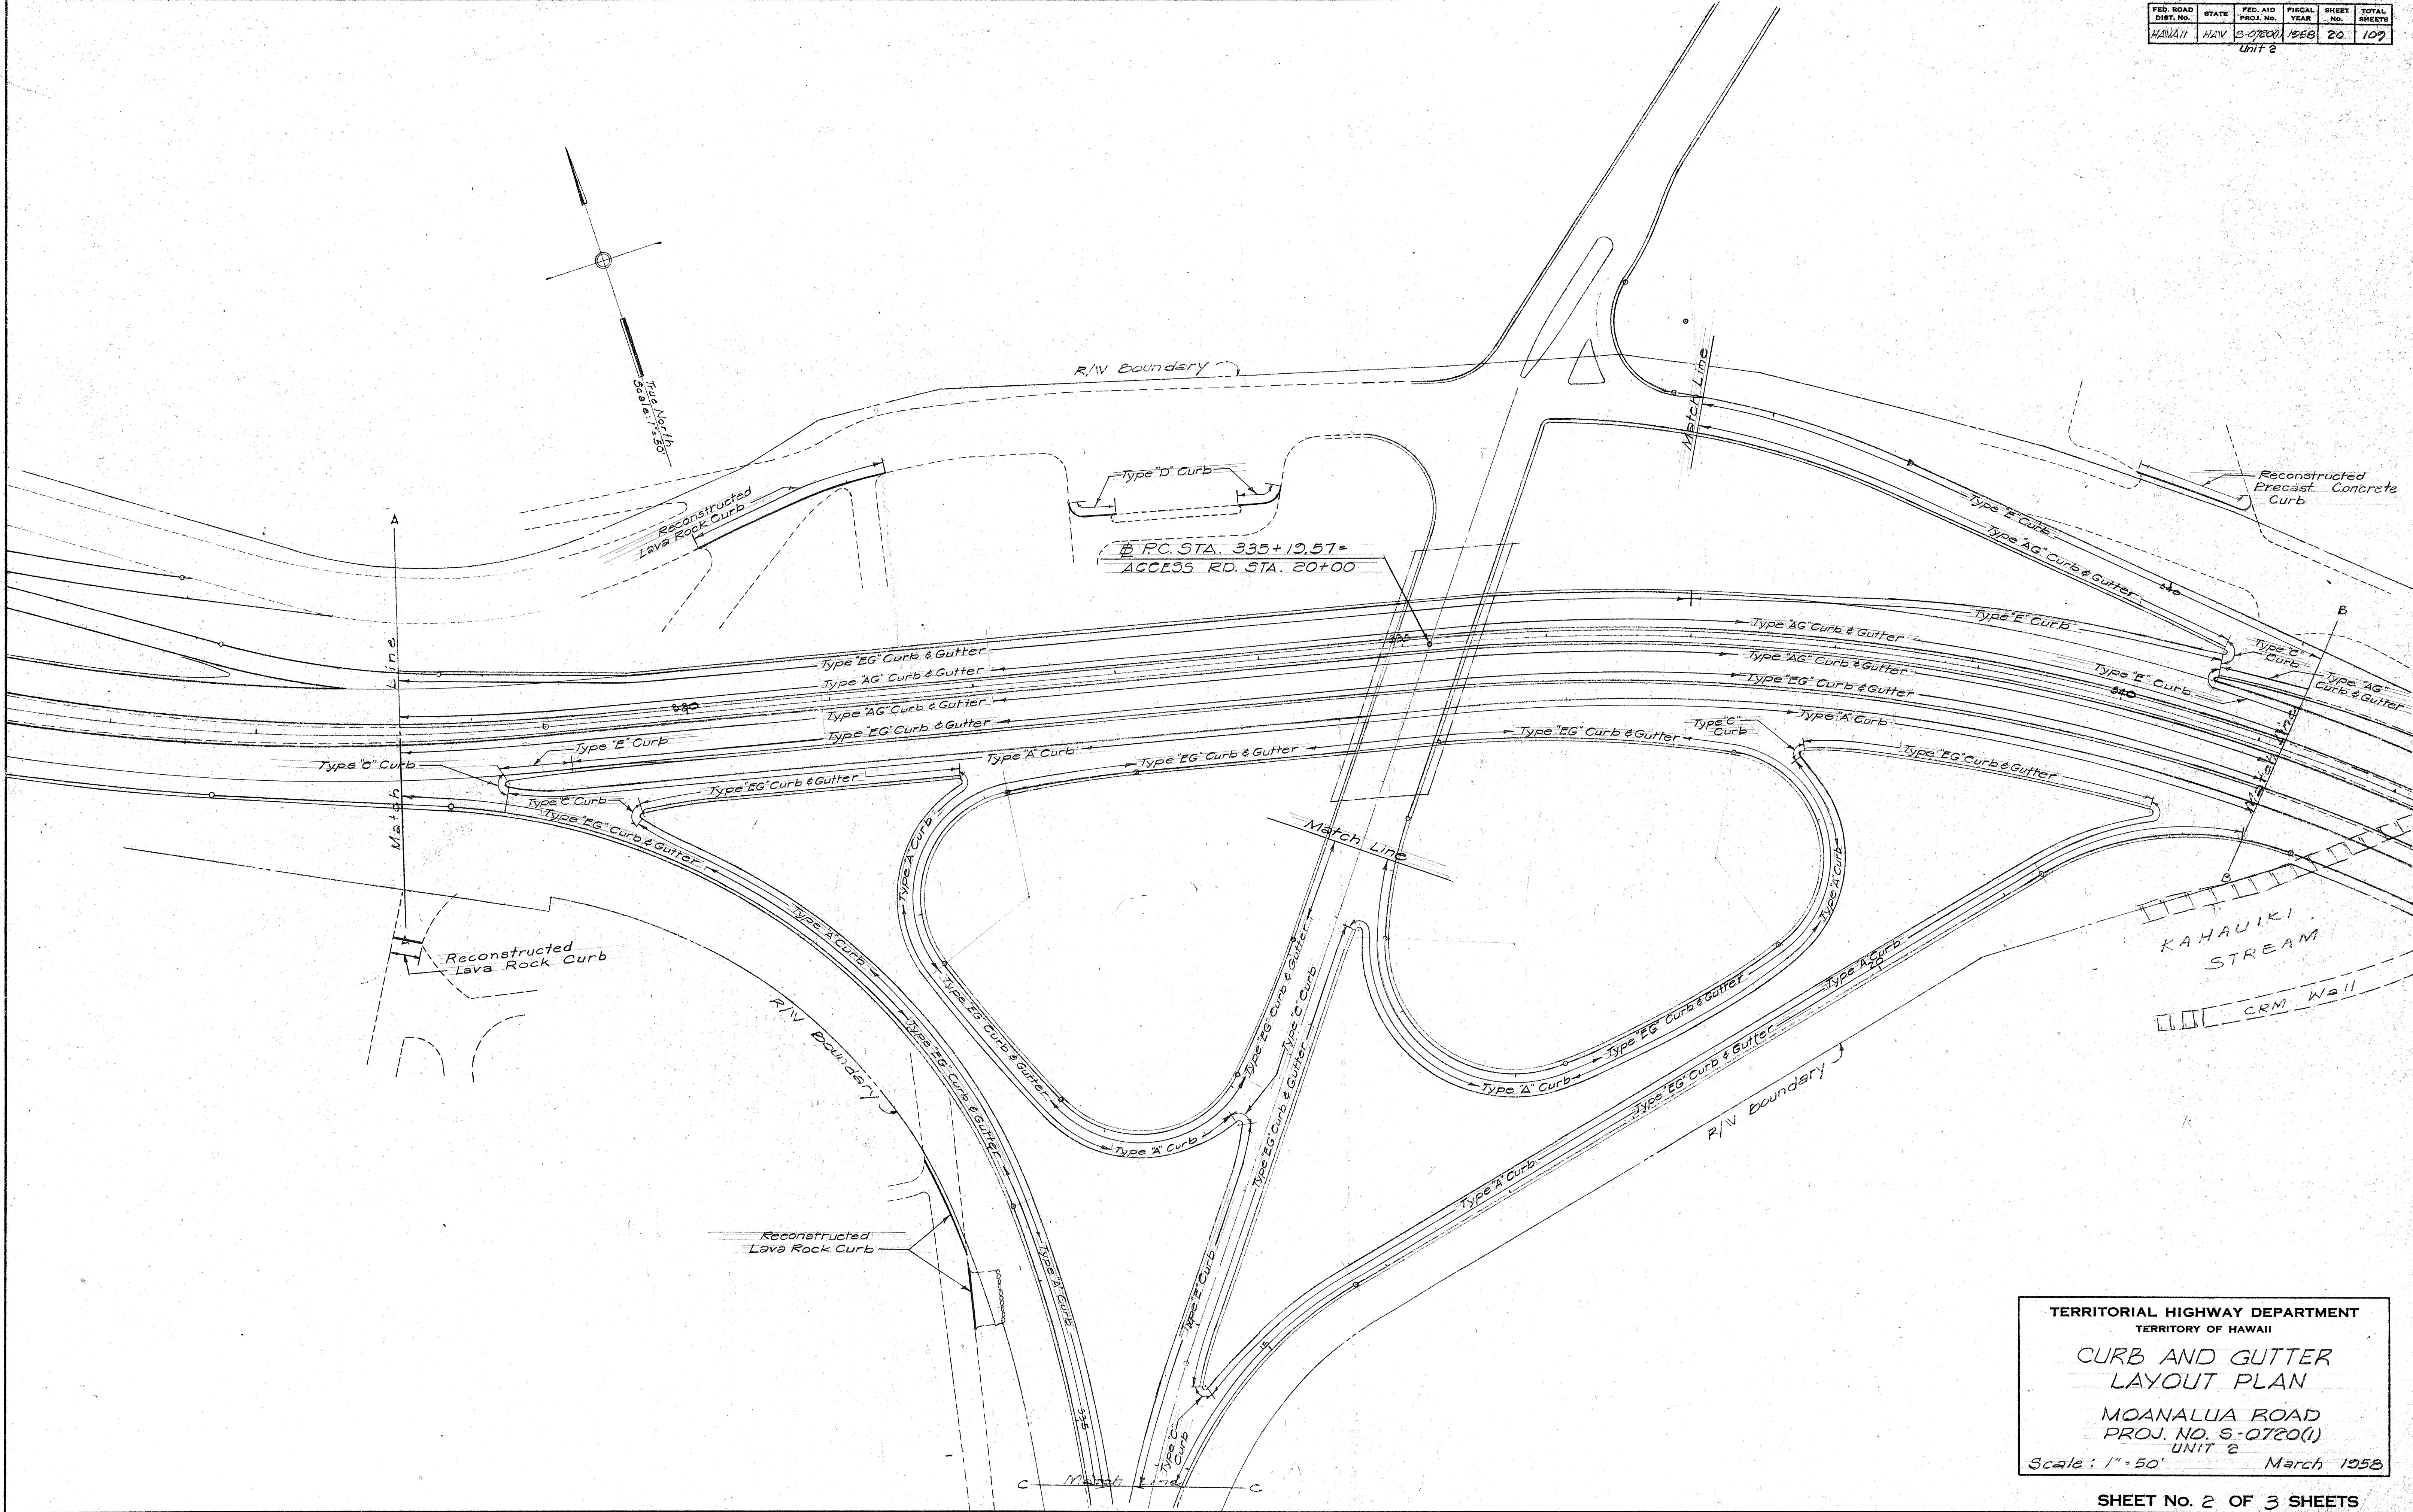


TERRITORIAL HIGHWAY DEPARTMENT
 TERRITORY OF HAWAII
**CURB AND GUTTER
 LAYOUT PLAN**
 MOANALUA ROAD
 PROJ. NO. S-0720(1)
 UNIT 2
 Scale: 1" = 50' March 1958

SHEET No. 2 OF 3 SHEETS

5444.20

FED. ROAD DIST. NO.	STATE	FED. AID PROJ. NO.	FISCAL YEAR	SHEET NO.	TOTAL SHEETS
HAWAII	HAW	S-0720(1)	1958	21	109
Unit 2					

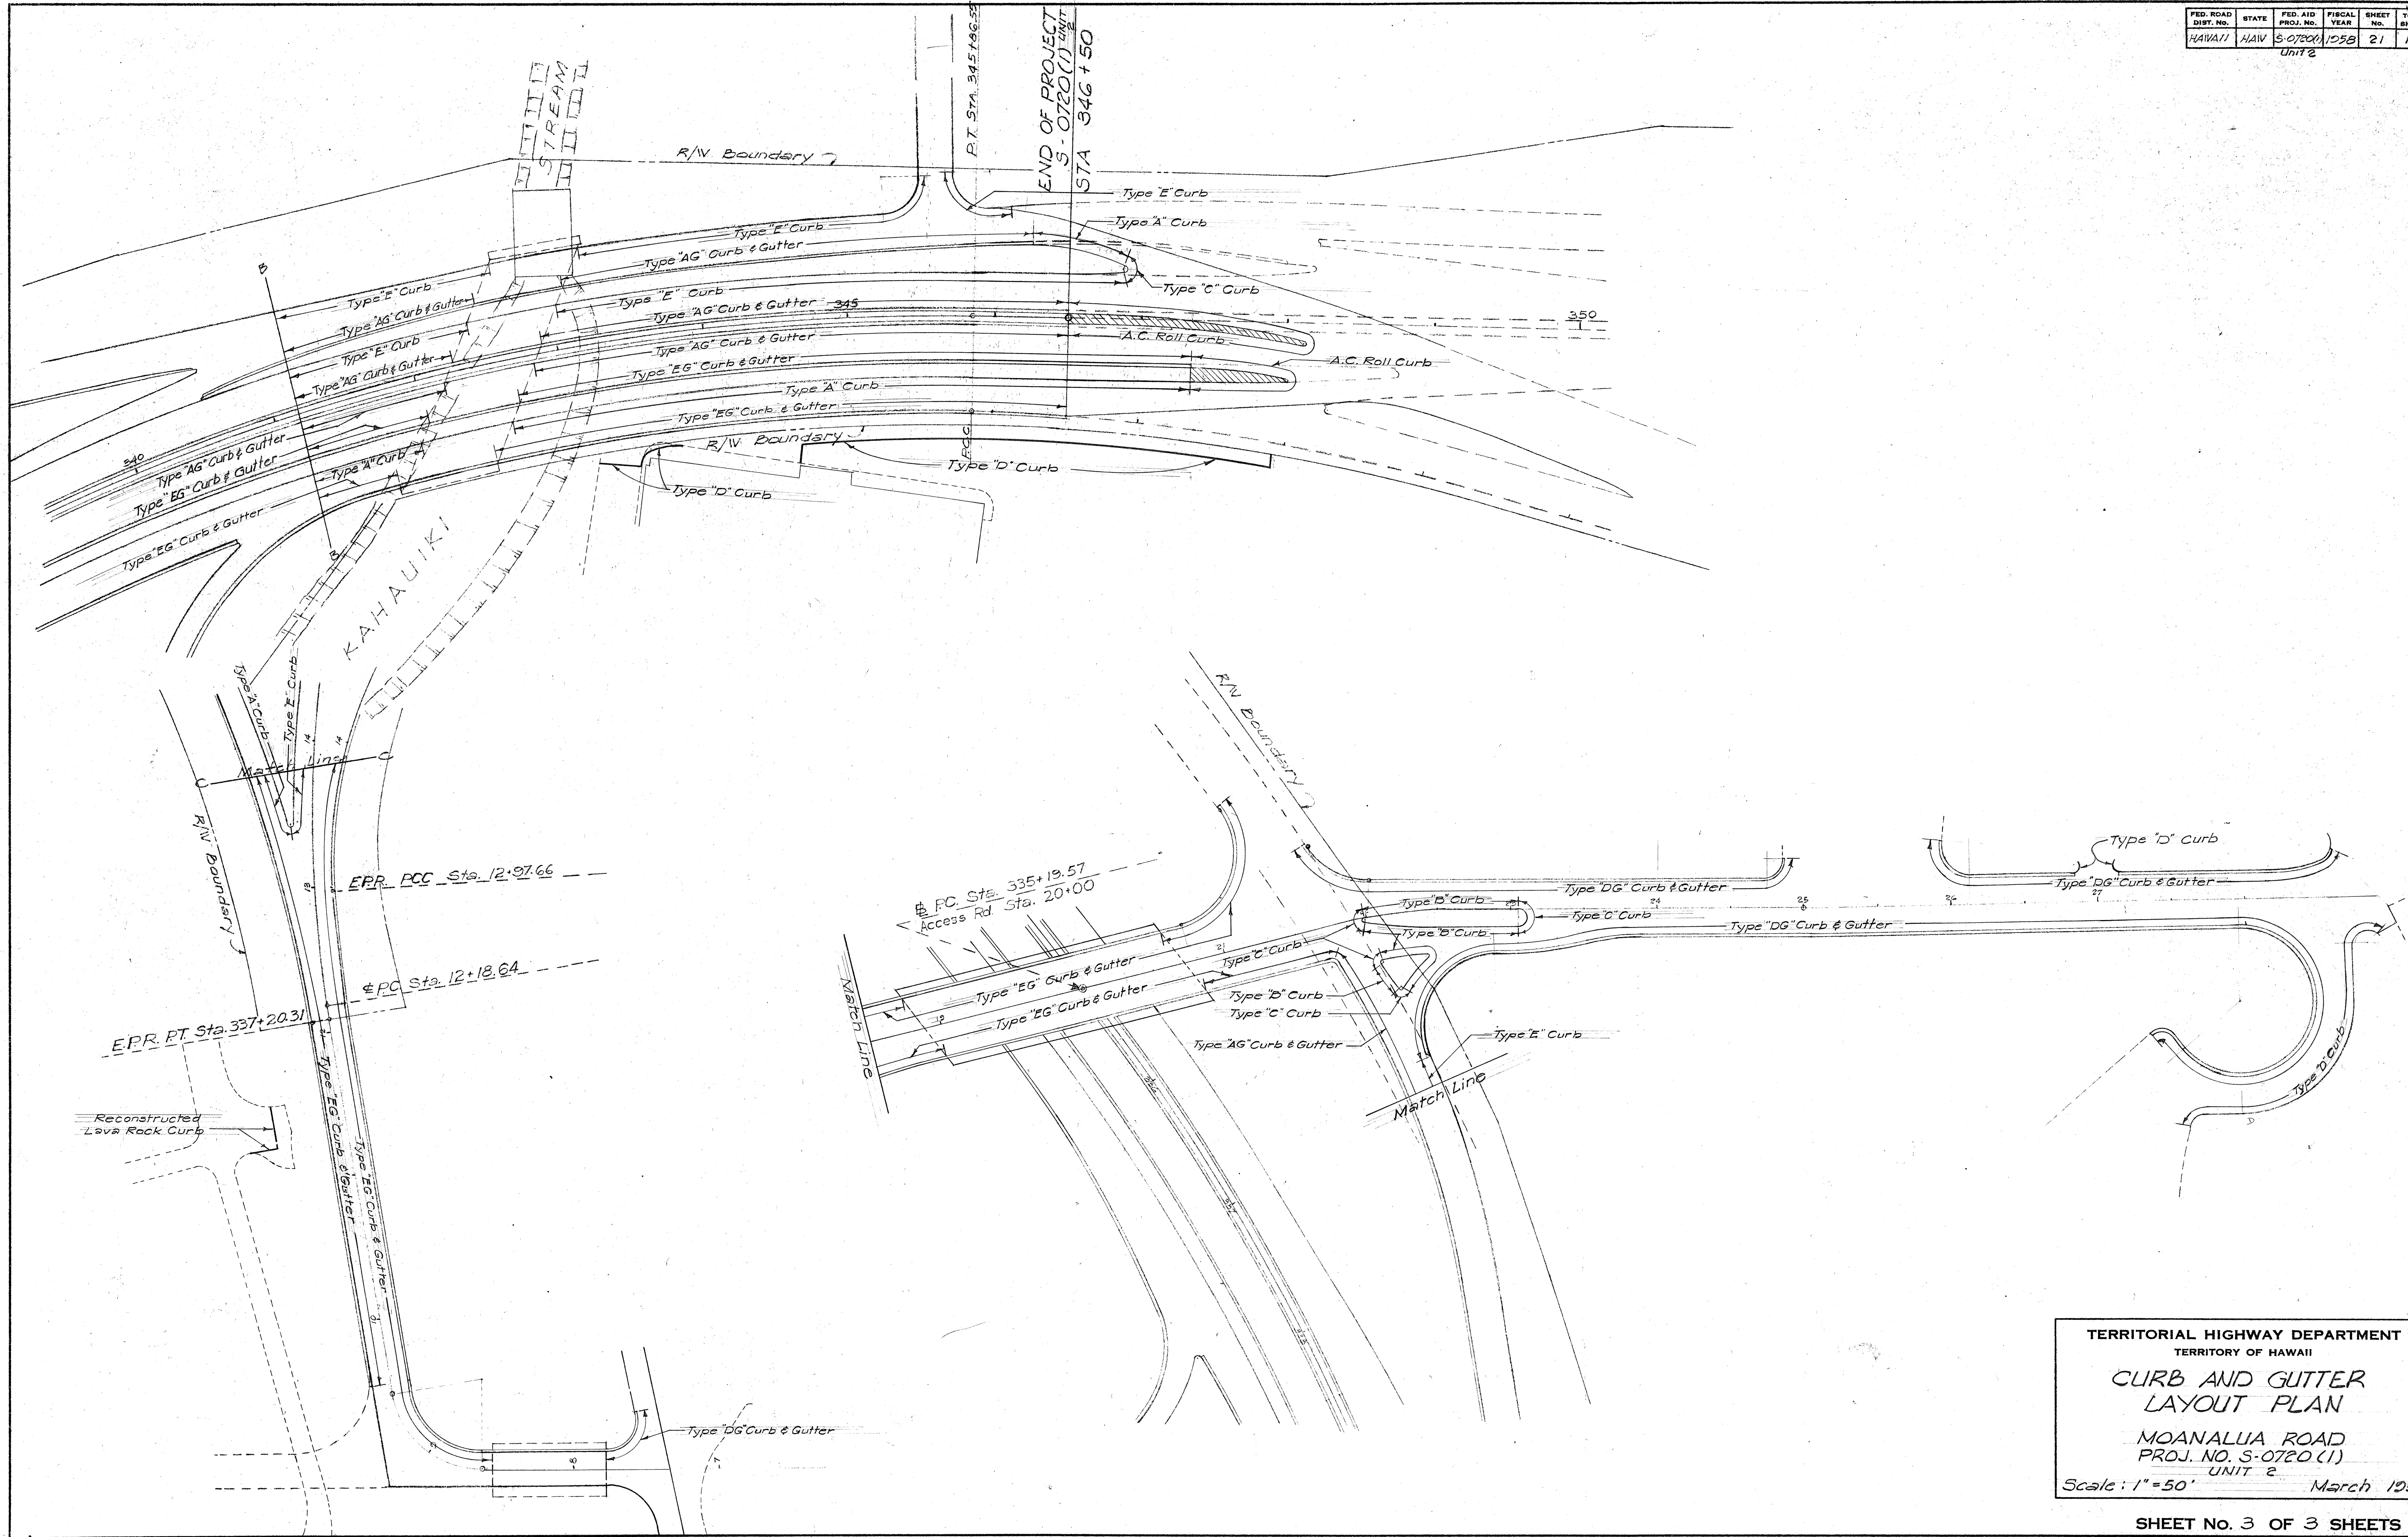

DESIGNED BY	DATE
DRAWN BY	
CHECKED BY	
QUANTITIES CHECKED BY	
NOTE BOOK NO.	

TERRITORIAL HIGHWAY DEPARTMENT
TERRITORY OF HAWAII
**CURB AND GUTTER
LAYOUT PLAN**
MOANALUA ROAD
PROJ. NO. S-0720(1)
UNIT 2
Scale: 1"=50' March 1958

SHEET No. 3 OF 3 SHEETS

5444.21