
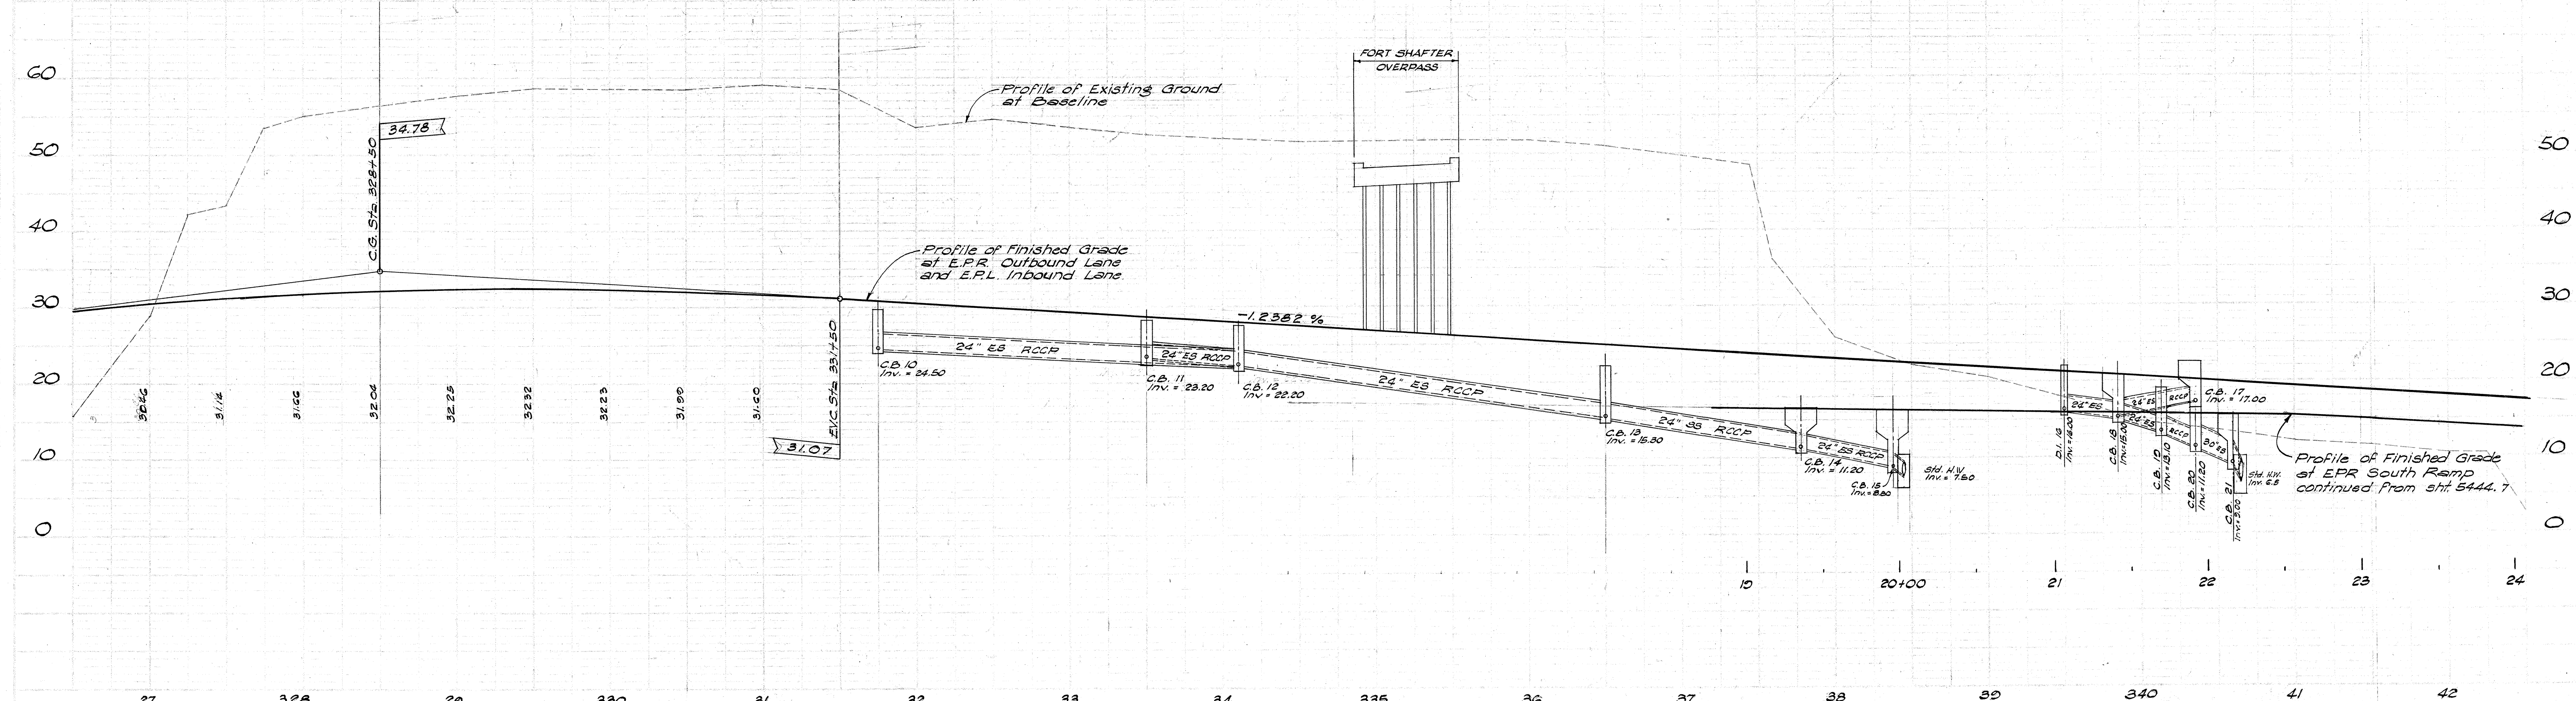


FED. ROAD DIST. NO.	STATE	FED. AID PROJ. NO.	FISCAL YEAR	SHEET NO.	TOTAL SHEETS
	HAWAII	3-07201	1958	5	100

August 28, 1958
Sept. 11, 1958

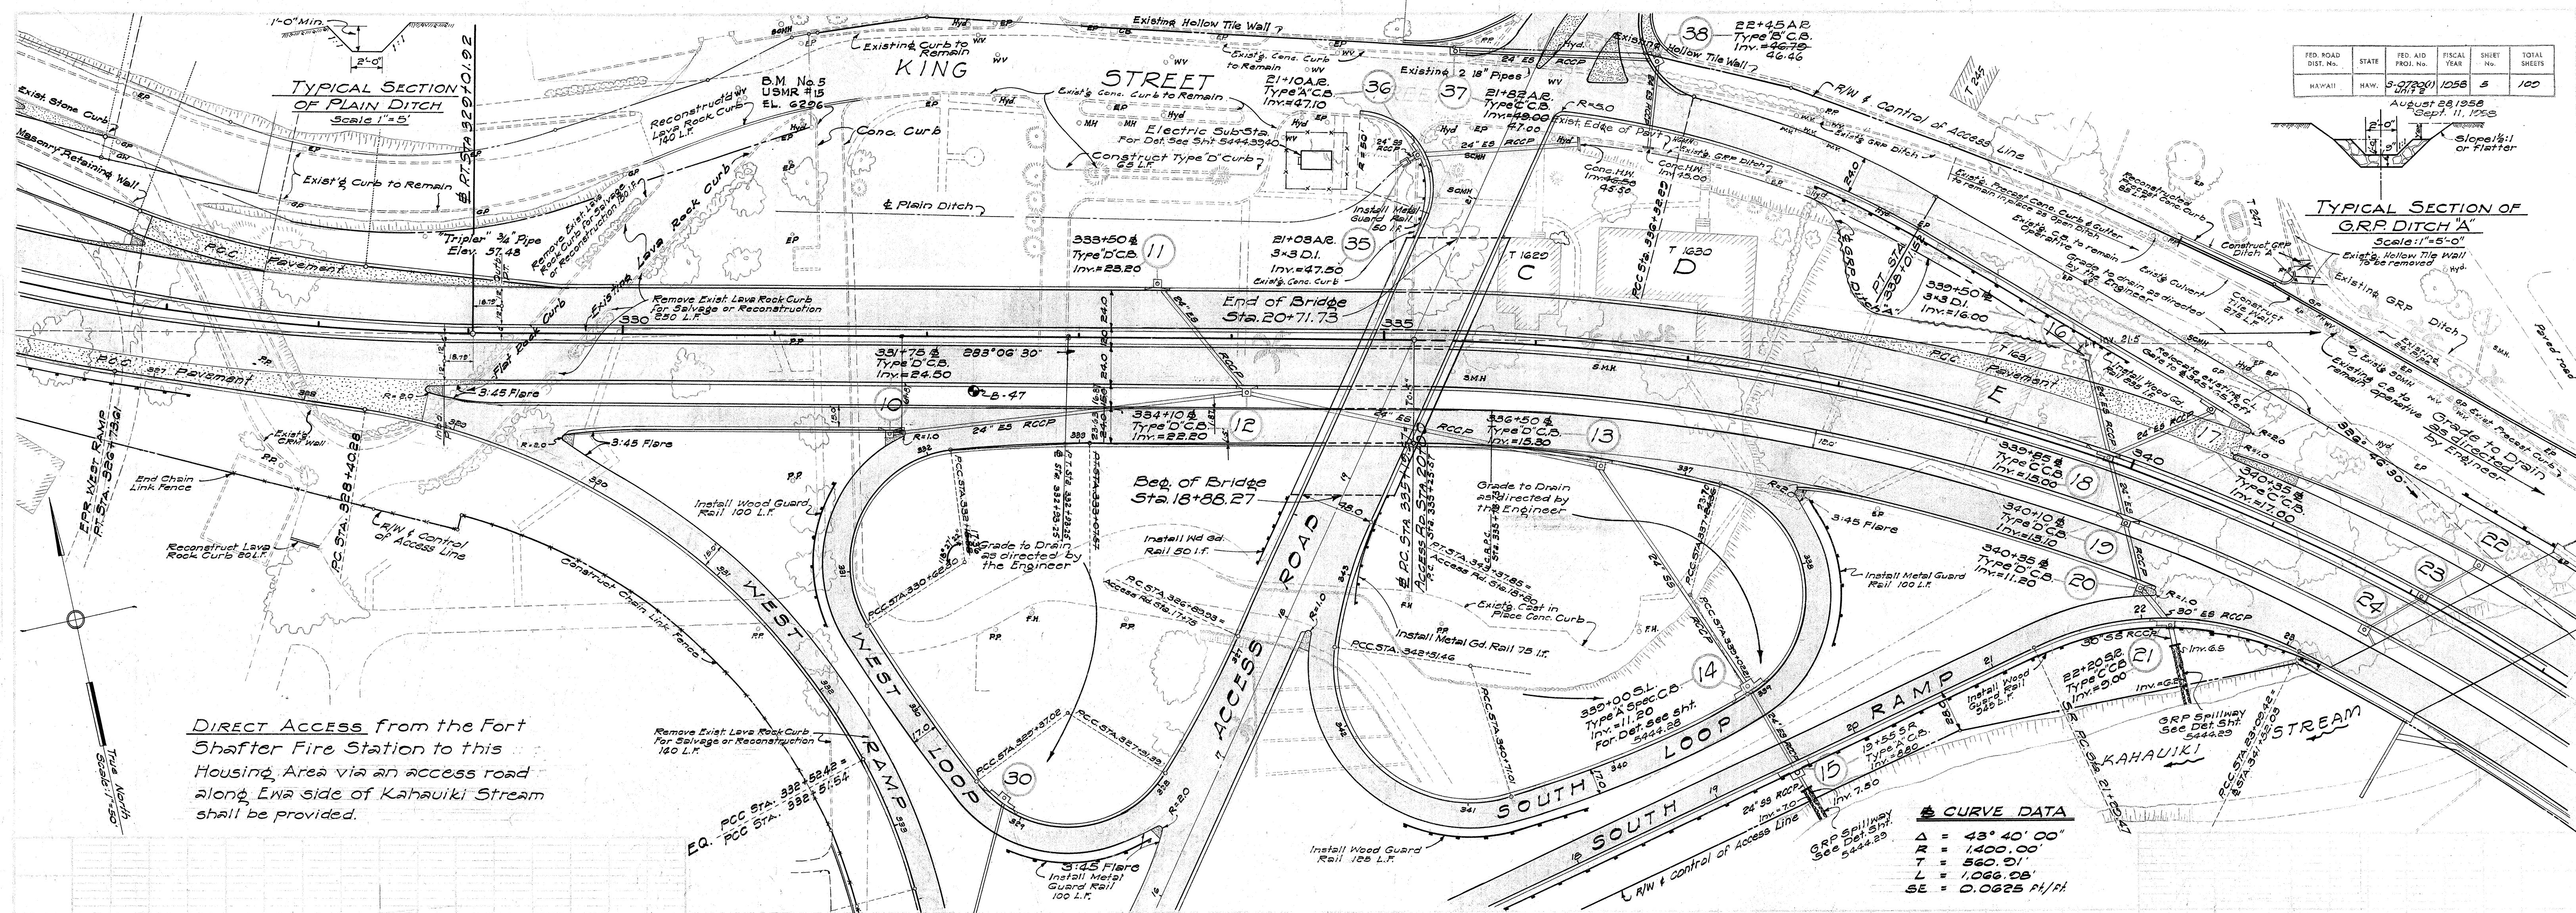

5444.5

DD-P-5

NOTES

1. The Capehart Housing Access Road from Sta. 0+00 to Sta. 1+65.85 shall be paved.
2. The Capehart Housing Access Rd. from Sta. 1+65.85 to Sta. 5+00 shall be excavated and rough graded only.

CURVE DATA



$\Delta = 79^{\circ}33'40''$
 $R = 267.33'$
 $T = 239.32'$
 $L = 399.41'$

CURVE DATA

$\Delta = 75^{\circ}00'00''$
 $R = 180.00'$
 $T = 138.12'$
 $L = 235.619'$

FED. ROAD DIST. No.	STATE	FED. AID PROJ. No.	FISCAL YEAR	SHEET No.	TOTAL SHEETS
HAWAII	HAW.	5-0720(1)	1958	7	109

August 28, 1958
 Sept. 11, 1958
 Dec. 18, 1959
 March 7, 1960

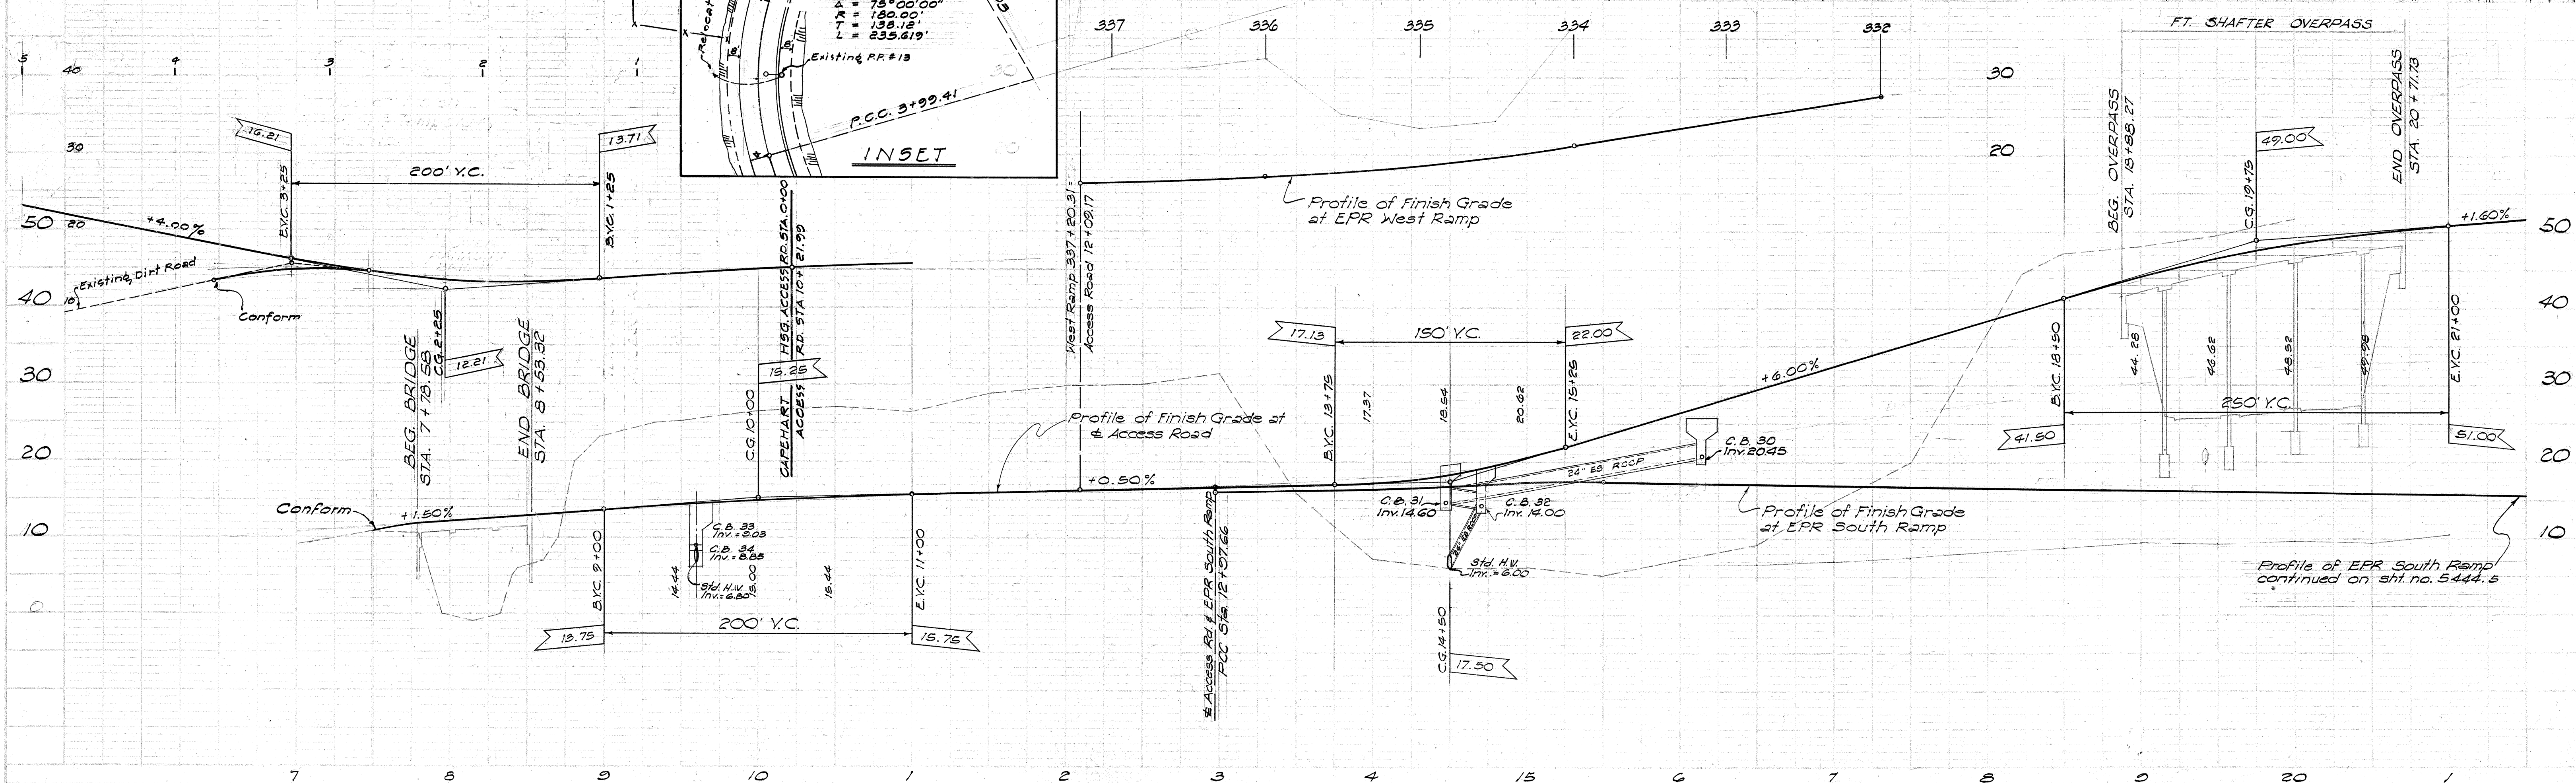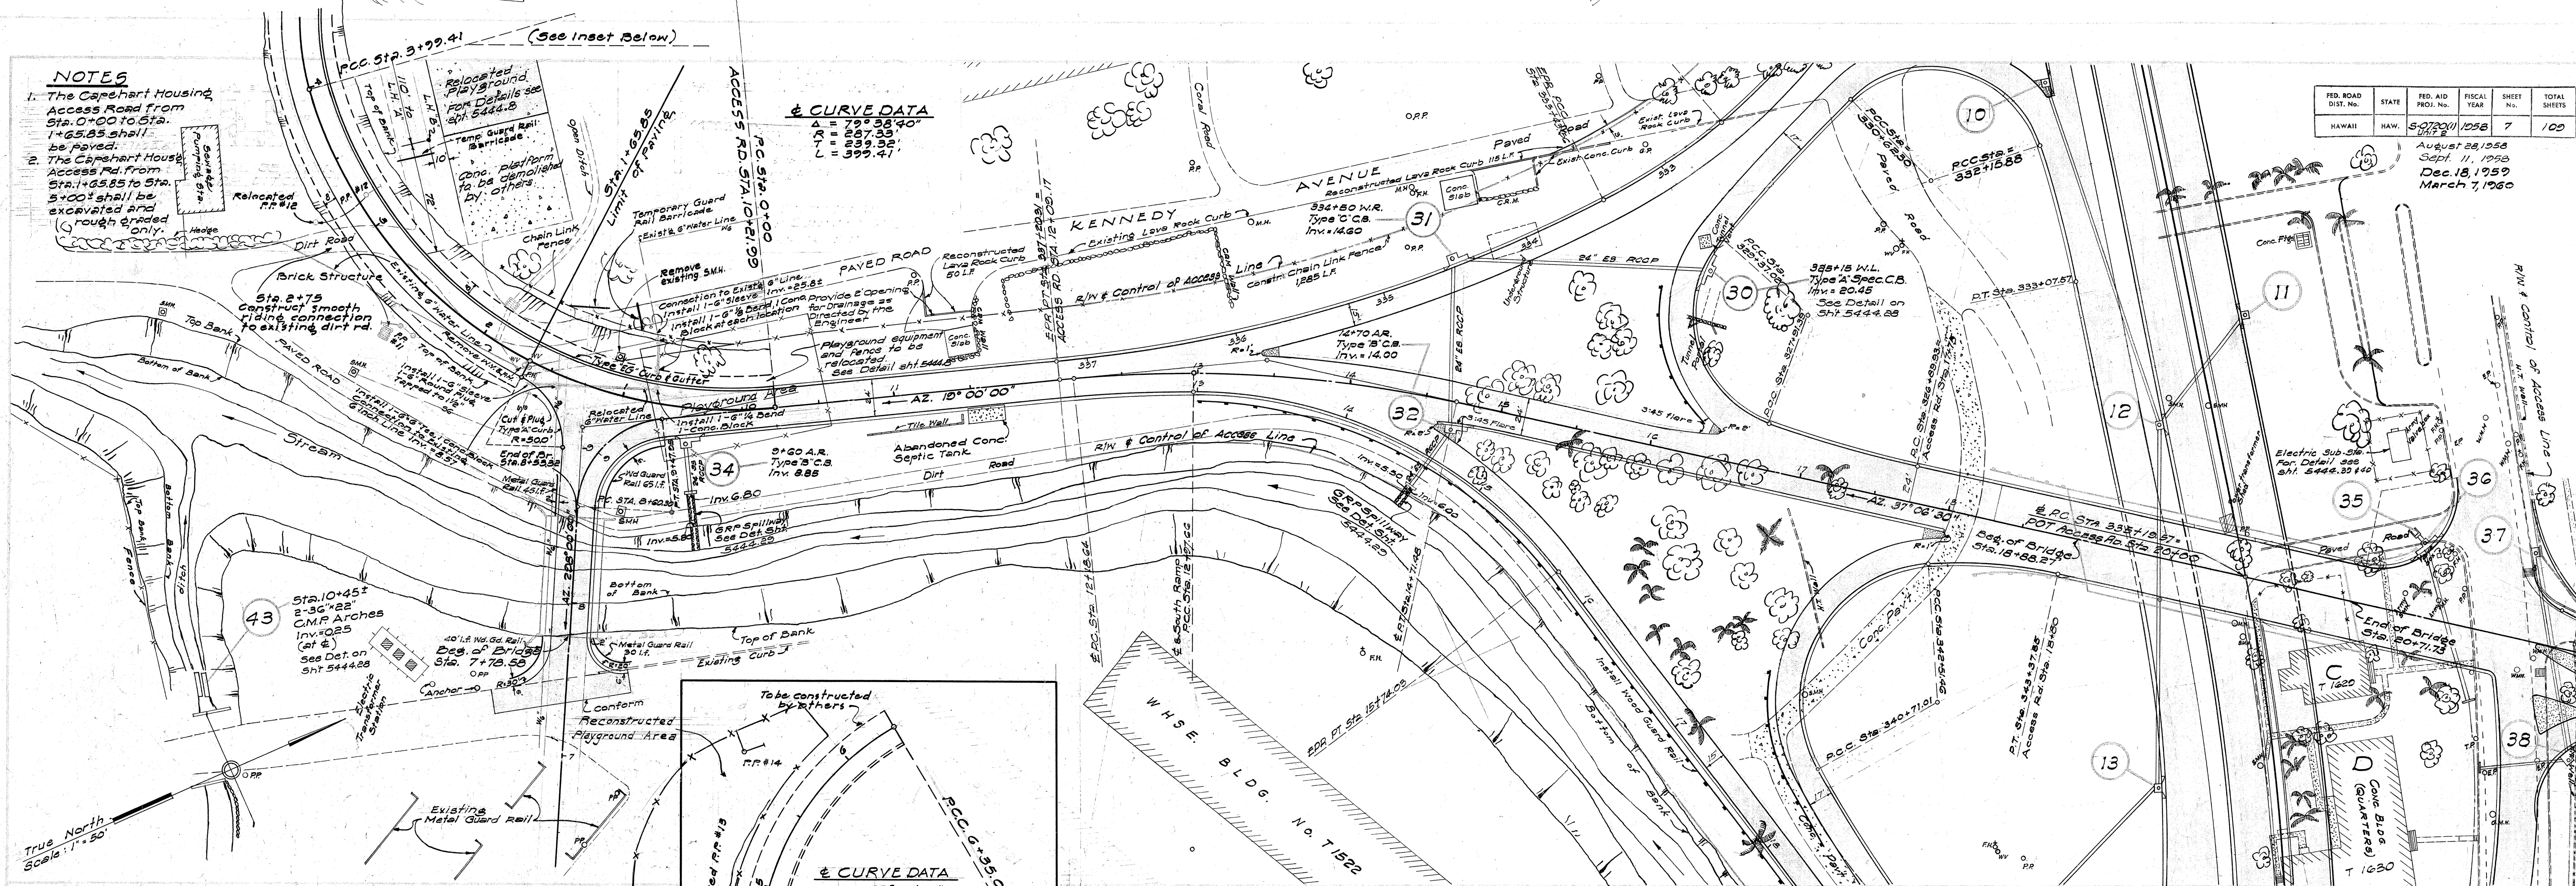


5444.7A

FED. ROAD DIST. No.	STATE	FED. AID PROJ. No.	FISCAL YEAR	SHEET No.	TOTAL SHEETS
HAWAII	HAW.	3-0720(1)	1958	8	100

AUGUST 28, 1958
SEPT. 11, 1958

Relocated chain link gate and fence
364 L.F.

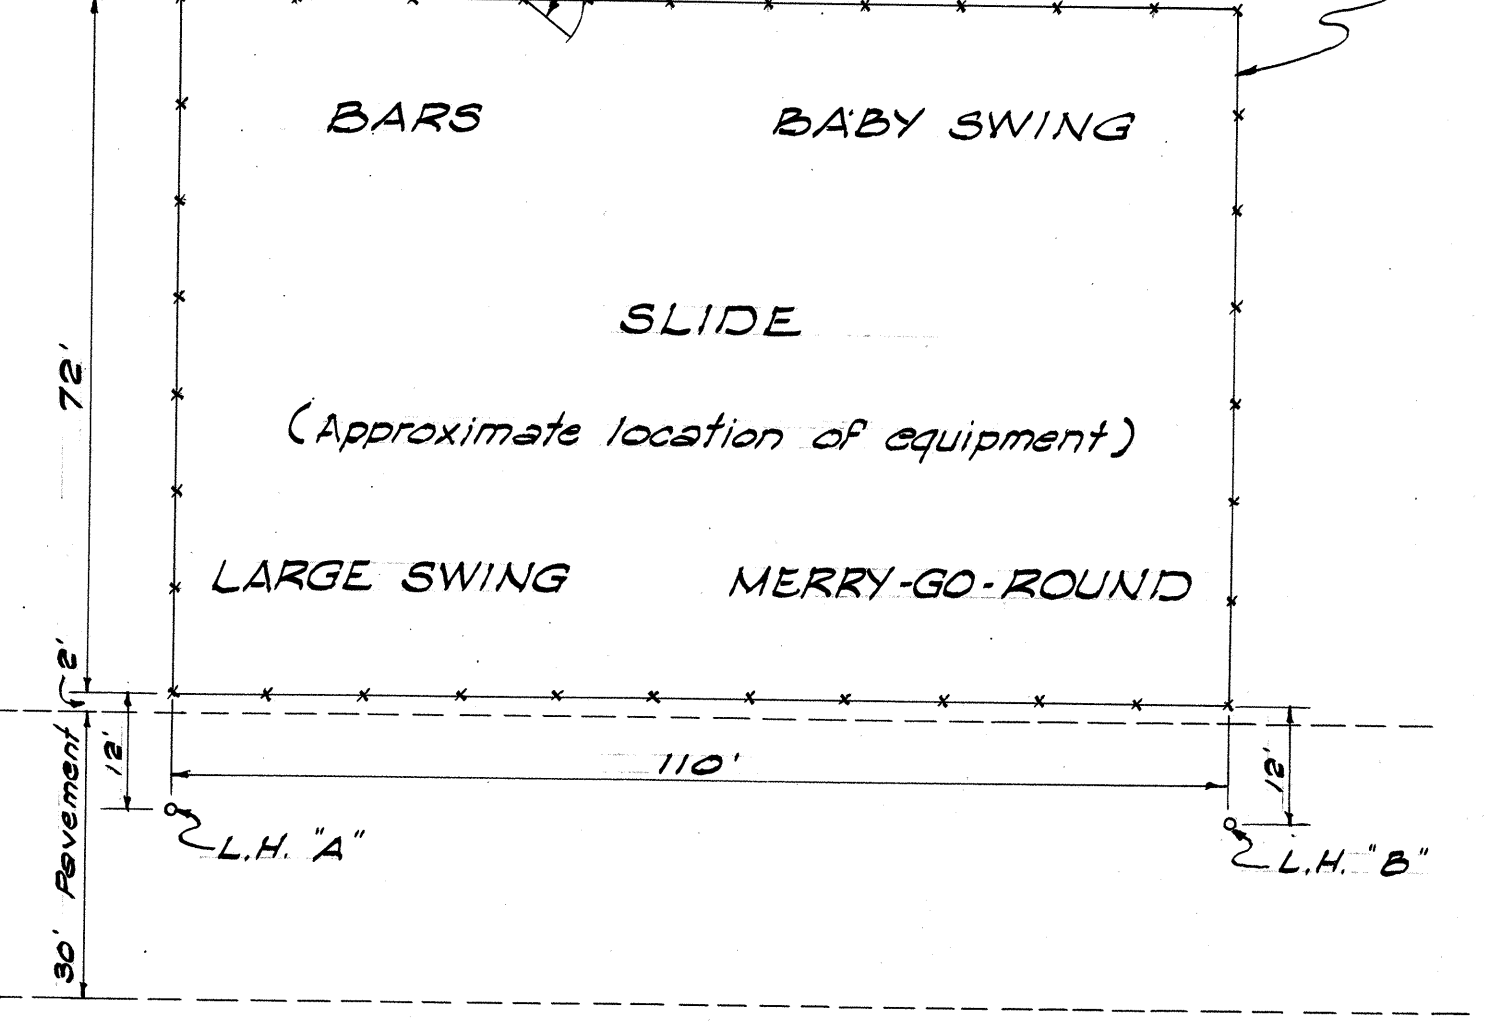


PLAN SHOWING RELOCATION OF
PLAYGROUND EQUIPMENT

Scale: 1" = 20'



NOTE:

1. In relocating the playground equipment, the Contractor shall demolish the existing concrete footing and construct new footings as per plan or as directed by the Engineer.
2. The exact location of the various equipment shall be determined by the Engineer.
3. All concrete shall be Class "B-1"

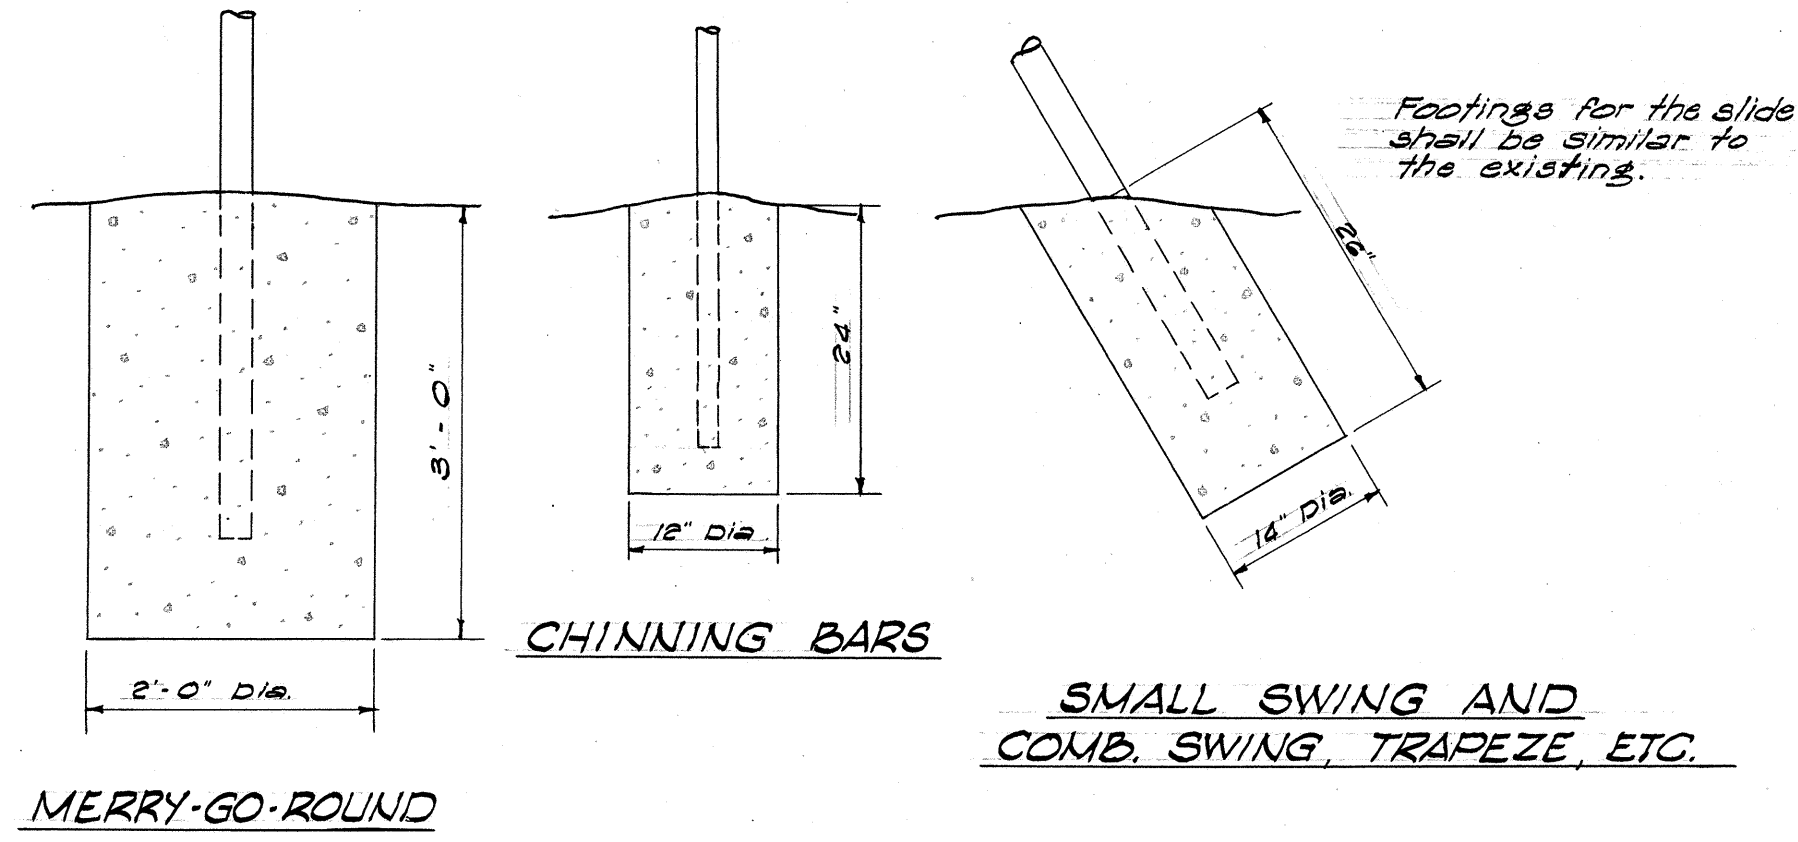

CONCRETE FOOTING DETAILS
FOR PLAYGROUND EQUIPMENT

Scale: 3/4" = 1'-0"

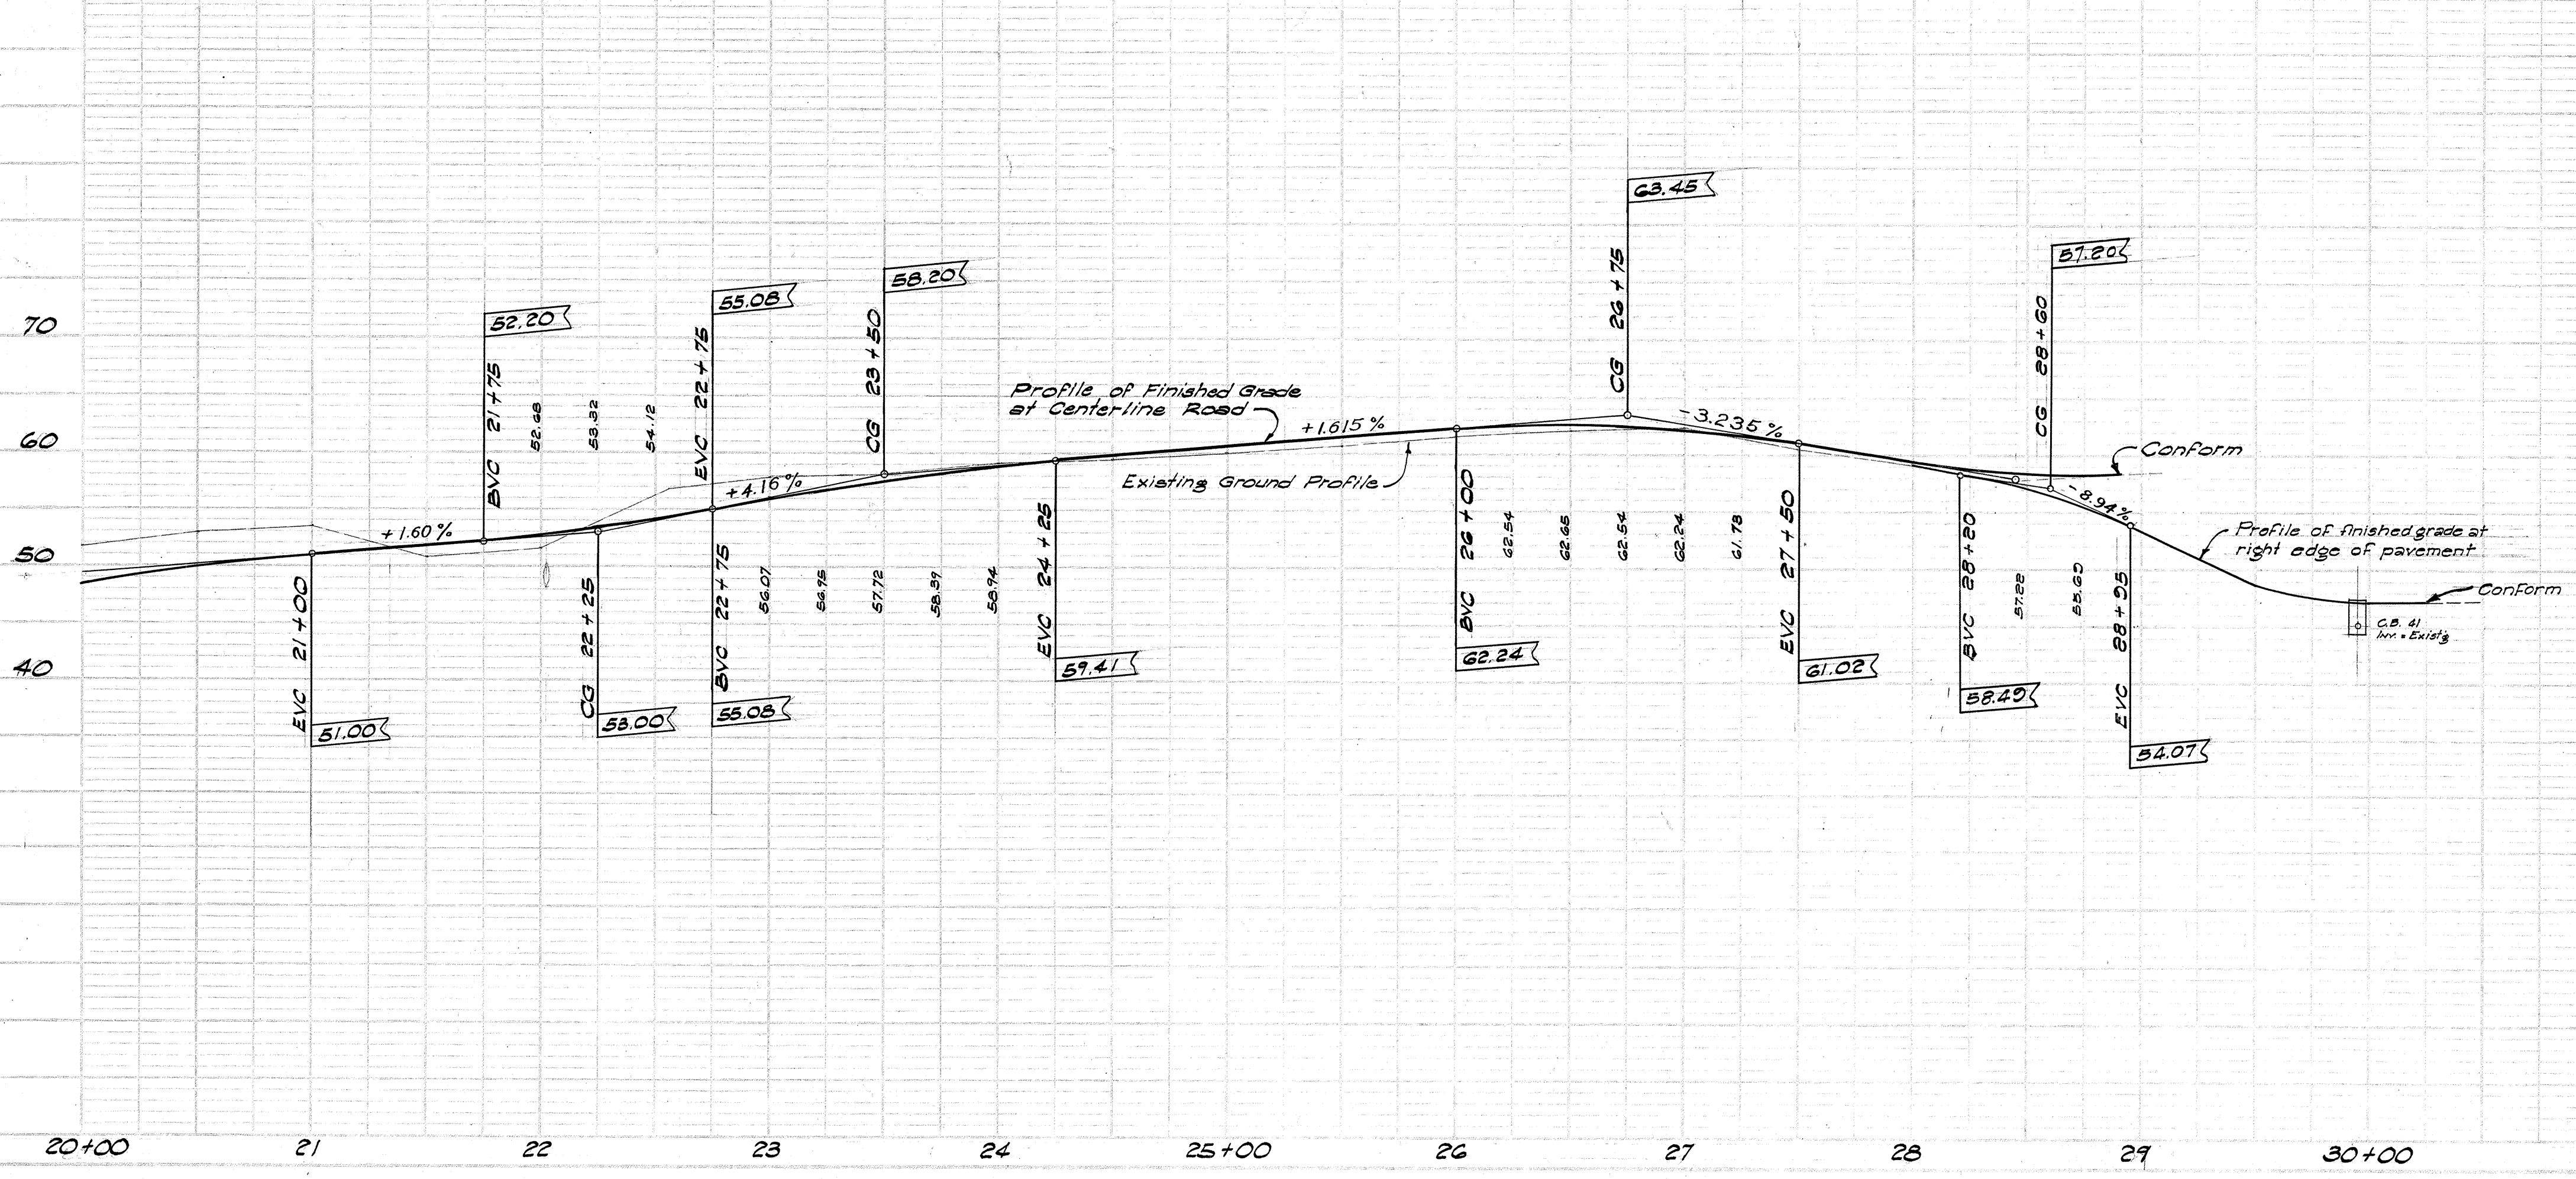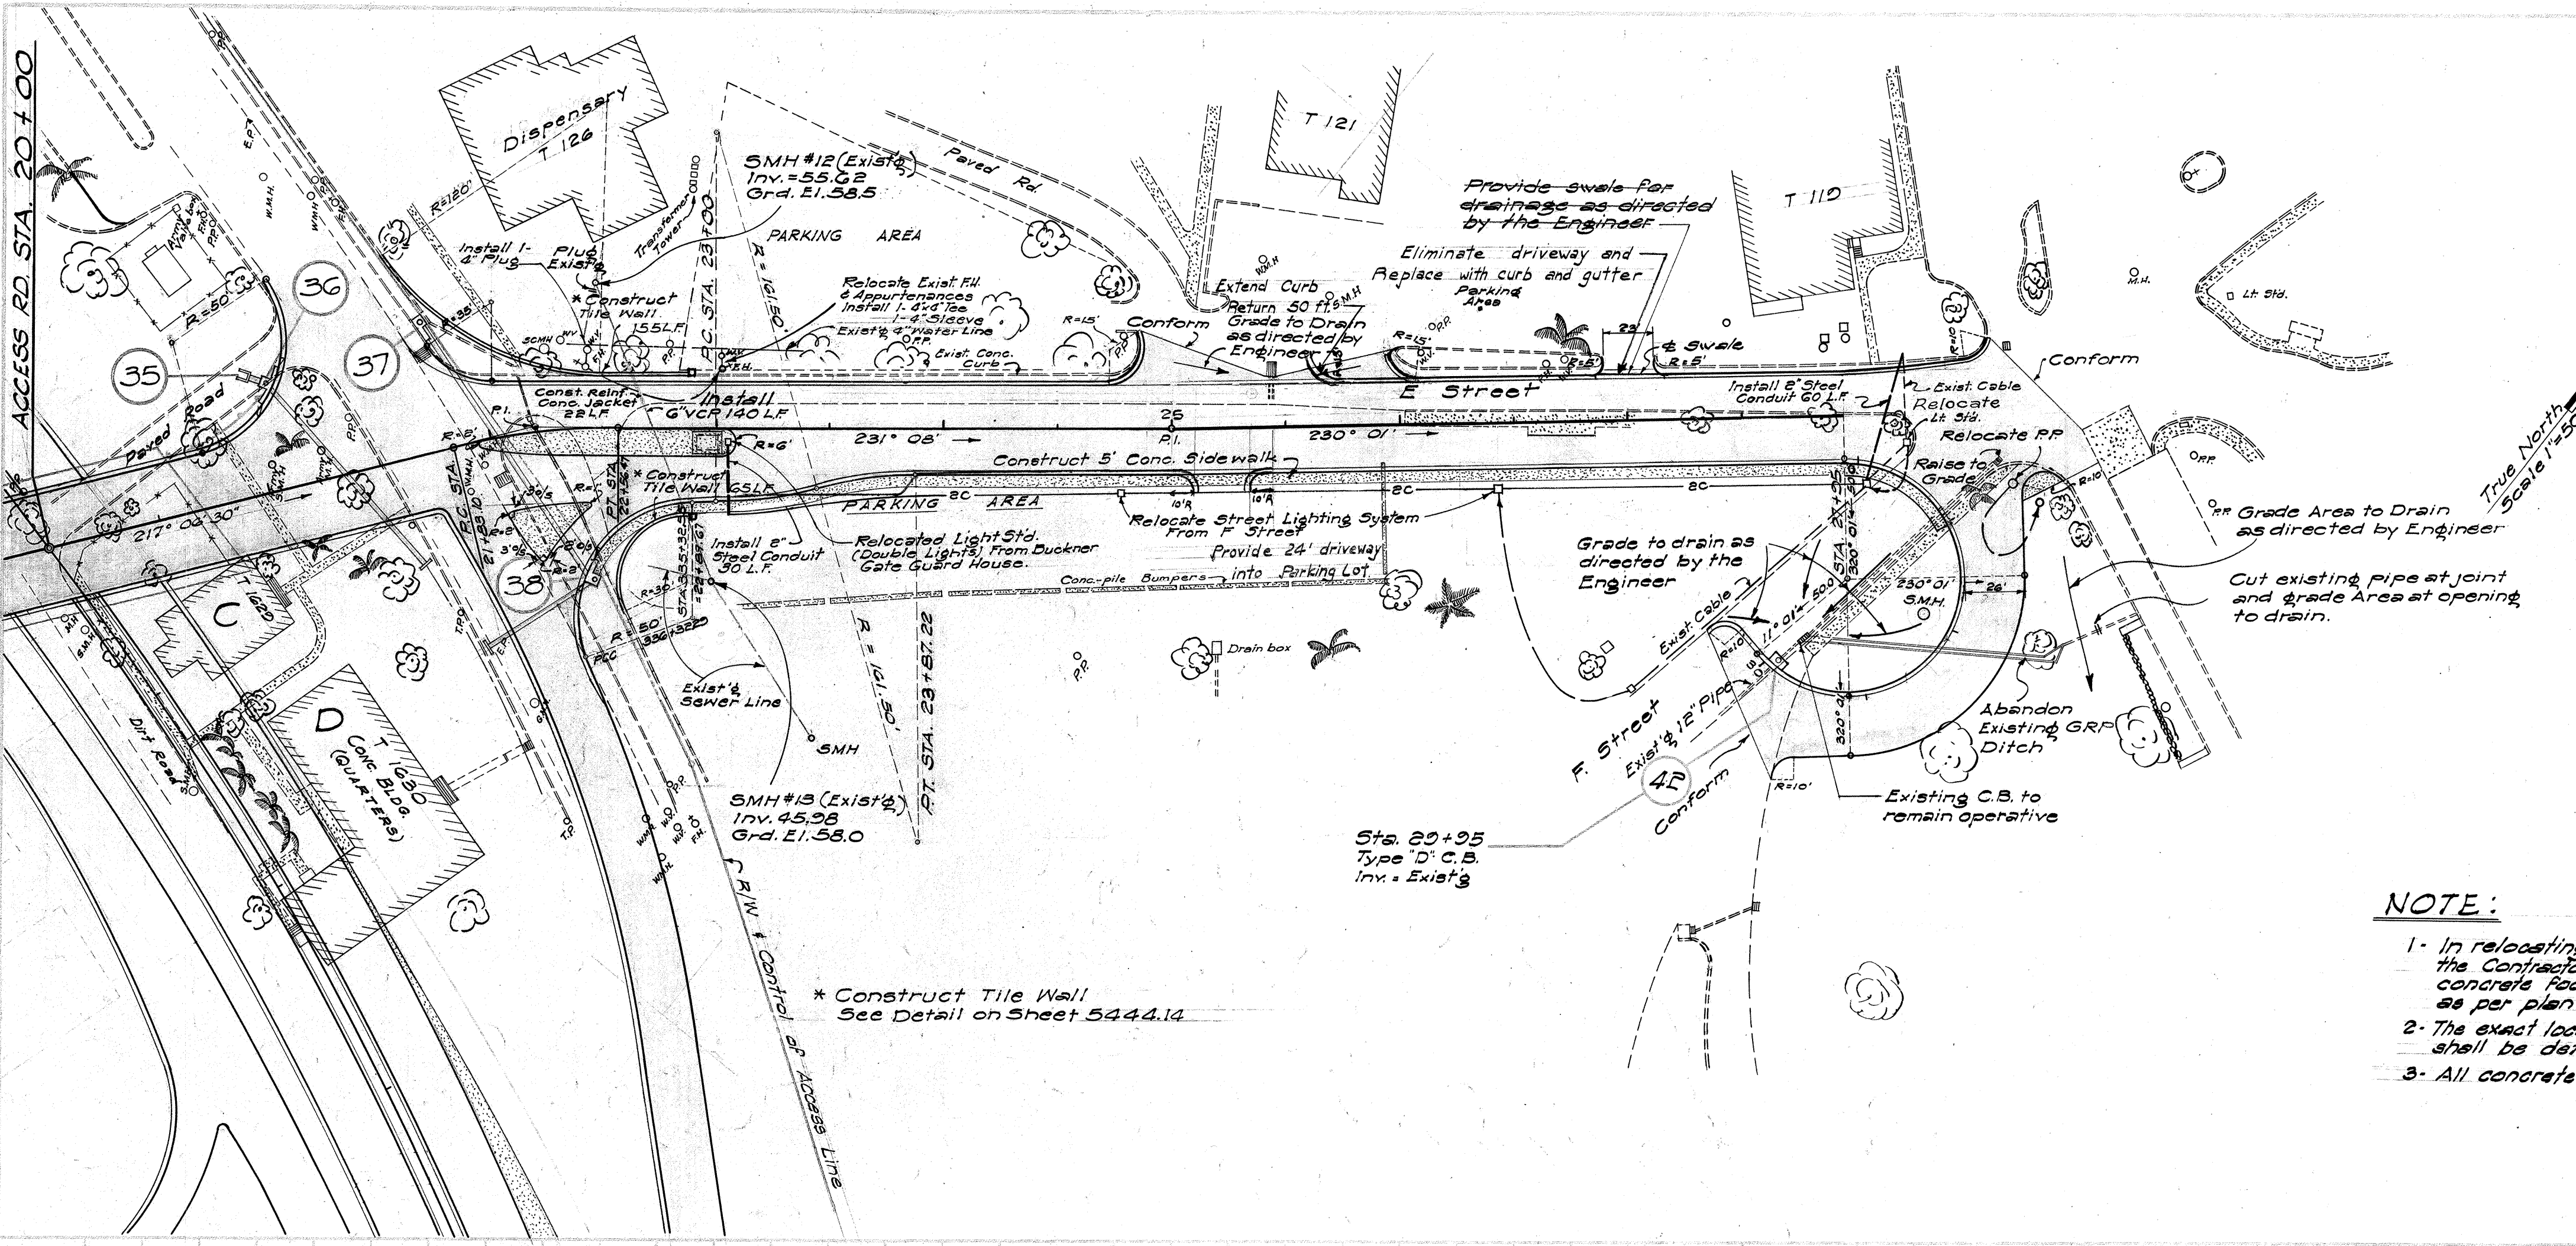


FED. ROAD DIST. NO.	STATE	FED. AID PROJ. NO.	FISCAL YEAR	SHEET NO.	TOTAL SHEETS
HAWAII	HAW.	5-272601	1958	0	100

August 28, 1958



Note:
Sta. 0+00 to Sta. 0+20± Lt. Adjust finished grade of pavement to conform to top of Existing Signal Corps Manhole.
Sta. 0+00 to Sta. 2+00± Cross Slope of the gutter shall be the same as that of the pavement.
Azimuths shown refer to Salt Lake Δ

PLAN	DATE	BY
DESIGNED		
CHECKED		
NOTED		
NO.		

PROFILE	DATE	BY
DESIGNED		
CHECKED		
NOTED		
NO.		

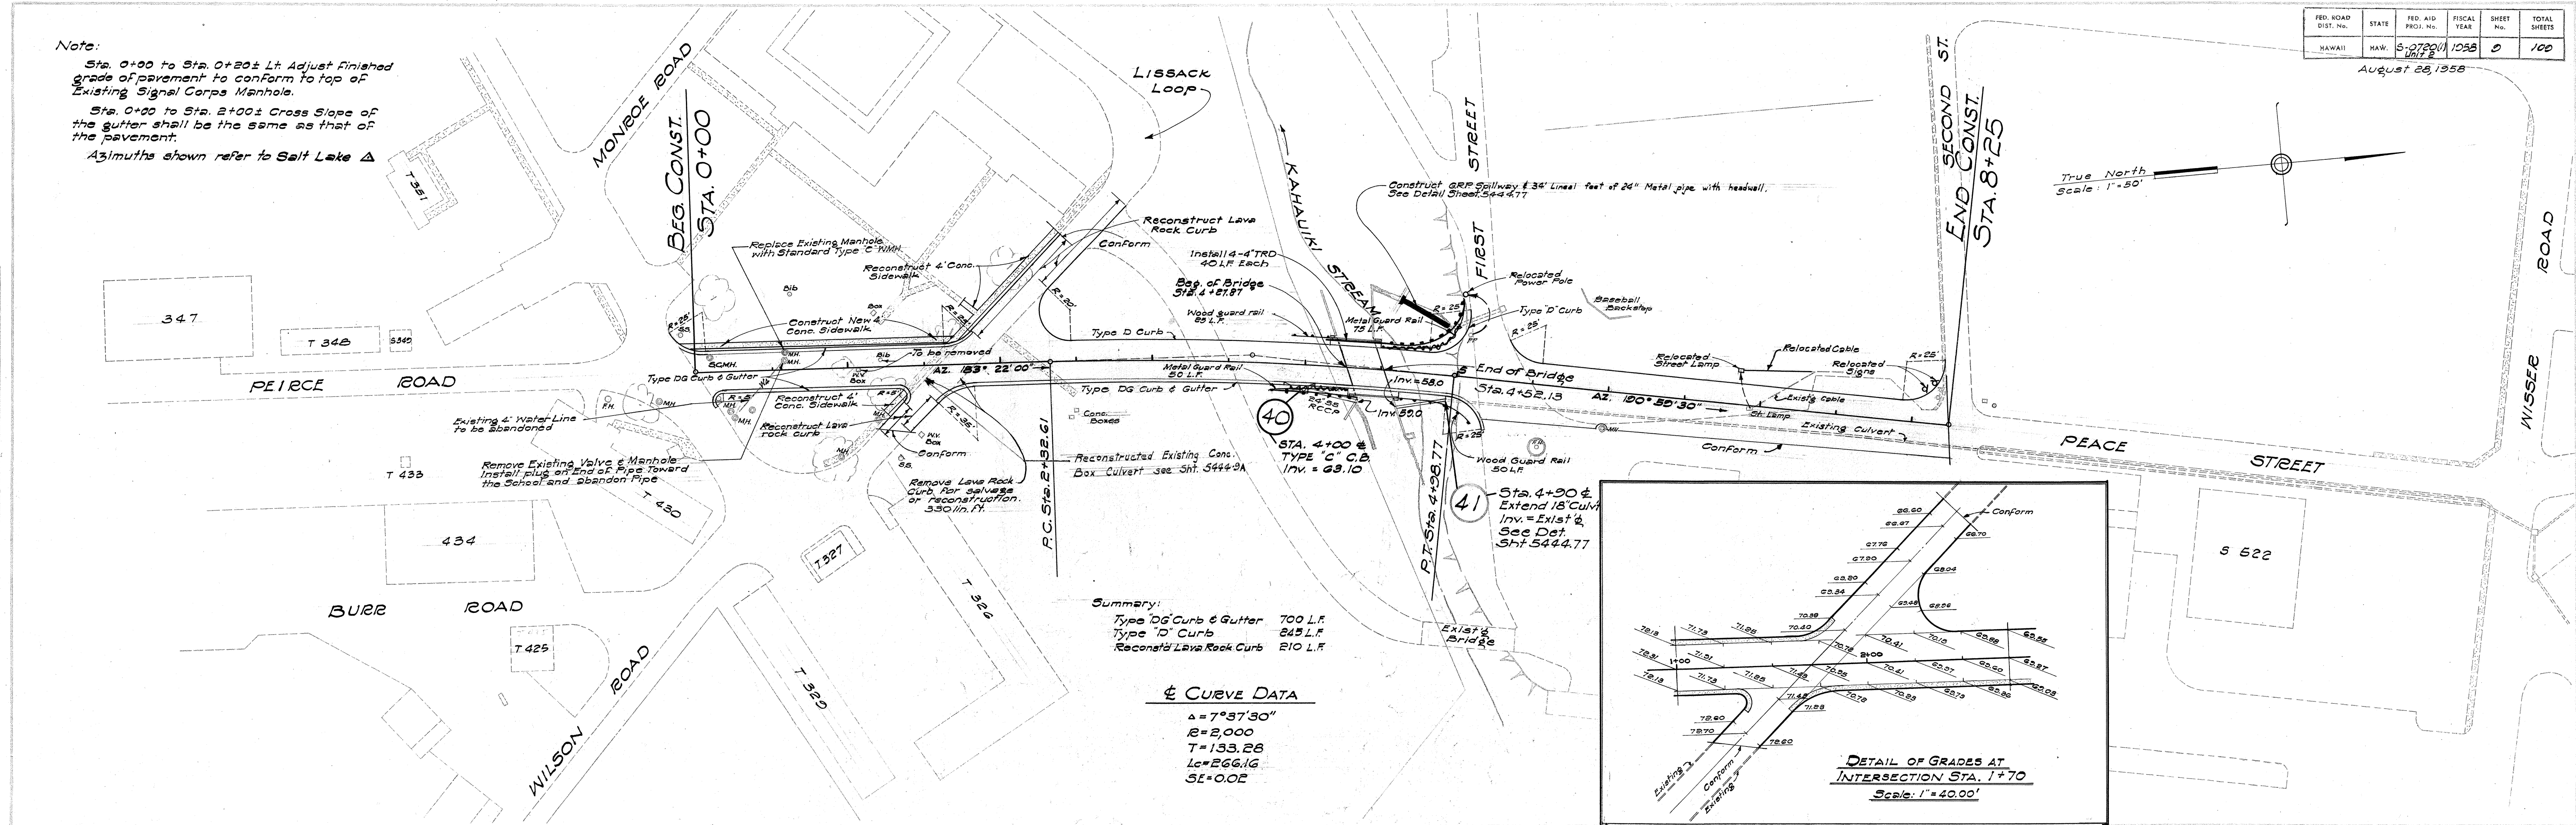


Summary:
Type "DG" Curb & Gutter 700 L.F.
Type "D" Curb 845 L.F.
Reconstruct Lave Rock Curb 110 L.F.

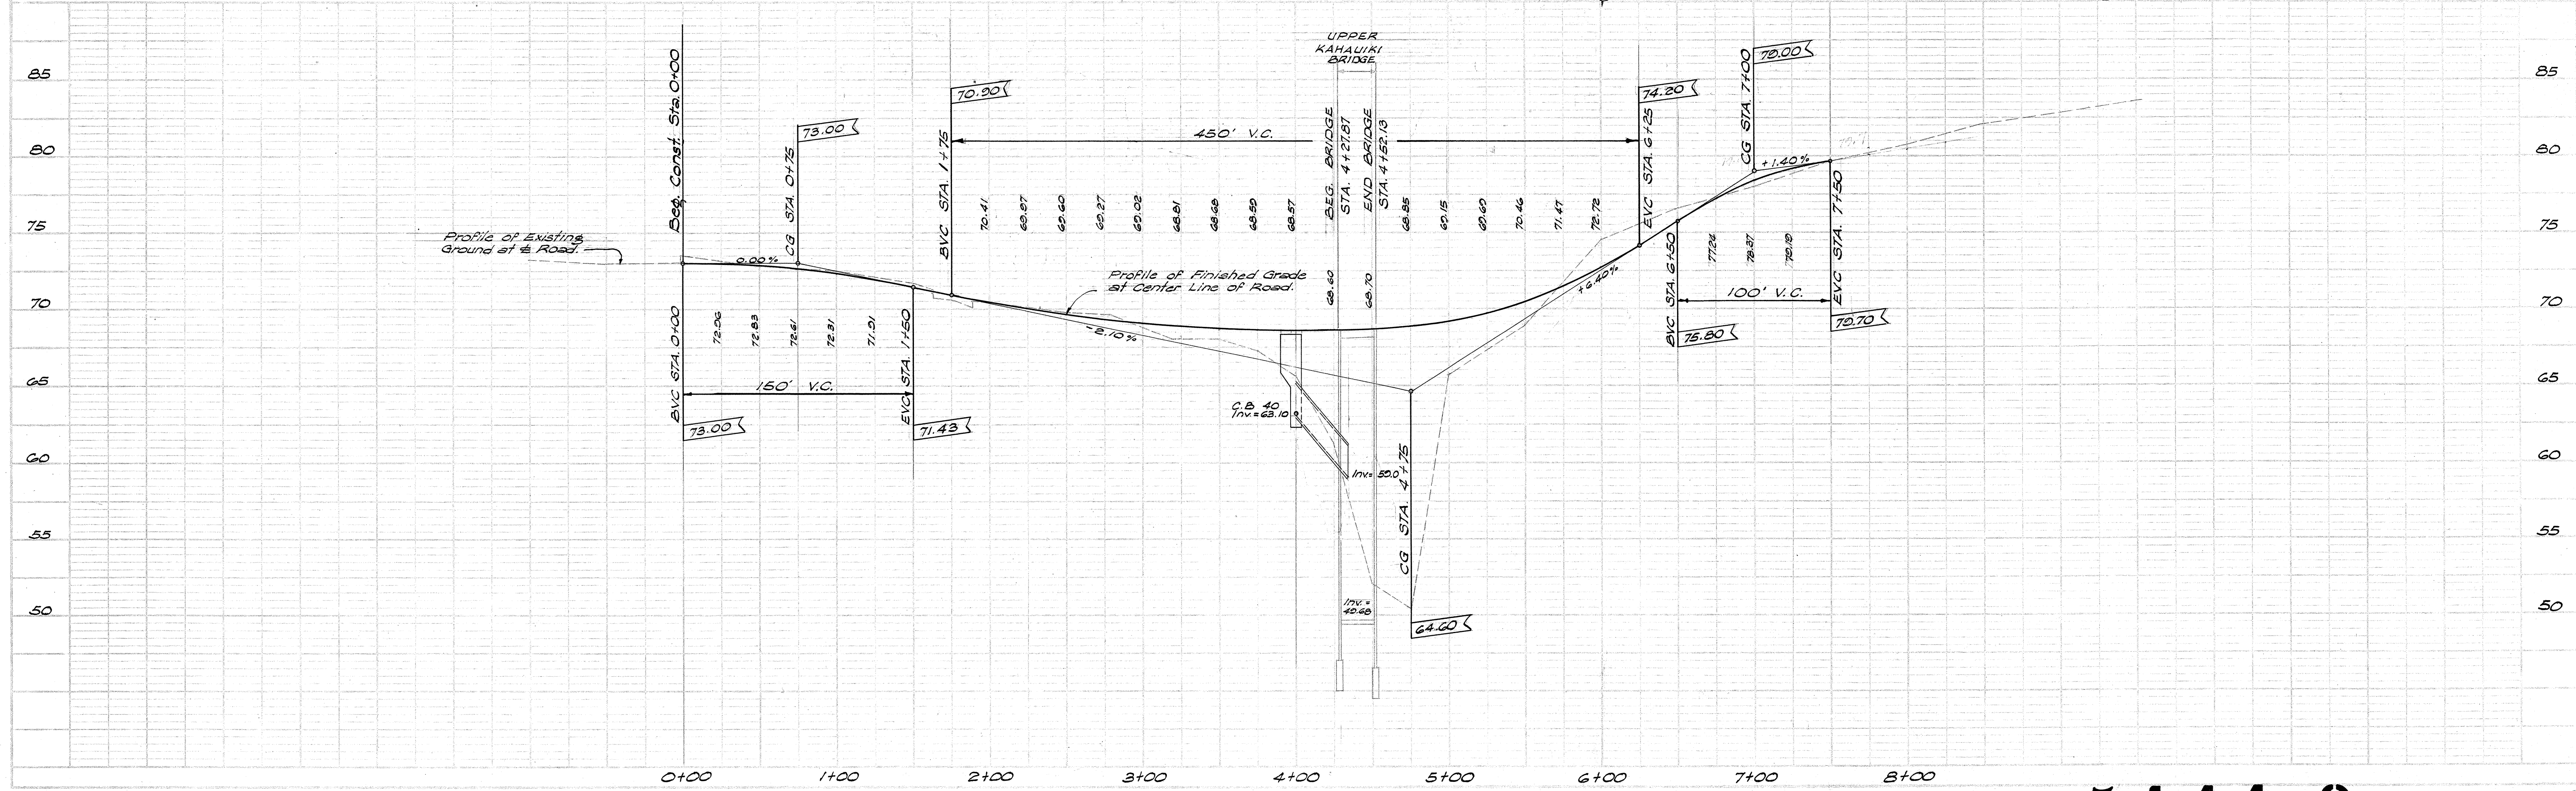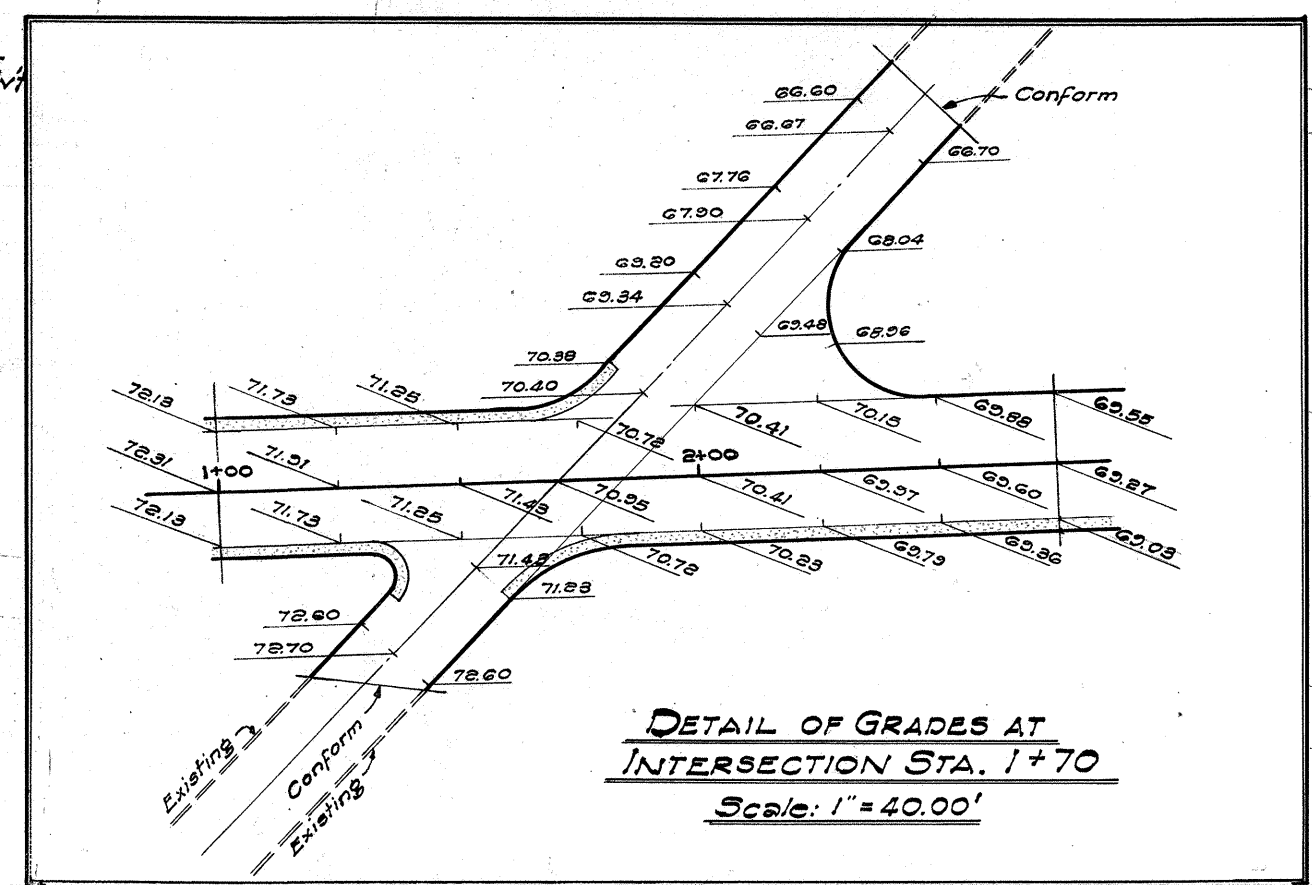


5444.9

FED. ROAD DIST. NO.	STATE	FED. AID PROJ. NO.	FISCAL YEAR	SHEET NO.	TOTAL SHEETS

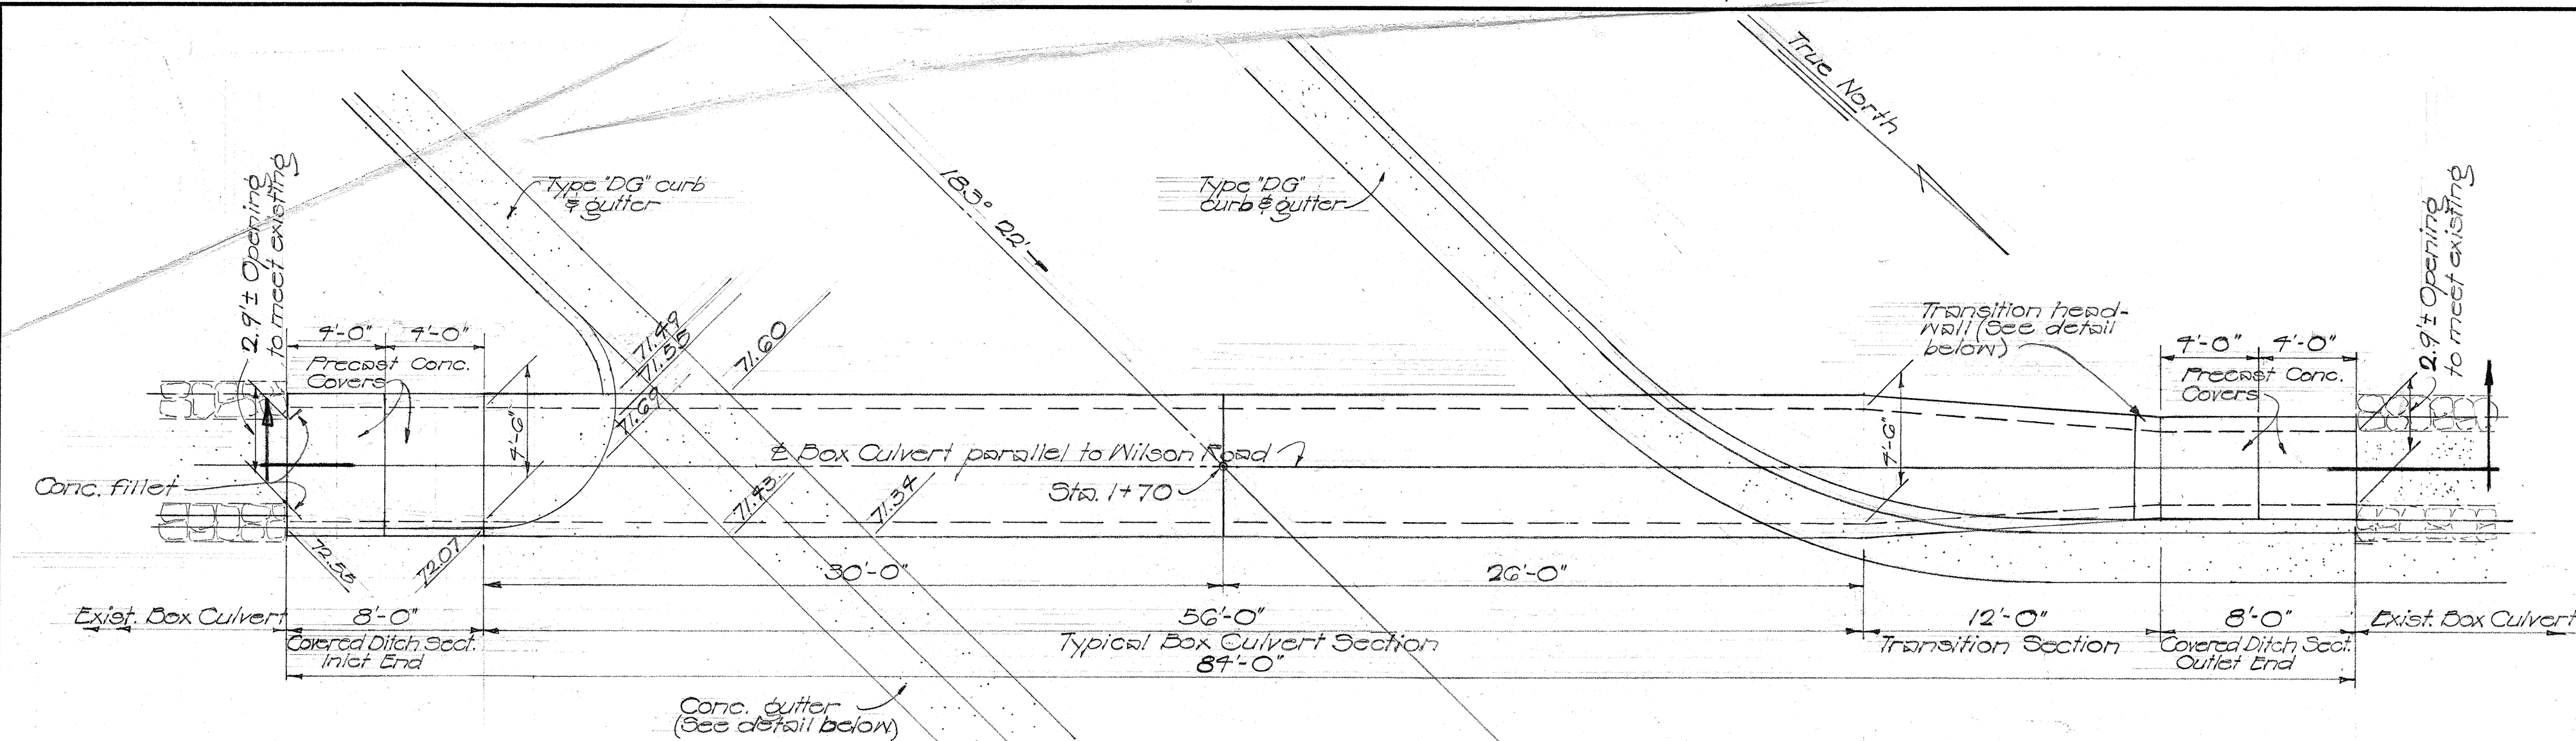


PLAN
Scale: 1" = 5'


Note: For additional details see Sheet 5444.9

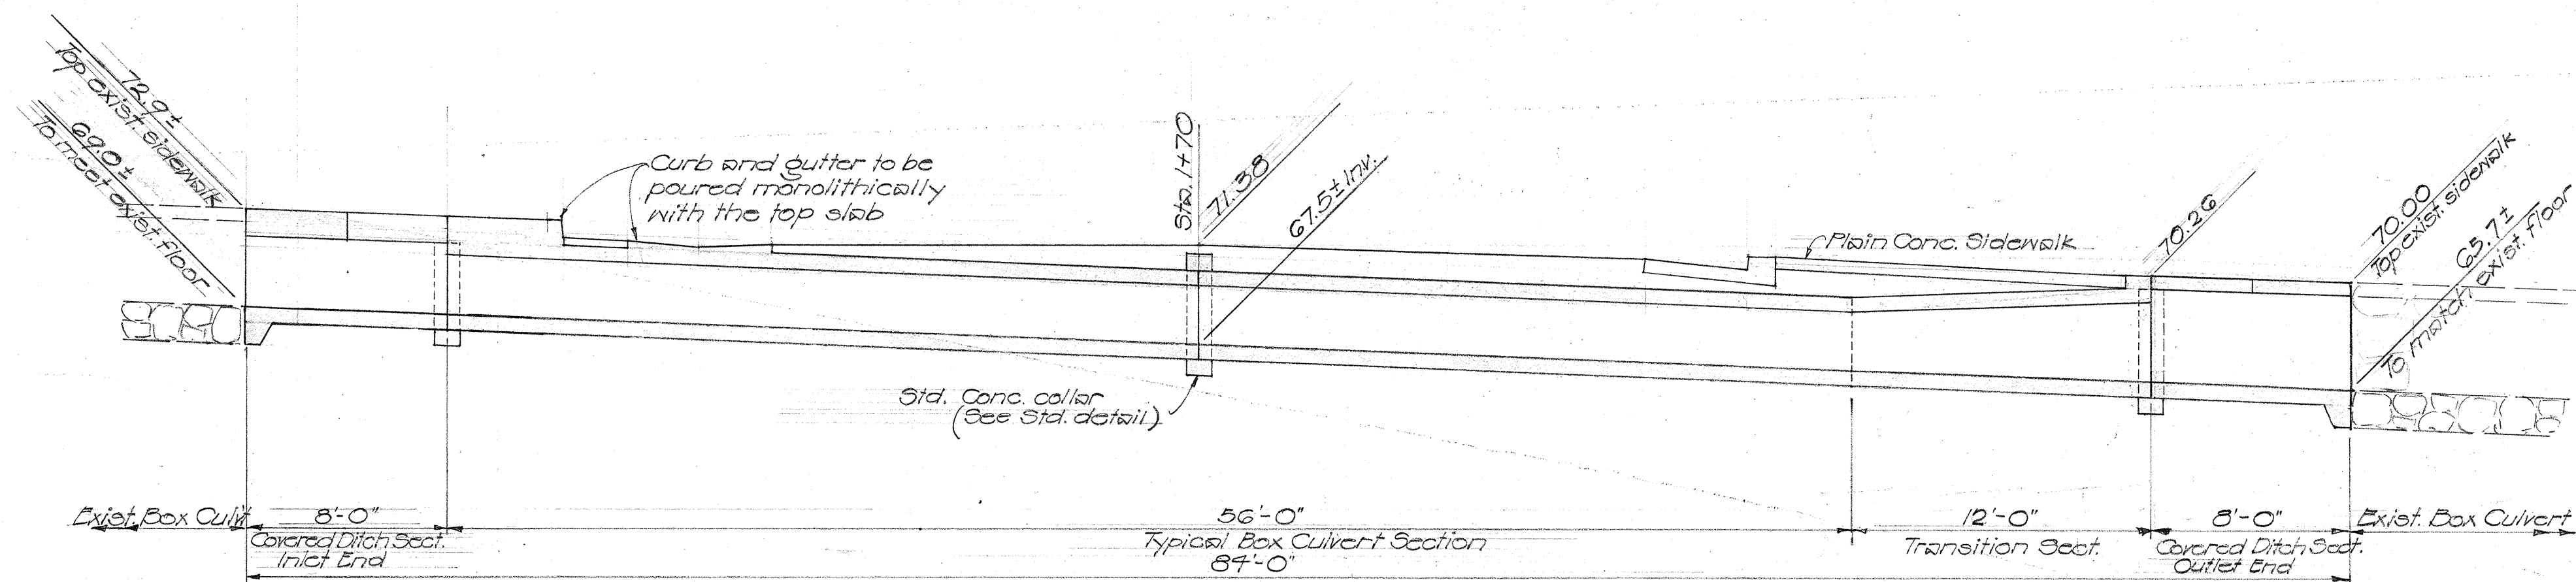


E SECTION
Scale: 1" = 3'

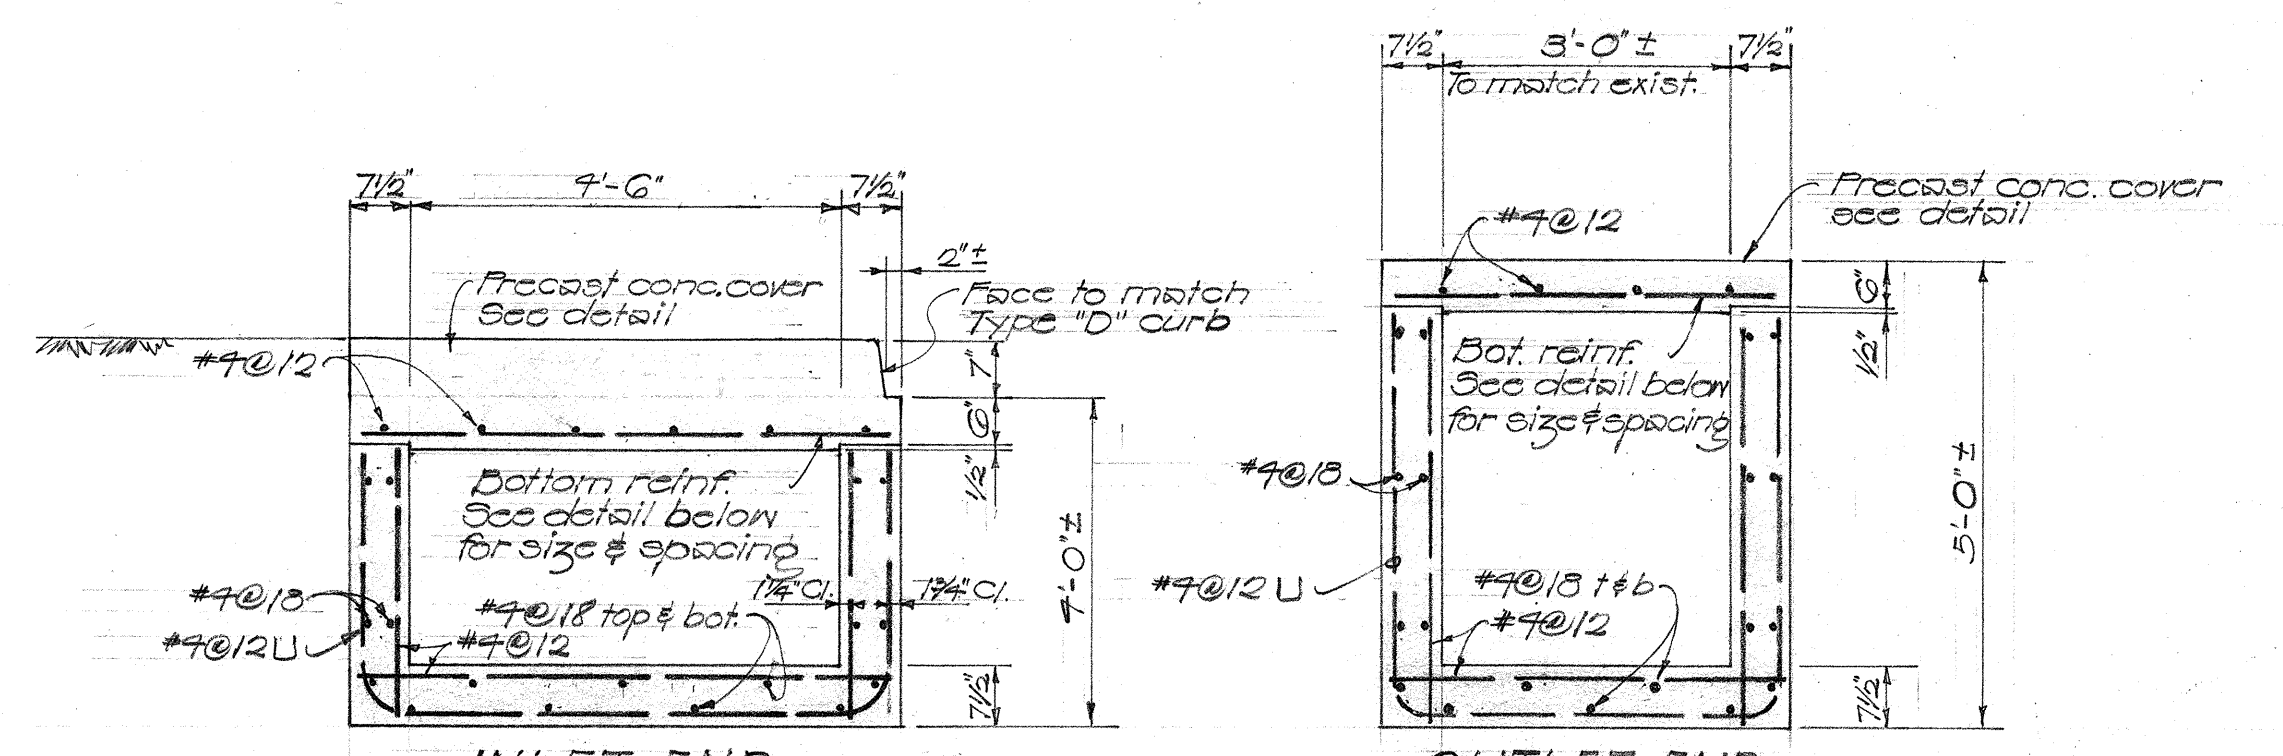


INLET END
OUTLET END
TYPICAL SECTION - COVERED DITCH
Scale: 1/2" = 1'-0"

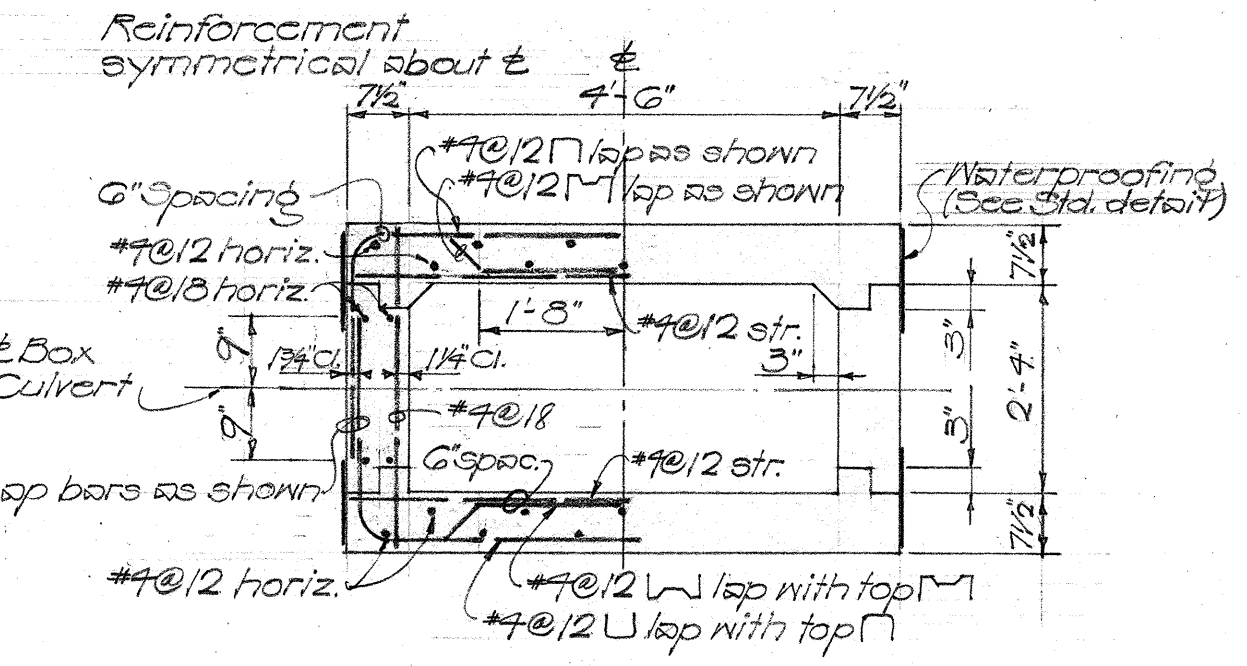


TYPICAL SECTION BOX CULVERT
Scale: 1/2" = 1'-0"

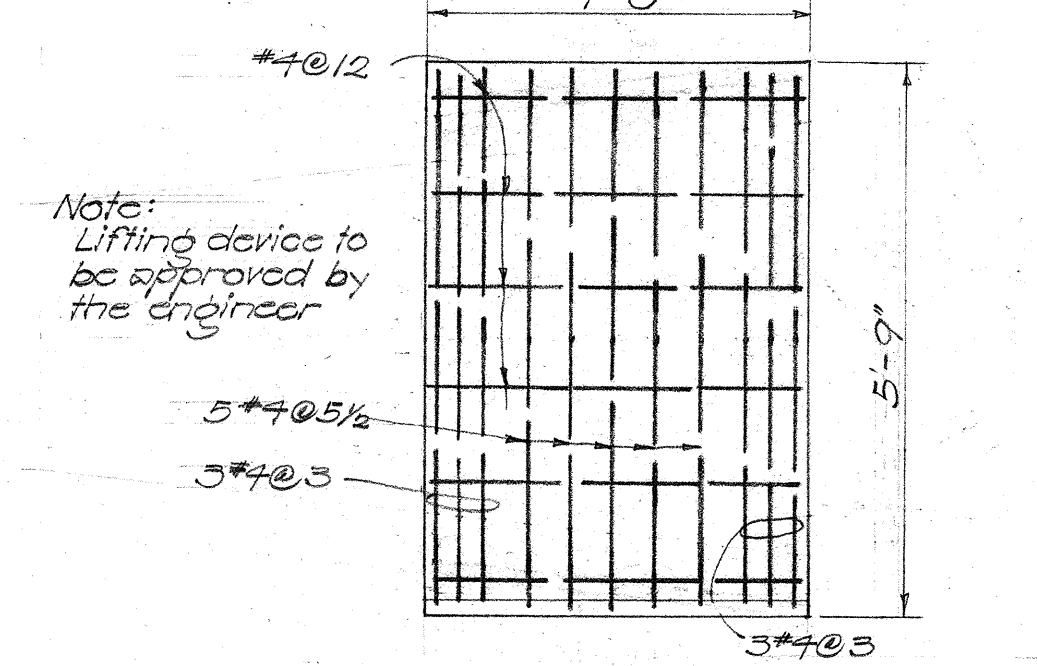

TYPICAL COVER DETAIL
INLET END
Scale: 1/2" = 1'-0"

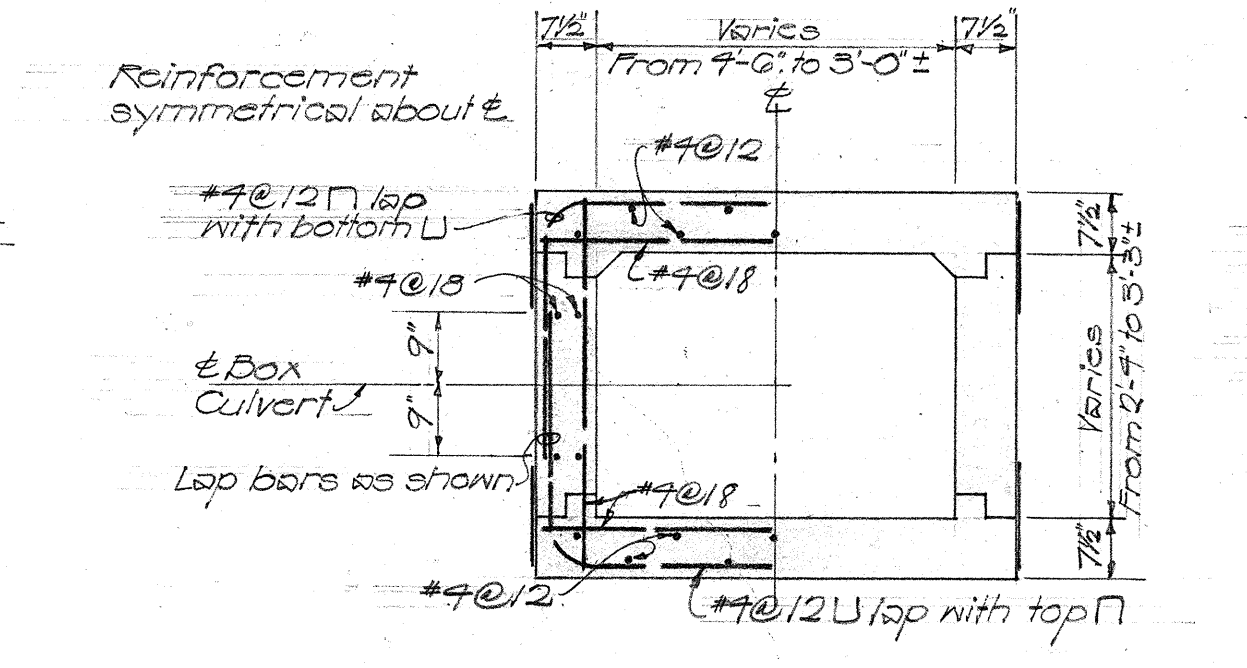


TYPICAL TRANSITION SECTION
Scale: 1/2" = 1'-0"

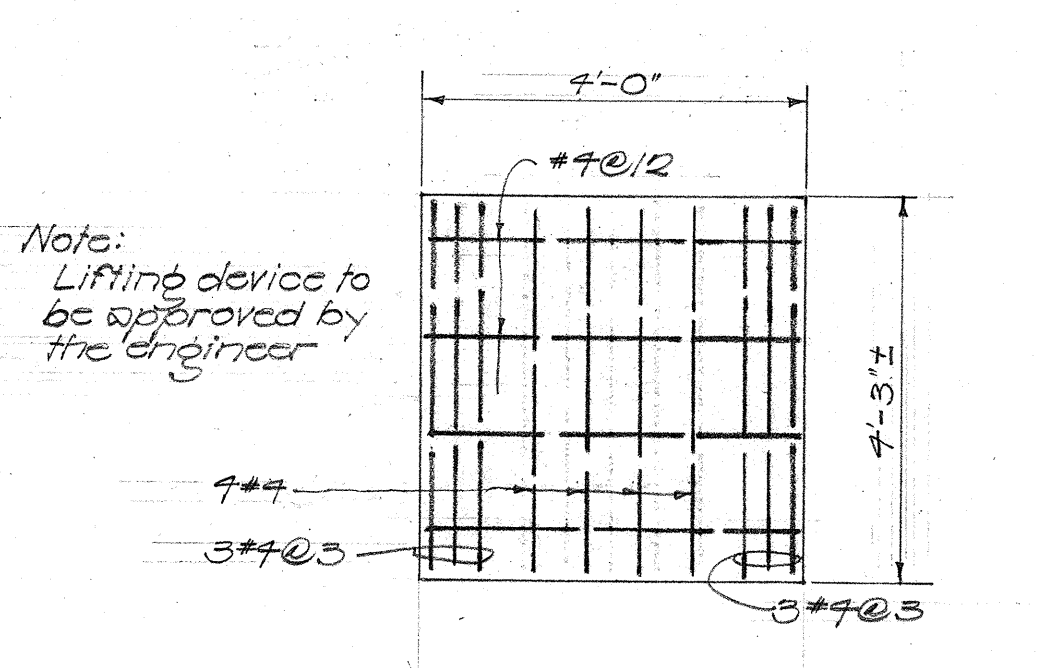


TYPICAL COVER DETAIL
OUTLET END
Scale: 1/2" = 1'-0"

ESTIMATED QUANTITIES


Class A-1 concrete	35.5 c.y.
Reinforcing steel	4600 #
Structural excavation	110 c.y.

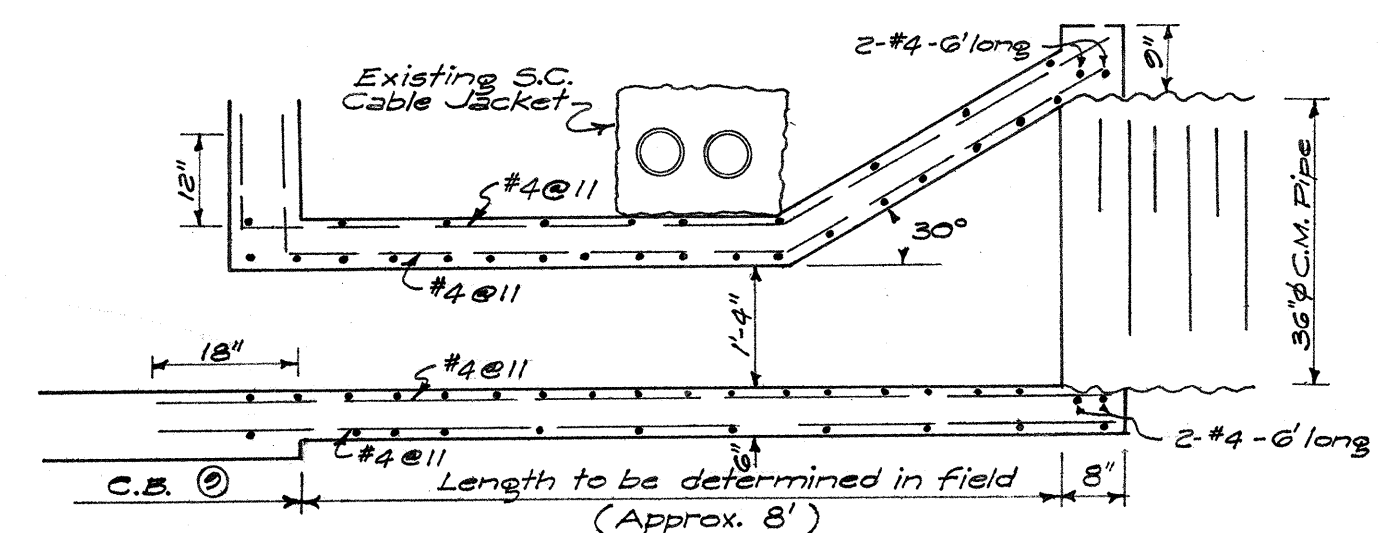


LONGITUDINAL SECTION
Scale: 1/2" = 1'-0"

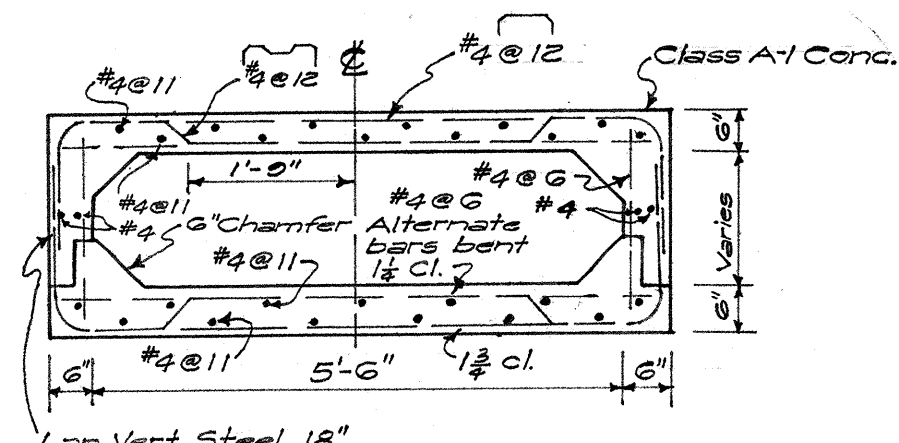

TYPICAL SECTION
Scale: 1/2" = 1'-0"

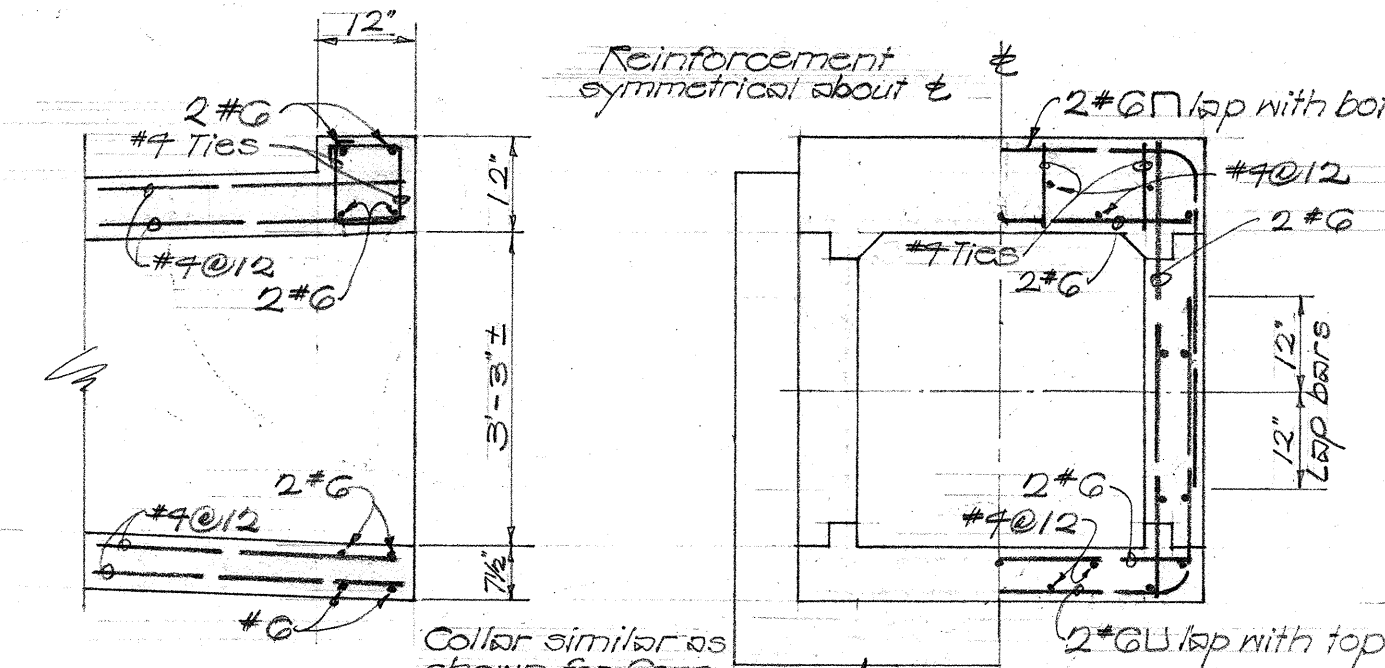

SECTION
ELEVATION
TRANSITION HEADWALL DETAIL
Scale: 1/2" = 1'-0"

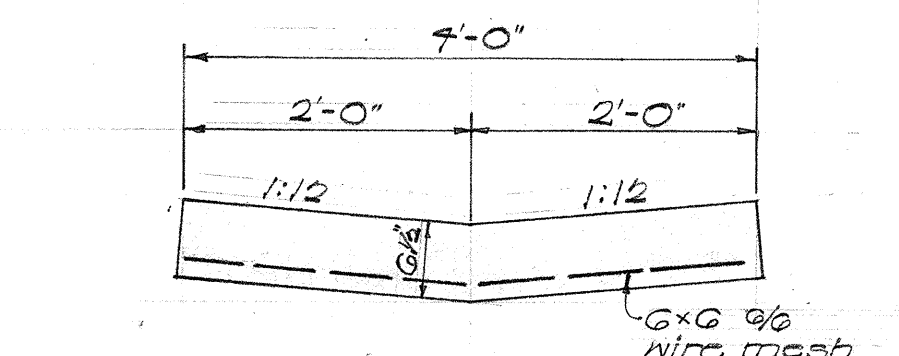

CAST-IN-PLACE CONC. GUTTER
Scale: 3/4" = 1'-0"

CONNECTION CB 9 TO 36" CMP

Scale: As Noted
NOTE: See Sheet 4 for Plan of Connection.

July 21, 1960

TERRITORIAL HIGHWAY DEPARTMENT
TERRITORY OF HAWAII
RECONSTRUCT PORTION
OF EXIST. BOX CULVERT
MOANALUA ROAD
PROJ. NO. S-0750(1) UNIT C
August 1959

SHEET NO. 1 OF 1 SHEETS

5444.9A

SURVEY PLOTTED BY	DATE
DRAWN BY	
TRACED BY	
QUANTITIES CHECKED BY	
NO.	