


INDEX TO DRAWINGS	
SHEET NO.	DESCRIPTION
1	TITLE SHEET
2 - 3	TYPICAL SECTIONS
4 - 9	PLAN PROFILE
10	DRAINAGE SYSTEM QUANTITIES
11 - 12	DAMON ACCESS
13	SAND DRAIN
14 - 14A	NEW FT. SHAFT. ENTRANCE & TILE WALL DET.
15	SOIL PROFILE
16 - 18	ROADWAY GRADES
19 - 21	CURB LAYOUT
22 - 27	UTILITIES
28 - 29	MISCELLANEOUS DETAILS
30 - 34	STANDARD DETAILS - WATER & SEWER
35 - 40	HIGHWAY LIGHTING SYSTEM
41 - 44	TRAFFIC SIGNS
45 - 47	SPRINKLER SYSTEM
48 - 50	BOX CULVERTS
51 - 58	KAHAUHIKI BRIDGE
59 - 66	DAMON OVERPASS
67 - 72	FORT SHAFTER SEPARATION
73 - 76	KAHAUHIKI MAKAI BRIDGE
77 - 82	KAHAUHIKI MAUKA BRIDGE
83	STANDARD ALUMINUM RAILING DETAIL
84 - 109	CROSS SECTIONS

TERRITORY OF HAWAII
TERRITORIAL HIGHWAY DEPARTMENT
HONOLULU, OAHU, T. H.

PLANS OF
MOANALUA ROAD
FEDERAL AID SECONDARY PROJECT NO. S 0720(I)
UNIT 2
HONOLULU DISTRICT,
ISLAND OF OAHU

SCALES		
PLAN	1 INCH	= 50 FEET
PROFILE	HOR. 1 INCH	= 50 FEET
	VER. 1 INCH	= 10 FEET
CROSS SECTIONS	HOR. 1 INCH	= 10 FEET
	VER. 1 INCH	= 10 FEET

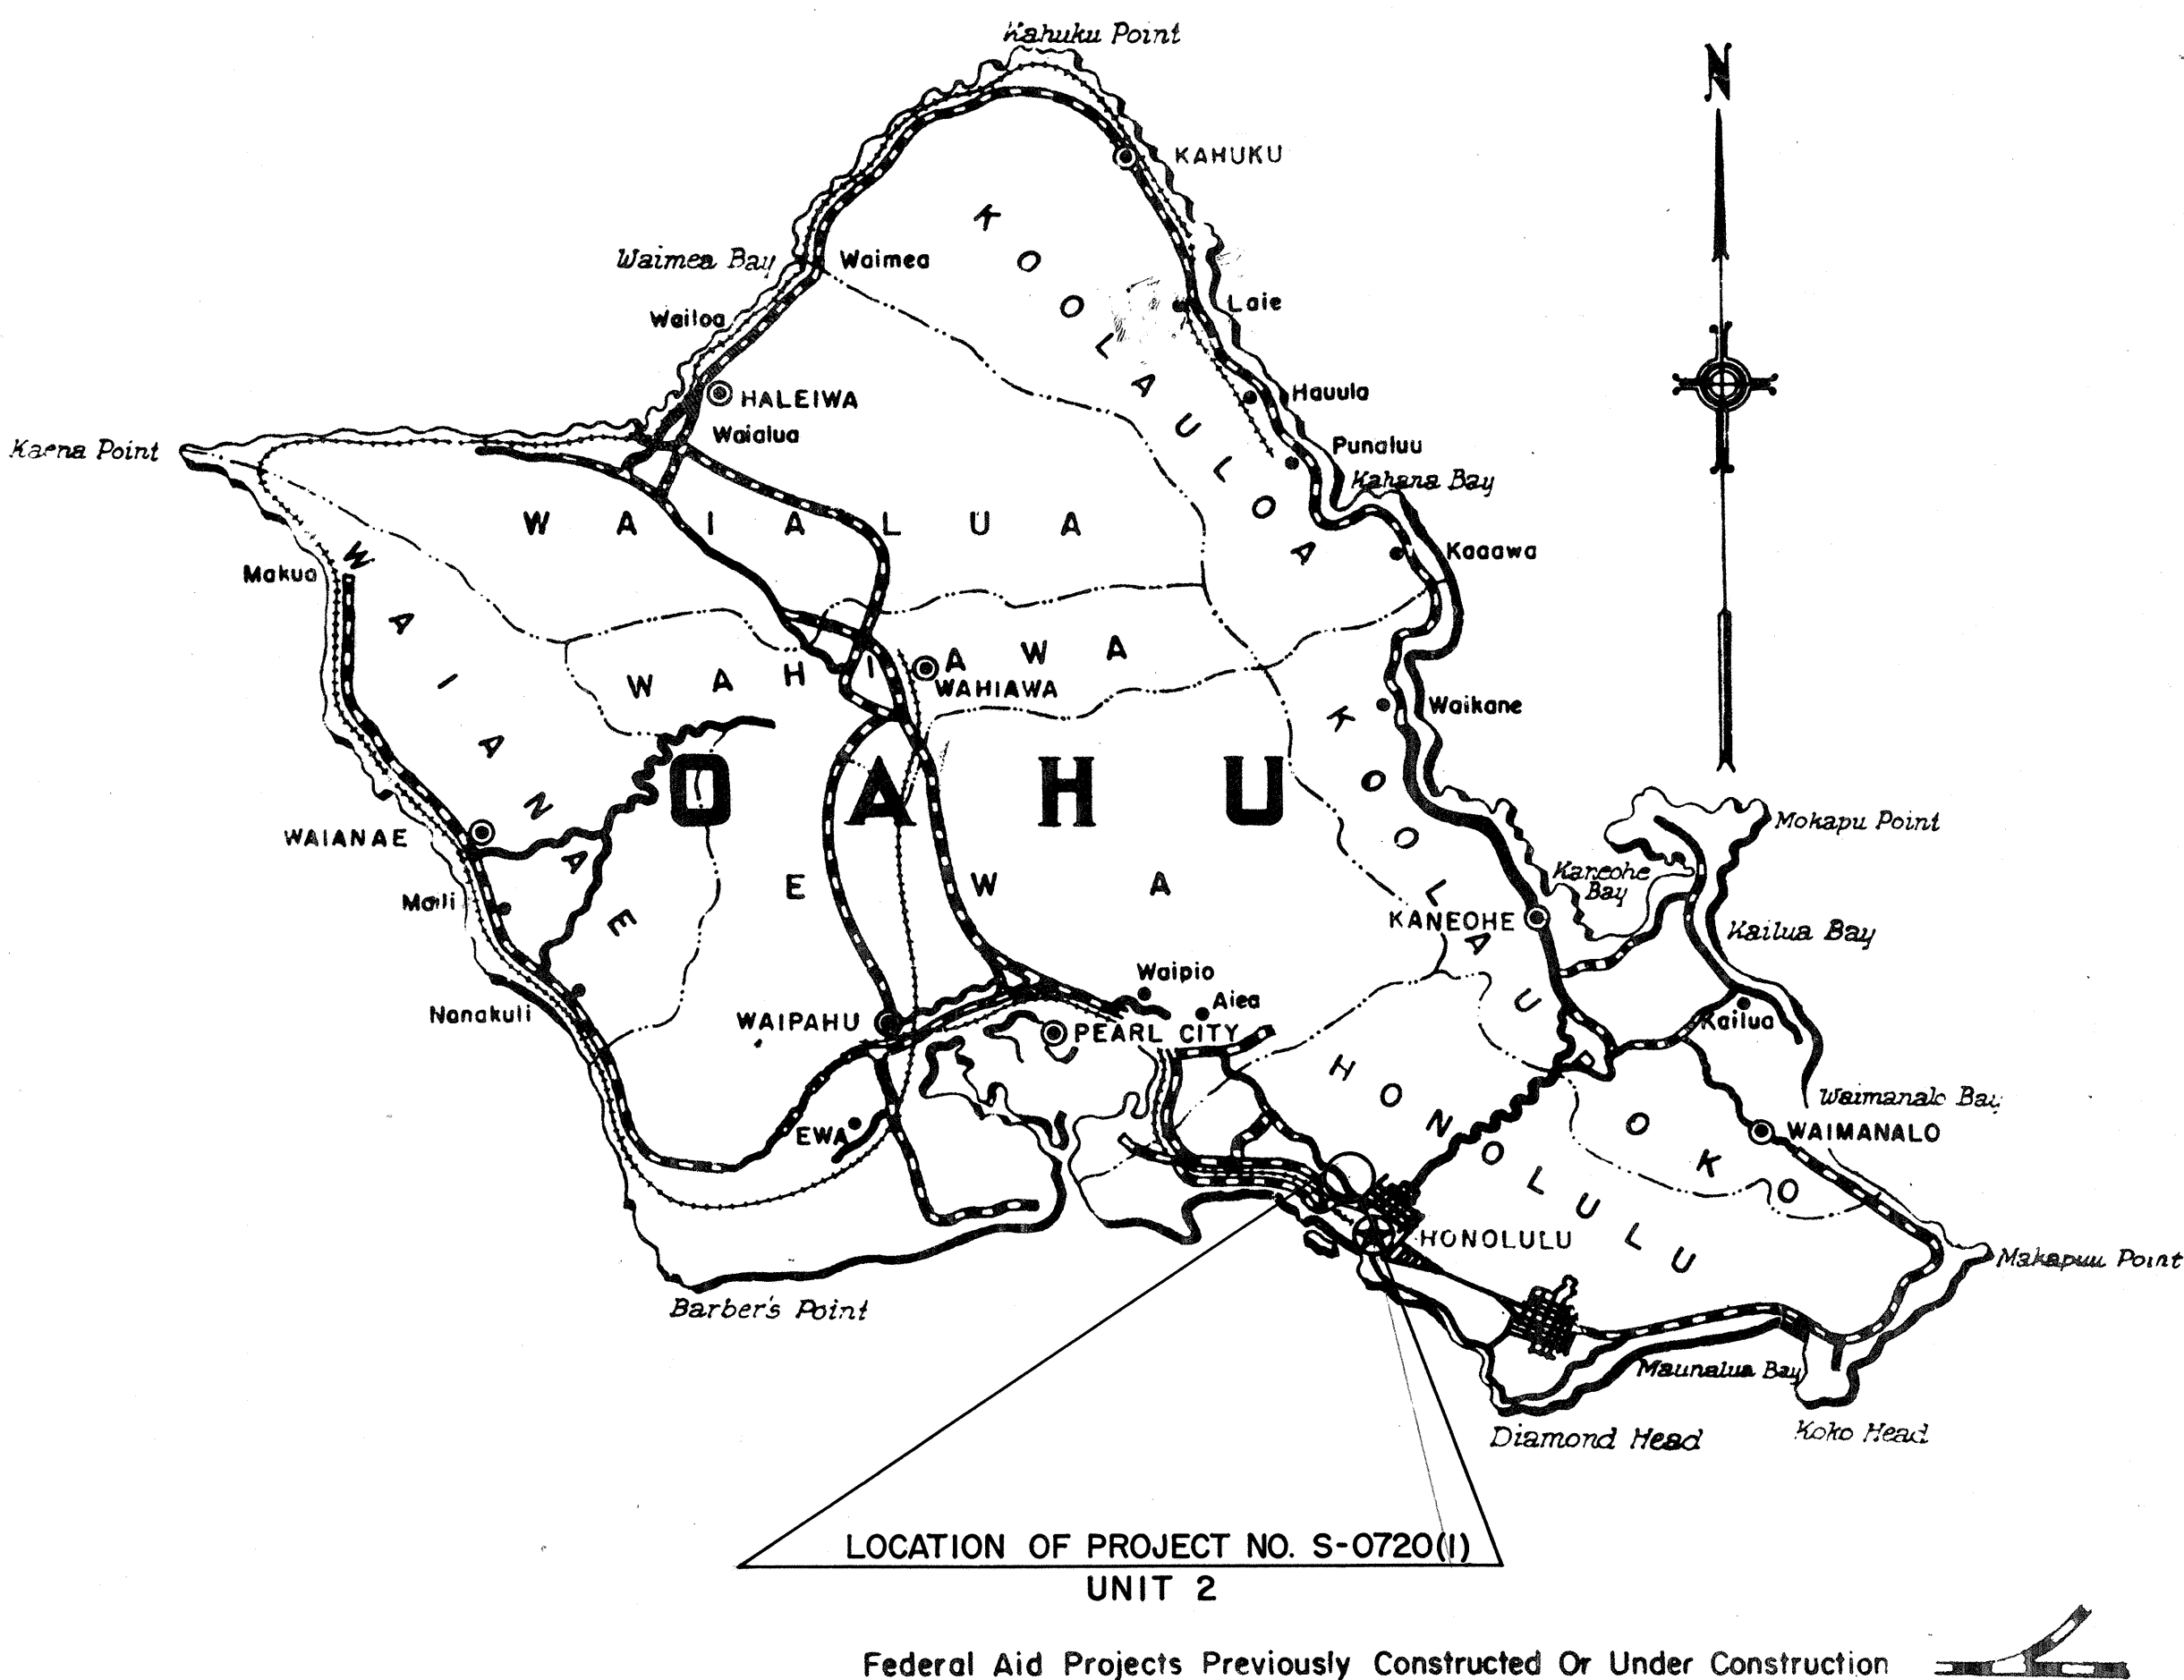

NOTE :

ALL CHANGES MADE DURING CONSTRUCTION
HAVE BEEN NOTED IN RED ON THESE
TRACING AND CHECKED BY:

T.M. Chun
PROJECT ENGINEER
10/12/61
DATE

CONVENTIONAL SIGNS	
Centerline	55
Boundary Lines	or
Fences (Noted)	or
Existing Roadway	
Circular Conc. Culvert	
Railroad	
Telephone Pole	O.T.P.
Electric Power Line Pole	O.E.P.
Sewer Manhole	O.S.M.H.
Telephone Manhole	O.T.M.H.
Fire Hydrant	O.F.H.
Water Valve	O.W.V.
Water Manhole	O.W.M.H.
St'd Conc. Roll Curb	
Water Main	W
Gasoline Pipe Line	G
Communication Cable	
Warning & Regulatory Signs	(Type)
Centerline Monument	⊙
Destination Signs	DESTINATION → DESTINATION

APPROVED: DATE 5/21/53
Wm. Waithe
TERRITORIAL HIGHWAY ENGINEER

DEPARTMENT OF COMMERCE
BUREAU OF PUBLIC ROADS
APPROVED:
DIVISION ENGINEER DATE